


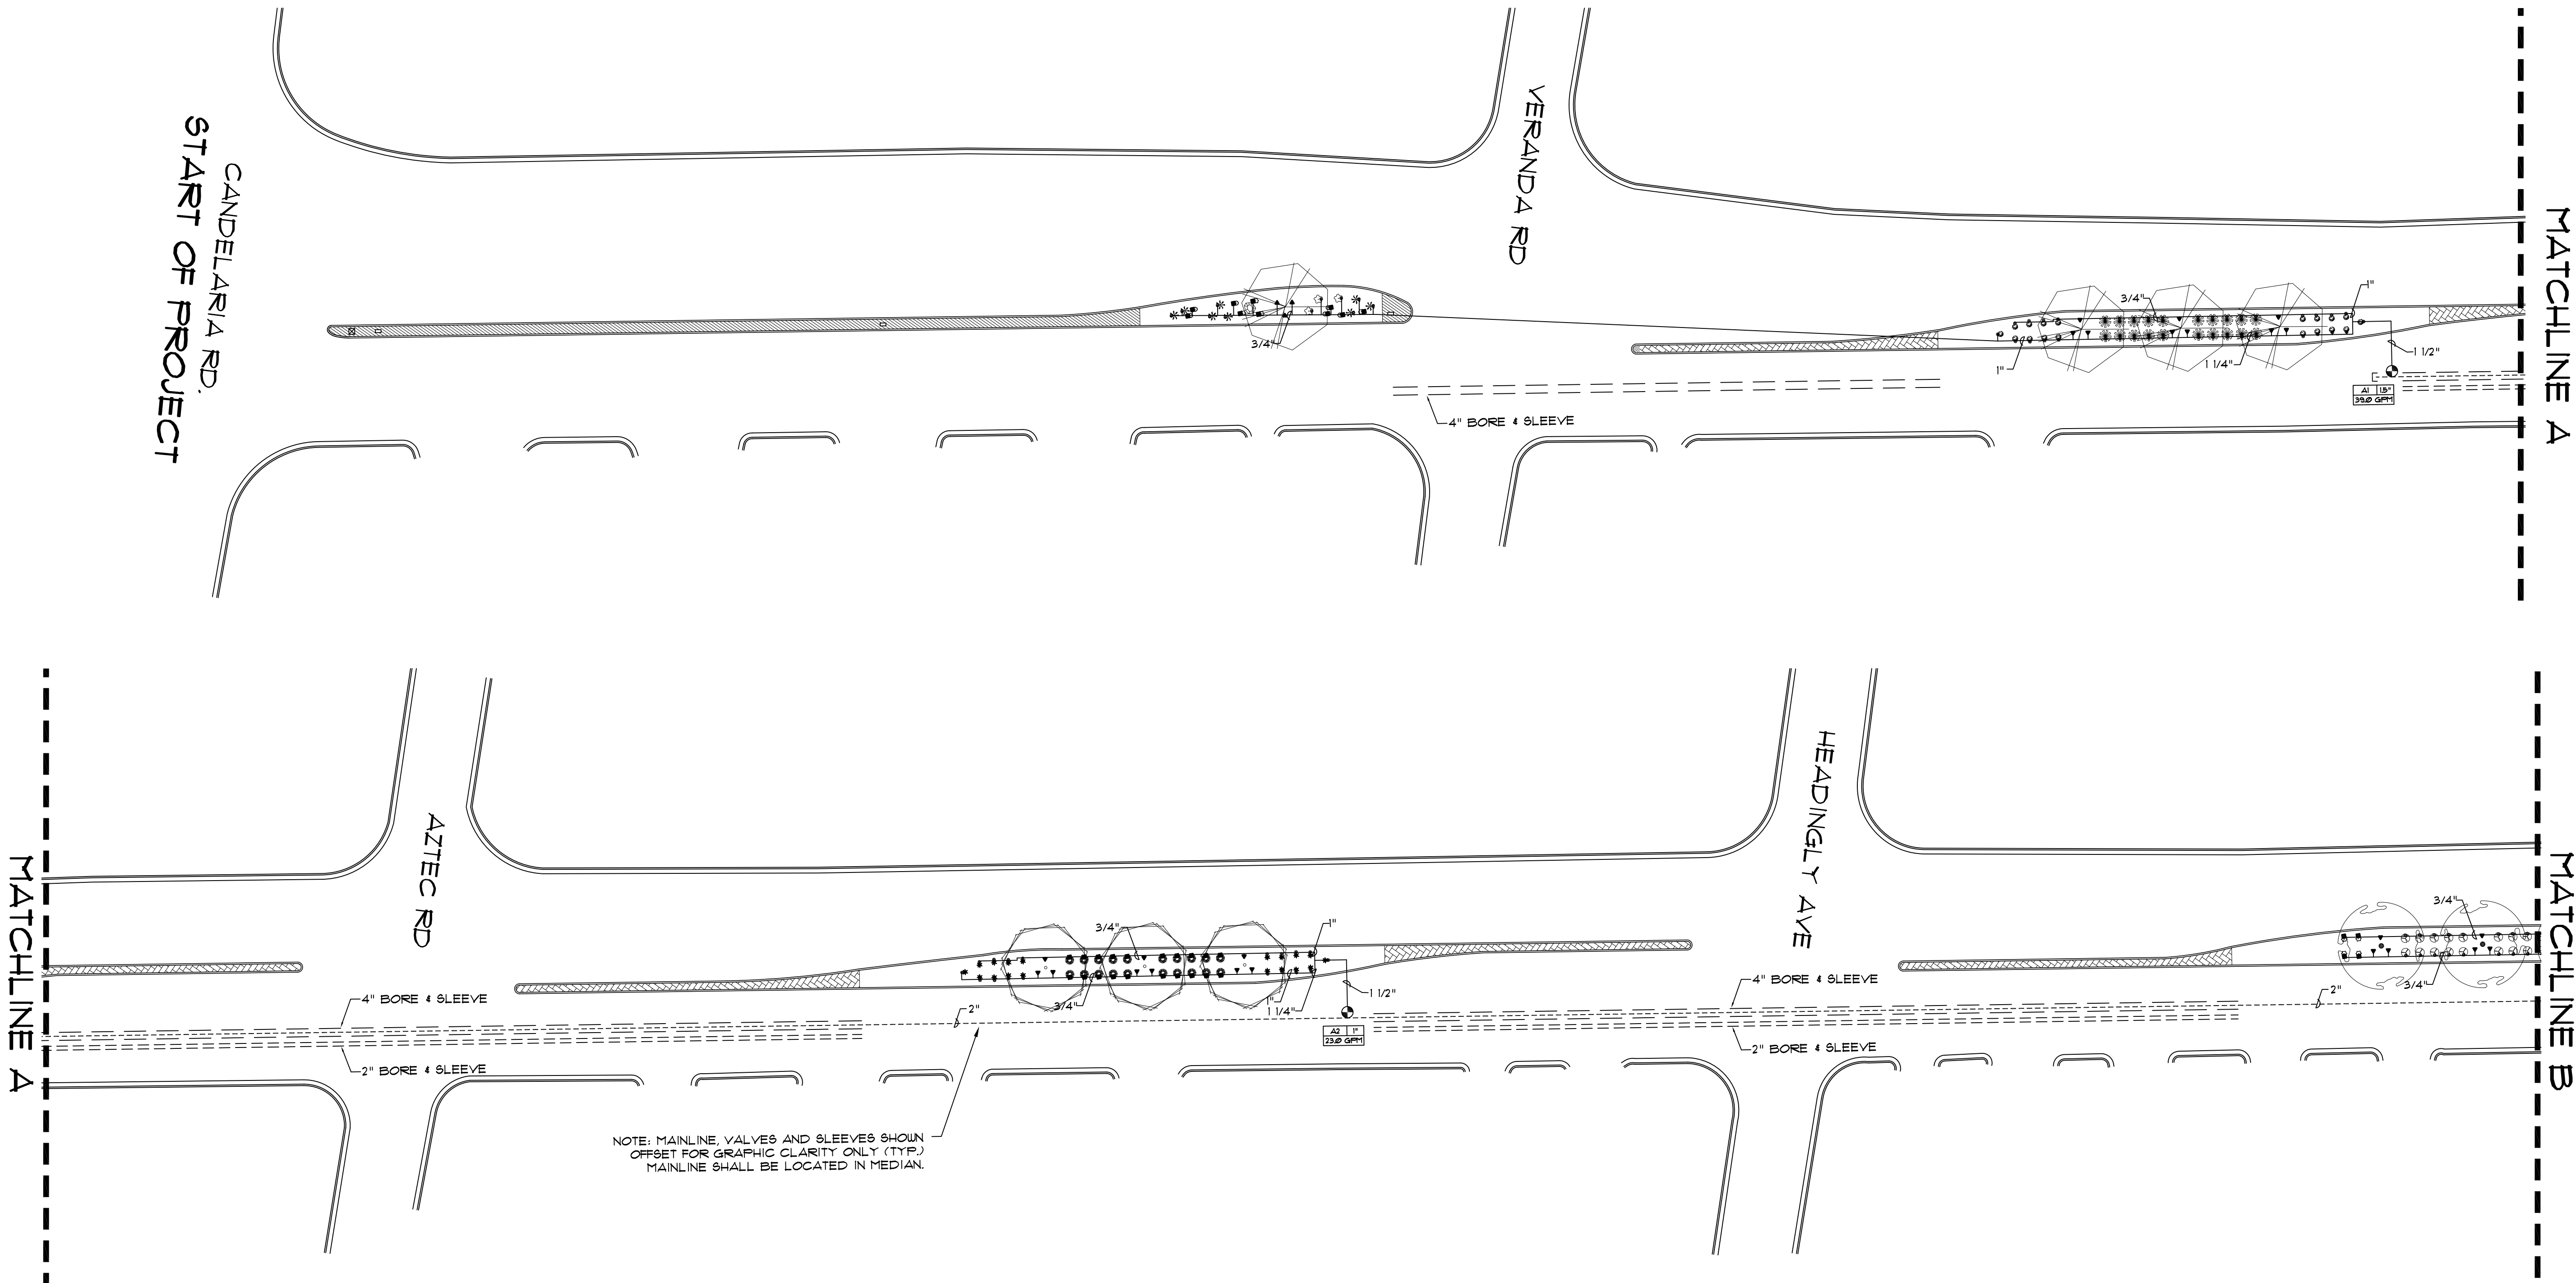

CANDELARIA RD.
START OF PROJECT

VERANDA RD

HEADINGLY AVE

AZTEC RD

MATCHLINE A

MATCHLINE B


IRRIGATION LEGEND for POC #1

- WATER METER, 2". INSTALL PER C.O.A. DIAG. 2362 OR 2363.
- IRRIGATION MAIN LINE, 2", SCH 40 BELL END, SOLVENT WELD PVC. DEPTH OF BURY SHALL BE 28".
- LATERAL PIPING, SCH. 40 BELL END, SOLVENT WELD PVC. DEPTH OF BURY, 18". SIZE PER PLAN.
- MAIN LINE AND LATERAL SLEEVE PIPING, 2 SIZES LARGER THAN PIPE SIZE, CLASS 200, SDR-21, BELL-END, SOLVENT WELD PVC. SLEEVES ARE TO BE BORED, SAWCUT WILL NOT BE ALLOWED.
- 24-VOLT IRRIGATION WIRE SLEEVE PIPING, 2", CLASS 200, SDR-21, BELL-END, SOLVENT WELD PVC. SLEEVES ARE TO BE BORED, SAWCUTS WILL NOT BE ALLOWED.
- ISOLATION VALVE ASSEMBLY, 2". INSTALL PER C.O.A. DRAWING NO. 2101.
- FEBCO 860-U 2" REDUCED PRESSURE PRINCIPAL BACKFLOW PREVENTER AND MASTER VALVE ASSEMBLY WITH BALL VALVES, INSTALLED IN HEATED AND INSULATED ENCLOSURE AND MASTER METER INSTALLED IN VALVE BOX PER DETAIL C14. SIZE OF RP, MASTER VALVE, AND MASTER METER SHALL BE SAME AS LINE SIZE. ENCLOSURE SHALL BE SIZED TO ACCOMMODATE SIZE OF RP AND MASTER VALVE ASSEMBLY.
- REMOTE CONTROL VALVE ASSEMBLY, RAINBIRD FEB PLASTIC BODY 24-VOLT AUTOMATIC VALVE, SIZE PER PLAN, INSTALL PER C.O.A. DRAWING NO. 2103. (SIMILAR - SEE IRRIGATION NOTES #25 AND #26, SHEET 2.)
- SOLVENT WELD CAP, SCH. 40 PVC, LINE SIZE.
- 1" AIR RELEASE VALVE. INSTALL PER C.O.A. DRAWING NO. 2105.



PRESSURE COMPENSATING BUBBLER ASSEMBLIES, RAIN BIRD 1400 SERIES, AS FOLLOWS: INSTALL PER C.O.A. DRAWING NUMBERS 2110, 2111, 2111-A AND 2112.

MODEL NO.	GR1	FS1
1401	25	30
1402	50	30
1404	10	30

IRRINET M AC 12 STATION CONTROLLER.

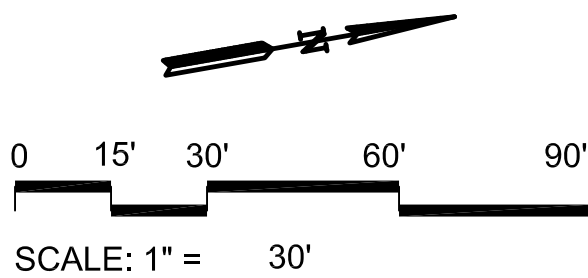

AS-BUILT
11/28/2011

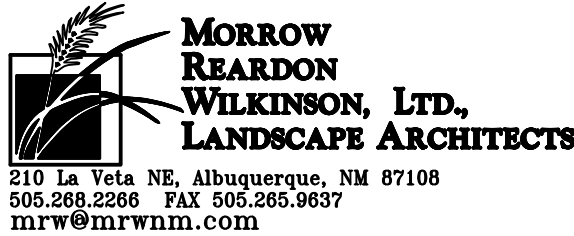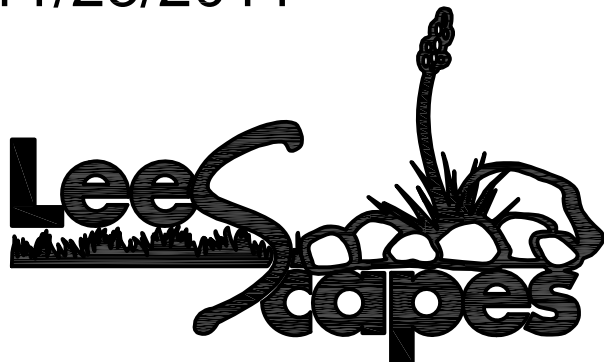

CITY OF ALBUQUERQUE
CAPITAL IMPLEMENTATION PROGRAM
DEPARTMENT OF MUNICIPAL DEVELOPMENT

PROTOTYPE MEDIAN AND INTERSTATE LANDSCAPES FY-11B
2ND ST. CANDELARIA RD. TO MONTANO RD.
IRRIGATION PLAN: WORK ORDER #1

Design Review Committee

City Engineer Approval

Last Design Update

Mo./Day/Yr.

Mo./Day/Yr.

City Project No.
777702

Zone Map No.
F-15, G-14


Sheet
1 OF 4

AS-BUILT INFORMATION	
CONTRACTOR	LEE LANDSCAPES, INC.
WORKED BY	DATE
INSPECTED BY	DATE
ACCEPTANCE BY	DATE
VERIFICATION BY	DATE
DATE	11/28/11
MICRO-FILM INFORMATION	
RECORDED BY	DATE
NO.	

SURVEY INFORMATION	
FIELD NOTES	DATE
NO.	BY


ARCHITECTURAL SEAL	
NO.	BY

REVISIONS	
NO.	DATE
REMARKS	
NO.	DATE
DESIGNED BY	7/28/11
DRAWN BY	AT
CHECKED BY	7/28/11

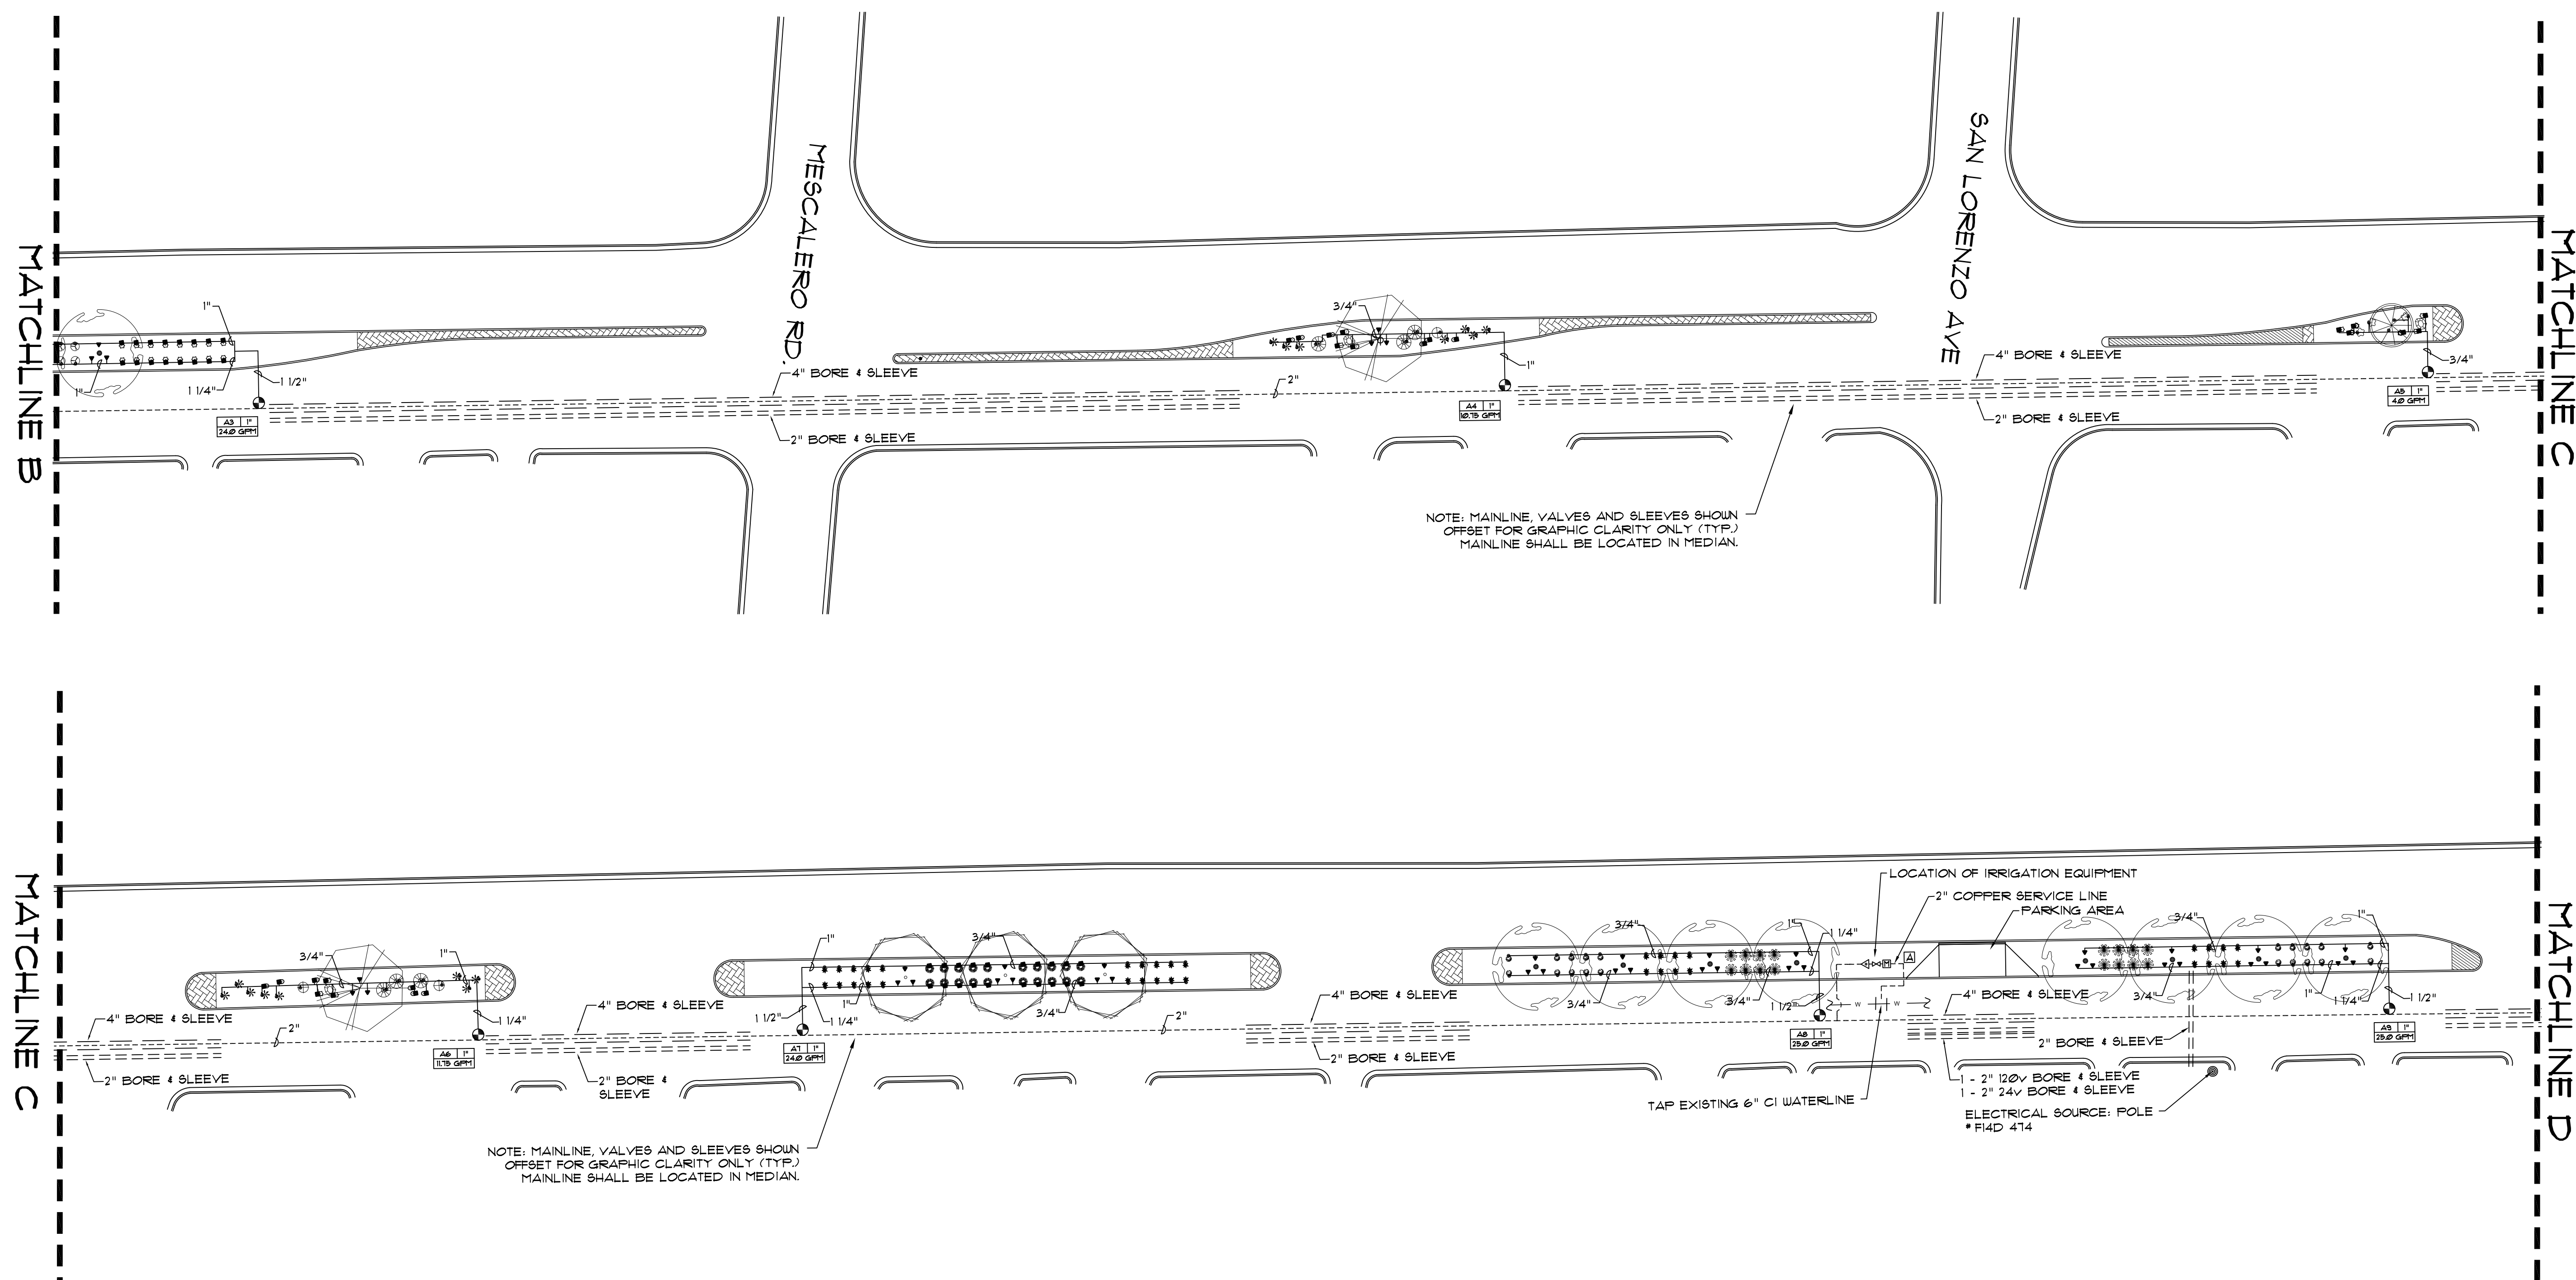


NOTE: MAINLINE, VALVES AND SLEEVES SHOWN
OFFSET FOR GRAPHIC CLARITY ONLY (TYP.).
MAINLINE SHALL BE LOCATED IN MEDIAN

NOTE: MAINLINE, VALVES AND SLEEVES SHOWN
OFFSET FOR GRAPHIC CLARITY ONLY (TYP.)
MAINLINE SHALL BE LOCATED IN MEDIAN

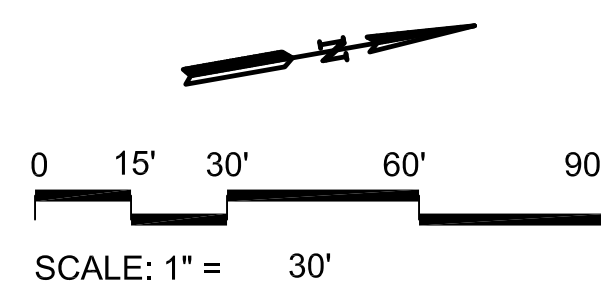[illegible]

AS-BUILT
11/28/2011

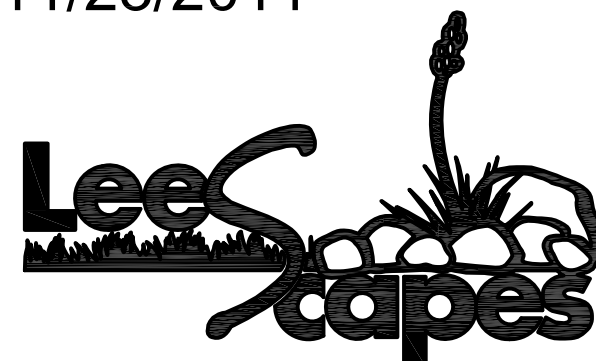

**MORROW
REARDON
WILKISON, LTD.,
LANDSCAPE ARCHITECTS**

210 La Veta NE, Albuquerque, NM 87108
505.268.2266 FAX 505.265.9637
mrw@mrwnm.com



CITY OF ALBUQUERQUE
CAPITAL IMPLEMENTATION PROGRAM
DEPARTMENT OF MUNICIPAL DEVELOPMENT

PROTOTYPE MEDIAN AND INTERSTATE LANDSCAPES FY-11B
2ND ST: CANDELARIA RD TO MONTANO RD.
IRRIGATION PLAN: WORK ORDER #1

Design Review Committee	City Engineer Approval
-------------------------	------------------------

ast Design | Update

Mo./Day/Yr.	Mo./Day/Yr.
-------------	-------------

City Project No.	Zone Map No.	Sheet
777702	F-15. G-14	2 OF 4


SURVEY INFORMATION		BENCH MARKS	AS-BUILT INFORMATION
FIELD NOTES			
NO.	BY	DATE	
			CONTRACTOR LEE LANDSCAPES, INC.
			WORK STARTED BY
			DATE
			FIELD ACCEPTANCE BY
			DATE
			FIELD CORRECTION BY
			DATE
			DRAWINGS BY
			DATE 11/28/11
			CORRECTED BY
			DATE
			RECORDED BY
			DATE
			NO.

[illegible]

QUE
 PROGRAM
 DEVELOPMENT
 LANDSCAPES FY-11B
 MONTANO RD.
 ORDER #1

Mo./Day/Yr.	Mo./Day/Yr.

Sheet
 4 2 OF 4

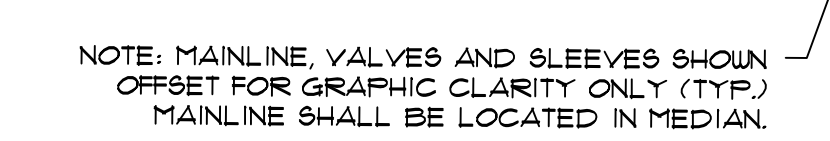

NOTE: MAINLINE, VALVES AND SLEEVES SHOWN
OFFSET FOR GRAPHIC CLARITY ONLY (TYP.)
MAINLINE SHALL BE LOCATED IN MEDIAN.



11/28/2011



Design Review Committee	City Engineer Approval	Last Design Update	Mo./Day/Yr.	Mo./Day/Yr.

[illegible]