


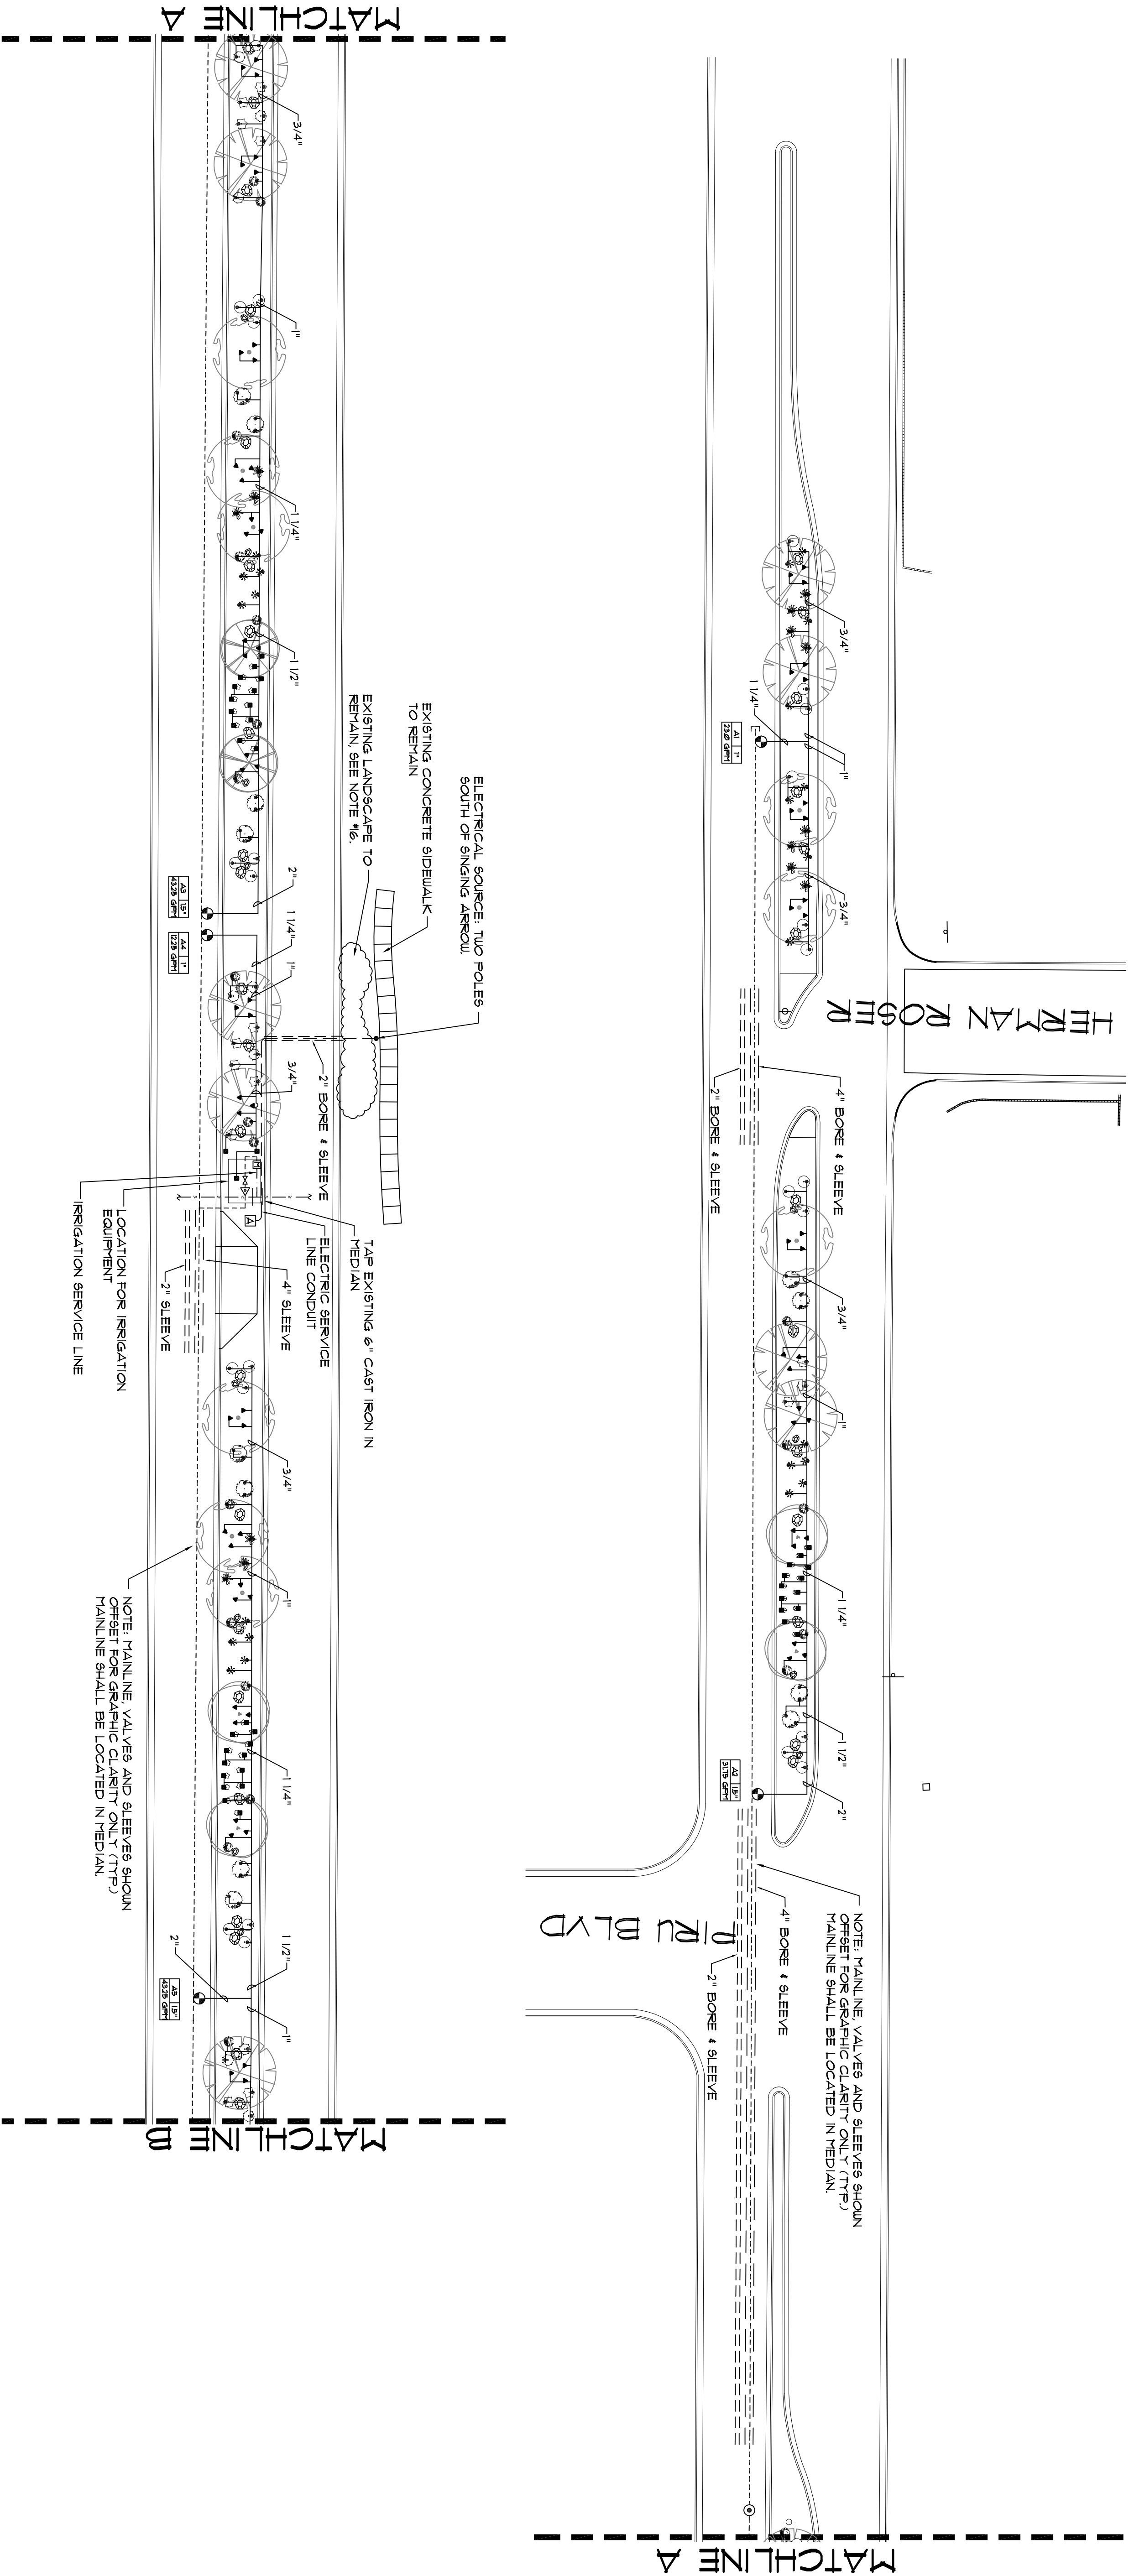

IRRIGATION LEGEND for POC #1	
	WATER METER 2" INSTALLED PER COA DUG, 3363 OR 3363.
	IRRIGATION MAIN CONSTANT PRESSURE LINE 2" SCH 40 BELL END, 3363 OR 3363. SHALL BE FINISHED 36" UNDER ROADWAY AND FINISH 36" IN MEDIAN.
	IRRIGATION MAIN LINE 2" SCH 40 BELL END, SOLVENT WELD PVC. DEPTH OF BURY SHALL BE 28".
	LATERAL PIPING SCH 40 BELL END, SOLVENT WELD PVC. DEPTH OF BURY 18" SIZE PER PLAN.
	MAINLINE AND LATERAL SLEEVE PIPING 2 SIZES LARGER THAN PIPE SIZE. 24-VOLT IRRIGATION WIRE SLEEVE PIPING 2" CLASS 200 SDR-21 BELL-END BORED SAUCUTS WILL NOT BE ALLOWED.
	ISOLATION VALVE ASSEMBLY 2" INSTALL PER COA, DRAWING NO. 2101.
	FEBCO 860-U-2 REDUCED PRESSURE PRINCIPAL BACKFLOW PREVENTER AND MASTER VALVE ASSEMBLY WITH BALL VALVES INSTALLED IN HEATED BOX PER DETAIL C/4. SIZE OF RP MASTER VALVE AND MASTER FETER SHALL BE SAME AS LINE SIZE. ENCLOSURE SHALL BE SIZED TO ACCOMMODATE SIZE OF RP AND MASTER VALVE ASSEMBLY.
	REMOTE CONTROL VALVE ASSEMBLY RAINBOW FIB PLASTIC BODY 24-VOLT AUTOMATIC VALVE SIZE PER PLAN INSTALL PER COA, DRAWING NO. 2103. (SIMILAR - SEE IRRIGATION NOTES #5 AND #6, SHEET 2.)
	SOLVENT WELD CAP SCH 40 PVC, LINE SIZE.
	1" AIR RELEASE VALVE, INSTALL PER COA, DRAWING NO. 2105.




PRESSURE COMPENSATING BUBBLER ASSEMBLIES, RAIN BIRD 1400 SERIES, AS FOLLOWS. INSTALL PER COA, DRAWING NUMBERS 2100, 2111, 2111-A AND 2112.	
MODEL NO.	FSI
1400	50
1402	30
1404	10
1404	30

IRRIENET M AC 12 STATION CONTROLLER	
	IRRIENET M AC 12 STATION CONTROLLER


IRRIGATION NOTES	
1.	INSTALL 4 ADDITIONAL IRRIGATION CONTROL WIRES AND 1 IRRIGATION CONTROL WIRE IN VALVE BOX NEXT TO IRRIGATION MAINLINE STUBOUT. LENGTH OF WIRE SHALL BE AS REQUIRED TO EXTEND TO FUTURE VALVES. APPROXIMATE LOCATION OF FUTURE VALVES NORTH OF MEDIAN DRAINAGE BREAK ARE AS FOLLOWS:
VALVE 1 --	140 LF FROM MEDIAN DRAINAGE BREAK
VALVE 2 --	300 LF
VALVE 3 --	600 LF
VALVE 4 --	120 LF

AS-BUILT
3/19/2012

--	--	--	--	--	--	--	--	--	--

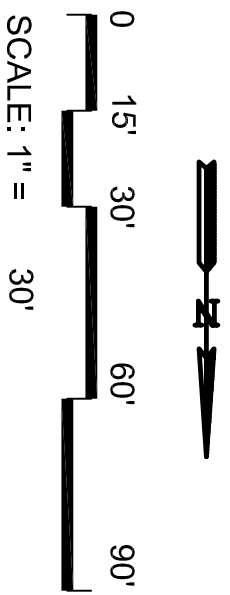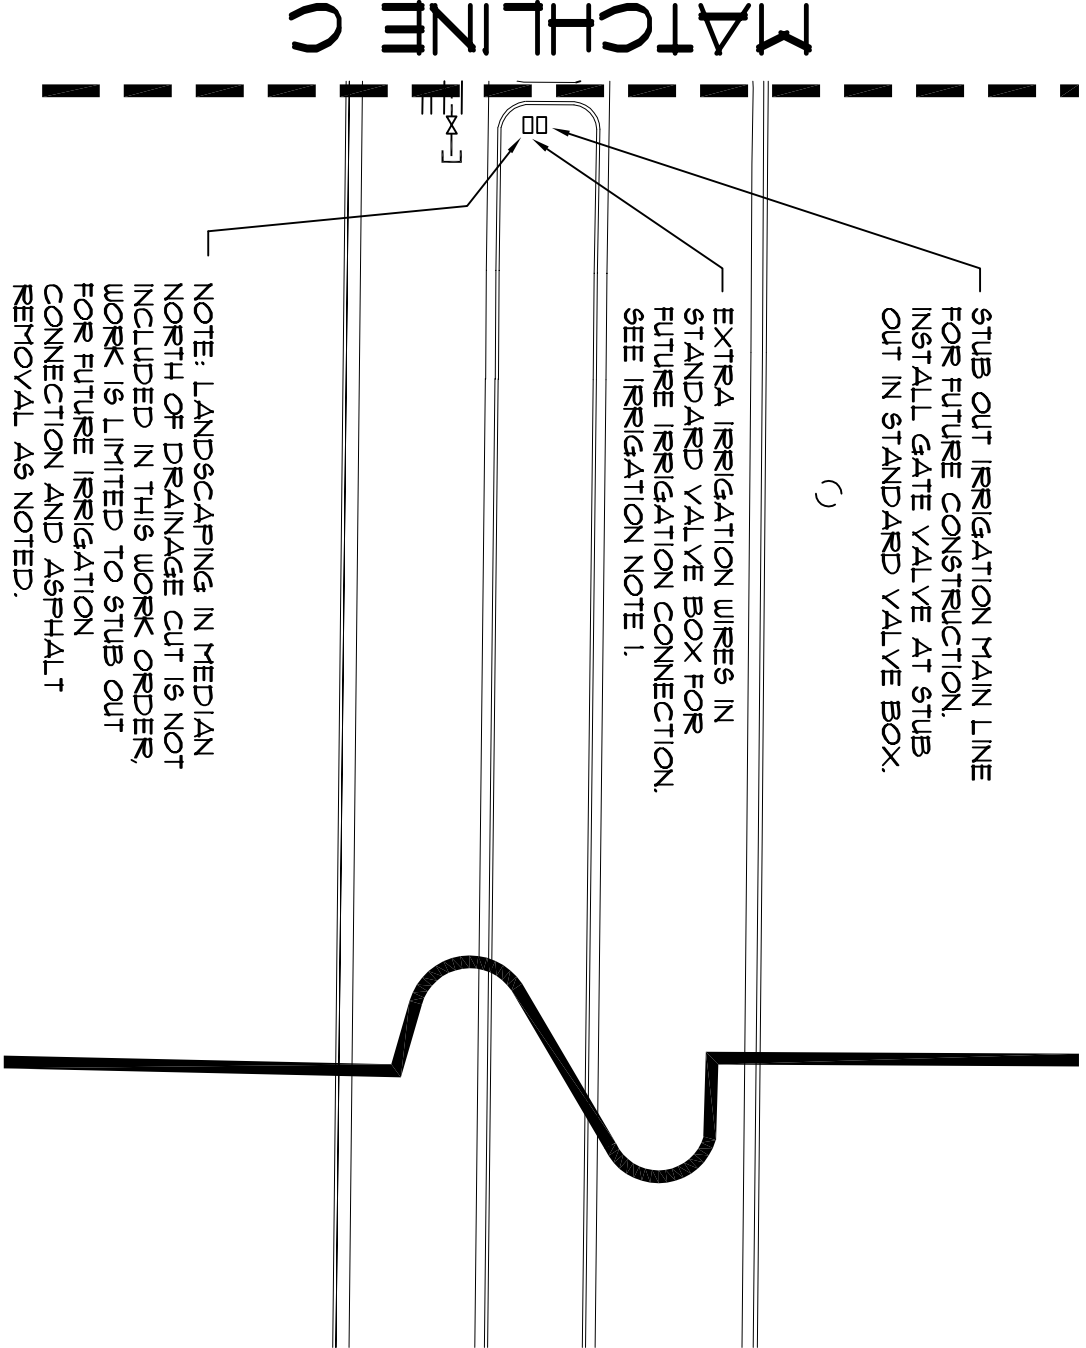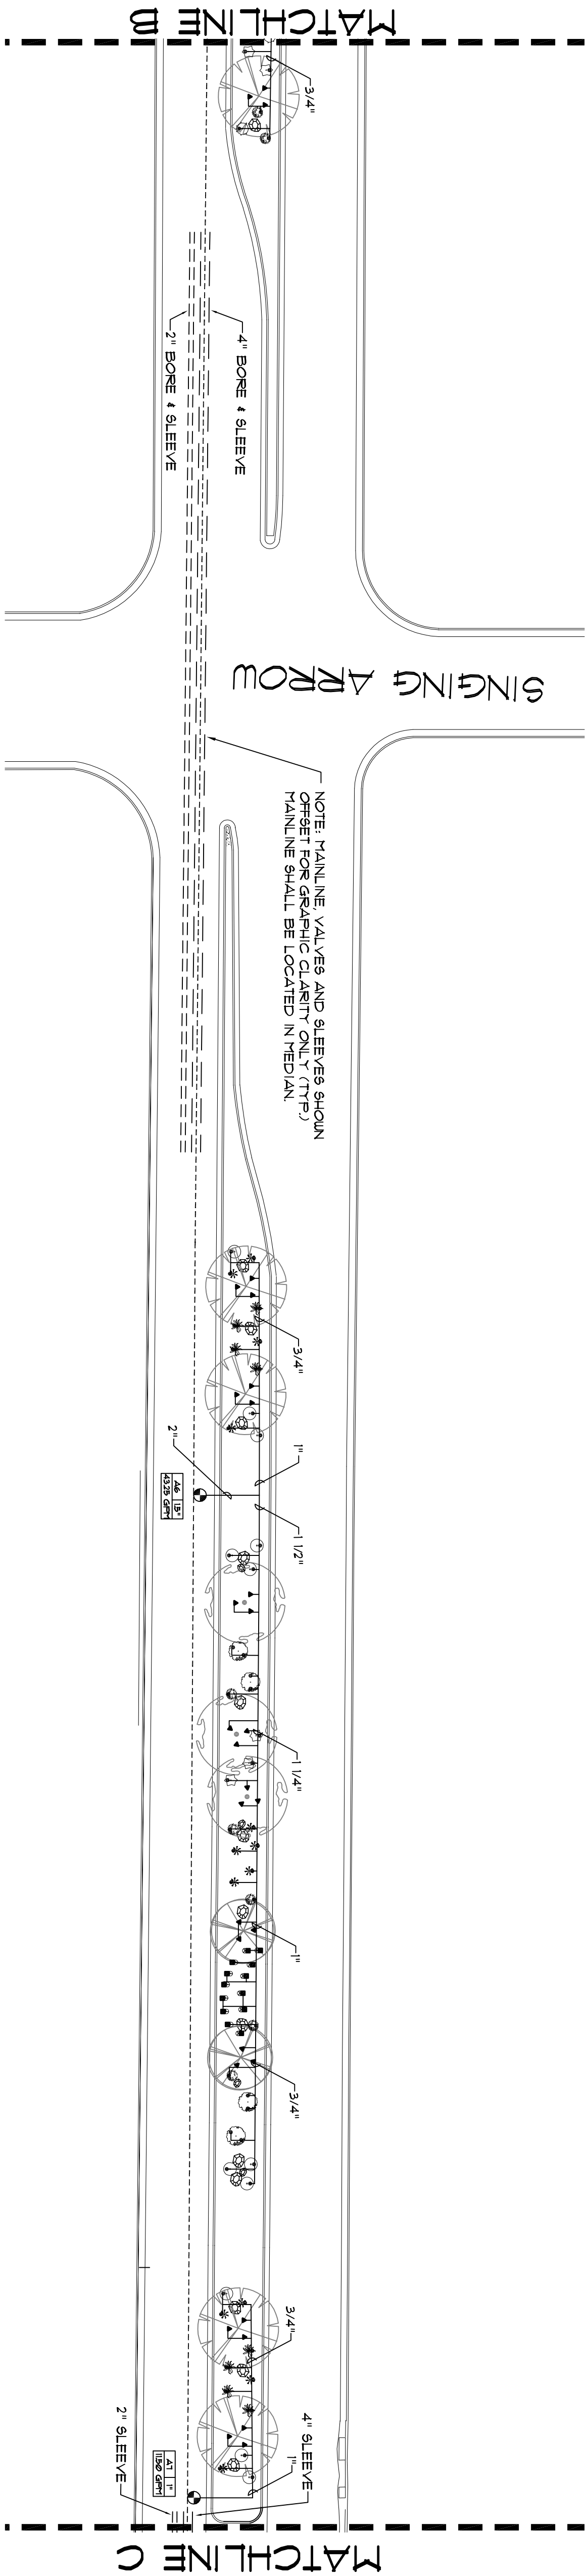

AS-BUILT
3/19/2012

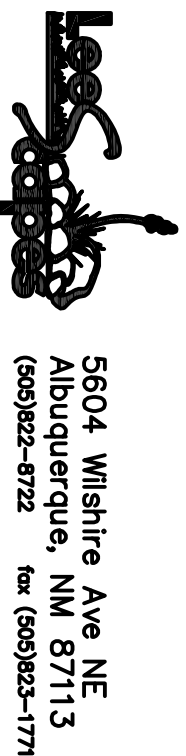

CITY OF ALBUQUERQUE
CAPITAL IMPLEMENTATION PROGRAM
DEPARTMENT OF MUNICIPAL DEVELOPMENT

PROTOTYPE MEDIAN AND INTERSTATE LANDSCAPES FY-11B
JUAN TABO: BETWEEN HERMAN BOSCH TO SOUTHERN BLVD.
IRRIGATION PLAN: WORK ORDER #4

Design Review Committee

City Engineer Approval

Last Design Update

Mo./Day/Yr.

Mo./Day/Yr.

City Project No.

777704

Zone Map No.

L-21

Sheet

2 OF 2

AS-BUILT INFORMATION	
CONTRACTOR	LEE LANDSCAPES, INC.
WORK STAKED BY	DATE
INSPECTOR'S ACCEPTANCE BY	DATE
FIELD VERIFICATION BY	DATE
DRAWINGS CORRECTED BY	ML DATE 3/19/2012
MICRO-FILM INFORMATION	
RECORDED BY	DATE
NO.	

BENCH MARKS

SURVEY INFORMATION

FIELD NOTES

NO.	BY	DATE

ARCHITECTURAL SEAL

REVISIONS			
NO.	DATE	REMARKS	BY
DESIGNED BY	ML	DATE 12/19/11	
DRAWN BY	ML	DATE 12/19/11	
CHECKED BY	LS	DATE 12/19/11	