



PLACE 1" POLYETHYLENE FOAM FILLERS AS SHOWN. PLASTIZONE OR APPROVED EQUAL DO NOT ANCHOR WITH NAILS OR BONDING AGENT. KEEP IN PLACE WITH FRESH CONCRETE WHEN POURING UPSTREAM SECTION. DO NOT ALLOW FRESH CONCRETE BETWEEN FILLER AND PREVIOUS CONCRETE.

CONCRETE RUNDOWN DETAILS
NTS

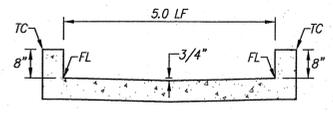

CONCRETE CHANNEL DETAIL
SCALE: 1"=2'

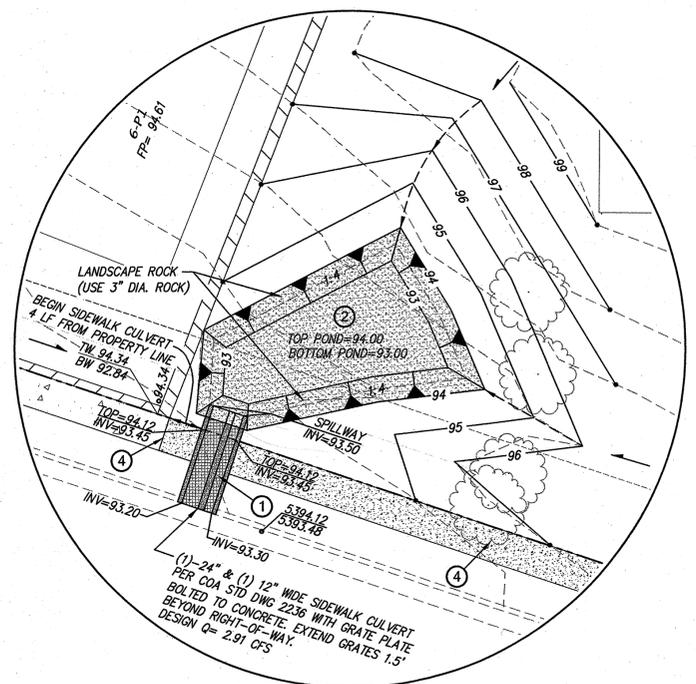


POND DETAIL
SCALE: 1"=10'

STATEMENT CERTIFICATION:

I, Jeffrey T. Wooten, PE, of Wooten Engineering, do hereby certify to the best of my knowledge and belief, that the infrastructure designed by: **WOOTEN ENGINEERING** (Engineer of Record), with observation services performed by: **SPINELLO-DCS, LLC** (Part-time), was constructed in accordance with the plans and specifications approved by the City Engineer and that the original design intent of the approved plans has been met, except as noted on the Record Drawings. All warranties, guarantees and quality of work are the responsibility of the Contractor of record and their subcontractors. This Certification is based on the inspections conducted and the As-Built Survey performed by: _____ on _____

Signature: *JTW* Date: **8/13/2019**
 CERTIFYING ENGINEER DATE
 WOOTEN ENGINEERING
 (SUB-CONSULTANT TO SPINELLO-DCS, LLC)
 JEFFREY T. WOOTEN, PE
 NM PE 16892

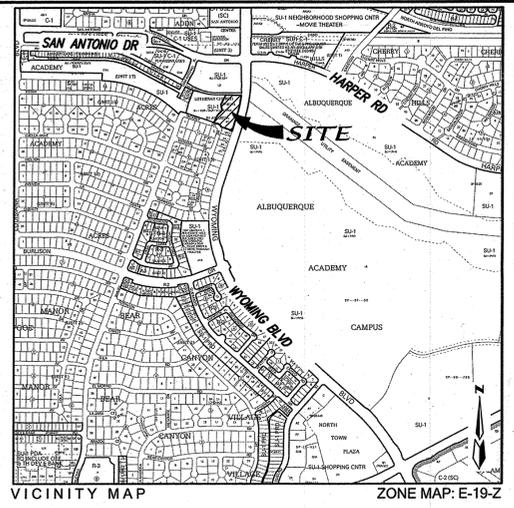

LEGAL DESCRIPTION

A TRACT OF LAND SITUATE WITHIN THE ELENA GALLEGOS GRANT, PROJECTED SECTION 30, TOWNSHIP 11 NORTH, RANGE 4 EAST, NEW MEXICO PRINCIPAL MERIDIAN, CITY OF ALBUQUERQUE, BERNALILLO COUNTY, NEW MEXICO, BEING ALL OF TRACT A-1-B, LANDS OF LUTHERAN CHURCH IN AMERICA, AS THE SAME IS SHOWN AND DESIGNATED ON SAID PLAT FILED FOR RECORD IN THE OFFICE OF THE COUNTY CLERK OF BERNALILLO COUNTY, NEW MEXICO ON 5/5/16, IN PLAT BOOK 2016C, PAGE 50, AND CONTAINING 1.9565 ACRES MORE OR LESS.

WORK ORDER CONSTRUCTION NOTES

- CONSTRUCT SIDEWALK CULVERTS PER C.O.A. STD DWG #2236. TACK WELD BOLTS TO PLATE.
- CONSTRUCT WATER HARVEST DETENTION POND PER DRAWING. POND SPILLWAY ELEVATION TRANSITIONS INTO SIDEWALK CULVERTS AT 5393.50' AS INDICATED ON THIS PLAN. POND TO BE ARMORED WITH 3" DIAMETER ROCK.
- CONSTRUCT NEW 5' WIDE RUNDOWN SPILLWAY INTO ARROYO PER DESIGN.
- CONSTRUCT NEW 4' WIDE SIDEWALK PER C.O.A. STD DWG #2430. TIE NEW SIDEWALK TO EXISTING SIDEWALK ON THE EAST NEAR LOT 1A ON FRANTZ DRIVE AND TO THE WEST OF THE NEW SIDEWALK AT LOT 6-P1 IN THE FRUITA DEL SOL SUBDIVISION. CROSS SLOPE ON SIDEWALK SHALL BE 2% AS INDICATED ON STD DWG. EXISTING BC TO SIDEWALK IS APPROXIMATELY 4.38 FEET. BEGIN SIDEWALK AT ROW/P.L. PER RECORDED FINAL PLAT.
- ALL WORK DETAILED ON THESE PLANS TO BE PERFORMED, EXCEPT AS OTHERWISE STATED OR PROVIDED HEREON, SHALL BE CONSTRUCTED IN ACCORDANCE WITH CITY OF ALBUQUERQUE STANDARD SPECIFICATIONS FOR PUBLIC WORKS CONSTRUCTION, 1986 EDITION THROUGH UPDATE #9, AND WILL BE REFERRED TO HEREIN AS "STANDARD SPECIFICATIONS".
- CURB AND GUTTER AND SIDEWALKS SHALL MATCH THE ELEVATIONS OF ADJUTING EXISTING AREAS AS SHOWN ON THE PLANS OR AS DIRECTED BY THE PROJECT ENGINEER.
- AN EXCAVATION/CONSTRUCTION PERMIT WILL BE REQUIRED BEFORE BEGINNING ANY WORK WITHIN CITY RIGHT-OF-WAY.
- AT CONTRACTORS EXPENSE, CONTRACTOR SHALL ASSUME RESPONSIBILITY FOR ANY DAMAGE TO EXISTING PAVEMENT, PAVEMENT MARKINGS, SIGNAGE, CURB AND GUTTER, HANDICAP RAMPS, AND SIDEWALK DURING CONSTRUCTION APART FROM THOSE SECTIONS INDICATED FOR REMOVAL ON THE PLANS AND SHALL REPAIR OR REPLACE PER STANDARD SPECIFICATIONS.
- TWO (2) WORKING DAYS PRIOR TO ANY EXCAVATION, CONTRACTOR MUST CONTACT NEW MEXICO ONE CALL SYSTEM (246-1990) FOR LOCATION OF EXISTING UTILITIES.

APPROVED RECORD DRAWINGS	
City Inspector	Henry Blair
Contractor	Solis Brothers Construction
Construction Engineer	Muhammed Adeb
Date	9/3/2019

MINI WORK ORDER
 DRB CASE 1006844
 DRAINAGE FILE: E19D021A

MARK GOODWIN & ASSOCIATES, P.A. CONSULTING ENGINEERS P.O. BOX 90606 ALBUQUERQUE, NEW MEXICO 87199 (505) 828-2200, FAX (505) 797-9539	
CITY OF ALBUQUERQUE PUBLIC WORKS DEPARTMENT	
TITLE: TRACT A-1-B HOLY CROSS LUTHERAN CHURCH DRAINAGE IMPROVEMENTS MINI WORK ORDER	
APPROVALS DRC CHAIRMAN: <i>[Signature]</i> HYDROLOGY: <i>[Signature]</i>	ENGINEER: <i>[Signature]</i> DATE: 8/13/19 APPROVED FOR CONSTRUCTION CITY ENGINEER: <i>[Signature]</i> DATE: 10/26/16
DRB CASE NO: 1006844 DRAINAGE FILE: E19D021A	CITY PROJECT NO. 785372 ZONE MAP NO. E-19 SHEET 1 OF 1

AS BUILT INFORMATION	
CONTRACTOR	NO.
WORKED BY	DATE
INSPECTED BY	DATE
ACCEPTANCE BY	DATE
VERIFICATION BY	DATE
DRAWINGS	DATE
CORRECTED BY	DATE
MICRO-FILM INFORMATION	NO.
RECORDED BY	DATE

BENCH MARKS	
AGCS MONUMENT stamped "25-E18"	NO.
Geographic Position, in feet (NAD83)	DATE
N.M. State Plane Coordinates (Central Zone)	DATE
Elevation, in feet (NAD83)-5339.186	DATE

SURVEY INFORMATION	
FIELD NOTES	NO.
BY	DATE

ENGINEERS STAMP & SIGNATURE	
	5-13-16