


2 3 4 5 6 7 8 9 10 11 12 13 14 15
26-7836-81-091CONSTRUCTION PLANS FOR
PASEO CROSSING
SHOPPING CENTERALBUQUERQUE
BERNALILLO COUNTY, NEW MEXICO
JANUARY 2007*FW*

INDEX TO DRAWINGS

1. TITLE SHEET
2. PLAT
3. MASTER PAVING PLAN
4. PALOMAS PAVING IMPROVEMENTS
5. ACCESS ROAD PAVING IMPROVEMENTS
6. PALOMAS STRIPING
7. ACCESS ROAD STRIPING
8. PAVING DETAILS
9. DRAINAGE IMPROVEMENTS
10. EXISTING UTILITY IMPROVEMENTS
11. DETAIL SHEET



CERTIFICATE OF SUBSTANTIAL COMPLIANCE ON PLANS

I, Ronald R. Bohannan, of the firm of Tierra West LLC, a Registered Professional Engineer in the State of New Mexico, do hereby certify, to the best of my knowledge and belief, that the infrastructure installed as part of this project has been inspected by me or by a qualified person under my direct supervision and has been constructed in accordance with the plans and specifications approved by the City Engineer and that the original design intent of the approved plans has been met, except as noted by me on the as-built construction drawings. This Certification is based on site inspections by me or personnel under my direction with survey information provided by David Vigil of Geo-Surv Co. NMPLS# 8911.

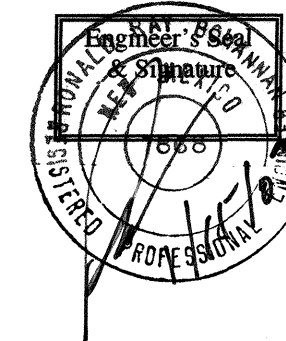

RECORD DRAWING

DRB # 1002112

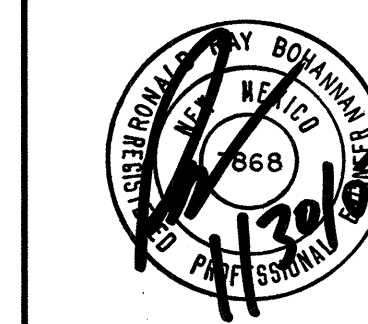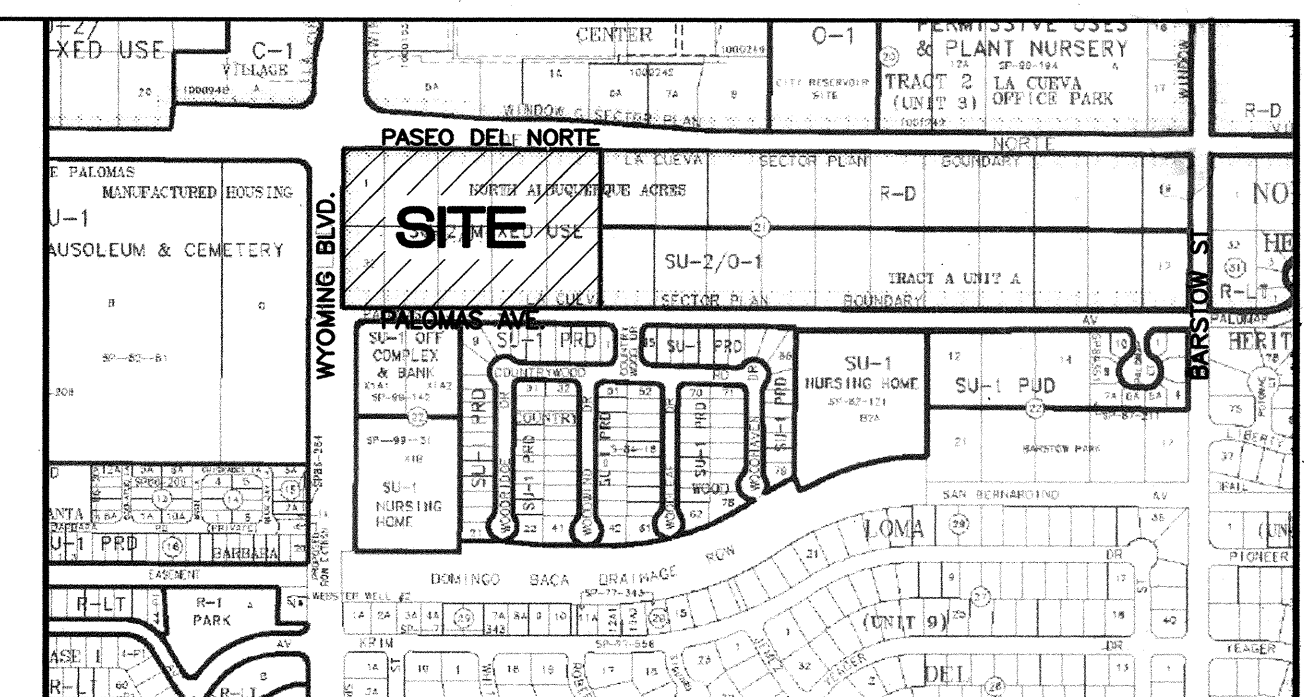TIERRA WEST, LLC
8509 JEFFERSON NE
ALBUQUERQUE, NEW MEXICO 87113
(505)858-3100APPROVED AS RECORD DRAWINGS
DESIGN REVIEW SECTION
CITY ENGINEER
Anthony
DATE: 03/09/09RONALD R. BOHANNAN
P.E. #7868

VICINITY MAP

D-19

SCALE NONE

NOTICE TO CONTRACTORS


1. ALL WORK DETAILED ON THESE PLANS TO BE PERFORMED UNDER CONTRACT SHALL, EXCEPT AS OTHERWISE STATED OR PROVIDED FOR HEREON, BE CONSTRUCTED IN ACCORDANCE WITH THE CITY OF ALBUQUERQUE STANDARD SPECIFICATIONS FOR PUBLIC WORKS CONSTRUCTION, 1988 EDITION AS REVISED THROUGH UPDATE #7 INCLUDING AMENDMENT 1.
2. TWO WORKING DAYS PRIOR TO BEGINNING CONSTRUCTION, THE CONTRACTOR MUST CONTACT NEW MEXICO ONE CALL SYSTEM (280-1990) FOR LOCATION OF EXISTING UTILITIES.
3. FIVE (5) WORKING DAYS PRIOR TO BEGINNING CONSTRUCTION, THE CONTRACTOR SHALL SUBMIT TO CONSTRUCTION COORDINATION DIVISION A DETAILED CONSTRUCTION SCHEDULE. TWO (2) WORKING DAYS PRIOR TO THE START OF CONSTRUCTION, THE CONTRACTOR SHALL OBTAIN A BARRICADING PERMIT FROM THE CONSTRUCTION COORDINATION DIVISION. CONTRACTOR SHALL NOTIFY THE CONSTRUCTION COORDINATION ENGINEER (924-3400) PRIOR TO OCCUPYING AN INTERSECTION. REFER TO SECTION 19 OF THE GENERAL CONDITIONS OF THE STANDARD SPECIFICATIONS.
4. CONTRACTOR SHALL NOTIFY THE ENGINEER NOT LESS THAN SEVEN (7) DAYS PRIOR TO STARTING WORK IN ORDER THAT THE CITY SURVEYOR MAY TAKE NECESSARY MEASURES TO INSURE THE PRESERVATION OF SURVEY MONUMENTS. CONTRACTOR SHALL NOT DISTURB PERMANENT SURVEY MONUMENTS WITHOUT THE CONSENT OF THE CITY SURVEYOR AND SHALL NOTIFY THE CITY SURVEYOR AND BEAR THE EXPENSE OF REPLACE ANY THAT MAY BE DISTURBED WITHOUT PERMISSION. REPLACEMENT SHALL BE DONE ONLY BY THE CITY SURVEYOR. WHEN A CHANGE IS MADE IN THE FINISHED ELEVATIONS OF THE PAVEMENT OF ANY ROADWAY IN WHICH A PERMANENT SURVEY MONUMENT IS LOCATED, CONTRACTOR SHALL, AT HIS OWN EXPENSE, ADJUST THE MONUMENT COVER TO THE NEW GRADE UNLESS OTHERWISE SPECIFIED. REFER TO SECTION 4.4 OF THE GENERAL CONDITIONS OF THE STANDARD SPECIFICATIONS UPDATE NO. 7.
5. ALL UTILITY WORK SHALL BE CONSTRUCTED IN ACCORDANCE WITH CITY OF ALBUQUERQUE UTILITIES, INC. SPECIFICATIONS FOR WATER AND WASTEWATER FACILITIES (MOST RECENT REVISIONS). THE CONTRACTOR SHALL NOTIFY CITY OF ALBUQUERQUE THREE (3) WORKING DAYS PRIOR TO BEGINNING THE CONSTRUCTION OF THE UTILITIES.
6. FOR STORM DRAIN CONSTRUCTION, RCP PIPE JOINTS SHALL NOT BE GROUTED PRIOR TO FINAL INSPECTION. FINAL INSPECTION WILL DETERMINE JOINTS TO BE GROUTED FOR FINAL ACCEPTANCE OF THE CONSTRUCTION.
7. THE CONTRACTOR SHALL COORDINATE WITH WATER SYSTEMS DIVISION (857-8200) SEVEN (7) WORKING DAYS PRIOR TO ANY WORK IN WHICH MAY AFFECT THE EXISTING CITY PUBLIC WATER OR SEWER UTILITIES. CONTRACTOR SHALL BE RESPONSIBLE FOR TUNING AND COORDINATION OF WATER SHUTOFF. EXISTING CITY VALVES TO BE OPERATOR BY CITY PERSONNEL ONLY. REFER TO SECTION 18 OF THE STANDARD SPECIFICATIONS.
8. ALL EXCAVATION, TRENCHING, AND SHORING ACTIVITIES MUST BE CARRIED-OUT IN ACCORDANCE WITH OSHA 29 CFR 1926.650 SUBPART P.
9. ELECTRONIC MARKER DISKS (EMD) WILL BE PLACED ACCORDING TO SECTION 170 OF THE CITY OF ALBUQUERQUE STANDARD SPECIFICATIONS FOR PUBLIC WORKS CONSTRUCTION, 1988 EDITION AS REVISED THROUGH UPDATE #7 INCLUDING AMENDMENT #1.
10. THE CONTRACTOR WILL BE RESPONSIBLE FOR DISPOSING OF ALL DEBRIS, INCLUDING, NOT LIMITED TO HAZARDOUS WASTE AT DISPOSAL SITES APPROVED BY GOVERNMENTAL AGENCIES REGULATING THE DISPOSAL OF SUCH MATERIALS.
11. TACK COAT FOR SURFACE COURSE REQUIREMENTS WILL BE DETERMINED BY THE ENGINEER.
12. PERMANENT PAVEMENT STRIPING AND MARKINGS WILL BE PLACED BY THE CONTRACTOR. THE ROAD SHALL NOT BE OPENED TO THE TRAFFIC UNTIL IT IS STRIPED. ALL STRIPING, PAVEMENT MARKINGS INCLUDING CROSSWALKS, ARROWS AND LINE MARKINGS ARE TO BE CONSTRUCTED OF HOT PLASTIC OR COLD PLASTIC IN ACCORDANCE WITH THE MANUAL OF UNIFORM TRAFFIC CONTROL DEVICES.
13. CONTRACTOR SHALL MAINTAIN A GRAFFITI-FREE WORK SITE. CONTRACTOR SHALL PROMPTLY REMOVE ANY AND ALL GRAFFITI FROM EQUIPMENT, WHETHER PERMANENT OR TEMPORARY.
14. ALL WATER VALVE BOXES MANHOLES IN THE STREET CONSTRUCTION RE TO BE ADJUSTED TO FINISH GRADE AND WILL BE MEASURED AND PAID PER EACH
15. CONTRACTOR WILL BE RESPONSIBLE FOR PROVIDING AND MAINTAINING ALL CONSTRUCTION SIGNING UNTIL PROJECT HAS BEEN ACCEPTED BY THE CITY.

THE FOLLOWING NOTES ALSO APPLY WHEN CHECKED

- ☒ ALL UTILITIES AND UTILITY SERVICE LINES SHALL BE INSTALLED PRIOR TO PAVING.
- ☒ BACKFILL COMPACTION SHALL BE ACCORDING TO SPECIFIED STREET USE.
- ☒ TACK COAT REQUIREMENTS SHALL BE DETERMINED BY THE PROJECT ENGINEER.
- ☒ SIDEWALKS AND WHEELCHAIR RAMPS WITHIN THE CURB RETURNS SHALL BE CONSTRUCTED WHEREVER A NEW CURB RETURN IS CONSTRUCTED.
- ☒ IF CURB IS DEPRESSED FOR A DRIVEPAD, THE DRIVEPAD SHALL BE CONSTRUCTED PRIOR TO ACCEPTANCE OF CURB AND GUTTER.
- ☒ ALL STORM DRAINAGE FACILITIES SHALL BE COMPLETED PRIOR TO FINAL ACCEPTANCE.

REV	SHEETS	CITY ENGINEER	DATE	USER DEPT.	DATE	USER DEPT.	DATE
ENGINEERS STAMP & SIGNATURE		APPROVALS	ENGINEER	DATE	APPROVED FOR CONSTRUCTION		
		DRC Chairman	<i>M. L.</i>	3-9-07	<i>Ronald R. Bohannan</i> City Engineer Date: 3-2-07		
		Transportation	<i>M. L.</i>	1/30/07			
		Water/Wastewater	<i>William D. Bohannan</i>	1/30/07			
		Hydrology	<i>Quinn</i>	2-9-07			
		AMAFCA					
		Constr. Mngmt.					
		Constr. Coord.					
		CITY PROJECT NO.	785681		SHEET 1 OF 11		

James Logg of Middlebury, Vt.

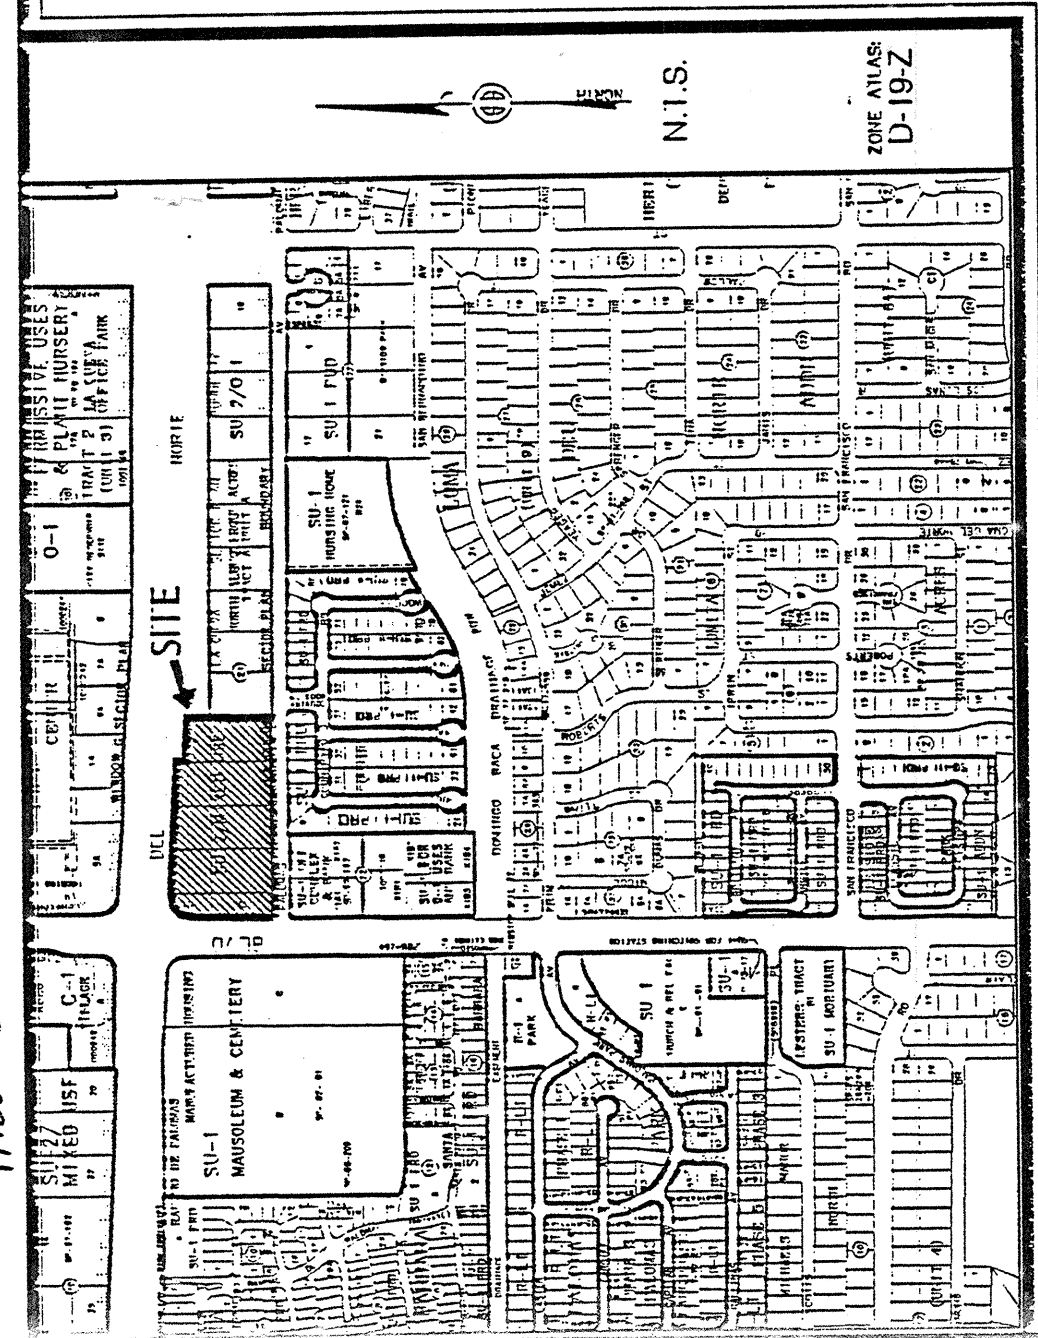

PLAT OF
LOT 28-A, BLOCK 21
TRACT A, UNIT A, NORTH ALBUQUERQUE ACRES
SITUATE WITHIN PROJECTED SECTION 19,
T. 11 N., R. 4 E., N.M.P.M.
ELENA GALLEGOS LAND GRANT
CITY OF ALBUQUERQUE
BERNALILLO COUNTY, NEW MEXICO
JANUARY 2006

DISCLOSURE STATEMENT
THE PURPOSE OF THIS PLAT IS TO CREATE ONE (1) LOT OF LAND FROM TEN (10) EXISTING LOTS AND TO SHOW DEDICATED RIGHT-OF-WAY.

FREE CONSENT

TITLE UNDERSTANDING OWNERS(S) AND PROPRIETOR(S) OF THE PROPERTY DESCRIBED HEREON DO HEREBY
 CONSENT TO THE PLATING OF SAID PROPERTY AS SHOWN HEREON AND THE SAME IS WITH THE FREE
 CONSENT AND IN ACCORDANCE WITH THEIR DESIRES AND SAID OWNERS' WARRANT THAT THEY HOLD
 COMPLETE AND INDEFEASIBLE TITLE IN FEE SIMPLE TO THE LAND SUBDIVIDED AND DO HEREBY DEDICATE
 ADDITIONAL STREET RIGHT-OF-WAY TO THE CITY OF ALBUQUERQUE IN FEE SIMPLE.

Vicinity Map

SUBMISSION DATA / NOTES

1. PLAT WAS COMPILED USING EXISTING RECORD DATA & ACTUAL FIELD SURVEY.
2. BEARINGS ARE NEW MEXICO STATE PLANE GRID BEARINGS, CENTRAL ZONE, NAD 1987, AND ARE BASED ON ACS CONTROL MONUMENT STATIONS HEAVEN AND ACS 7-019, AS SHOWN HEREIN.
3. DISTANCES ARE GROUND DISTANCES.
4. PLAT SHOWS ALL EASEMENTS OF RECORD.
5. GROSS ACREAGE: **4.4912** ACRES
6. NUMBER OF EXISTING LOTS: 10
7. NUMBER OF LOTS CREATED: 1
8. THIS PROPERTY IS ZONED SU-2/MIXED USE.

OWNERS) SIGNATURE: [Signature]
OWNERS) PRINT NAME: ERSON, DANIEL S.
ADDRESS: 5321 MENARD AVE. SEED TRNG:
Solid Gold Classic LLC 1-19-06
WINNING WINNER
number number

[illegible]


DRAWN BY : RS
ZONE ALIAS: D-19-Z
WYOPASEO CR5

6. NUMBER OF EXISTING LOTS: 10
7. NUMBER OF LOTS CREATED: 1
8. PLOTTERY IS ZONED SU-2 MIXED USE:

LINE TABLE			CURVE TABLE		
LINE	LENGTH	BEARING	CURVE	RADIUS	DELTA
L1	8.94'	S00°19'30"W	C1	39.76'	91°07'24"
L2	8.51'	N86°44'23"W	C2	120.20'	91°49'22"
L3	54.09'	N89°40'29"W			
L4	24.03'	S86°44'23"E			


CURVE TABLE		350' ± 2.00'		274.00'	
CURVE	LENGTH	RADIUS	DELTA	CHORD	CHORD BEARING
C1	39.76'	25.00'	91°07'24"	35.70'	N44°07'27"W
C2	120.20'	75.00'	91°49'22"	107.74'	N47°20'56"E

PASEO DEL NORTE N.E.
(200' + RIGHT-OF-WAY VARIES)

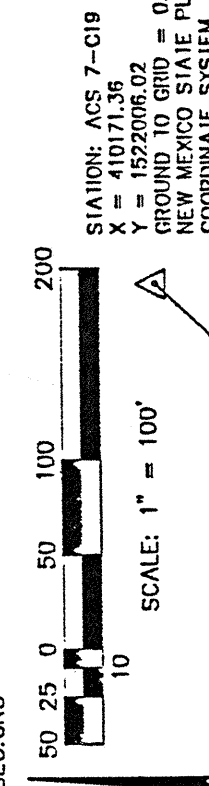

STATION: NGS HEAVEN
X = 407051.31
Y = 1518737.03
GROUND TO GRID = 0.99
DELTA ALPHA = -00'10"
NEW MEXICO STATE PLANT
COORDINATE SYSTEM
CENTRAL ZONE

PASEO DEL NORTE N.E.
(200' + RIGHT-OF-WAY VARIES)

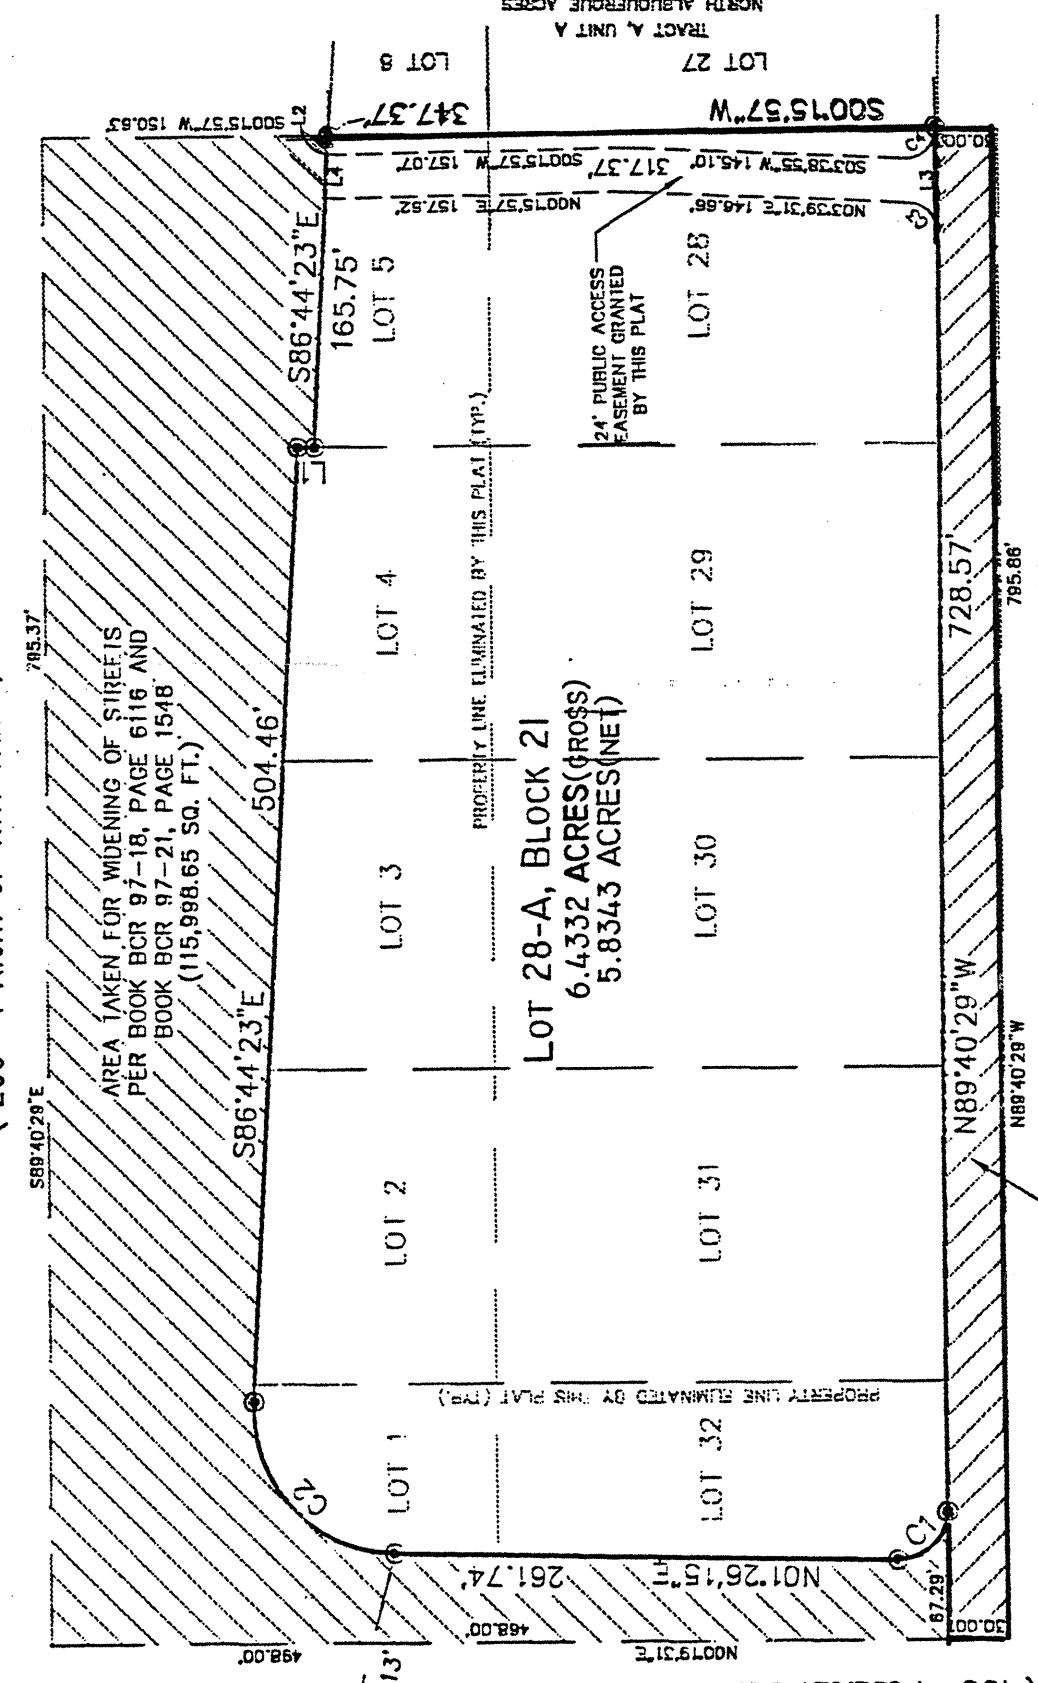

MONUMENT LEGEND

	- FOUND CONTROL STATION AS NOTED
	- FOUND MONUMENT AS NOTED
	- SET 1/2" REBAR W/RED PLASTIC CAP STAMPED "MWR 11224" UNLESS OTHERWISE NOTED

THIS IS TO CERTIFY THAT TAXES ARE CURRENT & PAID ON
UPC #: 7019032701951050 *see certificate for more info*
PROPERTY OWNER OF RECORD: *Solo and Cassie LLL*
BERNALILLO COUNTY TREASURERS OFFICE
5-11-20 6-1-26

SURVEYOR'S CERTIFICATION

I, Gary E. Glickson, a duly qualified Registered Professional Land Surveyor under the laws of the State of New Mexico, do hereby certify that this plat and description were prepared by me or under my supervision, shows all easements as shown on the plat of record or made known to me by the owners of the land surveyed, and that I am fully conversant with the facts pertaining to the surveying and subdivision of the land herein described. All boundaries are shown according to the best of my knowledge and belief.

Gary E. Grisko Jan 16, 2006
Date

NON INFORMATION

A circular professional seal for Gary E. Gritsko, a Registered Professional Land Surveyor in New Mexico. The seal features the text "GARY E. GRITSKO" at the top, "NEW MEXICO" on the left, "REGISTERED PROFESSIONAL LAND SURVEYOR" on the right, and the number "8888" in the center. Two small stars are positioned at the top and bottom of the seal.


SURVEYS SOUTHWEST, LTD.

333 LOMAS BLVD., N.E.
ALBUQUERQUE, NEW MEXICO
87102

T11NR4E SEC. 19

FOR REFERENCE ONLY


RECORD DRAWING

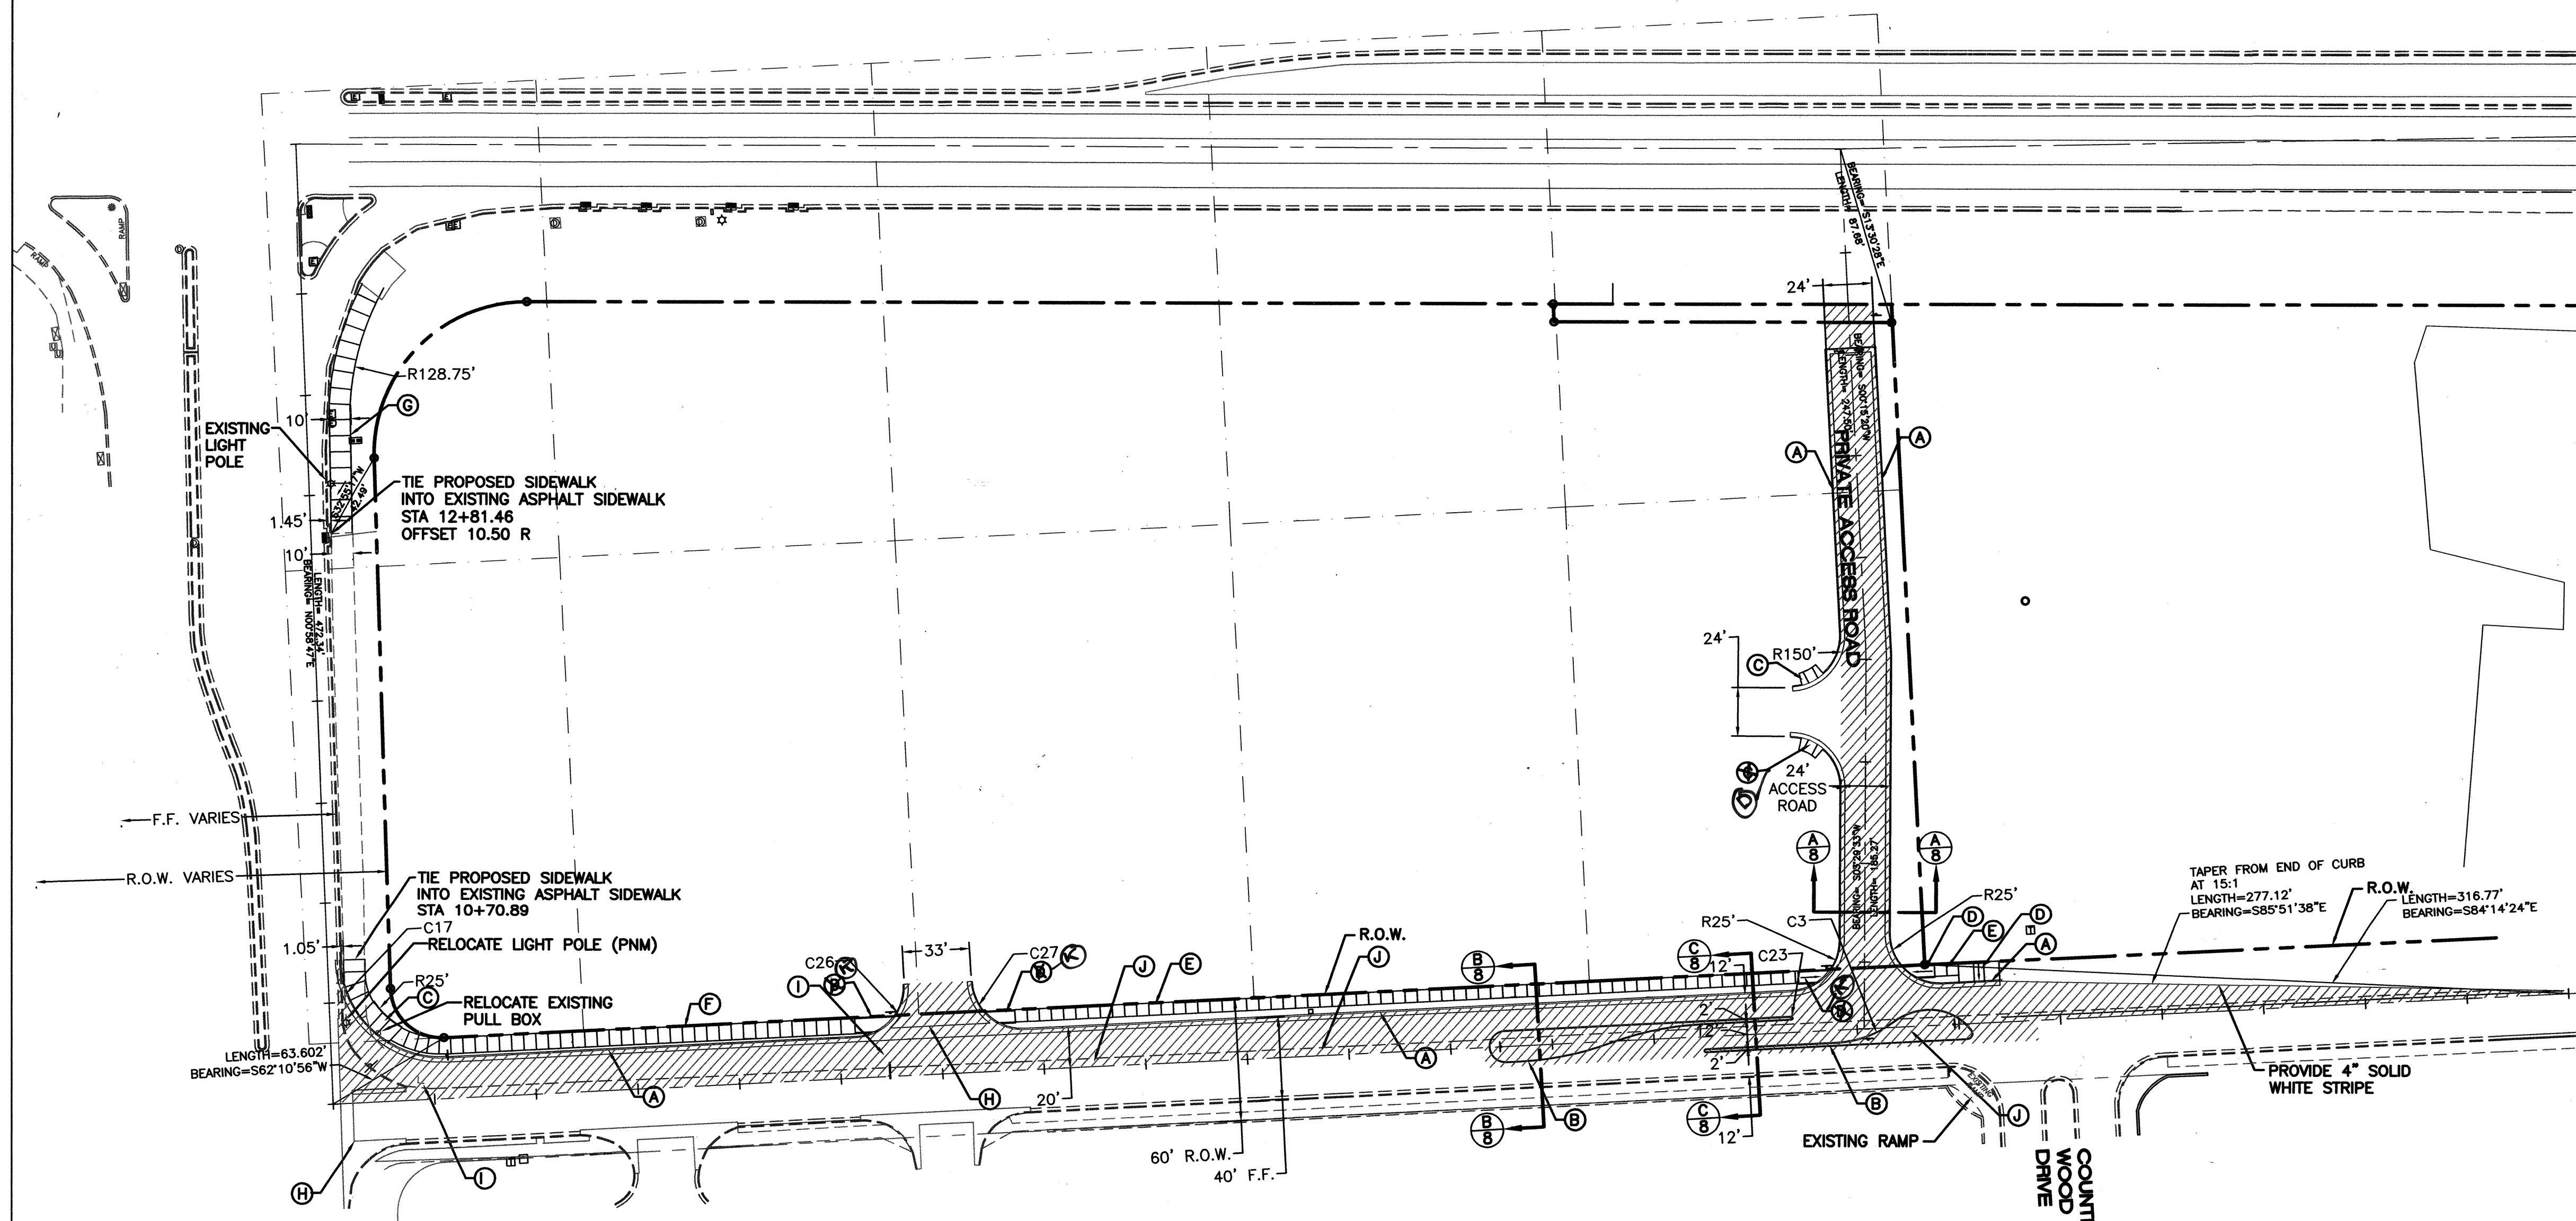


NOTE:
IN WORK AREAS, ALL EXISTING MANHOLE, VALVE
BOX AND OTHER UTILITY RIMS MUST BE
ADJUSTED TO FINAL GRADE.

CERTIFICATE OF SUBSTANTIAL COMPLIANCE ON PLANS


I, Ronald R. Bohannon, of the firm of Tierra West LLC, a registered Professional Engineer in the State of New Mexico, do hereby certify to the best of my knowledge and belief, that the infrastructure installed as part of this project has been inspected by me or by a qualified person under my direct supervision and has been constructed in accordance with the plans and specifications approved by the City Engineer and that the original design intent of the approved plans has been met, except as noted by me on the as-built construction drawings. This Certification is based on site inspections by me or personnel under my direction with survey information provided by David Vigil of Geo-Sure Co. NMPSI SR 8911.

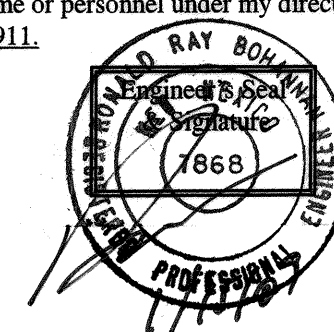

RECORD DRAWING

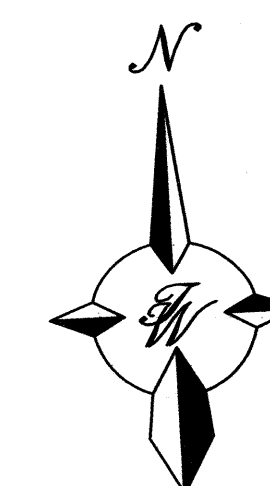

GRAPHIC SCALE



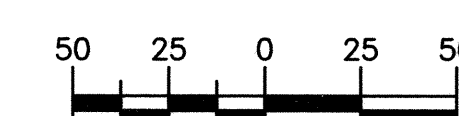


SCALE: 1"=50'

KEYED NOTES:

- ✓(A) STANDARD CURB AND GUTTER PER COA STD DWG #2415A.
- ✓(B) MEDIAN CURB PER COA STD DWG #2415B.
- ✓(C) WHEEL CHAIR RAMP PER COA STD DWG #2441 CASE II.
SEE SHEET 13 11
- == ✓(D) UNIDIRECTIONAL WHEELCHAIR RAMP SEE DETAIL SHEET 13 13.
- == ✓(E) 6' SIDEWALK TO BE BUILT WITH THIS WORK ORDER PER
COA STD DWG #2430.
- ✓(F) 8' SIDEWALK TO BE BUILT WITH THIS WORK ORDER PER
COA STD DWG #2430.
- == ✓(H) 6' VALLEY GUTTER PER COA STD DWG #2420.
- ✓(I) ADJUST EXISTING WATER VALVE BOX TO FINAL GRADE
- ✓(J) ADJUST EXISTING MANHOLE TO FINAL GRADE
- ✓(K) **MODIFY (U)-DIRECTION TO ALLOW PEDESTRIAN
ACCESS TO CURB**

LEGEND

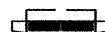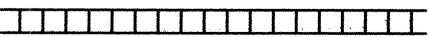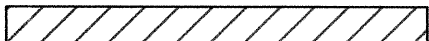	EXISTING SAS MANHOLE
--- EX. 8" SAS ---	EXISTING SANITARY SEWER LINE
	EXISTING METER
	EXISTING VALVE W/BOX
	EXISTING FIRE HYDRANT
	EXISTING AIR RELEASE VALVE
	EXISTING REDUCER
--- EX. 16" WL ---	EXISTING WATER LINE
	EXISTING STORM SEWER MANHOLE
	EXISTING STORM SEWER INLET
--- EX. 24" RCP ---	EXISTING STORM SEWER LINE
	PROPOSED STORM SEWER MANHOLE
	PROPOSED DBL. "A" INLET
	PROPOSED SINGL. "A" INLET
--- 24" RCP ---	PROPOSED STORM SEWER LINE
=====	EXISTING CURB & GUTTER
=====	PROPOSED CURB & GUTTER
-----	BOUNDARY LINE
-----	EXISTING BOUNDARY LINE
-----	EASEMENT
	PROPOSED SIDEWALK
-----	CENTERLINE
----- L1 -----	RIGHT-OF-WAY
-----	LOT LINES
-----	EXISTING LOT LINES
-----	LANE
-----	STRIPING
	BENCH MARK
	DIRECTION OF FLOW
	PROPOSED PAVING

CAUTION:

EXISTING UTILITIES ARE NOT SHOWN.
IT SHALL BE THE SOLE RESPONSIBILITY
OF THE CONTRACTOR TO CONDUCT ALL
NECESSARY FIELD INVESTIGATIONS PRIOR
TO ANY EXCAVATION TO DETERMINE THE
ACTUAL LOCATION OF UTILITIES & OTHER
IMPROVEMENTS.

TIERRA WEST, LLC
5571 MIDWAY PARK PLACE NE
ALBUQUERQUE, NM 87109
(505)858-3100

CITY OF ALBUQUERQUE
PUBLIC WORKS DEPARTMENT
ENGINEERING GROUP

TITLE: **PASEO CROSSING SHOPPING CENTER**
MASTER PAVING PLAN


DESIGN REVIEW COMMITTEE		CITY ENGINEER APPROVAL		LAST DESIGN UPDATE	MO./DAY/YR.		MO./DAY/YR.	
								
DESIGN REVIEW COMMITTEE		CITY ENGINEER						
CITY PROJECT NO. 7856.81				ZONE MAP NO. D-19	SHEET 3		OF 11	

7856.81

ZONE MAP NO.
D-19

SHEET 3 OF 11

\\2006\26010\Drawings\Construction\2610-SH03-MPC.dwg Jan 30, 2007 = 12:35pm

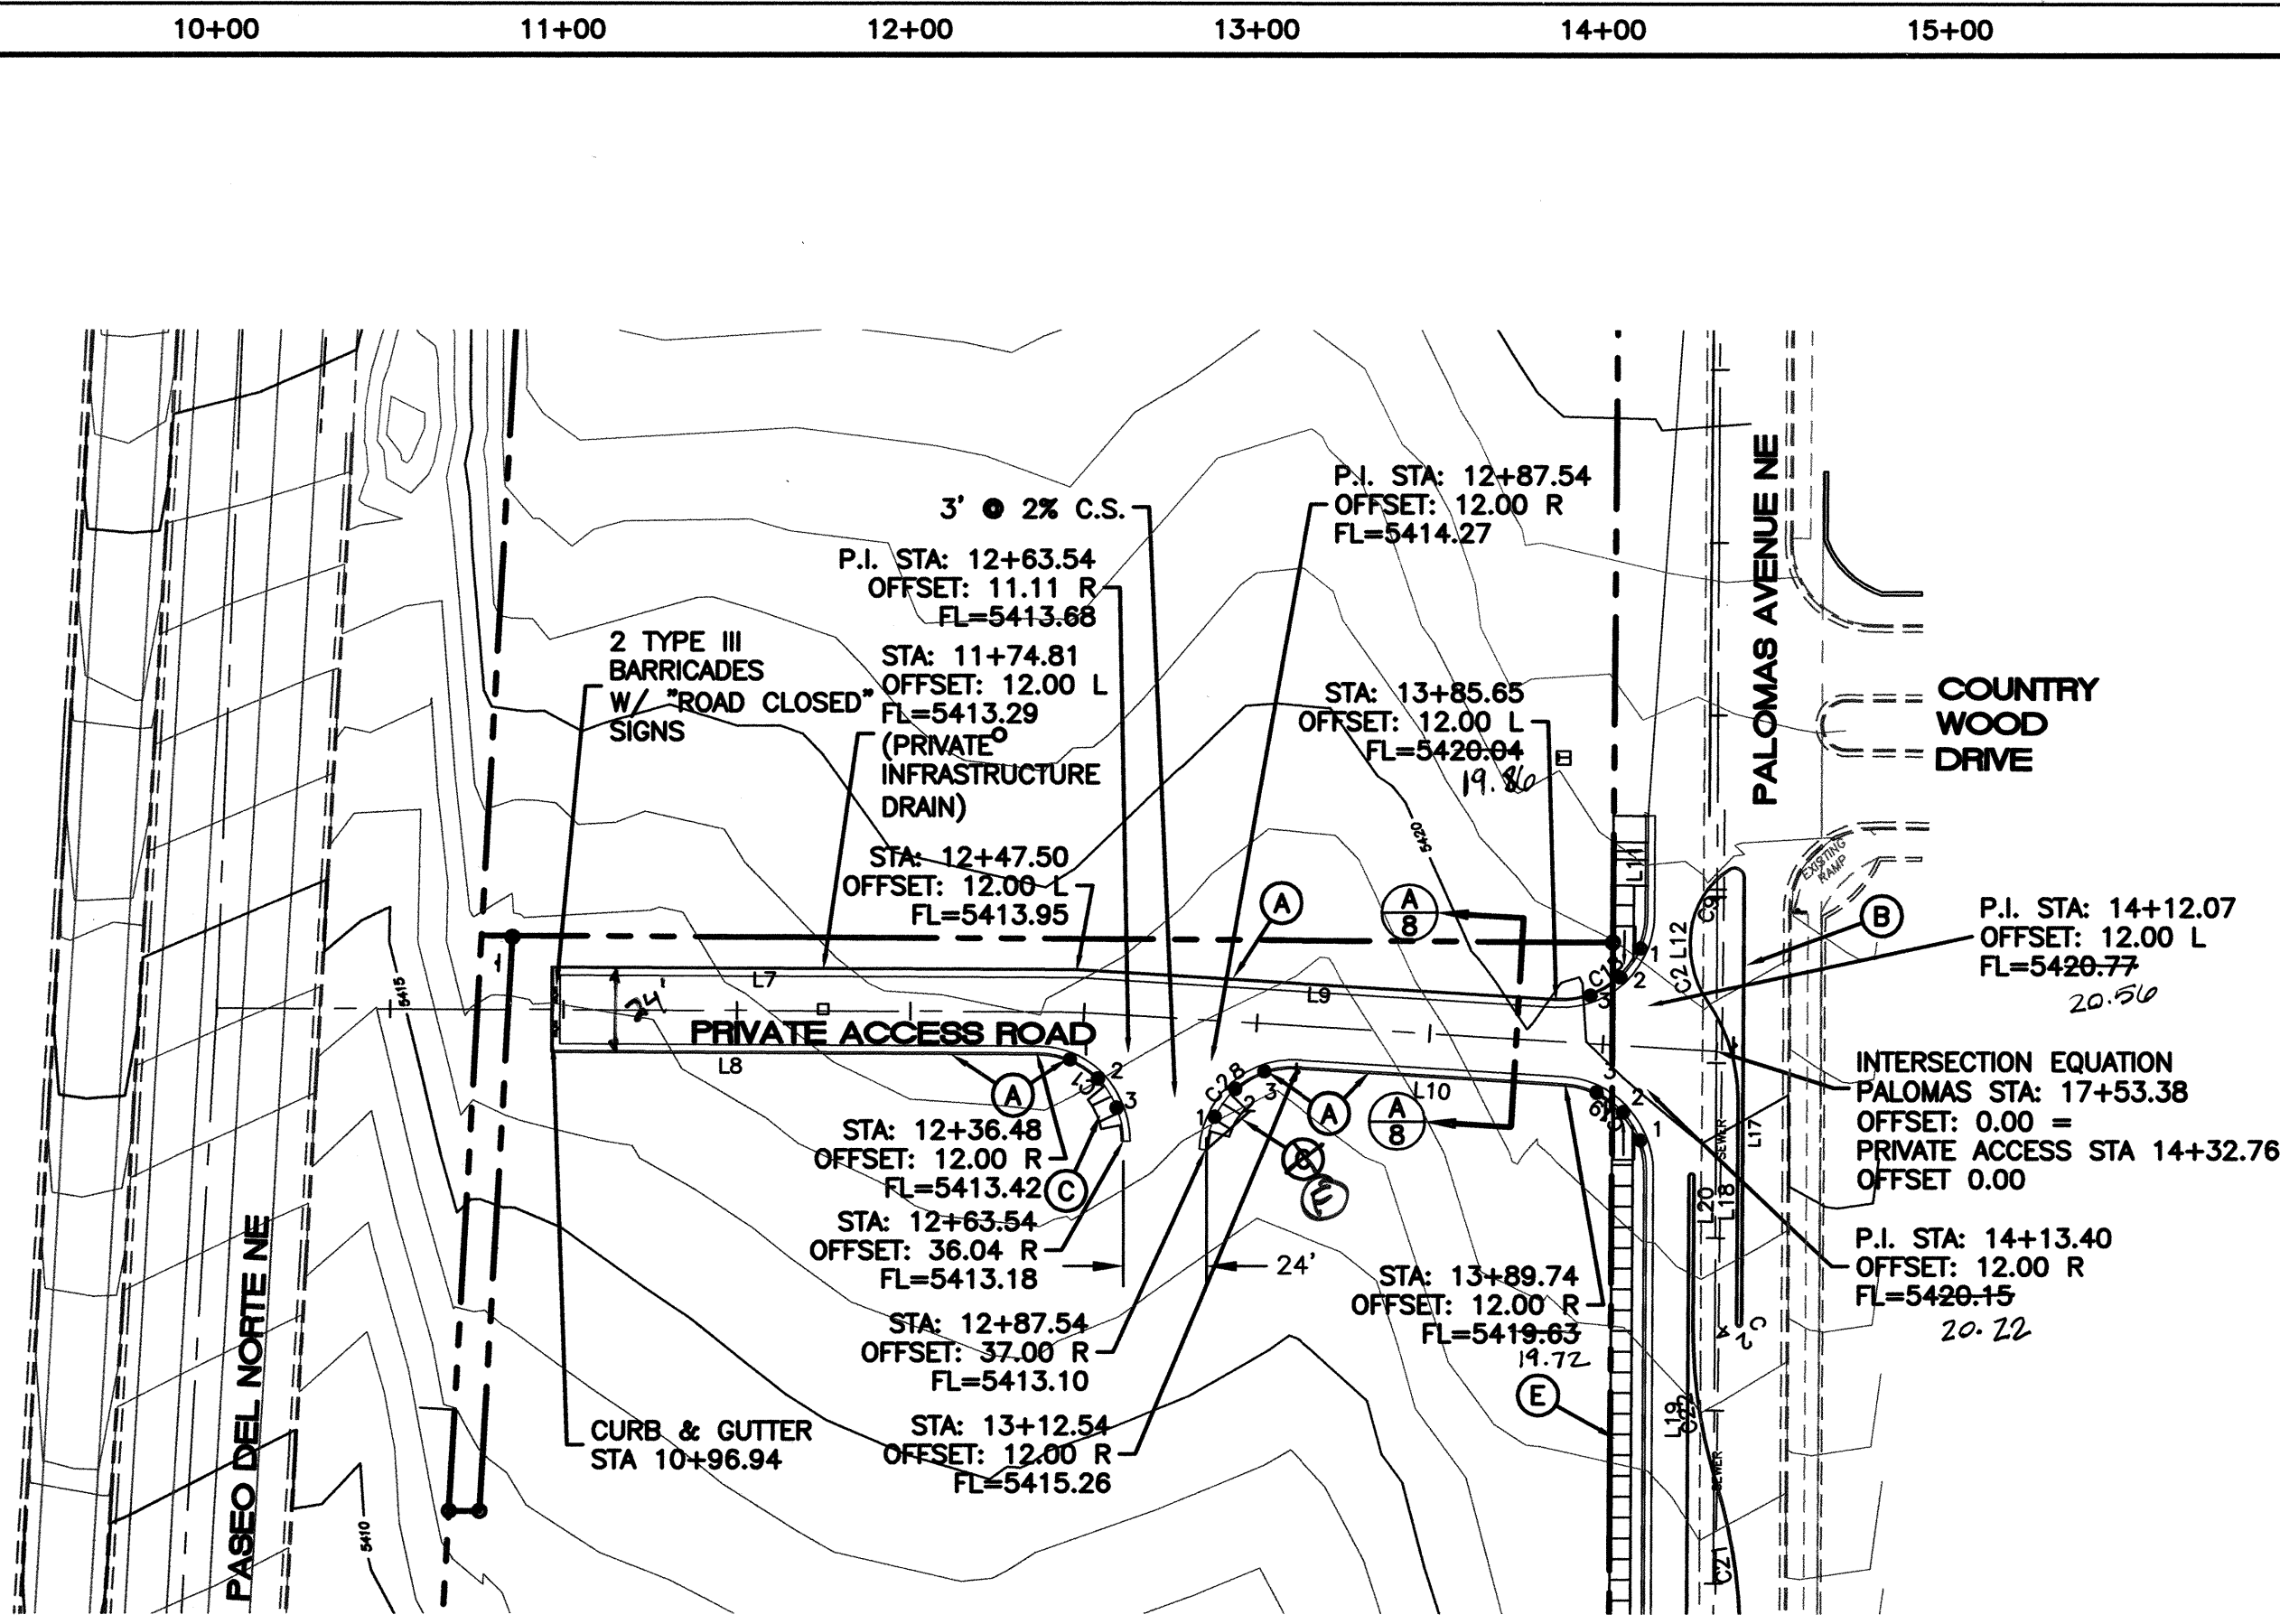

CERTIFICATE OF SUBSTANTIAL COMPLIANCE ON PLANS

I, Ronald R. Bohannon, of the firm of Tierra West LLC, a Registered Professional Engineer in the State of New Mexico, do hereby certify, to the best of my knowledge and belief, that the infrastructure installed as part of this project has been inspected by me or by a qualified person under my direct supervision and has been constructed in accordance with the plans and specifications approved by the City Engineer and that the original design intent of the approved plans has been met, except as noted by me on the as-built construction drawings. This Certification is based on site inspections by me or personnel under my direction with survey information provided by David Vigil, of Geo-Surv Co., NMPLS# 8911.

CURVE TABLE				
CURVE	LENGTH	RADIUS	DELTA	CHORD BEARING
C1	38.16	25.00	89°44'40"	N45°07'40"E
C18	40.85	25.00	93°10'02"	S43°08'28"E
C19	37.89	25.00	88°49'58"	N48°54'32"E
C20	25.13	8.00	180°00'00"	S00°19'31"W
C28	39.27	25.00	90°00'00"	N41°30'27"W

LINE TABLE		
LINE	LENGTH	BEARING
L7	167.59	N00°15'20"E
L8	157.89	S00°15'20"W
L9	138.48	S03°28'43"W
L10	77.20	S03°29'33"W

QUARTER POINTS

C18		
FL	ELEV.	
1	5421.09	
2	5420.74	
3	5420.39	

C19		
FL	ELEV.	
1	5419.61	
2	5419.59	
3	5419.57	

C20		
FL	ELEV.	
1	5413.36	
2	5413.30	
3	5413.24	



C28		
FL	ELEV.	
1	5413.64	
2	5414.18	
3	5414.72	

KEYED NOTES

- (A) STANDARD CURB AND GUTTER PER COA STD DWG #2415A
- (B) MEDIAN CURB PER COA STD DWG #2415B
- (C) WHEEL CHAIR RAMP PER COA STD DWG #2441 CASE II
- (E) 6' SIDEWALK TO BE BUILT WITH THIS WORK ORDER PER COA STD DWG #2430
- (F) UNIDIRECTIONAL HK RAMP SEE DETAIL SHEET II

PRIVATE ACCESS ROAD
LEFT FLOW LINE


PRIVATE ACCESS ROAD
RIGHT FLOW LINE

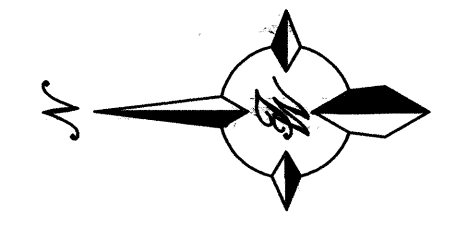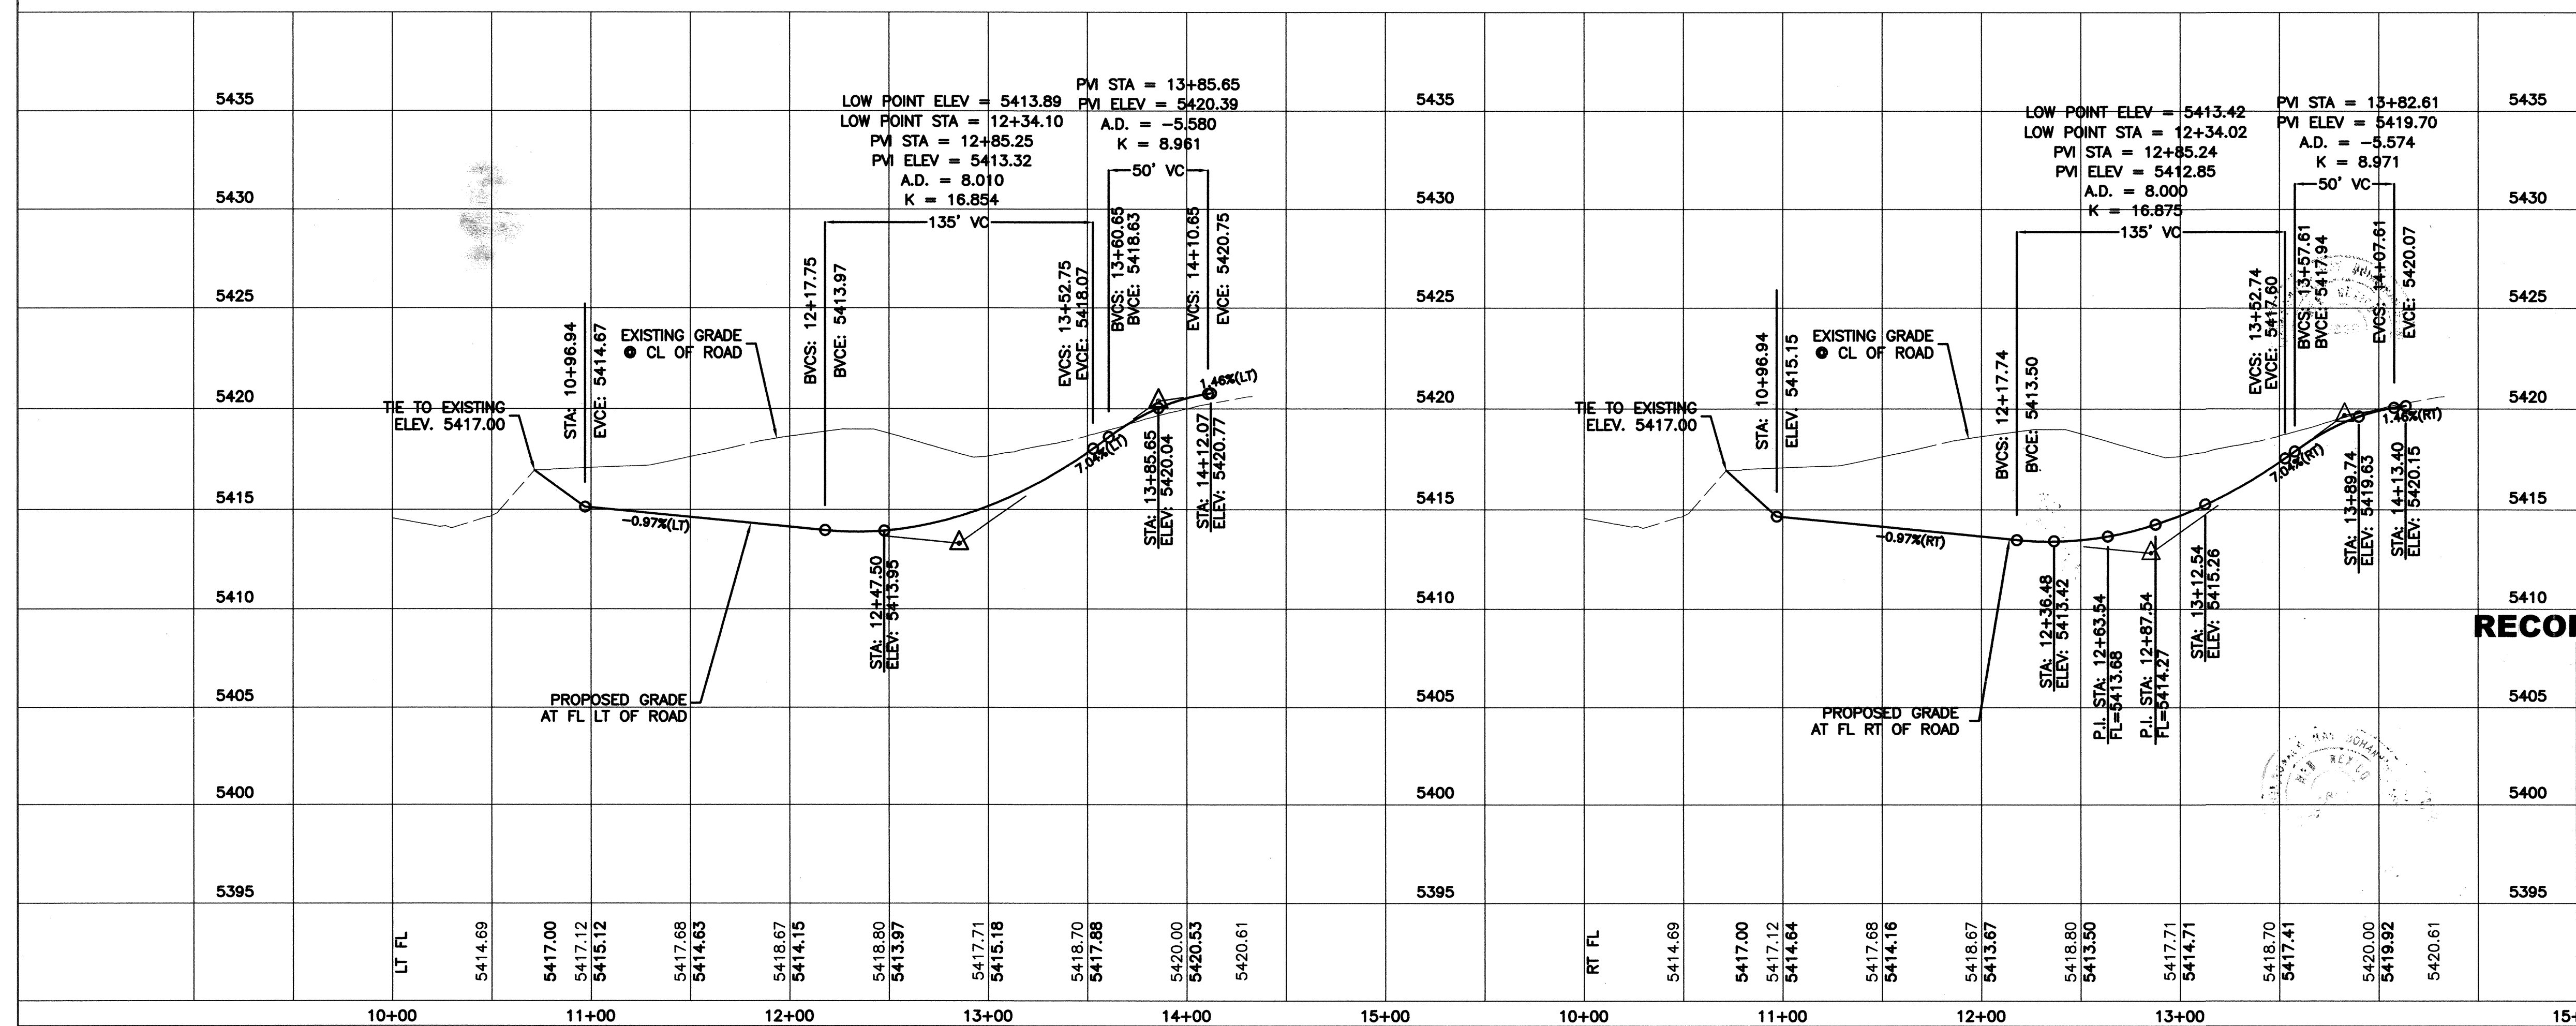


RECORD DRAWING

SCALE: HORIZ. 1"=50'
VERT. 1"=5'


TERRA WEST, LLC 5571 MIDWAY PARK PLACE NE ALBUQUERQUE, NM 87109 (505)858-3100	
CITY OF ALBUQUERQUE PUBLIC WORKS DEPARTMENT ENGINEERING GROUP	
TITLE: ACCESS ROAD PAVING IMPROVEMENTS	
DESIGN REVIEW COMMITTEE APPROVE MAR - 9 2007	CITY ENGINEER APPROVAL APPROVE MAR 9 2007 CITY ENGINEER
DESIGNED BY: BW DRAWN BY: DY CHECKED BY: RRB	DATE: 07-17-06 DATE: 07-17-06 DATE: 07-17-06
CITY PROJECT NO. 7856.81	ZONE MAP NO. D-19
SHEET 5 OF 11	

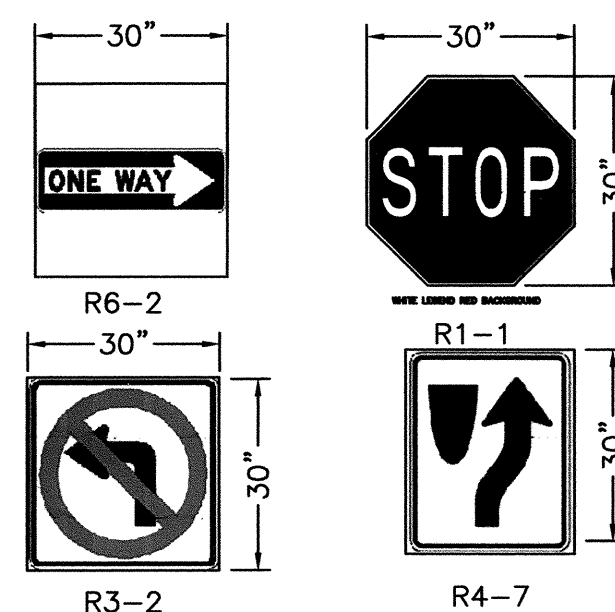

*** SIGN COLORS SHALL COMPLY WITH LATEST MUTCD STANDARDS

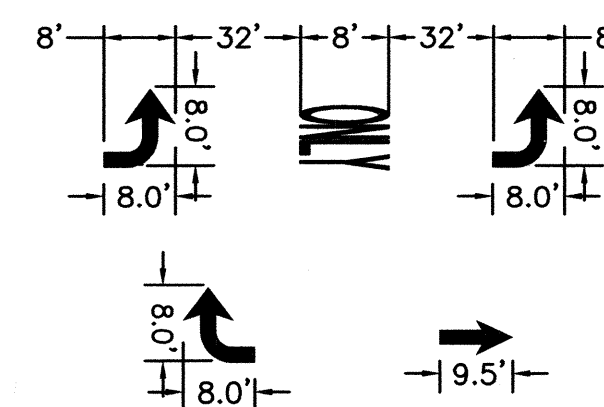

ARROW DETAILS


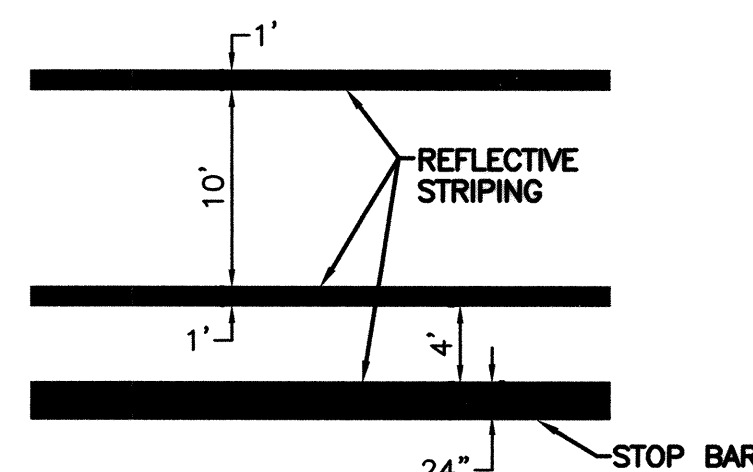


**** ALL PAVEMENT MARKINGS SHALL CONFORM TO
M.U.T.C.D. SPECS (LATEST EDITION)**


CROSSWALK DETAIL

CERTIFICATE OF SUBSTANTIAL COMPLIANCE ON PLANS

I, **Ronald R. Bohannan**, of the firm of **Tierra West LLC**, a Registered Professional Engineer in the State of New Mexico, do hereby certify to the best of my knowledge and belief, that the infrastructure installed as part of this project has been installed by me or by a qualified person under my direct supervision and has been constructed in accordance with the plans and specifications approved by the City Engineer and that the original design intent of the approved plans has been met, except as noted by me on the as-built construction drawings. This Certification is based on site inspections by me or personnel under my direction with survey information provided by **David Vigil**, of **Geo-Survey Co. NMPLS# 8911**.

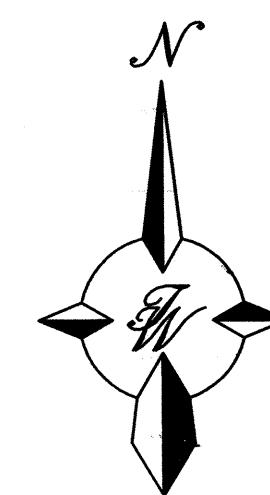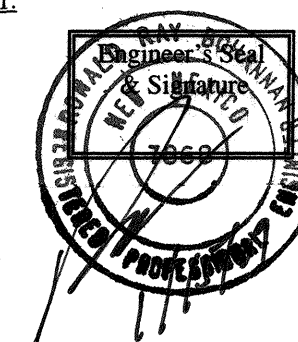

GRAPHIC SCALE

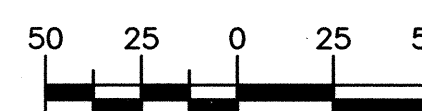

SCALE: 1"=50'

RECORD DRAWING







TIERRA WEST, LLC
5571 MIDWAY PARK PLACE NE
ALBUQUERQUE, NM 87109
(505)858-3100

CITY OF ALBUQUERQUE
PUBLIC WORKS DEPARTMENT
ENGINEERING GROUP

TITLE: **PALOMAS AVENUE**
STRIPING PLAN

DESIGN REVIEW COMMITTEE		CITY ENGINEER APPROVAL		LAST DESIGN UPDATE	MO./DAY/YR.		MO./DAY/YR.	
APPROVE MAR - 9 2007 DESIGN REVIEW COMMITTEE		APPROVE MAR 9 2007 CITY ENGINEER						
DESIGN REVIEW COMMITTEE		CITY ENGINEER		LAST DESIGN UPDATE	MO./DAY/YR.		MO./DAY/YR.	
CITY PROJECT NO. 7856.81		ZONE MAP NO. D-19		SHEET 6	OF 11			

[illegible]

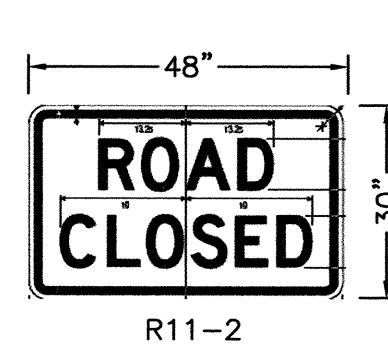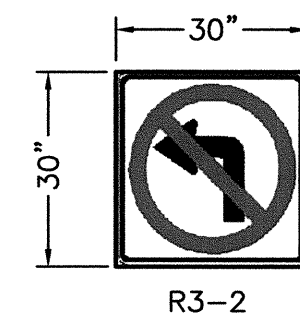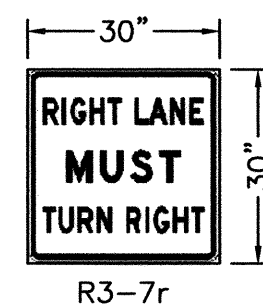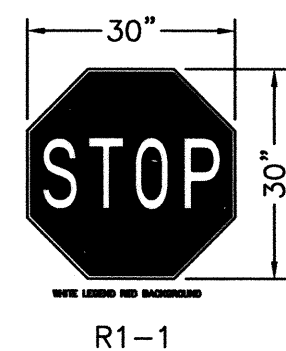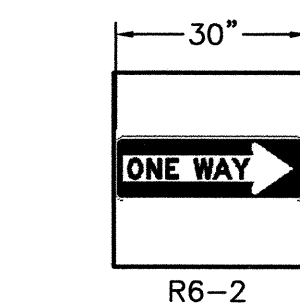
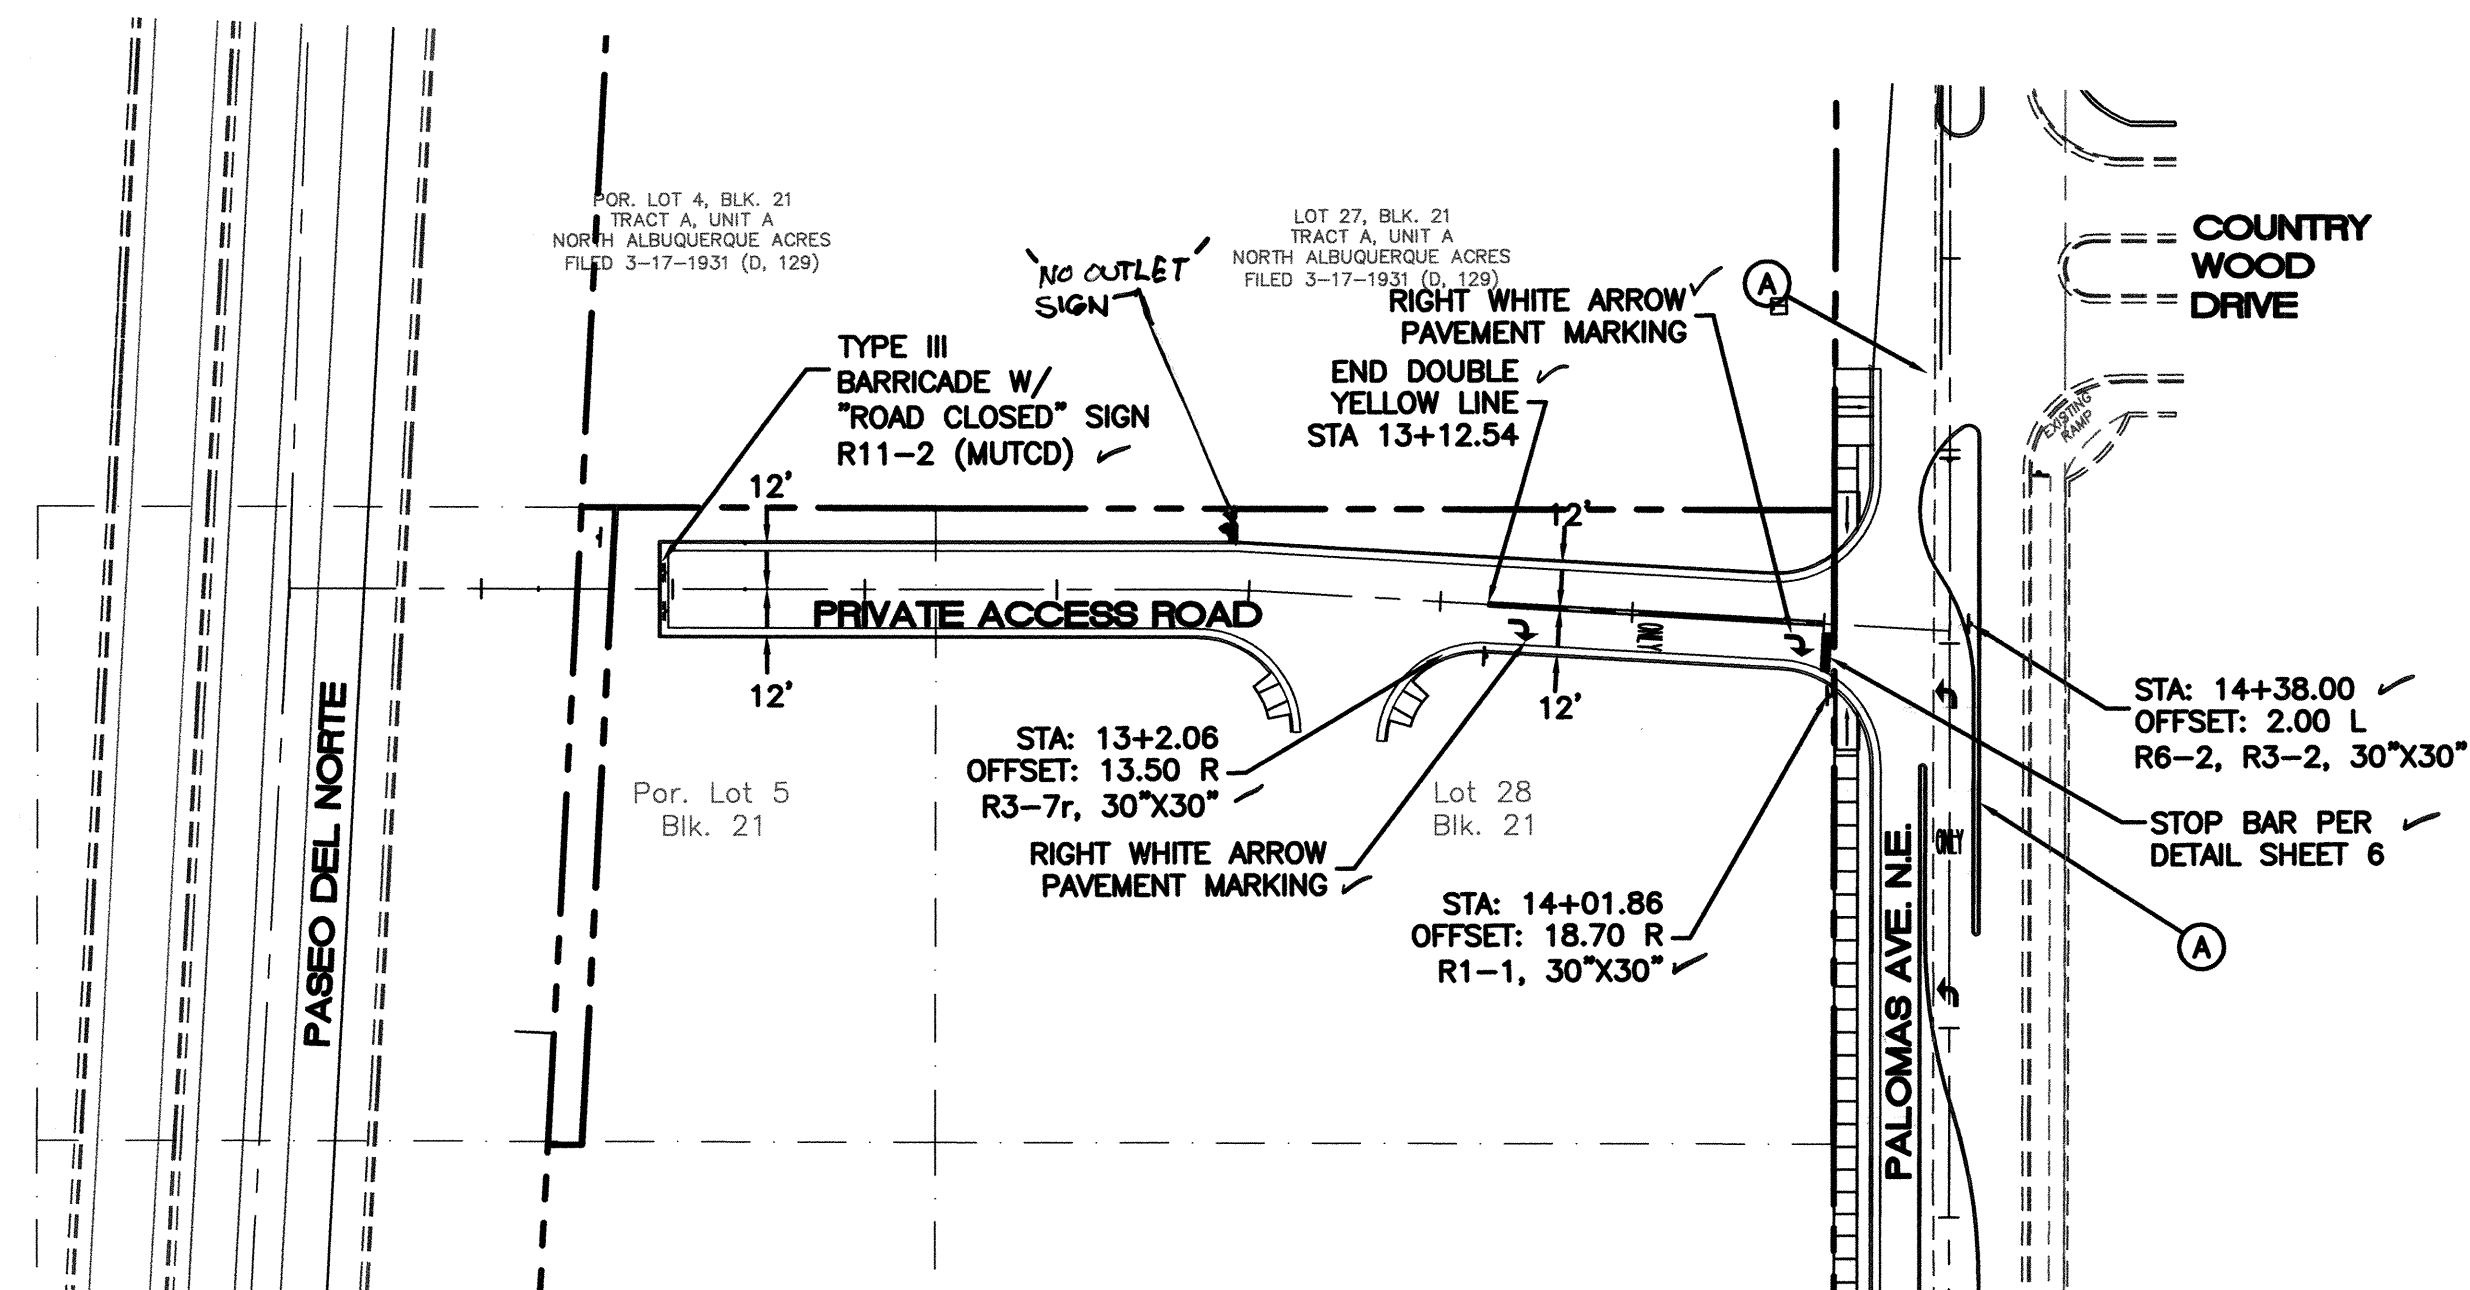


* SIGN FACES SHOWN FOR REFERENCE; CONTRACTOR SHALL VERIFY DIRECTION OF ARROW TO CORRELATE WITH INSTALLATION LOCATION AND TRAFFIC MOVEMENTS.


**** CONTRACTOR SHALL COORDINATE WITH TRAFFIC
OPERATIONS PRIOR SIGNING AND STRIPING**

CERTIFICATE OF SUBSTANTIAL COMPLIANCE ON PLANS

I, Ronald R. Bohanan, of the firm of Tierra West LLC, a Registered Professional Engineer in the State of New Mexico, do hereby certify, to the best of my knowledge and belief, that the infrastructure installed as part of this project has been inspected by me or by a qualified person under my direct supervision and has been constructed in accordance with the plans and specifications approved by the City Engineer and that the original design intent of the approved plans has been met, except as noted by me on the as-built construction drawings. This Certification is based on site inspections by me or personnel under my direction with survey information provided by David Vigil, of Geo-Surv Co. NMPS # 8911.

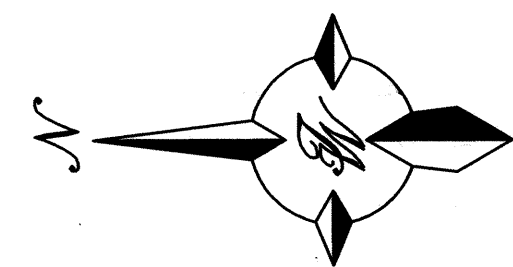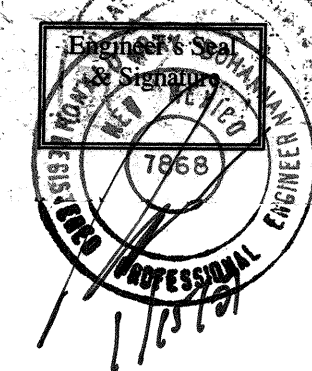

GRAPHIC SCALE

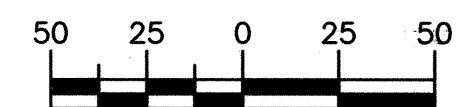

SCALE: 1"=50'

RECORD DRAWING


TIERRA WEST, LLC
5571 MIDWAY PARK PLACE NE
ALBUQUERQUE, NM 87109
(505)858-3100

CITY OF ALBUQUERQUE
PUBLIC WORKS DEPARTMENT
ENGINEERING GROUP

TITLE: ***ACCESS ROAD***
STRIPING PLAN


DESIGN REVIEW COMMITTEE		CITY ENGINEER APPROVAL		LAST DESIGN UPDATE		MO./DAY/YR.		MO./DAY/YR.	
									
DESIGN REVIEW COMMITTEE		CITY ENGINEER							
CITY PROJECT NO.		ZONE MAP NO.		SHEET		OF			
7856.81		D-19		7		11			

[illegible]

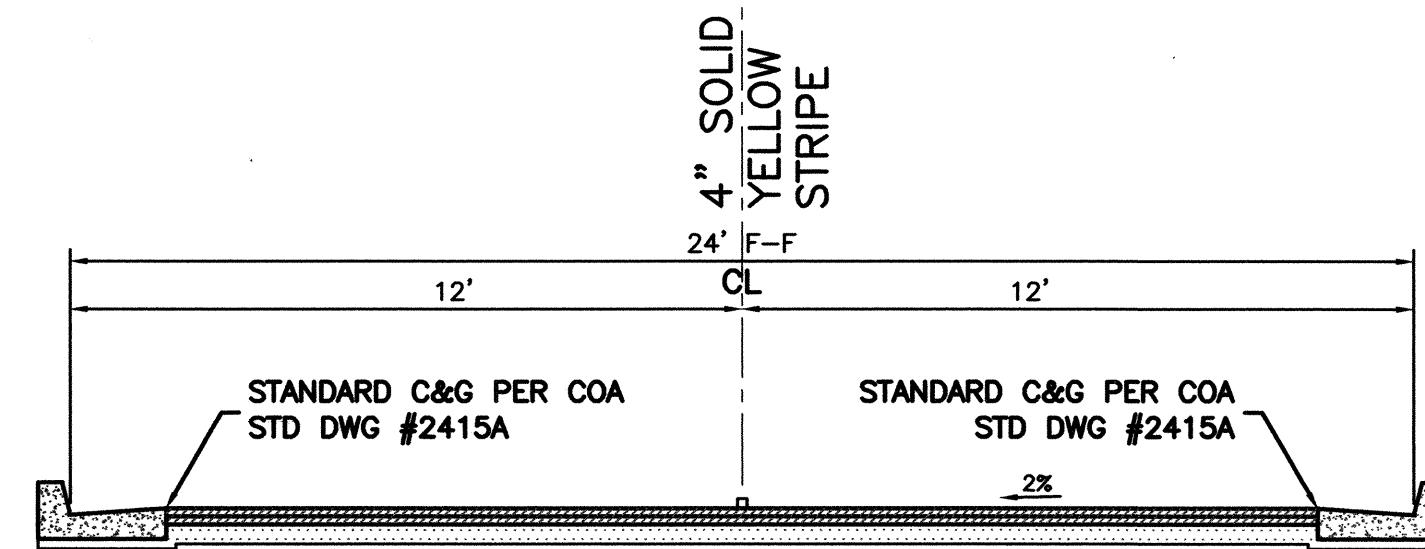


SECTION A-A
PRIVATE ACCESS ROAD
STA 13+75
SC: 1"=4'


FINISH SURFACE OF SUBGRADE SHALL BE MOISTURE CONTROLLED AT COMPACTION MOISTURE RANGE, OR PRIME COAT APPLIED AS REQUIRED BY THE ENGINEER UNTIL NEXT/FINAL SURFACE IS COMPLETED. SUBGRADE PREPARATION SHALL BE PERFORMED AFTER ALL SUBSURFACE R/W UTILITIES CONSTRUCTION IS COMPLETED.

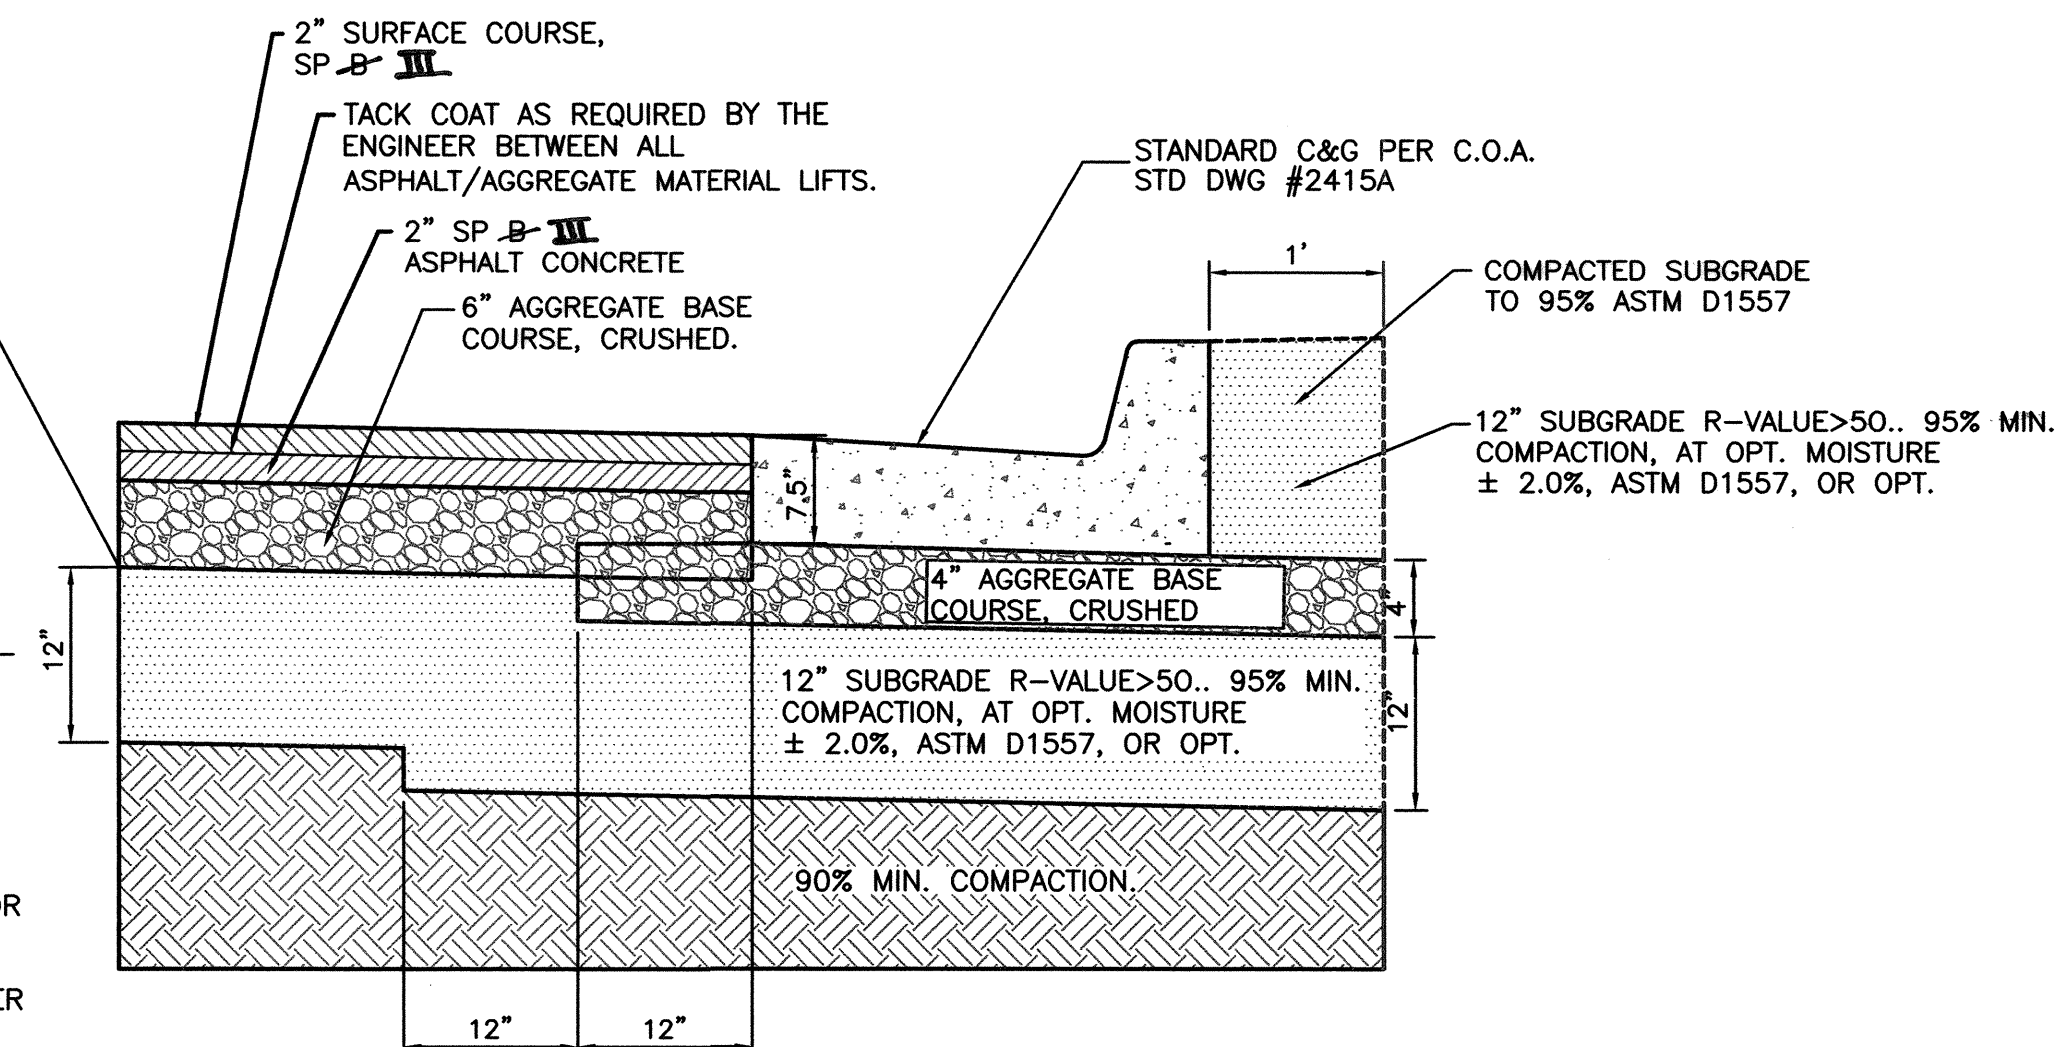

PRIVATE ROAD / PALOMAS AVE TYPICAL PAVING SECTION
REFERENCE CITY PROJECT # 4083.90

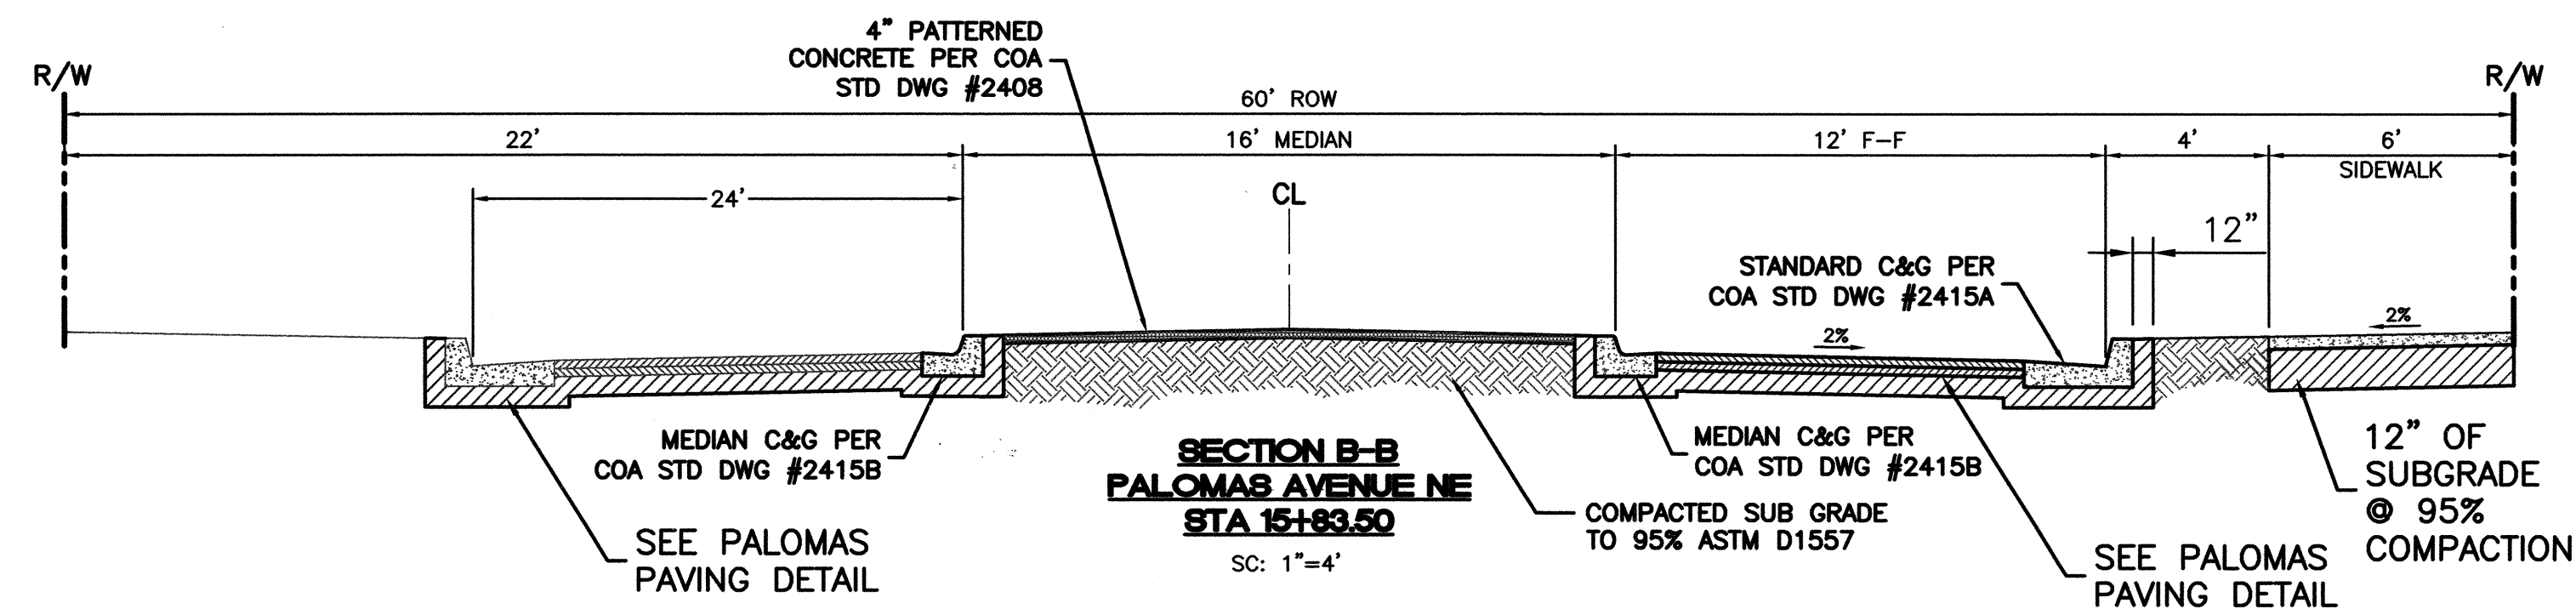

SECTION B-B
PALOMAS AVENUE NE
STA 15+83.50
SC: 1"=4'

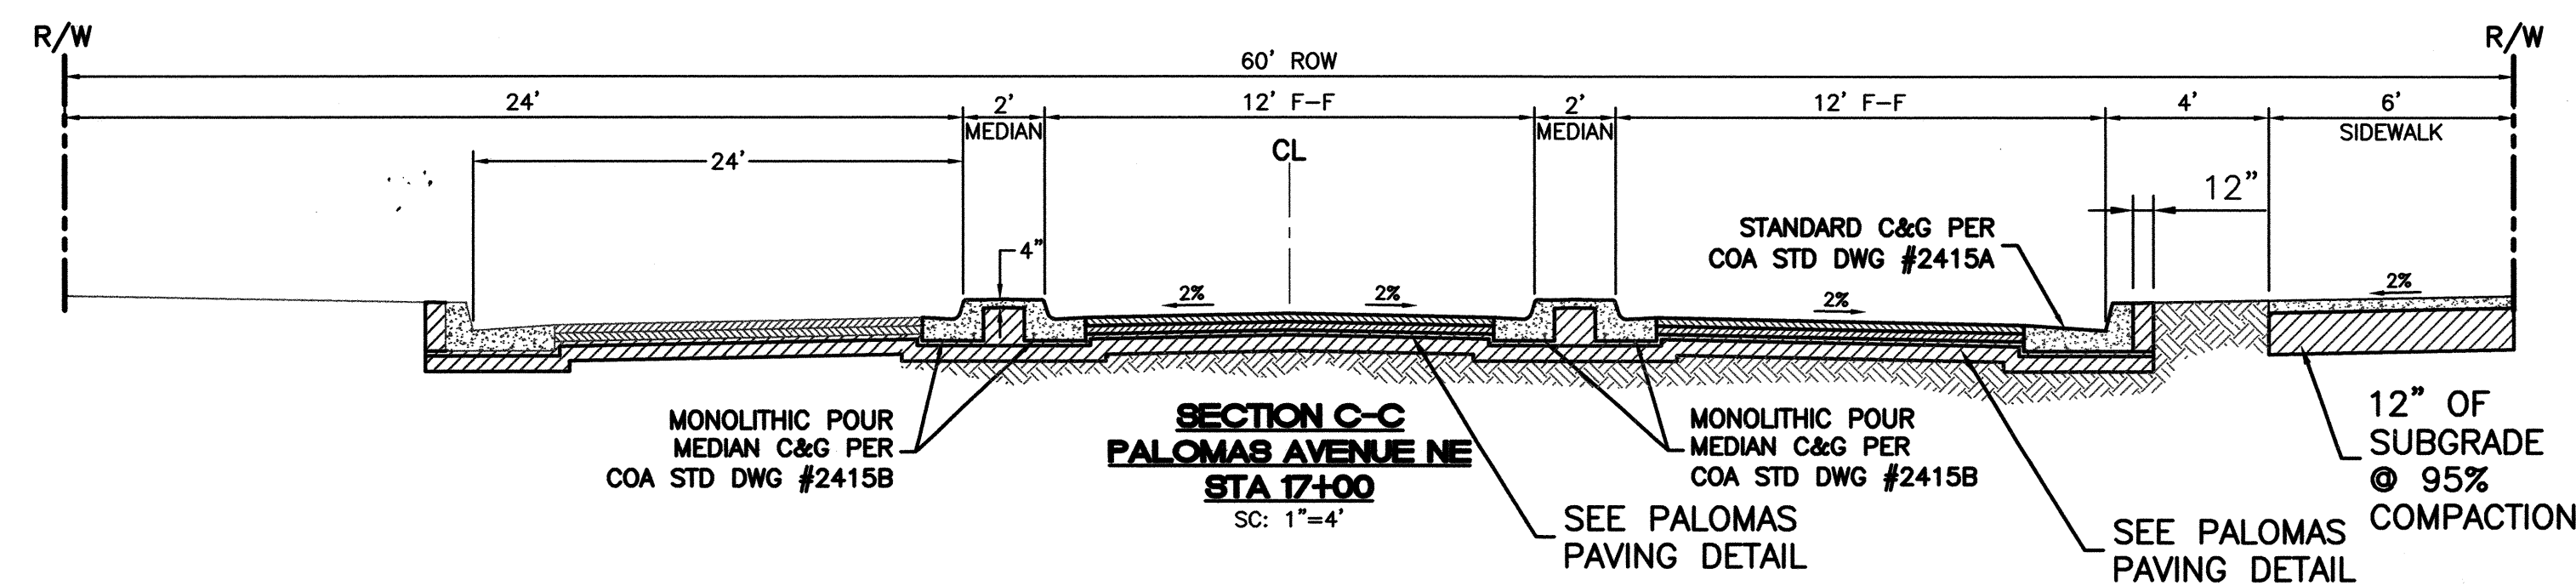

SECTION C-C
PALOMAS AVENUE NE
STA 17+00
SC: 1"=4'


4" TEMPORARY ASPHALT
(2-2" LIFT)

12" SUBGRADE PREPARATION
COMPACTED TO 95% OF MAX.
DENSITY AS DETERMINED BY
ASTM D-1557

PALOMAS TEMPORARY ASPHALT PAVING SECTION
N.T.S. REFERENCE CITY PROJECT # 4083.90

CERTIFICATE OF SUBSTANTIAL COMPLIANCE ON PLANS

I, **Ronald R. Bohanan**, of the firm of **Tierra West LLC**, a Registered Professional Engineer in the State of New Mexico, do hereby certify, to the best of my knowledge and belief, that the infrastructure installed as part of this project has been inspected by me or by a qualified person under my direct supervision and has been constructed in accordance with the plans and specifications approved by the City Engineer and that the original design intent of the approved plans has been met, except as noted by me on the as-built construction drawings. This Certification is based on site inspections by me or personnel under my direction with survey information provided by **David Vigil**, of **Geo-Surv Co. NMPLS# 8911**.

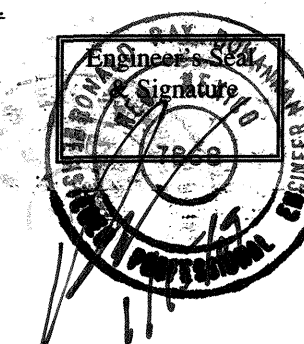

RECORD DRAWING

TIERRA WEST, LLC
5571 MIDWAY PARK PLACE NE
ALBUQUERQUE, NM 87109
(505)858-3100

CITY OF ALBUQUERQUE
PUBLIC WORKS DEPARTMENT
ENGINEERING GROUP

TITLE: **PASEO CROSSING SHOPPING CENTER**
PAVING DETAILS

DESIGN REVIEW COMMITTEE

APPROVE

MAR - 9 2007

DESIGN REVIEW COMMITTEE



CITY ENGINEER APPROVAL
 [Signature]
 DATE: 10/10/17
 CITY ENGINEER

LATEST DESIGN UPDATE


MO./DAY/YR.	MO./DAY/YR.

CITY PROJECT NO. **7856.81**

ZONE MAP NO.
D-19

SHEET	OF
8	11

[illegible]

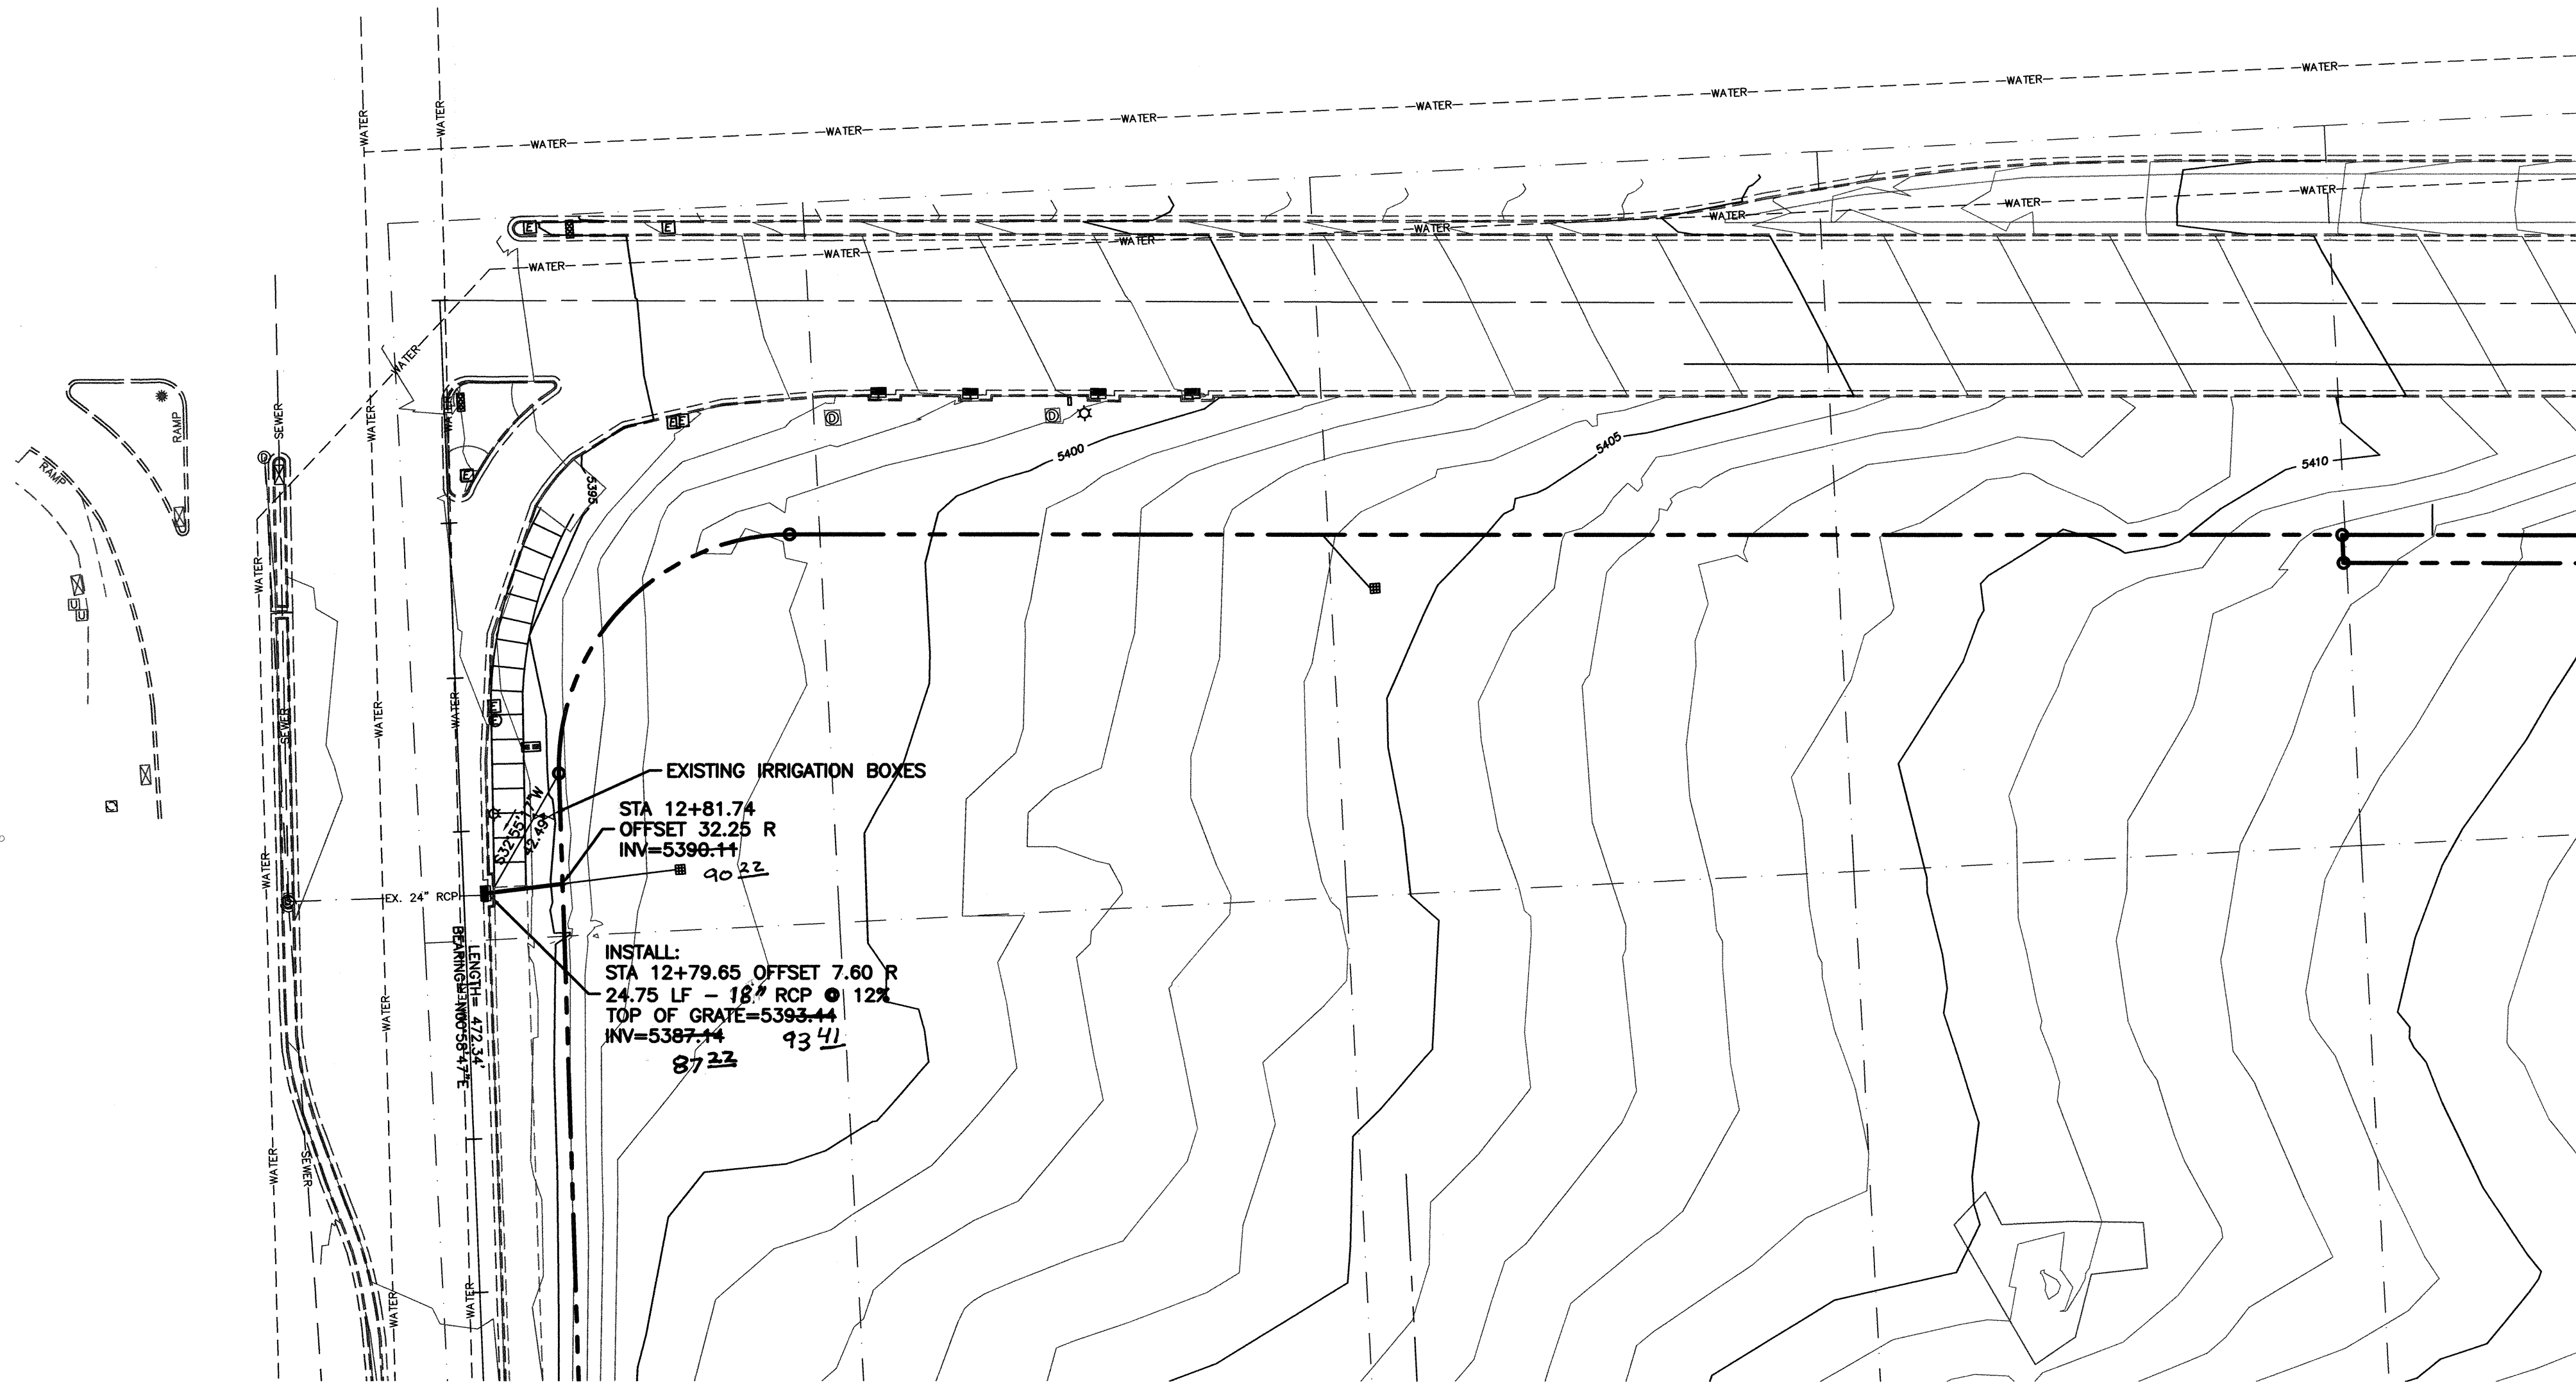


NOTICE TO CONTRACTORS


1. AN EXCAVATION/CONSTRUCTION PERMIT WILL BE REQUIRED BEFORE BEGINNING ANY WORK WITHIN CITY RIGHT-OF-WAY. AN APPROVED COPY OF THESE PLANS MUST BE SUBMITTED AT THE TIME OF APPLICATION FOR THIS PERMIT.
2. ALL WORK DETAILED ON THESE PLANS TO BE PERFORMED, INLESS OTHERWISE STATED OR PROVIDED HEREON, WITH CITY OF ALBUQUERQUE INTERIM STANDARD SPECIFICATIONS FOR PUBLIC WORKS CONSTRUCTION, 1986 THROUGH UPDATE 7.
3. TWO WORKING DAYS PRIOR TO ANY EXCAVATION, CONTRACTOR MUST CONTACT NEW MEXICO ONE CALL SYSTEM (260-1990), FOR LOCATION OF EXISTING UTILITIES.
4. PRIOR TO CONSTRUCTION, THE CONTRACTOR SHALL EXCAVATE AND VERIFY THE HORIZONTAL AND VERTICAL LOCATIONS OF ALL CONSTRUCTIONS. SHOULD A CONFLICT EXIST, THE CONTRACTOR SHALL NOTIFY THE ENGINEER SO THAT THE CONFLICT CAN BE RESOLVED WITH A MINIMUM AMOUNT OF DELAY.
5. BACKFILL COMPACTION SHALL BE ACCORDING TO ARTERIAL STREET USE, PER CITY OF ALBUQUERQUE SPECIFICATIONS.
6. MAINTENANCE OF THOSE FACILITIES NOT WITHIN DEDICATED EASEMENTS SHALL BE THE RESPONSIBILITY OF THE OWNER OF THE PROPERTY SERVED.
7. WORK ON ARTERIAL STREETS SHALL BE PERFORMED ON A 24-HOUR BASIS.
8. CONTRACTOR IS RESPONSIBLE TO PROVIDE UTILITY STUBS 5' FROM BUILDING
9. CONTRACTOR IS REQUIRED TO VERIFY INVERT AND LOCATIONS OF STORM DRAINS AND SANITARY SEWER AT SERVICE CROSSINGS AND CONNECTIONS AT START OF CONSTRUCTION. CONTRACTOR SHALL IMMEDIATELY NOTIFY ENGINEER OF DISCREPANCIES BETWEEN INVERT ELEVATIONS SHOWN ON THESE PLANS AND ACTUAL FIELD ELEVATIONS.

CERTIFICATE OF SUBSTANTIAL COMPLIANCE ON PLANS

I, Ronald R. Bohannon, of the firm of Tierra West LLC, a Registered Professional Engineer in the State of New Mexico, do hereby certify, to the best of my knowledge and belief, that the infrastructure installed as part of this project has been inspected by me or by a qualified person under my direct supervision and has been constructed in accordance with the plans and specifications approved by the City Engineer and that the original design intent of the approved plans has been met, except as noted by me on the as-built construction drawings. This Certification is based on site inspections by me or personnel under my direction with survey information provided by David Vigil of Geo-Surv Co. NMPLSR 8911.

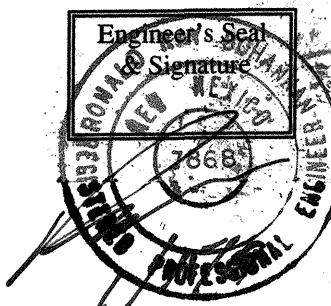


LEGEND	DESCRIPTION
○	EXISTING SAS MANHOLE
---	EX. 8" SAS
●	PROPOSED SAS MANHOLE
8	PROPOSED SAS CLEANOUT
---	8" SAS
---	PROPOSED SANITARY SEWER LINE
---	SANITARY SEWER SERVICE LINE
⊗	EXISTING METER
⊗	EXISTING VALVE W/BOX
⊗	EXISTING FIRE HYDRANT
⊗	EXISTING AIR RELEASE VALVE
⊗	EXISTING REDUCER
---	EX. 16" WL
⊗	EXISTING WATER LINE
⊗	PROPOSED METER
⊗	PROPOSED VALVE W/BOX
⊗	PROPOSED FIRE HYDRANT
⊗	PROPOSED REDUCER
---	8" WL
---	PROPOSED WATER LINE
⊗	EXISTING STORM SEWER MANHOLE
---	EX. 24" RCP
⊗	EXISTING STORM SEWER LINE
⊗	PROPOSED STORM SEWER MANHOLE
⊗	PROPOSED DBL. "A" INLET
⊗	PROPOSED SNGL. "A" INLET
---	24" RCP
---	PROPOSED STORM SEWER LINE
---	EXISTING CURB & GUTTER
---	PROPOSED CURB & GUTTER
---	BOUNDARY LINE
---	EXISTING BOUNDARY LINE
---	EASEMENT
---	PROPOSED SIDEWALK
---	CENTERLINE
---	RIGHT-OF-WAY
---	LOT LINES
---	EXISTING LOT LINES
---	SETBACK LINE
---	LANE
---	STRIPING
○	BENCH MARK
⊗	STREET LIGHTS
→	DIRECTION OF FLOW
C.S.	CROSS SLOPE

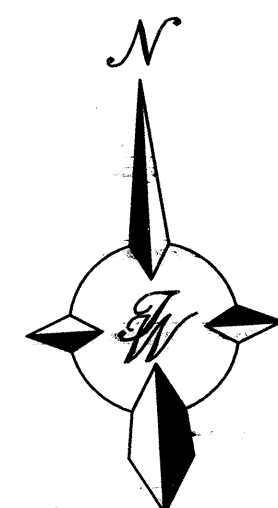






RECORD DRAWING

SCALE: HORIZ. 1"=40'

Tierra West, LLC 5571 MIDWAY PARK PLACE NE ALBUQUERQUE, NM 87109 (505)858-3100		CITY OF ALBUQUERQUE PUBLIC WORKS DEPARTMENT ENGINEERING GROUP	
TITLE: WYOMING BOULEVARD NE DRAINAGE IMPROVEMENTS			
DESIGN REVIEW COMMITTEE APPROVE MAR - 9 2007 DESIGN REVIEW COMMITTEE	CITY ENGINEER APPROVAL APPROVE MAR 9 2007 CITY ENGINEER	MO./DAY/YR. MO./DAY/YR. MO./DAY/YR. MO./DAY/YR.	MO./DAY/YR. MO./DAY/YR. MO./DAY/YR. MO./DAY/YR.
CITY PROJECT NO. 7856.81		ZONE MAP NO. D-19	SHEET 9 OF 11

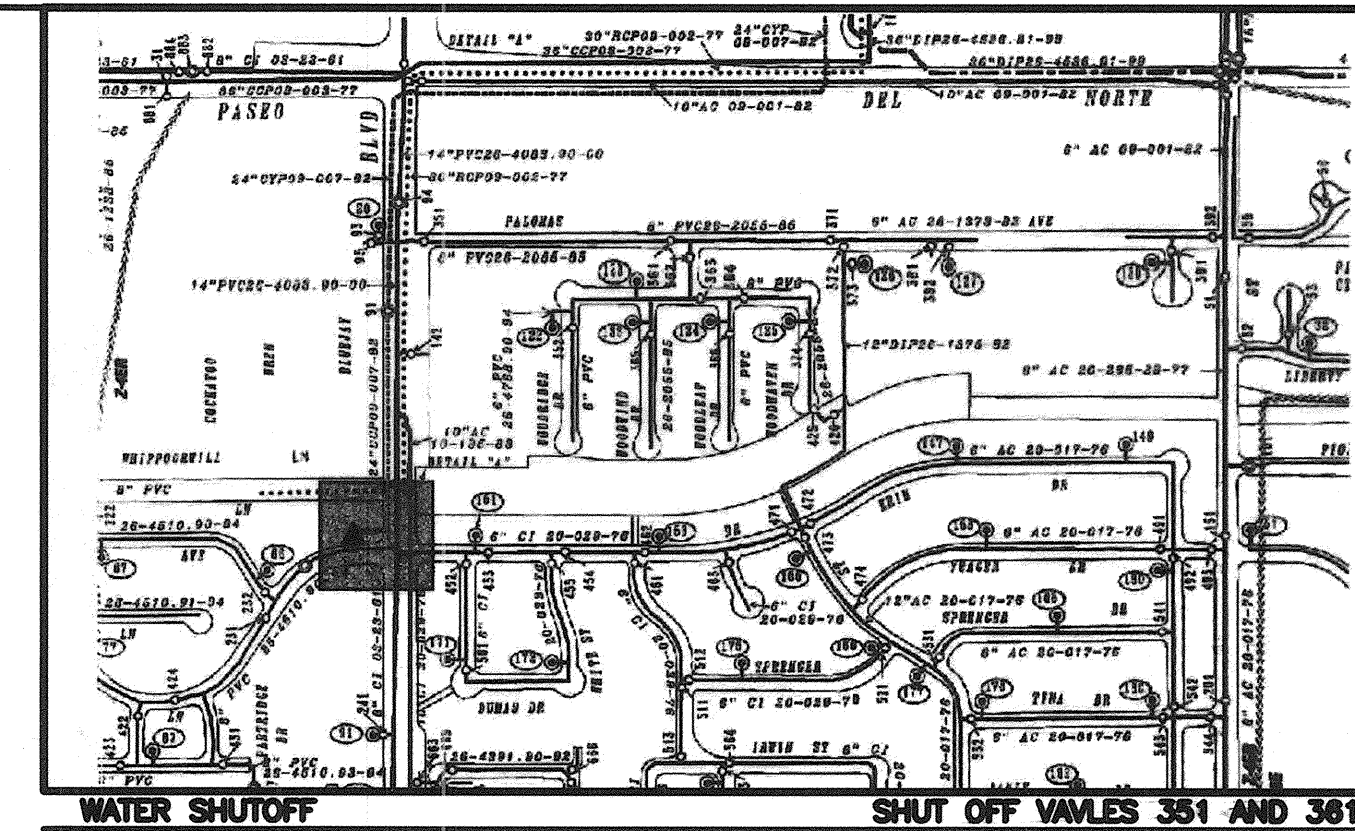

- ## LEGEND

     
- | | |
|---|------------------------------|
|  | EXISTING SAS MANHOLE |
| — EX. 8" SAS — | EXISTING SANITARY SEWER LINE |
|  | PROPOSED SANITARY SEWER LINE |
|  | EXISTING METER |
|  | EXISTING VALVE W/BOX |
|  | EXISTING FIRE HYDRANT |
| — EX. 16" WL — | EXISTING WATER LINE |
|  | PROPOSED METER |
|  | PROPOSED VALVE W/BOX |
|  | PROPOSED FIRE HYDRANT |
|  | PROPOSED WATER LINE |
|  | EXISTING STORM SEWER MANHOLE |
|  | EXISTING STORM SEWER INLET |
| — EX. 24" RCP — | EXISTING STORM SEWER LINE |
| — 24" RCP — | PROPOSED STORM SEWER LINE |
|  | EXISTING CURB & GUTTER |
|  | PROPOSED CURB & GUTTER |
|  | BOUNDARY LINE |
| — — — — — | EASEMENT |
|  | PROPOSED SIDEWALK |
|  | EXISTING SIDEWALK |
| — — — — — | LANE |
|  | STRIPING |
|  | EXISTING POWER POLE |
|  | PROPOSED POWER POLE |

NOTE:
IN WORK AREAS, ALL EXISTING MANHOLE RIMS,
METER AND VALVE BOX RIMS MUST BE ADJUSTED
TO FINAL GRADE PER COA STD. DWG'S 2328,
2368 & 2460.

1. EXISTING FIRE HYDRANT.
2. PNM TO REMOVE AND RELOCATE EXISTING POWER POLES AND CONDUCTORS.
3. EXISTING 2" METER BOX AND 2" SERVICE LINE PER COA STD DWG #2363.
4. EXISTING 1" METER BOX AND 1" SERVICE LINE.

1. 4' MINIMUM BURY REQUIRED FOR ALL UTILITIES UNLESS OTHERWISE NOTED.
2. REFERENCE ARCHITECTURAL PLANS FOR WATER LINE RISER LOCATIONS.
3. CLEAN OUTS ARE TO BE BUILT PER UNIFORM PLUMBING CODE STANDARDS. CLEAN OUTS TO BE BUILT WITH BUILDING PERMIT.
4. ALL RESTRAINT JOINT IS PER CITY OF ALBUQUERQUE STANDARD DWG. 2340.
5. ALL PLUMBING PIPE MATERIAL TO BE USED PER UPC.
6. FIRE LINE AND DOMESTIC WATERLINE MUST HAVE BACKFLOW PREVENTORS PER UPC. IF BACKFLOW PREVENTOR IS INSTALLED EXTERIOR OF BUILDING A HOT BOX SHALL BE INSTALLED AND USED.
7. REMOVE AND REPLACE EXISTING ARTERIAL PAVING PER COA STD DWG #2465. TYPICAL AT ALL UTILITY CONNECTIONS IN R.O.W.
8. ALL EXCAVATION, TRENCHING AND SHORING ACTIVITIES MUST BE CARRIED-OUT IN ACCORDANCE WITH OSHA 29 CFR 1926.650 SUBPART P.
9. ALL WORK IN ROW TO BE PART OF WORK ORDER.

RECORD DRAWING

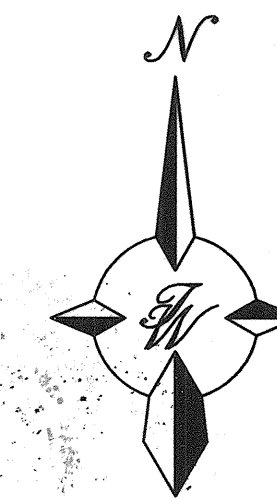

CAUTION:
EXISTING UTILITIES ARE NOT SHOWN.
IT SHALL BE THE SOLE RESPONSIBILITY
OF THE CONTRACTOR TO CONDUCT ALL
NECESSARY FIELD INVESTIGATIONS PRIOR
TO ANY EXCAVATION TO DETERMINE THE
ACTUAL LOCATION OF UTILITIES & OTHER
IMPROVEMENTS.

CONTRACTOR TO POT HOLE AND VERIFY
EXISTING SAS INVERTS PRIOR TO
CONSTRUCTION.

ENGINEER'S SEAL				SURVEY INFORMATION		BENCH MARKS		AS BUILT INFORMATION			
				FIELD NOTES		NO. DATE BY		CONTRACTOR			
								WORK STATIONED BY GEO. SURV. CO. ACCEPTANCE BY GEO. INC.			
				AGS 7-C19, 1999				COAST/TV DATE 2008 COAST/TV DATE 2008 TERRA WEST DATE 2008			
				NM STATE PLANE COORDINATES Central Zone N.A.D. 1927 X=410,171.36 Y=1,522,006.02				MICRO-FILM INFORMATION RECORDED BY DATE			
DESIGNED BY: BW				DATE: 07-17-06							
DRAWN BY: DY				DATE: 07-17-06							
DRAWING NAME: 2610-SH10-PALOMAS-UT				JOB NO.: 26010							
CHECKED BY: RRB				DATE: 07-17-06							

TIERRA WEST, LLC
5571 MIDWAY PARK PLACE NE
ALBUQUERQUE, NM 87109
(505)858-3100

CITY OF ALBUQUERQUE
PUBLIC WORKS DEPARTMENT
ENGINEERING GROUP

TITLE: ***PALOMAS AVENUE***
EXISTING UTILITY IMPROVEMENTS

DESIGN REVIEW COMMITTEE

APPROVE

MAR - 9 2007

DESIGN REVIEW COMMITTEE






CITY ENGINEER APPROVAL
APPROVED
MAR 30 2007
CITY ENGINEER

LAST DESIGN UPDATE	MO./DAY/YR.	MO./DAY/YR.

CITY PROJECT NO.



ZONE MAP NO.	
--------------	--

SHEET 10 OF 11

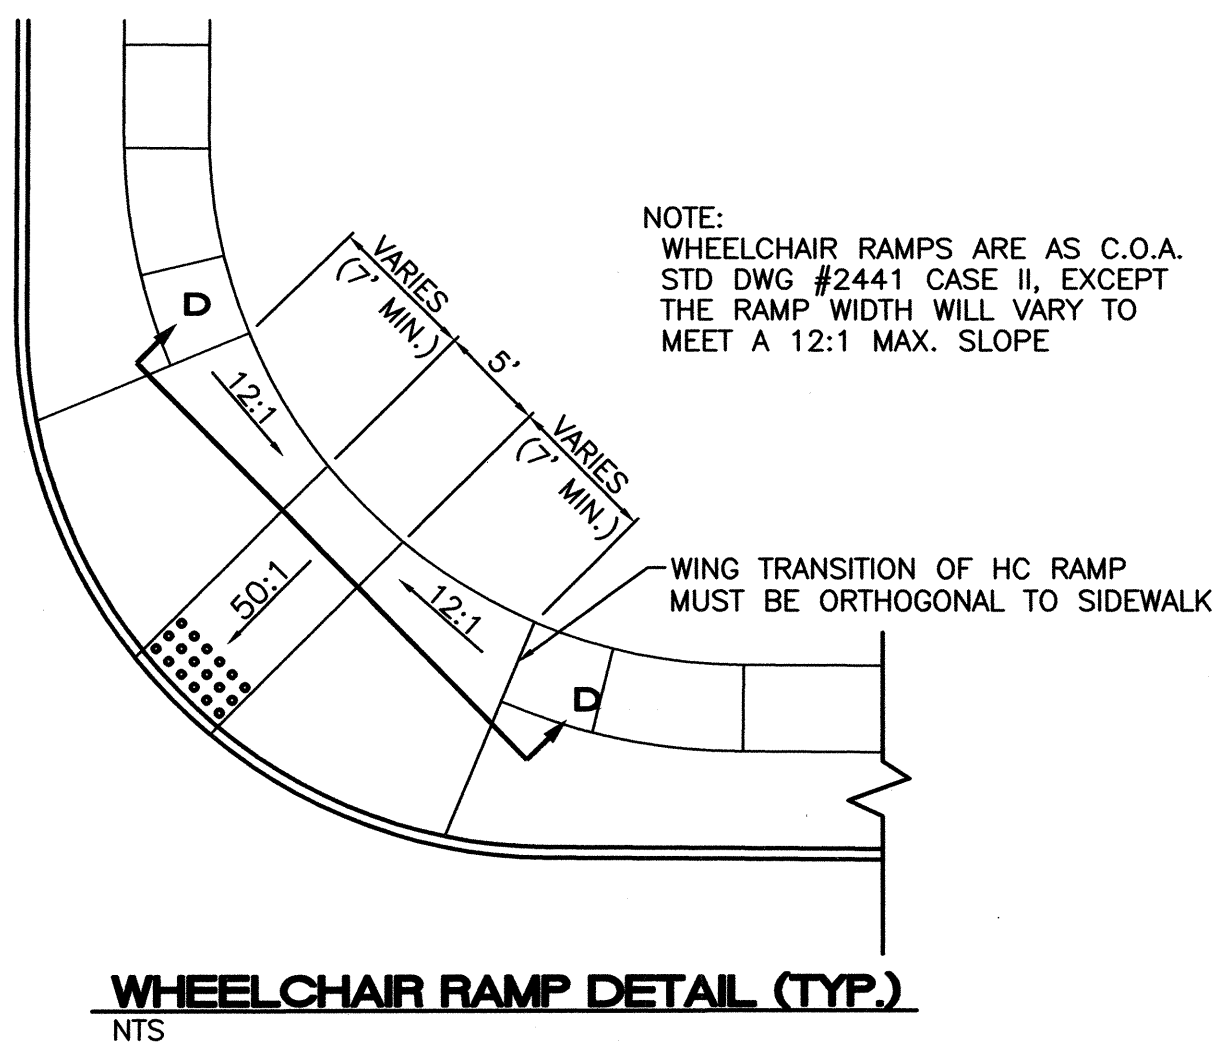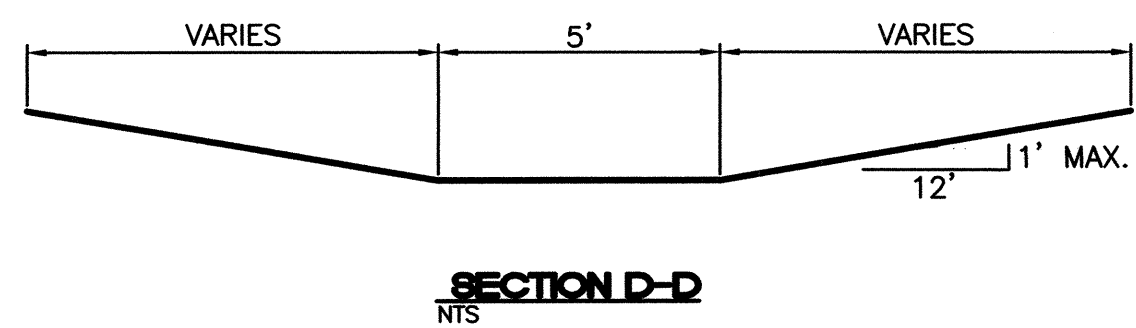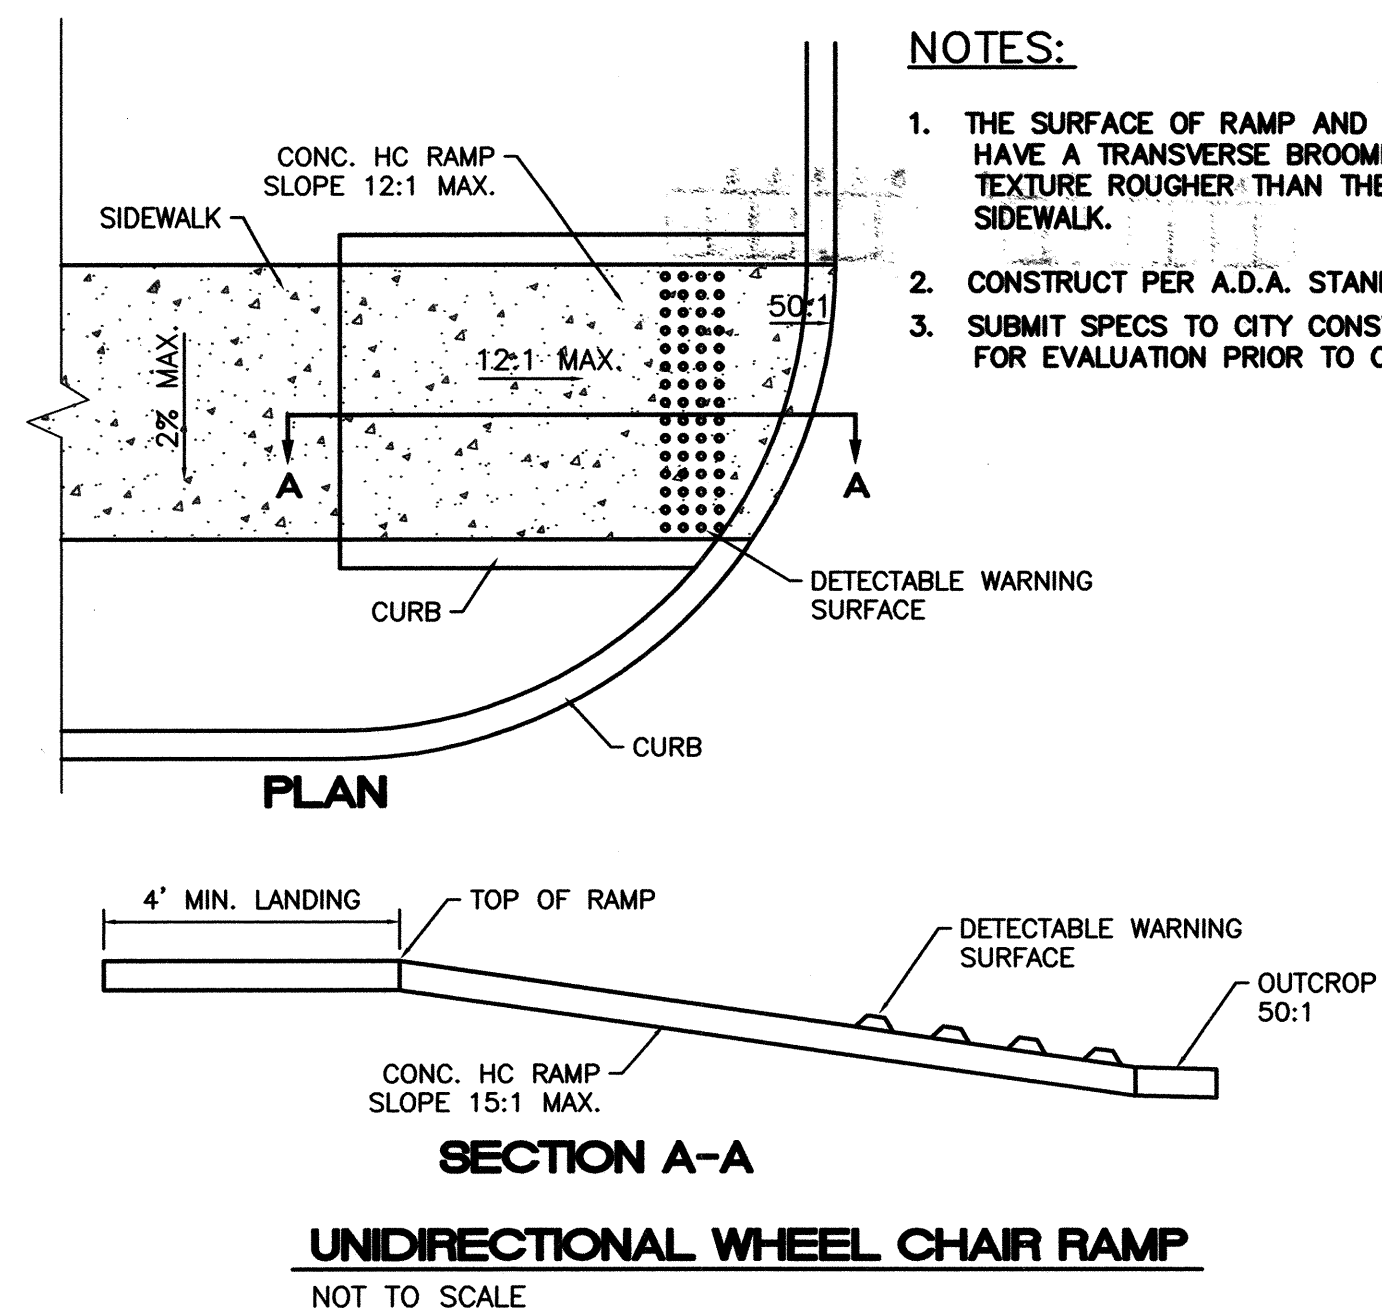


- NOTES:


1. THE SURFACE OF RAMP AND SIDES SHALL HAVE A TRANSVERSE BROOMED SURFACE TEXTURE ROUGHER THAN THE SURROUNDING SIDEWALK.
2. CONSTRUCT PER A.D.A. STANDARDS.
3. SUBMIT SPECS TO CITY CONSTRUCTION ENGINEER FOR EVALUATION PRIOR TO CONSTRUCTION.

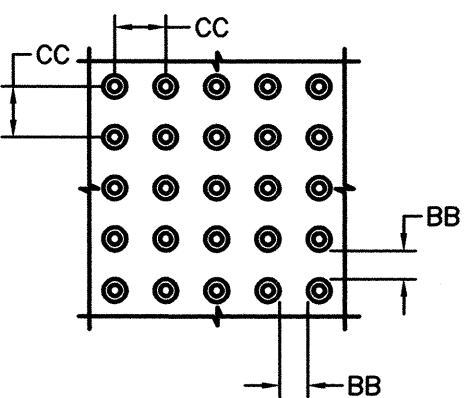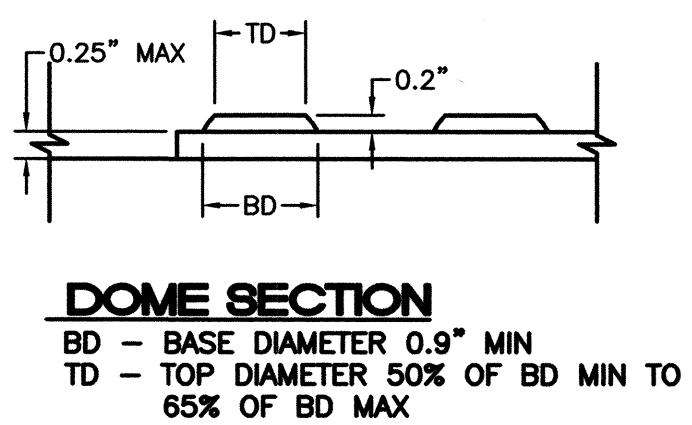


DOME SPACING
CC – CENTER TO CENTER SPACING
2.35"
BB – BASE TO BASE SPACING
1.48" MIN

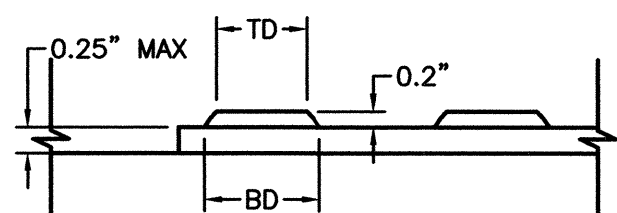

DOMES SECTION
BD - BASE DIAMETER 0.9" MIN
TD - TOP DIAMETER 50% OF BD MIN TO
65% OF BD MAX

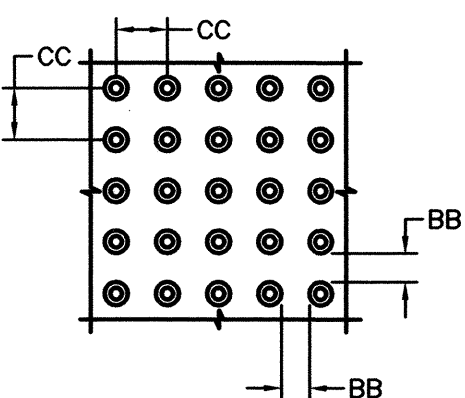

DOME SPACING
CC – CENTER TO CENTER SPACING
2.35"
BB – BASE TO BASE SPACING
1.48" MIN

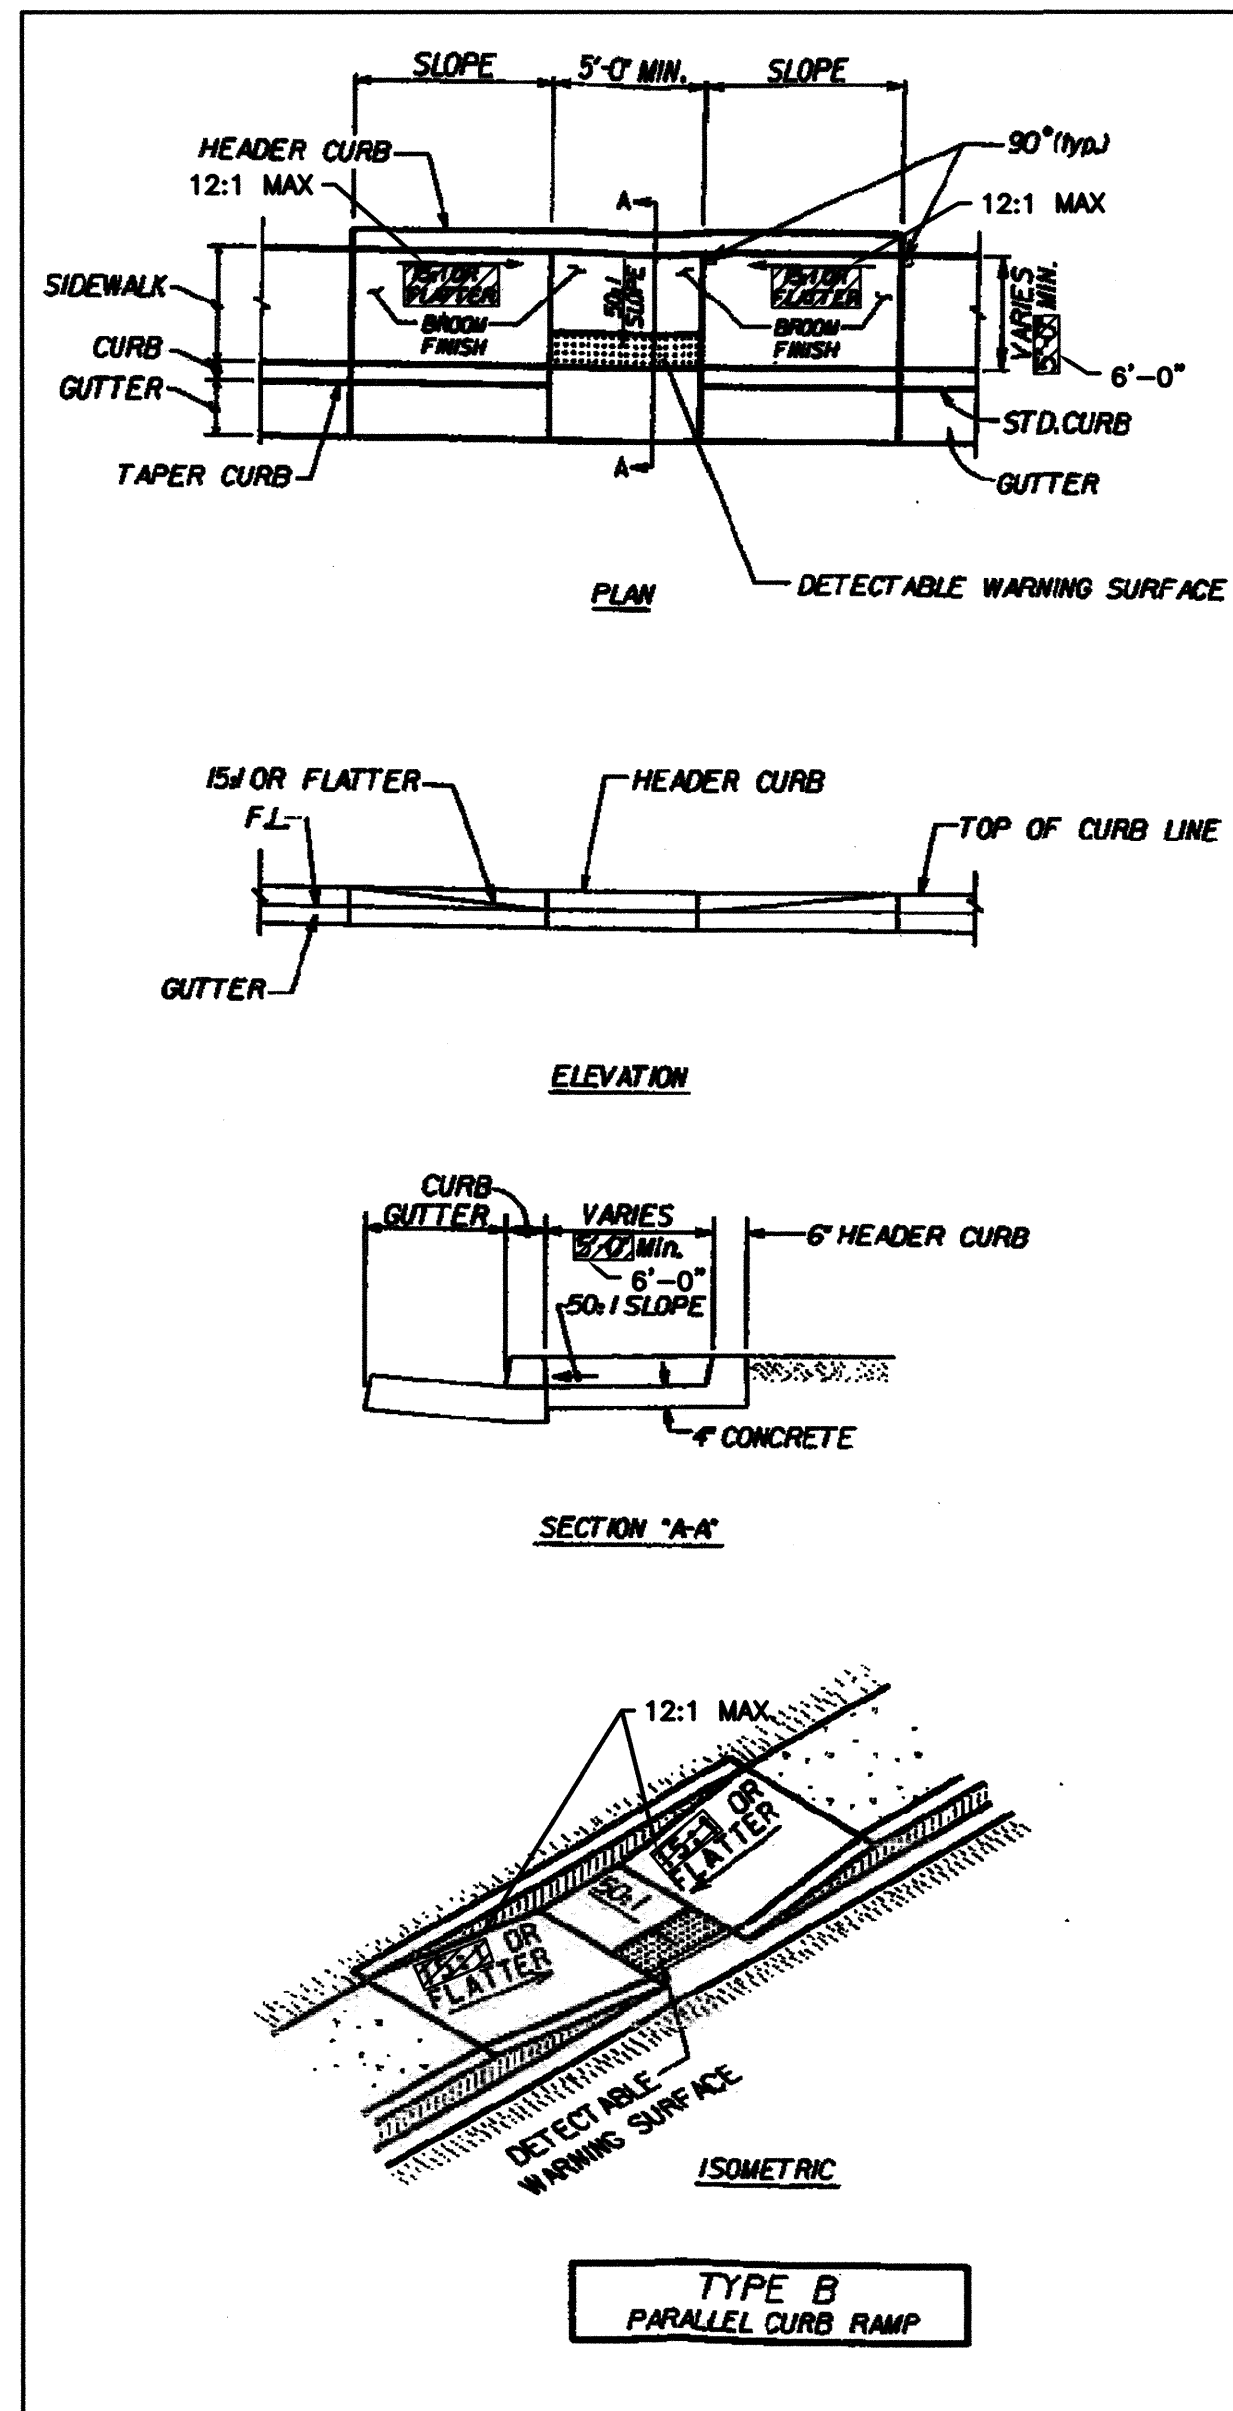

PARRALLEL CURB RAMP (PALOMAS AVE. N.E.)
NOT TO SCALE

CERTIFICATE OF SUBSTANTIAL COMPLIANCE ON PLANS

I, **Ronald R. Bohannon**, the firm of **Tierra Vista LLC**, a Registered Professional Engineer in the State of New Mexico, do hereby certify, to the best of my knowledge and belief, that the infrastructure installed as part of this project, has been inspected by me or by a qualified person under my direct supervision and has been constructed in accordance with the plans and specifications approved by the City Engineer and that the original design intent of the approved plans has been met, except as noted by me on the as-built construction drawings. This Certification is based on site inspections by me, or personnel under my direction with survey information provided by **David Vigil** of **Geo-Surv Co.**, NMPS number **8911**.



RECORD DRAWING

TIERRA WEST, LLC
5571 MIDWAY PARK PLACE NE
ALBUQUERQUE, NM 87109
(505)858-3100

CITY OF ALBUQUERQUE
PUBLIC WORKS DEPARTMENT
ENGINEERING GROUP

TITLE: **PASEO CROSSING SHOPPING CENTER**
DETAIL SHEET

DESIGN REVIEW COMMITTEE
APPROVED
MAR - 9 2007
DESIGN REVIEW COMMITTEE

CITY ENGINEER APPROVAL

APPROVED

MAR 30 2007

CITY ENGINEER

LAST DESIGN UPDATE

--	--	--	--	--	--

MO.

./DAY,

/ YR.

MO.,

/ DAY /

YR.

10\Drawings\Construction\2610-SH1