
SCANNED BY PLANNING

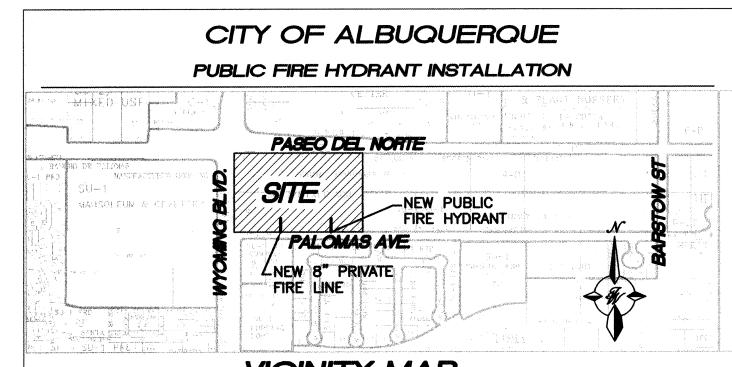

## VICINITY MAP

LEGAL DESCRIPTION OF PROPERTY AND ADDRESS:

LOT 28-A, BLOCK 21, TRACT A, UNIT A

NORTH ALBUQUERQUE ACRES


## 8000 PASEO DEL NORTE BLVD. ALBUQUERQUE, NM, 87113


 An excavation/barricade permit will be required before beginning any work within City, County, or Village right—of—way. An approved copy of these plans must be submitted at the time of application for these permits.


NOTICE TO CONTRACTORS


- 2. All work detailed on these plans to be done, except as otherwise stated or provided hereon, will be constructed in accordance with "City of Albuquerque Interim Standard Specification for Public Works Construction, 1986," latest revision.
- 3. Two working days prior to any excavation, the contractor must contact Line Locating Service, 260—1990, for location of existing utilities.
- 4. Prior to construction, the contractor will excavate and verify the horizontal and vertical locations of all construction. Should a conflict exist, the contractor will notify the Construction Engineer so that the conflict can be resolved with a minimum amount of delay.
- 5. The contractor will be responsible for coordinating the water shutoff with the Water Division seven working days prior to construction.
- 6. The contractor will be responsible for performing soil density tests as required


APPROVALS FOR	NAME	DATE	TITLE OF PROJECT:
<b>DESIGN:</b> UTILITY DEVELOPMENT	William g. Bulch	10/24/06	7868 ERF HYDRANT
CONSTRUCTIONS CONSTRUCTION ENGINEER AS-BULT	3 He	12/29/2006	
ACCEPTANCE:	Orlando	,	PROJECT NO. 785682 ZONE ATLA
CONSTRUCTION INSPECTOR	Benevilay Ju	12/11/06	SHEET 1 OF 6 D-19-Z

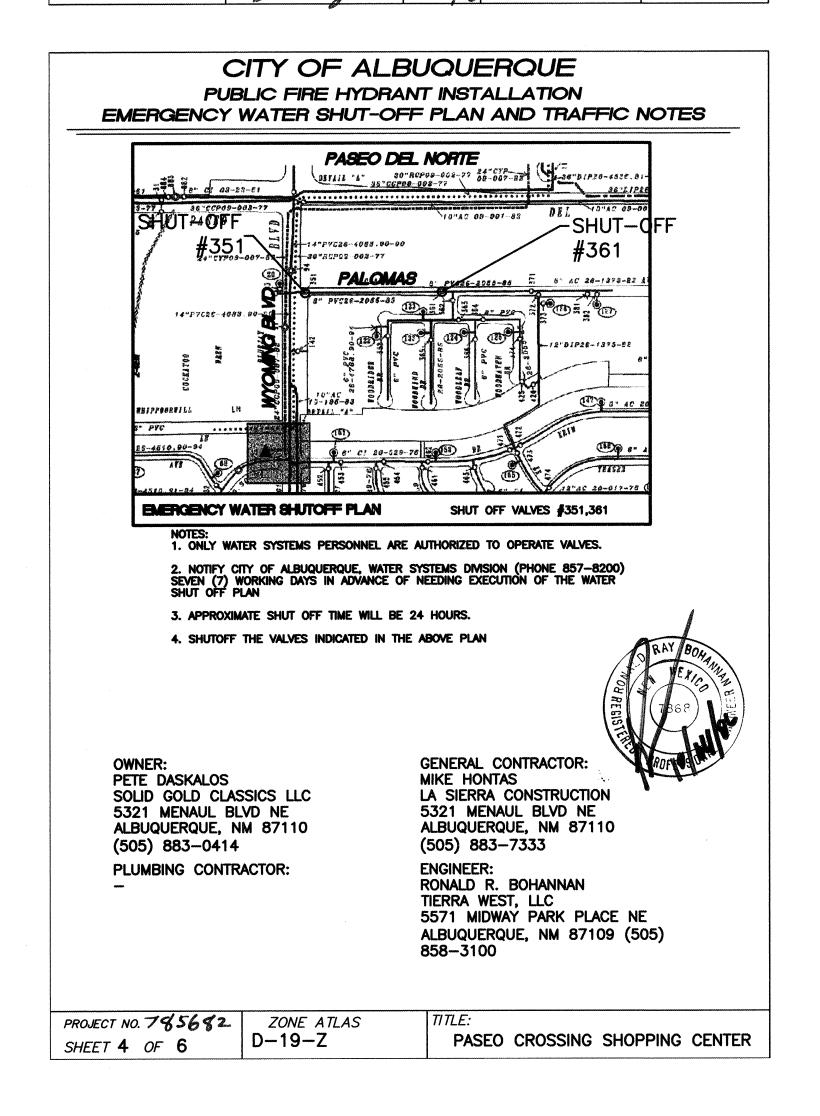

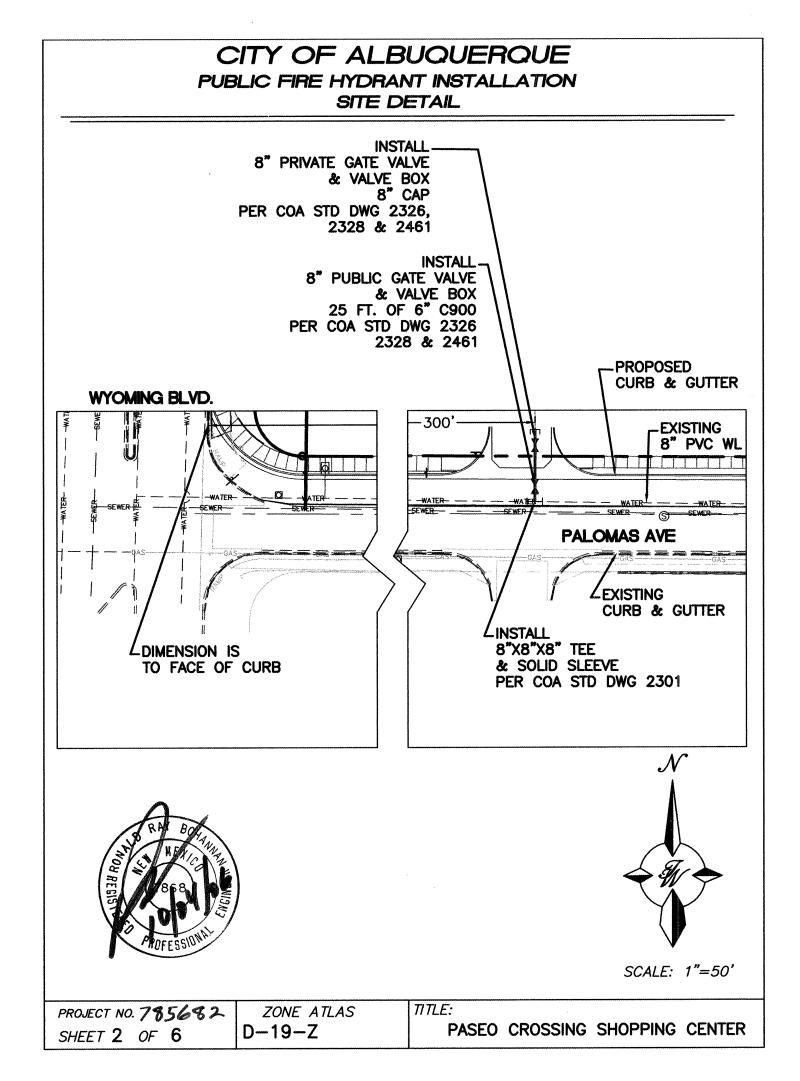

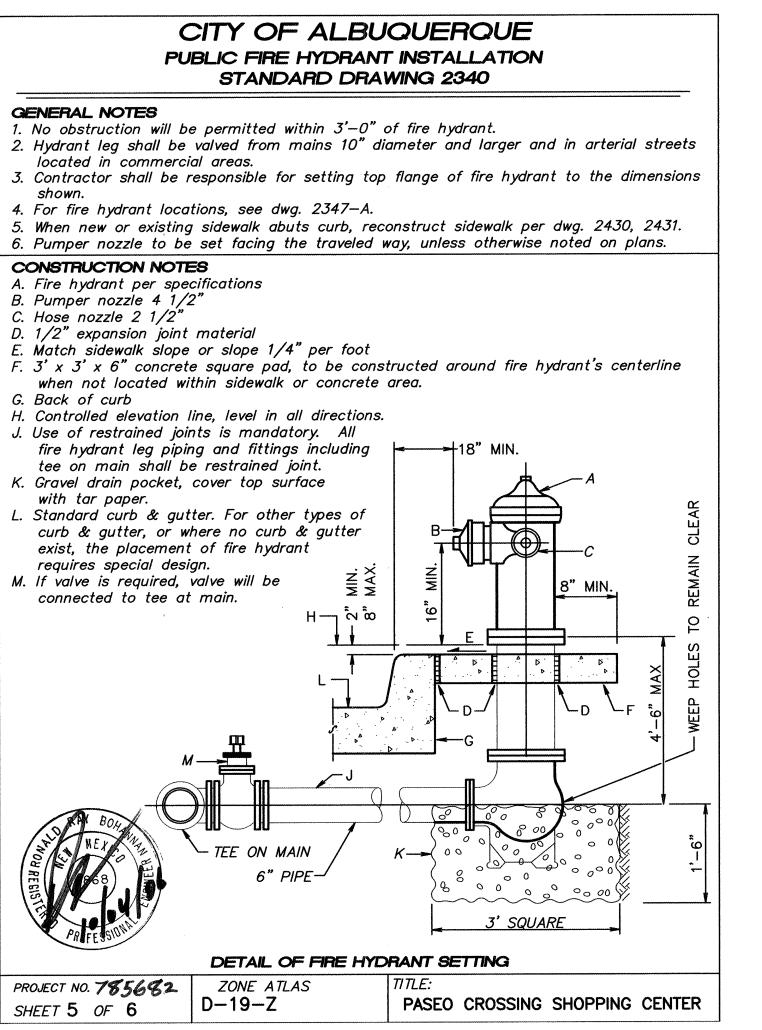

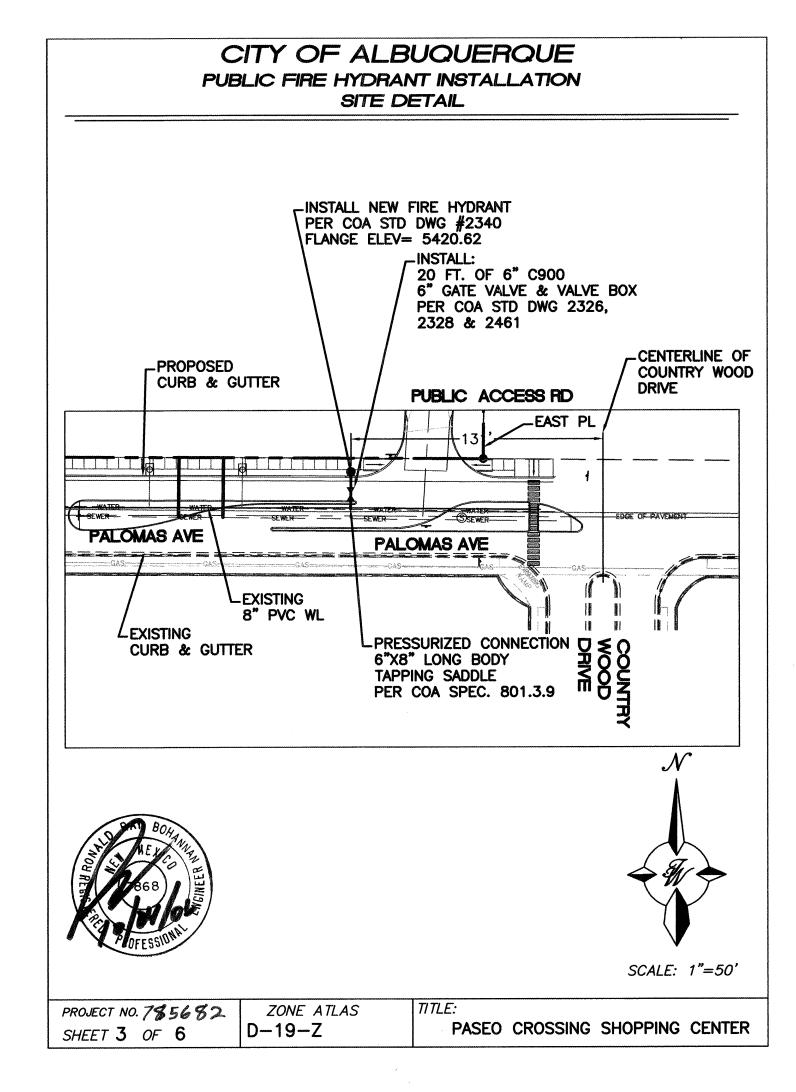

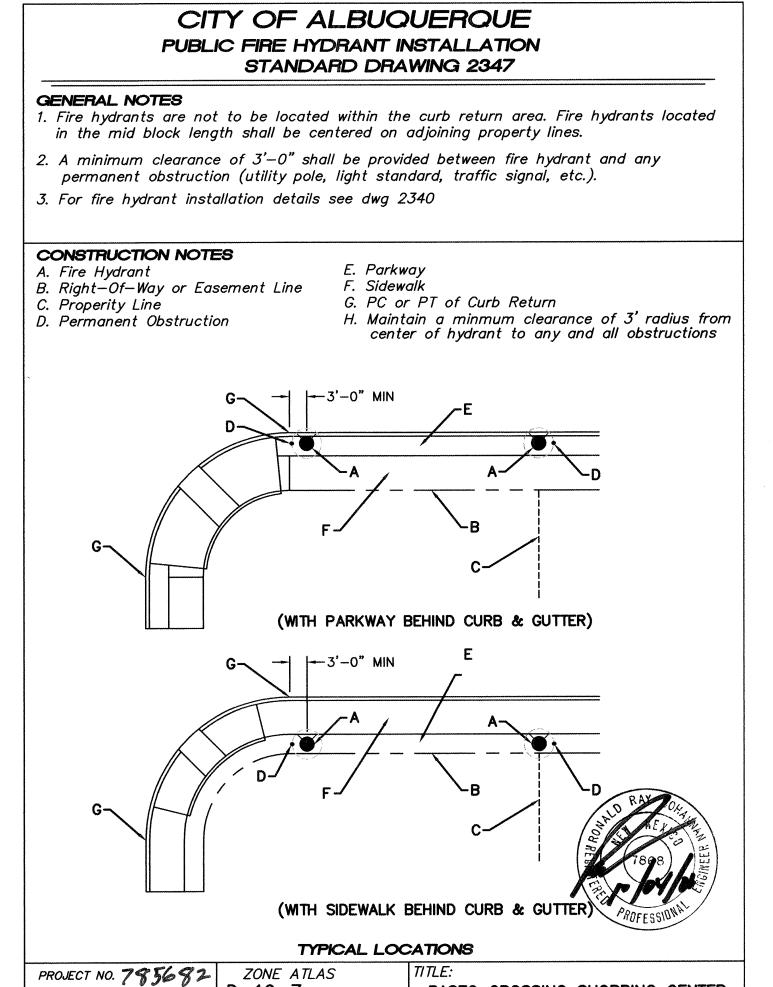

PASEO CROSSING SHOPPING CENTER

D-19-Z

SHEET 6 OF 6