


IRRIGATION LEGEND for FOC #1		
	WATER METER, 1", INSTALLED PER COA DWG. 2362 OR 2363.	
	IRRIGATION SERVICE LINE, 28" DEPTH OF BURY.	
	IRRIGATION MAIN LINE, SCH 40 BELL END, SOLVENT WELD PVC. DEPTH OF BURY SHALL BE 28" AT CONSTANT PRESSURE MAIN LINE, 18" DEPTH OF BURY AT NON-CONSTANT PRESSURE MAIN LINE. SIZE PER PLAN.	
	LATERAL PIPING, SCH. 40, BELL END, SOLVENT WELD PVC. DEPTH OF BURY, 18". SIZE PER PLAN.	
	MAIN LINE AND LATERAL SLEEVE PIPING, 2 SIZES LARGER THAN PIPE SIZE, CLASS 200, SDR-21, BELL-END, SOLVENT WELD PVC. SLEEVES ARE TO BE BORED.	
	24-VOLT IRRIGATION WIRE SLEEVE PIPING, 2", CLASS 200, SDR-21, BELL-END, SOLVENT WELD PVC. SLEEVES ARE TO BE BORED.	
	ISOLATION VALVE	
	FEBCO 860-U 1" REDUCED PRESSURE PRINCIPAL BACKFLOW PREVENTER AND MASTER VALVE ASSEMBLY WITH BALL VALVES, INSTALLED IN HEATED AND INSULATED ENCLOSURE AND FLOW METER INSTALLED IN VALVE BOX PER DETAIL C/4. SIZE OF RP, MASTER VALVE, AND FLOW METER SHALL BE SAME AS LINE SIZE. ENCLOSURE SHALL BE SIZED TO ACCOMMODATE SIZE OF RP AND MASTER VALVE ASSEMBLY.	
	PRESSURE COMPENSATING BUBBLER ASSEMBLIES, RAIN BIRD 1400 SERIES, AS FOLLOWS: INSTALL PER C.O.A. DRAWING NUMBERS 2710, 2711, 2711-A AND 2712.	
	IRRINET M AC 12 STATION CONTROLLER.	
	ELECTRICAL SERVICE	



ASBUILT
5/18/2015

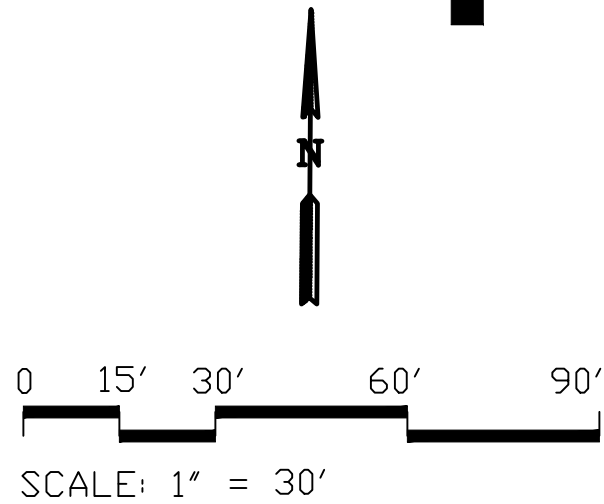







5604 Wilshire Ave NE
Albuquerque, NM 87113
(505)822-8722

CITY OF ALBUQUERQUE CAPITAL IMPLEMENTATION PROGRAM DEPARTMENT OF MUNICIPAL DEVELOPMENT				
PROTOTYPE MEDIAN AND INTERSTATE LANDSCAPES FY-14A COMANCHE: HAHN ARROYO TO LOUISIANA-WORK ORDER #9 IRRIGATION PLAN				
Design Review Committee	City Engineer Approval	Last Design Update	Mo./Day/Yr.	Mo./Day/Yr.
City Project No.		Zone Map No.		Sheet
785810		G18		2 OF 3


MATCHLINE C

MATCHLINE D

MATCHLINE E

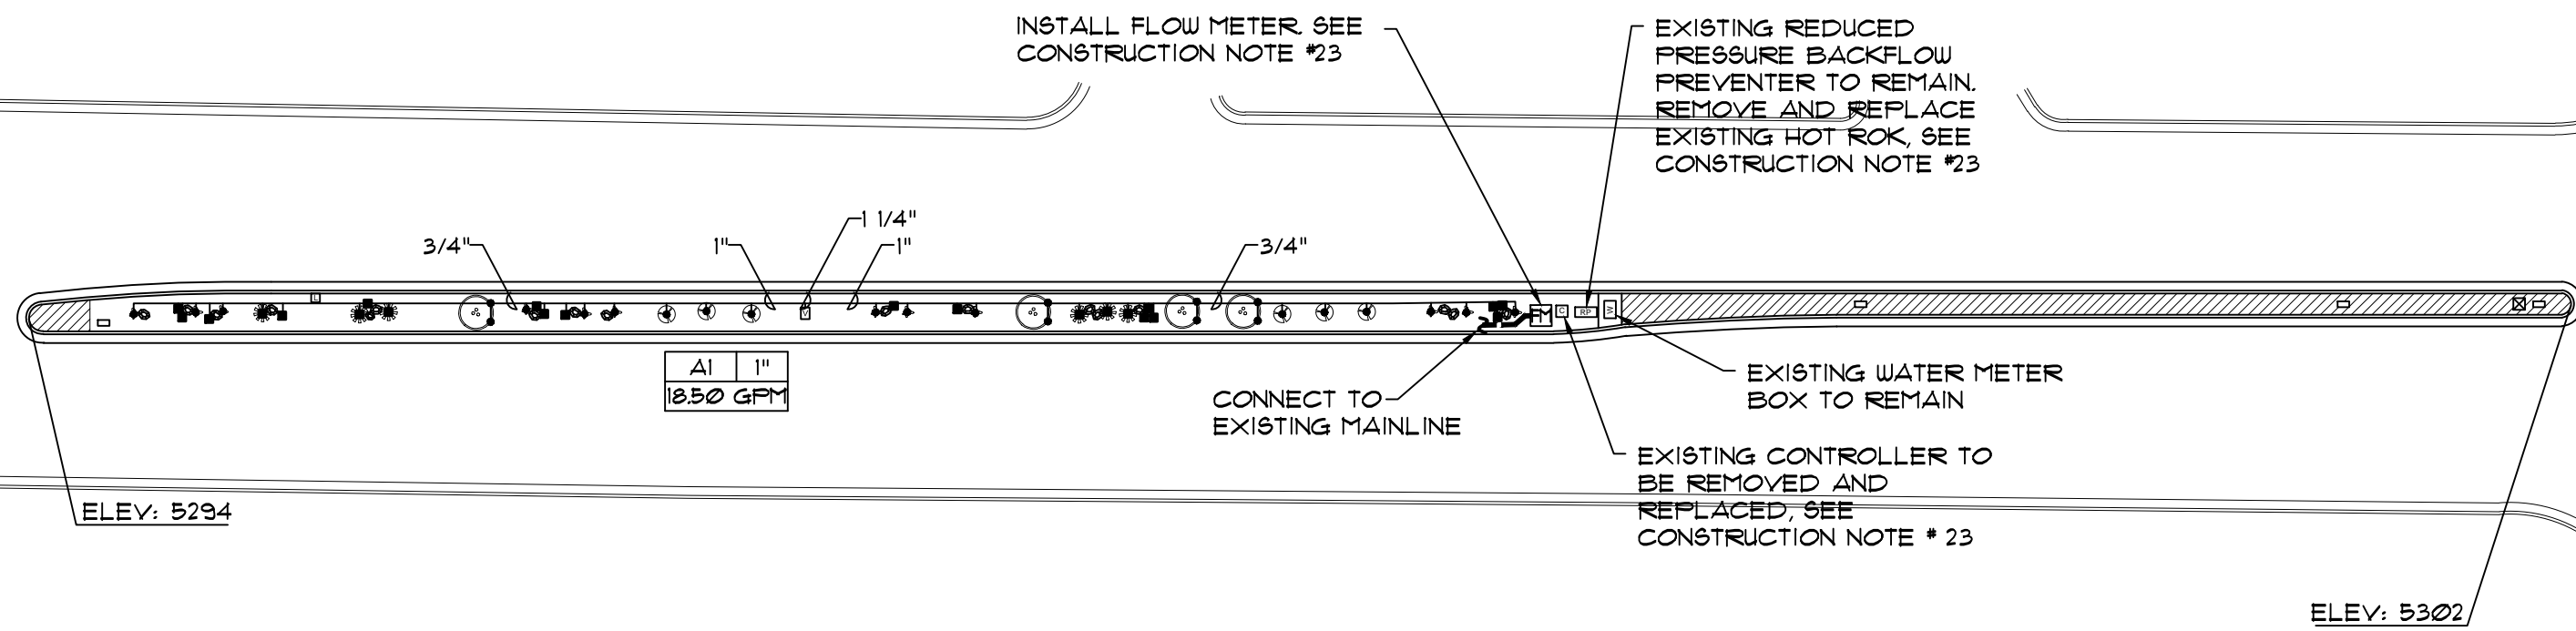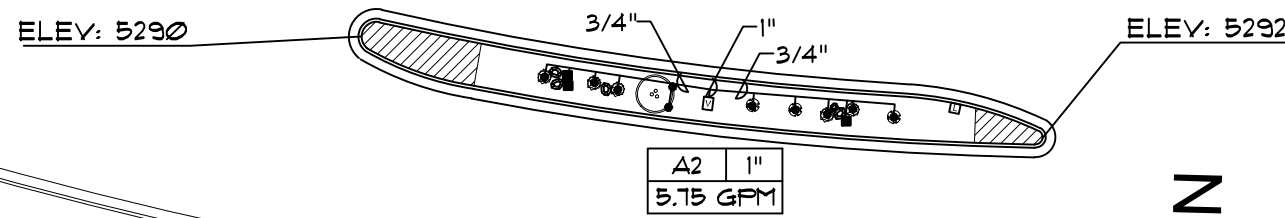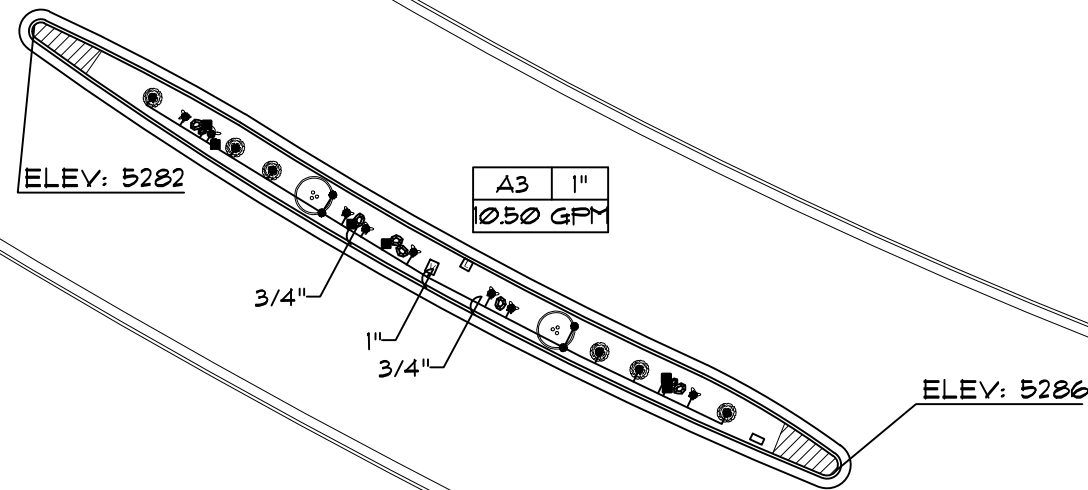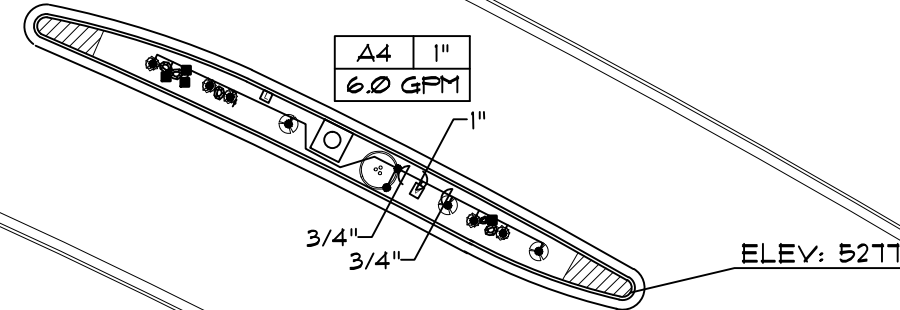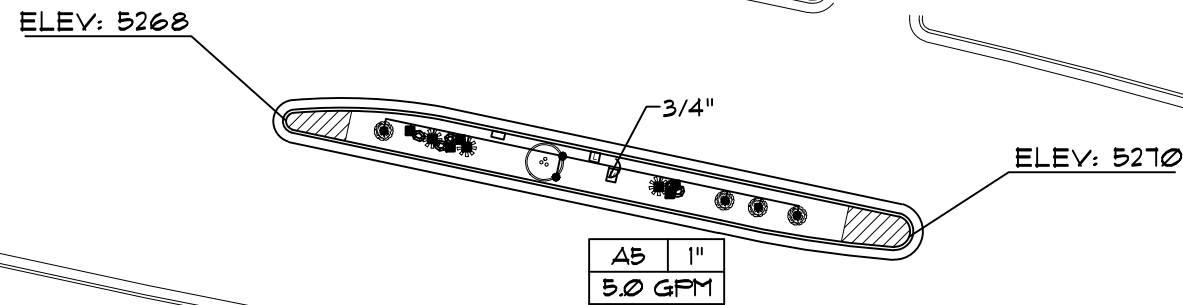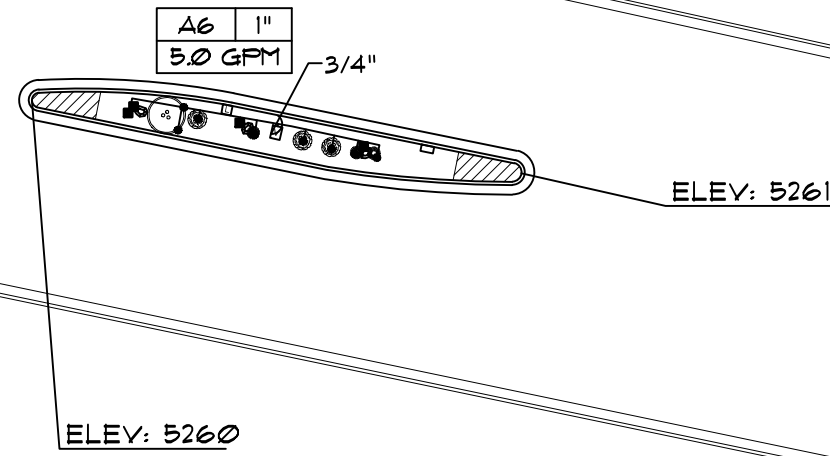

IRRIGATION LEGEND for POC #2			
-----	IRRIGATION MAIN LINE, SCH 40 BELL END, SOLVENT WELD PVC. DEPTH OF BURY SHALL BE 28" AT CONSTANT PRESSURE MAIN LINE, 18" DEPTH OF BURY AT NON-CONSTANT PRESSURE MAIN LINE. SIZE PER PLAN.		
---	LATERAL PIPING, SCH. 40, BELL END, SOLVENT WELD PVC. DEPTH OF BURY, 18". SIZE PER PLAN.		
■	PRESSURE COMPENSATING BUBBLER ASSEMBLIES, RAIN BIRD 1400 SERIES, AS FOLLOWS: INSTALL PER C.O.A. DRAWING NUMBERS 2710, 2711, 2711-A AND 2712.		
●	MODEL NO.	GPM	PSI
▲	1401	25	30
	1402	50	30
	1404	100	30
A	IRRINET M AC 12 STATION CONTROLLER.		
FM	FLOWMETER		

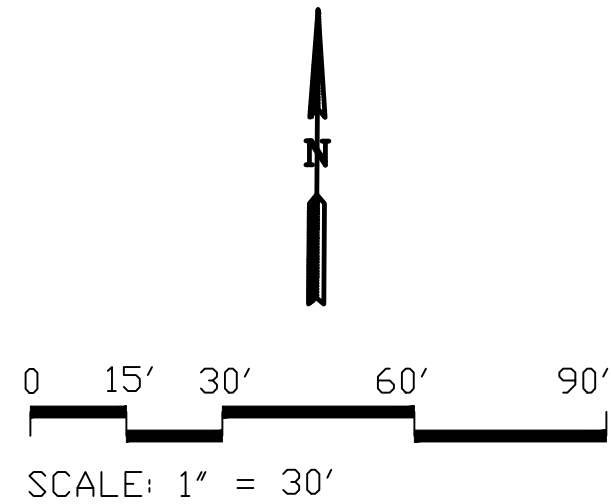

CALIFORNIA

DAKOTA

FLORIDA

MOSSMAN

LOUISIANA BLVD

ASBUILT
5/18/2015

 5604 Wilshire Ave NE
Albuquerque, NM 87113
(505)822-8722

CITY OF ALBUQUERQUE
CAPITAL IMPLEMENTATION PROGRAM
DEPARTMENT OF MUNICIPAL DEVELOPMENT

PROTOTYPE MEDIAN AND INTERSTATE LANDSCAPES FY-14A
COMANCHE: HAHN ARROYO TO LOUISIANA-WORK ORDER #9
IRRIGATION PLAN

Design Review Committee

City Engineer Approval

Last Design Update

Mo./Day/Yr.

Mo./Day/Yr.

City Project No.
785810

Zone Map No.
G18

Sheet
3 OF 3

ARCHITECTURAL SEAL		SURVEY INFORMATION		BENCH MARKS		AS-BUILT INFORMATION	
		FIELD NOTES					
		NO.	BY	DATE			
					WORK NO. BY	CONTRACTOR	DATE
					INSPECTOR'S		
					ACCEPTANCE BY		DATE
					DATE		
					VERIFICATION BY		DATE
					DRAWINGS	ML	DATE 5/18/15
					CORRECTED BY		
					MICRO-FILM INFORMATION		
					RECORDED BY		DATE
					NO.		