
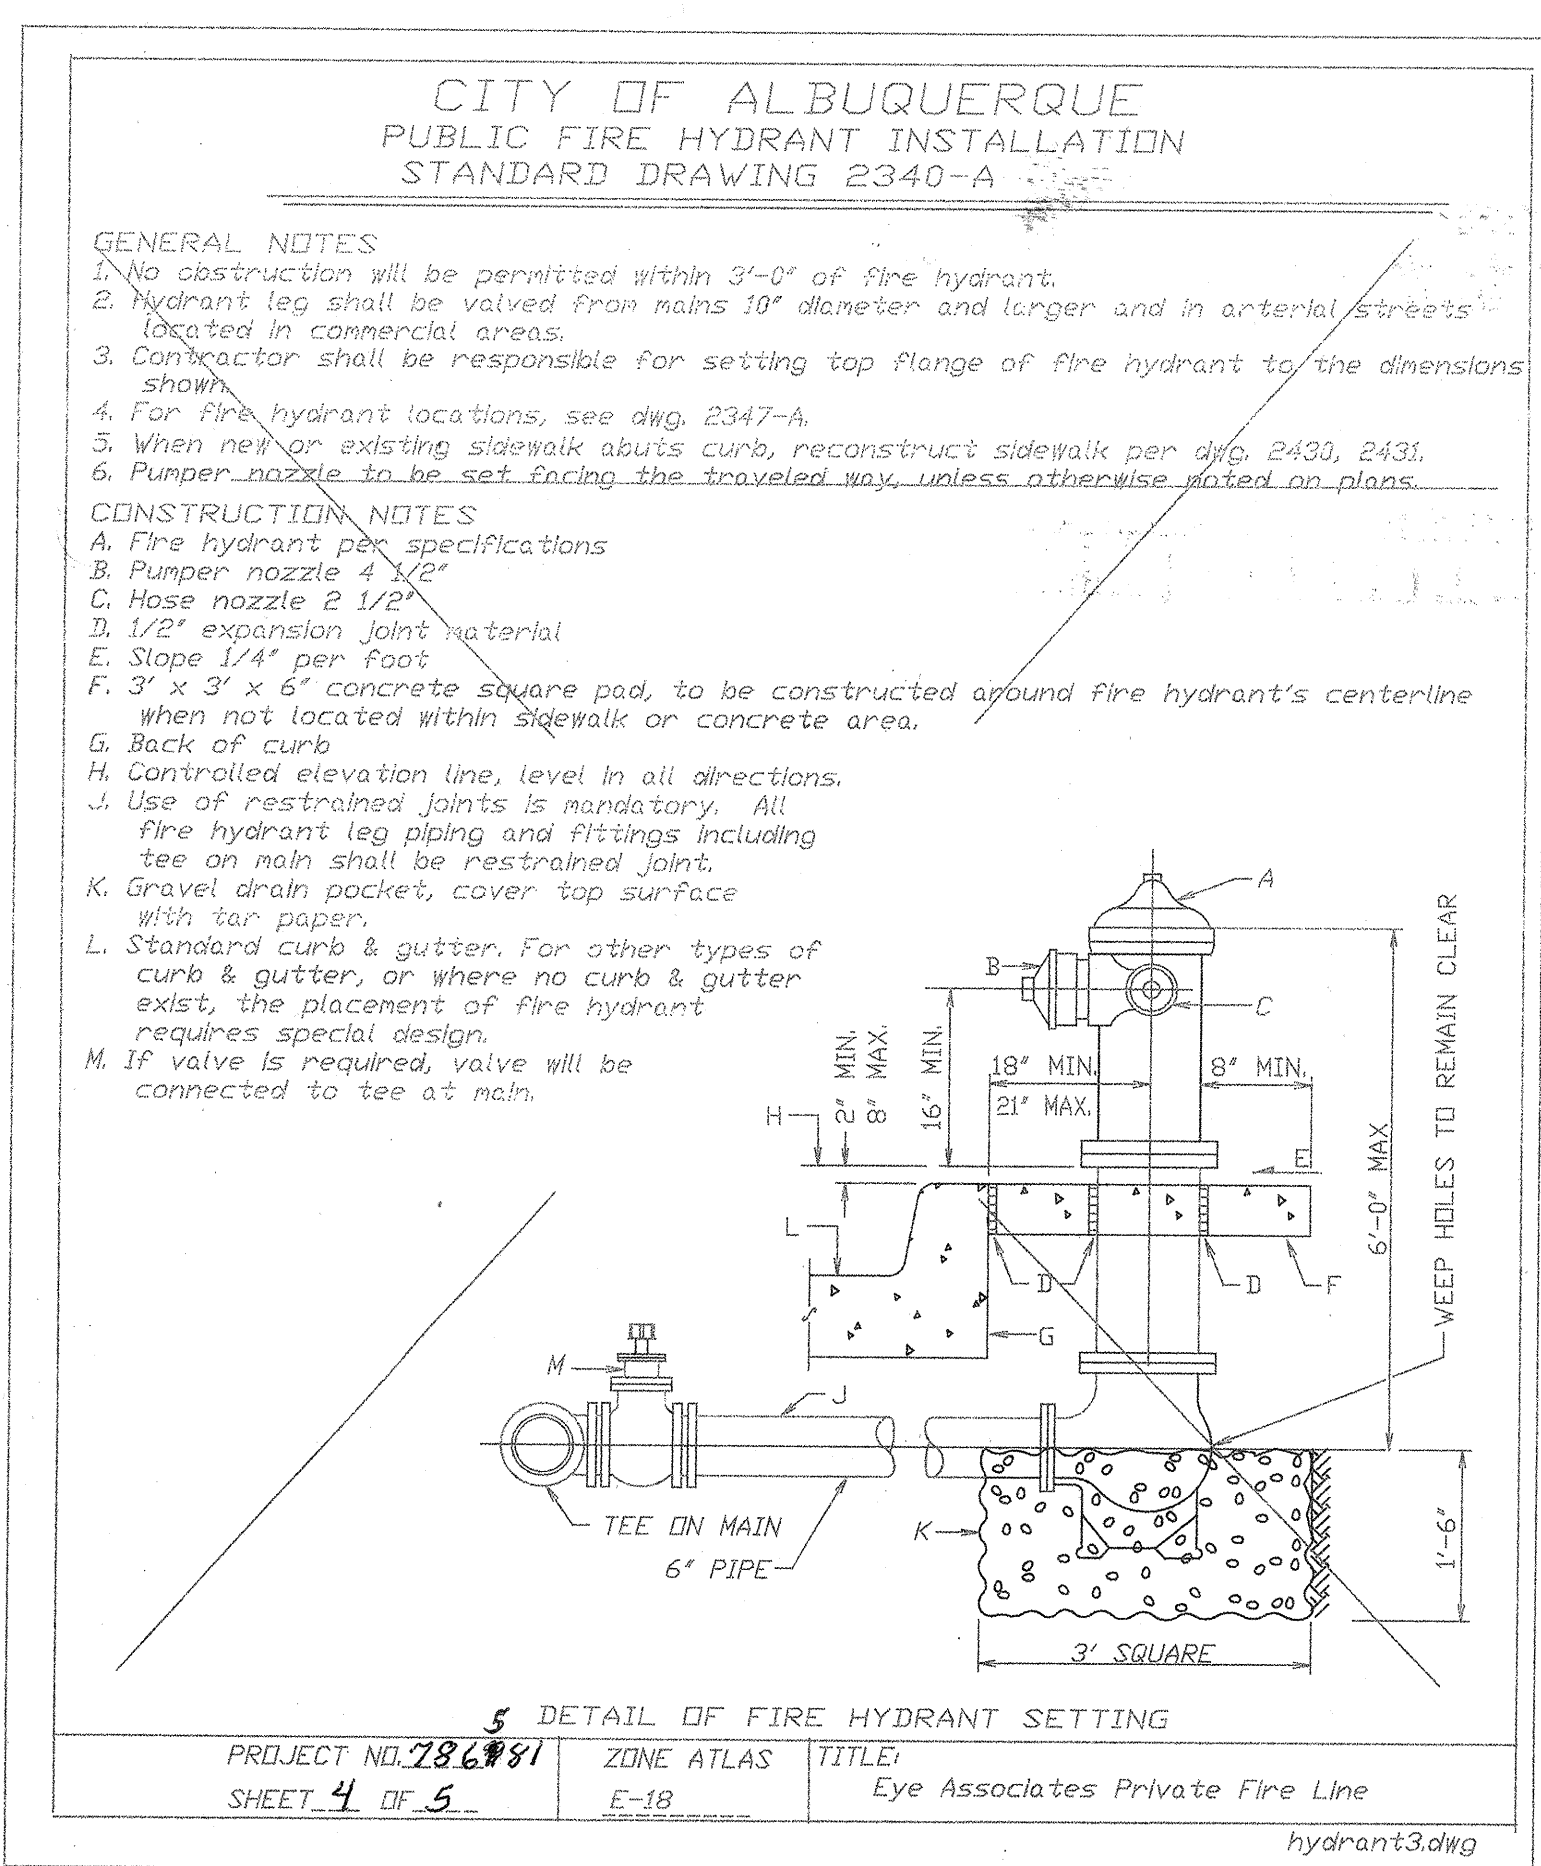
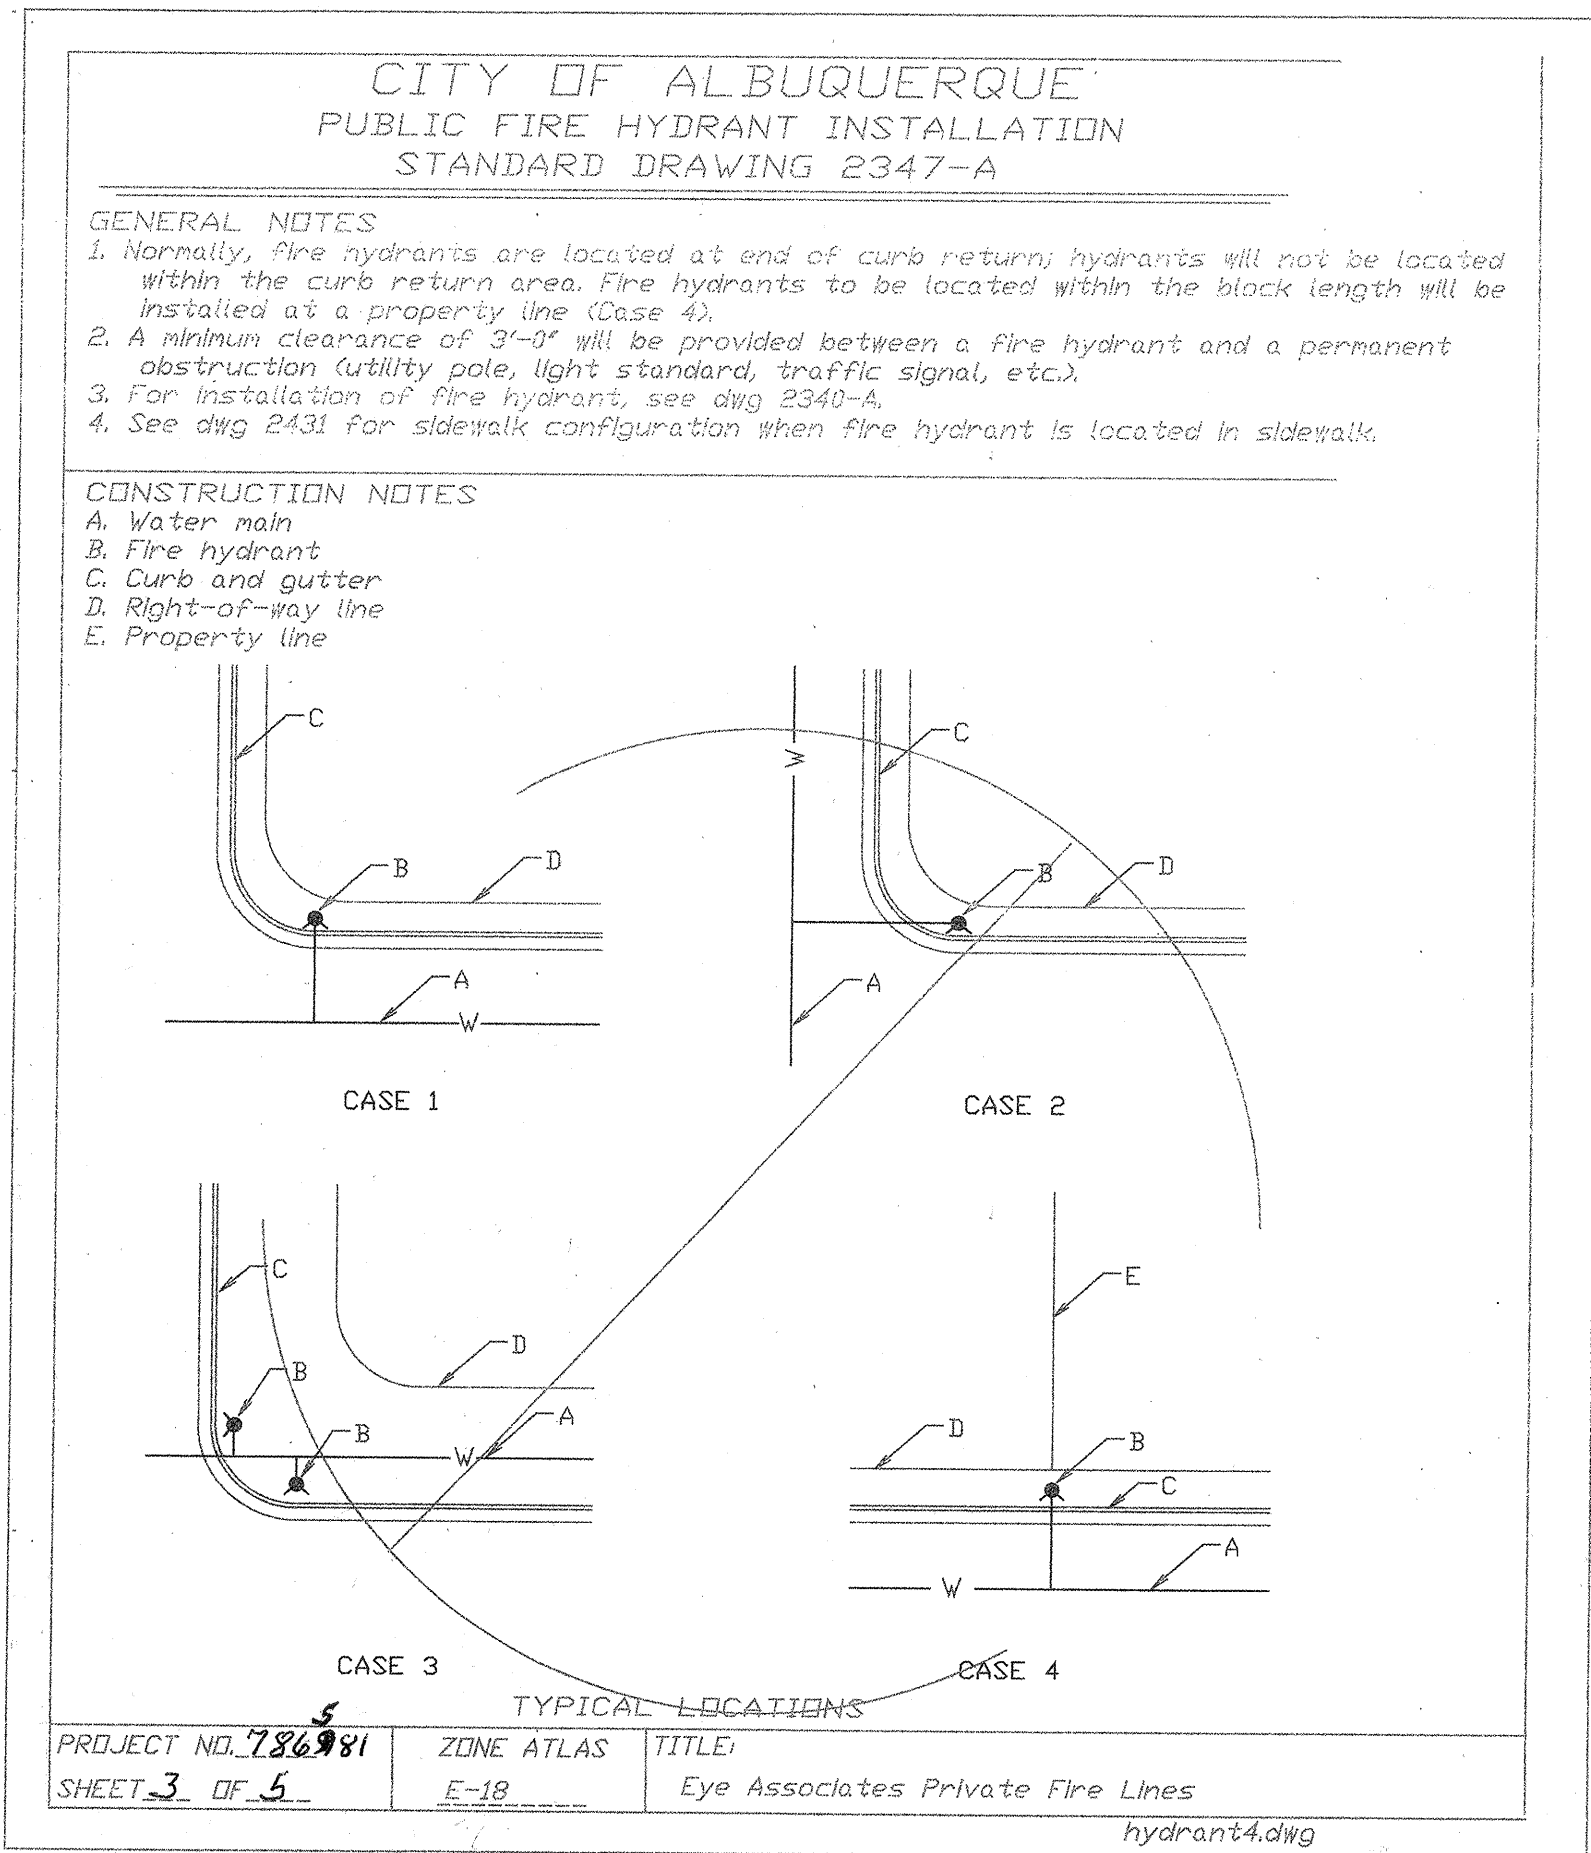
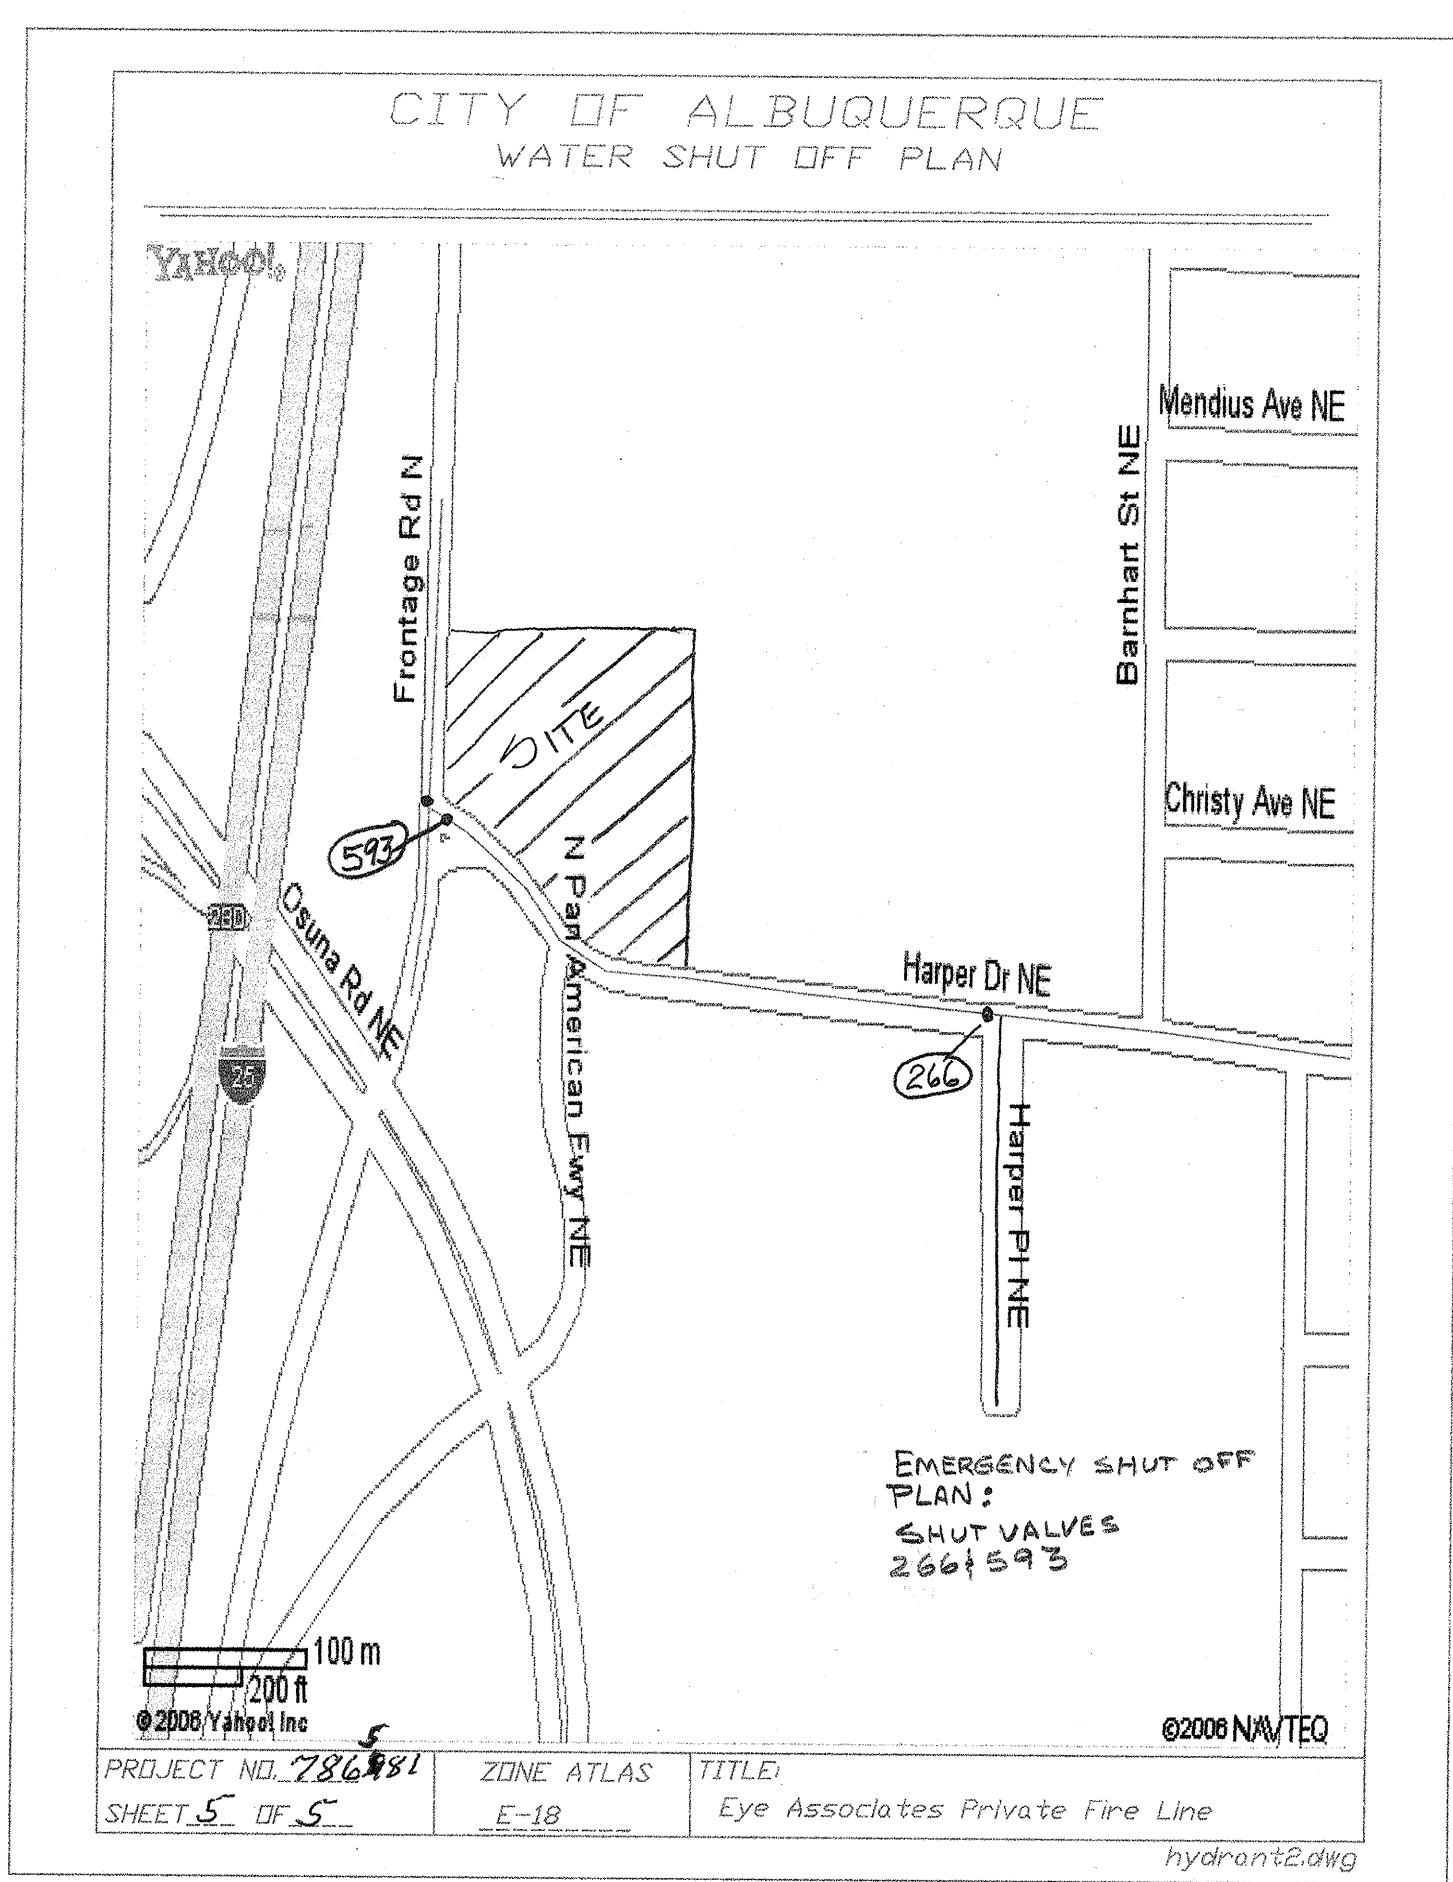
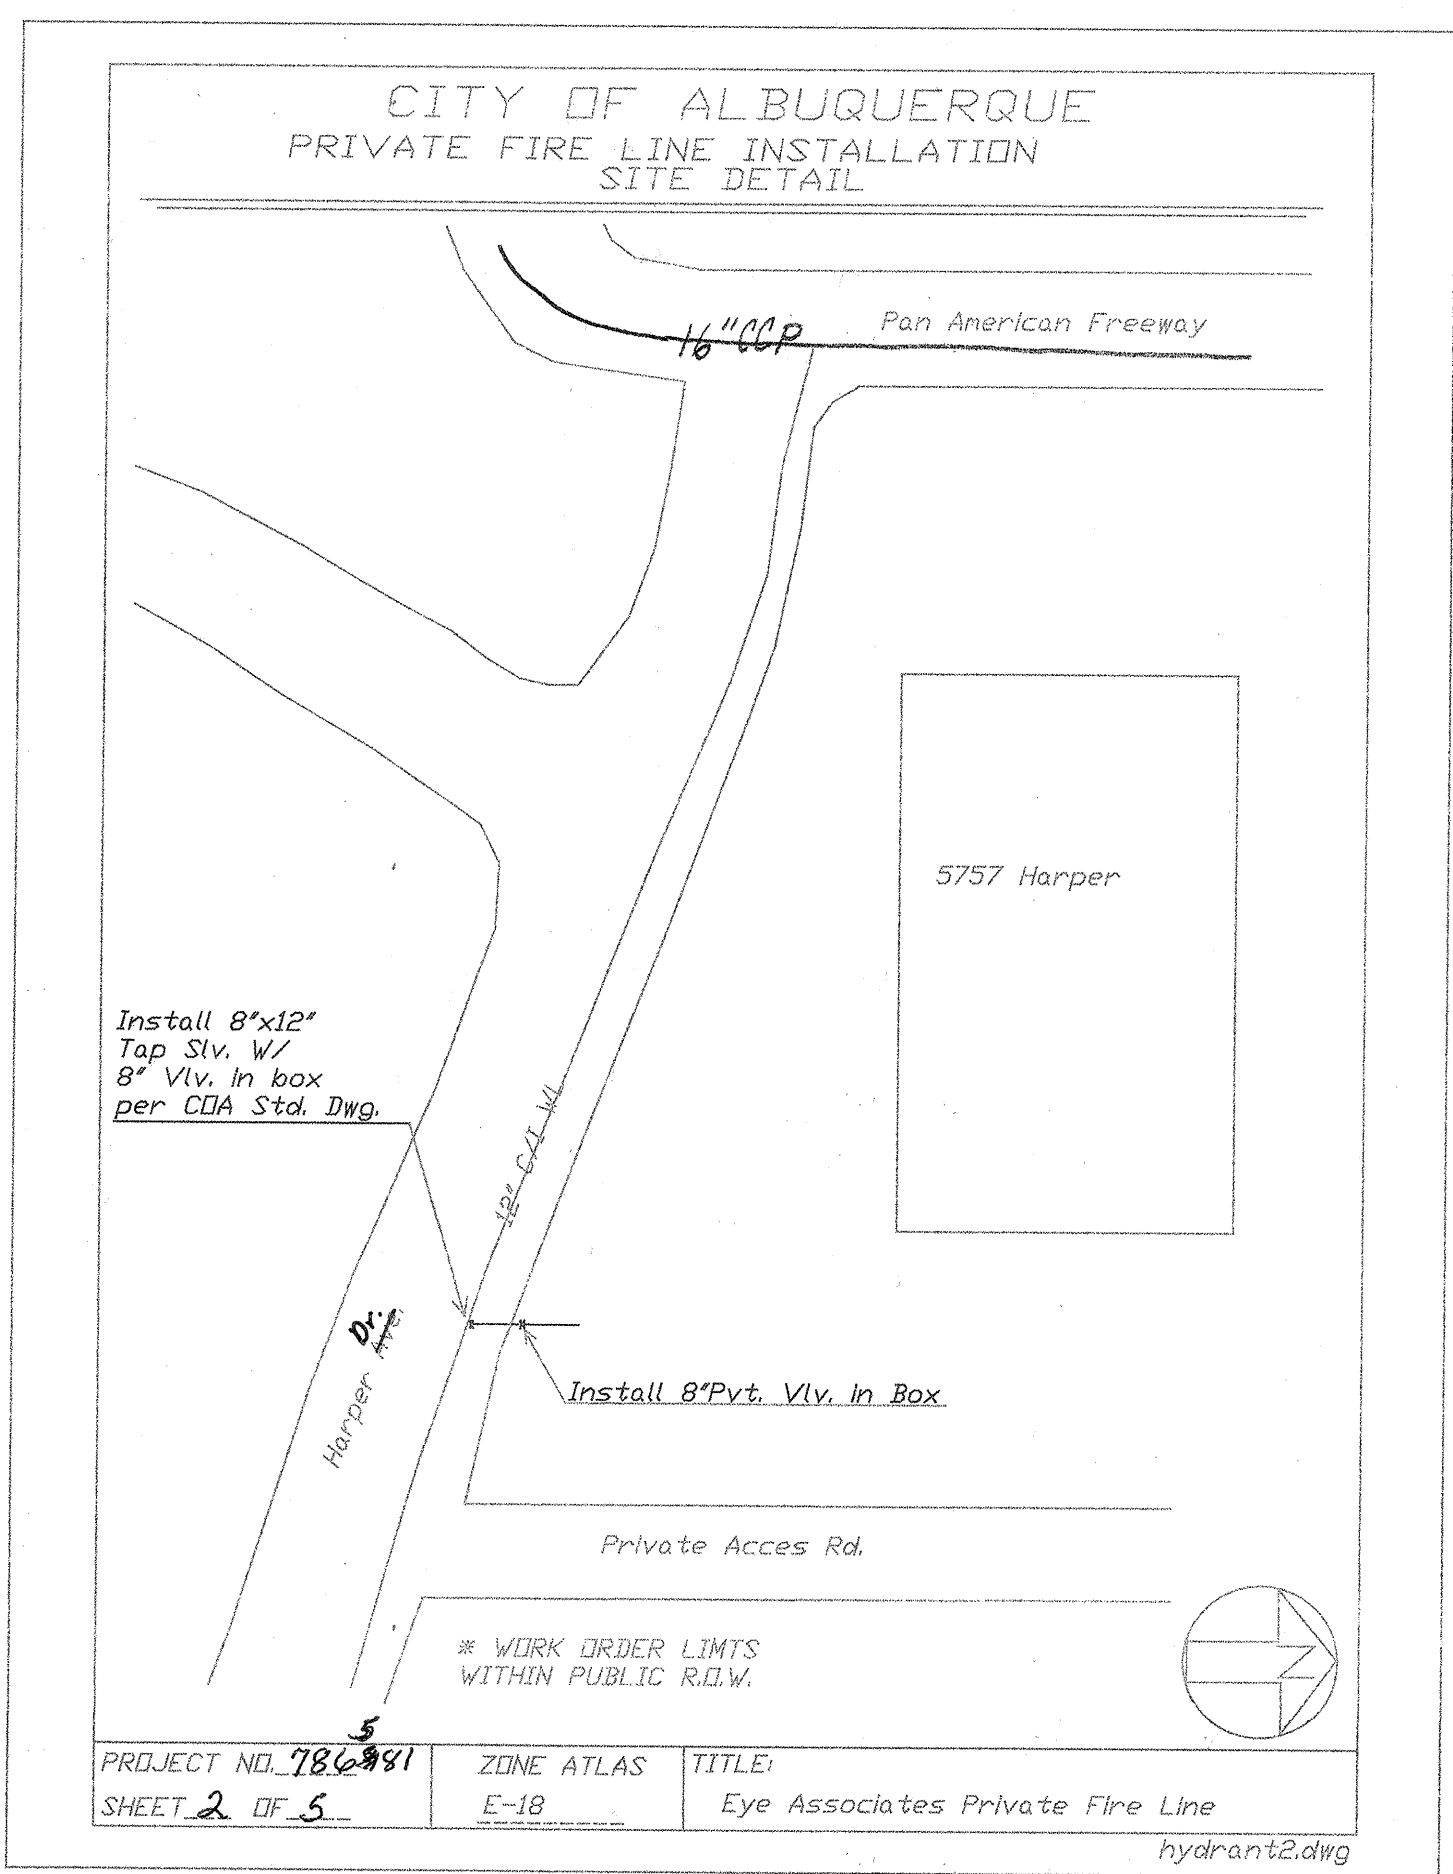


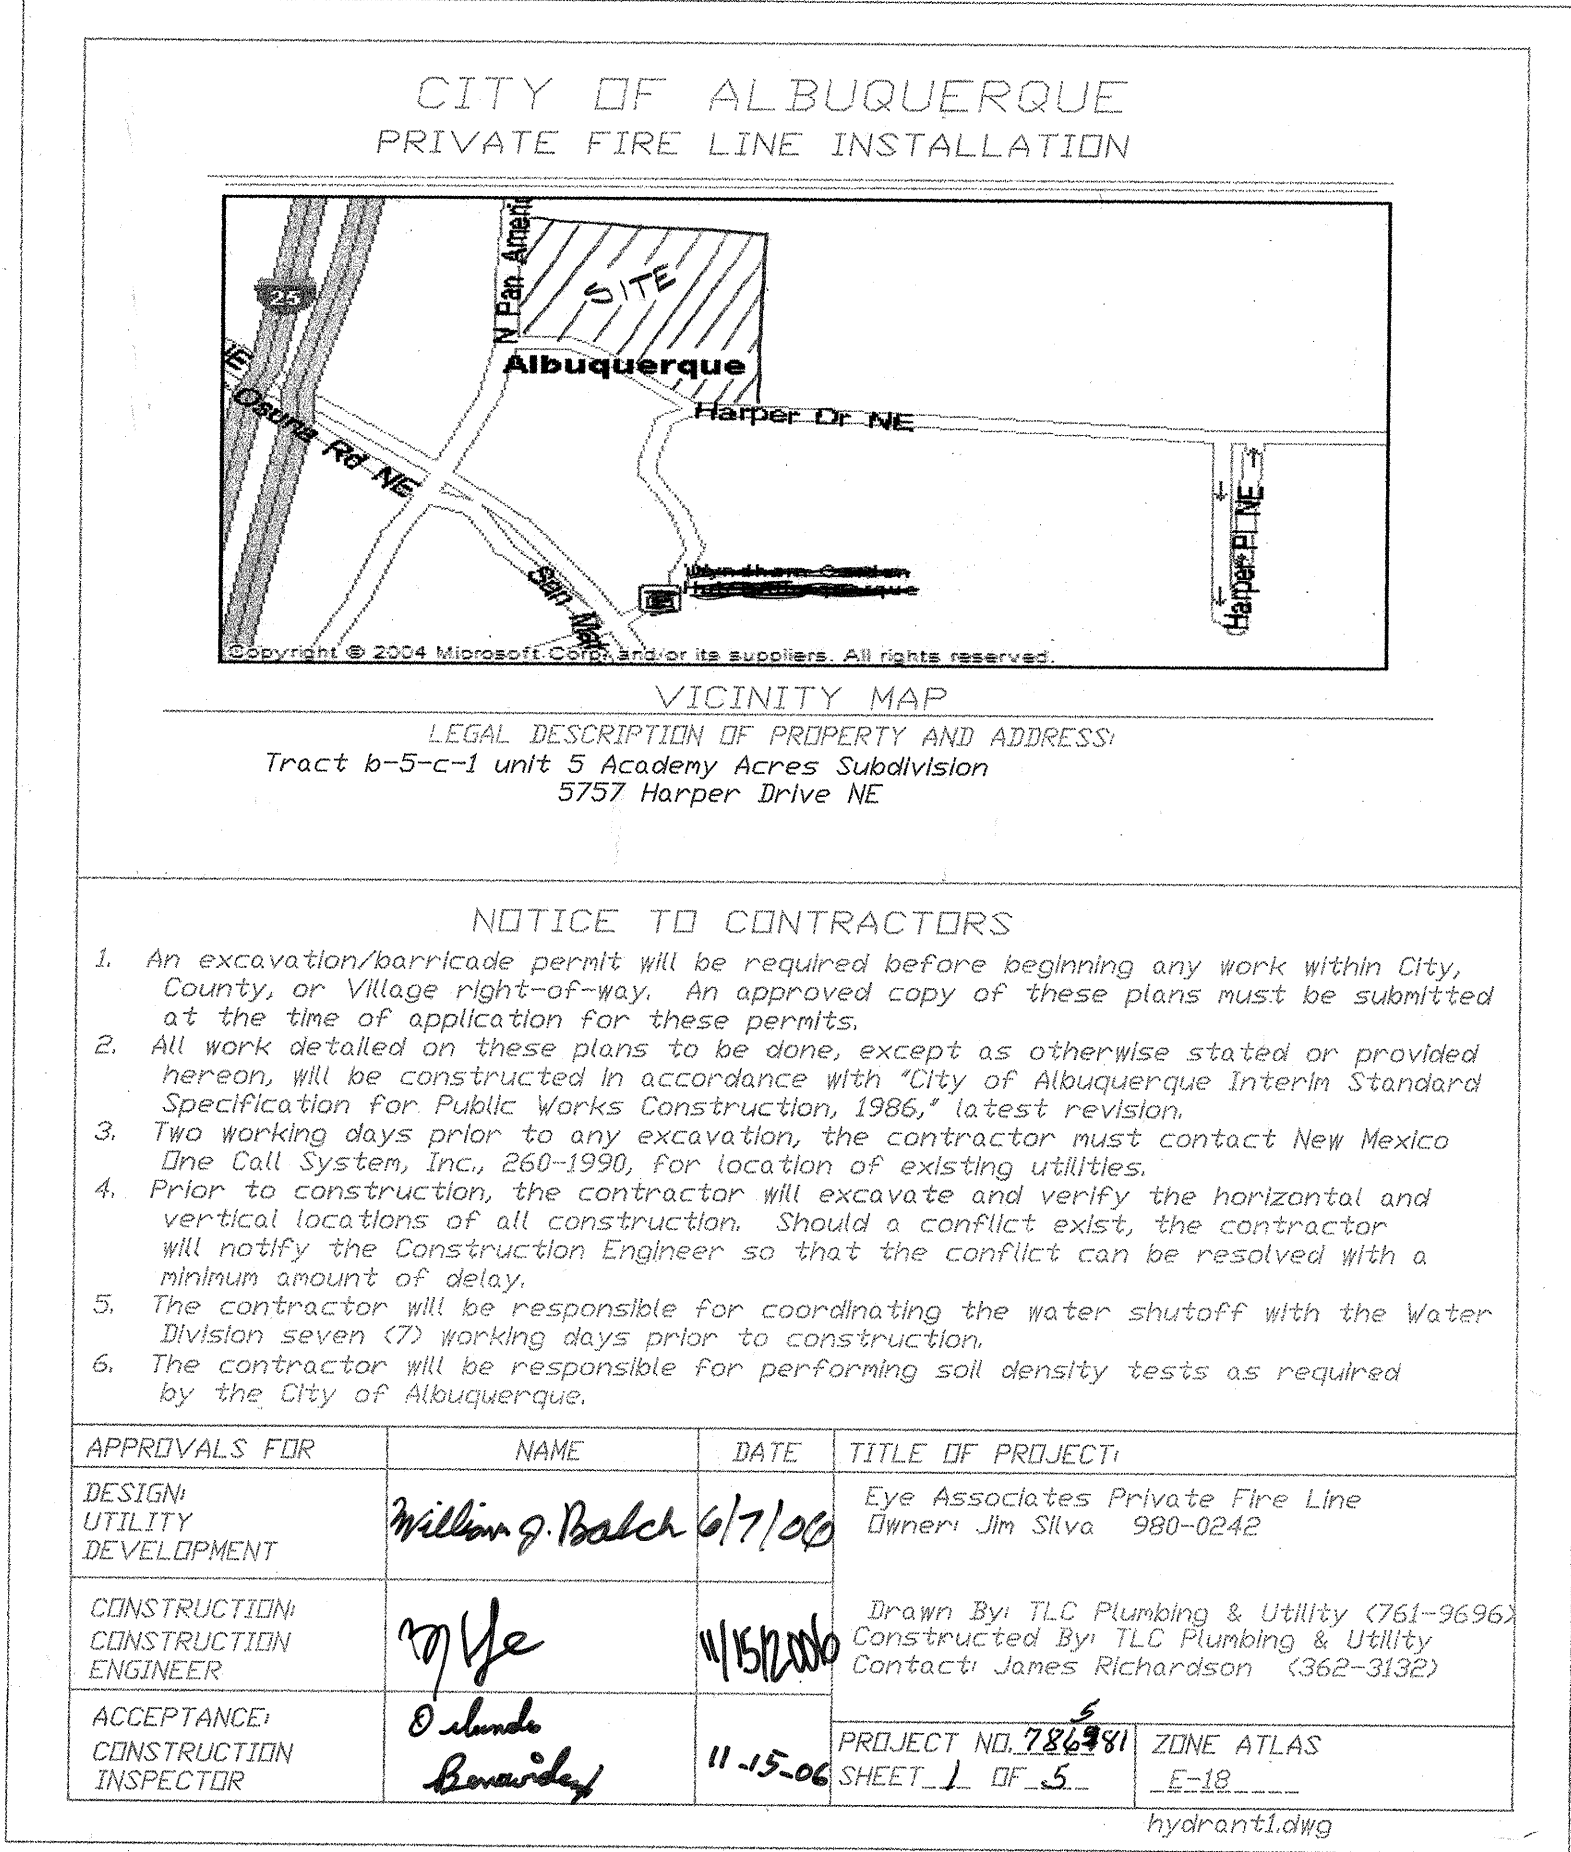

SCANNED BY
PLANNING

SCANNED BY
PLANNING

2 3 4 5 6 7 8 9 10 11 12 13 14 15
26-786981-106

J8P281