

GENERAL NOTES

1. FIVE (5) WORKING DAYS PRIOR TO BEGINNING CONSTRUCTION, THE CONTRACTOR WILL SUBMIT A DETAILED CONSTRUCTION SCHEDULE TO THE CITY CONSTRUCTION COORDINATION DIVISION. TWO (2) DAYS PRIOR TO CONSTRUCTION, THE CONTRACTOR WILL OBTAIN A BARRICADING PERMIT FROM THE CONSTRUCTION COORDINATION DIVISION. CONTRACTOR SHALL NOTIFY BARRICADE ENGINEER (924-3400) PRIOR TO OCCUPYING AN INTERSECTION. REFER TO SECTION 19 OF SPECIFICATIONS.
2. THE CONTRACTOR WILL NOTIFY THE FIELD ENGINEER NOT LESS THAN SEVEN (7) DAYS PRIOR TO STARTING WORK, IN ORDER THAT THE CITY SURVEY SECTION MAY TAKE NECESSARY MEASURES TO INSURE THE PRESERVATION OF SURVEY MONUMENTS. THE CONTRACTOR WILL NOTIFY THE ENGINEER IF A MONUMENT IS DISTURBED. REPLACEMENT WILL BE DONE ONLY BY THE CITY OF ALBUQUERQUE SURVEY SECTION AT THE CONTRACTOR'S EXPENSE. WHEN A CHANGE IS MADE IN THE FINISHED ELEV. OF THE PAVEMENT OF ANY ROADWAY IN WHICH A PERMANENT SURVEY MONUMENT IS LOCATED, CONTRACTOR WILL, AT HIS OWN EXPENSE, HAVE THE CITY SURVEY SECTION ADJUST THE MONUMENT COVER TO THE NEW GRADE UNLESS OTHERWISE SPECIFIED. REFER TO SECTION 4 OF SPECIFICATIONS.
3. THE SPECIFICATIONS USED FOR THIS PROJECT ARE THE CITY OF ALBUQUERQUE STANDARD SPECIFICATIONS FOR PUBLIC WORKS CONSTRUCTION, 1986 EDITION, UPDATE NO. 7.
4. ALL NEW MANHOLES SHALL BE TYPE "E" (COA DWG. 2102) UNLESS OTHERWISE NOTED ON THE PLANS.
5. THE CONTRACTOR WILL BE RESPONSIBLE FOR DISPOSING OF ALL DEBRIS, INCLUDING, BUT NOT LIMITED TO HAZARDOUS WASTE AT DISPOSAL SITES APPROVED BY GOVERNMENTAL AGENCIES REGULATING THE DISPOSAL OF SUCH MATERIALS.
6. ALL WATER VALVE BOXES AND MANHOLES IN THE STREET CONSTRUCTION ARE TO BE ADJUSTED TO FINISH GRADE AND WILL BE MEASURED AND PAID PER EACH.
7. SUBGRADE PREPARATION UNDER SIDEWALKS AND DRIVE PADS, AND SUBGRADE AND SUBBASE PREPARATION UNDER CURB AND GUTTER IS CONSIDERED INCIDENTAL TO THE CONSTRUCTION OF SUCH, AND NO DIRECT PAYMENT SHALL BE MADE FOR THOSE ITEMS OF WORK.
8. THE CONTRACTOR WILL REPLACE ANY STRIPING THAT HAS BEEN RUINED OR REMOVED IN THE COURSE OF CONSTRUCTION.
9. ALL EXCAVATION WILL BE GOVERNED BY FEDERAL, STATE AND LOCAL LAWS, RULES, AND REGULATIONS CONCERNING CONSTRUCTION SAFETY AND HEALTH.
10. ALL SIGNS AND CODING WILL BE IN ACCORDANCE WITH THE "MANUAL OF UNIFORM TRAFFIC CONTROL DEVICES FOR STREETS AND HIGHWAYS" CURRENT EDITION PUBLISHED BY THE U.S. DEPARTMENT OF TRANSPORTATION.
11. THE CONTRACTOR IS TO EXERCISE CARE TO AVOID DISTURBING ANY EXISTING UNDERGROUND UTILITIES. IT WILL BE HIS RESPONSIBILITY TO COORDINATE WITH THE UTILITY COMPANIES IN ORDER TO PREVENT ANY SERVICE DISRUPTION. SEE SECTION 18 "UTILITIES", CITY OF ALBUQUERQUE, STANDARD SPECIFICATIONS FOR CONTRACTOR REQUIREMENTS.
12. WHEN ABUTTING NEW PAVEMENT TO EXISTING INTERSECTING STREETS, SAW CUT EXISTING PAVEMENT TO A STRAIGHT LINE AND AT RIGHT ANGLES AND REMOVE ANY BROKEN OR CRACKED PAVEMENT. NO DIRECT PAYMENT WILL BE MADE FOR SAW CUTTING.
13. ALL GAS VALVES, GAS MANHOLES, ELECTRICAL MANHOLES, TELEPHONE MANHOLES, AND UTILITY POLES WILL BE ADJUSTED TO GRADE BY EACH UTILITY COMPANY.CONTRACTOR WILL COORDINATE THROUGH CITY UTILITY COORDINATOR.
14. WHEN REMOVAL OF EXISTING CURB AND GUTTER OR SIDEWALK IS REQUIRED, REMOVE BACK TO NEAREST SUITABLE JOINT UNLESS OTHERWISE DIRECTED BY THE CITY FIELD ENGINEER.
15. THE CONTRACTOR WILL NOTIFY THE NEW MEXICO ONE CALL SYSTEM 260-1990 TWO (2) WORKING DAYS PRIOR TO COMMENCING WORK IN NEW AREAS.
16. CONTRACTOR WILL MAKE ALL WATER VALVES AND MANHOLES ACCESSIBLE TO THE CITY AT ALL TIMES.
17. CONTRACTOR WILL PLACE BITUMINOUS MATERIAL WITH THE USE OF A LAYDOWN MACHINE WHERE PAVEMENT IS 8 FEET IN WIDTH OR WIDER.
18. ALL SUBGRADE AND SUBBASE MATERIAL ENCOUNTERED IN PAVEMENT REMOVAL AND REPLACEMENT THAT IS DETERMINED BY THE FIELD ENGINEER TO MEET THE SPECIFICATIONS, CAN BE REUSED. HOWEVER, THE MATERIAL WILL BE PROCESSED AND COMPACTED TO MEET MOISTURE CONTENT AND PERCENT COMPACTION REQUIRED BY THE SPECIFICATIONS.
19. CONTRACTOR WILL NOT PAVE OVER ANY SURFACE FEATURE, I.E., GAS VALVE, MANHOLE COVER, ETC. WITHOUT PRIOR APPROVAL FROM THE CITY FIELD ENGINEER.
20. CONTRACTOR WILL CONFINE HIS WORK WITHIN THE CONSTRUCTION EASEMENT LIMITS AND/OR RIGHT-OF-WAY, OR PROVIDE COPIES OF AGREEMENTS WITH ADJACENT LANDOWNERS TO THE CITY OF ALBUQUERQUE.
21. ALL WATER VALVES AND FIRE HYDRANTS REMOVED TO BE SALVAGED AND RETURNED TO THE C.O.A.
22. MINIMUM BOTTOM WIDTH OF TRENCHES FOR RIGID PIPE SHALL BE EQUAL TO THE OUTSIDE DIAMETER PLUS 16 INCHES. BEDDING MATERIAL SHALL BE CLASS II, III, OR IV UNLESS OTHERWISE SPECIFICALLY NOTED ON THE PLANS.
23. MINIMUM BOTTOM WIDTH OF TRENCHES FOR NON-RIGID PIPE SHALL BE EQUAL TO THE OUTSIDE DIAMETER PLUS 12 INCHES. BEDDING MATERIAL SHALL BE CLASS I, II, OR III.
24. THE CONTRACTOR AGREES TO TAKE NECESSARY SAFETY PRECAUTIONS AS REQUIRED BY FEDERAL, STATE AND LOCAL AUTHORITIES TO PROTECT PEDESTRIAN AND VEHICULAR TRAFFIC IN THE CONSTRUCTION AREA, WHICH INCLUDES BUT ARE NOT LIMITED TO: MAINTAINING ADEQUATE WARNING SIGNS, BARRICADES, LIGHTS, GUARD FENCES, WALKS AND BRIDGES.
25. ALL STRUCTURAL CONCRETE WILL BE 3000 PSI UNLESS OTHERWISE NOTED ON PLANS.
26. ALL REINFORCING STEEL WILL BE GRADE 60.
27. ALL EXPOSED EDGES ON CAST-IN-PLACE CONCRETE STRUCTURES WILL HAVE A 1" CHAMFER UNLESS OTHERWISE NOTED.
28. ALL SPLICES IN REINFORCING STEEL TO BE 2-FOOT 6-INCH MINIMUM UNLESS OTHERWISE NOTED.
29. PRIOR TO CONSTRUCTION, THE CONTRACTOR WILL EXCAVATE AND VERIFY THE HORIZONTAL AND VERTICAL LOCATIONS OF ALL POTENTIAL CONFLICTING UTILITIES. SHOULD A CONFLICT EXIST BETWEEN THE FIELD INFORMATION AND THE PLANS, THE CONTRACTOR WILL NOTIFY THE FIELD ENGINEER SO THE CONFLICT CAN BE RESOLVED WITH MINIMUM AMOUNT OF DELAY.
30. THE REPLACEMENT OF THE EXISTING UTILITIES AND THE INSTALLATION OF NEW UTILITY LINES WILL BE COMPLETED IN ADVANCE OF STARTING THE PAVEMENT WORK. TEMPORARY PAVEMENT WILL BE PLACED IN ALL TRENCHES REQUIRED FOR THE UTILITY REPLACEMENTS IN THOSE AREAS THAT MUST MAINTAIN TRAFFIC UNTIL THE FINAL PAVEMENT WORK STARTS IN EACH AREA. TEMPORARY STRIPING SHALL BE THE CONTRACTOR'S RESPONSIBILITY. MAINTENANCE OF THE TEMPORARY PAVING AND STRIPING WILL BE AT THE CONTRACTOR'S EXPENSE.
31. TACK COAT FOR SURFACE COURSE REQUIREMENTS WILL BE DETERMINED BY THE FIELD ENGINEER.
32. THE CONTRACTOR WILL CONTACT THE CITY OF ALBUQUERQUE TRAFFIC DIVISION 857-8025, ONE (1) WEEK IN ADVANCE OF ANY CHANGES REQUIRED IN THE TRAFFIC SIGNALIZATION OF THIS PROJECT. ALL WORK ASSOCIATED WITH NEW TRAFFIC SIGNALIZATION SHALL BE THE RESPONSIBILITY OF THE CONTRACTOR.
33. ALL NEW STREET PAVING, DRIVEWAYS, SIDEWALKS, AND CURB AND GUTTERS, ABUTTING EXISTING AREAS SHALL MATCH THE ELEVATION OF THOSE AREAS.
34. PERMANENT PAVEMENT STRIPING AND MARKINGS WILL BE PLACED BY THE CONTRACTOR. ROAD SHALL NOT BE OPENED TO TRAFFIC UNTIL IT IS STRIPED. ALL STRIPING, PAVEMENT MARKINGS INCLUDING CROSSWALKS, ARROWS AND LINE MARKINGS ARE TO BE CONSTRUCTED OF HOT PLASTIC OR COLD PLASTIC IN ACCORDANCE WITH THE MANUAL OF UNIFORM TRAFFIC CONTROL DEVICES.
35. ALL EXCAVATED MATERIAL THAT IS NOT REQUIRED TO BE REUSED MUST BE REMOVED FROM THE PROJECT AREA WITHIN FOUR DAYS OF EXCAVATION. SPOIL PILES WILL BE ALLOWED ONLY AS DIRECTED BY THE CITY FIELD ENGINEER.
36. THE CONTRACTOR WILL COORDINATE THE CONSTRUCTION ACTIVITIES WITH ALL OTHER CONTRACTORS AND UTILITY COMPANIES WORKING IN THE SAME AREA. THE CONTRACTOR MAY BE REQUIRED TO RESCHEDULE THEIR ACTIVITIES TO ALLOW UTILITY CREWS TO PERFORM THEIR REQUIRED WORK. NO ADDITIONAL COMPENSATION WILL BE ALLOWED FOR DELAYS OR INCONVENIENCE CAUSED BY UTILITY COMPANY WORK CREWS. A CONTRACT EXTENSION MAY BE ALLOWED AS DELINEATED IN CITY OF ALBUQUERQUE STANDARD SPECIFICATIONS.
37. ALL CONSTRUCTION EASEMENTS ON PRIVATE PROPERTY WILL BE OBTAINED BY THE CITY OF ALBUQUERQUE PRIOR TO THE BEGINNING OF CONSTRUCTION.
38. EXISTING MEDIAN CURB AND GUTTER AND STANDARD CURB AND GUTTER, NOT DISTURBED BY CONTRACTOR, BUT OUT OF ALIGNMENT, DISPLACED VERTICALLY, BADLY BROKEN AND/OR DETERIORATED, WILL BE REPLACED AS DIRECTED BY THE FIELD ENGINEER AND PAID FOR AT CONTRACT UNIT PRICES.
39. ALL TRAFFIC CONTROL DEVICES REQUIRED FOR DRIVEWAY CLOSURES, UTILITY CONSTRUCTION OR FOR OTHER REASONS AND NOT SHOWN ON THE SIGNING PLANS WILL BE FURNISHED BY THE CONTRACTOR AND WILL BE PAID AS SPECIFIED IN THE TECHNICAL SPECIFICATIONS AND BID PROPOSAL. PRIOR TO PLACING THE TRAFFIC CONTROL DEVICES, THE CONTRACTOR WILL NOTIFY THE AFFECTED OWNERS IN ACCORDANCE WITH THE SPECIFICATIONS. CONTRACTOR MUST MAKE PROVISIONS TO PROVIDE ACCESS TO PROPERTIES. REFER TO SECTION 19 OF THE SPECIFICATIONS.
40. ALL UTILITY LINES WHICH ARE NOT SPECIFICALLY DESIGNATED TO BE REMOVED AND REPLACED ON THE PLANS, WILL BE MAINTAINED IN SERVICE. SHORING, SHEETING AND OTHER MEANS OF SUPPORT SHALL BE EMPLOYED BY THE CONTRACTOR TO PREVENT DAMAGE OR LOSS OF THESE EXISTING UTILITIES AND THESE SHORING, SHEETING, AND SUPPORTS ARE CONSIDERED INCIDENTAL TO THIS PROJECT. BEAM AND CABLE OR OTHER ADEQUATE SUPPORTS WILL BE USED FOR TEMPORARY SUPPORT OF ALL UTILITY LINES WHICH CROSS THE TRENCH. ANY DAMAGE TO EXISTING UTILITIES WILL PROMPTLY BE REPAIRED AT THE CONTRACTOR'S EXPENSE. THE CONTRACTOR WILL NOTIFY THE ENGINEER IMMEDIATELY OF ANY SIGNIFICANT DEVIATION OF EXPOSED UTILITIES FROM THE LOCATIONS SHOWN ON THE PLANS SO THAT CONFLICTS CAN BE RESOLVED IN A TIMELY MANNER.


41. THE CONTRACTOR WILL ASSUME RESPONSIBILITY FOR ANY DAMAGE TO EXISTING COA INFRASTRUCTURE (C & G, PAVING, ETC.) DURING CONSTRUCTION, APART FROM THOSE SECTIONS INDICATED FOR REMOVAL ON THE PLANS, AND WILL REPAIR OR REPLACE SAME AT HIS OWN EXPENSE. HE WILL SUITABLY PROTECT THE CURB AND GUTTER FROM INCIDENTAL SPLASHING DURING THE TACK COAT APPLICATION AND WILL BE RESPONSIBLE FOR CLEANING SAME AT HIS OWN COST SHOULD SPLASHING OCCUR.
42. ALL INTERFERING PORTIONS OF ABANDONED UTILITY LINES WHICH ARE EXPOSED AS A RESULT OF CONSTRUCTION WILL BE REMOVED AND DISPOSED OF BY THE CONTRACTOR.
43. STATIONS OF STORM DRAIN INLETS ARE TO THE CENTER OF GRATE. ALL STORM DRAIN INLETS WILL BE TYPE "A" UNLESS OTHERWISE NOTED ON THE PLANS.
44. SHORING COSTS WILL BE CONSIDERED INCIDENTAL TO THE TRENCH AND BACKFILL COSTS.
45. THE CONTRACTOR WILL BE RESPONSIBLE FOR SECURING NPDES PERMITS REQUIRED BY APPLICABLE CITY, STATE, AND FEDERAL REGULATIONS.
46. ALL STORM DRAIN AND CONNECTOR PIPE WILL BE CLASS IV REINFORCED CONCRETE PIPE UNLESS OTHERWISE NOTED ON THE PLANS.
47. THE TERM REMOVE USED IN THIS PLAN SET INCLUDES THE DISPOSAL OF SAID MATERIAL IN ACCORDANCE WITH CITY OF ALBUQUERQUE SPECIFICATIONS, LATEST EDITION.
48. CONTRACTOR WILL SURVEY AND LOG EXISTING ELEVATIONS OF CURB-AND-GUTTER, SIDEWALK, AND PAVEMENT WHICH WILL BE REMOVED FOR CONSTRUCTION OF IMPROVEMENTS. CONTRACTOR WILL REPLACE REMOVED CURB-AND-GUTTER, SIDEWALK, DRIVE PADS, AND PAVEMENT TO ELEVATIONS PRIOR TO REMOVAL UNLESS OTHERWISE INDICATED ON THE PLANS.
49. CONTRACTOR WILL CONSTRUCT TEMPORARY ASPHALT PAVEMENT AS DIRECTED BY THE FIELD ENGINEER TO PROVIDE ACCESS TO LOCAL BUSINESS, ETC. TEMPORARY PAVEMENT SHALL BE REMOVED AND DISPOSED OF PRIOR TO PLACEMENT OF FULL WIDTH PAVEMENT SECTION. TEMPORARY PAVING SHALL BE PER COA STD. DWG. 2415 AND PAID FOR PER COA STD. SPECIFICATIONS.
50. ALL CLASSES OF SEEDING SHALL BE DRY LAND MIX PLACED AT 1.5 LBS/1000 S.F. WITH FERTILIZER 21-12-12 PLACED AT 5 LBS/1000 S.F.
51. ALL ASPHALTIC CONCRETE SHALL BE MINIMUM 1800 LB. STABILITY AND COMPACTED TO 95% MODIFIED MARSHALL DENSITY UNLESS OTHERWISE NOTED ON THE PLANS.
52. ANY WORK OCCURRING WITHIN AN ARTERIAL ROADWAY REQUIRES TWENTY-FOUR (24) HOUR CONSTRUCTION.
53. ALL EXCAVATION, TRENCHING AND SHORING ACTIVITIES MUST BE CARRIED-OUT IN ACCORDANCE WITH OSHA 29 CFR 1926.650 SUBPART P.
54. THE CONTRACTOR SHALL BE RESPONSIBLE FOR TIMING AND COORDINATION OF WATER SHUTOFF AT LEAST SEVEN (7) WORKING DAYS PRIOR TO CONSTRUCTION. CONTRACTOR SHALL CONTACT THE WATER SYSTEMS DIVISION, 857-8200, TO INITIATE IMPLEMENTATION OF THE NON-PRESSURIZED CONNECTION PLAN.
55. FOR STORM DRAIN CONSTRUCTION, RCP PIPE JOINTS SHALL NOT BE GROUTED PRIOR TO FINAL INSPECTION. FINAL INSPECTION WILL DETERMINE JOINTS TO BE GROUTED FOR FINAL ACCEPTANCE OF THE CONSTRUCTION.
56. CONTRACTOR SHALL MAINTAIN A GRAFFITI-FREE WORK SITE. CONTRACTOR SHALL PROMPTLY REMOVE ANY AND ALL GRAFFITI FROM EQUIPMENT, WHETHER PERMANENT OR TEMPORARY.
57. CONTRACTOR SHALL ERECT TEMPORARY CHAIN LINK CONSTRUCTION FENCE. SUCH FENCE SHALL BE MAINTAINED THROUGHOUT THE DURATION OF THE CONSTRUCTION PERIOD AND REMOVED ONLY UPON FINAL ACCEPTANCE OF THE PROJECT BY THE CITY.
58. QUANTITIES PROVIDED ON THE PLANS ARE FOR THE CONTRACTOR'S CONVENIENCE ONLY. PLANS SHALL TAKE PRECEDENCE IN ALL CASES.
59. CONTRACTOR SHALL INSTALL ALL FURNISHINGS, FENCES, SPORTS EQUIPMENT, SHADE STRUCTURES, AND OTHER MISCELLANEOUS SITE FURNISHINGS WITH TAMPER PROOF HARDWARE UNLESS OTHERWISE NOTED ON THE PLANS. IN LIEU OF TAMPER PROOF HARDWARE, CONTRACTOR MAY SPOT WELD OR LIQUID WELD HARDWARE UPON PRIOR APPROVAL BY THE OWNER. CONTRACTOR SHALL PROVIDE A SUBMITTAL FOR TAMPER PROOF HARDWARE AND/OR LIQUID WELD PRODUCTS. CONTRACTOR SHALL PAINT TO MATCH ANY SPOT WELDS. CONTRACTOR SHALL CUT OFF BOLT ENDS THAT EXTEND BEYOND 2 THREADS PAST THE NUT. ALL PLAY AREA EQUIPMENT SHALL BE INSTALLED WITH THE MANUFACTURER'S RECOMMENDED HARDWARE.



CITY OF ALBUQUERQUE
PARK DESIGN AND CONSTRUCTION DIVISION
DEPARTMENT OF MUNICIPAL DEVELOPMENT

BLACK ARROYO PARK IMPROVEMENTS
GENERAL NOTES

Design Review Committee	City Engineer Approval	Last Design Update	Mo./Day/Yr.	Mo./Day/Yr.
City Project No.		Zone Map No.	Sheet	
787491		A-12	2 OF 21	

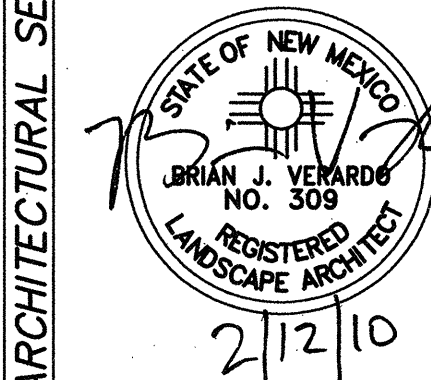



SURVEY INFORMATION		BENCH MARKS		AS-BUILT INFORMATION	
NO.	BY	DATE		CONTRACTOR	
				WORK	DATE
				STAMPED BY	DATE
				ACCEPTANCE BY	DATE
				FIELD NOTES BY	DATE
				DRAWN BY	DATE
				CHECKED BY	DATE
				RECORDED BY	DATE
				NO.	

PROJECT# 787491

Black Arroyo Park Improvements

FINAL FOR CONSTRUCTION
DATE: FEBRUARY 12, 2010

RECORD DRAWINGS
DATE:

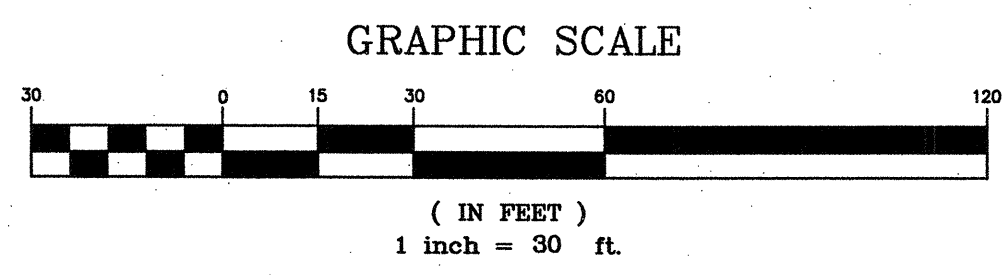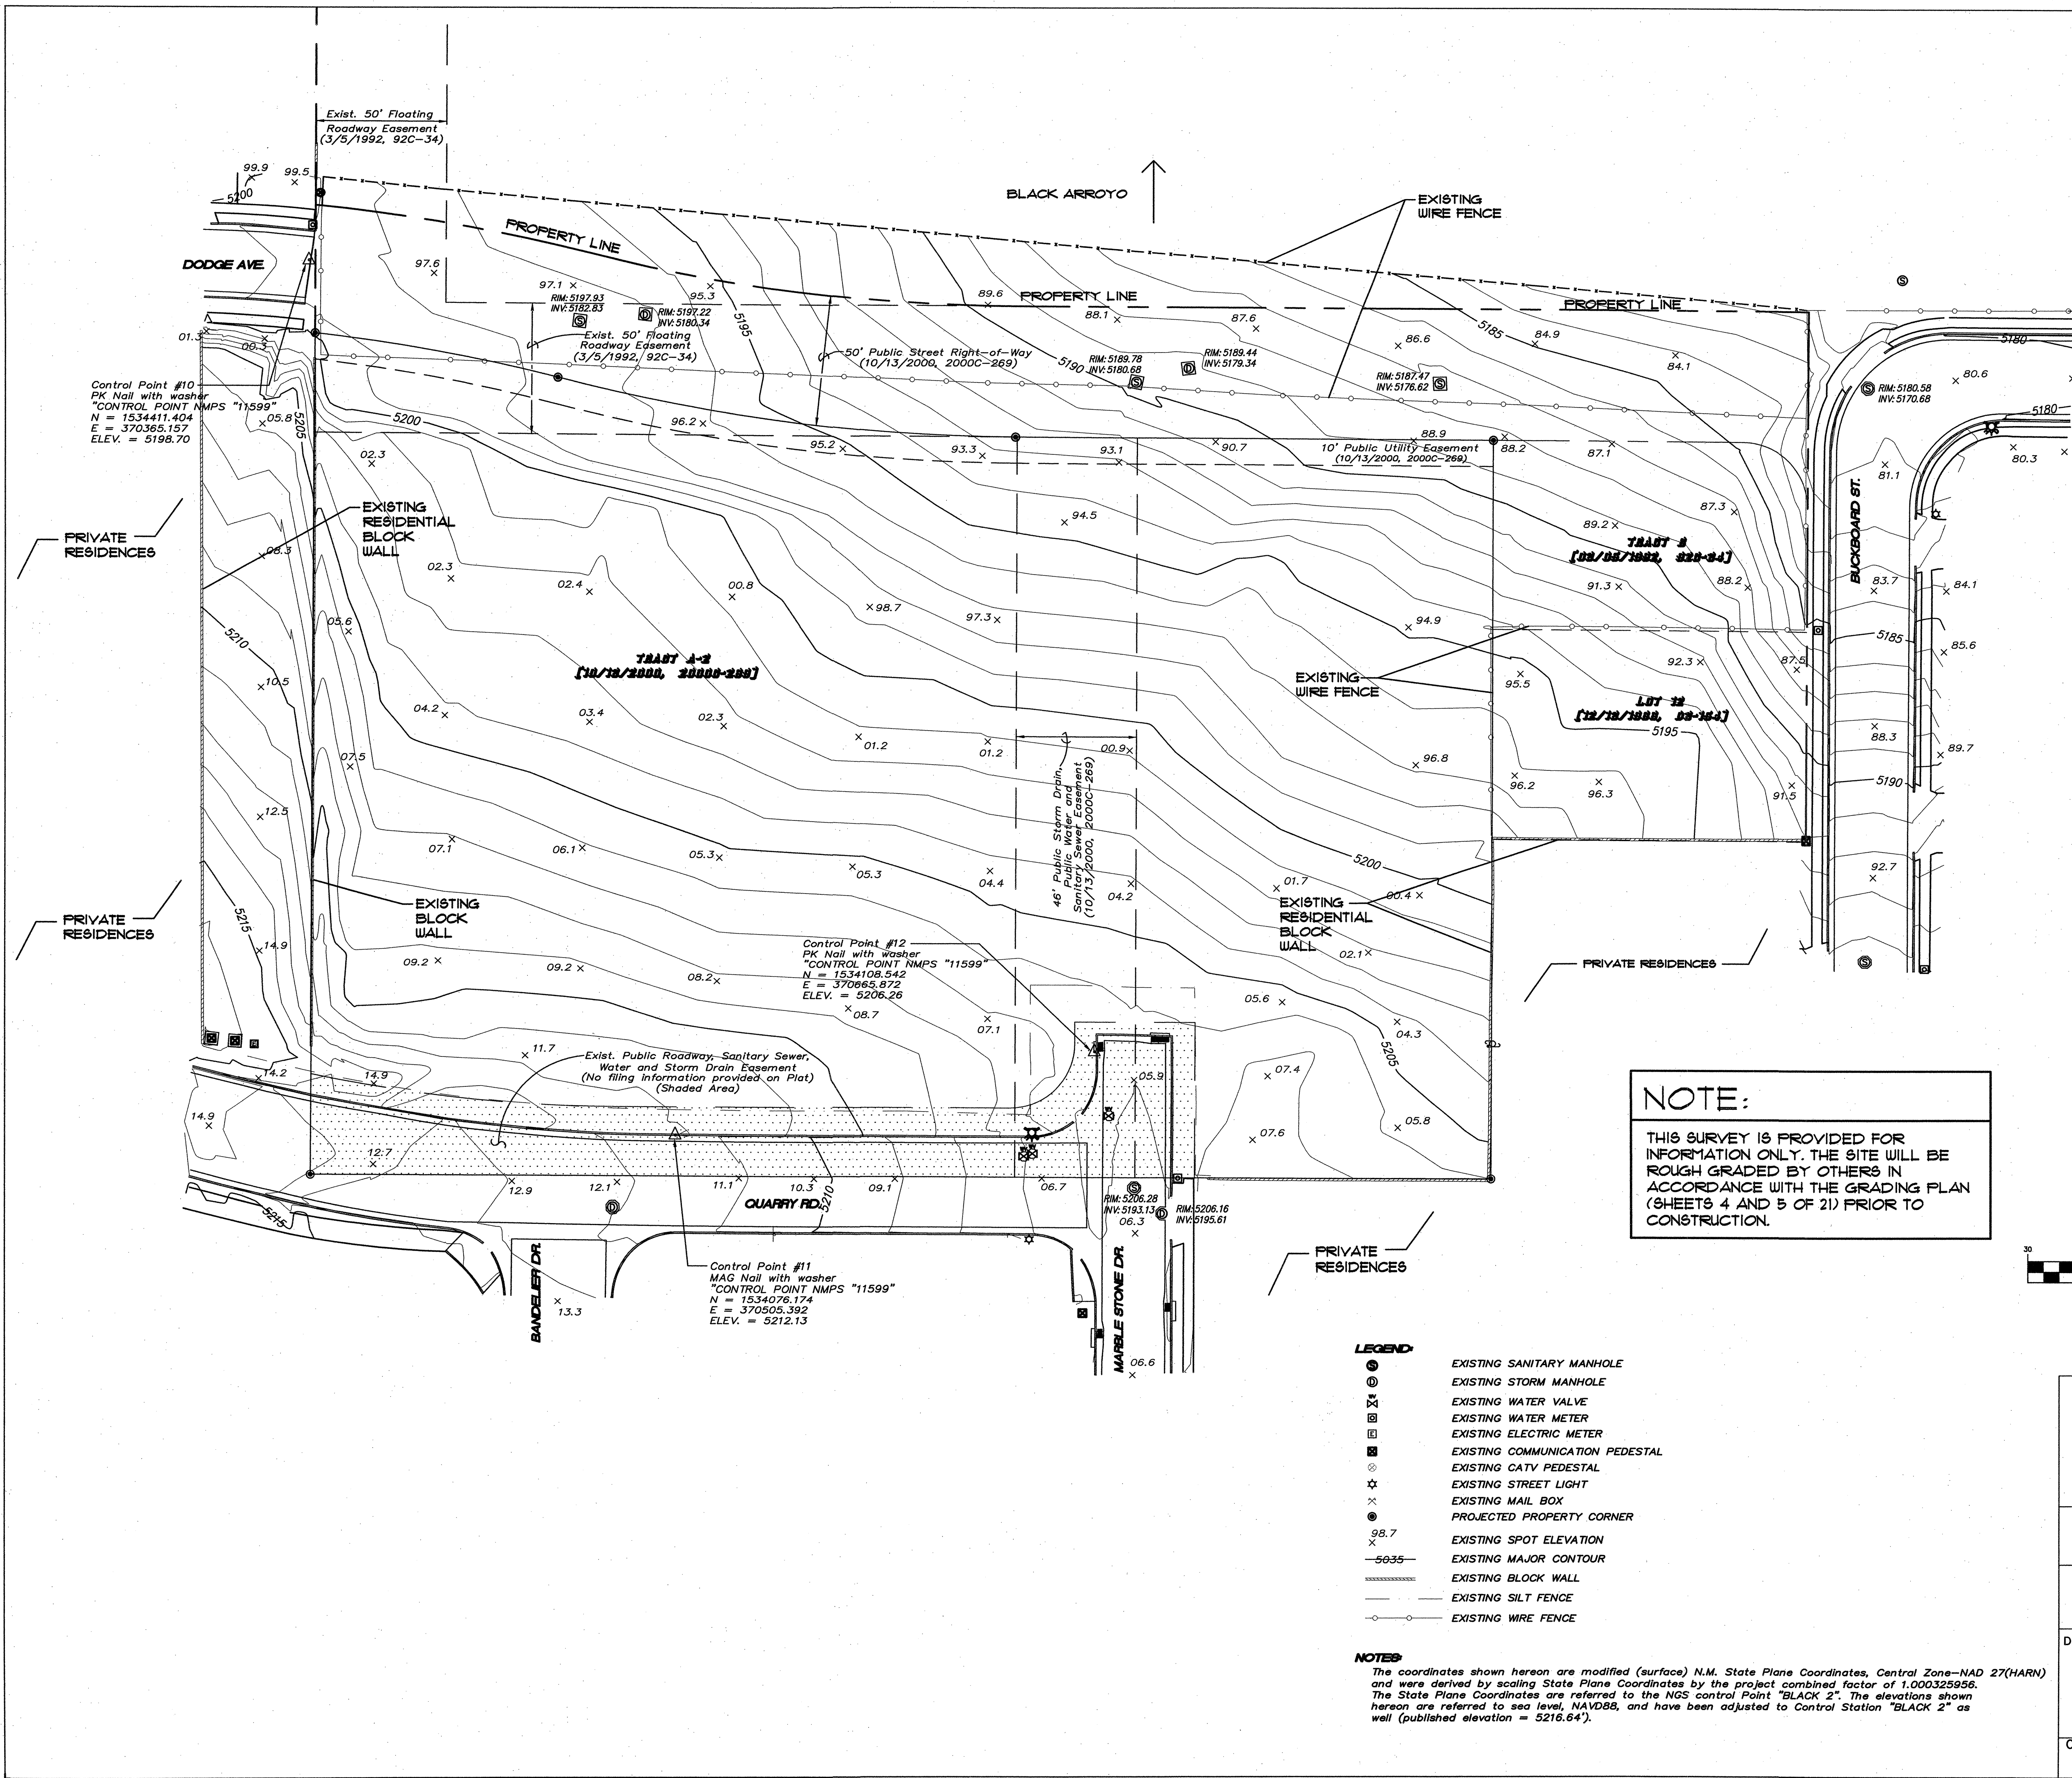

MORROW REARDON
WILKINSON MILLER, LTD.,
LANDSCAPE ARCHITECTS
210 La Veta NE, Albuquerque, NM 87108
505.268.2269 FAX 505.268.9837
mrw@mrwm.com

CITY OF ALBUQUERQUE PARK DESIGN AND CONSTRUCTION DIVISION DEPARTMENT OF MUNICIPAL DEVELOPMENT		BLACK ARROYO PARK IMPROVEMENTS EXISTING CONDITIONS	
Design Review Committee	City Engineer Approval	Last Design Update	
City Project No. 787491	Zone Map No. A-12	Mo./Day/Yr.	Mo./Day/Yr.
Sheet 3 OF 21		RECORD DRAWINGS	

AS-BUILT INFORMATION		BENCH MARKS		SURVEY INFORMATION		ARCHITECTURAL SEAL		REVISIONS		REMARKS		NO. DATE		DESIGNED BY		DRAWN BY		CHECKED BY		DATE		DATE		DATE		DATE		DATE		DATE	
CONTRACTOR		NO.	DATE	NO.	DATE																										
WORK STAMPED BY		FIELD	DATE	NO.	DATE																										
INSPECTOR'S FIELD		NO.	DATE			2/12/10																									
VERIFICATION BY		NO.	DATE																												
CORRECTED BY		NO.	DATE																												
RECORDED BY		NO.	DATE																												


FINAL FOR CONSTRUCTION
DATE: FEBRUARY 12, 2010

Black Arroyo Park Improvements

PROJECT# 787491

RECORD DRAWINGS

DATE:

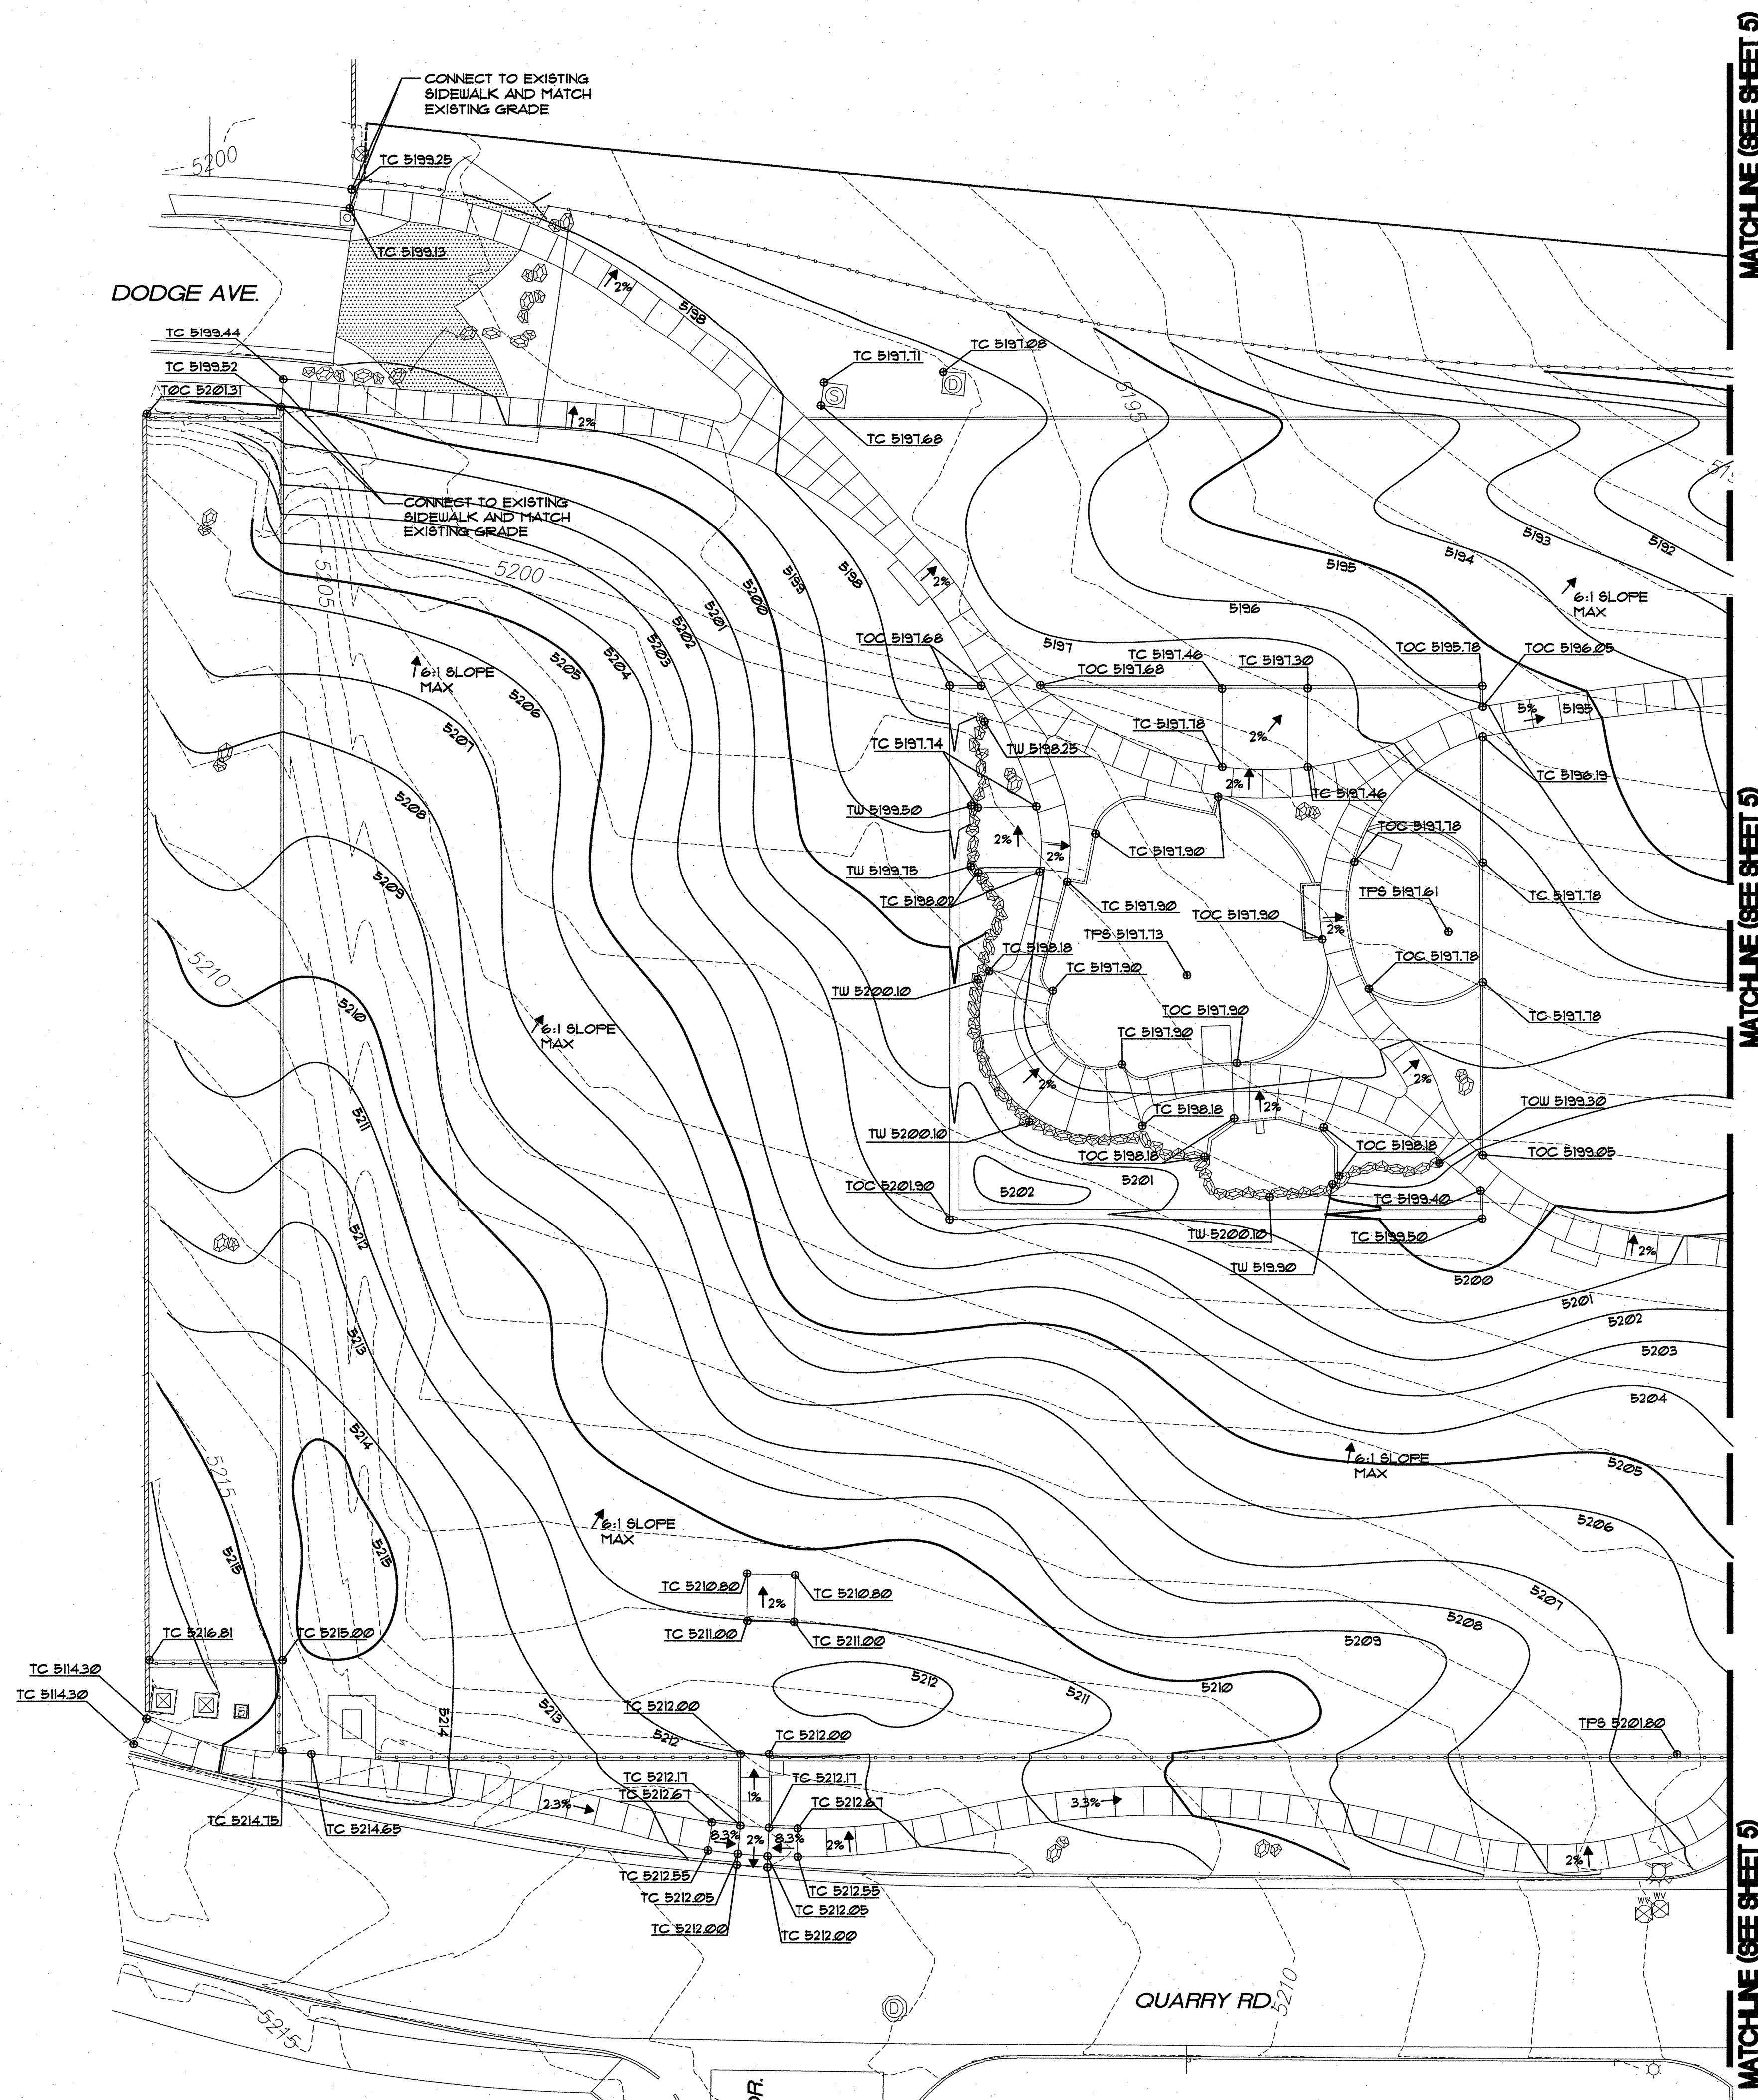


GRADING LEGEND

TC TOP OF CURB
TC TOP OF CONCRETE
TFB TOP OF PLAY SURFACING
TW TOP OF WALL

GENERAL NOTES

1. LANDSCAPE ARCHITECT WILL PROVIDE ELECTRONIC VERSIONS OF THE PLAN FOR SURVEYING PURPOSES

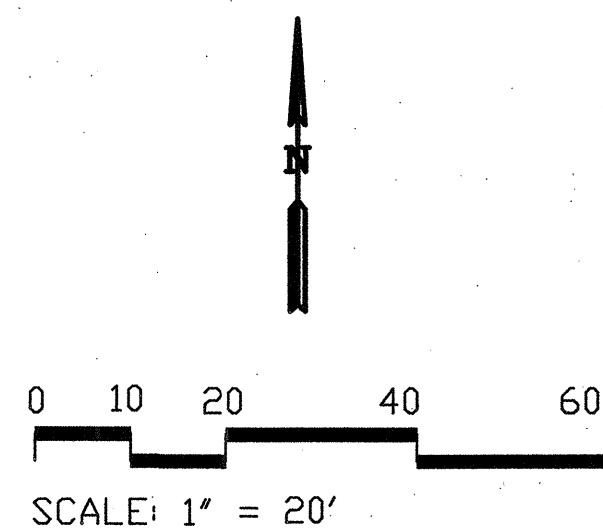

NOTE:

THE SITE WILL BE ROUGH GRADED BY OTHERS PRIOR TO CONSTRUCTION. THE CONTRACTOR SHALL BE RESPONSIBLE FOR FINISH GRADING THE SITE PER THIS PLAN.

**MORROW REARDON
WILKINSON MILLER, LTD.,
LANDSCAPE ARCHITECTS**
210 La Yeta NE, Albuquerque, NM 87108
505.266.2266 FAX 505.266.9697
mrw@mrwm.com

CITY OF ALBUQUERQUE
PARK DESIGN AND CONSTRUCTION DIVISION
DEPARTMENT OF MUNICIPAL DEVELOPMENT

**BLACK ARROYO PARK IMPROVEMENTS
GRADING PLAN**

Design Review Committee	City Engineer Approval	Last Design Update	Mo./Day/Yr.	Mo./Day/Yr.

City Project No.	Zone Map No.	Sheet
787491	A-12	4 OF 21

REVISIONS		REMARKS		BY	


DESIGNED BY	DATE	8/27/09
DRAWN BY	AD	8/27/09
CHECKED BY	BV	8/27/09

ARCHITECTURAL SEAL		SURVEY INFORMATION		BENCH MARKS		AS-BUILT INFORMATION	
		FIELD NOTES	DATE			CONTRACTOR	DATE
		NO.	BY			WORK	DATE
						STAMPED BY	DATE
						ACCEPTANCE BY	DATE
						FIELD	DATE
						PERFORMANCE BY	DATE
						CONNECTED BY	DATE
						MICRO-FILM INFORMATION	DATE
						RECORDED BY	DATE
						NO.	DATE

MATCHLINE (SEE SHEET 4)

MATCHLINE (SEE SHEET 4)

MATCHLINE (SEE SHEET 4)

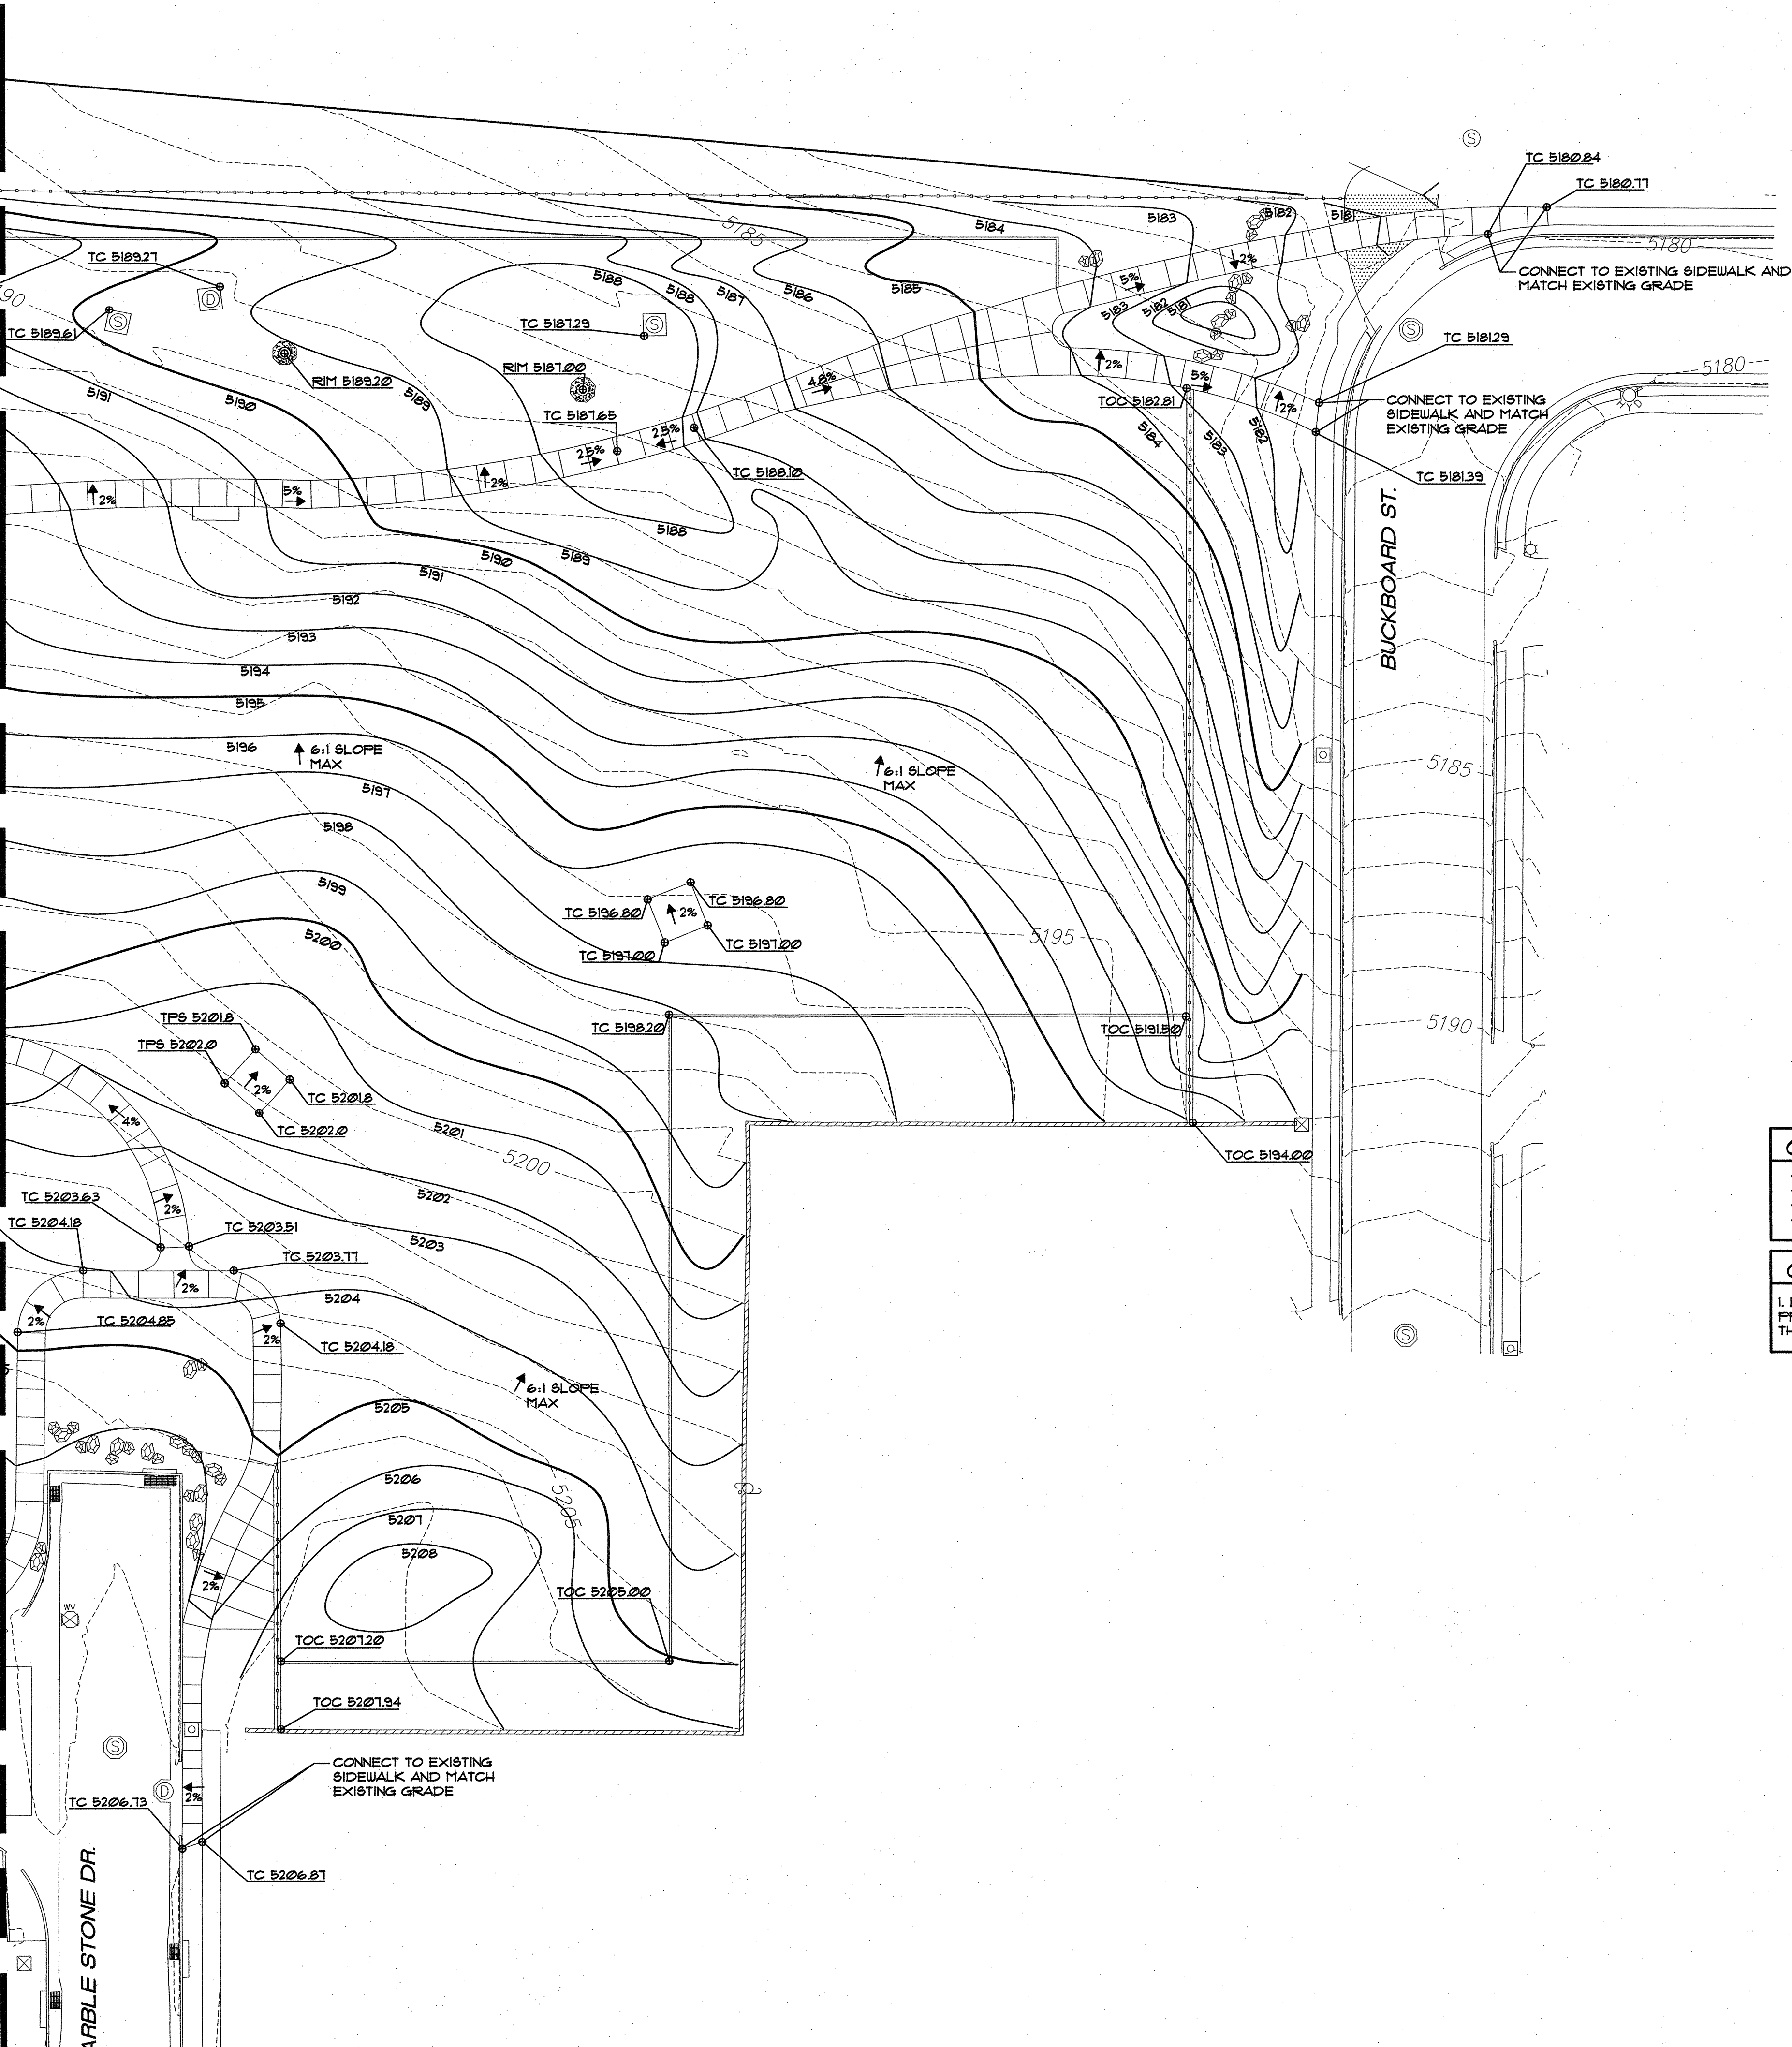


GRADING LEGEND

TC TOP OF CURB
TC TOP OF CONCRETE
TFS TOP OF PLAY SURFACING
TW TOP OF WALL

GENERAL NOTES

1. LANDSCAPE ARCHITECT WILL PROVIDE ELECTRONIC VERSIONS OF THE PLAN FOR SURVEYING PURPOSES

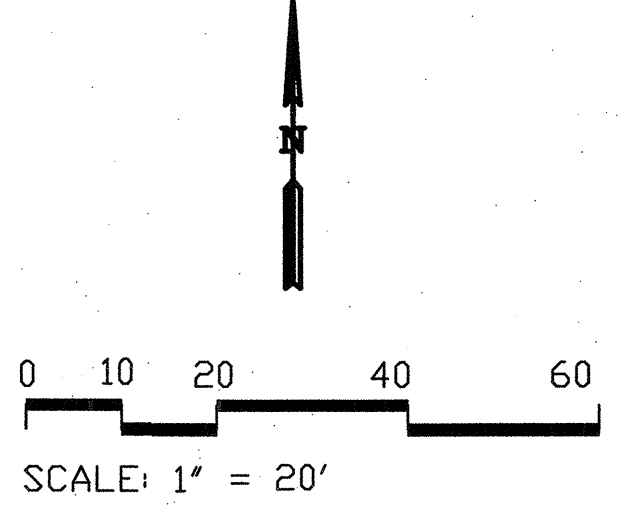



NOTE:

THE SITE WILL BE ROUGH GRADED BY OTHERS PRIOR TO CONSTRUCTION. THE CONTRACTOR SHALL BE RESPONSIBLE FOR FINISH GRADING THE SITE PER THIS PLAN.

**MORROW REARDON
WILKINSON MILLER, LTD.,
LANDSCAPE ARCHITECTS**
210 La Veta NE, Albuquerque, NM 87108
505.265.2290 FAX 505.265.9537
mrw@mrwnm.com

CITY OF ALBUQUERQUE PARK DESIGN AND CONSTRUCTION DIVISION DEPARTMENT OF MUNICIPAL DEVELOPMENT	
BLACK ARROYO PARK IMPROVEMENTS GRADING PLAN	
Design Review Committee	City Engineer Approval
City Project No. 787491	Zone Map No. A-12
Last Design Update	
Sheet 5 OF 21	

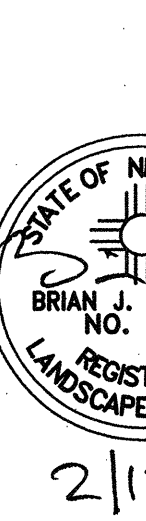ARCHITECTURAL SEAL		SURVEY INFORMATION		BENCH MARKS		AS-BUILT INFORMATION	
 2/12/10		FIELD NOTES					
		NO.	DATE				
		BY	DATE				
		NO.	DATE				
		BY	DATE				
		NO.	DATE			</	

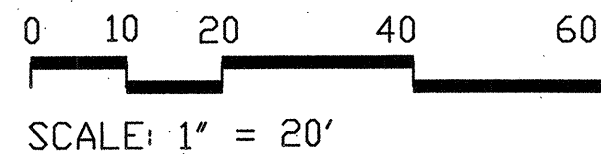

EASTING (X)=		NORTHING (Y)=	
00	X=730321.67	Y=1534104.22	
01	X=730324.93	Y=1534121.69	
02	X=730335.81	Y=1534098.76	
03	X=730350.77	Y=1534096.33	
04	X=730352.95	Y=1534121.69	
05	X=730362.54	Y=1534114.39	
06	X=730372.54	Y=1534101.98	
07	X=730390.86	Y=1534092.38	
08	X=730430.22	Y=1534083.84	
09	X=730443.20	Y=1534088.01	
10	X=730448.59	Y=1534087.35	
11	X=730451.36	Y=1534080.58	
12	X=730461.03	Y=1534080.17	
13	X=730458.08	Y=1534097.48	
14	X=730455.08	Y=1534101.98	
15	X=730450.37	Y=1534129.82	
16	X=730460.54	Y=1534139.65	
17	X=730458.08	Y=1534140.08	
18	X=730492.05	Y=1534083.40	
19	X=730545.65	Y=1534088.83	
20	X=730598.71	Y=1534079.51	
21	X=730625.89	Y=1534077.06	
22	X=730645.64	Y=1534081.60	
23	X=730659.89	Y=1534091.85	
24	X=730658.45	Y=1534101.99	
25	X=730699.89	Y=1534035.32	
26	X=730716.94	Y=1534059.93	
27	X=730701.66	Y=1534081.37	
28	X=730716.96	Y=1534074.47	
29	X=730715.46	Y=1534081.37	
30	X=730700.55	Y=1534098.07	
31	X=730707.73	Y=1534112.36	
32	X=730709.96	Y=1534117.35	
33	X=730710.97	Y=1534122.72	
34	X=730716.95	Y=1534122.29	
35	X=730801.46	Y=1534073.97	
36	X=730914.41	Y=1534190.62	
37	X=730921.96	Y=1534214.03	
38	X=730805.64	Y=1534242.84	
39	X=730800.96	Y=1534214.47	
40	X=730800.02	Y=1534229.86	
41	X=730710.95	Y=1534146.64	
42	X=730709.56	Y=1534150.35	
43	X=730706.19	Y=1534152.47	
44	X=730701.40	Y=1534158.47	
45	X=730698.60	Y=1534159.83	
46	X=730697.15	Y=1534162.57	
47	X=730704.84	Y=1534199.55	
48	X=730718.96	Y=1534200.35	
49	X=730682.10	Y=1534197.21	
50	X=730648.56	Y=1534210.97	
51	X=730625.03	Y=1534215.15	
52	X=730619.23	Y=1534207.82	
53	X=730604.96	Y=1534214.46	
54	X=730599.44	Y=1534233.52	
55	X=730595.66	Y=1534227.12	
56	X=730604.94	Y=1534227.79	
57	X=730596.03	Y=1534240.52	
58	X=730588.47	Y=1534240.34	
59	X=730586.85	Y=1534239.72	
60	X=730588.98	Y=1534241.99	
61	X=730592.39	Y=1534248.17	
62	X=730587.01	Y=1534256.45	
63	X=730592.92	Y=1534259.92	
64	X=730604.29	Y=1534264.29	
65	X=730581.09	Y=1534262.7	
66	X=730580.65	Y=1534263.60	
67	X=730577.17	Y=1534274.24	
68	X=730577.33	Y=1534287.08	
69	X=730585.74	Y=1534288.00	
70	X=730604.29	Y=1534288.66	
71	X=730593.83	Y=1534296.73	
72	X=730580.57	Y=1534296.48	
73	X=730581.94	Y=1534299.11	
74	X=730568.24	Y=1534325.91	
75	X=730593.26	Y=1534317.80	
76	X=730598.95	Y=1534320.31	
77	X=730604.95	Y=1534326.41	
78	X=730604.95	Y=1534321.97	
79	X=730663.55	Y=1534328.95	
80	X=730707.93	Y=1534321.20	
81	X=730722.56	Y=1534329.86	
82	X=730716.80	Y=1534359.96	
83	X=730773.12	Y=1534335.55	
84	X=730781.57	Y=1534352.18	
85	X=730821.95	Y=1534349.84	

EASTING (X)=		NORTHING (Y)=	
85	X=370821.95	Y=1534349.84	
86	X=370880.72	Y=1534370.67	
87	X=370884.90	Y=1534371.88	
88	X=370884.23	Y=1534352.44	
89	X=370888.02	Y=1534358.47	
90	X=370884.12	Y=1534361.91	
91	X=370886.99	Y=1534366.23	
92	X=370885.39	Y=1534382.98	
93	X=370913.20	Y=1534349.67	
94	X=370915.56	Y=1534355.30	
95	X=370941.83	Y=1534346.54	
96	X=370950.01	Y=1534370.40	
97	X=370947.66	Y=1534380.05	
98	X=370962.57	Y=1534382.44	
99	X=370991.05	Y=1534389.45	
100	X=370967.25	Y=1534388.95	
101	X=370966.08	Y=1534388.84	
102	X=370947.19	Y=1534386.09	
103	X=370941.43	Y=1534384.84	
104	X=370324.24	Y=1534383.47	
105	X=370352.94	Y=1534390.96	
106	X=370352.95	Y=1534381.79	
107	X=370364.10	Y=1534400.21	
108	X=370366.98	Y=1534427.16	
109	X=370367.66	Y=1534433.07	
110	X=370367.00	Y=1534420.34	
111	X=370379.38	Y=1534424.38	
112	X=370386.97	Y=1534430.78	
113	X=370398.16	Y=1534426.48	
114	X=370377.58	Y=1534388.79	
115	X=370400.19	Y=1534387.04	
116	X=370388.82	Y=1534406.74	
117	X=370402.77	Y=1534418.51	
118	X=370408.70	Y=1534427.61	
119	X=370426.05	Y=1534412.80	
120	X=370427.29	Y=1534385.02	
121	X=370436.34	Y=1534383.72	
122	X=370448.76	Y=1534383.84	
123	X=370445.36	Y=1534381.58	
124	X=370448.45	Y=1534387.91	
125	X=370457.88	Y=1534387.50	
126	X=370449.54	Y=1534373.87	
127	X=370462.71	Y=1534382.92	
128	X=370479.85	Y=1534350.63	
129	X=370485.48	Y=1534357.71	
130	X=370491.65	Y=1534350.98	
131	X=370496.98	Y=1534343.68	
132	X=370492.96	Y=1534326.45	
133	X=370512.06	Y=1534326.41	
134	X=370500.42	Y=1534326.45	
135	X=370513.82	Y=1534315.54	
136	X=370516.17	Y=1534315.71	
137	X=370513.25	Y=1534313.27	
138	X=370498.95	Y=1534301.43	
139	X=370515.17	Y=1534308.30	
140	X=370533.92	Y=1534303.06	
141	X=370540.30	Y=1534311.80	
142	X=370550.24	Y=1534309.88	
143	X=370549.45	Y=1534303.68	
144	X=370561.47	Y=1534296.76	
145	X=370578.29	Y=1534290.93	
146	X=370569.09	Y=1534285.17	
147	X=370567.26	Y=1534272.98	
148	X=370572.26	Y=1534268.69	
149	X=370569.96	Y=1534245.43	
150	X=370567.22	Y=1534253.75	
151	X=370552.90	Y=1534247.11	
152	X=370571.34	Y=1534233.29	
153	X=370557.45	Y=1534232.32	
154	X=370456.25	Y=1534246.60	
155	X=370547.43	Y=1534231.30	
156	X=370551.83	Y=1534255.07	
157	X=370543.09	Y=1534246.13	
158	X=370534.15	Y=1534243.98	
159	X=370531.56	Y=1534244.35	
160	X=370529.74	Y=1534246.26	
161	X=370528.50	Y=1534246.67	
162	X=370492.96	Y=1534214.46	
163	X=370516.88	Y=1534249.35	
164	X=370514.55	Y=1534261.07	
165	X=370514.22	Y=1534262.41	
166	X=370512.64	Y=1534266.74	
167	X=370512.75	Y=1534264.31	
168	X=370516.70	Y=1534281.80	
169	X=370517.20	Y=1534283.72	
170	X=370517.59	Y=1534285.57	
171	X=370511.85	Y=1534287.58	
172	X=370523.83	Y=1534296.60	
173	X=370527.71	Y=1534301.65	
174	X=370516.93	Y=1534303.27	
175	X=370518.24	Y=1534294.46	

1. LANDSCAPE ARCHITECT WILL PROVIDE ELECTRONIC VERSIONS OF THE PLAN FOR SURVEY STAKING.

 **MORROW REARDON
WILKINSON MILLER, LTD.
LANDSCAPE ARCHITECTS**

210 La Veta NE, Albuquerque, NM 87108
505.268.2266 FAX 505.265.9637
mrw@mrwnm.com

CITY OF ALBUQUERQUE
PARK DESIGN AND CONSTRUCTION DIVISION
DEPARTMENT OF MUNICIPAL DEVELOPMENT

BLACK ARROYO PARK IMPROVEMENTS DIMENSION PLAN


Design Review Committee	City Engineer Approval	Last Design Update	Mo./Day/Yr.	Mo./Day/Yr.
City Project No. 787491		Zone Map No. A-12	Sheet 7 OF 21	

[illegible]

PROJECT# 787491

RECORD DRAWINGS

FINAL FOR CONSTRUCTION
DATE: FEBRUARY 12, 2010

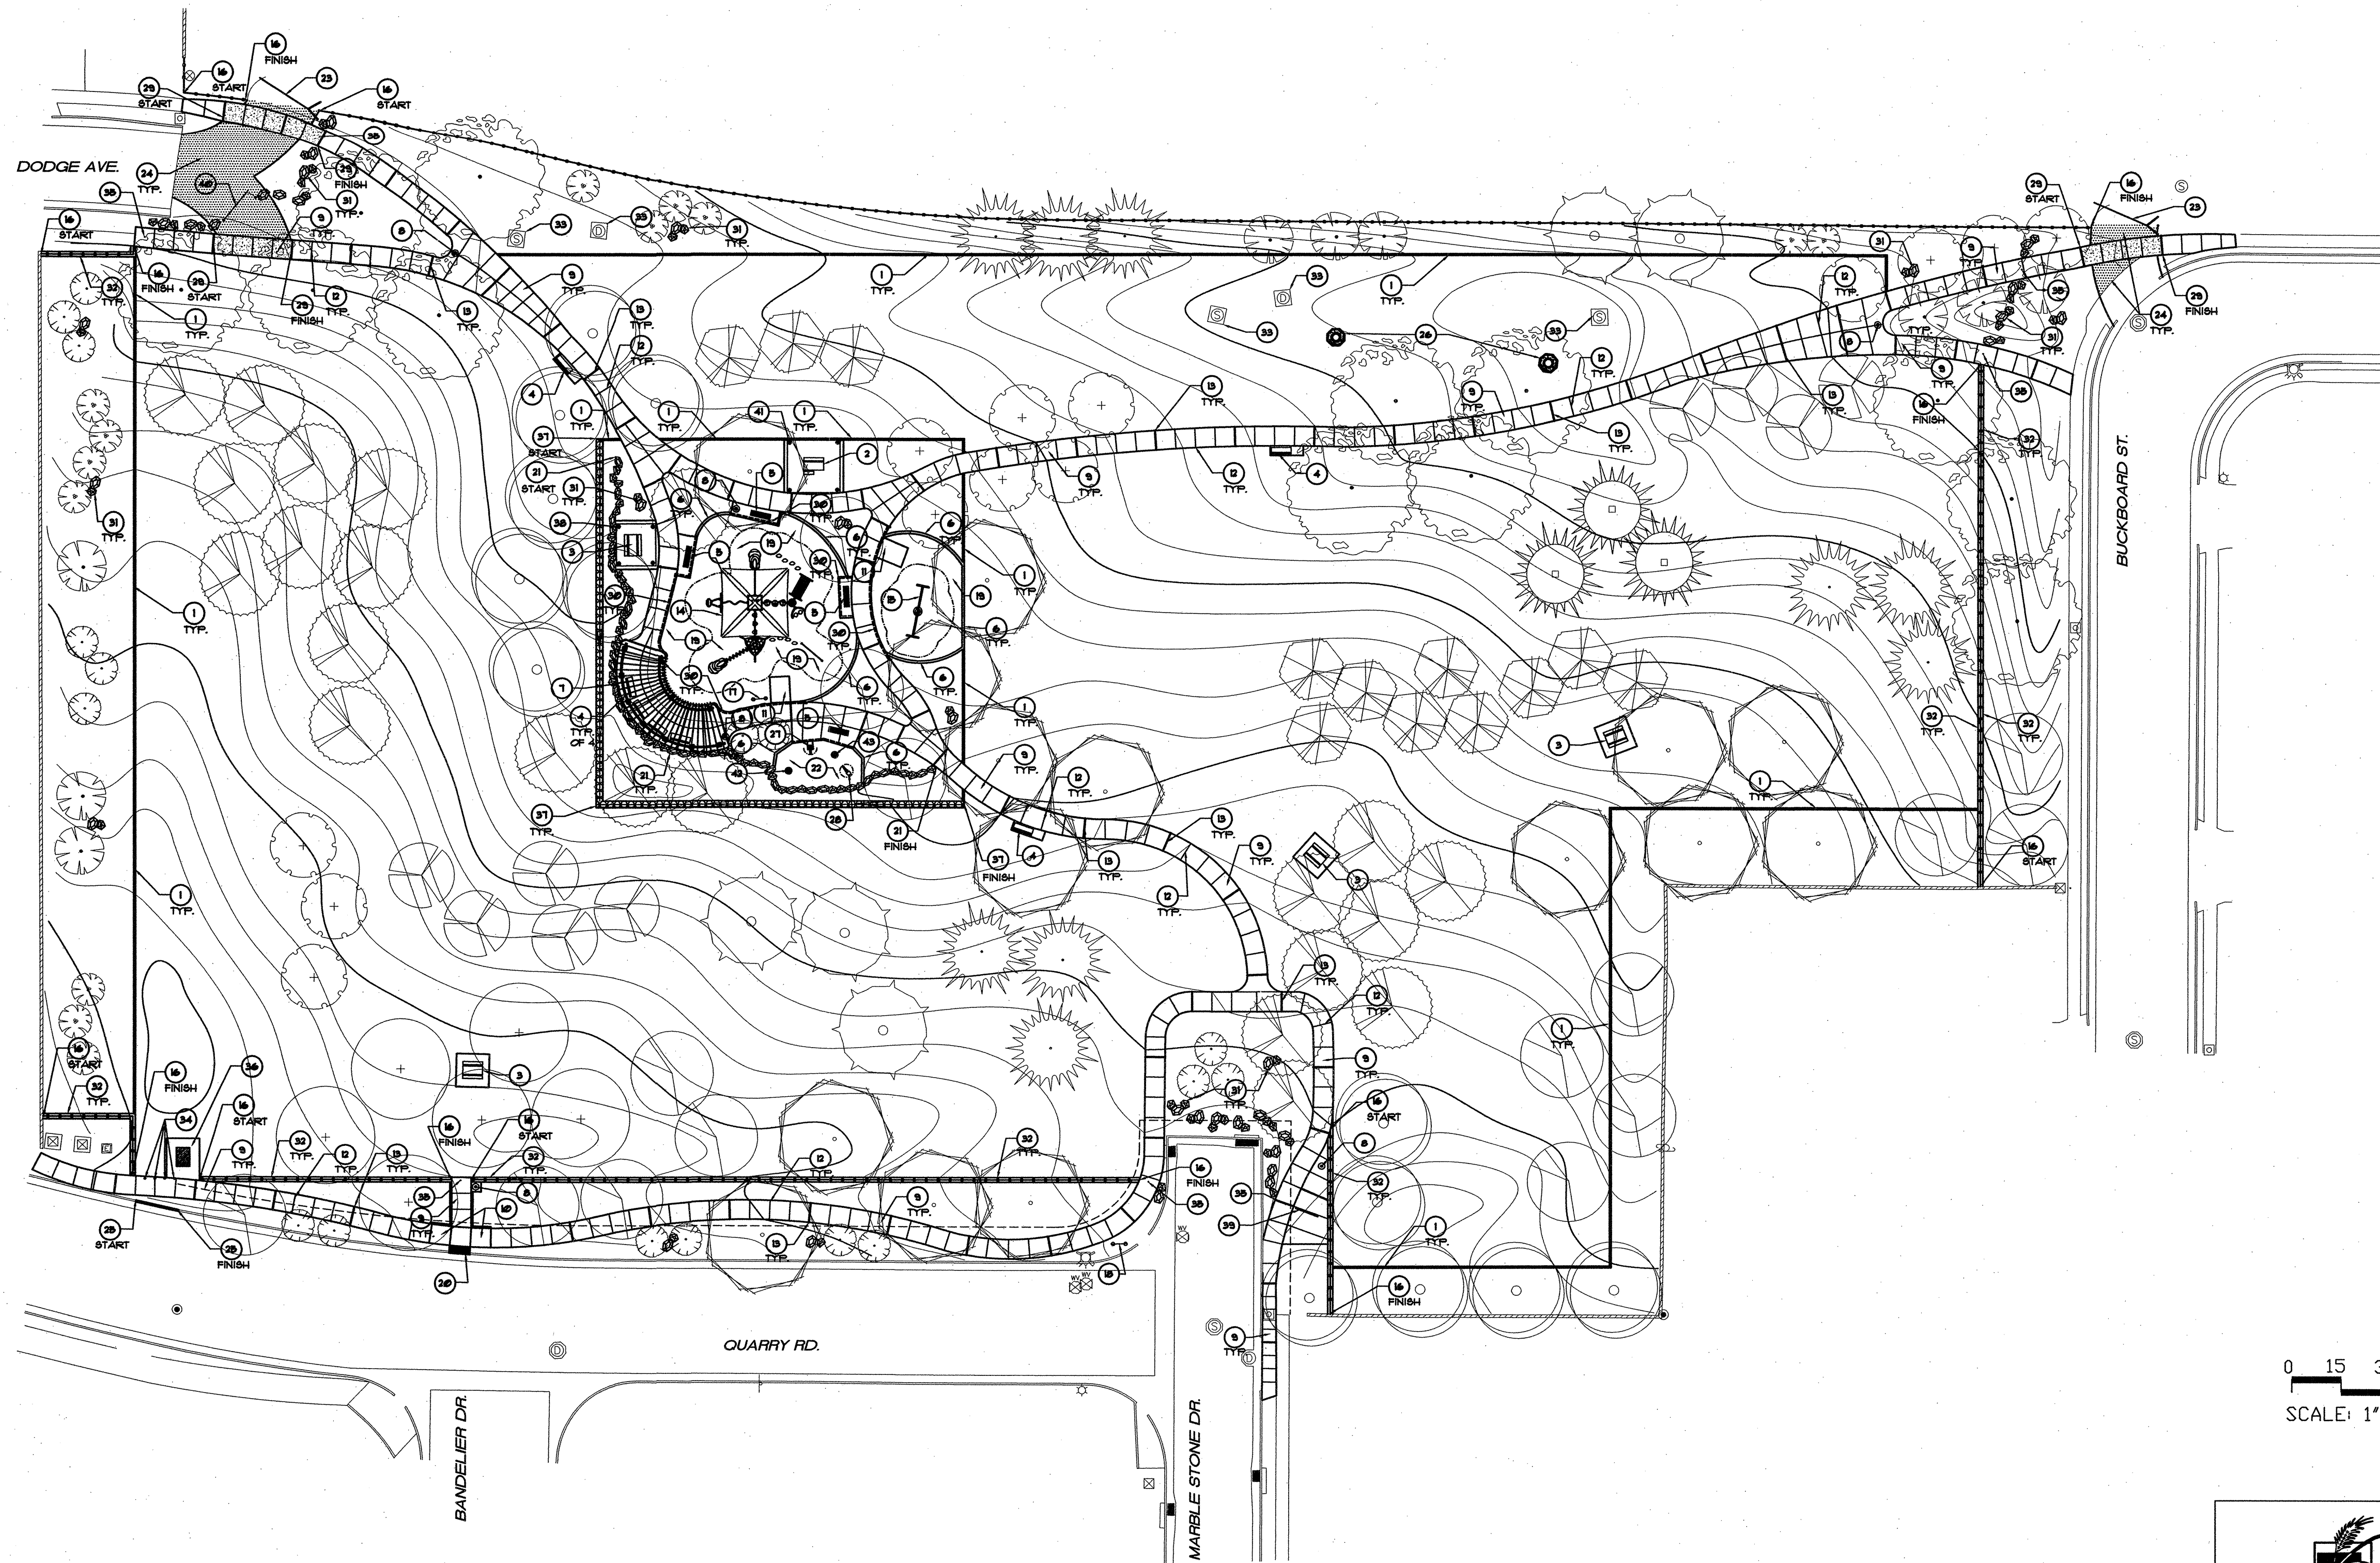

GENERAL NOTE:
SEE SHEETS 9 OF 21 AND 10 OF 21 FOR CONSTRUCTION KEYED NOTES.

**MORROW REARDON
WILKINSON MILLER, LTD.,
LANDSCAPE ARCHITECTS**
210 La Veta NE, Albuquerque, NM 87108
505.268.2266 FAX 505.265.9837
mrlw@mlrwm.com



CITY OF ALBUQUERQUE
PARK DESIGN AND CONSTRUCTION DIVISION
DEPARTMENT OF MUNICIPAL DEVELOPMENT

**BLACK ARROYO PARK IMPROVEMENTS
CONSTRUCTION PLAN**

Design Review Committee	City Engineer Approval	Last Design Update	Mo./Day/Yr.	Mo./Day/Yr.
City Project No.	Zone Map No.	Sheet		
787491	A-12	8 OF 21		

REVISIONS		ARCHITECTURAL SEAL		SURVEY INFORMATION		BENCH MARKS		AS-BUILT INFORMATION	
				NO.	BY	DATE		CONTRACTOR	
								WORK STAGED BY	DATE
								ACCEPTANCE BY	DATE
								FIELD CHECK BY	DATE
								DRAWINGS	DATE
								CORRECTED BY	DATE
								RECORDED BY	DATE
								NO.	

NO.	DATE

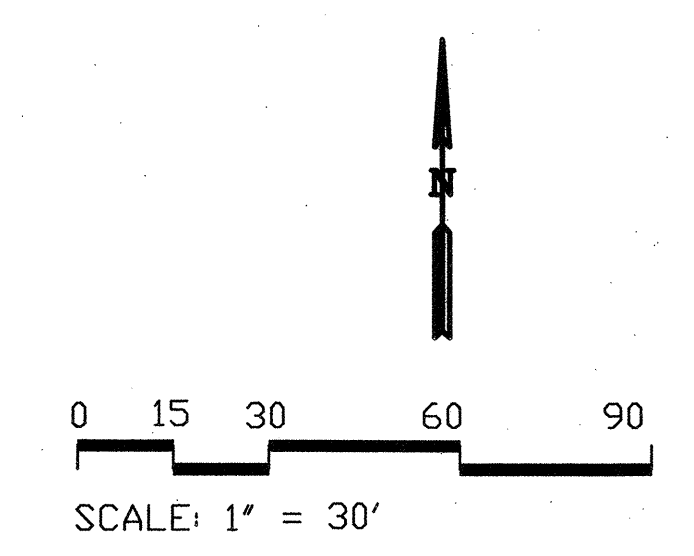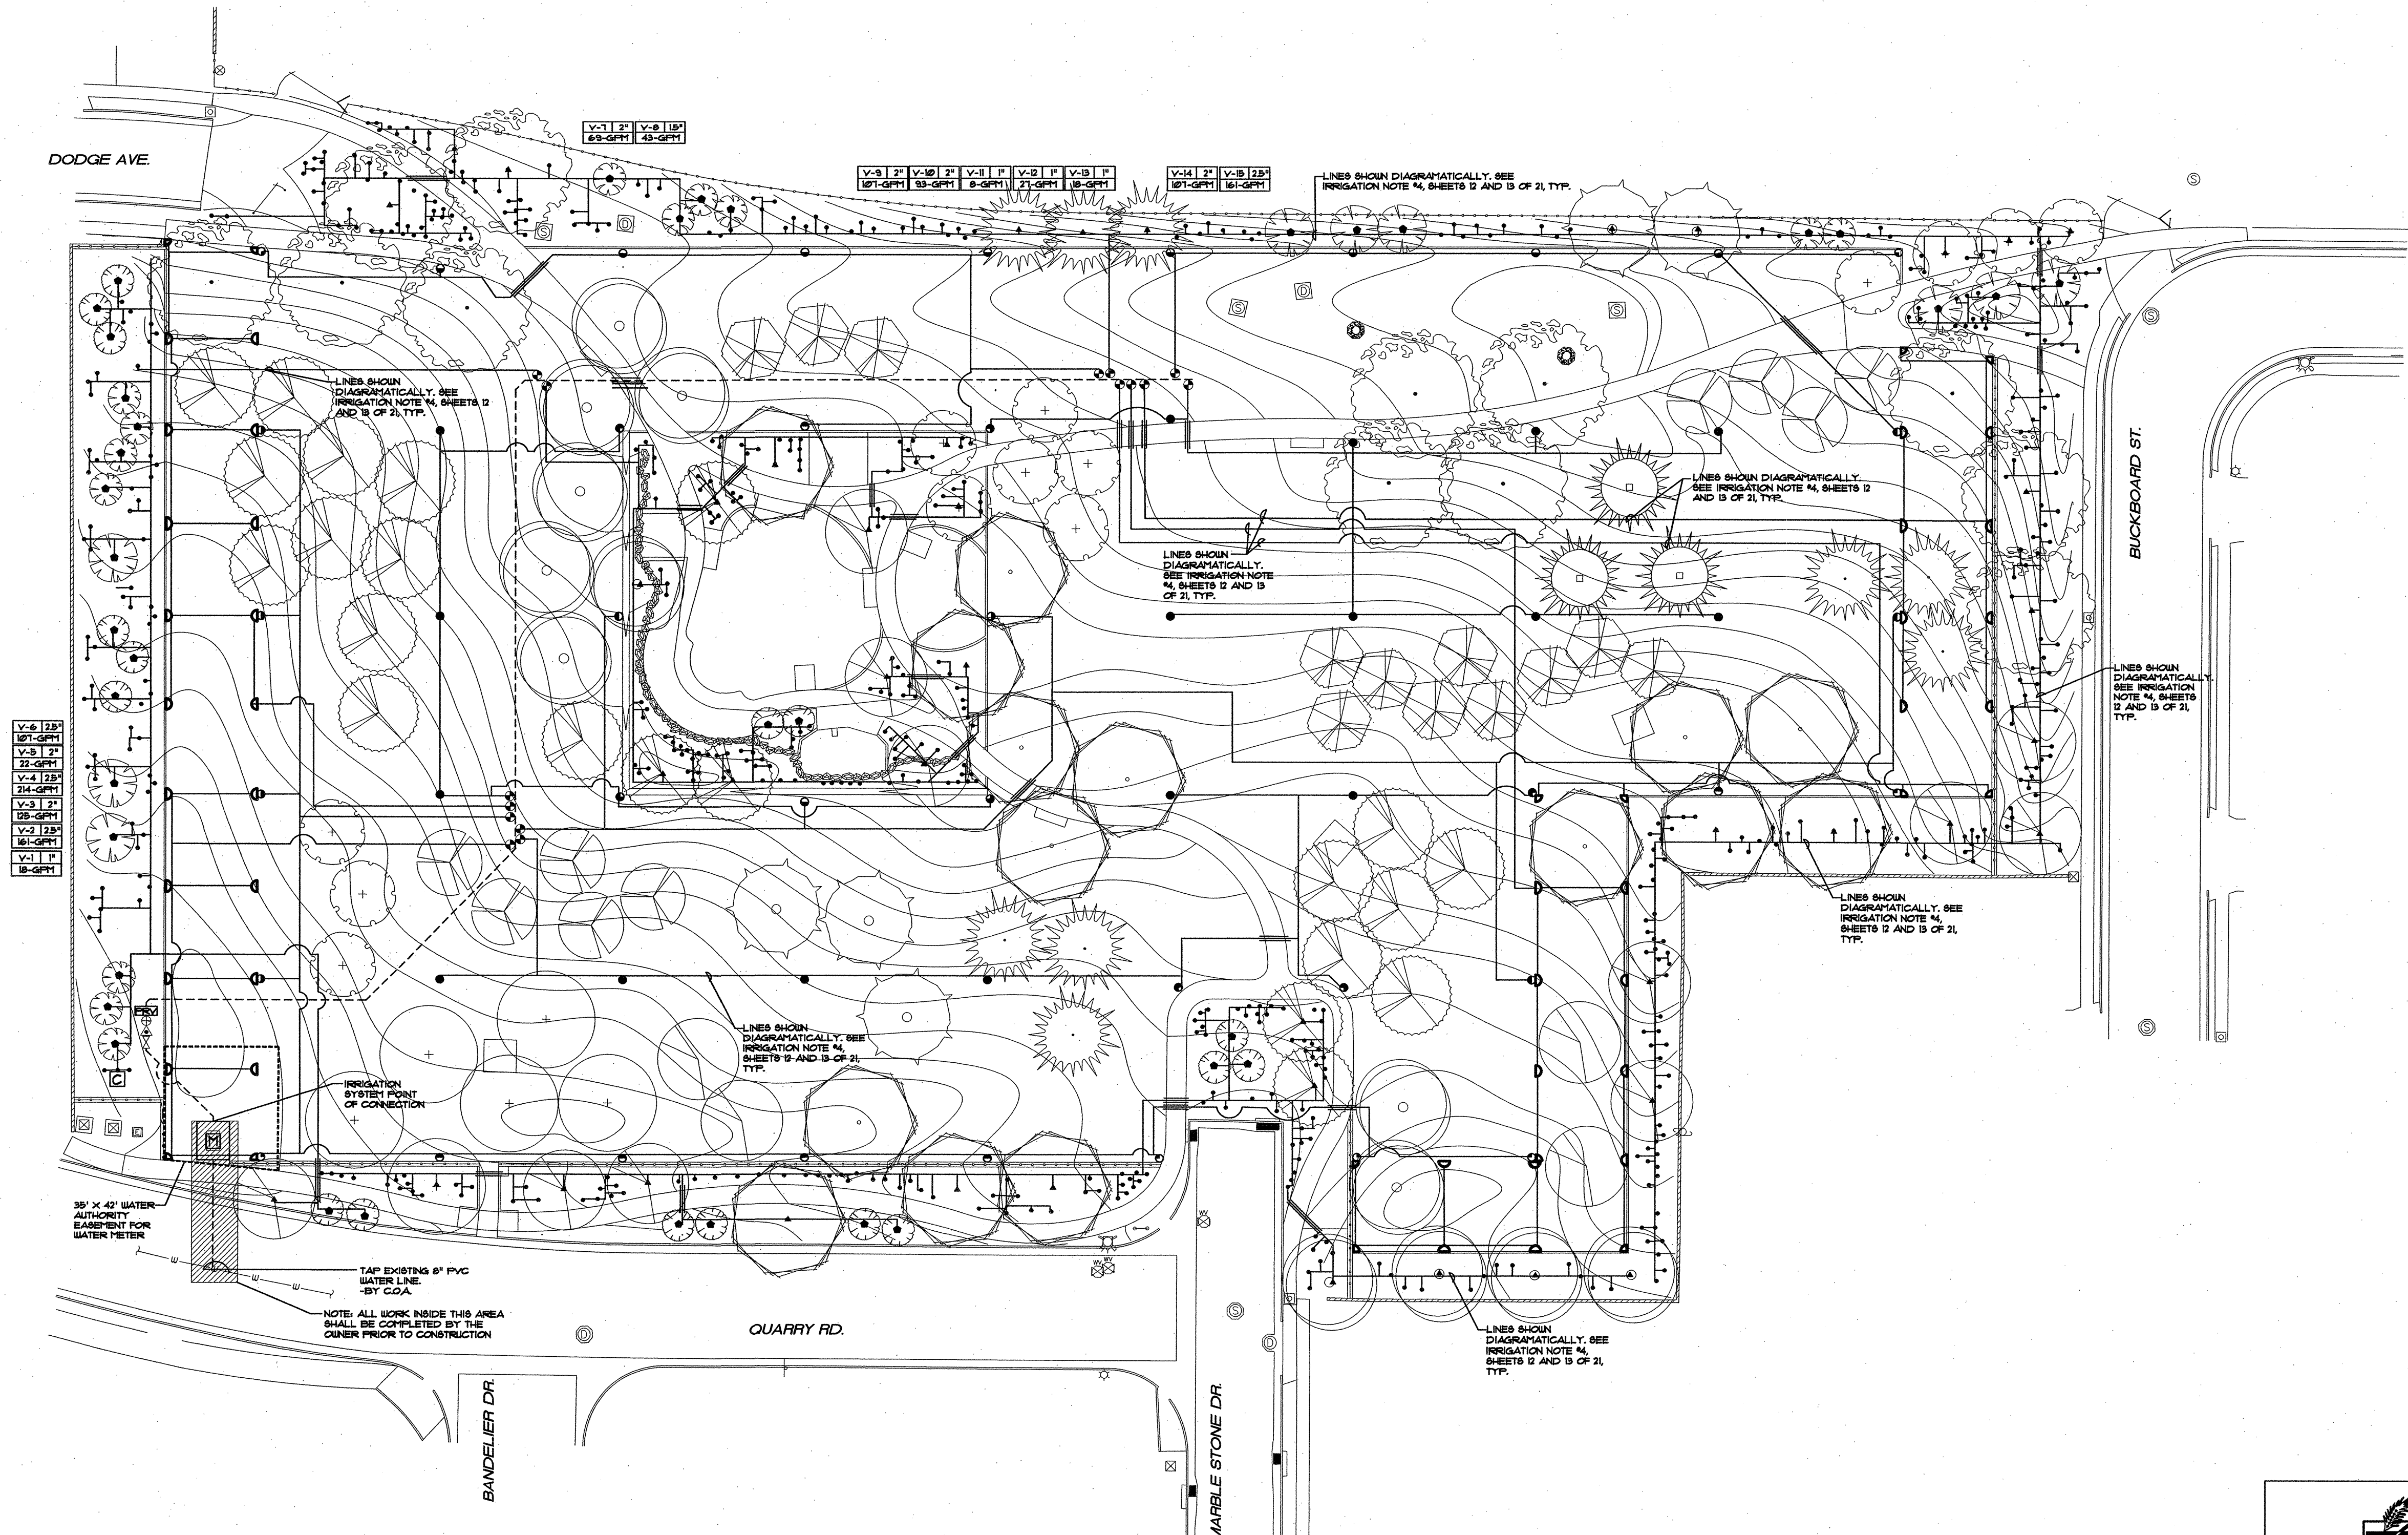

GENERAL NOTE:
SEE SHEETS 12 AND 13 OF 21 FOR IRRIGATION LEGEND, IRRIGATION NOTES, WATER MANAGEMENT GUIDE, IRRIGATION SCHEDULE, AND PIPE SIZING.



**MORROW REARDON
WILKINSON MILLER, LTD.**
LANDSCAPE ARCHITECTS
210 La Veta NE, Albuquerque, NM 87108
505.265.2266 FAX 505.265.9637
mrw@mrwml.com

CITY OF ALBUQUERQUE
PARK DESIGN AND CONSTRUCTION DIVISION
DEPARTMENT OF MUNICIPAL DEVELOPMENT

**BLACK ARROYO PARK IMPROVEMENTS
OVERALL IRRIGATION PLAN**

Design Review Committee

City Engineer Approval

City Project No.
787491

Zone Map No.
A-12

Sheet
11 OF 21

REVISIONS

NO.	DATE	BY

REMARKS

NO.	DATE	BY

DESIGNED BY
AD

DATE
8/27/09

DRAWN BY
BV

DATE
8/27/09

CHECKED BY

DATE
8/27/09

LAST DESIGN UPDATE

Mo./Day/Yr.	Mo./Day/Yr.

AS-BUILT INFORMATION

CONTRACTOR	DATE

SURVEY INFORMATION

FIELD NOTES	DATE

ARCHITECTURAL SEAL


2/2/10

BENCH MARKS

NO.	DATE

MICRO-FILM INFORMATION

NO.	DATE

RECORD DRAWINGS

DATE: **FEBRUARY 12, 2010**

FINAL FOR CONSTRUCTION
DATE: FEBRUARY 12, 2010

Black Arroyo Park Improvements

PROJECT# 787491

RECORD DRAWINGS
DATE:

DODGE AVE.

V-6 1/2" 107-GPM
V-5 2" 22-GPM
V-4 2 1/2" 214-GPM
V-3 2" 125-GPM
V-2 2 1/2" 161-GPM
V-1 1" 18-GPM

V-7 2" 69-GPM
V-8 1 1/2" 43-GPM

V-9 2" 107-GPM
V-10 2" 93-GPM
V-11 1" 8-GPM
V-12 1" 21-GPM
V-13 1" 18-GPM

LINE SHOWN
DIAGRAMMATICALLY. SEE
IRRIGATION NOTE #4, SHEETS 12
AND 13 OF 21, TYP.

LINE SHOWN
DIAGRAMMATICALLY. SEE
IRRIGATION NOTE #4,
SHEETS 12 AND 13 OF 21,
TYP.

IRRIGATION
SYSTEM POINT
OF CONNECTION

35' X 42' WATER
AUTHORITY
EASEMENT FOR
WATER METER

TAP EXISTING 8" PVC
WATER LINE
-BY COA

NOTE: ALL WORK INSIDE THIS AREA

0 10 20 40 60
SCALE: 1" = 20'

MATCHLINE (SEE SHEET 12)

MATCHLINE (SEE SHEET 13)

MATCHLINE (SEE SHEET 13)

IRRIGATION LEGEND

- WATER METER, SIZE: 4". BY COA.
- MAIN LINE AND LATERAL SLEEVE PIPING, CLASS 200, SDR-21, BELL-END, SOLVENT WELD PVC, SEE NOTE NO. 2 BELOW.
- 24-VOLT IRRIGATION WIRE SLEEVE PIPING, CLASS 200, SDR-21, BELL-END, SOLVENT WELD PVC, SEE NOTE NO. 2 BELOW.
- IRRIGATION MAIN LINE, CLASS 200 O-RING AND GASKET, SIZE 6". DEPTH OF BURY 28" FOR CONTINUOUS PRESSURE IRRIGATION MAIN AND 18" FOR NON-CONTINUOUS. ALL JOINTS SHALL HAVE LEEMCO JOINT RESTRAINTS. ALL RUNS SHALL BE TRUE TO LINE.
- LATERAL PIPING, SIZES 2-1/2" AND LARGER SHALL BE CLASS 200, SOLVENT WELD PVC, SIZES 2" AND SMALLER SHALL BE SCH. 40, BELL END, SOLVENT WELD PVC. ALL JOINTS SHALL BE THRUST BLOCKED PER COA STD. DWG. 2104. SIZE AS SHOWN ON PLAN. DEPTH OF BURY, 18". PIPE CONVEYING LESS THAN 5 GPM SHALL BE 3/4"
- MAINLINE ISOLATION VALVE WITH UNIONS. SIZE: 6" SEE COA DETAIL DWG. 2107
- 6" PRESSURE REGULATOR - WATTS SERIES UB - IN AN APPLIED ENGINEERING PRODUCTS 1130-18 VALVE BOX W/ 1130-2A (ABS) BOLT DOWN FLUSH COVER WITH EXTENSIONS AS REQUIRED.
- BACKFLOW PREVENTER, MASTER VALVE, AND FLOW METER ASSEMBLY, FEBCO 880V, 6" REDUCED. PRESSURE PRINCIPLE BACKFLOW PREVENTER WITH BALL VALVES IN HOT BOX MODEL NO. HB4000 HEATED AND INSULATED BACKFLOW ENCLOSURE AND 6" CLA-VAL MASTER VALVE AND MASTER METER FLOW METER, SIZE 6". SEE DETAIL A1/6.
- REMOTE CONTROL VALVE ASSEMBLY, WEATHERMATIC 11024-FCR PLASTIC BODY 24-VOLT AUTOMATIC VALVE, SIZE AS SHOWN ON PLAN. SEE COA DWG. 2103
- SOLVENT WELD CAP, SCH. 40 PVC, LINE SIZE.
- FIXED SPRAY POP-UP SPRINKLER ASSEMBLIES, HUNTER, 1-20 ULTRA SERIES, 4" STAINLESS STEEL AS FOLLOWS: (INSTALL ODD ARCS AS REQUIRED) SEE COA DWG. 2109
- | NOZZLE | RADIUS | GPM | PSI | PR |
|-------------|--------|-----|-----|----|
| 1-20-ADS-15 | 32' | 18 | 55 | 68 |
| 1-20-ADS-15 | 32' | 18 | 55 | 34 |
- ROTARY POP-UP SPRINKLER ASSEMBLIES, HUNTER, 1-25 PLUS SERIES, 3.5" STAINLESS STEEL AS FOLLOWS: SEE COA DWG. 2109
- | MODEL NO. | RADIUS | GPM | PSI | PR |
|-------------|--------|------|-----|-----|
| 1-25-ADS-20 | 62' | 17.8 | 60 | 178 |
| 1-25-ADS-20 | 62' | 17.8 | 60 | 89 |
| 1-25-ADS-20 | 62' | 17.8 | 60 | 66 |
| 1-25-36S-20 | 62' | 17.8 | 60 | 44 |
- PRESSURE COMPENSATING BUBBLER ASSEMBLIES, HUNTER PCB SERIES, AS FOLLOWS: SEE COA DWG. 2110 AND 2111 AND DETAILS A/11, B/11 AND C/11.
- | MODEL NO. | GPM | PSI |
|-----------|-----------------|-----|
| PCB-25 | 25 | 30 |
| PCB-25 | 5 (2 PER SHRUB) | 30 |
| PCB-50/25 | 10/15 | 30 |
- REFERENCE DETAIL B/11
REFERENCE DETAIL C/11
- IRRIGATION CONTROLLER, IRRINET MODEL #16-R2A-HRU-OT-SB M-SERIES 24 STATION CONTROLLER WITH UHF HI POWER RADIO WITH TRANSFORMER, ANTENNA, SURGE PROTECTION, AND COMMUNICATION TO ICC CENTRAL. AVAILABLE FROM MESA TURF PRODUCTS, LLC. (828) 891-3240. INSTALL CONTROLLER IN STROMBOX UL STAINLESS STEEL LOCKING DOOR ENCLOSURE (POWDERCOAT PAINT COLOR: TAN) PER DETAIL B/16. INSTALL GROUNDING RODS AT CONTROLLER PER DETAIL D/16. CONTRACTOR SHALL TEST GROUNDING OF CONTROLLER PER MANUFACTURER'S SPECIFICATIONS AND SHALL PROVIDE TEST RESULTS IN WRITING TO THE OWNER.

WATER MANAGEMENT GUIDE

VALVE I.D. SIZE & TYPE	HEAD TYPE	MODEL NUMBER	QTY.	GPM/HEAD	GPM/TOTAL	OPER. PRESS.	PR @ AVE.	* RUN TIME/DAY TO APPLY 2/3" PRECIPITATION
V-1 SIZE 1" WEATHERMATIC 11024FCR10	HUNTER I-20 SERIES HALF QTR CIRCLE	I-20-ADS-1.5	10	1.8	18	55	.34	1.97 HR
V-2 SIZE 2 1/2" WEATHERMATIC 8200CR25D	HUNTER I-25 SERIES FULL QTR CIRCLE	I-25-36S-20	9	17.8	161	60	.44	1.52 HR
V-3 SIZE 2" WEATHERMATIC 11024FCR20	HUNTER I-25 SERIES HALF QTR CIRCLE	I-25-ADS-20	7	17.8	125	60	.89	.75 HR
V-4 SIZE 2 1/2" WEATHERMATIC 8200CR25D	HUNTER I-25 SERIES FULL QTR CIRCLE	I-25-ADS-20	12	17.8	214	60	.89	.75 HR
V-5 SIZE 1" WEATHERMATIC 11024FCR10	HUNTER I-20 SERIES HALF CIRCLE	I-20-ADS-1.5	12	1.8	22	55	.34	1.97 HR
V-6 SIZE 2 1/2" WEATHERMATIC 8200CR25D	HUNTER I-25 SERIES FULL QTR CIRCLE	I-25-36S-20	6	17.8	107	60	.44	1.52 HR
V-7 SIZE 2" WEATHERMATIC 11024FCR20	BUBBLER ZONE	HUNTER PCB SERIES	332	.25	68	30	N/A	.45 HR
V-8 SIZE 1 1/2" WEATHERMATIC 11024FCR15	BUBBLER ZONE	HUNTER PCB SERIES	192	.25	43	30	N/A	.45 HR
V-9 SIZE 2" WEATHERMATIC 11024FCR20	HUNTER I-25 SERIES HALF QTR CIRCLE	I-25-ADS-20	6	17.8	107	60	.89	.75 HR
V-10 SIZE 2" WEATHERMATIC 11024FCR20	BUBBLER ZONE	HUNTER PCB SERIES	320	.25	93	30	N/A	.45 HR
V-11 SIZE 1" WEATHERMATIC 11024FCR10	HUNTER I-20 SERIES QTR CIRCLE	I-20-ADS-1.5	4	1.8	8	55	.68	.99 HR
V-12 SIZE 1" WEATHERMATIC 11024FCR10	HUNTER I-20 SERIES HALF QTR CIRCLE	I-20-ADS-1.5	15	1.8	27	55	.34	1.97 HR
V-13 SIZE 1" WEATHERMATIC 11024FCR10	HUNTER I-20 SERIES HALF QTR CIRCLE	5-20-ADS-1.5	10	1.8	18	55	.34	1.97 HR
V-14 SIZE 2" WEATHERMATIC 11024FCR20	HUNTER I-25 SERIES HALF QTR CIRCLE	I-25-ADS-20	6	17.8	107	60	.89	.75 HR
V-15 SIZE 2" WEATHERMATIC 11024FCR20	HUNTER I-25 SERIES FULL CIRCLE	I-25-36S-20	9	17.8	161	60	.44	1.52 HR
TOTAL TIME TO APPLY 2/3" PRECIPITATION WITH SAME-HEAD VALVES OPERATING TOGETHER: 5.23 HRS								

IRRIGATION SCHEDULE

PROGRAM	VALVES	PR CALC	RUN TIME	CYCLES	TOTAL GPM	COMMENTS
1	1, 5, 12, 13	.34	1.97 HRS	1	85	
2	2, 6, 15	.44	1.52 HRS	1	429	
3	3, 4, 9, 14	.89	.75 HRS	1	553	
4	11	.68	.99 HRS	1	8	
5	7, 8, 10	N/A	N/A	N/A	N/A	
TOTAL RUN TIME FOR ROTOR HEADS TO APPLY 2/3": 5.23 HOURS					553	MAX FLOW @ MASTER

IRRIGATION NOTES

- CONTRACTOR SHALL FURNISH ALL LABOR, MATERIALS AND EQUIPMENT NECESSARY TO CONSTRUCT PROPOSED IRRIGATION SYSTEM IN ACCORDANCE WITH PLANS, WRITTEN SPECIFICATIONS AND DETAILS.
- THE CONTRACTOR SHALL COORDINATE THE INSTALLATION OF SLEEVE PIPING WITH ALL TRADES TO INSURE THAT SLEEVES ARE INSTALLED PROPERLY PRIOR TO INSTALLATION OF CURBS AND GUTTER, ASPHALT PAVING, SIDEWALKS, CONCRETE PADS, ETC.
- THIS SYSTEM WAS DESIGNED AT A MINIMUM STATIC PRESSURE OF 106 PSI AT THE POINT OF CONNECTION. CONTRACTOR SHALL VERIFY ACTUAL PSI AND DELIVER RESULTS TO LANDSCAPE ARCHITECT PRIOR TO CONSTRUCTION. IN THE EVENT THE ACTUAL PSI AT THE POINT OF CONNECTION IS LESS THAN 114 PSI THE CONTRACTOR SHALL RECEIVE DIRECTION FROM LANDSCAPE ARCHITECT REGARDING DESIGN MODIFICATIONS IF NECESSARY.
- PIPE ROUTING IS SHOWN DIAGRAMMATICALLY. PIPE SHALL BE ROUTED TO ACHIEVE MINIMUM 10' CLEARANCE FROM THE TRUNK OF ANY TREE. PIPE ROUTING SHALL BE REVIEWED WITH THE LANDSCAPE ARCHITECT PRIOR TO TRENCHING.
- IN NO CASE SHALL A ROTOR HEAD OR IRRIGATION VALVE BE LOCATED WITHIN 12' OF ANY TREE TRUNK.
- CONTRACTOR SHALL LOCATE ALL ROTOR HEADS IN TURF AREAS WITH GPS EQUIPMENT PRIOR TO INSTALLATION. HEAD LAYOUT SHALL BE APPROVED BY LANDSCAPE ARCHITECT PRIOR TO INSTALLATION.

**MORROW REARDON
WILKINSON MILLER, LTD.,
LANDSCAPE ARCHITECTS**
210 La Vista NE, Albuquerque, NM 87108
505.268.2286 FAX 505.268.9837
mrw@mrwm.com

CITY OF ALBUQUERQUE
PARK DESIGN AND CONSTRUCTION DIVISION
DEPARTMENT OF MUNICIPAL DEVELOPMENT

BLACK ARROYO PARK IMPROVEMENTS
IRRIGATION PLAN

Design Review Committee	City Engineer Approval	Mo./Day/Yr.	Mo./Day/Yr.
City Project No.	Zone Map No.	Sheet	
787491	A-12	12 OF 21	



FINAL FOR CONSTRUCTION
DATE: FEBRUARY 12, 2010

Black Arroyo Park Improvements

PROJECT# 787491

RECORD DRAWINGS
DATE:

MATCHLINE (SEE SHEET 12)

MATCHLINE (SEE SHEET 12)

MATCHLINE (SEE SHEET 12)

V-14 2" 107-GPM
V-15 2.5" 161-GPM

LINE SHOWN DIAGRAMMATICALLY. SEE IRRIGATION NOTE #4, SHEETS 12 AND 13 OF 21, TYP.

LINE SHOWN DIAGRAMMATICALLY. SEE IRRIGATION NOTE #4, SHEETS 12 AND 13 OF 21, TYP.

BUCKBOARD ST.

IRRIGATION LEGEND

- WATER METER, SIZE: 4". BY C.O.A.**
- MAIN LINE AND LATERAL SLEEVE PIPING, CLASS 200, SDR-21, BELL-END, SOLVENT WELD PVC, SEE NOTE NO. 2 BELOW.**
- 24-VOLT IRRIGATION WIRE SLEEVE PIPING, CLASS 200, SDR-21, BELL-END, SOLVENT WELD PVC, SEE NOTE NO. 2 BELOW.**
- IRRIGATION MAIN LINE, CLASS 200 O-RING AND GASKET, SIZE 6". DEPTH OF BURY 28" FOR CONTINUOUS PRESSURE IRRIGATION MAIN AND 18" FOR NON-CONTINUOUS. ALL JOINTS SHALL HAVE LEMCO JOINT RESTRAINTS. ALL RUNS SHALL BE TRUE TO LINE.**
- LATERAL PIPING: SIZES 2-1/2" AND LARGER SHALL BE CLASS 200, SOLVENT WELD PVC. SIZES 2" AND SMALLER SHALL BE SCH. 40, BELL END, SOLVENT WELD PVC. ALL JOINTS SHALL BE THRUST BLOCKED PER COA STD. DWG. 2104. SIZE AS SHOWN ON PLAN. DEPTH OF BURY, 18". PIPE CONVEYING LESS THAN 5 GPM SHALL BE 3/4"**
- MAINLINE ISOLATION VALVE WITH UNIONS. SIZE: 6" SEE COA DETAIL DWG. 2107**
- 6" PRESSURE REGULATOR - WATTS SERIES U5 - IN AN APPLIED ENGINEERING PRODUCTS 1130-10 VALVE BOX W/ 1130-24 (ABS) BOLT DOWN FLUSH COVER WITH EXTENSIONS AS REQUIRED.**
- BACKFLOW PREVENTER, MASTER VALVE, AND FLOW METER ASSEMBLY, FEBCO 880V, 6" REDUCED PRESSURE PRINCIPLE BACKFLOW PREVENTER WITH BALL VALVES IN HOT BOX MODEL NO. HB4000 HEATED AND INSULATED BACKFLOW ENCLOSURE AND 6" CLA-VAL MASTER VALVE AND MASTER METER FLOW METER, SIZE 6". SEE DETAIL A/16.**
- REMOTE CONTROL VALVE ASSEMBLY, WEATHERMATIC 11024-FCR PLASTIC BODY 24-VOLT AUTOMATIC VALVE, SIZE AS SHOWN ON PLAN. SEE COA DWG. 2103**
- SOLVENT WELD CAP, SCH. 40 PVC, LINE SIZE.**
- FIXED SPRAY POP-UP SPRINKLER ASSEMBLIES, HUNTER I-20 ULTRA SERIES, 4" STAINLESS STEEL AS FOLLOWS: (INSTALL ODD ARCS AS REQUIRED) SEE COA DWG. 2109**
- | NOZZLE | RADIUS | GPM | PSI | PR. D. |
|-------------|--------|-----|-----|--------|
| I-20-ADS-15 | 32' | 18 | 55 | 6.8 |
| I-20-ADS-15 | 32' | 18 | 55 | 3.4 |
- ROTARY POP-UP SPRINKLER ASSEMBLIES, HUNTER I-25 PLUS SERIES, 3.5" STAINLESS STEEL AS FOLLOWS: SEE COA DWG. 2109**
- | MODEL NO. | RADIUS | GPM | PSI | PR. D. |
|-------------|--------|------|-----|--------|
| I-25-ADS-20 | 62' | 11.8 | 60 | 1.0 |
| I-25-ADS-20 | 62' | 11.8 | 60 | 2.0 |
| I-25-ADS-20 | 62' | 11.8 | 60 | 6.6 |
| I-25-36S-20 | 62' | 11.8 | 60 | 4.4 |
- PRESSURE COMPENSATING BUBBLER ASSEMBLIES, HUNTER PCB SERIES, AS FOLLOWS: SEE COA DWG. 2110 AND 2111 AND DETAILS A/11, B/11 AND C/11.**
- | MODEL NO. | GPM | PSI |
|-----------|-----------------|-----|
| PCB-25 | 25 | 30 |
| PCB-25 | 5 (2 FPR SHRUB) | 30 |
| PCB-50/25 | 10/15 | 30 |
- REFERENCE DETAIL B/11**
- REFERENCE DETAILS A/11 & C/11**
- IRRIGATION CONTROLLER, IRRINET MODEL #16-R2A-HRU-OT-SB M-SERIES 24 STATION CONTROLLER WITH UHF HI POWER RADIO WITH TRANSFORMER, ANTENNA, SURGE PROTECTION, AND COMMUNICATION TO ICC CENTRAL. AVAILABLE FROM MESA TURF PRODUCTS, LLC. (805) 891-3240. INSTALL CONTROLLER IN STRONGBOX UL STAINLESS STEEL LOCKING DOOR ENCLOSURE (POWDERCOAT PAINT COLOR: TAN) PER DETAIL B/16. INSTALL GROUNDING RODS AT CONTROLLER PER DETAIL D/16. CONTRACTOR SHALL TEST GROUNDING OF CONTROLLER PER MANUFACTURER'S SPECIFICATIONS AND SHALL PROVIDE TEST RESULTS IN WRITING TO THE OWNER.**

WATER MANAGEMENT GUIDE


VALVE I.D. SIZE & TYPE	HEAD TYPE	MODEL NUMBER	QTY.	GPM/HEAD	GPM/TOTAL	OPER. PRESS.	PR. D. AVE.	* RUN TIME/DAY TO APPLY 2/3" PRECIPITATION
V-1 SIZE 1" WEATHERMATIC 11024FCR10	HUNTER I-20 SERIES HALF QTR CIRCLE	I-20-ADS-15	10	1.8	18	55	.34	1.97 HR
V-2 SIZE 2.5" WEATHERMATIC 8200CR25D	HUNTER I-25 SERIES FULL 1/2 CIRCLE	I-25-36S-20	9	17.8	161	60	.44	1.52 HR
V-3 SIZE 2" WEATHERMATIC 11024FCR20	HUNTER I-25 SERIES HALF QTR CIRCLE	I-25-ADS-20	7	17.8	125	60	.89	.75 HR
V-4 SIZE 2.5" WEATHERMATIC 8200CR25D	HUNTER I-25 SERIES HALF QTR CIRCLE	I-25-ADS-20	12	17.8	214	60	.89	.75 HR
V-5 SIZE 1" WEATHERMATIC 11024FCR10	HUNTER I-20 SERIES HALF CIRCLE	I-20-ADS-15	12	1.8	22	55	.34	1.97 HR
V-6 SIZE 2.5" WEATHERMATIC 8200CR25D	HUNTER I-25 SERIES FULL 1/2 CIRCLE	I-25-36S-20	6	17.8	107	60	.44	1.52 HR
V-7 SIZE 2" WEATHERMATIC 11024FCR20	BUBBLER ZONE	HUNTER PCB SERIES	332	.25	68	30	N/A	.45 HR
V-8 SIZE 1.5" WEATHERMATIC 11024FCR15	BUBBLER ZONE	HUNTER PCB SERIES	192	.25	43	30	N/A	.45 HR
V-9 SIZE 2" WEATHERMATIC 11024FCR20	HUNTER I-25 SERIES HALF QTR CIRCLE	I-25-ADS-20	6	17.8	107	60	.89	.75 HR
V-10 SIZE 2" WEATHERMATIC 11024FCR20	BUBBLER ZONE	HUNTER PCB SERIES	320	.25	93	30	N/A	.45 HR
V-11 SIZE 1" WEATHERMATIC 11024FCR10	HUNTER I-20 SERIES QTR CIRCLE	I-20-ADS-15	4	1.8	8	55	.68	.99 HR
V-12 SIZE 1" WEATHERMATIC 11024FCR10	HUNTER I-20 SERIES HALF QTR CIRCLE	I-20-ADS-15	15	1.8	27	55	.34	1.97 HR
V-13 SIZE 1" WEATHERMATIC 11024FCR10	HUNTER I-20 SERIES HALF QTR CIRCLE	5-20-ADS-15	10	1.8	18	55	.34	1.97 HR
V-14 SIZE 2" WEATHERMATIC 11024FCR20	HUNTER I-25 SERIES HALF QTR CIRCLE	I-25-ADS-20	6	17.8	107	60	.89	.75 HR
V-15 SIZE 2" WEATHERMATIC 11024FCR20	HUNTER I-25 SERIES FULL CIRCLE	I-25-36S-20	9	17.8	161	60	.44	1.52 HR
TOTAL TIME TO APPLY 2/3" PRECIPITATION WITH SAME-HEAD VALVES OPERATING TOGETHER:								5.23 HRS

IRRIGATION SCHEDULE

PROGRAM	VALVES	PR. CALC.	RUN TIME	CYCLES	TOTAL GPM	COMMENTS
1	1, 5, 12, 13,	.34	1.97 HRS	1	85	
2	2, 6, 15	.44	1.52 HRS	1	429	
3	3, 4, 9, 14	.89	.75 HRS	1	553	
4	11	.68	.99 HRS	1	8	
5	7, 8, 10	N/A	N/A	N/A	N/A	MAX FLOW @ MASTER
TOTAL RUN TIME FOR ROTOR HEADS TO APPLY 2/3" 5.23 HOURS						

IRRIGATION NOTES

- CONTRACTOR SHALL FURNISH ALL LABOR, MATERIALS AND EQUIPMENT NECESSARY TO CONSTRUCT PROPOSED IRRIGATION SYSTEM IN ACCORDANCE WITH PLANS, WRITTEN SPECIFICATIONS AND DETAILS.
- THE CONTRACTOR SHALL COORDINATE THE INSTALLATION OF SLEEVE PIPING WITH ALL TRADES TO INSURE THAT SLEEVES ARE INSTALLED PROPERLY PRIOR TO INSTALLATION OF CURB AND GUTTER, ASPHALT PAVING, SIDEWALKS, CONCRETE PADS, ETC.
- THIS SYSTEM WAS DESIGNED AT A MINIMUM STATIC PRESSURE OF 106 PSI AT THE POINT OF CONNECTION. CONTRACTOR SHALL VERIFY ACTUAL PSI AND DELIVER RESULTS TO LANDSCAPE ARCHITECT PRIOR TO CONSTRUCTION. IN THE EVENT THE ACTUAL PSI AT THE POINT OF CONNECTION IS LESS THAN 114 PSI THE CONTRACTOR SHALL RECEIVE DIRECTION FROM LANDSCAPE ARCHITECT REGARDING DESIGN MODIFICATIONS IF NECESSARY.
- PIPE ROUTING IS SHOWN DIAGRAMMATICALLY. PIPE SHALL BE ROUTED TO ACHIEVE MINIMUM 10' CLEARANCE FROM THE TRUNK OF ANY TREE. PIPE ROUTING SHALL BE REVIEWED WITH THE LANDSCAPE ARCHITECT PRIOR TO TRENCHING.
- IN NO CASE SHALL A ROTOR HEAD OR IRRIGATION VALVE BE LOCATED WITHIN 12' OF ANY TREE TRUNK.
- CONTRACTOR SHALL LOCATE ALL ROTOR HEADS IN TURF AREAS WITH GPS EQUIPMENT PRIOR TO INSTALLATION. HEAD LAYOUT SHALL BE APPROVED BY LANDSCAPE ARCHITECT PRIOR TO INSTALLATION.

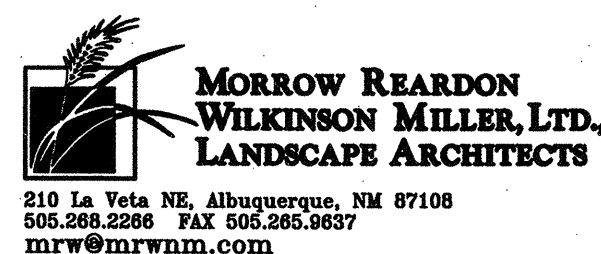

CITY OF ALBUQUERQUE
PARK DESIGN AND CONSTRUCTION DIVISION
DEPARTMENT OF MUNICIPAL DEVELOPMENT

BLACK ARROYO PARK IMPROVEMENTS IRRIGATION PLAN


Design Review Committee	City Engineer Approval	Mo./Day/Yr.	Mo./Day/Yr.
City Project No.	Zone Map No.	Sheet	
787491	A-12	13 OF 21	

FINAL FOR CONSTRUCTION
DATE: FEBRUARY 12, 2010

Black Arroyo Park Improvements

PROJECT# 787491

RECORD DRAWINGS
DATE:

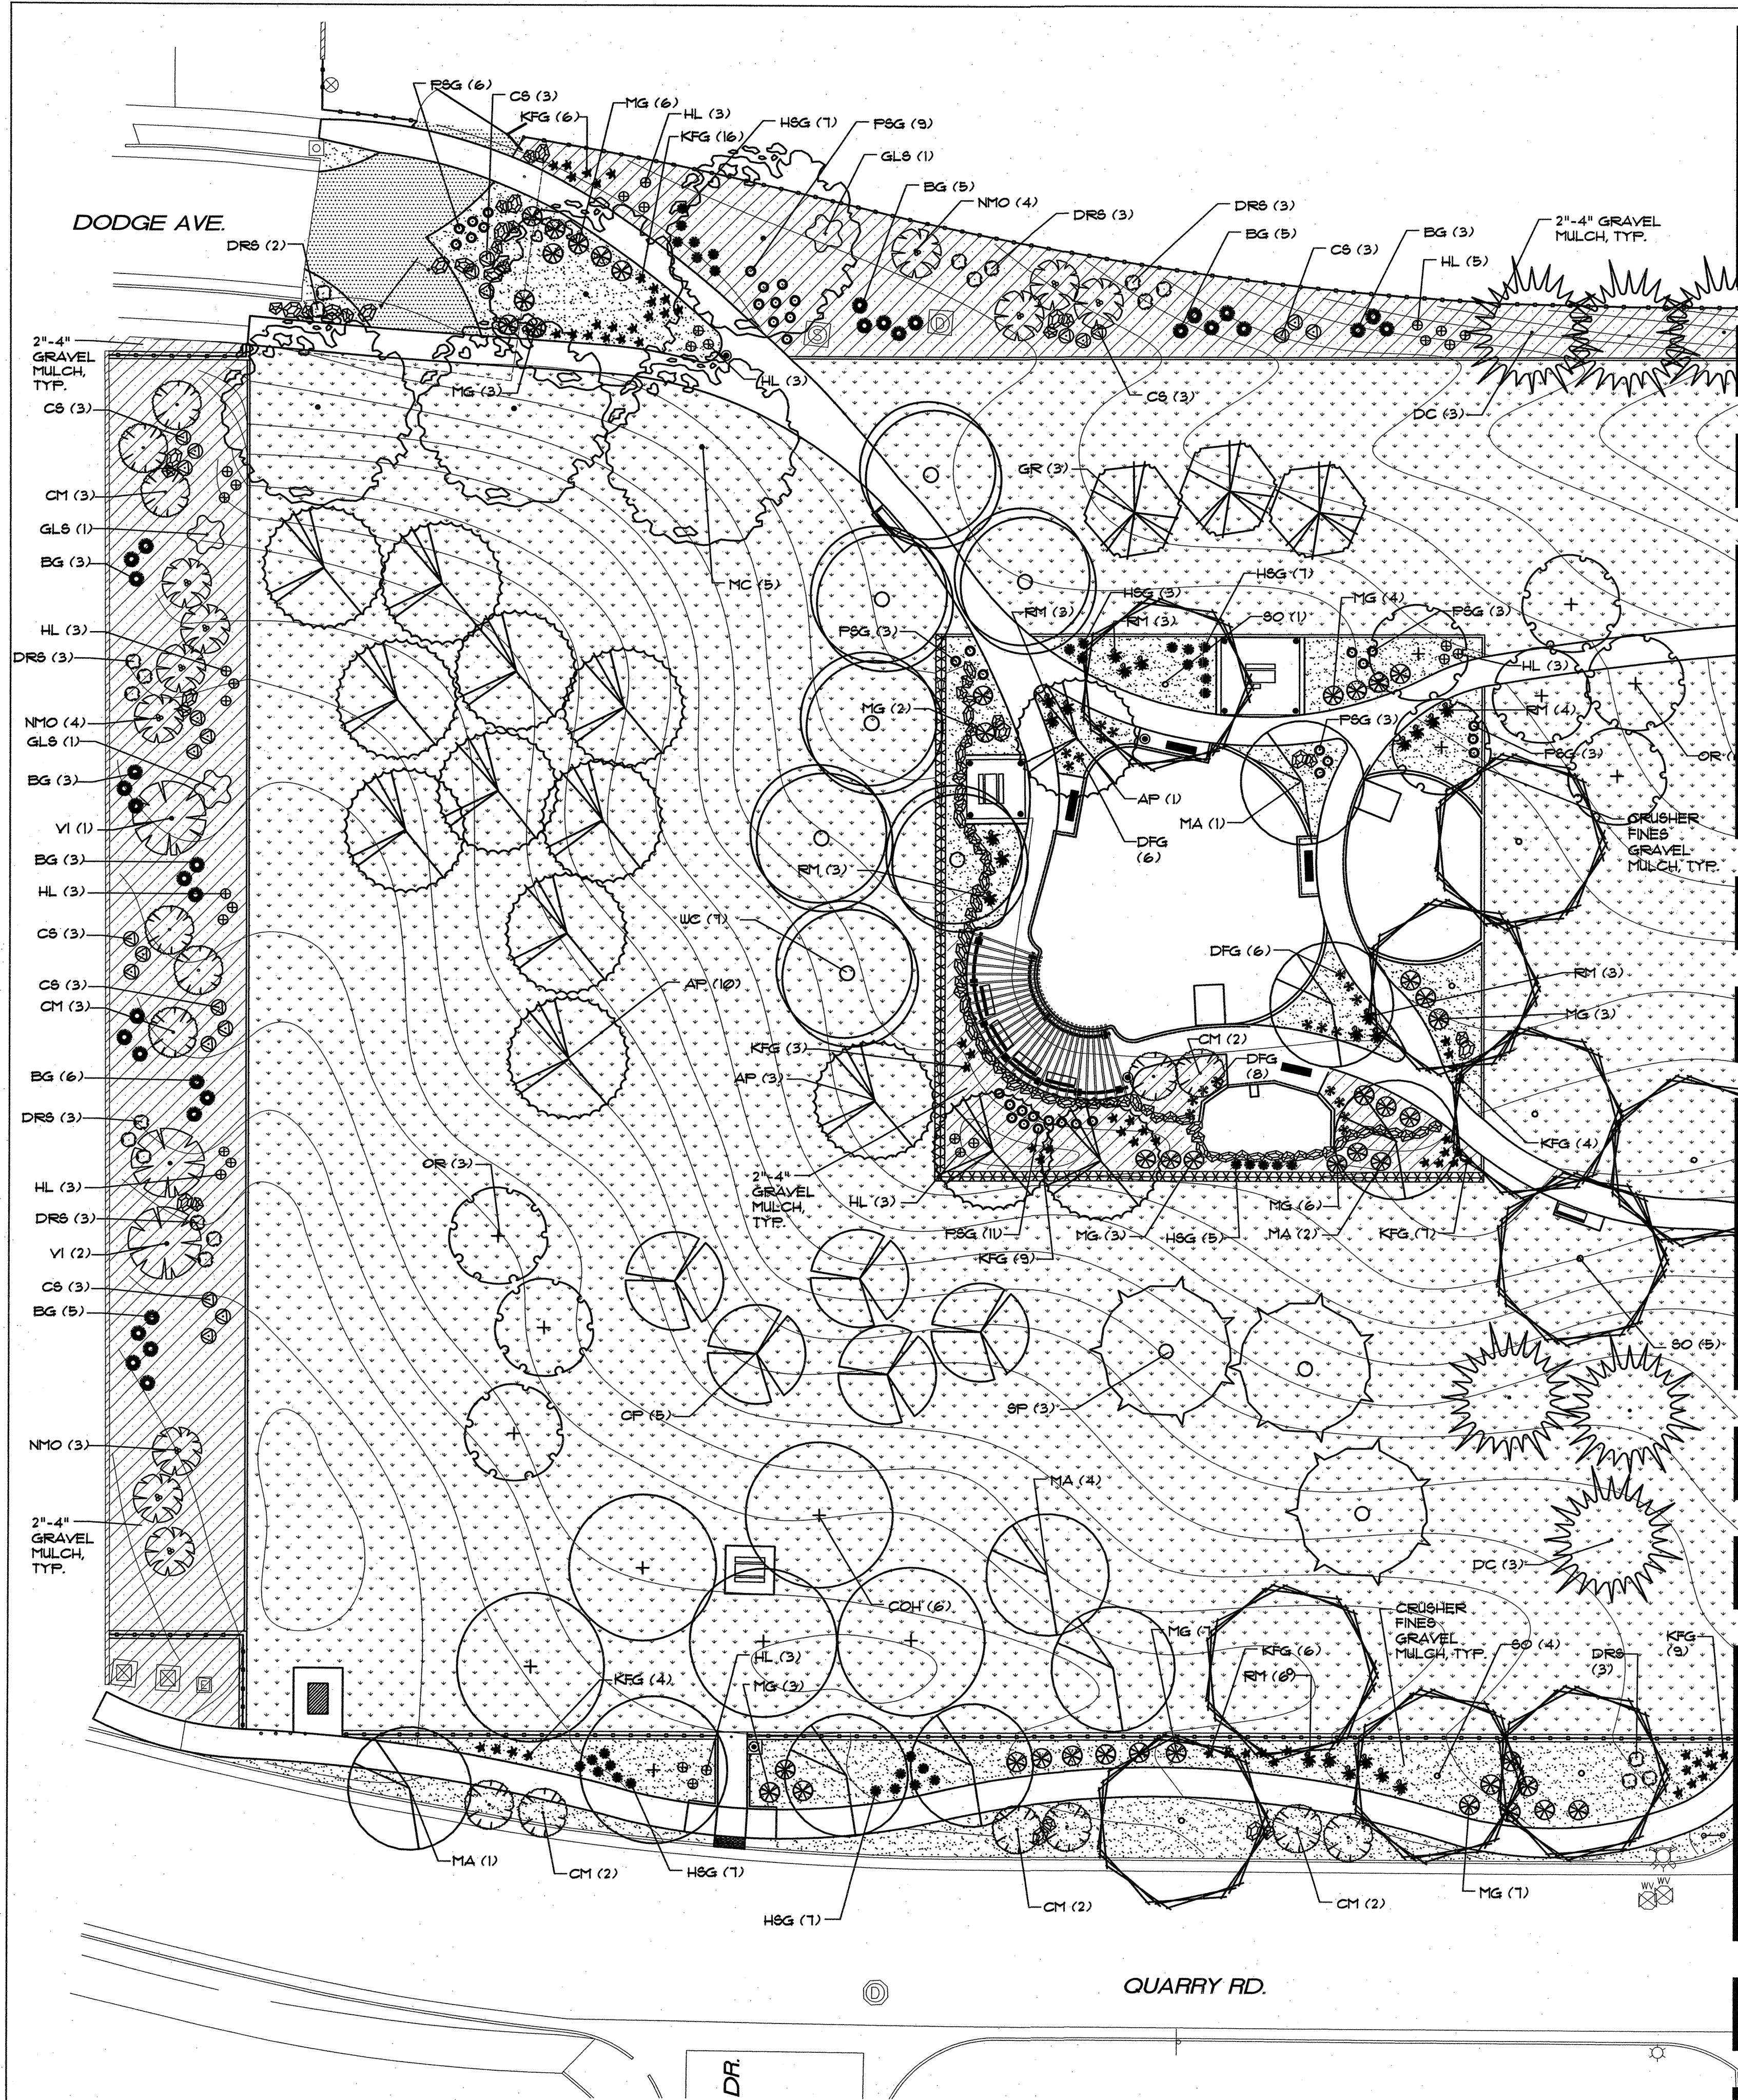

MATCHLINE (SEE SHEET 15)

MATCHLINE (SEE SHEET 15)

MATCHLINE (SEE SHEET 15)


PLANT SCHEDULE



KEY	COMMON NAME	BOTANICAL NAME	QUANTITY	SIZE		REMARKS
				INSTALLED	MATURE	
EVERGREEN TREES						
AC	Atlas Cedar	Cedrus atlantica	3	5'-1' ht.	40' ht. x 30' spd.	30" box
DC	Deodar Cedar	Cedrus deodara	9	5'-1' ht.	50' ht. x 30' spd.	30" box
SP	Scotch Pine	Pinus sylvestris 'Albyn'	5	5'-1' ht.	50' ht. x 30' spd.	30" box
LARGE DECIDUOUS TREES						
AP	Autumn Purple Ash	Fraxinus americana 'Autumn Purple'	22	2 1/2" cal, 12'-14' ht.	40' ht. x 25' spd.	30" box
COH	Common Hackberry	Celtis occidentalis	6	2 1/2" cal, 12'-14' ht.	30' ht. x 4' spd.	30" box
SO	Shumard Oak	Quercus shumardii	15	2 1/2" cal, 12'-14' ht.	40' ht. x 35' spd.	30" box
MA	Modesto Ash	Fraxinus velutina 'Modesto'	15	2 1/2" cal, 12'-14' ht.	40' ht. x 25' spd.	30" box
MC	Mountain Cottonwood	Populus fremontii	13	2 1/2" cal, 12'-14' ht.	50' ht. x 40' spd.	30" box
WC	Western Catalpa	Catalpa speciosa	13	2 1/2" cal, 12'-14' ht.	40' ht. x 30' spd.	30" box
ACCENT TREES						
CP	Aristocrat Pear	Pyrus calleryana 'Aristocrat'	9	2" cal, 12'-14' ht.	25' ht. x 20' spd.	30" box
GR	Goldenrain Tree	Koeleruteria paniculata	12	2" cal, 12'-14' ht.	25' ht. x 20' spd.	30" box
OR	Oklahoma Redbud	Cercis canadensis 'Oklahoma'	13	2" cal, 12'-14' ht.	25' ht. x 20' spd.	30" box
SMALL DECIDUOUS TREES						
CM	Crape Myrtle	Lagerstroemia indica	17	5'-1' ht.	10' ht. x 4' spd.	15-gal. multi-trunk
NMO	New Mexico Olive	Forestiera neomexicana	13	5'-1' ht.	15' ht. x 10' spd.	15-gal.
VI	Vitex	Vitex agnus-castus	9	5'-1' ht.	15' ht. x 4' spd.	15 gal.
SHRUBS						
BG	Beargrass	Nolina texana	41	Min. 18" ht.	3' ht. x 4' spd.	5-gal.
CS	Cherry Sage	Salvia greggii	39	Min. 12" spd.	3' ht. x 4' spd.	5-gal.
DFG	Dwarf Fountain Grass	Femisetum alopeuroides 'Hameln'	20	Min. 12" ht.	2' ht. x 4' spd.	5-gal.
DRS	Dwarf Russian Sage	Perovskia atriplicifolia 'Little Spire'	21	Min. 12" ht.	3' ht. x 4' spd.	5-gal.
GLS	Gro-Low Sumac	Rhus aromatica 'Gro-Low'	8	Min. 18" spd.	3' ht. x 8' spd.	5-gal.
HL	Hidcote Lavender	Lavandula angustifolia 'Hidcote'	44	Min. 6" ht.	2' ht. x 4' spd.	5-gal.
HSG	'Heavy Metal' Switch Grass	Panicum virgatum 'Heavy Metal'	88	Min. 18" ht.	4' ht. x 2' spd.	5-gal.
KFG	Karl Foerster's Grass	Calamagrostis acutiflora 'Karl Foerster'	80	Min. 8" spd.	3' ht. x 4' spd.	5-gal.
MG	Maiden Hair Grass	Miscanthus sinensis 'Gracillimus'	107	Min. 18" ht.	6' ht. x 4' spd.	5-gal.
PFG	'Prairie Fire' Switch Grass	Panicum virgatum 'Prairie Fire'	63	Min. 12" ht.	4' ht. x 2' spd.	5-gal.
RM	Regal Mist Muhly Grass	Muhlenbergia capillaris 'Regal Mist'	56	Min. 10" spd.	3' ht. x 4' spd.	5-gal.
TURF						
	Park Blend	Poa pratensis Festuca ellator Lolium perenne	125,160 SF			Seed

PLANTING NOTES

- IN CASE OF DISCREPANCY IN PLANT QUANTITIES SHOWN ON THE PLANT LIST AND THOSE SHOWN ON THE PLANTING PLAN, THE QUANTITIES SHOWN ON THE PLAN SHALL GOVERN. CONTRACTOR SHALL VERIFY ALL QUANTITIES PRIOR TO BID AND INSTALLATION. NO ADDITIONAL PAYMENT WILL BE MADE FOR ANY DISCREPANCIES IN QUANTITIES BETWEEN THE PLANTING PLAN AND THE PLANT LIST.
- THE CONTRACTOR SHALL PRUNE LOWER BRANCHES OF DECIDUOUS TREES AS DIRECTED BY L.A. IN FIELD.
- IF THERE IS A DISCREPANCY IN THE FIELD OR NURSERY BETWEEN THE CONTAINER SIZE CALLED OUT UNDER "REMARKS" AND HEIGHT & SPREAD CALLED OUT UNDER "SIZE", THE SPECIFIED PLANT MUST MEET HEIGHT & SPREAD REQUIREMENTS SPECIFIED UNDER "SIZE", EVEN IF THE LARGER CONTAINER SIZE IS REQUIRED TO MEET THESE SPECIFICATIONS, AT NO ADDITIONAL COST TO THE OWNER.
- TREES AND SHRUBS IN PLANTERS SHALL BE INSTALLED PER COA STD. DUG 2710 & 2711. TREES IN TURF SHALL BE INSTALLED PER COA STD. DUG. 2713.
- ALL LANDSCAPE BEDS SHALL BE FINE GRADED TO PRODUCE A DEPRESSED CENTER WITH FINISH GRADE AT A MINIMUM OF 4" BELOW TOP OF ADJACENT PAVING.
- TREES IN TURF AREAS SHALL BE PLANTED A MINIMUM OF 12' AWAY FROM CONCRETE EDGER TO ALLOW FOR MOWER ACCESS.

MULCH HATCH LEGEND

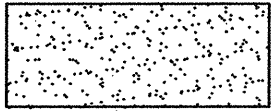
-  INSTALL A 4" DEPTH OF 'CANYON GOLD' CRUSHED GRAVEL MULCH IN PLANTING BED WITH FILTER FABRIC UNDER. FILTER FABRIC SHALL BE MIN. 4 OZ. WOVEN NEEDLE PUNCHED POLYPROPYLENE (DEWITT OR EQUIVALENT). OVERLAP ENDS 3", TURN DOWN EDGES 6".
-  INSTALL A 2"-4" DEPTH OF 'CANYON GOLD' CRUSHED GRAVEL MULCH IN PLANTING BED WITH FILTER FABRIC UNDER. FILTER FABRIC SHALL BE MIN. 4 OZ. WOVEN NEEDLE PUNCHED POLYPROPYLENE (DEWITT OR EQUIVALENT). OVERLAP ENDS 3", TURN DOWN EDGES 6".

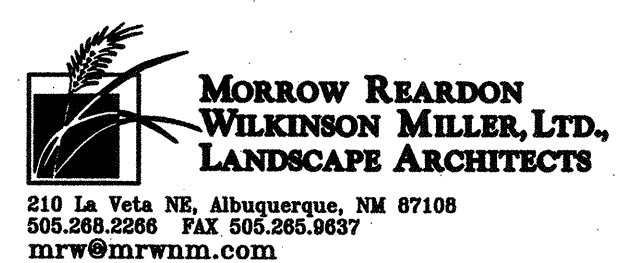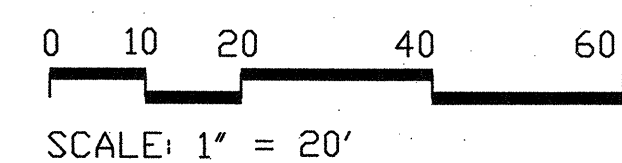

CITY OF ALBUQUERQUE
PARK DESIGN AND CONSTRUCTION DIVISION
DEPARTMENT OF MUNICIPAL DEVELOPMENT

BLACK ARROYO PARK IMPROVEMENTS PLANTING PLAN

Design Review Committee	City Engineer Approval	Mo./Day/Yr.	
Last Design Update		Mo./Day/Yr.	Mo./Day/Yr.
City Project No.	Zone Map No.	Sheet	
787491	A-12	14 OF 21	

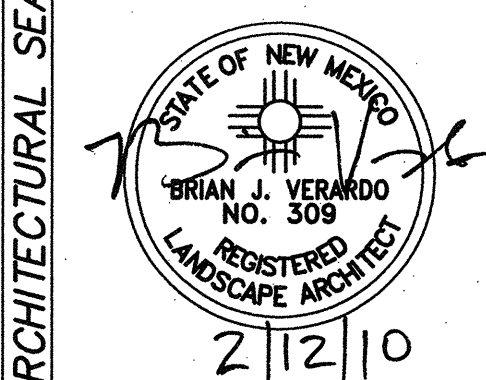

Black Arroyo Park Improvements

PROJECT# 787491


RECORD DRAWINGS
DATE:

FINAL FOR CONSTRUCTION
DATE: FEBRUARY 12, 2010


MATCHLINE (SEE SHEET 14)

MATCHLINE (SEE SHEET 14)

MATCHLINE (SEE SHEET 14)

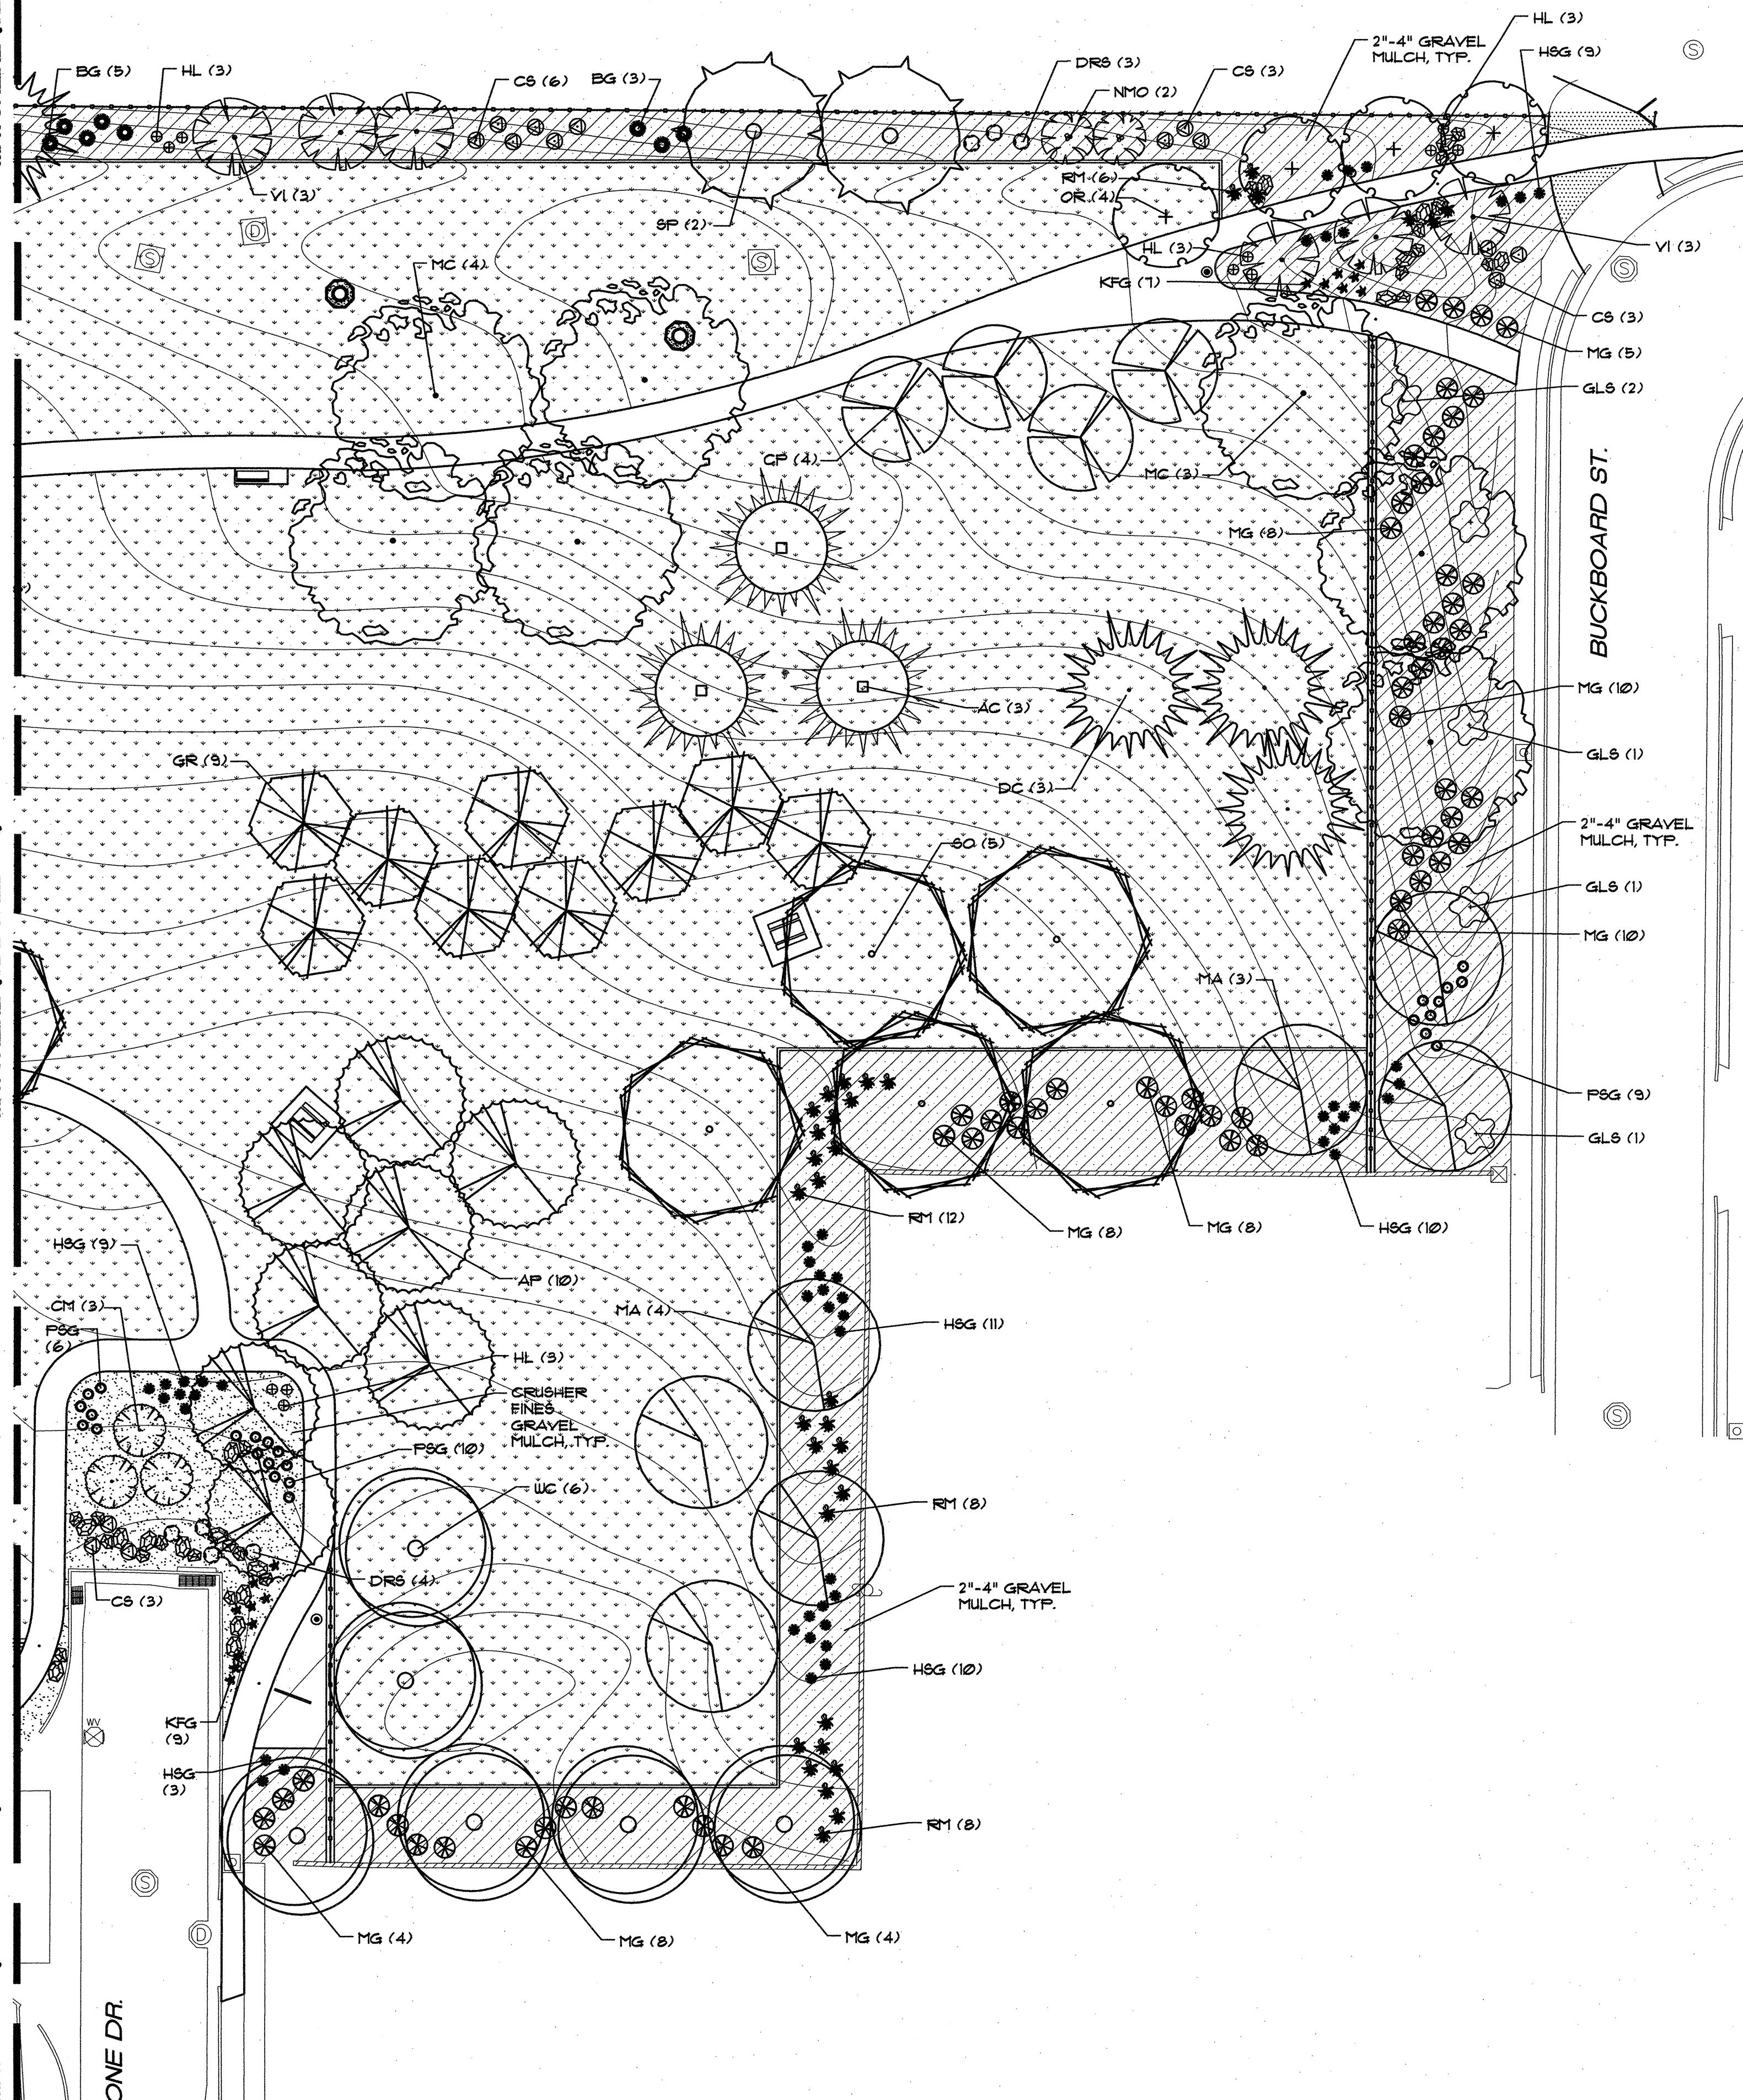

PLANT SCHEDULE

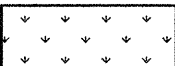KEY	COMMON NAME	BOTANICAL NAME	QUANTITY	INSTALLED	SIZE		REMARKS
						MATURE	
EVERGREEN TREES							
AC	Atlas Cedar	Cedrus atlantica	3	5'-7' ht.		40' ht. 4 30' epd.	30" box
DC	Deodar Cedar	Cedrus deodara	9	5'-7' ht.		50' ht. 4 30' epd.	30" box
SP	Scotch Pine	Pinus sylvestris 'Albyn'	5	5'-7' ht.		50' ht. 4 30' epd.	30" box
LARGE DECIDUOUS TREES							
AP	Autumn Purple Ash	Fraxinus americana 'Autumn Purple'	22	2 1/2" cal, 12'-14' ht.		40' ht. 4 25' epd.	30" box
COH	Common Hackberry	Celtis occidentalis	6	2 1/2" cal, 12'-14' ht.		30' ht. 4 epd.	30" box
SO	Shumard Oak	Quercus shumardii	15	2 1/2" cal, 12'-14' ht.		40' ht. 4 35' epd.	30" box
MA	Modesto Ash	Fraxinus velutina 'Modesto'	15	2 1/2" cal, 12'-14' ht.		40' ht. 4 25' epd.	30" box
MC	Mountain Cottonwood	Populus fremontii	13	2 1/2" cal, 12'-14' ht.		50' ht. 4 40' epd.	30" box
WC	Western Catalpa	Catalpa speciosa	13	2 1/2" cal, 12'-14' ht.		40' ht. 4 30' epd.	30" box
ACCENT TREES							
CP	Aristocrat Pear	Pyrus calleryana 'Aristocrat'	9	2" cal, 12'-14' ht.		25' ht. 4 20' epd.	30" box
GR	Goldenrain Tree	Koeleruteria paniculata	12	2" cal, 12'-14' ht.		25' ht. 4 20' epd.	30" box
OR	Oklahoma Redbud	Cercis canadensis 'Oklahoma'	13	2" cal, 12'-14' ht.		25' ht. 4 20' epd.	30" box
SMALL DECIDUOUS TREES							
CM	Crepe Myrtle	Lagerstroemia indica	17	5'-7' ht.		10' ht. 4 epd.	15-gal. multi-trunk
NMO	New Mexico Olive	Forestiera neomexicana	13	5'-7' ht.		15' ht. 4 10' epd.	15-gal.
VI	Vitex	Vitex agnus-castus	9	5'-7' ht.		15' ht. 4 epd.	15 gal.
SHRUBS							
BG	Beargrass	Nolina texana	41	Min. 18" ht.		3' ht. 4 4' epd.	5-gal.
CS	Cherry Sage	Salvia greggii	39	Min. 12" epd.		3' ht. 4 epd.	5-gal.
DRG	Dwarf Fountain Grass	Pennisetum alopecuroides 'Hameln'	20	Min. 12" ht.		2' ht. 4 epd.	5-gal.
DRS	Dwarf Russian Sage	Perovskia atriplicifolia 'Little Spire'	27	Min. 12" ht.		3' ht. 4 epd.	5-gal.
GLS	Gro-Low Sumac	Rhus aromatica 'Gro-Low'	8	Min. 18" epd.		3' ht. 4 8' epd.	5-gal.
HL	Hidcote Lavender	Lavandula angustifolia 'Hidcote'	44	Min. 6" ht.		2' ht. 4 epd.	5-gal.
HSG	'Heavy Metal' Switch Grass	Panicum virgatum 'Heavy Metal'	88	Min. 18" ht.		4' ht. 4 2' epd.	5-gal.
KFG	Karl Foerster's Grass	Calamagrostis acutiflora 'Karl Foerster'	80	Min. 8" epd.		3' ht. 4 epd.	5-gal.
MG	Maiden Hair Grass	Miscanthus sinensis 'Gracillimus'	107	Min. 18" ht.		6' ht. 4 4' epd.	5-gal.
PFG	'Prairie Fire' Switch Grass	Panicum virgatum 'Prairie Fire'	63	Min. 12" ht.		4' ht. 4 2' epd.	5-gal.
RM	Regal Mist Muhly Grass	Muhlenbergia capillaris 'Regal Mist'	56	Min. 10" epd.		3' ht. 4 epd.	5-gal.
TURF							
			Park Blend		Poa pratensis Festuca eliator Lolium perenne		Seed
				125,760 SF			


PLANTING NOTES

- IN CASE OF DISCREPANCY IN PLANT QUANTITIES SHOWN ON THE PLANT LIST AND THOSE SHOWN ON THE PLANTING PLAN, THE QUANTITIES SHOWN ON THE PLAN SHALL GOVERN. CONTRACTOR SHALL VERIFY ALL QUANTITIES PRIOR TO BID AND INSTALLATION. NO ADDITIONAL PAYMENT WILL BE MADE FOR ANY DISCREPANCIES IN QUANTITIES BETWEEN THE PLANTING PLAN AND THE PLANT LIST.
- THE CONTRACTOR SHALL PRUNE LOWER BRANCHES OF DECIDUOUS TREES AS DIRECTED BY L.A. IN FIELD.
- IF THERE IS A DISCREPANCY IN THE FIELD OR NURSERY BETWEEN THE CONTAINER SIZE CALLED OUT UNDER "REMARKS" AND HEIGHT & SPREAD CALLED OUT UNDER "SIZE", THE SPECIFIED PLANT MUST MEET HEIGHT & SPREAD REQUIREMENTS SPECIFIED UNDER "SIZE", EVEN IF THE LARGER CONTAINER SIZE IS REQUIRED TO MEET THESE SPECIFICATIONS, AT NO ADDITIONAL COST TO THE OWNER.
- TREES AND SHRUBS IN PLANTERS SHALL BE INSTALLED PER COA STD. DWG. 2110 & 2111. TREES IN TURF SHALL BE INSTALLED PER COA STD. DWG. 2113.
- ALL LANDSCAPE BEDS SHALL BE FINE GRADED TO PRODUCE A DEEPRESSED CENTER WITH FINISH GRADE AT A MINIMUM OF 4" BELOW TOP OF ADJACENT PAVING.
- TREES IN TURF AREAS SHALL BE PLANTED A MINIMUM OF 12' AWAY FROM CONCRETE EDGER TO ALLOW FOR MOWER ACCESS.

MULCH HATCH LEGEND

	INSTALL A 4" DEPTH OF 'CANYON GOLD' CRUSHER FINES, OR PRIOR APPROVED EQUAL, CRUSHED GRAVEL MULCH IN PLANTING BED WITH FILTER FABRIC UNDER. FILTER FABRIC SHALL BE MIN. 4 OZ. WOVEN NEEDLE PUNCHED POLYPROPYLENE (DEWITT OR EQUIVALENT). OVERLAP ENDS 3", TURN DOWN EDGES 6".
	INSTALL A 4" DEPTH OF 2-4" 'CANYON GOLD' OR PRIOR APPROVED EQUAL, CRUSHED GRAVEL MULCH IN PLANTING BED WITH FILTER FABRIC UNDER. FILTER FABRIC SHALL BE MIN. 4 OZ. WOVEN NEEDLE PUNCHED POLYPROPYLENE (DEWITT OR EQUIVALENT). OVERLAP ENDS 3", TURN DOWN EDGES 6".

0 10 20 40 60
SCALE: 1" = 20'

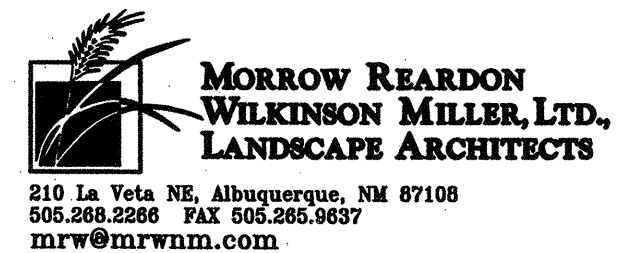

CITY OF ALBUQUERQUE
PARK DESIGN AND CONSTRUCTION DIVISION
DEPARTMENT OF MUNICIPAL DEVELOPMENT

BLACK ARROYO PARK IMPROVEMENTS PLANTING PLAN


Design Review Committee	City Engineer Approval	Mo./Day/Yr.	
Last Design Update		Mo./Day/Yr.	
City Project No.	787491	Zone Map No.	A-12
Sheet	15 OF 21		

PROJECT# 787491

RECORD DRAWINGS
DATE:


Black Arroyo Park Improvements

FINAL FOR CONSTRUCTION
DATE: FEBRUARY 12, 2010

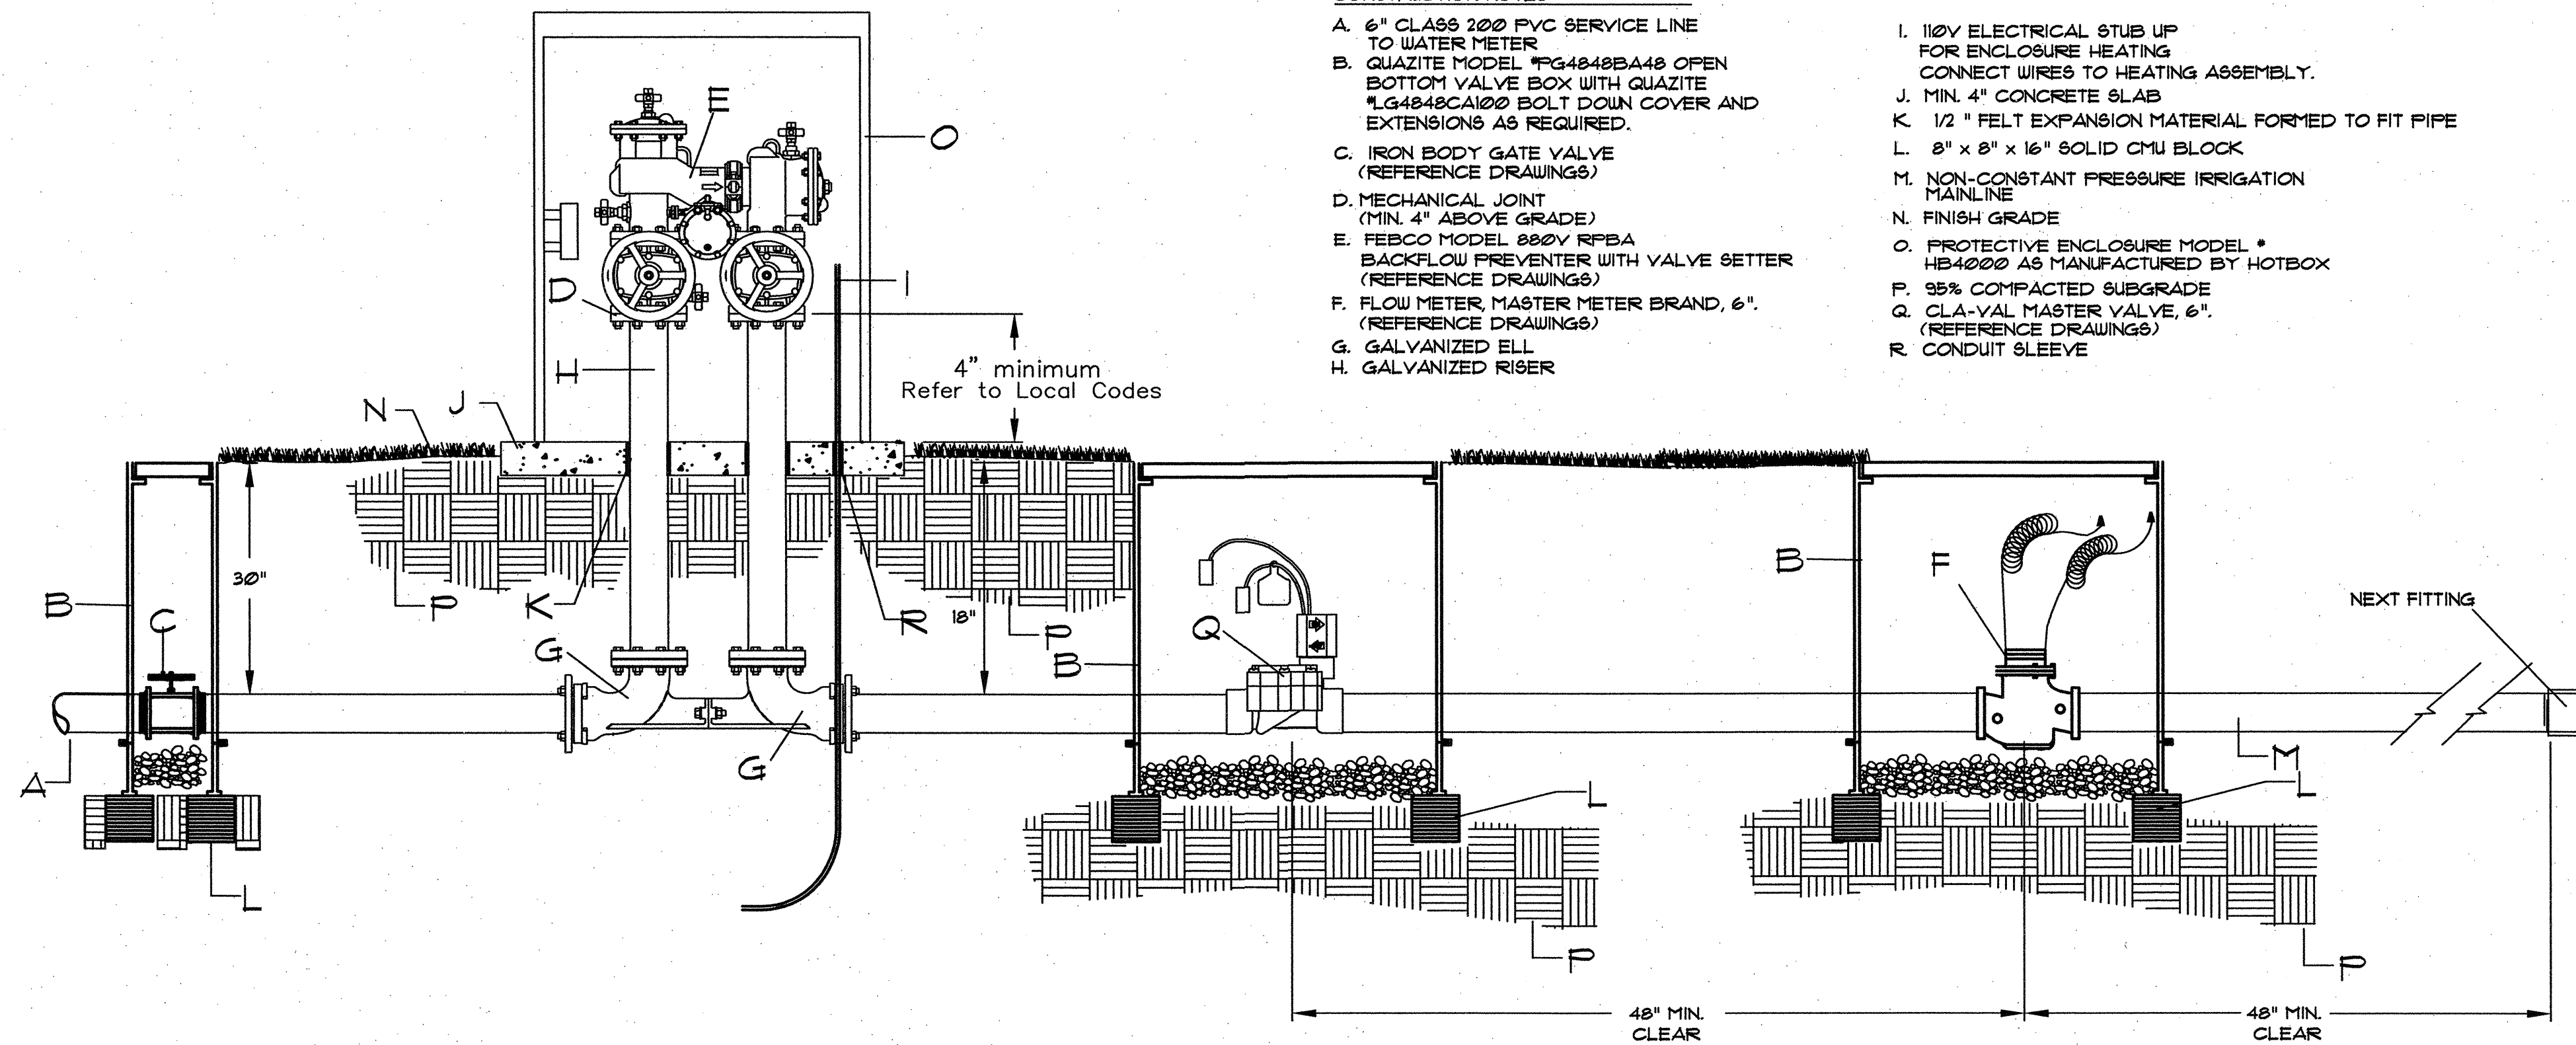

CONSTRUCTION NOTES



- 6" CLASS 200 PVC SERVICE LINE TO WATER METER
- QUAZITE MODEL #FG4848BA48 OPEN BOTTOM VALVE BOX WITH QUAZITE #L4848CA1000 BOLT DOWN COVER AND EXTENSIONS AS REQUIRED.
- IRON BODY GATE VALVE (REFERENCE DRAWINGS)
- MECHANICAL JOINT (MIN. 4" ABOVE GRADE)
- FEBCO MODEL 882V RPBA BACKFLOW PREVENTER WITH VALVE SETTER (REFERENCE DRAWINGS)
- FLOW METER MASTER METER BRAND, 6" (REFERENCE DRAWINGS)
- GALVANIZED ELL
- GALVANIZED RISER
- 110V ELECTRICAL STUB UP FOR ENCLOSURE HEATING. CONNECT WIRES TO HEATING ASSEMBLY.
- MIN. 4" CONCRETE SLAB
- 1/2" FELT EXPANSION MATERIAL FORMED TO FIT PIPE
- 8" x 8" x 16" SOLID CMU BLOCK
- NON-CONSTANT PRESSURE IRRIGATION MAINLINE
- FINISH GRADE
- PROTECTIVE ENCLOSURE MODEL #HB4000 AS MANUFACTURED BY HOTBOX
- 95% COMPACTED SUBGRADE
- CLA-VAL MASTER VALVE, 6" (REFERENCE DRAWINGS)
- CONDUIT SLEEVE

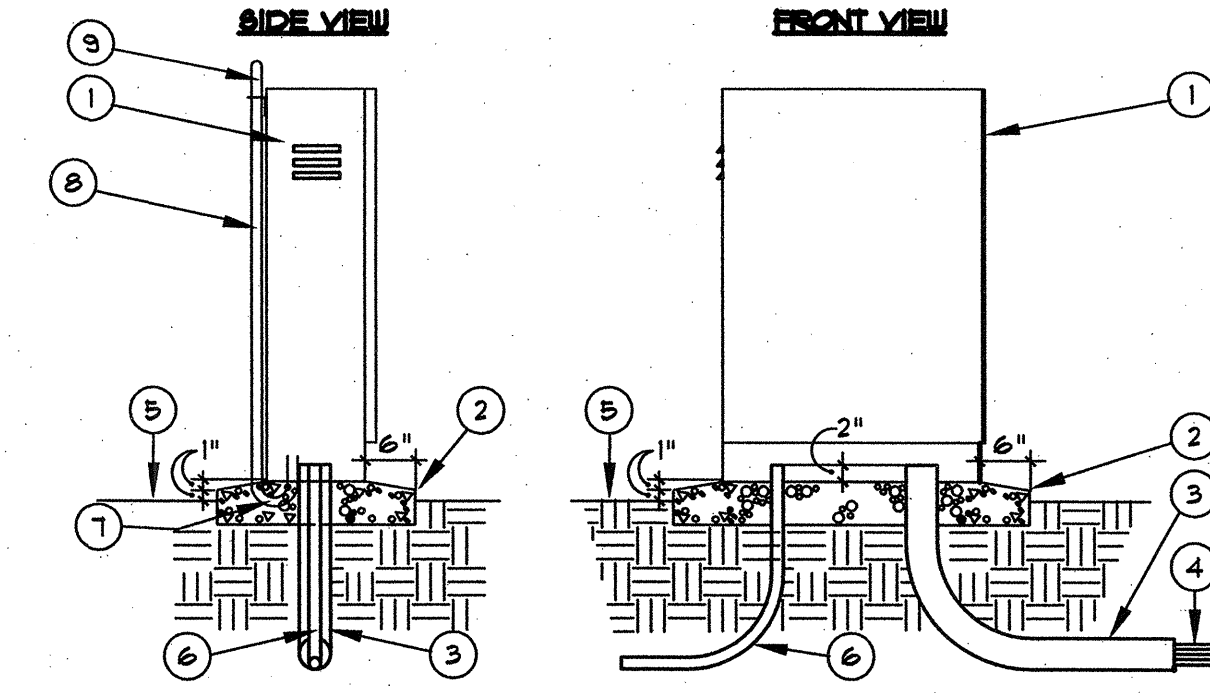

- IRRIGATION CONTROLLER, SEE IRRIGATION LEGEND. INSTALL TO MANUFACTURER'S STANDARDS
- 3000 PSI CONCRETE BASE. 8" MINIMUM THICKNESS. ALL EDGES SHALL BE TOOLED WITH 1/2" RADIUS
- 4" RIGID PVC LONG SWEEP ELL. EXTEND 12" BEYOND ADJACENT WALKS
- 24-VOLT WIRES FROM CONTROLLER TO AUTOMATIC VALVES. SEE SPECIFICATIONS
- FINISH GRADE.
- 120-VOLT SERVICE IN CONDUIT, PER N.E.C.
- 1" GALVANIZED SWEEP 90° ELBOW AND FITTINGS
- 1" GALVANIZED CONDUIT
- ANTENNA

A
16 MASTER METER WITH RPBA
MCD-2101-B 8/02

B
16 IRRIGATION CONTROLLER
MCD-0165 N.T.S.

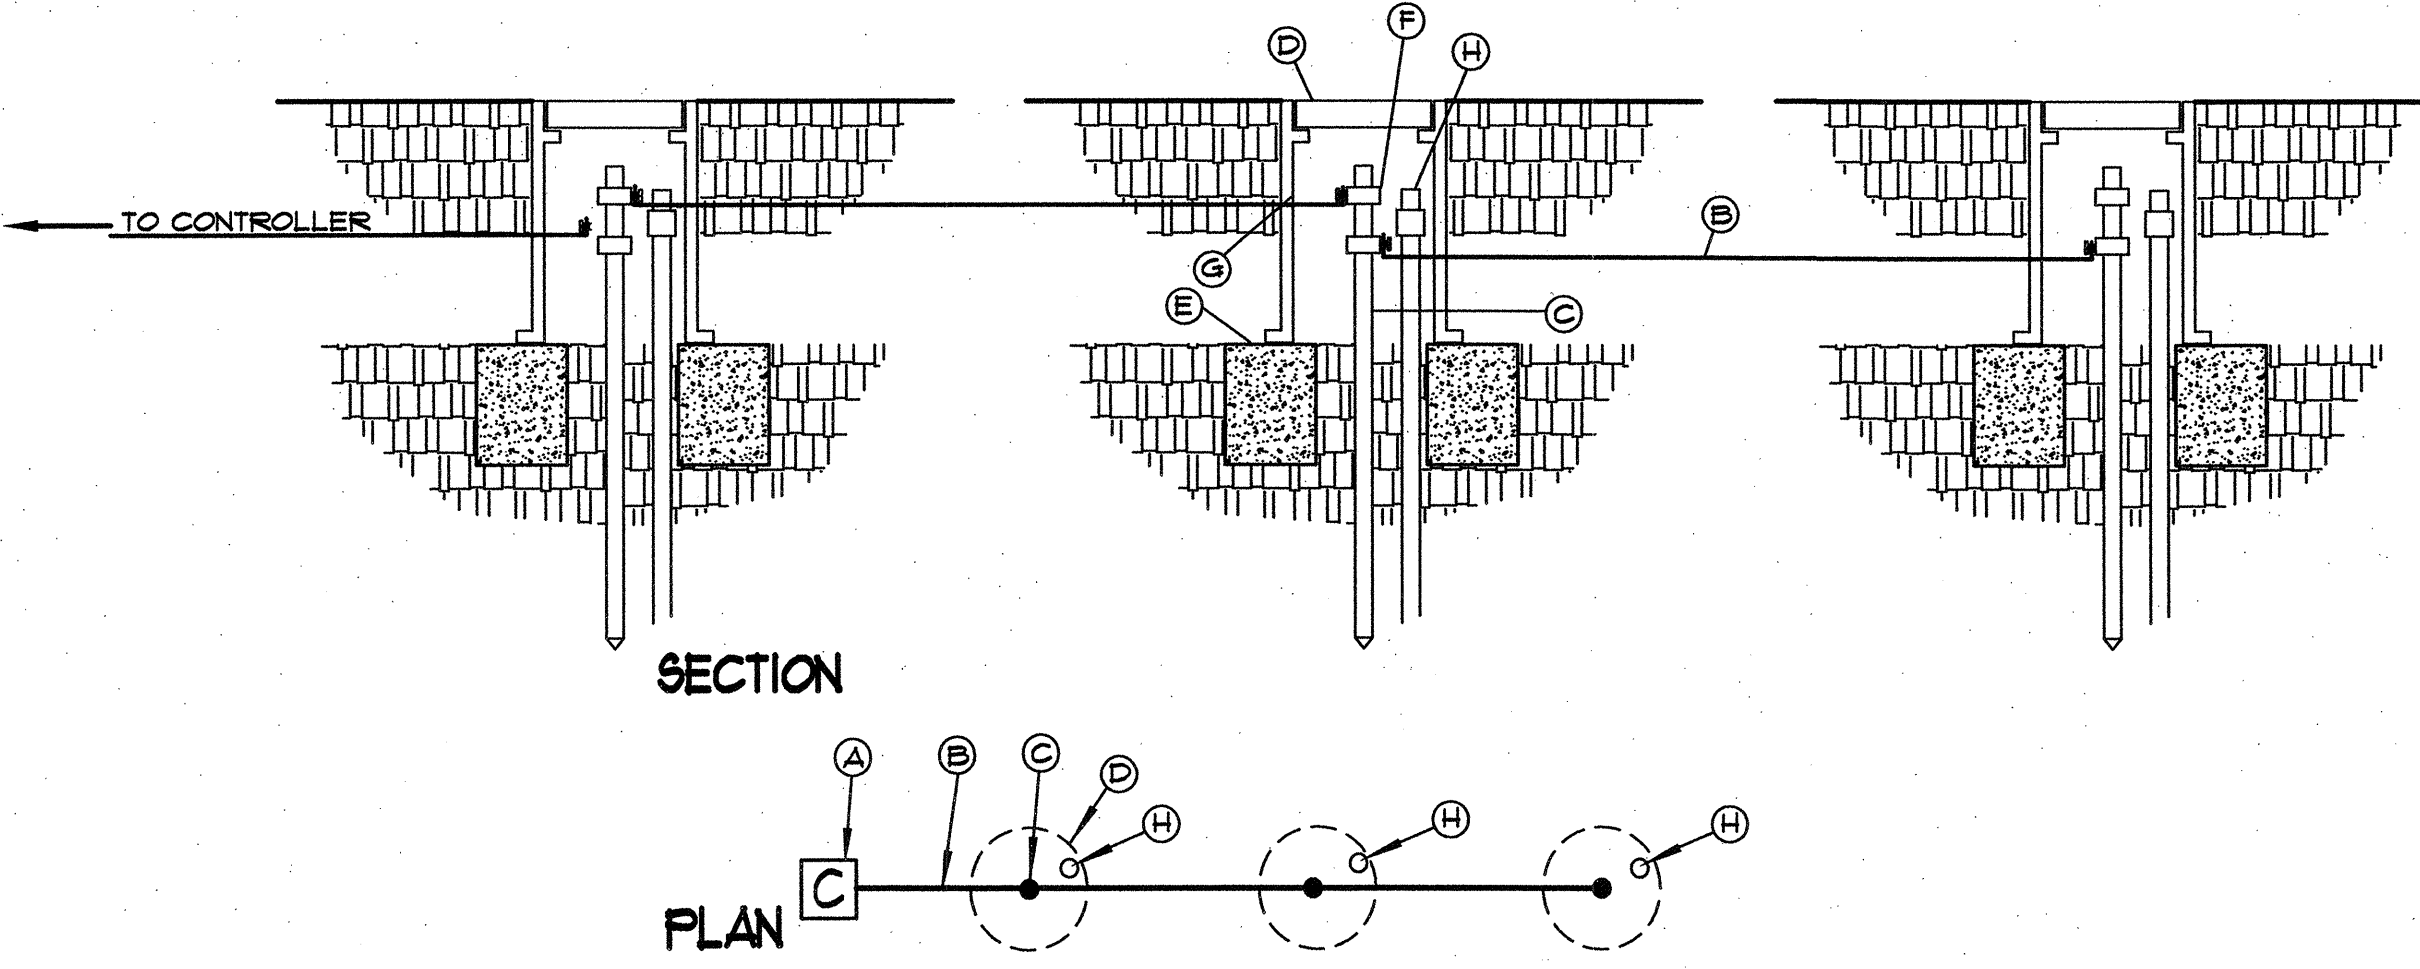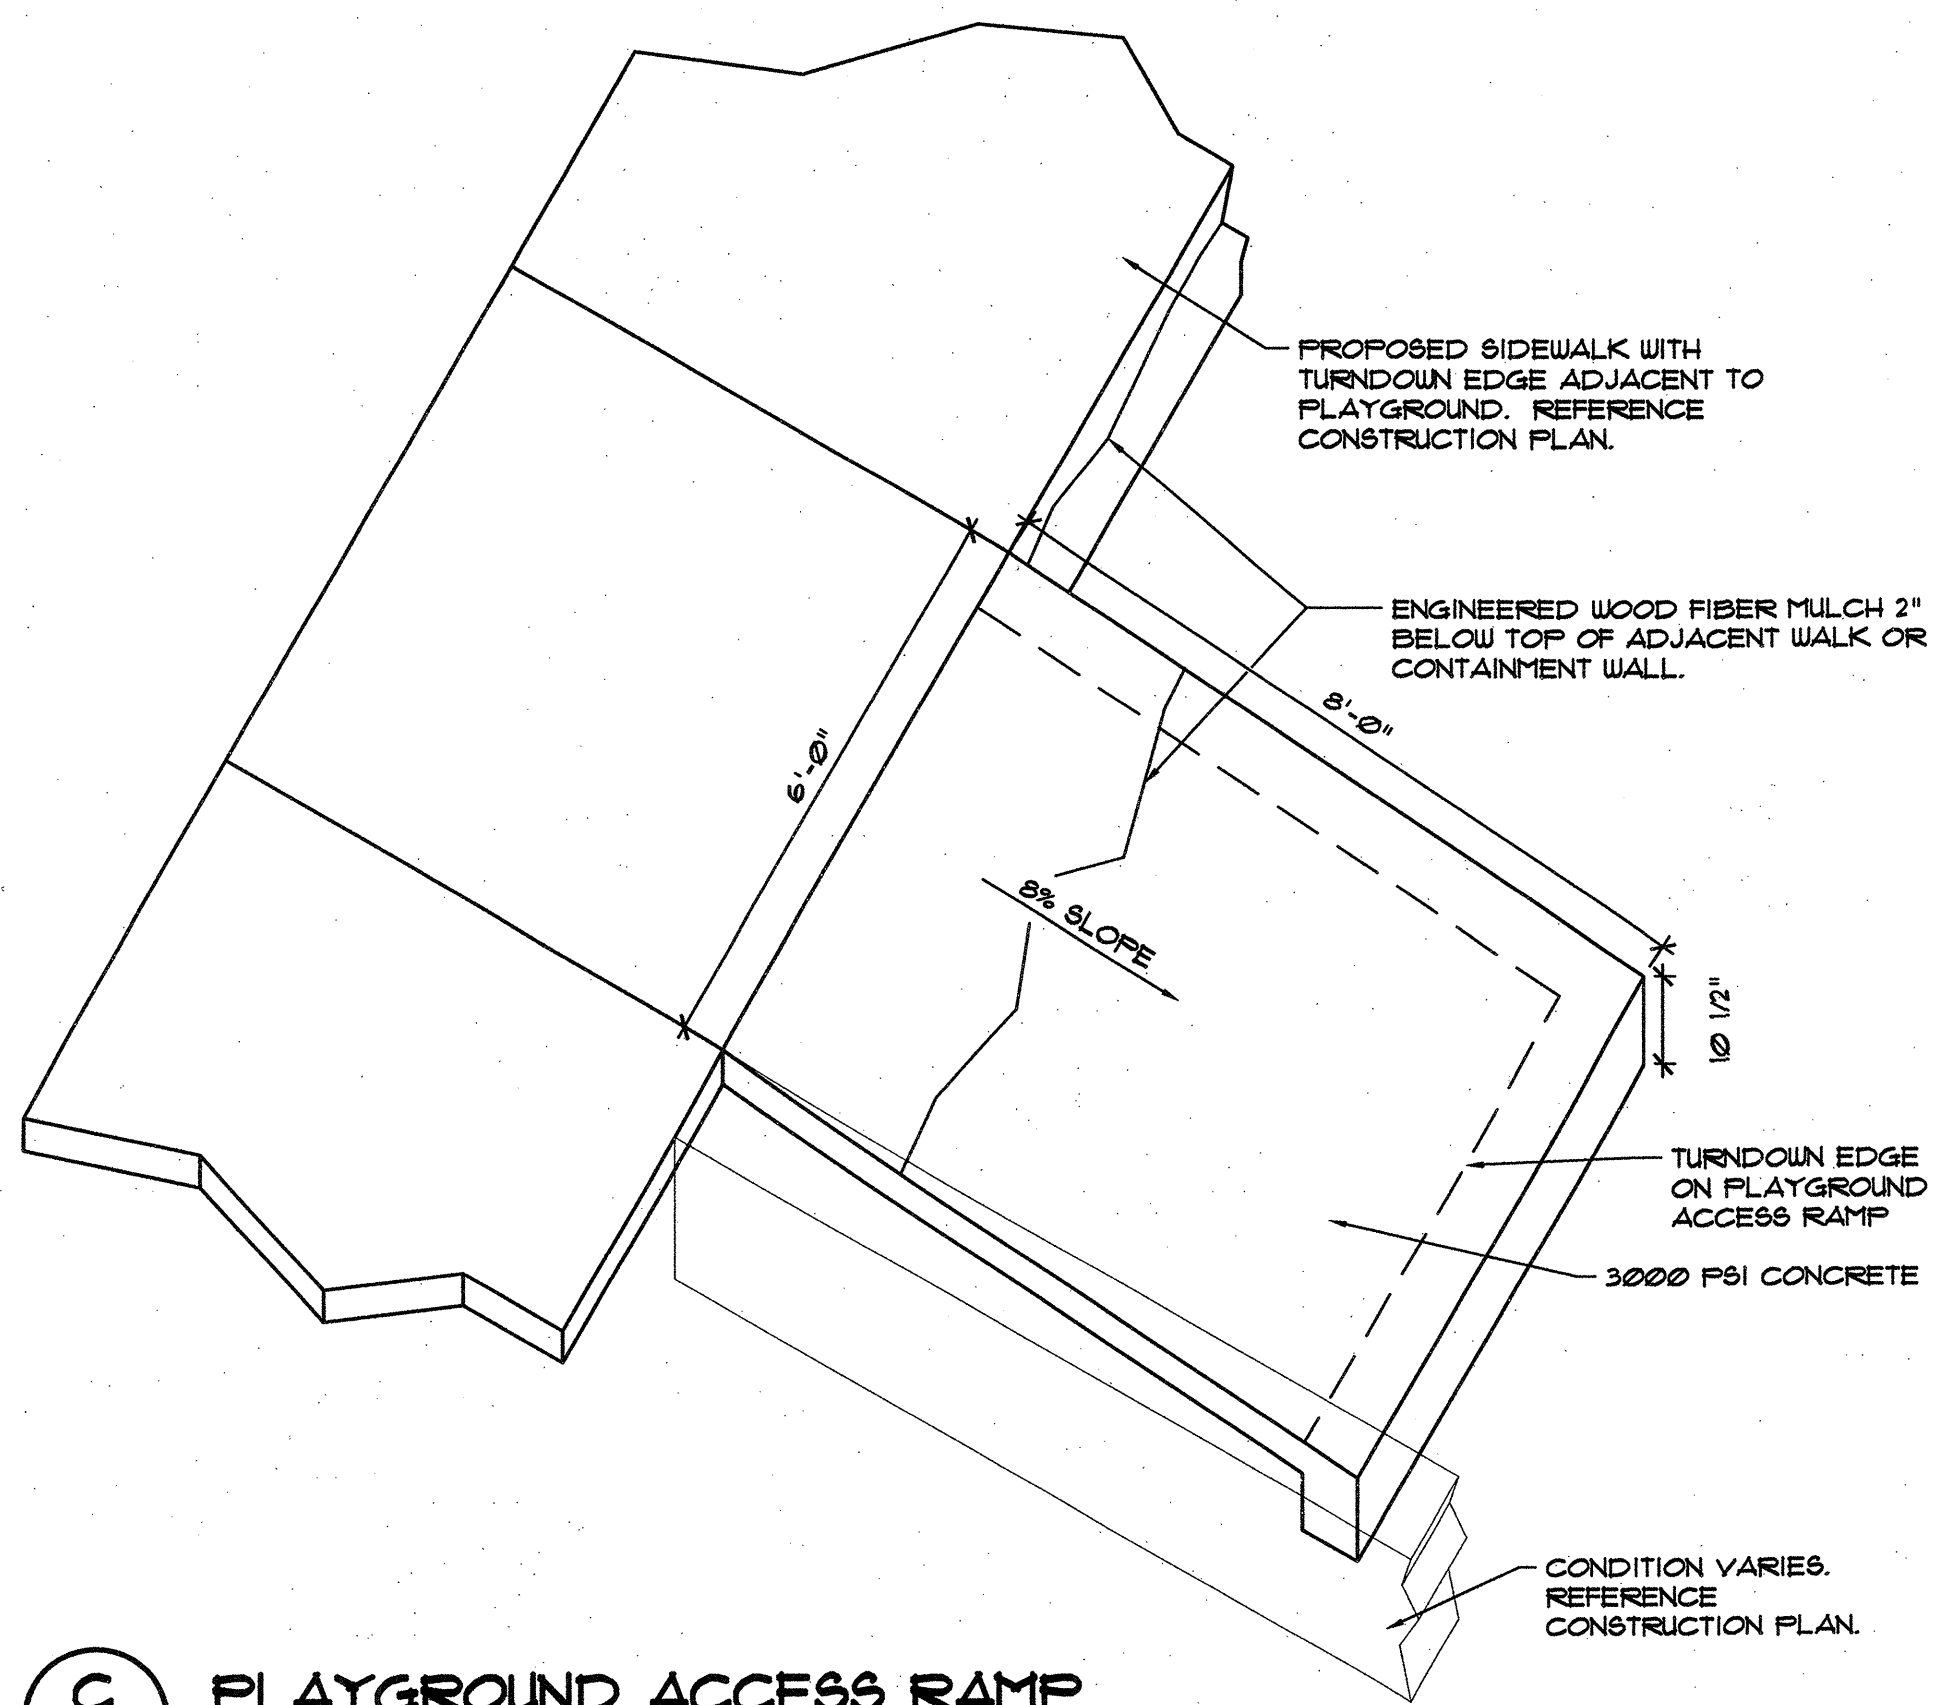


KEY (TYPICAL)

- IRRIGATION CONTROLLER, SEE IRRIGATION LEGEND.
- 1/2" AWG WIRE FROM IRRIGATION CONTROLLER TO GROUND ROD CLAMP. WIRE SHALL BE INSTALLED STRAIGHT AND TAUT.
- 8' LENGTH GROUND ROD, PLACE A MINIMUM OF 16' FROM ONE ANOTHER W/ ONE ROD A MIN. 12' FROM CONTROLLER. (OPTION: REPLACE GROUNDING RODS W/ 1 EA. 1/8" X 12" X 18" COPPER, BURIED 12" DEPTH. SOLDER 1/8" BARE COPPER WIRE TO PLATE).
- APPLIED ENGINEERING PRODUCTS 910L 10" ROUND VALVE BOX AND COVER
- 8"x8"x16" SOLID CMU BLOCK TWO PER VALVE BOX
- GROUND ROD CLAMP
- DRILL A SMALL OPENING IN VALVE BOX TO MAINTAIN WIRE TAUTNESS.
- CONTRACTOR SHALL INSTALL ONE BUBBLER WITHIN VALVE BOX AT EACH GROUND ROD. SEE IRRIGATION PLAN.

D
16 CONTROLLER GROUNDING DETAIL
N.T.S.


C
16 PLAYGROUND ACCESS RAMP
1/2" = 1'

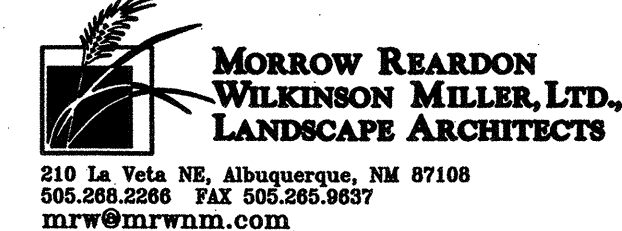

CITY OF ALBUQUERQUE
PARK DESIGN AND CONSTRUCTION DIVISION
DEPARTMENT OF MUNICIPAL DEVELOPMENT

BLACK ARROYO PARK IMPROVEMENTS DETAILS SHEET

Design Review Committee	City Engineer Approval	Last Design Update	Mo./Day/Yr.	Mo./Day/Yr.
City Project No.	Zone Map No.	Sheet		
787491	A-12	16 OF 21		


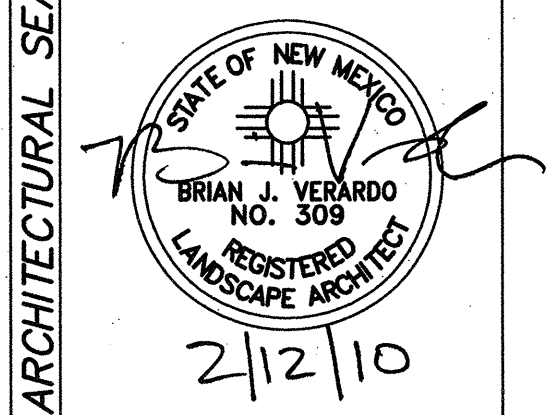


FINAL FOR CONSTRUCTION
DATE: FEBRUARY 12, 2010

Black Arroyo Park Improvements

PROJECT# 787491


RECORD DRAWINGS
DATE:

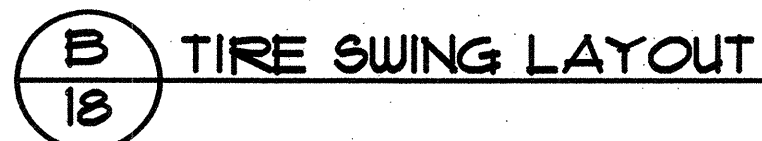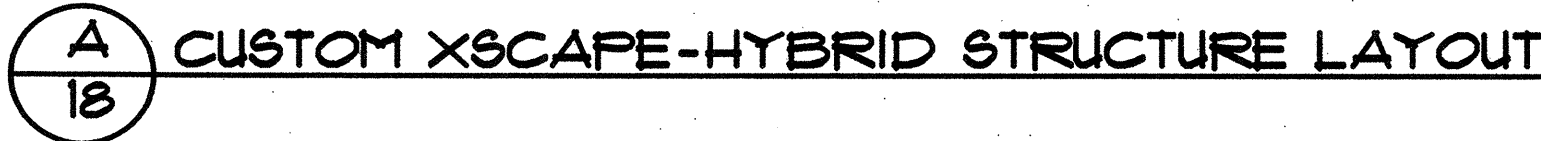

NOTE: PLAY STRUCTURE COLOR PALETTE SHALL BE "FOREST"



1. THE CONTRACTOR SHALL FURNISH ALL LABOR, MATERIAL, EQUIPMENT NECESSARY TO INSTALL AND CONSTRUCT ALL PLAY EQUIPMENT AND SITE FURNISHINGS AS SPECIFIED AND DESCRIBED ON THIS PLAN.
2. THE GROUND SPACE AND USE ZONE (UZ) FOR EACH PIECE OF PLAY EQUIPMENT ARE SHOWN ON THE PLAN. THE GROUND SPACE IS THE ACTUAL SPACE THAT THE EQUIPMENT OCCUPIES. THE USE ZONE IS THE REQUIRED OBSTACLE FREE SURFACE AROUND THE EQUIPMENT. THE USE ZONE FOR STATIONARY PLAT EQUIPMENT SHALL EXTEND NO LESS THAN 6' FROM ALL SIDES OF THE PLAY STRUCTURE. IN INSTANCES WHERE THE USE ZONE EXTENDS BEYOND 6' FROM A SPECIFIC SIDE OF A STRUCTURE, THE REQUIRED LENGTH OF EXTENSION IS SHOWN ON THE PLAN.
3. THE USE ZONES FOR ANY TWO ADJACENT PLAY STRUCTURES SHALL NOT OVERLAP.
4. PRIOR TO FINAL ACCEPTANCE BY THE OWNER, THE CONTRACTOR SHALL PROVIDE AN "AS-BUILT" DRAWING WHICH DOCUMENTS THAT EACH PIECE OF PLAY EQUIPMENT IS CONSTRUCTED WITH THE REQUIRED USE ZONE AND THAT NO USE ZONES OVERLAP.
5. PRIOR TO FINAL ACCEPTANCE BY THE OWNER THE CONTRACTOR MUST PROVIDE WRITTEN AUTHORIZATION THAT THE CONSTRUCTION AND INSTALLATION OF EACH PIECE OF PLAY EQUIPMENT HAS BEEN INSPECTED BY A REPRESENTATIVE OF THE EQUIPMENT MANUFACTURER, AND THAT THE CONSTRUCTION AND INSTALLATION OF EACH PIECE OF EQUIPMENT FULLY COMPLIES WITH THE ASTM F-1487-98 AND THE U.S. CONSUMER PRODUCT SAFETY COMMISSION HANDBOOK FOR PUBLIC PLAYGROUND SAFETY.

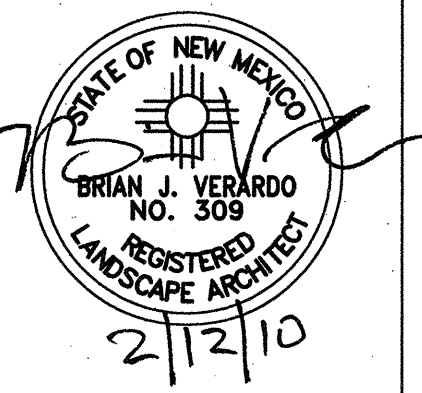

Design Review Committee		City Engineer Approval		Last Design Update	Mo./Day/Yr.	Mo./Day/Yr.
City Project No.		Zone Map No.		Sheet		
787491		A-12		18 OF 21		

RECORD DRAWINGS
DATE:

CONNECT 18" RCP SD TO EXST 8" MANHOLE:
RIM ELEV=5189.44
INV NE=79.34±
INV SW=82.99±
INV SE=83.0
HGL=83.1


109 LF EXST 60" RCP
SD @ 3.95%
Q100=172.5 CFS
S=1.25%
Q100=9.1 CFS
V100=6.6 FPS
TP SAS=80.7
BTM SD=83.3

1-18" NYLOPLAST DRAIN BASIN WITH
18" INLET & OUTLET @ 150° ANGLE
1-18" CONCRETE ADAPTER NW
SOLID GRATE AND CONCRETE COLLAR
SEE DETAIL THIS SHEET
RIM=89.2
INV W=83.25
INV E=83.35

1-30" NYLOPLAST INLINE DRAIN WITH 18"
OUTLET,
DOMED GRATE AND CONCRETE COLLAR
SEE DETAIL THIS SHEET
RIM=87.0
INV W=84.0
HGL=85.8


65 LF 18"
ADS N-12WT
SD @ S=1.0%
Q100=9.1 CFS
V100=5.2 CFS

20 LF 18"
RCP SD @
S=1.25%
Q100=9.1 CFS
V100=6.6 FPS

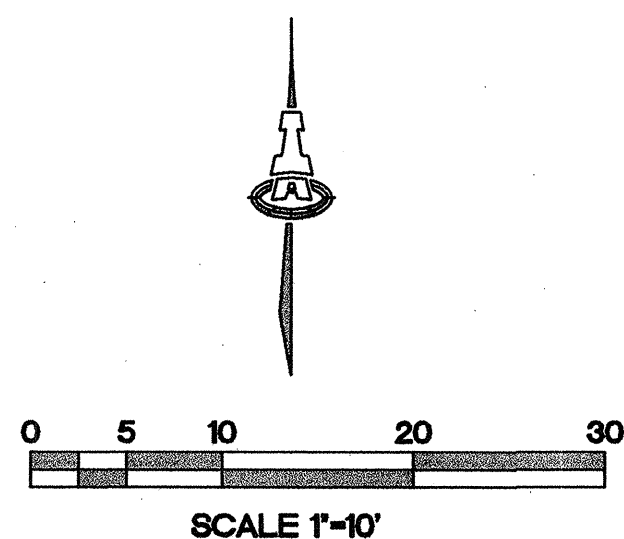



NOTES

- CONTRACTOR SHALL FURNISH ALL STORM DRAIN PRODUCTS.
- INSTALL ALL ADS N-12WT (WATERTIGHT) PIPE, FITTINGS, INLINE DRAIN DRAIN BASIN, AND GRATES PER MANUFACTURER'S REQUIREMENTS. ALL GRATES SHALL HAVE LOCKING OPTION.
- INSTALL ALL NEW STORM DRAIN LINES AT RIM AND INVERT ELEVATIONS SHOWN.

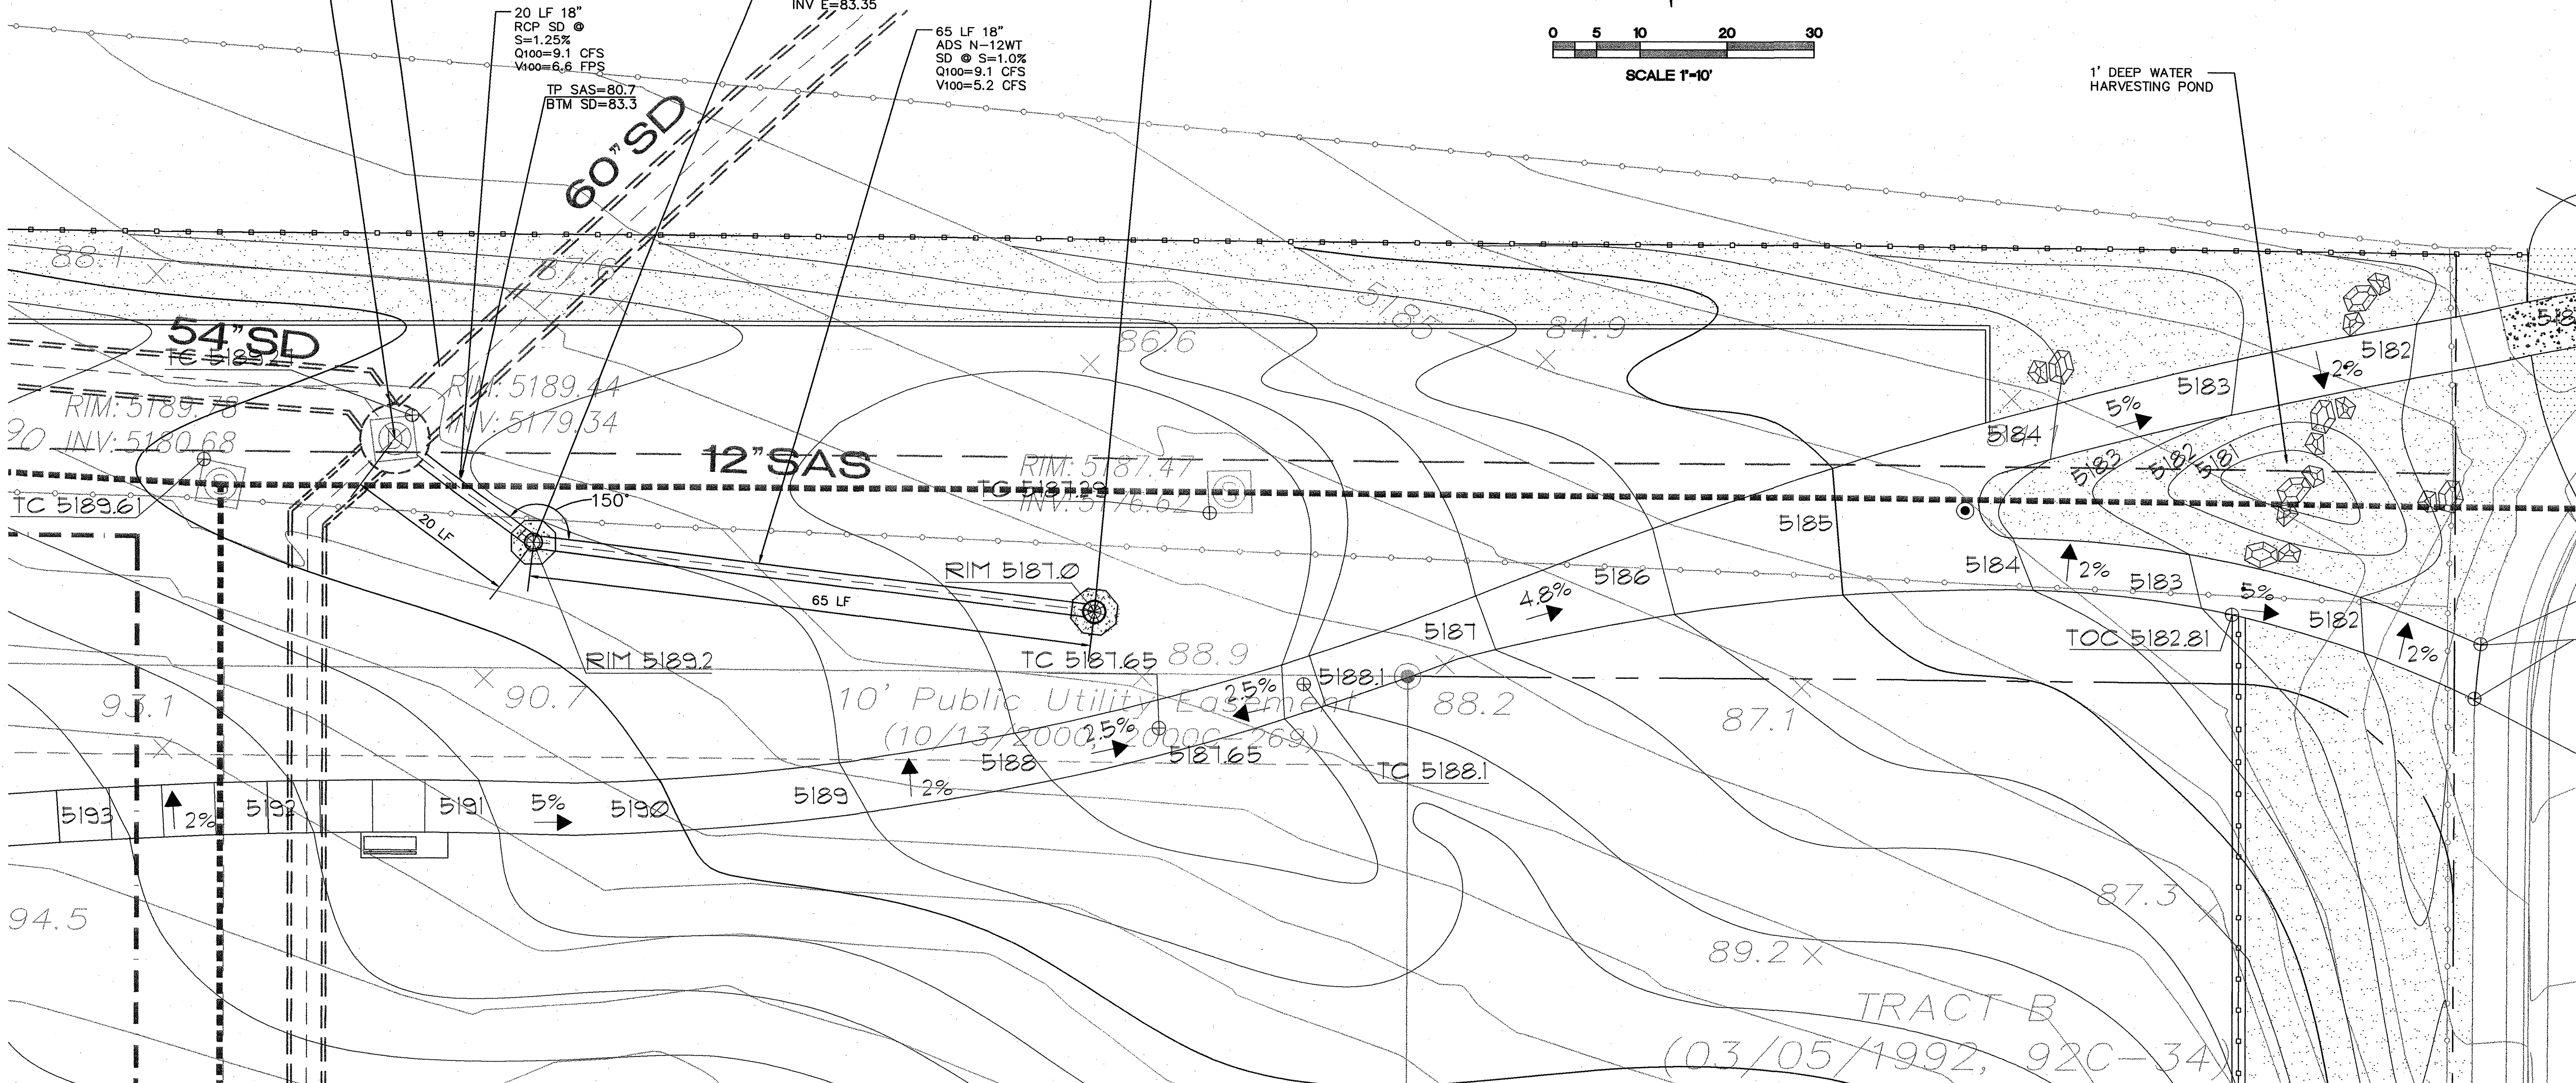

INLINE DRAIN


NTS

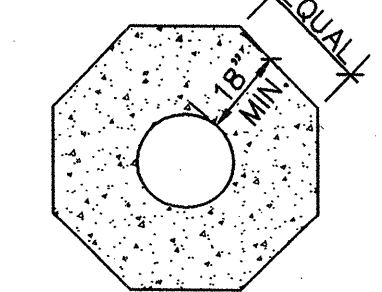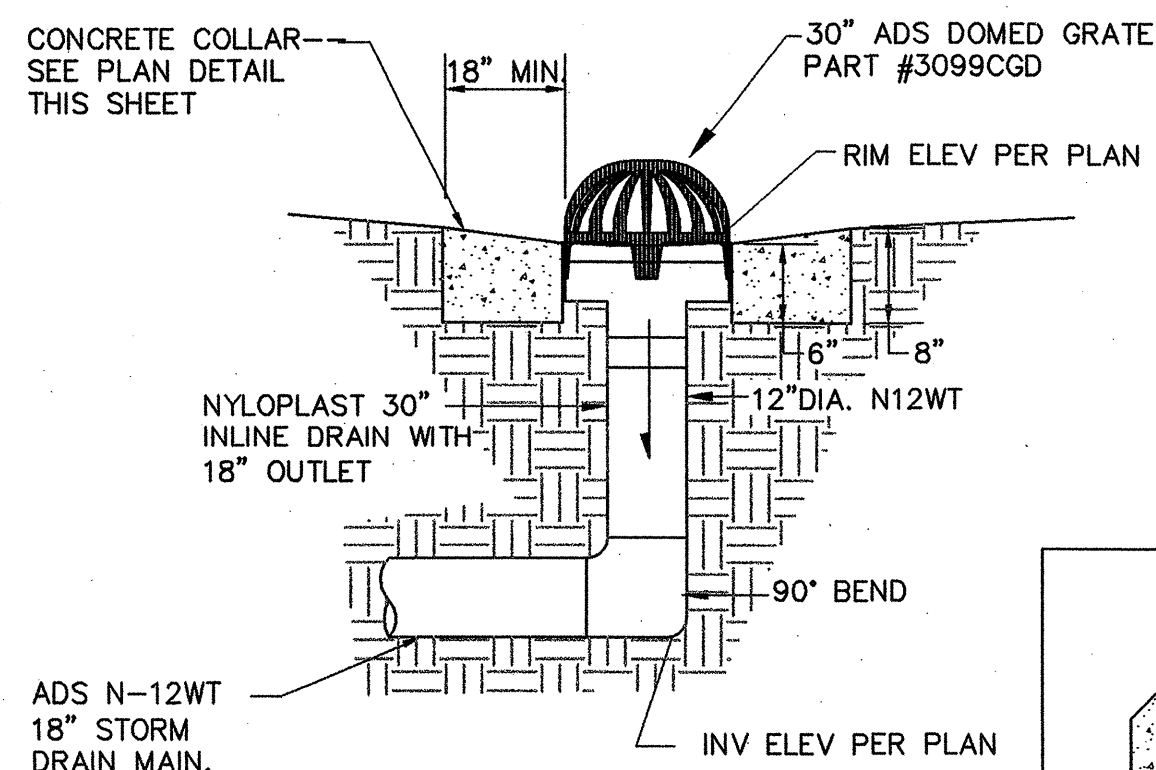

CONCRETE COLLAR PLAN
NTS

DRAIN BASIN

NTS

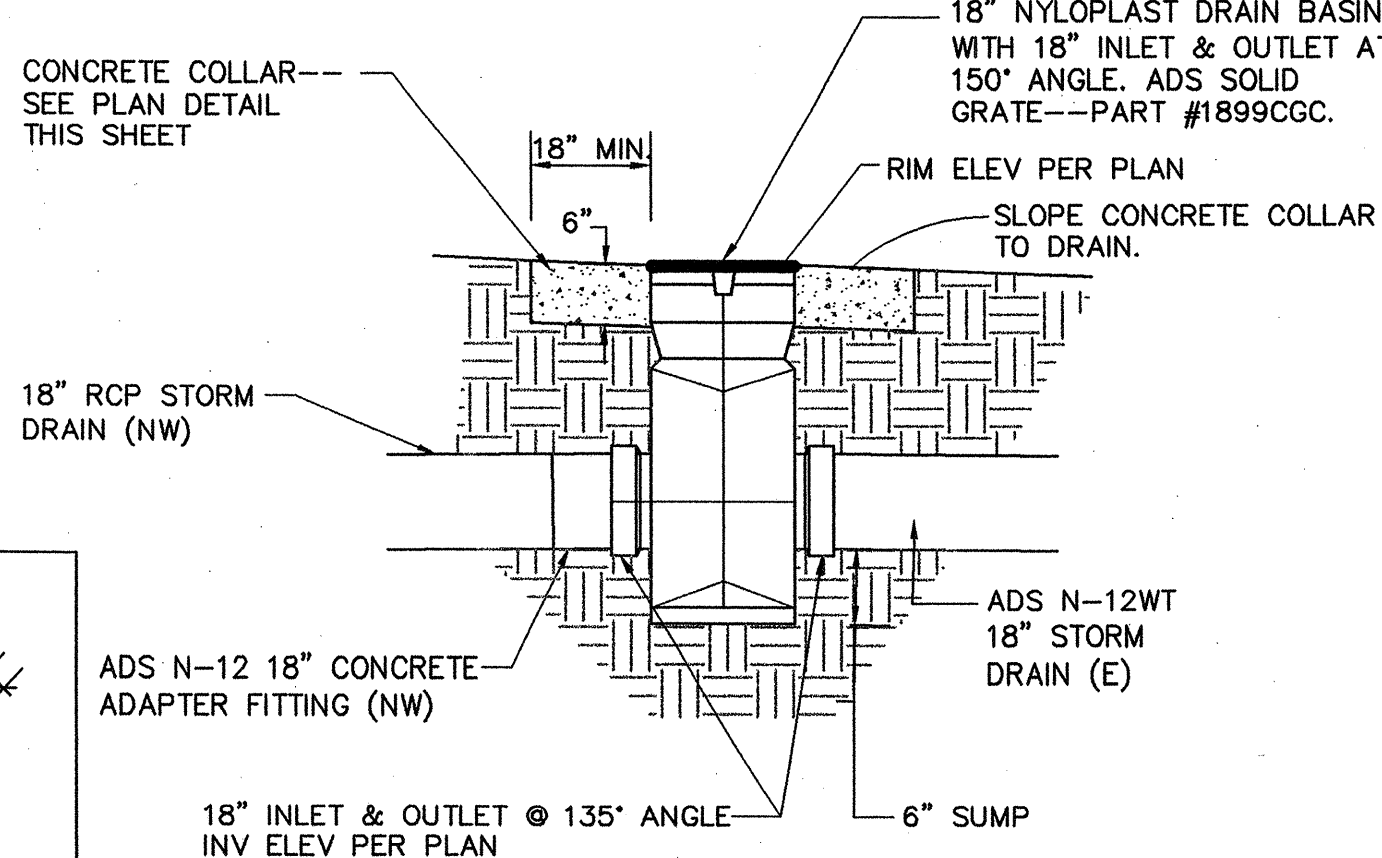

S.O.19 : NOTICE TO CONTRACTORS


- AN EXCAVATION / CONSTRUCTION PERMIT WILL BE REQUIRED BEFORE BEGINNING ANY WORK WITHIN THE CITY RIGHT-OF-WAY.
- ALL WORK DETAILED ON THESE PLANS TO BE PERFORMED, EXCEPT AS OTHERWISE STATED OR PROVIDED FOR HEREON, SHALL BE CONSTRUCTED IN ACCORDANCE WITH THE CITY OF ALBUQUERQUE STANDARD SPECIFICATIONS FOR PUBLIC WORKS CONSTRUCTION, 1986 EDITION AS REVISED THROUGH UPDATE #7 AMENDMENT 1.
- TWO WORKING DAYS PRIOR TO ANY EXCAVATION, THE CONTRACTOR MUST CONTACT NEW MEXICO ONE CALL SYSTEM (260-1990) FOR LOCATION OF EXISTING UTILITIES.
- PRIOR TO CONSTRUCTION, THE CONTRACTOR SHALL EXCAVATE AND VERIFY THE HORIZONTAL AND VERTICAL LOCATIONS OF ALL CONSTRUCTIONS. SHOULD A CONFLICT EXIST, THE CONTRACTOR SHALL NOTIFY THE ENGINEER SO THAT THE CONFLICT CAN BE RESOLVED WITH A MINIMUM AMOUNT OF DELAY.
- BACKFILL COMPACTION SHALL BE ACCORDING TO TRAFFIC / STREET USE.
- MAINTENANCE OF THESE FACILITIES SHALL BE THE RESPONSIBILITY OF THE OWNER OF THE PROPERTY SERVED.
- WORK ON ARTERIAL STREETS SHALL BE PERFORMED ON A 24-HOUR BASIS.

APPROVAL NAME DATE
INSPECTOR

ISAACSON & ARFMAN, P.A.

Consulting Engineering Associates

128 Monroe Street N.E.
Albuquerque, New Mexico 87108
Ph. 505-268-8828 Fax: 505-268-2632
1751 CU-501.dwg Feb 01, 2010

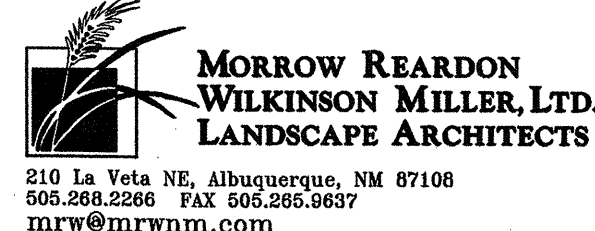

CITY OF ALBUQUERQUE
PARK DESIGN AND CONSTRUCTION DIVISION
DEPARTMENT OF MUNICIPAL DEVELOPMENT

BLACK ARROYO PARK IMPROVEMENTS STORM DRAIN PLAN

Design Review Committee City Engineer Approval
City Project No. 787491 Zone Map No. A-12 Sheet 19 OF 21



AS-BUILT INFORMATION		BENCH MARKS		SURVEY INFORMATION		ENGINEER'S SEAL	
CONTRACTOR	DATE	CONTRACTOR	DATE	FIELD NOTES	DATE	ENGINEER'S SEAL	DATE
WITNESSED BY	DATE	CONTRACTOR	DATE	NO.	BY	ENGINEER'S SEAL	DATE
INSPECTOR'S	DATE	CONTRACTOR	DATE	1. Surveying Control, Inc. 12/06	BY	ENGINEER'S SEAL	DATE
ACCEPTANCE BY	DATE	CONTRACTOR	DATE		BY	ENGINEER'S SEAL	DATE
VERIFICATION BY	DATE	CONTRACTOR	DATE		BY	ENGINEER'S SEAL	DATE
OWNERS	DATE	CONTRACTOR	DATE		BY	ENGINEER'S SEAL	DATE
RECORDED BY	DATE	CONTRACTOR	DATE		BY	ENGINEER'S SEAL	DATE
NO.	DATE	CONTRACTOR	DATE		BY	ENGINEER'S SEAL	DATE

FINAL FOR CONSTRUCTION
DATE: FEBRUARY 12, 2010



Black Arroyo Park Improvements


PROJECT# 787491

RECORD DRAWINGS
DATE:

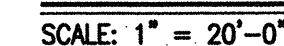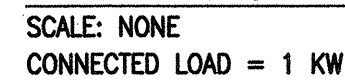

-

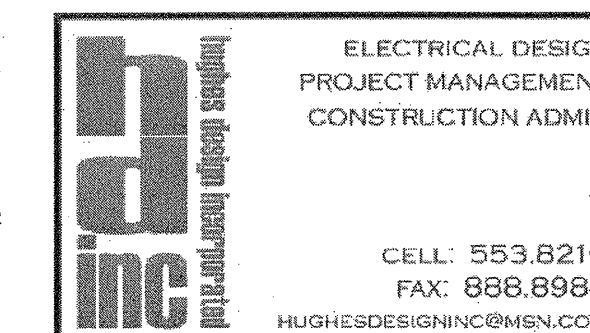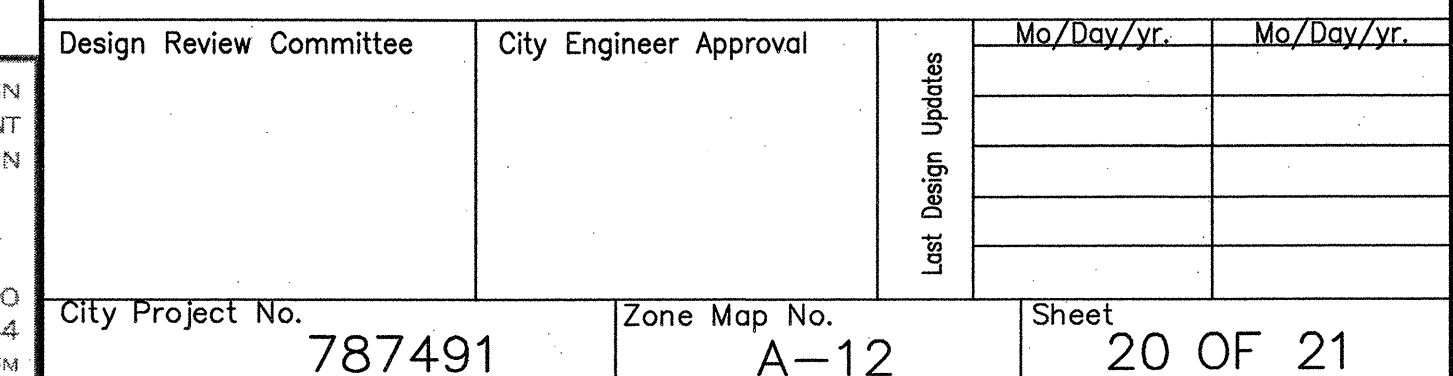

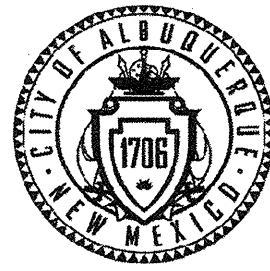

City of Albuquerque
Richard J. Berry, Mayor

Department of Municipal Development
Michael J. Riordan, P.E., Acting Director

Project Information Form

Date: 2/12/10
To: Jeff Hart, Superintendent, Park Management, Parks & Recreation Department (PRD)
From: John Casados, Construction Manager, Park Design & Construction, DMD
Subject: Black Arroyo Park Improvements - Substantial Completion:
PRD, Park Management Division Accepts Maintenance Responsibility

As of (date): 2/12/10
Project ID#: 787491
Name of Facility: Black Arroyo Park
Address: 5001 Quarry Rd. CD: 5
Albuquerque, NM Park Zoning: R-1

... is officially assigned to the Park Management Division, Parks & Recreation Department, City of Albuquerque for maintenance. Outlined below is a description of work completed:

Renovation X Developed

Detailed Park Summary Information:

Total Park Acreage: 4.25 acres
Acres Developed: 4.25 acres

Description of Project:

Acres of Irrigated Turf	2.89	cool / warm season
Turf Removal:	0	square feet
Landscape Area Trees & Shrubs:	40,392	square feet
Tree Count:	84/17	Deciduous/Evergreen
Recycled Construction Materials:	2	truckloads
Recycled Benches	10	
Recycled Tables	5	
Engineered Wood Fibers	140	cubic yards

Park property developed; per FINAL FOR CONSTRUCTION DOCUMENTS DATED X/XX/09 and COA specifications.
New:
1. Site furnishings: Recycled Plastic Picnic Tables; Recycled Plastic Benches; Trash Receptacles; Shade Structures; Bike Rack; ornamental fencing
2. Hardscape: Concrete sidewalk paving; concrete access ramp into play area; mowcurbs; mountable roll-type curb; wheelchair access ramps
3. Playground: Play equipment; Engineered wood fibers

Vendor: Everplay
Phone: (505) 577-7004
Application:
Product: Play Equipment
Model#: #LSI-120891A, Dino Egg Fossil, Dino Head Fossil
Manufacture structural warranty:

Project Name: Black Arroyo Park Improvements				
Amenities	Total Existing	# Removed	# Added	Current Total
Benches	0	0	10	10
Bike Racks (capacity)	0	0	7	7
Exercise Stations	0	0	0	0
Mutt Mitt Dispensers	0	0	0	0
Picnic Tables-ADA	0	0	1	1
Picnic Tables	0	0	4	4
Play Areas	0	0	1	1
Play Areas-wood fiber (sf)	0	0	3547	3547
Play Structures (2 to 5 yrs)	0	0	0	0
Play Structures (5 to 12 yrs)	0	0	1	1
Swings Sets	0	0	1	1
Shade Structure	0	0	3	3
Trash Receptacles	0	0	6	6

Wire Fence - 4' (LF)	0	0	1129	1129
Chain Link Fence - 4'	0	0	0	0
Parking Spaces-ADA	0	0	0	0
Parking Spaces-standard	0	0	0	0

Light Pole-Single Hd Fixture	0	0	0	0
Light Pole - Double Hd Fixture	0	0	0	0
Basketball Courts (Full)	0	0	0	0
Basketball Courts (Half)	0	0	0	0
Off Leash Dog Area wood fiber	0	0	0	0
Recreation Fields	0	0	0	0
Skate Facility, Modular	0	0	0	0
Softball Fields (Lit)	0	0	0	0
Softball Fields (Unlit)	0	0	0	0
Tennis Courts (Lit)	0	0	0	0
Tennis Courts (Unlit)	0	0	0	0

Effective date: 2/10/10
NO MORE CHARGES for new water, electric and gas

...will be accepted by the contractor:

...are to occur against activity numbers:

Contacts:

Project Manager, City of Albuquerque, Park Design & Construction, DMD

Project Manager: David Flores
Phone: (505) 768-3815
Email: dflores@cabq.gov
Fax: (505) 768-2310

Consultant: AE#7309.01

Design Consultant: Morrow Reardon Wilkinson Miller, Ltd.
Address: 210 La Veta NE, Albuquerque, NM 87108
Project Manager: Brian Verardo, ASLA
Phone: (505) 268-2266
Email: verardo@mrwnm.com
Application:

Landscape Architect of Record: Brian Verardo
Address: 210 La Veta NE, Albuquerque, NM 87108
Phone: (505) 268-2266
Email: verardo@mrwnm.com

Contractor Information:

Contractor:
Contract Name:
Phone:
Scope of Work:
Warranty: One (1) year labor and materials
Warranty Start Date:

Contractor:
Contract Name:
Phone:
Scope of Work:
Warranty: One (1) year labor and materials
Warranty Start Date:

Warranty and Vendor Information:

The following is a listing of all labor, vendors and product warranties pertaining to project:
During the first year all calls regarding warranty information will go to the contractor. After one year calls regarding warranty go directly to the vendor.

Vendor: Kids Place Designs
Phone: (505) 553-3467
Application:
Product: Benches, Picnic Tables, Bike Rack, Shade Structures
Model#: #6CP-GL, #6CPDNB-GL, 6' Mountaineer Picnic Table, 6' Handicapped Accessible Mountaineer Picnic Table, #5990, #AS-MP1440-RC, #4S12-AS, #4S16-AS
Manufacture structural warranty:

Vendor: Gametime
Phone: (505) 899-6892
Application:
Product: Play Equipment
Model#: #RDU
Manufacture structural warranty:

Audit Information for Play Equipment, Irrigation System and Backflow Preventor

Auditor:
Phone:
Inspector Name:
Inspection Date:
Products Inspected: All Play Equipment and Surfacing

Auditor:
Phone:
Inspector Name:
Inspection Date:
Products Inspected: Backflow Prevention Assembly

Auditor:
Phone:
Inspector Name:
Inspection Date:
Products Inspected: Landscape Irrigation Water Audit

Water Meter:


Reading: _____
Address: _____
Serial Number: _____
Type: _____
Final billing date: _____
New Service JV: _____

Electric Meter:

Reading: _____
Number: _____
Serial Number: _____
Type: _____

- Maintenance Documents
 - Keys (6-trash receptacles)
 - Benches
 - Tables
 - Play Structures
 - Shade Structures (engineered drawings and footing details)
 - Irrigation Controller
- Permits (date approved)
 - Electrical ()
 - SWPPP/NOI ()
 - Building
 - Dust Control
 - Water Meter Tap ()
 - Concrete Tests
 - Compaction Tests
- Punch list complete date:
- Record drawings per General Conditions section 6.10
 - Reproducible as built Record Drawings for entire park project completed by a certified draftsman.
 - same scale as plans.
 - Legible, reduced laminate layout drawings of irrigation system for each controller.
 - color coded by each valve front of copy.
 - irrigation legend and scheduled back of copy.
 - irrigation schedule back of copies.
 - 11"x17" format.

Email copies to:

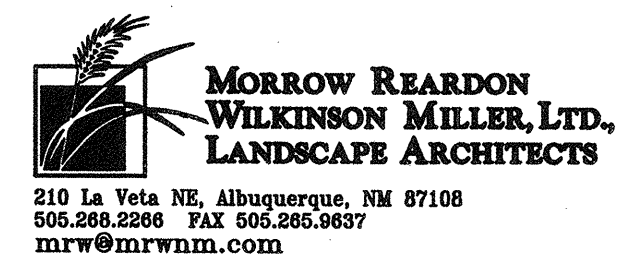

CITY OF ALBUQUERQUE
PARK DESIGN AND CONSTRUCTION DIVISION
DEPARTMENT OF MUNICIPAL DEVELOPMENT

BLACK ARROYO PARK IMPROVEMENTS PROJECT INFORMATION FORM

Design Review Committee	City Engineer Approval	Last Design Update	Mo./Day/Yr.	Mo./Day/Yr.
City Project No.	Zone Map No.	Sheet		
787491	A-12	21 OF 21		

AS-BUILT INFORMATION		BENCH MARKS		SURVEY INFORMATION		ARCHITECTURAL SEAL		REVISIONS		NO. DATE		REMARKS		DESIGNED BY		DRAWN BY		CHECKED BY													
CONTRACTOR	DATE	WORK STATED BY	DATE	FIELD NOTES	BY	DATE		NO.	BY	DATE	NO.	DATE	BY	DATE	AD	BV	DATE	DATE	DATE												

FINAL FOR CONSTRUCTION
DATE: FEBRUARY 12, 2010

Black Arroyo Park Improvements

PROJECT# 787491

RECORD DRAWINGS
DATE: