


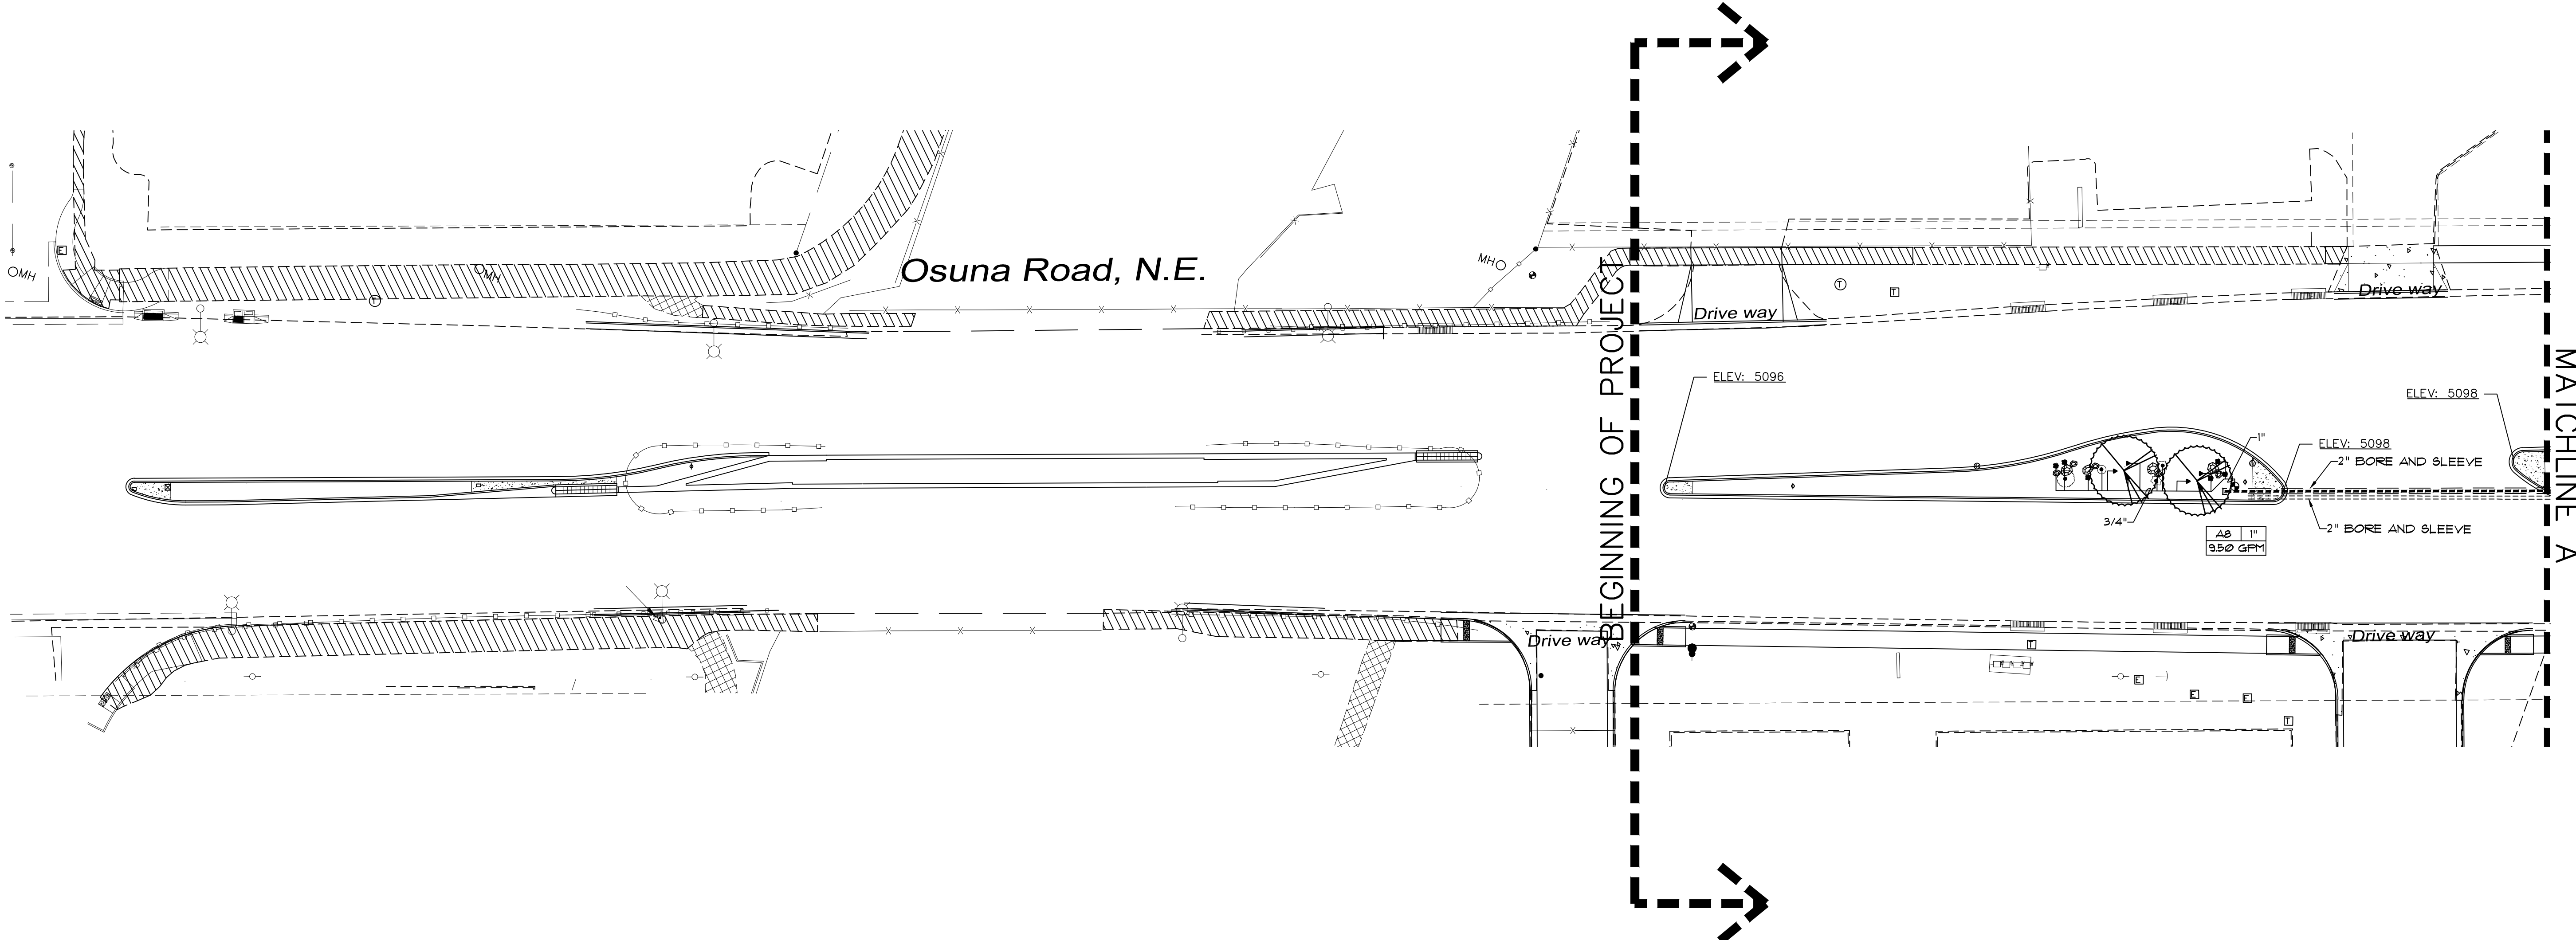

IRRIGATION LEGEND for POC #1		
	WATER METER, 2".	
	IRRIGATION SERVICE LINE, 28" DEPTH OF BURY.	
	IRRIGATION MAIN LINE, SCH. 40 BELL END, SOLVENT WELD PVC, DEPTH OF BURY SHALL BE 28" AT CONSTANT PRESSURE MAIN LINE, 18" DEPTH OF BURY AT NON-CONSTANT PRESSURE MAIN LINE, SIZE PER PLAN.	
	LATERAL PIPING, SCH. 40 BELL END, SOLVENT WELD PVC, DEPTH OF BURY, 18", SIZE PER PLAN.	
	MAIN LINE AND LATERAL SLEEVE PIPING, 2 SIZES LARGER THAN PIPE SIZE, CLASS 200, SDR-21, BELL-END, SOLVENT WELD PVC. SLEEVES ARE TO BE BORED.	
	24-VOLT IRRIGATION WIRE SLEEVE PIPING, 2", CLASS 200, SDR-21, BELL-END, SOLVENT WELD PVC. SLEEVES ARE TO BE BORED.	
	ISOLATION VALVE	
	FEBCO 825-YA 15' REDUCED PRESSURE PRINCIPAL BACKFLOW PREVENTER AND ARAD FLOW METER COMBO MASTER VALVE WITH BALL VALVES, INSTALLED IN HEATED AND INSULATED ENCLOSURE. SIZE OF RP, MASTER VALVE, AND FLOW METER SHALL BE SAME AS LINE SIZE. ENCLOSURE SHALL BE SIZED TO ACCOMMODATE SIZE OF RP AND ARAD FLOW METER/MASTER VALVE ASSEMBLY.	
	REMOTE CONTROL VALVE ASSEMBLY, RAINBIRD FEB PLASTIC BODY 24-VOLT AUTOMATIC VALVE, SIZE PER PLAN. INSTALL PER C.O.A. DRAWING NO. 2103.	
	1" AIR RELEASE VALVE. INSTALL PER C.O.A. DRAWING NO. 2105.	
	SOLVENT WELD CAP, SCH. 40 PVC, LINE SIZE.	
	PRESSURE COMPENSATING BUBBLER ASSEMBLIES, RAIN BIRD 1400 SERIES, AS FOLLOWS: INSTALL PER C.O.A. DRAWING NUMBERS 2110, 2111, 2111-A AND 2112.	
	MODEL NO.	PSI
	1401	15
	1402	30
	1404	10
	IRRINET M AC CONTROLLER	
	ELECTRIC PEDESTAL AND METER	

IRRIGATION NOTES		
1. LATERAL SHALL BE LOCATED A MINIMUM OF 5' FROM THE TRUNK OF THE TREE. LATERALS MAY BE SHOWN CLOSER TO THE TRUNK FOR GRAPHIC CLARITY.		

AS-BUILT
4/10/2017


5604 Wilshire Ave NE
Albuquerque, NM 87113
(505)822-8722

CITY OF ALBUQUERQUE
CAPITAL IMPLEMENTATION PROGRAM
DEPARTMENT OF MUNICIPAL DEVELOPMENT

PROTOTYPE MEDIAN AND INTERSTATE LANDSCAPES FY-17A
OSUNA: JEFFERSON TO NORTH DIVERSION CHANNEL-WORK ORDER#1
IRRIGATION PLAN


Design Review Committee	City Engineer Approval	Last Design Update	Mo./Day/Yr.	Mo./Day/Yr.

City Project No.	Zone Map No.	Sheet
790001	E16, E17	1 of 3

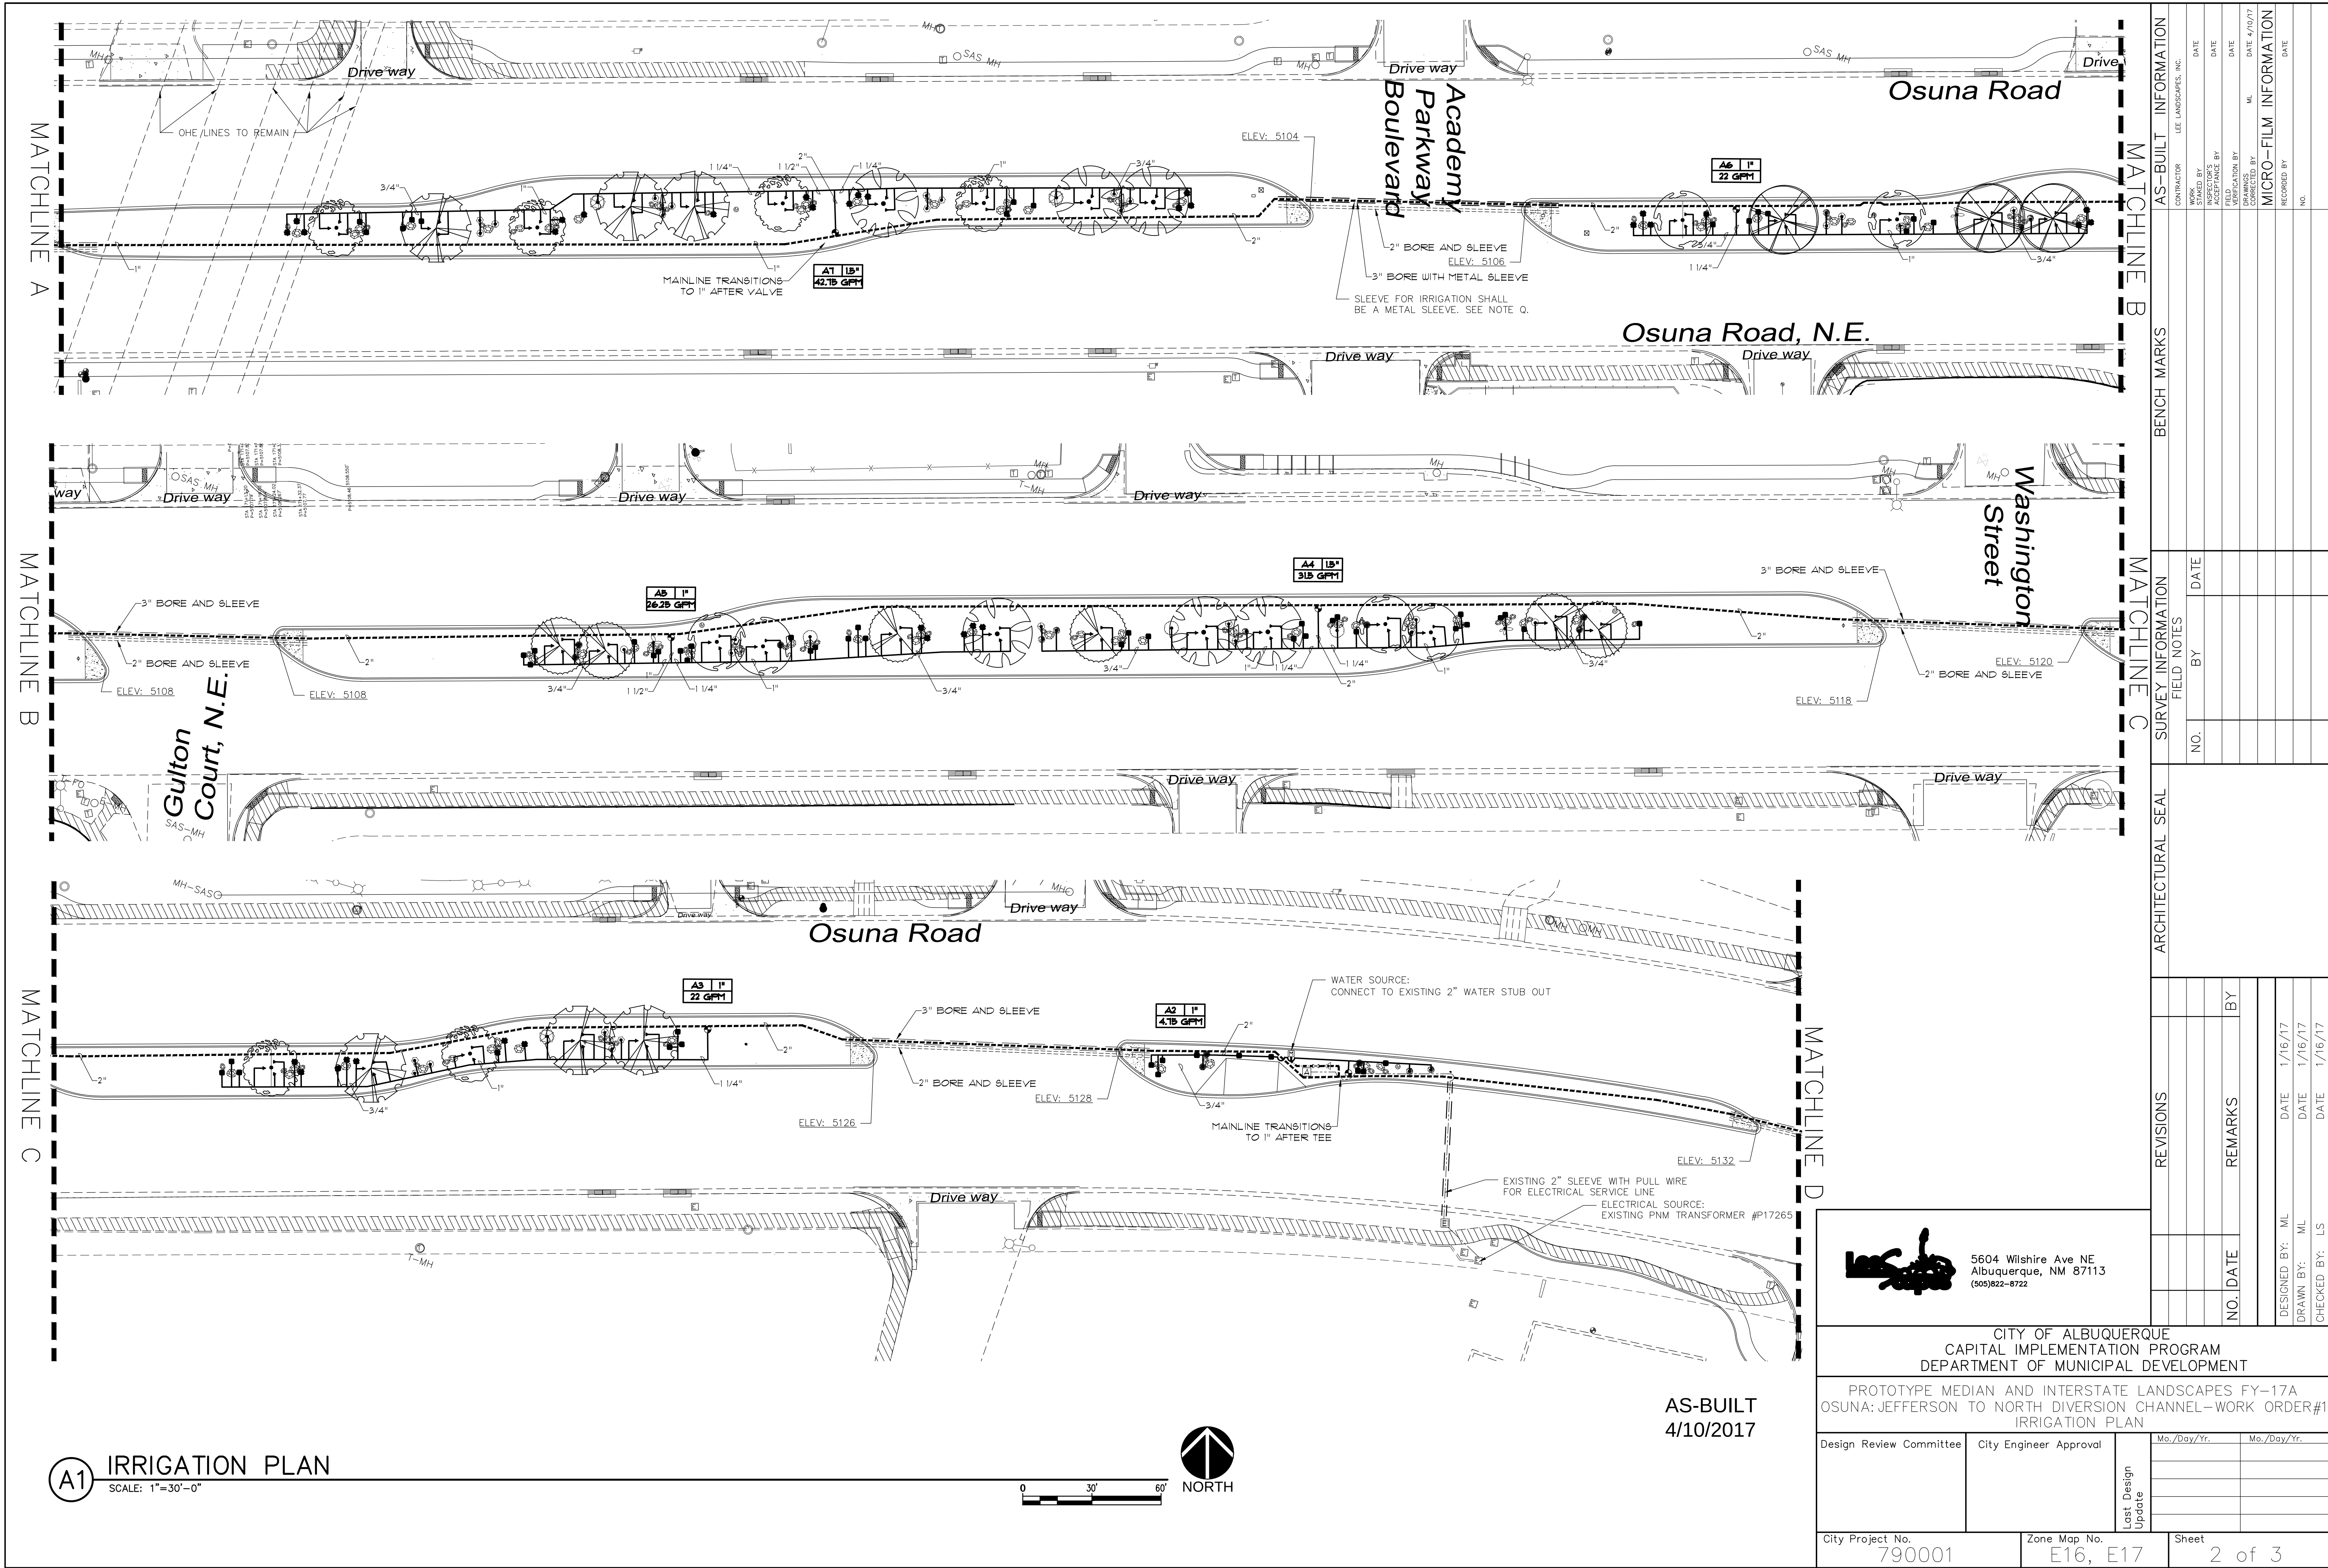


AS-BUILT INFORMATION				BENCH MARKS			
CONTRACTOR	LEE LANDSCAPES, INC.	DATE		NO.	BY	DATE	
INSPECTOR'S		DATE					
ACCEPTANCE BY		DATE					
VERIFICATION BY		DATE					
MICRO-FILM INFORMATION							
DRAWING NO.	470/17	DATE					
RECORDED BY		DATE					
NO.							

DATE: "OSUNA MEDIANS" PROJECT# 790001 RECORD DRAWINGS DATE: 4/10/17

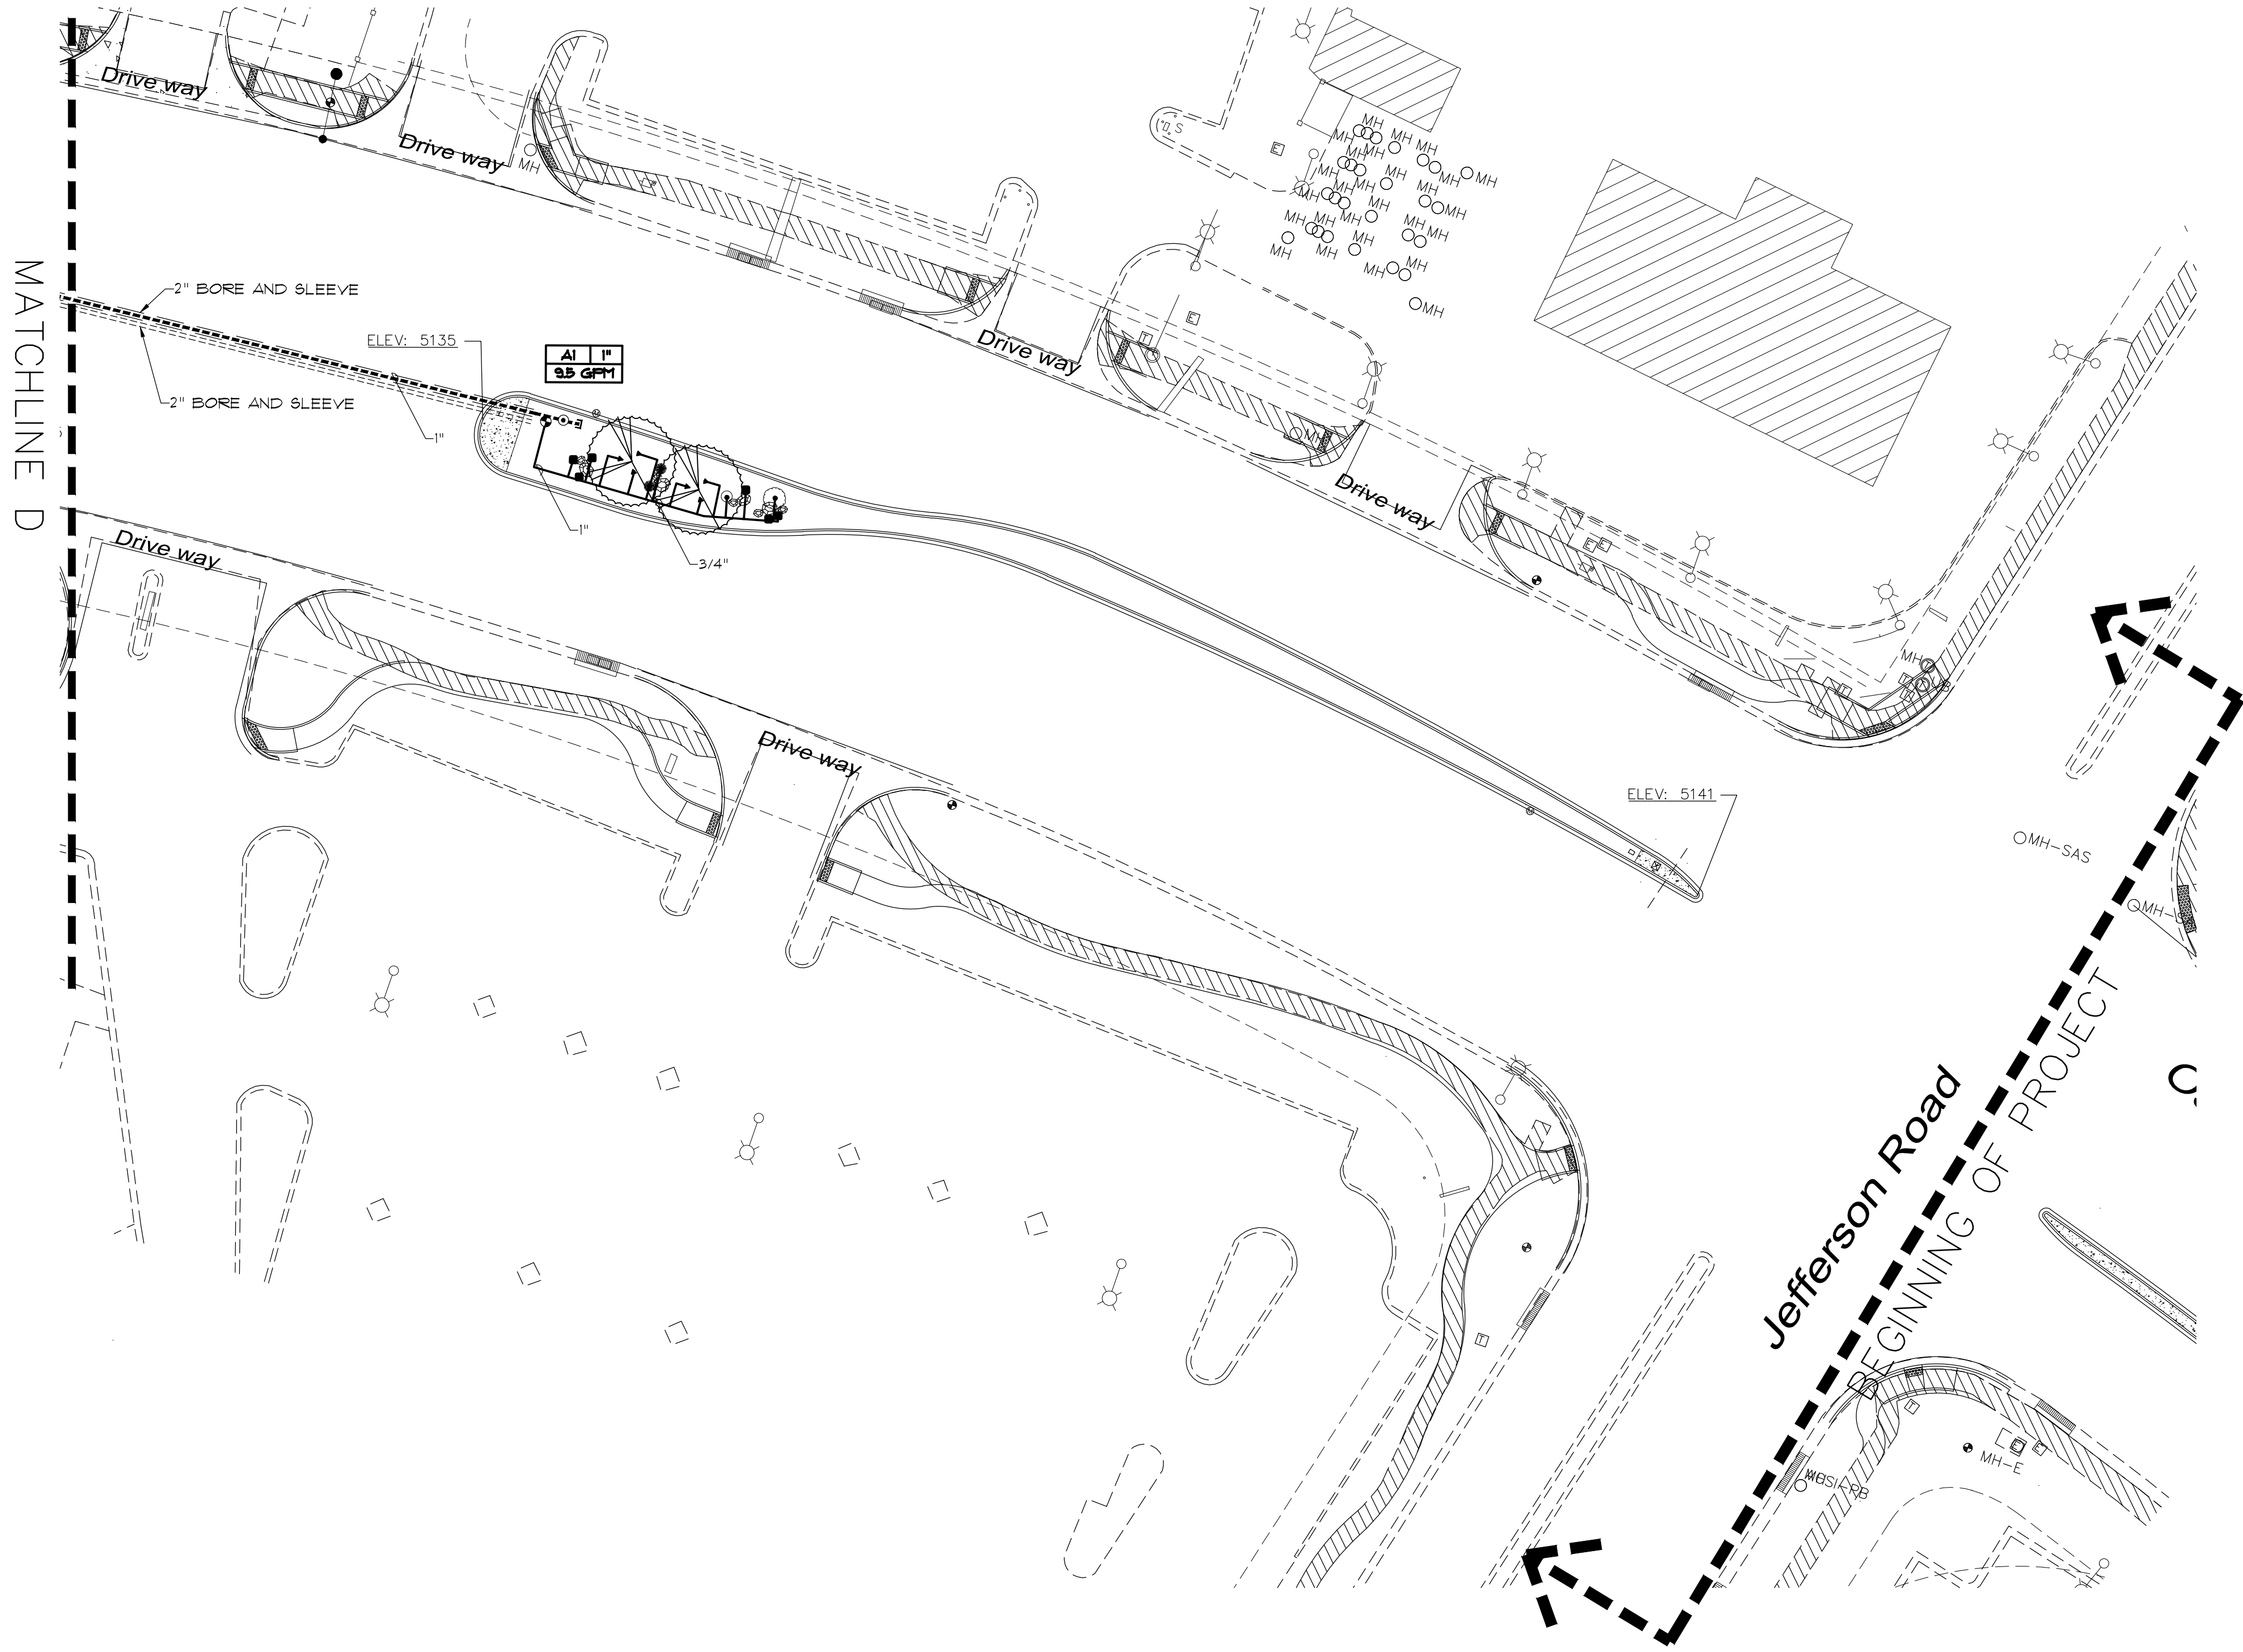

(A1) IRRIGATION PLAN
SCALE: 1"=30'-0"

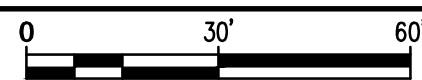

AS-BUILT
4/10/2017

		5604 Wilshire Ave NE Albuquerque, NM 87113 (505)822-8722	
CITY OF ALBUQUERQUE CAPITAL IMPLEMENTATION PROGRAM DEPARTMENT OF MUNICIPAL DEVELOPMENT			
PROTOTYPE MEDIAN AND INTERSTATE LANDSCAPES FY-17A OSUNA: JEFFERSON TO NORTH DIVERSION CHANNEL-WORK ORDER#1 IRRIGATION PLAN			
Design Review Committee	City Engineer Approval	Last Design Update	Mo./Day/Yr.
			Mo./Day/Yr.
City Project No. 790001	Zone Map No. E16, E17	Sheet 3 of 3	

REVISIONS		ARCHITECTURAL SEAL		SURVEY INFORMATION		BENCH MARKS		AS-BUILT INFORMATION	
				FIELD NOTES				CONTRACTOR	
				NO.				LEE LANDSCAPES, INC.	
				BY				DESIGNED BY	
				DATE				DATE	
				REMARKS				INSPECTOR'S SIGNATURE BY	
				BY				DATE	
				NO. DATE				ACCEPTANCE BY	
				DATE				DATE	
				DESIGNED BY: ML				DRAWINGS VERIFICATION BY	
				DATE 1/16/17				DATE 4/10/17	
				DRAWN BY: ML				ML	
				CHECKED BY: LS				MICRO-FILM INFORMATION	
				DATE 1/16/17				RECORDED BY	
								DATE	
								NO.	

RECORD DRAWINGS
DATE: 4/10/17

PROJECT# 790001

"OSUNA MEDIANS"

DATE: