





 








IRRIGATION LEGEND for POC #1		
	WATER METER, 1".	
	IRRIGATION SERVICE LINE, 28" DEPTH OF BURY.	
	IRRIGATION MAIN LINE, SCH 40 BELL END, SOLVENT WELD PVC. DEPTH OF BURY SHALL BE 28" AT CONSTANT PRESSURE MAIN LINE, 18" DEPTH OF BURY AT NON-CONSTANT PRESSURE MAIN LINE. SIZE PER PLAN.	
	LATERAL PIPING, SCH. 40, BELL END, SOLVENT WELD PVC. DEPTH OF BURY, 18". SIZE PER PLAN.	
	MAIN LINE AND LATERAL SLEEVE PIPING, 2 SIZES LARGER THAN PIPE SIZE, CLASS 200, SDR-21, BELL-END, SOLVENT WELD PVC. SLEEVES ARE TO BE BORED.	
	24-VOLT IRRIGATION WIRE SLEEVE PIPING, 2", CLASS 200, SDR-21, BELL-END, SOLVENT WELD PVC. SLEEVES ARE TO BE BORED.	
	ISOLATION VALVE	
	FEBCO 825-YA 1" REDUCED PRESSURE PRINCIPAL BACKFLOW PREVENTER AND MASTER VALVE ASSEMBLY WITH BALL VALVES, INSTALLED IN INSULATED ENCLOSURE AND FLOW METER INSTALLED IN VALVE BOX PER DETAIL C/4. SIZE OF RP, MASTER VALVE, AND FLOW METER SHALL BE SAME AS LINE SIZE. ENCLOSURE SHALL BE SIZED TO ACCOMMODATE SIZE OF RP AND MASTER VALVE ASSEMBLY.	
	REMOTE CONTROL VALVE ASSEMBLY, RAINBIRD FEB PLASTIC BODY, 24-VOLT, AUTOMATIC VALVE, SIZE PER PLAN. INSTALL PER C.O.A. DRAWING NO. 2103.	
	1" AIR RELEASE VALVE. INSTALL PER C.O.A. DRAWING NO. 2105.	
	SOLVENT WELD CAP, SCH. 40 PVC, LINE SIZE.	
	PRESSURE COMPENSATING BUBBLER ASSEMBLIES, RAIN BIRD 1400 SERIES, AS FOLLOWS: INSTALL PER C.O.A. DRAWING NUMBERS 2110, 2111, 2111-A AND 2112.	
	MODEL NO.	GPM FSI
	1401	25 30
	1402	50 30
	1404	10 30
	IRRINET M DC CONTROLLER	
IRRIGATION NOTES		
1. LATERAL SHALL A MINIMUM OF 5' FROM THE TRUNK OF THE TREE. LATERALS MAY BE SHOWN CLOSER TO THE TRUNK FOR GRAPHIC CLARITY.		

A1 IRRIGATION PLAN
SCALE: 1"=30'-0"



AS-BUILT
5/17/2017

		5604 Wilshire Ave NE Albuquerque, NM 87113 (505)822-8722	
CITY OF ALBUQUERQUE CAPITAL IMPLEMENTATION PROGRAM DEPARTMENT OF MUNICIPAL DEVELOPMENT			
PROTOTYPE MEDIAN AND INTERSTATE LANDSCAPES FY-17A INDIAN SCHOOL RD: UPTOWN LOOP TO PENNSYLVANIA IRRIGATION PLAN WORK ORDER #2			
Design Review Committee	City Engineer Approval	Mo./Day/Yr. Mo./Day/Yr.	
City Project No. 790090	Zone Map No. H19	Last Design Update	
Sheet 1 of 2		RECORD DRAWINGS DATE: MAY 17, 2017	

REVISIONS		ARCHITECTURAL SEAL		SURVEY INFORMATION FIELD NOTES		BENCH MARKS		AS-BUILT INFORMATION	
				NO.	BY	DATE		CONTRACTOR	LEE LANDSCAPES, INC.
								WORK	
								STAGED BY	DATE
								ACCEPTANCE BY	DATE
								FIELD ACTION BY	DATE
								DRAWINGS	ML
								CORRECTED BY	DATE 5/17/17
								RECORDED BY	DATE
								NO.	

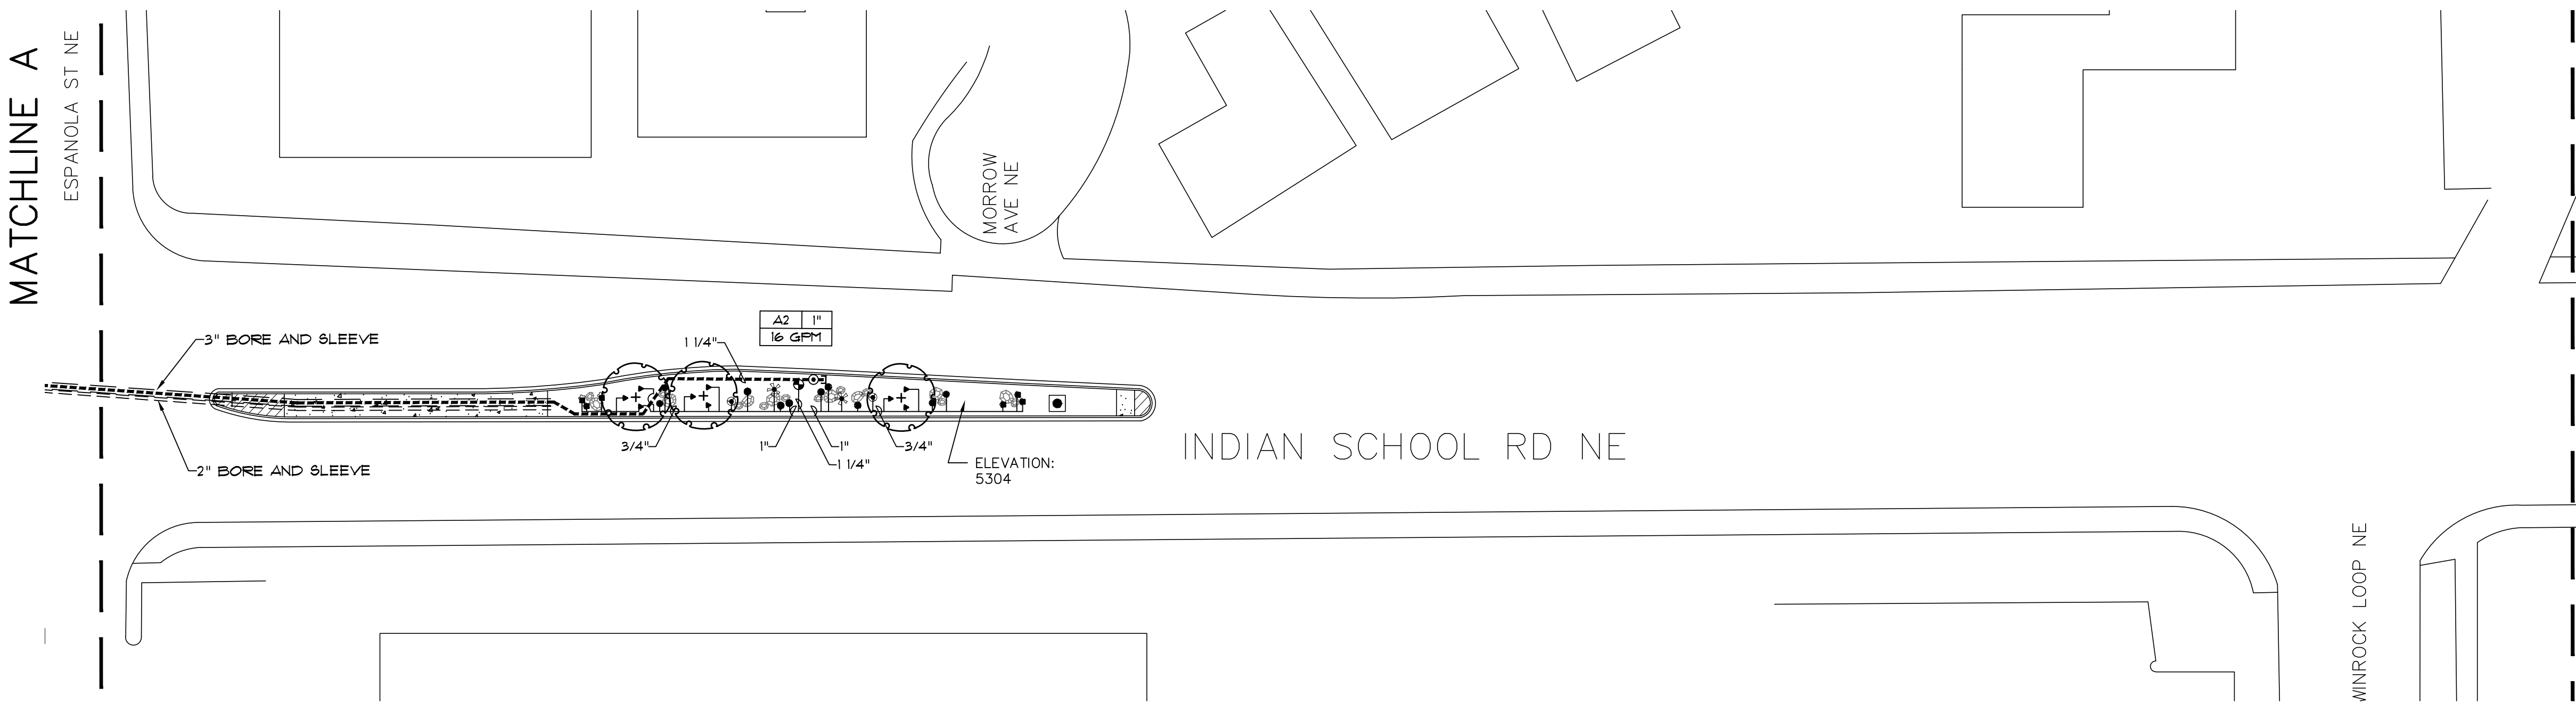
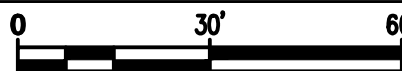
FOR CONSTRUCTION
DATE: MARCH 14, 2017

INDIAN SCHOOL
UPTOWN LOOP TO PENNSYLVANIA



PROJECT# 790090

A1 IRRIGATION PLAN

SCALE: 1"=30'-0"



AS-BUILT
5/17/2017

		5604 Wilshire Ave NE Albuquerque, NM 87113 (505)822-8722		
<div><div></div><div>CITY OF ALBUQUERQUE CAPITAL IMPLEMENTATION PROGRAM DEPARTMENT OF MUNICIPAL DEVELOPMENT</div></div>				
PROTOTYPE MEDIAN AND INTERSTATE LANDSCAPES FY-17A INDIAN SCHOOL RD: UPTOWN LOOP TO PENNSYLVANIA IRRIGATION PLAN WORK ORDER #2				
Design Review Committee	City Engineer Approval	Last Design Update	Mo./Day/Yr.	Mo./Day/Yr.
City Project No.	Zone Map No.	Sheet		
790090	H19	2 of 2		

RECORD DRAWINGS
DATE: MAY 17, 2017

PROJECT# 790090

INDIAN SCHOOL
UPTOWN LOOP TO PENNSYLVANIA

FOR CONSTRUCTION
DATE: MARCH 14, 2017