


GENERAL NOTES:

1. ALL WORK DETAILED ON THESE PLANS TO BE PERFORMED UNDER CONTRACT SHALL, EXCEPT AS OTHERWISE STATED OR PROVIDED FOR HEREON, BE CONSTRUCTED IN ACCORDANCE WITH THE CITY OF ALBUQUERQUE STANDARD SPECIFICATIONS FOR PUBLIC WORKS CONSTRUCTION 1986 EDITION WITH UPDATE NO. 7 INCLUDING AMENDMENT #1.
2. ALL WORK ON THIS PROJECT SHALL BE PERFORMED IN ACCORDANCE WITH APPLICABLE FEDERAL, STATE, AND LOCAL LAWS, RULES, AND REGULATIONS CONCERNING CONSTRUCTION SAFETY AND HEALTH.
3. PRIOR TO CONSTRUCTION, THE CONTRACTOR SHALL EXCAVATE & VERIFY THE HORIZONTAL AND VERTICAL LOCATIONS OF ALL OBSTRUCTIONS. SHOULD A CONFLICT EXIST, THE CONTRACTOR SHALL NOTIFY THE ENGINEER SO THAT THE CONFLICT CAN BE RESOLVED WITH MINIMUM DELAY.
4. TWO (2) WORKING DAYS PRIOR TO ANY EXCAVATION, CONTRACTOR MUST CONTACT NEW MEXICO ONE CALL SYSTEM, INC. @ 260-1990 FOR LOCATION OF EXISTING UTILITIES.
5. CONTRACTOR SHALL CONDUCT HIS OPERATIONS IN A MANNER WHICH WILL MINIMIZE INTERFERENCE WITH LOCAL TRAFFIC. CONTRACTOR SHALL COMPLY WITH ALL APPLICABLE LAWS, ORDINANCES, RULES, REGULATIONS, AND ORDERS OF ANY PUBLIC BODY HAVING JURISDICTION FOR THE SAFETY OF PERSONS OR PROPERTY, AND TO PROTECT THEM FROM DAMAGE, INJURY, OR LOSS. CONTRACTOR SHALL ERECT AND MAINTAIN, AS REQUIRED BY THE CONDITIONS AND PROGRESS OF THE WORK, ALL NECESSARY SAFEGUARDS FOR SAFETY CONTINUOUSLY AND NOT LIMITED TO NORMAL WORKING HOURS, THROUGHOUT THE DURATION OF THE PROJECT.
6. THE CONTRACTOR AGREES THAT HE SHALL ASSUME THE SOLE AND COMPLETE RESPONSIBILITY FOR THE JOB SITE CONDITIONS DURING THE COURSE OF CONSTRUCTION OF THIS PROJECT, INCLUDING SAFETY OF ALL PERSONS AND PROPERTY; THAT THIS REQUIREMENT SHALL APPLY CONTINUOUSLY AND NOT BE LIMITED TO NORMAL WORKING HOURS; AND THAT THE CONTRACTOR SHALL DEFEND, INDEMNIFY, AND HOLD HARMLESS THE OWNER & ENGINEER FROM ANY AND ALL LIABILITY REAL OR ALLEGED, IN CONNECTION WITH THE PERFORMANCE OF WORK ON THIS PROJECT, EXCEPTING LIABILITY ARISING FROM THE SOLE NEGLIGENCE OF THE OWNER OR ENGINEER.
7. TRAFFIC CONTROL: FIVE (5) WORKING DAYS PRIOR TO BEGINNING CONSTRUCTION THE CONTRACTOR SHALL SUBMIT TO THE CONSTRUCTION COORDINATION DIVISION A DETAILED CONSTRUCTION SCHEDULE. TWO (2) WORKING DAYS PRIOR TO CONSTRUCTION, THE CONTRACTOR SHALL OBTAIN A BARRICADING PERMIT FROM THE CONSTRUCTION COORDINATION DIVISION. CONTRACTOR SHALL NOTIFY BARRICADE ENGINEER (924-3400) PRIOR TO OCCUPYING AN INTERSECTION. SEE SECTION 19 OF THE SPECIFICATIONS. ALL STREET STRIPING ALTERED OR DESTROYED SHALL BE REPLACED WITH PLASTIC REFLECTORIZED PAVEMENT MARKINGS BY CONTRACTOR TO LOCATION AS EXISTING OR AS SHOWN IN THIS PLAN SET.
8. WHEN ABUTTING EXISTING PAVEMENT TO NEW, SAWCUT EXISTING PAVEMENT TO A STRAIGHT EDGE AND AT A RIGHT ANGLE, OR AS APPROVED BY THE FIELD ENGINEER. REMOVAL OF BROKEN OR CRACKED PAVEMENT WILL ALSO BE REQUIRED.
9. EXISTING CURB AND GUTTER NOT TO BE REMOVED UNDER THE CONTRACT WHICH IS DAMAGED OR DISPLACED BY THE CONTRACTOR SHALL BE REMOVED AND REPLACED BY THE CONTRACTOR AT HIS EXPENSE.
10. ALL FINAL BACKFILL FOR TRENCHES SHALL BE COMPACTED TO A MINIMUM 95% PER COA STD DWG 2465 MAXIMUM DENSITY PER ASTM D-1557 AND AS DIRECTED BY SECTION 701.14.2 AND STANDARD DRAWING NUMBER 2315.
11. THE CONTRACTOR SHALL PROMPTLY CLEAN UP ANY MATERIAL EXCAVATED WITHIN THE PUBLIC RIGHT-OF-WAY OR PRIVATE ROADWAY EASEMENTS SO THAT THE EXCAVATED MATERIAL IS NOT SUSCEPTIBLE TO BEING WASHED DOWN THE STREET OR INTO ANY PUBLIC DRAINAGE FACILITY.
12. PROPOSED WATERLINE MATERIALS SHALL BE EITHER PVC PIPE MEETING AWWA C900 REQUIREMENTS (6"-12") OR DUCTILE IRON PIPE, THICKNESS CLASS 50 (6"-16").
13. ALL SANITARY SEWER LINE STATIONING REFERS TO SANITARY SEWER CENTERLINE STATIONING.
14. ALL FITTINGS ON WATERLINES SHALL HAVE RESTRAINED JOINTS AS NOTED ON THE PLANS.
15. CONTRACTOR SHALL SUPPORT ALL EXISTING, UNDERGROUND UTILITY LINES WHICH BECOME EXPOSED DURING CONSTRUCTION. PAYMENT FOR SUPPORTING WORK SHALL BE INCIDENTAL TO WATERLINE AND/OR SEWERLINE COSTS.
16. CONTRACTOR SHALL ASSIST THE ENGINEER/INSPECTOR IN THE RECORDING OF DATA ON ALL UTILITY LINES AND ACCESSORIES AS REQUIRED BY THE CITY OF ALBUQUERQUE FOR THE PREPARATION OF RECORD DRAWINGS. CONTRACTOR SHALL NOT COVER UTILITY LINES AND ACCESSORIES UNTIL ALL DATA HAS BEEN RECORDED.
17. THE CONTRACTOR SHALL NOTIFY THE ENGINEER NOT LESS THAN SEVEN (7) DAYS PRIOR TO STARTING WORK IN ORDER THAT THE ENGINEER MAY TAKE NECESSARY MEASURES TO INSURE THE PRESERVATION OF SURVEY MONUMENTS. CONTRACTOR SHALL NOT DISTURB PERMANENT SURVEY MONUMENTS WITHOUT THE CONSENT OF THE ENGINEER AND SHALL NOTIFY THE ENGINEER AND BEAR THE EXPENSE OF REPLACING ANY THAT MAY BE DISTURBED WITHOUT PERMISSION. REPLACEMENT SHALL BE DONE ONLY BY THE CITY SURVEYOR. WHEN A CHANGE IS MADE IN THE FINISHED ELEVATIONS OF THE PAVEMENT OF ANY ROADWAY IN WHICH A PERMANENT SURVEY MONUMENT IS LOCATED, CONTRACTOR SHALL, AT HIS OWN EXPENSE, ADJUST THE MONUMENT COVER TO THE NEW GRADE UNLESS OTHERWISE SPECIFIED. REFER TO SECTION 4.4 OF THE GENERAL CONDITIONS OF THE STANDARD SPECIFICATIONS.
18. PNM WILL PROVIDE AT NO COST TO THE CITY OR THE CONTRACTOR THE REQUIRED PERSONNEL FOR INSPECTION OR OBSERVATION DEEMED NECESSARY BY PNM WHILE THE CONTRACTOR IS EXPOSING PNM'S CABLES. HOWEVER, THE CONTRACTOR SHALL BE CHARGED THE TOTAL COST ASSOCIATED WITH REPAIRS TO ANY DAMAGED CABLES OR FOR ANY COST ASSOCIATED WITH SUPPORTING OR RELOCATING THE POLES AND CABLES DURING CONSTRUCTION.
19. WARNING--EXISTING UTILITY LINE LOCATIONS ARE SHOWN IN AN APPROXIMATE MANNER ONLY, AND SUCH LINES MAY EXIST WHERE NONE AREA SHOWN. THE LOCATION OF ANY SUCH EXISTING LINES IS BASED UPON INFORMATION PROVIDED BY THE UTILITY COMPANY, THE OWNER, OR BY OTHERS, AND THE INFORMATION MAY BE INCOMPLETE OR MAY BE OBSOLETE BY THE TIME CONSTRUCTION COMMENCES. THE ENGINEER HAS UNDERTAKEN NO FIELD VERIFICATION OF THE LOCATION, DEPTH, SIZE, OR TYPE OF EXISTING UNDERGROUND UTILITY LINES. MAKES NO REPRESENTATION PERTAINING THERETO, AND ASSUMES NO RESPONSIBILITY OR LIABILITY THEREFOR. THE CONTRACTOR SHALL INFORM ITSELF OF THE LOCATION OF ANY UTILITY LINE IN OR NEAR THE AREA OF THE WORK IN ADVANCE OF AND DURING EXCAVATION WORK. THE CONTRACTOR IS FULLY RESPONSIBLE FOR ANY AND ALL DAMAGE CAUSED BY ITS FAILURE TO LOCATE, IDENTIFY, AND PRESERVE ANY AND ALL EXISTING UTILITIES. THE CONTRACTOR SHALL COMPLY WITH STATE STATUTES, MUNICIPAL AND LOCAL ORDINANCES, RULES AND REGULATIONS PERTAINING TO THE LOCATION OF THESE LINES AND FACILITIES, IN PLANNING AND CONDUCTING EXCAVATION, WHETHER BY CALLING OR NOTIFYING THE UTILITIES, COMPLYING WITH "BLUE STAKES" PROCEDURES, OR OTHERWISE.
20. ANY WORK OCCURRING WITHIN AN ARTERIAL ROADWAY REQUIRES 24 HR. CONSTRUCTION.
21. ALL EXCAVATION, TRENCHING AND SHORING ACTIVITIES MUST BE ACCOMPLISHED IN ACCORDANCE WITH OSHA 29CFR 1926.650 SUBPART P.
22. CONTRACTOR SHALL MAINTAIN A GRAFFITI-FREE WORK SITE. CONTRACTOR SHALL PROMPTLY REMOVE ANY AND ALL GRAFFITI FROM EQUIPMENT, WHETHER PERMANENT OR TEMPORARY.
23. FOR STORM DRAIN CONSTRUCTION, RCP PIPE JOINTS SHALL NOT BE GROUTED PRIOR TO FINAL INSPECTION. FINAL INSPECTION WILL DETERMINE JOINTS TO BE GROUTED FOR FINAL ACCEPTANCE OF THE CONSTRUCTION.
24. CONTRACTOR WILL BE RESPONSIBLE FOR PROVIDING & MAINTAINING ALL CONSTRUCTION SIGNING UNTIL PROJECT HAS BEEN ACCEPTED BY THE COA.
25. ELECTRONIC MARKER DISKS (EMD) WILL BE PLACED ACCORDING TO SECTION 170 OF THE CITY OF ALBUQUERQUE STANDARD SPECIFICATIONS FOR PUBLIC WORKS CONSTRUCTION, 1986 EDITION AS REVISED THROUGH UPDATE #7.
26. PERMANENT PAVEMENT STRIPING AND MARKINGS WILL BE PLACED BY THE CONTRACTOR. THE ROAD SHALL NOT BE OPENED TO THE TRAFFIC UNTIL IT IS STRIPED. ALL STRIPING, PAVEMENT MARKINGS INCLUDING CROSSWALKS, ARROWS AND LINE MARKINGS ARE TO BE CONSTRUCTED OF HOT PLASTIC OR COLD PLASTIC IN ACCORDANCE WITH THE MANUAL OF UNIFORM TRAFFIC CONTROL DEVICES.

CITY OF ALBUQUERQUE PLANS FOR CONSTRUCTION

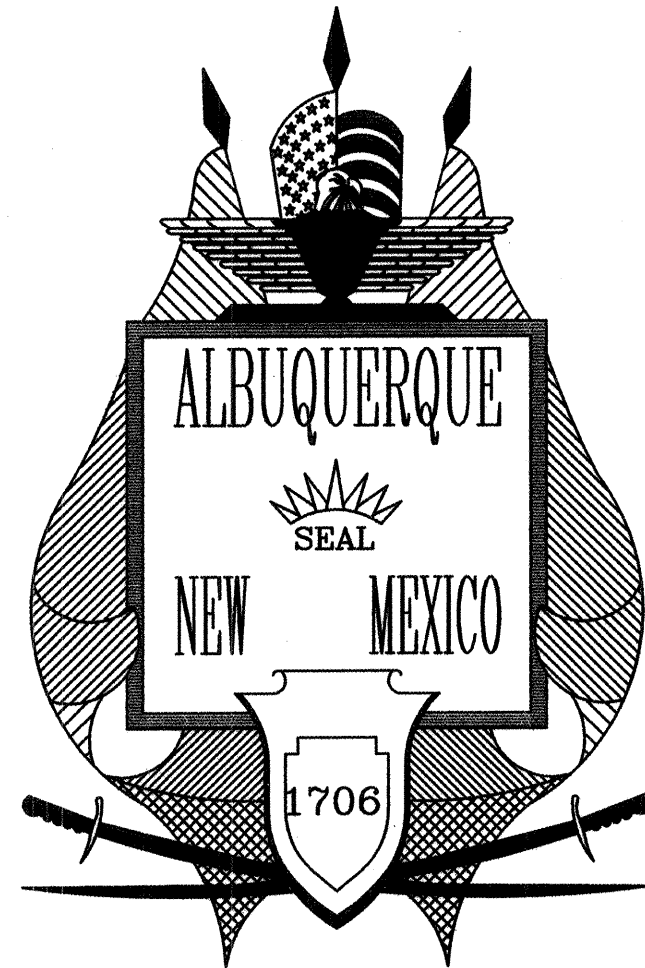

BLUFFS AT ENCANTADO SUBDIVISION

INDEX OF SHEETS


1	TITLE SHEET
2-3	PLAT
4	GRADING PLAN
5	PAVING DETAILS
6	DRAINAGE DETAILS
7	OVERALL PAVING PLAN
8	AVITAL DR. PAVING PLAN AND PROFILE
9	AVITAL DR. PAVING PLAN AND PROFILE
10	AVITAL DR. PAVING PLAN AND PROFILE
11	HUERFANO RD. PAVING PLAN AND PROFILE
12	OVERALL UTILITY PLAN
13	AVITAL DR. UTILITY PLAN AND PROFILE
14	AVITAL DR. UTILITY PLAN AND PROFILE
15	AVITAL DR. UTILITY PLAN AND PROFILE
16	HUERFANO RD. UTILITY PLAN AND PROFILE

10A. REVISED P/P - AVITAL DR.

SURVEYORS CERTIFICATION

I, Russ P. Hugg, New Mexico Professional Surveyor Number 9750, hereby certify that the as-built information shown hereon is the result of an actual field survey performed by me or under my direct supervision and that the same is true and correct to the best of my knowledge and belief:

Russ P. Hugg
NMPS No. 9750
6.9, 2007

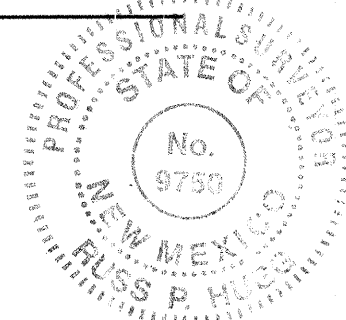


APPROVED AS RECORD DRAWINGS
DESIGN REVIEW SECTION
CITY CONSTRUCTION ENGINEER
Paul J. Bingham
DATE: 9/25/2007

VICINITY
MAP



MAP NO. K&L-23-Z

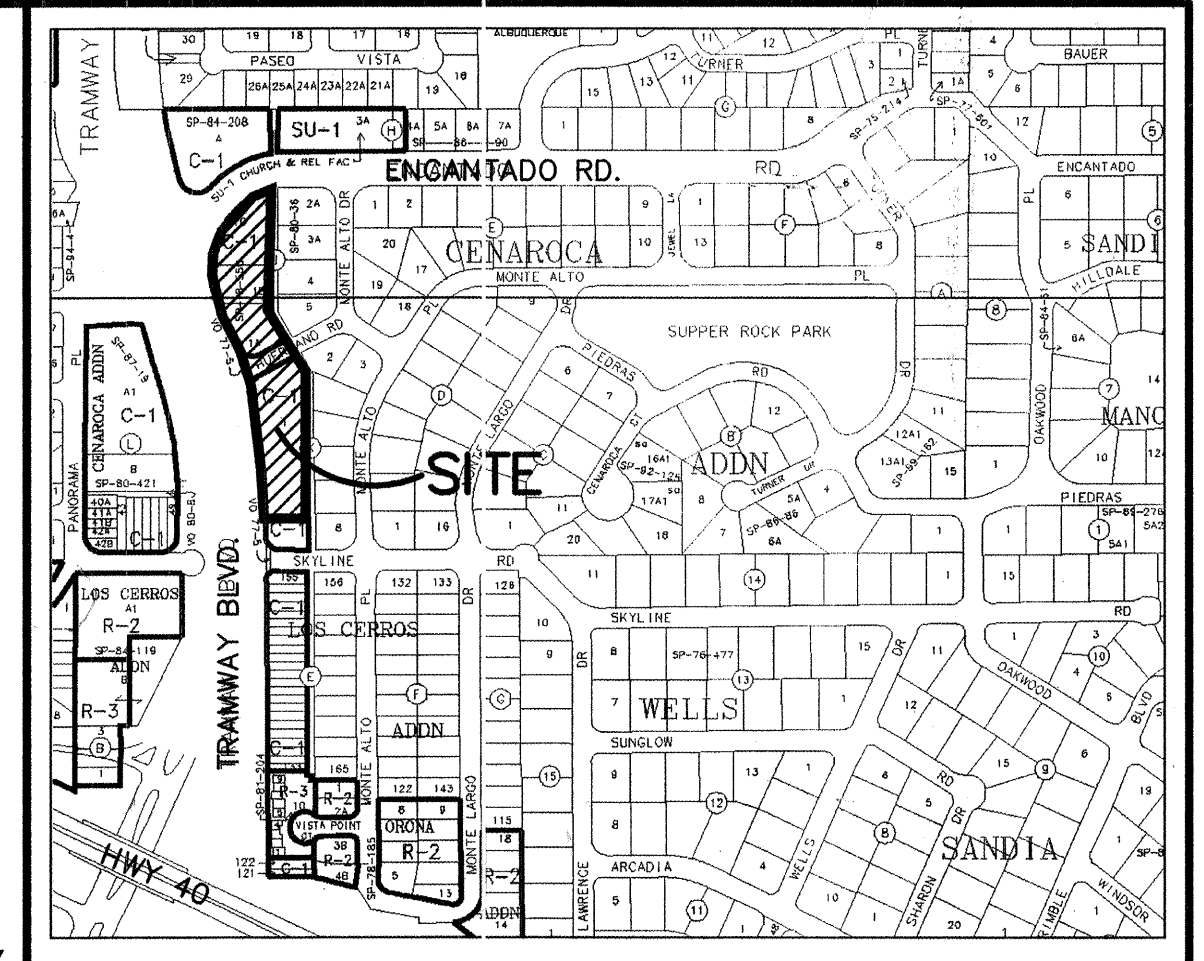

ZONE ATLAS MAP: K-23-Z AND L-23-Z

RECORD DRAWINGS

I, J. Allen Bolinger, of the firm of Smith Engineering Company, a Registered Professional Engineer in the State of New Mexico, do hereby state that to the best of my knowledge and belief, the infrastructure for this project as shown on the plans has been constructed in general accordance with the project plans and in general accordance with the City of Albuquerque Standard Specifications for Public Works Construction (including all updates), and that the general intent of the plans has been met except as noted on the as-built construction drawings. The infrastructure construction has been observed by a qualified person from Smith Engineering Company and this statement covers infrastructure installation that was observed while a representative from Smith Engineering was on site. This statement is based on site observations by Smith Engineering Company personnel and on as-built information provided to Smith Engineering Company by Russ P. Hugg (Surveyor's name), NMPS number 9750 (PS#).

J. Allen Bolinger
7/19/07

Thompson
Engineering
Consultants, Inc.
tccrm@yahoo.com

P.O. BOX 65760
ALBUQUERQUE, NM 87193
PHONE: (505) 271-2199
FAX: (505) 830-9426

REV.	SHEETS	CITY ENGINEER	DATE	USER DEPARTMENT	DATE	USER DEPARTMENT	DATE
ENGINEERS STAMP & SIGNATURE		APPROVED	ENGINEER	DATE	APPROVED FOR CONSTRUCTION		
		DRC Chairman		10-18-06			
		Transportation		9-7-06			
		Water/Wastewater		9-7-06			
		Hydrology		9-7-06			
		CIP					
AMAFCA					Bradley J. Bingham 10/16/06		
Constr. Coord.					CITY ENGINEER DATE		
PROJECT NUMBER							
790281						DRAWING NO. 1 OF 16	

DRB NO. 1004496

Plat of

within
in 10 North. Range 4 East. NMPM.

20

Page: 5 of 10

LINE TABLE

Public Utility Easements:

1. THE PNM ELECTRIC SERVICES DIVISION, FOR THE INSTALLATION, MAINTENANCE AND SERVICE OF OVERHEAD AND UNDERGROUND ELECTRICAL LINES, TRANSFORMERS, POLES AND STRUCTURES, BUILDINGS, STRUCTURES AND RELATED FACILITIES AND ANY OTHER EQUIPMENT, FIXTURES, OR ACCESSORIES, SHALL BE RESPONSIBLE FOR THE NECESSARY TO PROVIDE ELECTRICAL SERVICES.

3. QUEST FOR INSTALLATION, MAINTENANCE AND SERVICE OF ALL BURIED AND AERIAL COMMUNICATION LINES AND OTHER RELATED EQUIPMENT AND FACILITIES REASONABLY NECESSARY TO PROVIDE COMMUNICATION SERVICES, INCLUDING BUT NOT LIMITED TO RECORDING, REPEATING AND CLOSURES.

INCLUDED, IS THE RIGHT TO BUILD, REBUILD, RECONSTRUCT, LOCATE, RELOCATE, CHANGE, REMOVE, MODIFY, OPERATE AND MAINTAIN FACILITIES FOR THE PURPOSES DESCRIBED ABOVE, TOGETHER WITH FREE ACCESS TO ELECTRIC


IN APPROVING THIS PLAT, THE UTILITY COMPANIES DID NOT CONDUCT A TITLE SEARCH OF THE PROPERTIES SHOWN HEREON. CONSEQUENTLY, THE UTILITY COMPANIES DO NOT WAIVE OR RELEASE ANY EASEMENT OR EASEMENT RIGHTS WHICH MAY HAVE BEEN GRANTED BY PRIOR PLAT, REPLAT OR OTHER DOCUMENT AND WHICH ARE NOT SHOWN ON THIS PLAT. EASEMENTS FOR ELECTRIC TRANSFORMERS/SWITCHEARS, AS INSTALLED, SHALL EXTEND TEN FEET (10') IN FRONT OF TRANSFORMER/SWITCHGEAR DOORS, AND FIVE FEET (5') ON EACH SIDE.

L



(IN FEET)

—

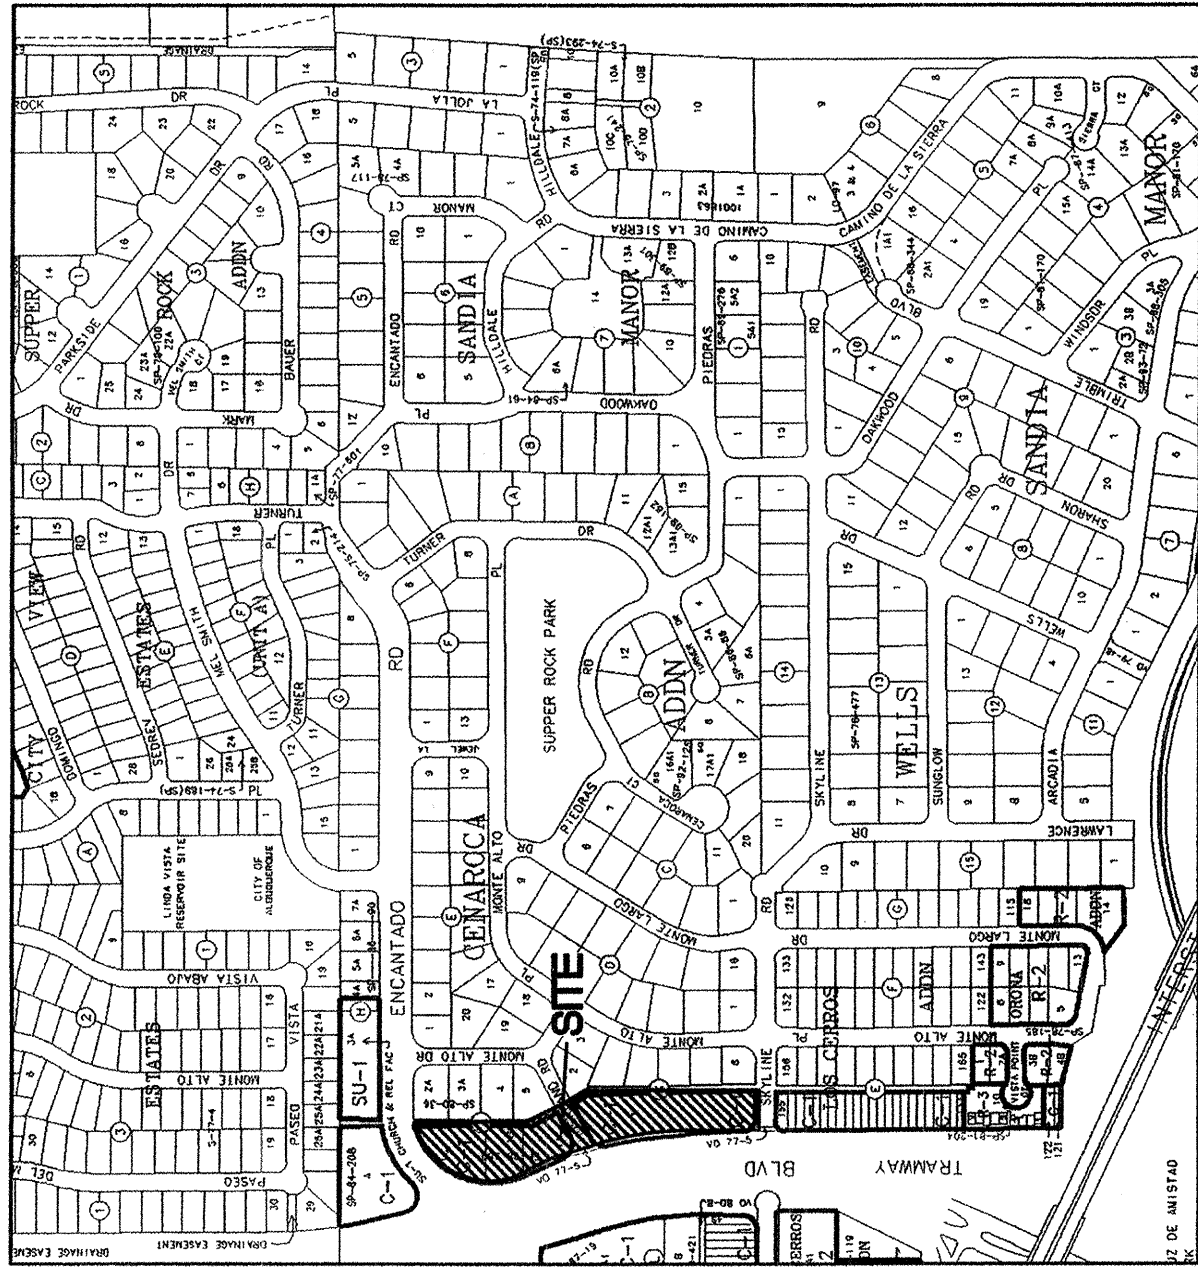

Vicinity Map K-23-Z and L-23-Z n.t.s.

Purpose of Plat

- 1. ELIMINATE LOT LINE AS SHOWN HEREON.
- 2. REDUCE PUBLIC RIGHT OF WAY AS SHOWN.
- 3. DEDICATE PUBLIC RIGHT OF WAY AS SHOWN.
- 4. VACATE EASEMENTS AS SHOWN.
- 5. VACATE EASEMENTS AS SHOWN.
- 6. VACATE EASEMENTS AS SHOWN.

Free Consent and Dedication

THE SUBDIVISION HEREON DESCRIBED IS WITH THE FREE CONSENT AND IN ACCORDANCE WITH THE DESIRES OF THE UNDERSIGNED OWNER(S) AND/OR PROPRIETOR(S) THEREOF AND SAID OWNER(S) AND/OR PROPRIETOR(S) DO HEREBY DEDICATE PUBLIC RIGHT OF WAY AS SHOWN HEREON IN FEE SIMPLE WITH WARRANTY COVENANTS, AND GRANT PUBLIC UTILITY EASEMENTS TO THE CITY OF ALBUQUERQUE, NEW MEXICO, AS SHOWN ON THE PLAT OF SAID SUBDIVISION, FILED IN THE OFFICE OF THE COUNTY CLERK OF BERNALILLO COUNTY, NEW MEXICO, ON OCTOBER 3, 1978, IN PLAT BOOK B15, PAGE 108.

THE UNDERSIGNED OWNER(S) AND/OR PROPRIETOR(S) HEREBY CONSENT TO THE CITY OF ALBUQUERQUE, NEW MEXICO, AS SHOWN ON THE PLAT OF SAID SUBDIVISION, FILED IN THE OFFICE OF THE COUNTY CLERK OF BERNALILLO COUNTY, NEW MEXICO, ON OCTOBER 3, 1978, IN PLAT BOOK B15, PAGE 108.

THE UNDERSIGNED OWNER(S) AND/OR PROPRIETOR(S) HEREBY CONSENT TO THE CITY OF ALBUQUERQUE, NEW MEXICO, AS SHOWN ON THE PLAT OF SAID SUBDIVISION, FILED IN THE OFFICE OF THE COUNTY CLERK OF BERNALILLO COUNTY, NEW MEXICO, ON OCTOBER 3, 1978, IN PLAT BOOK B15, PAGE 108.

PHIL LINDBORG, DRAGONFLY DEVELOPMENT, INC.

Acknowledgment

STATE OF NEW MEXICO }
COUNTY OF BERNALILLO } SS

THIS INSTRUMENT WAS ACKNOWLEDGED BEFORE ME ON _____
BY PHIL LINDBORG, DRAGONFLY DEVELOPMENT, INC.

NOTARY PUBLIC

MY COMMISSION EXPIRES _____

Notes

- 1. FIELD SURVEY PERFORMED IN JUNE 2006.
- 2. ALL DISTANCES ARE GROUND DISTANCES: U.S. SURVEY FOOT.
- 3. BENCHMARK--ACS MONUMENT "21-K23" HAVING AN ELEVATION OF 5708.72 (NAVD 29).
- 4. THE BASIS OF BEARINGS IS N.M.P.S. (NAD 27--GRID) REFERENCING THE ACS MONUMENTS AS SHOWN HEREON.
- 5. THE SUBJECT PROPERTY IS LOCATED WITHIN PROJECTED SECTION 23 & 26, TOWNSHIP 10 NORTH, RANGE 4 EAST, N14M.
- 6. ALL STREET MONUMENTATION SHALL BE INSTALLED AT ALL CENTERLINE P.C.'S, P.T.'S, ANGLE POINTS AND STREET INTERSECTIONS AND SHOWN AS THUS: ALL CENTERLINE MONUMENTS WILL BE SET USING THE STANDARD "A" ALUMINUM MONUMENT STAMPED "CITY OF ALBUQUERQUE CENTERLINE MONUMENT--DO NOT DISTURB, PS 14271" AND WILL BE SET FLUSH WITH THE FINAL ASPHALT.
- 7. LOT LINES ELIMINATED BY THIS PLAT SHOWN AS THUS:
- 8. A TEMPORARY EASEMENT EXISTS ACROSS THE SUBJECT PROPERTY BENEFITING THE CITY OF ALBUQUERQUE, TERMINATING UPON APPROVAL OF A SITE DEVELOPMENT PLAN PER DOCUMENT FILED AUGUST 22, 1988, IN BOOK MISC. 8884, THEREBY THE DOCUMENT CREATING THE SUBJECT EASEMENT IS ILLEGIBLE. THEREFORE, THE CITY OF ALBUQUERQUE, NEW MEXICO, AS SHOWN ON THE PLAT OF SAID SUBDIVISION, FILED IN THE OFFICE OF THE COUNTY CLERK OF BERNALILLO COUNTY, NEW MEXICO, ON OCTOBER 3, 1978, IN PLAT BOOK B15, PAGE 108, IS HEREBY VACATED BY THE FILING OF THIS PLAT.
- 9. THE SOUTHERLY 125 FEET OF LOT 1, BLOCK K WAS CONVEYED VIA WARRANTY DEED FILED MAY 25, 1957 IN BOOK 4790, PAGE 377.

Legal

LOTS 1-A, 1-B, AND 1-C, OF PLAT OF DIVISION LOT 1 IN BLOCK J OF CENARCOCA, A SUBDIVISION TO THE CITY OF ALBUQUERQUE, NEW MEXICO, AS SHOWN ON THE PLAT OF SAID SUBDIVISION, FILED IN THE OFFICE OF THE COUNTY CLERK OF BERNALILLO COUNTY, NEW MEXICO, ON OCTOBER 3, 1978, IN PLAT BOOK B15, PAGE 108, AND LOT NUMBERED ONE (1), EXCEPT THE SOUTHERLY ONE HUNDRED TWENTY-FIVE FEET (S.L.Y. 125'), THEREOF, IN BLOCK LETTERED "K", OF CENARCOCA, A SUBDIVISION, ALBUQUERQUE, NEW MEXICO, AS THE SAME IS SHOWN AND DESIGNATED ON THE COUNTY CLERK OF BERNALILLO COUNTY, NEW MEXICO, ON DECEMBER 22, 1954, IN PLAT BOOK D1, FOLIO 151.

A PORTION OF HUERFANO ROAD N.E. AS DESCRIBED BY METES AND BOUNDS AS FOLLOWS:

BEGINNING AT THE NORTHEAST CORNER OF THE HEREIN DESCRIBED PARCEL, WHENCE A TIE TO ACS MONUMENT "2-123" BEARS N 06°59'03" W, A DISTANCE OF 4239.28 FEET; THENCE, S 00°16'39" E, A DISTANCE OF 353.01 FEET;

THENCE, S 27°41'45" E, A DISTANCE OF 198.95 FEET;

THENCE, S 00°03'19" W, A DISTANCE OF 402.08 FEET TO THE SOUTHEAST CORNER;

THENCE, S 88°58'49" W, A DISTANCE OF 125.00 FEET TO THE SOUTHWEST CORNER;

THENCE, S 00°03'19" W, A DISTANCE OF 77.55 FEET;

THENCE, 285.18 FEET ALONG AN ARC TO THE LEFT, HAVING A RADIUS OF 1145.00 FEET, A DELTA OF 13°16'10" AND A CHORD OF N 6°41'24" W, A DISTANCE OF 264.58 FEET;

THENCE, 146.92 FEET ALONG AN ARC TO THE LEFT, HAVING A RADIUS OF 1046.05 FEET, A DELTA OF 8°02'50" AND A CHORD OF N 16°49'41" W, A DISTANCE OF 146.80 FEET;

THENCE, 128.59 FEET ALONG AN ARC TO THE LEFT, HAVING A RADIUS OF 1145.00 FEET, A DELTA OF 6°20'05" AND A CHORD OF N 23°40'05" W, A DISTANCE OF 128.53 FEET;

THENCE, 423.61 FEET ALONG AN ARC TO THE RIGHT, HAVING A RADIUS OF 234.99 FEET, A DELTA OF 103°17'04" AND A CHORD OF N 2°44'28" E, A DISTANCE OF 368.54 FEET TO THE POINT OF BEGINNING, CONTAINING 3.0926 ACRES (134,712 SQ. FT.) MORE OR LESS.

Subdivision Data

GROSS ACREAGE 3.0926 ACRES

ZONE ATLAS PAGE NO. K-23 AND L-23

NUMBER OF EXISTING LOTS 4

NUMBER OF LOTS CREATED 28

NUMBER OF LOTS ELIMINATED 4

MILES OF FULL WIDTH STREETS 0.00

MILES OF HALF WIDTH STREETS 0.17

STREET AREA DEDICATED TO THE CITY OF ALBUQUERQUE 0.5129


DATE OF SURVEY SEPTEMBER 2005

UTILITY CONTROL LOCATION SYSTEM LOG NUMBER 2006261368


ZONING SU-1 R-T USES

Legend

● FOUND AS INDICATED

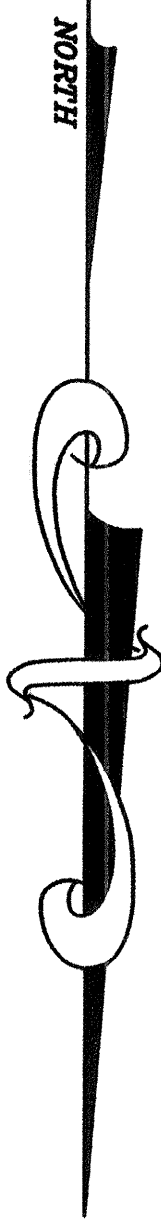

H1200

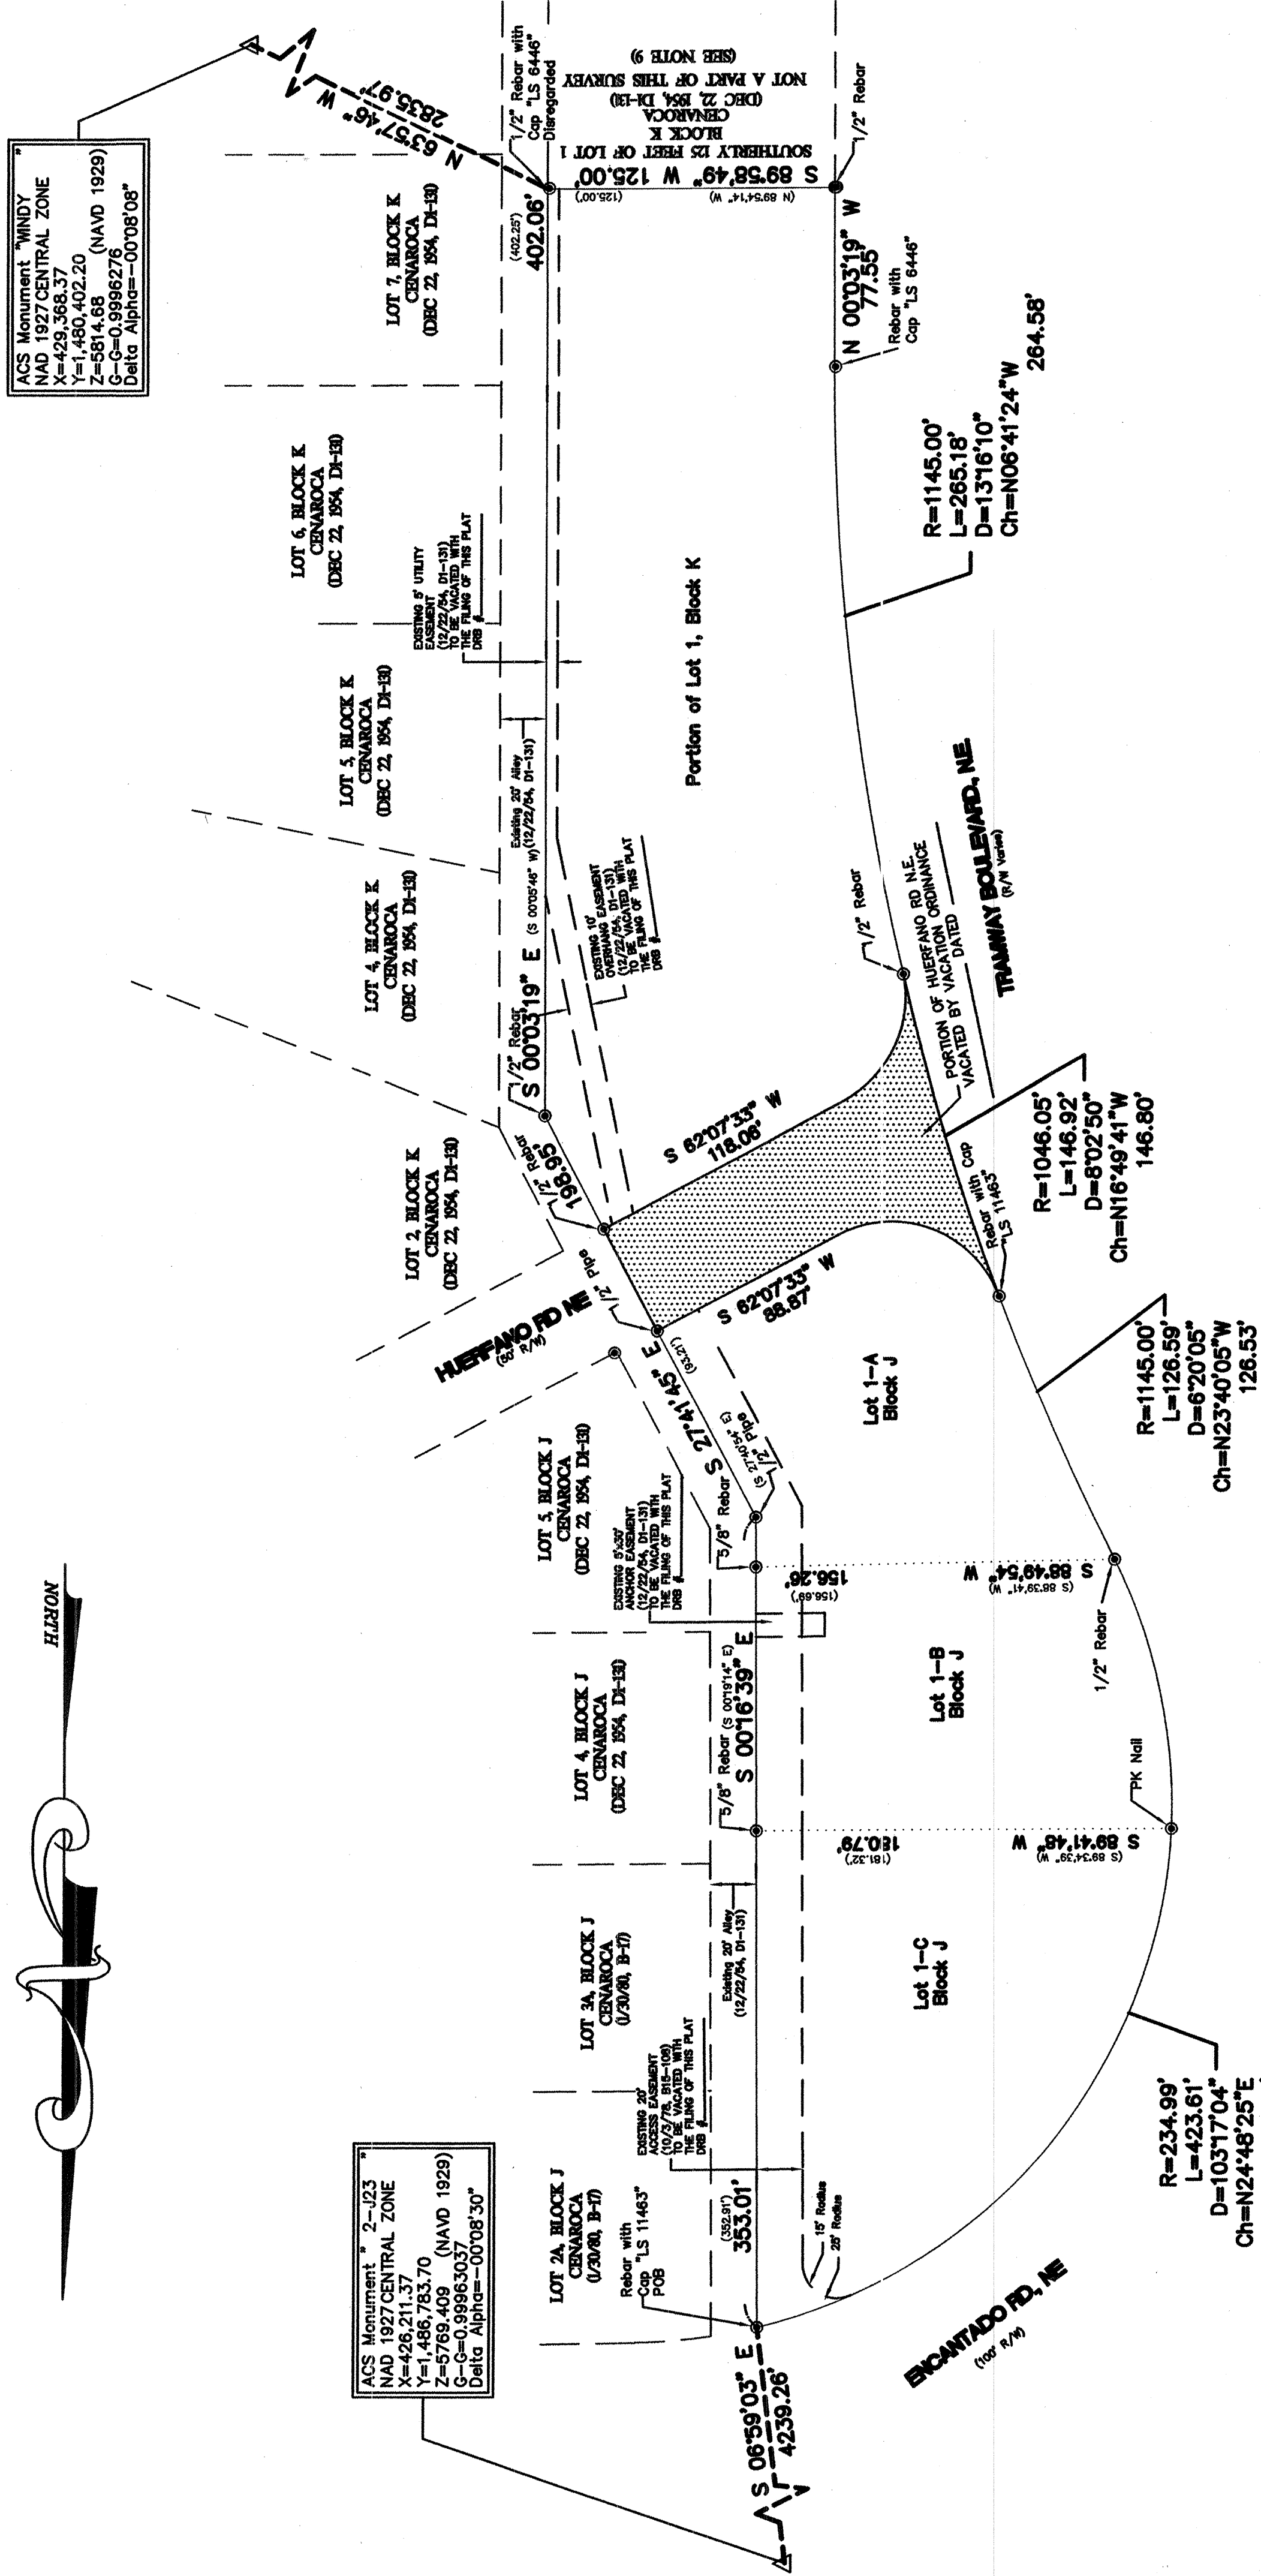

GRAPHIC SCALE

(IN FEET)
1 inch = 60 ft.

Plat of
THE BLUFFS AT ENCANTADO

(Lots 1A, 1B, and 1C, Block J, CENARCOCA, and Lot 1, Block K, CENARCOCA Except the South 125' and a vacated portion of Huernando Road NE)

with
Section 23 and 26, Township 10 North, Range 4 East, N14M
City of Albuquerque, Bernalillo County, New Mexico
September 2006

Approved and Accepted by:

APPROVAL AND CONDITIONAL ACCEPTANCE AS SPECIFIED BY THE ALBUQUERQUE SUBDIVISION ORDINANCE, CHAPTER 14, ARTICLE 14 OF THE REVISED ORDINANCES OF ALBUQUERQUE, NEW MEXICO, 1994.

Project Number _____

Application Number _____

Plat approvals: _____

PINN Electric Services	Date
PINN Gas Services	Date
QWest	Date
Comcast	Date
City approvals:	
City Surveyor	Date
Traffic Engineer	Date
Water Utilities Development	Date
Parks and Recreation Department	Date
AMAFCA	Date
City Engineer	Date
DRB Chairperson, Planning Department	Date
	Date

Surveyor's Certificate

"I, WILL PLOTNER JR., A DULY QUALIFIED REGISTERED PROFESSIONAL LAND SURVEYOR UNDER THE LAWS OF THE STATE OF NEW MEXICO, DO HEREBY CERTIFY THAT THIS PLAT AND DESCRIPTION WERE PREPARED BY ME OR UNDER MY SUPERVISION, SHOWS ALL EASEMENTS AS LISTED IN THE TITLE COMMITMENTS PREPARED BY RIO GRANDE TITLE DATED SEPTEMBER 7, 2005 (FILE NUMBER 02506861) AND SEPTEMBER 2, 2005 (FILE NUMBER 2005-00000000) AND THE MINIMUM REQUIREMENTS FOR MONUMENTATION AND SURVEYING OF WELLS. I HAVE REVIEWED THE PLAT AND THE FURTHER MEETS THE MINIMUM STANDARDS FOR LAND SURVEYING IN THE STATE OF NEW MEXICO AND IS TRUE AND CORRECT TO THE BEST OF MY KNOWLEDGE AND BELIEF."

WILL PLOTNER JR.,
N.M.P.S. No. 14271

CARTESIAN SURVEYS INC.

P.O. BOX 44414, RIO RANCHO, N.M. 87174
Phone (505) 898-3050 Fax (505) 891-0244

Sheet 1 of 5
052272

Plat of
THE BLUFFS AT ENCANTADO

(Lots 1A, 1B, and 1C, Block J, CENARCOCA, and Lot 1, Block K, CENARCOCA Except the South 125' and a vacated portion of Huernando Road NE)

with
Section 23 and 26, Township 10 North, Range 4 East, N14M
City of Albuquerque, Bernalillo County, New Mexico
September 2006

GRAPHIC SCALE

(IN FEET)
1 inch = 60 ft.

CARTESIAN SURVEYS INC.

P.O. BOX 44414, RIO RANCHO, N.M. 87174
Phone (505) 898-3050 Fax (505) 891-0244

Sheet 2 of 5
052272


Easement Notes

220 FOOT PUBLIC DRAINAGE EASEMENT GRANTED WITH THE FILING OF THIS PLAT.
THE AREA TO BE MAINTAINED BY THE OWNER OF LOT 15-P1.

Plat of THE BLUFFS AT ENCANTADO

(Lots 1A, 1B, and 1C, Block J Cenaroca and Lot 1, Block K, Cenaroca Except the South 125' and a vacated portion of Hefano Road NE)

Section 23 and 26, Township 10 North, Range 4 East, NMPM
City of Albuquerque, Bernalillo County, New Mexico
September 2006

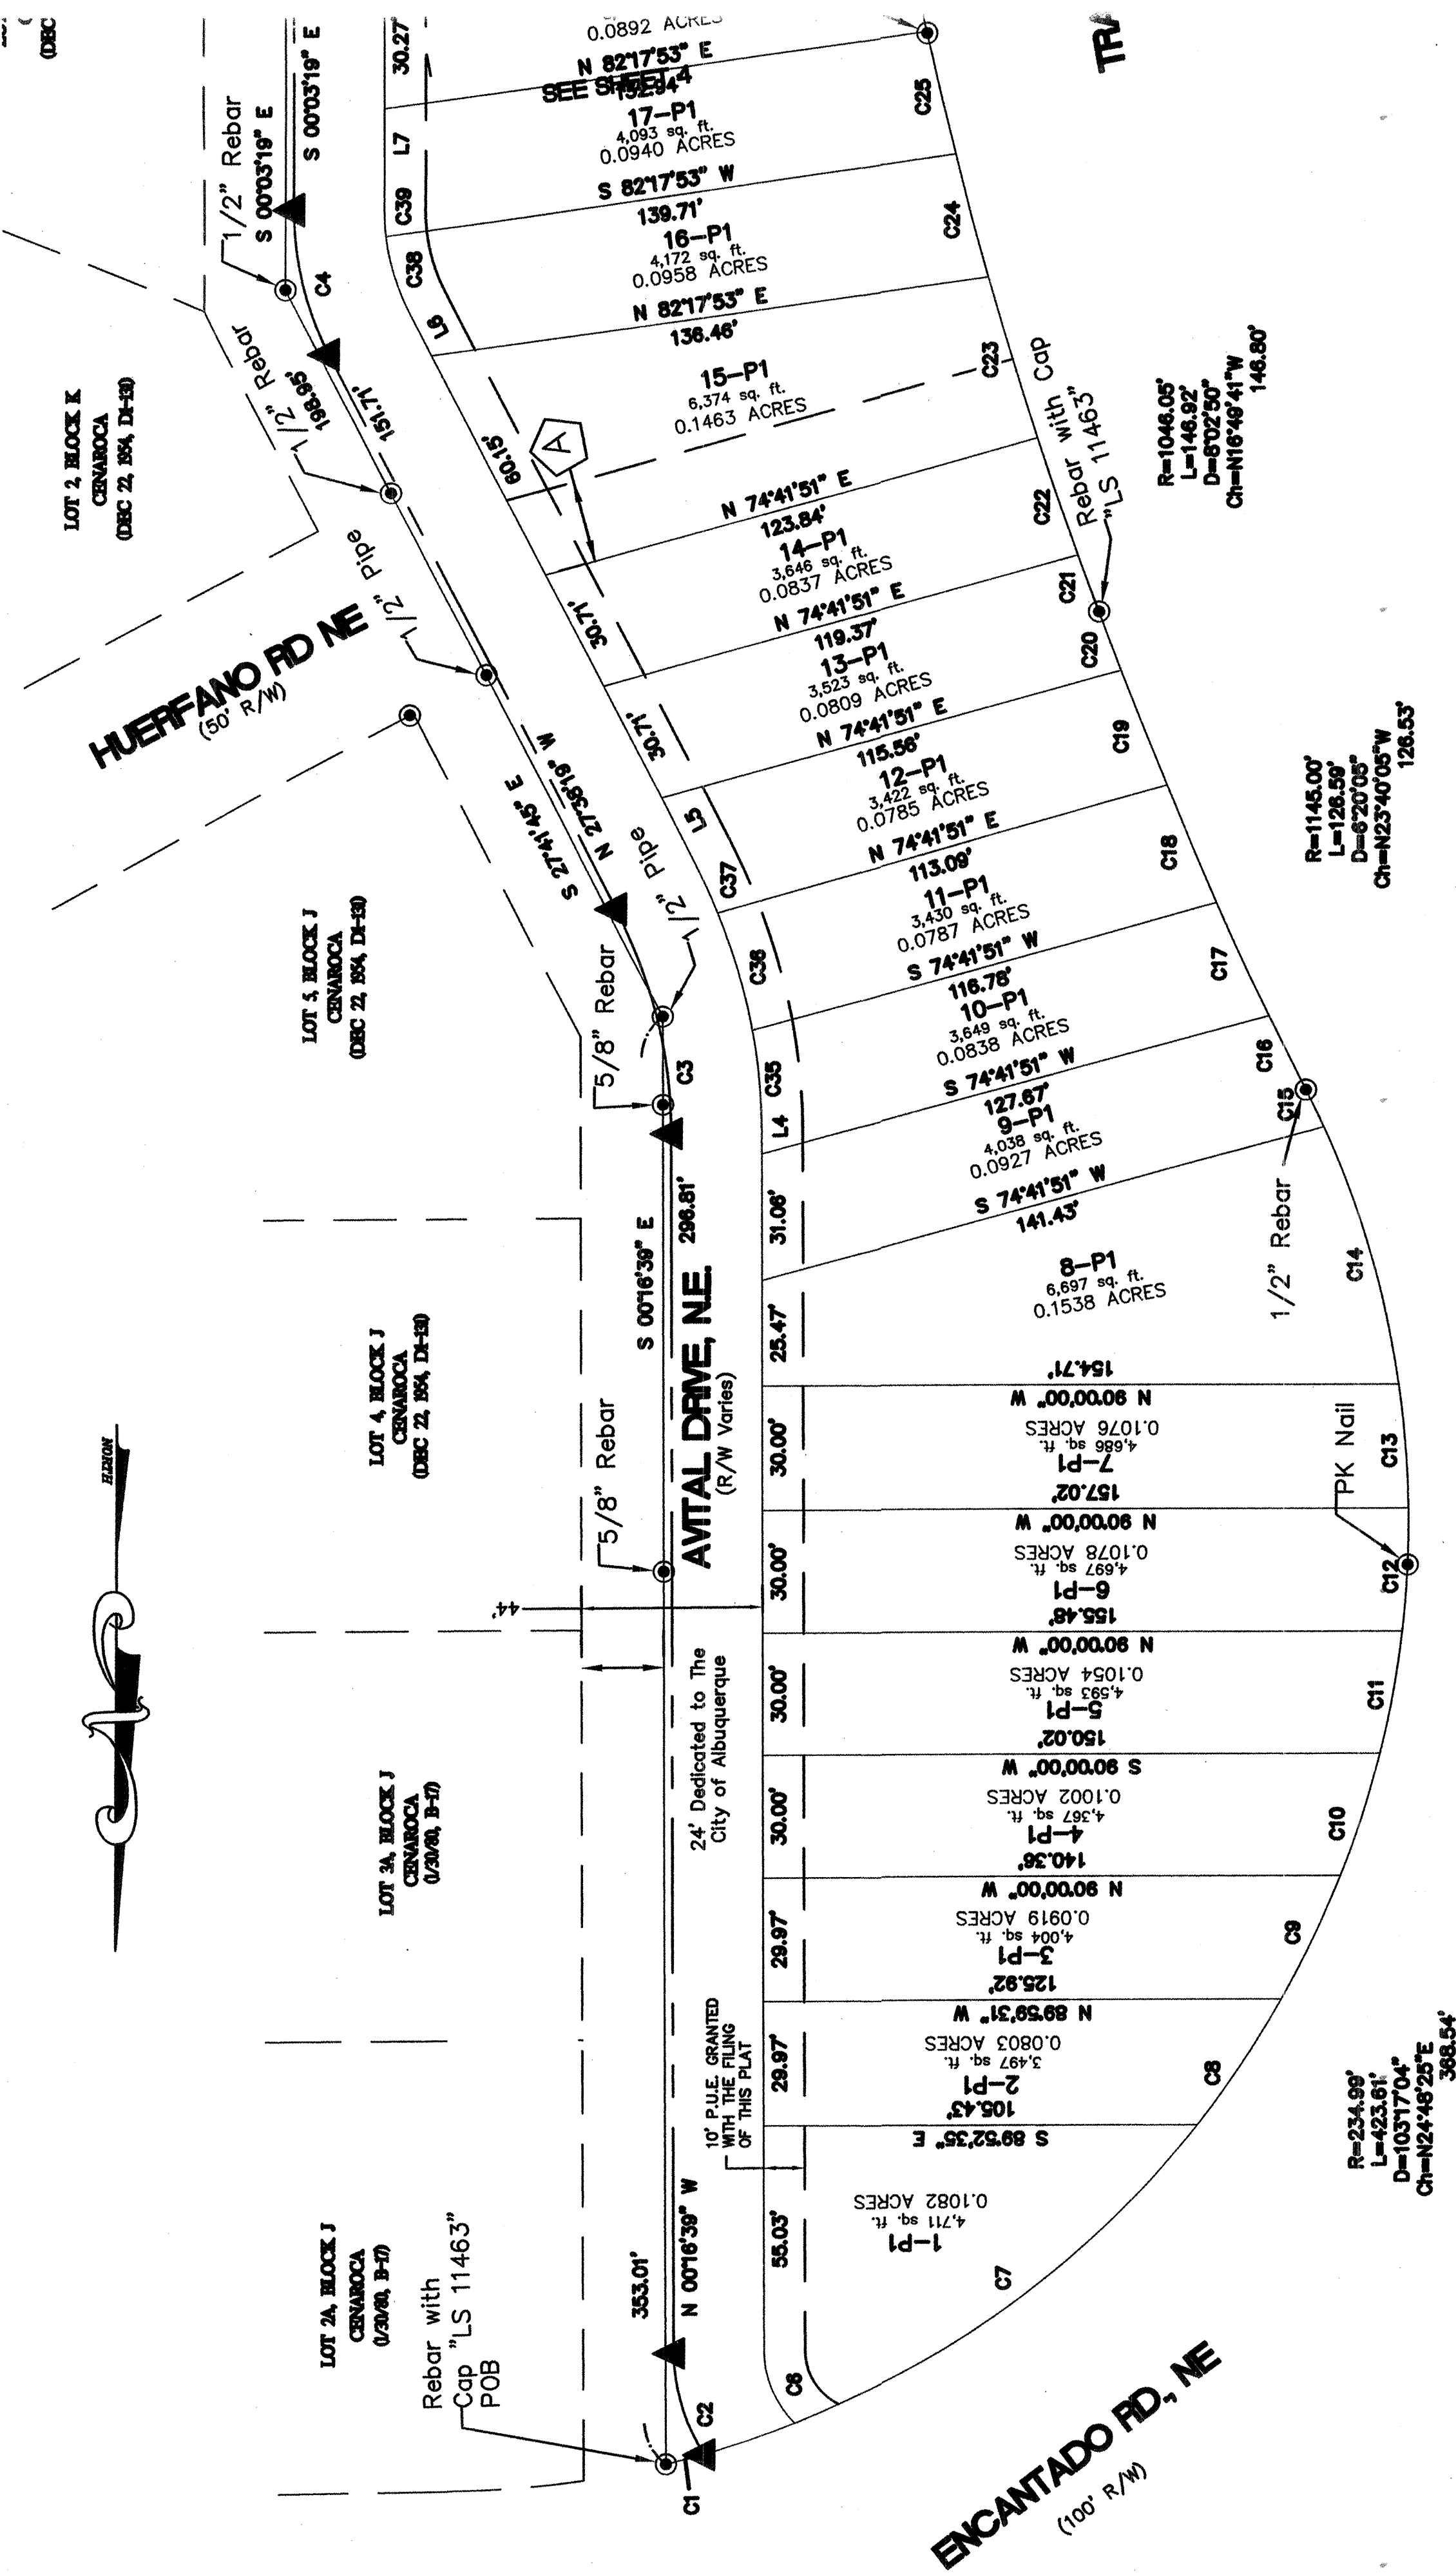

TRAMWAY BOULEVARD, NE
(R/W Varies)

GNATHIC SCALE

(IN FEET)

1 inch = 30 ft.

30 60


CARTESIAN SURVEYS INC.

Sheet 3 of 5
052272


THE BLUFFS AT ENCANTADO

(Lots 1A, 1B, and 1C, Block J Cenaroca and Lot 1, Block K, Cenaroca Except the South 125' and a vacated portion of Herfano Road NE)

Section 23 and 26, Township 10 North, Range 4 East, N4PM
City of Albuquerque, Bernalillo County, New Mexico
September 2008

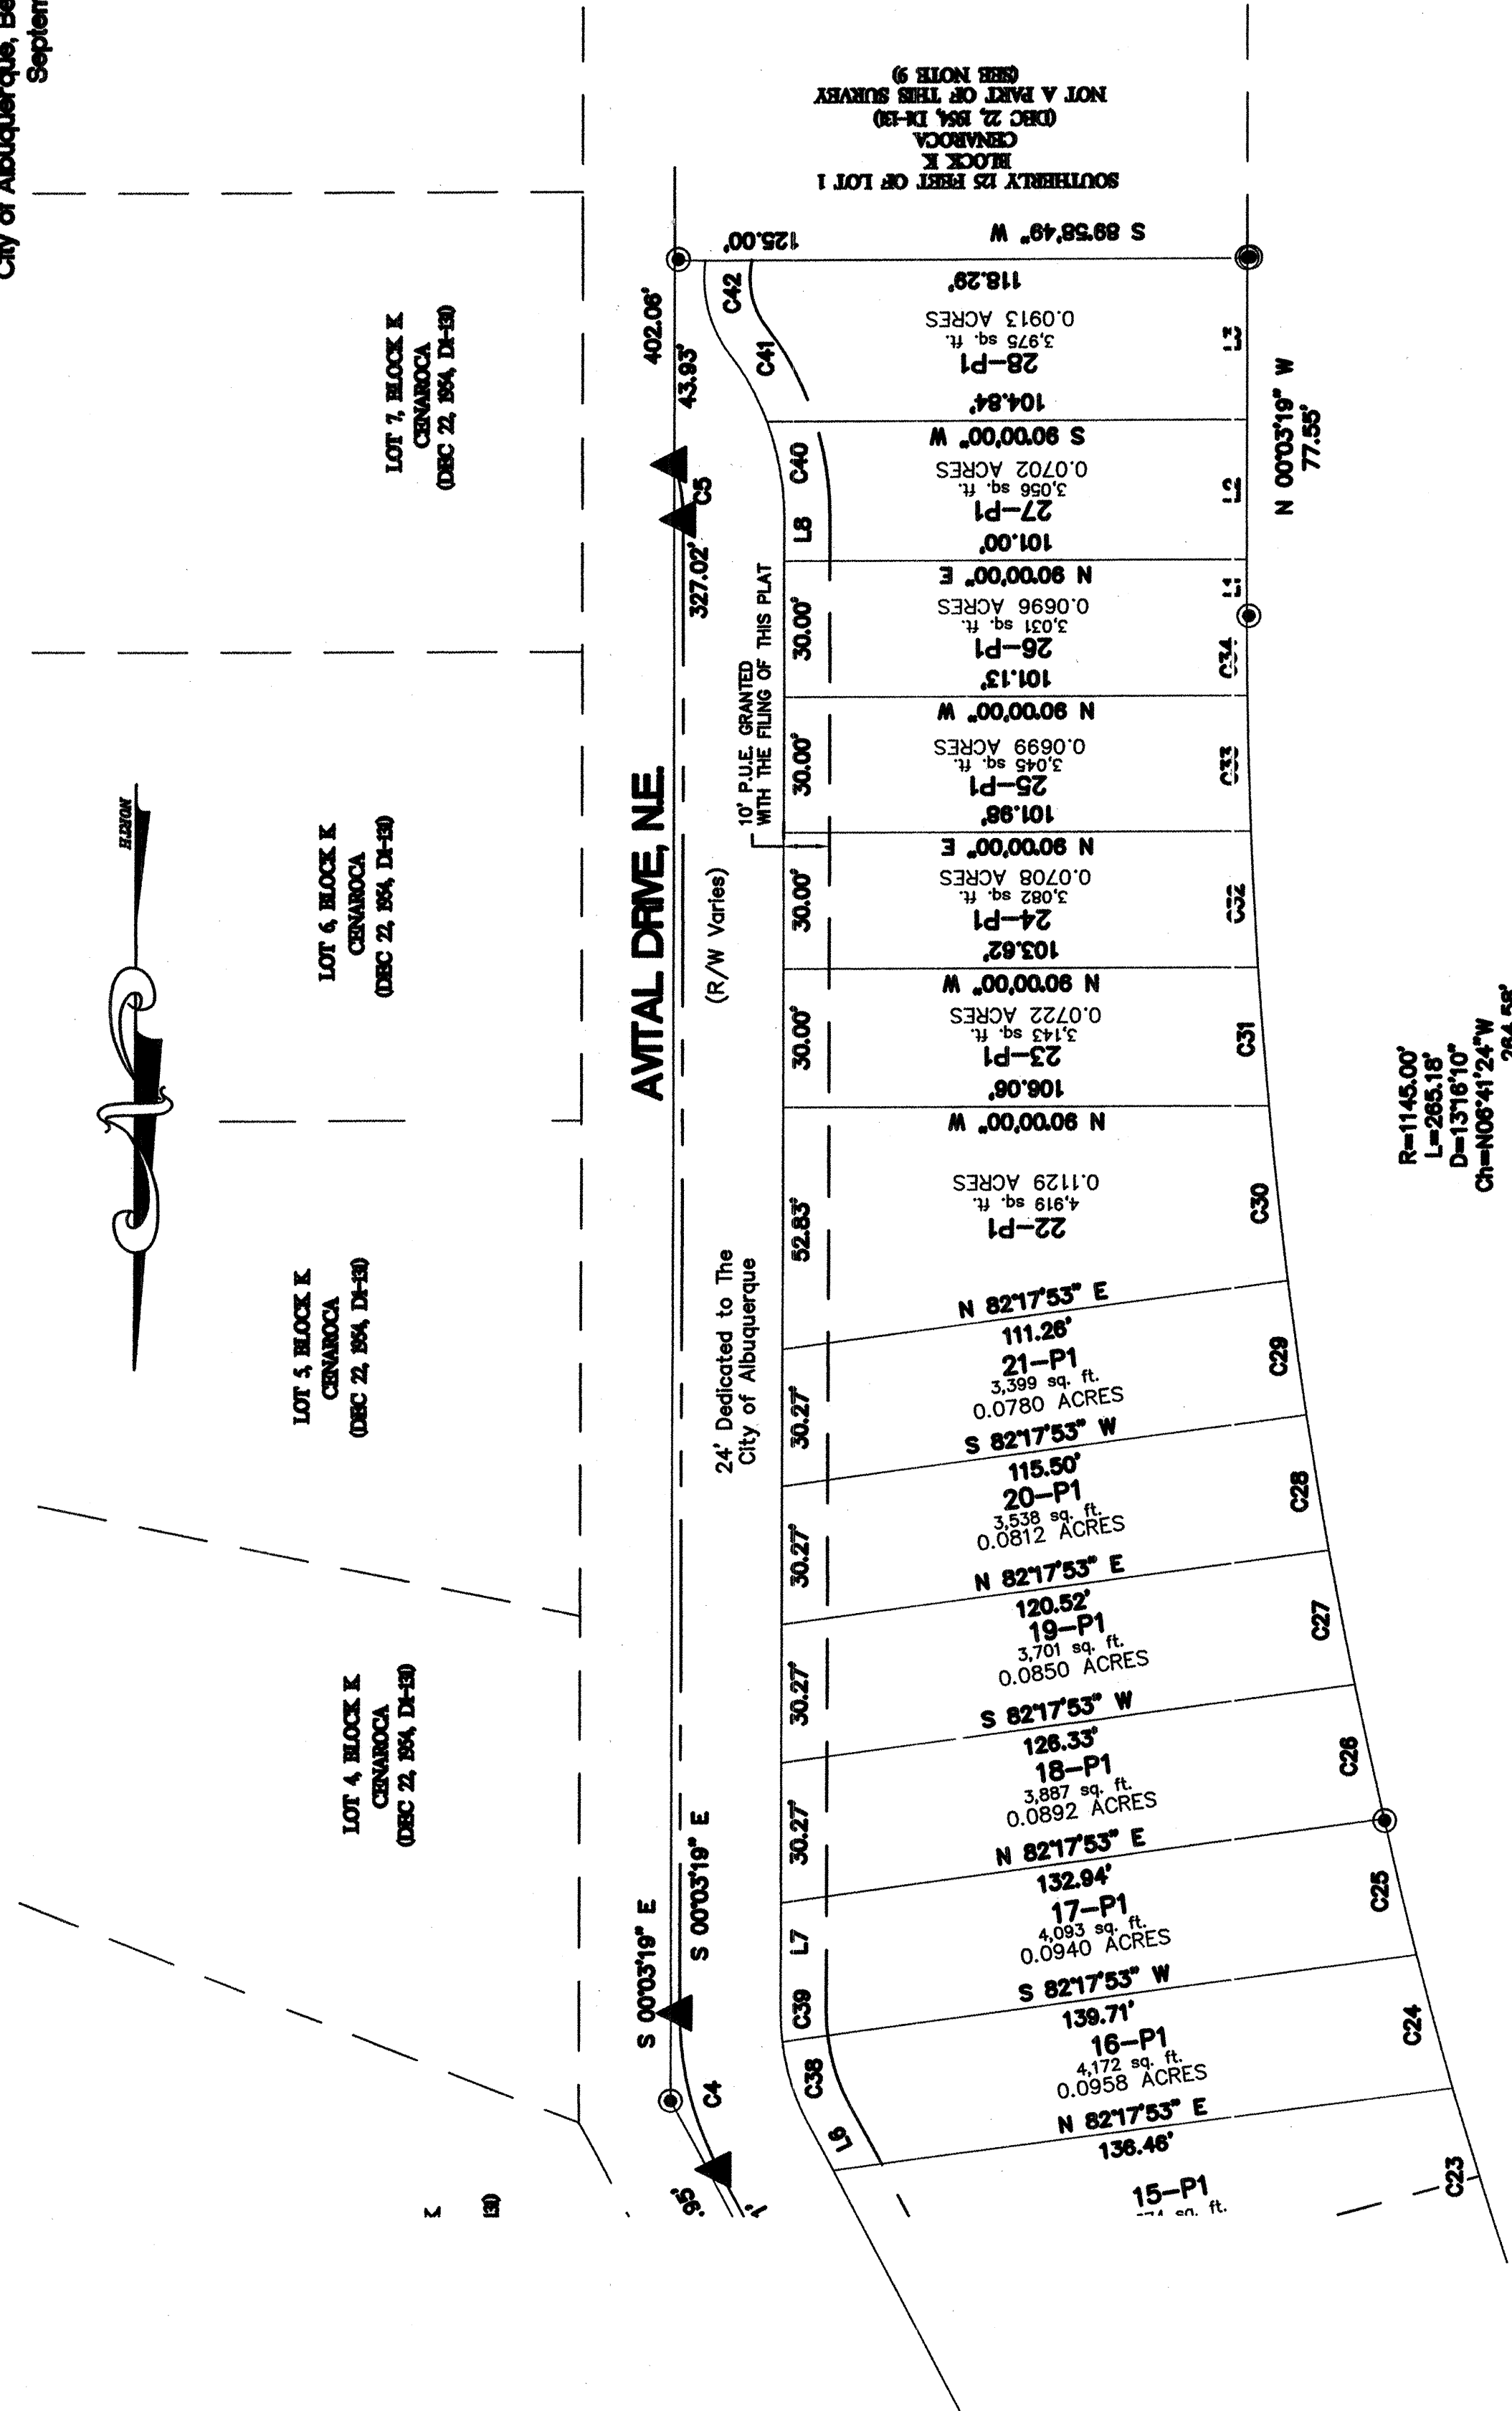

GRAPHIC SCALE

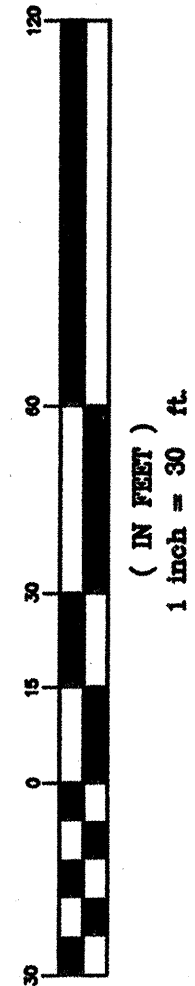

SHEET 3 of 16

CARTESIAN SURVEYS INC.


P.O. BOX 44414 RIO RANCHO, N.M. 87174
Phone (505) 898-3050 Fax (505) 891-0244

Plat of
THE BLUFFS AT ENCANTADO

(Lots 1A, 1B, and 1C, Block J Cenaroca and
Lot 1, Block K, Cenaroca Except the South 125'
and a veeded portion of Herfano Road NE)
with
Section 23 and 26, Township 10 North, Range 4 East, NMPM
City of Albuquerque, Bernalillo County, New Mexico
September 2006

LINE TABLE		
LINE	LENGTH	BEARING
L1	12.52	N 00°03'19" W
L2	30.00	N 00°03'19" W
L3	35.03	N 00°03'19" W
L4	5.31	S 00°16'39" E
L5	18.14	S 27°38'19" E
L6	12.00	S 27°38'19" E
L7	23.81	S 00°03'19" E
L8	9.30	S 00°03'19" E

CURVE TABLE			
CURVE	RADIUS	LENGTH	DELTA
C1	234.99'	9.56'	219°53'
C2	47.00'	28.47'	327°16'12"
C3	120.00'	57.31'	272°14'1"
C4	75.00'	36.11'	273°50'0"
C5	35.71'	12.01'	191°16'04"
C6	25.00'	19.70'	43°08'17"
C7	234.99'	123.06'	30°00'17"
C8	234.99'	36.43'	8°53'00"
C9	234.99'	33.24'	8°06'21"
C10	234.99'	31.50'	7°40'47"
C11	234.99'	30.49'	7°26'01"
C12	234.99'	30.05'	7°19'39"
C13	234.99'	30.12'	7°20'39"
C14	234.99'	65.66'	16°00'31"
C15	234.99'	10.18'	2°28'55"
C16	1145.00'	20.36'	1°01'08"
C17	1145.00'	30.44'	1°31'24"
C18	1145.00'	30.31'	1°31'01"
C19	1145.00'	30.21'	1°30'42"
C20	455.33'	15.32'	1°55'40"
C21	1027.78'	14.81'	0°49'32"
C22	1027.78'	30.07'	1°40'35"
C24	1027.78'	30.27'	1°41'15"
C25	1055.49'	30.16'	1°38'15"
C26	1145.00'	30.11'	1°30'24"
C27	1145.00'	30.05'	1°30'14"
C28	1145.00'	30.02'	1°30'07"
C29	1145.00'	30.00'	1°30'05"
C30	1145.00'	38.16'	1°54'34"
C31	1145.00'	30.10'	1°30'23"
C32	1145.00'	30.05'	1°30'13"
C33	1145.00'	30.01'	1°30'07"
C34	1145.00'	17.48'	0°52'29"
C35	142.00'	25.28'	10°11'59"
C36	142.00'	30.06'	12°07'49"
C37	142.00'	12.47'	5°01'52"
C38	53.00'	19.09'	20°38'20"
C39	53.00'	6.42'	6°56'41"
C40	57.71'	21.17'	21°01'13"
C41	57.71'	16.62'	16°30'06"
C42	27.27'	21.82'	45°51'20"

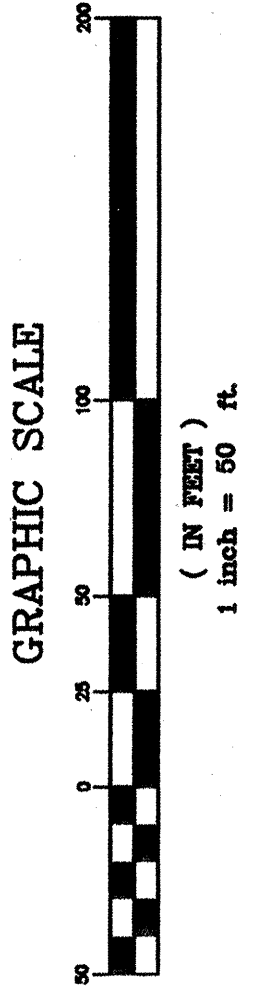

Legal

LOTS 1-A, 1-B, AND 1-C, OF PLAT OF DIVISION LOT 1 IN BLOCK J OF CENAROCA, A SUBDIVISION TO THE CITY OF ALBUQUERQUE, NEW MEXICO, AS SHOWN ON THE PLAT OF SAID SUBDIVISION, FILED IN THE OFFICE OF THE COUNTY CLERK OF BERNALILLO COUNTY, NEW MEXICO, ON OCTOBER 3, 1978, IN PLAT BOOK B15, PAGE 108.
AND
LOT NUMBERED ONE (1), EXCEPT THE SOUTHERLY ONE HUNDRED TWENTY-FIVE FEET (S.L.Y. 125'), THEREOF, IN BLOCK LETTERED "K", OF CENAROCA, A SUBDIVISION, ALBUQUERQUE, NEW MEXICO, AS THE SAME IS SHOWN AND DESIGNATED ON THE COUNTY CLERK OF BERNALILLO COUNTY, NEW MEXICO, ON DECEMBER 22, 1954, IN PLAT BOOK D1, FOLIO 131.
AND
A PORTION OF HUERFANO ROAD N.E. AS SHOWN HEREON.

Preliminary Plat THE BLUFFS AT ENCANTADO

(Lots 1A, 1B, and 1C, Block J Cenaroca and
Lot 1, Block K, Cenaroca Except the South 125')

within
Section 23 and 26, Township 10 North, Range 4 East, NMPM
City of Albuquerque, Bernalillo County, New Mexico
May 2006

Vicinity Map K and L-23-Z

Disclosure Statement

THE PURPOSE OF THIS PLAT IS TO:

- 1.) CREATE 28 NEW LOTS.
- 2.) GRANT NEW UTILITY EASEMENTS.
- 3.) DEDICATE RIGHT OF WAY.

Benchmark

ACS MONUMENT "21-K23" HAVING AN ELEVATION OF 5708.72 (NAVD 27).

Notes

1. BEARINGS ARE NEW MEXICO STATE PLANE GRID BEARINGS (CENTRAL ZONE-NAID 1927), REFERENCING STATIONS "2-J23" AND "WINDY".
2. DISTANCES SHOWN HEREON ARE GROUND.
3. ALL STREET MONUMENTATION SHALL BE INSTALLED AT ALL CENTERLINE PC'S, PT'S, ANGLE POINTS AND STREET INTERSECTIONS AND SHOWN AS THIS. ALL CENTERLINE MONUMENTS WILL BE SET USING THE STANDARD 4" ALUMINUM MONUMENT STAMPED "CITY OF ALBUQUERQUE CENTERLINE MONUMENT- DO NOT DISTURB, PS 14271" AND WILL BE SET FLUSH WITH THE FINAL ASPHALT.
4. MANHOLES WILL BE OFFSET AT ALL POINTS OF CURVATURE, POINTS OF TANGENCY, STREET INTERSECTIONS AND ALL OTHER ANGLE POINTS TO ALLOW CENTERLINE MONUMENTATION.
5. TOTAL NUMBER OF EXISTING LOTS: 4
6. TOTAL NUMBER OF LOTS CREATED: 28
7. TOTAL NUMBER OF TRACTS CREATED: 0
8. TOTAL MILEAGE OF FULL WIDTH STREETS CREATED: 0.17
9. CITY OF ALBUQUERQUE ZONE ATLAS PAGE: L-23 & K-23
10. NO LOT LINES BEING ELIMINATED 4
11. TOTAL AREA 2.8935
12. PROPERTY CORNERS TO BE SET ARE AN 18" BATHEY MONUMENT WITH STEEL CAP "LS 14271".
13. THE ZONING FOR THE LOT IS CURRENTLY: SU-1 R-T USES
14. ALL SET EXTERIOR PROPERTY CORNERS ARE A BATHEY MARKER WITH CAP "LS 14271" UNLESS INDICATED OTHERWISE.
15. LOT LINES ELIMINATED BY THIS PLAT SHOWN AS THIS
16. THE SOUTHERLY 125 FEET OF LOT 1, BLOCK K WAS CONVEYED VIA WARRANTY DEED FILED MAY 25, 1957 IN BOOK 4790, PAGE 377.

PHIL LINDBORG, DRAGONFLY DEVELOPMENT, INC. DATE

CITY SURVEYOR, CITY OF ALBUQUERQUE DATE
GLEN HAKIN P.S.

CARTESIAN SURVEYS INC.

P.O. BOX 44414 RIO RANCHO, N.M. 87174
Phone (505) 896-3050 Fax (505) 891-0244

ACS Monument "2-J23"
NAD 1927 CENTRAL ZONE
X=426,211.37
Y=1,486,783.70
Z=5769.409 (NAVD 1929)
G-G=0.99963037
Delta Alpha=-00°08'30"

ACS Monument "WINDY"
NAD 1927 CENTRAL ZONE
X=429,368.37
Y=1,480,402.20
Z=5814.68 (NAVD 1929)
G-G=0.9996276
Delta Alpha=-00°08'08"


CURVE TABLE					
CURVE	RADIUS	LENGTH	DELTA	CHORD DIR.	CHORD
C1	234.99' (235.00')	303.89' (304.01')	74°05'11"	S 39°24'22" W	283.12'
C2	234.99' (235.00')	119.15' (120.01')	28°11'54"	S 12°14'10" E	118.46'
C3	1145.00' (1145.00')	126.59' (126.23')	6°20'05"	N 23°40'05" W	126.53'
C4	50.00' (50.00')	84.97' (84.73')	97°22'25"	S 69°11'15" E	75.11'
C5	50.00' (50.00')	65.84' (65.86')	75°27'01"	S 24°24'02" W	61.19'
C6	1145.00' (1145.00')	265.18' (265.31')	13°16'10"	N 06°41'24" W	264.58'
C12	1046.05'	146.92'	8°02'50"	N 18°49'41" W	146.80'


LINE TABLE		
LINE	LENGTH	BEARING
L1	21.66 (21.65)	S 00°16'39" E (S 00°19'14" E)
L2	55.55 (55.64)	S 27°45'41" E (S 27°40'54" E)

CENTERLINE CURVE TABLE					
CURVE	RADIUS	LENGTH	DELTA	CHORD DIR.	CHORD
CLC1	47.00'	26.47'	32°16'12"	N 18°24'45" W	26.12'
CLC2	120.00'	67.31'	27°21'41"	S 13°57'29" E	56.76'
CLC3	75.00'	36.11'	27°35'00"	N 13°50'49" W	35.76'
CLC4	35.71'	12.01'	19°16'04"	S 09°41'21" E	11.95'

CENTERLINE LINE TABLE		
LINE	LENGTH	BEARING
CL1	298.81	N 00°16'39" W
CL2	151.71	N 27°38'19" W
CL3	327.02	S 00°03'19" E

GRAPHIC SCALE



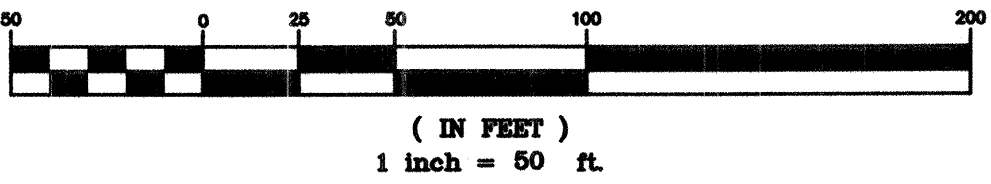


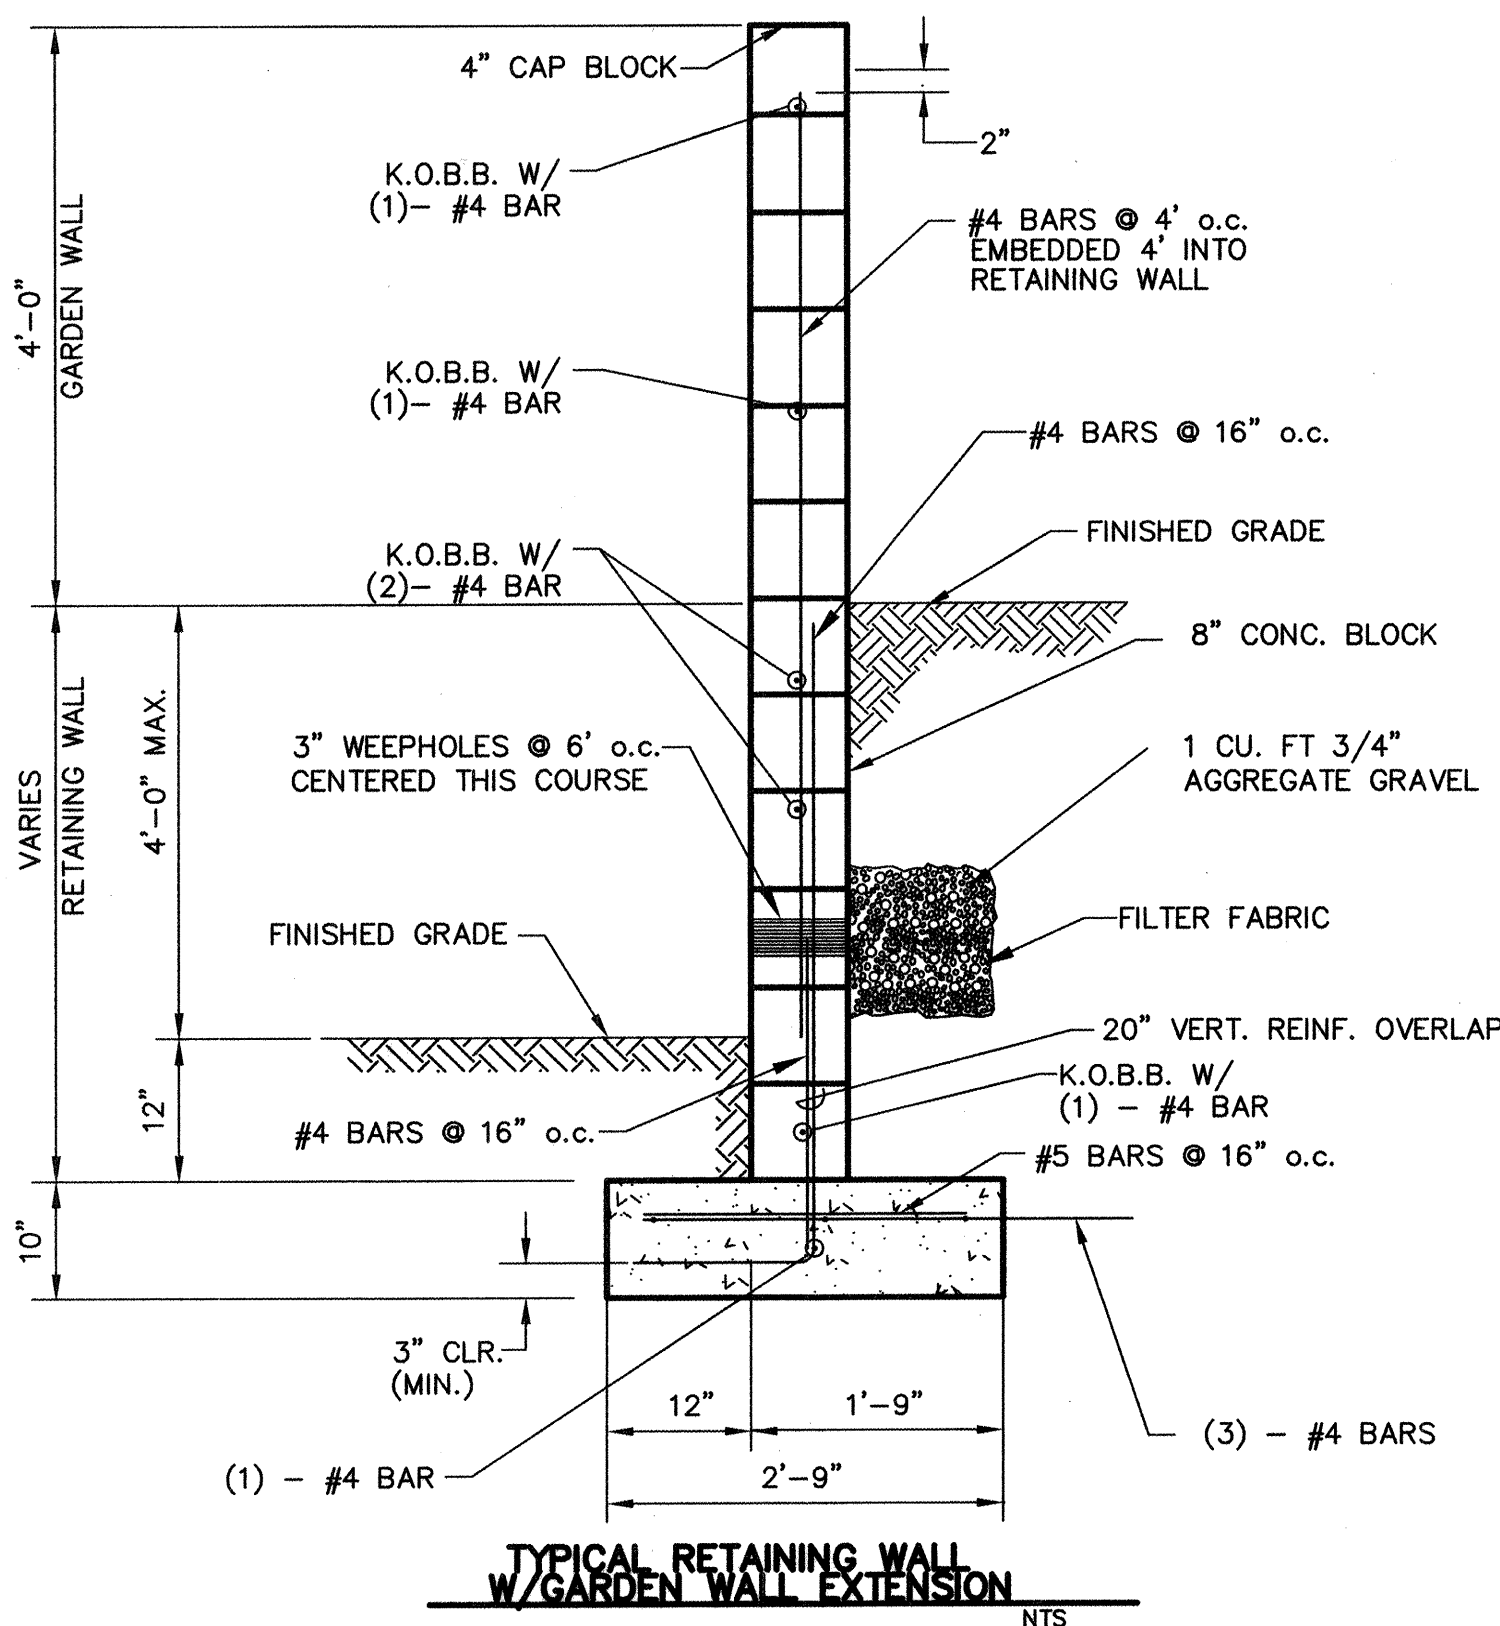

LEGAL DESCRIPTION
 LOTS 1A, 1B, & 1C, BLOCK J
 AND A PORTION OF LOT 1, BLOCK K
 CENAROCA SUBDIVISION


APPROVED FOR ROUGH GRADING

SIGNATURE _____ DATE _____

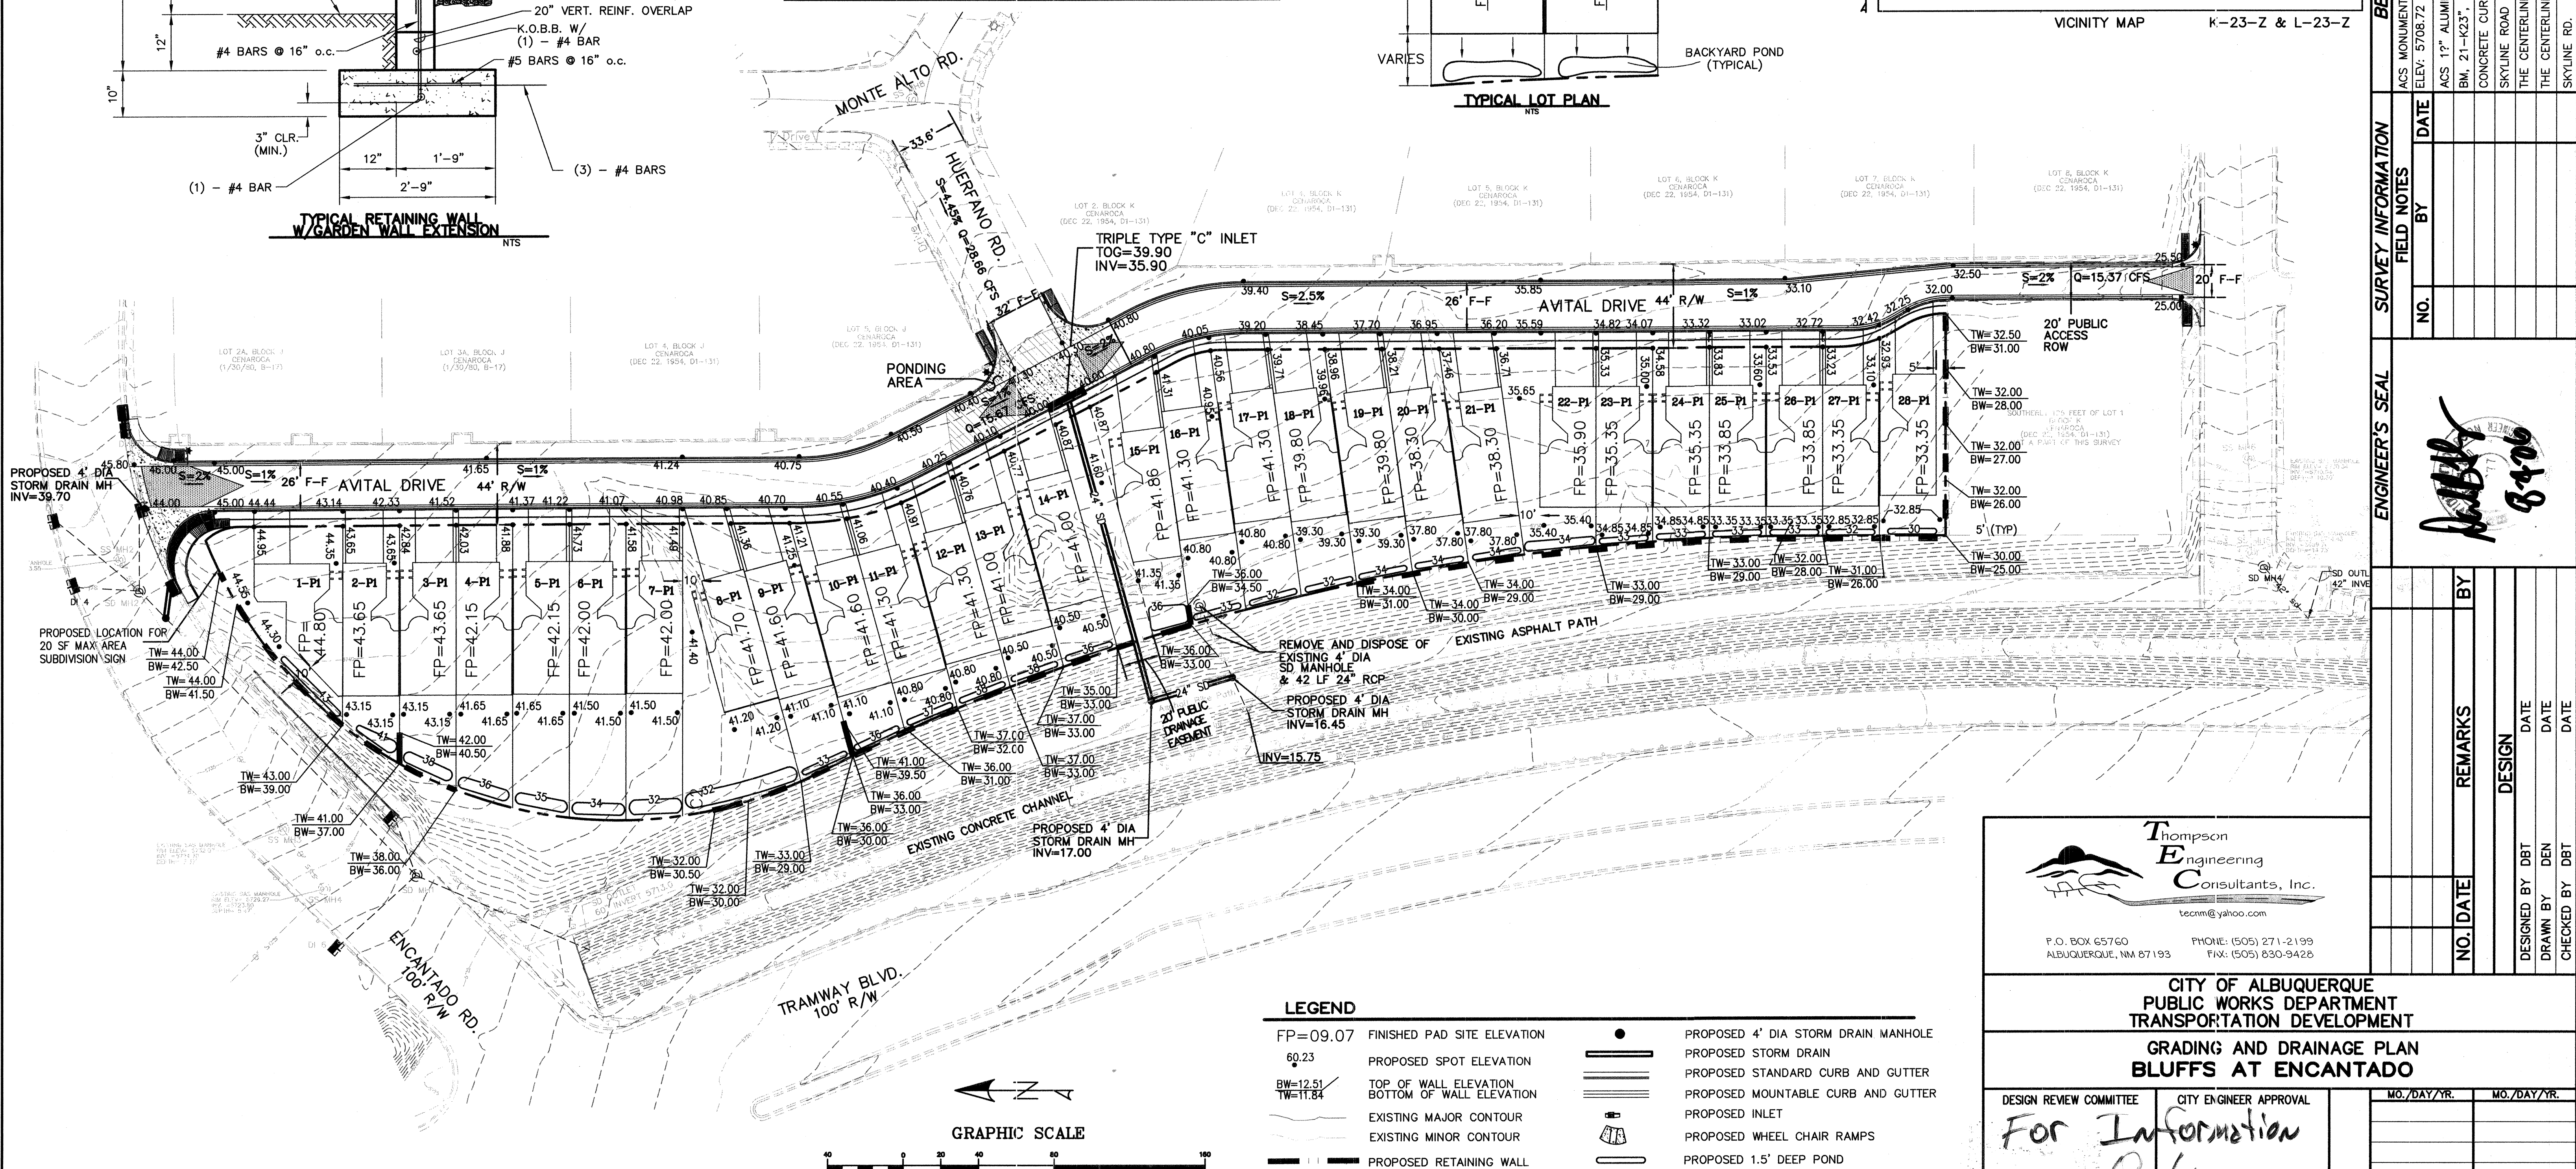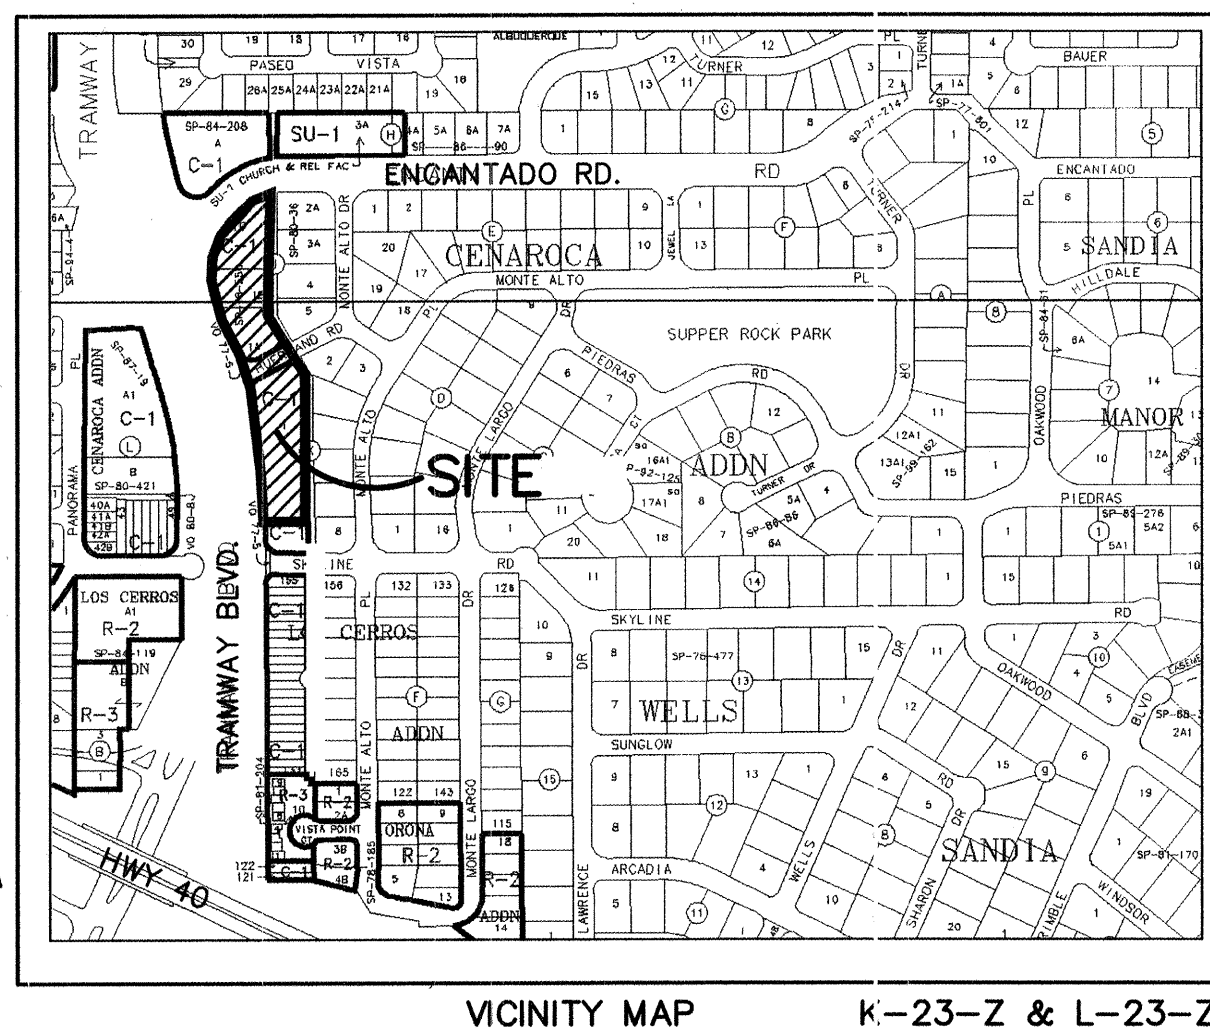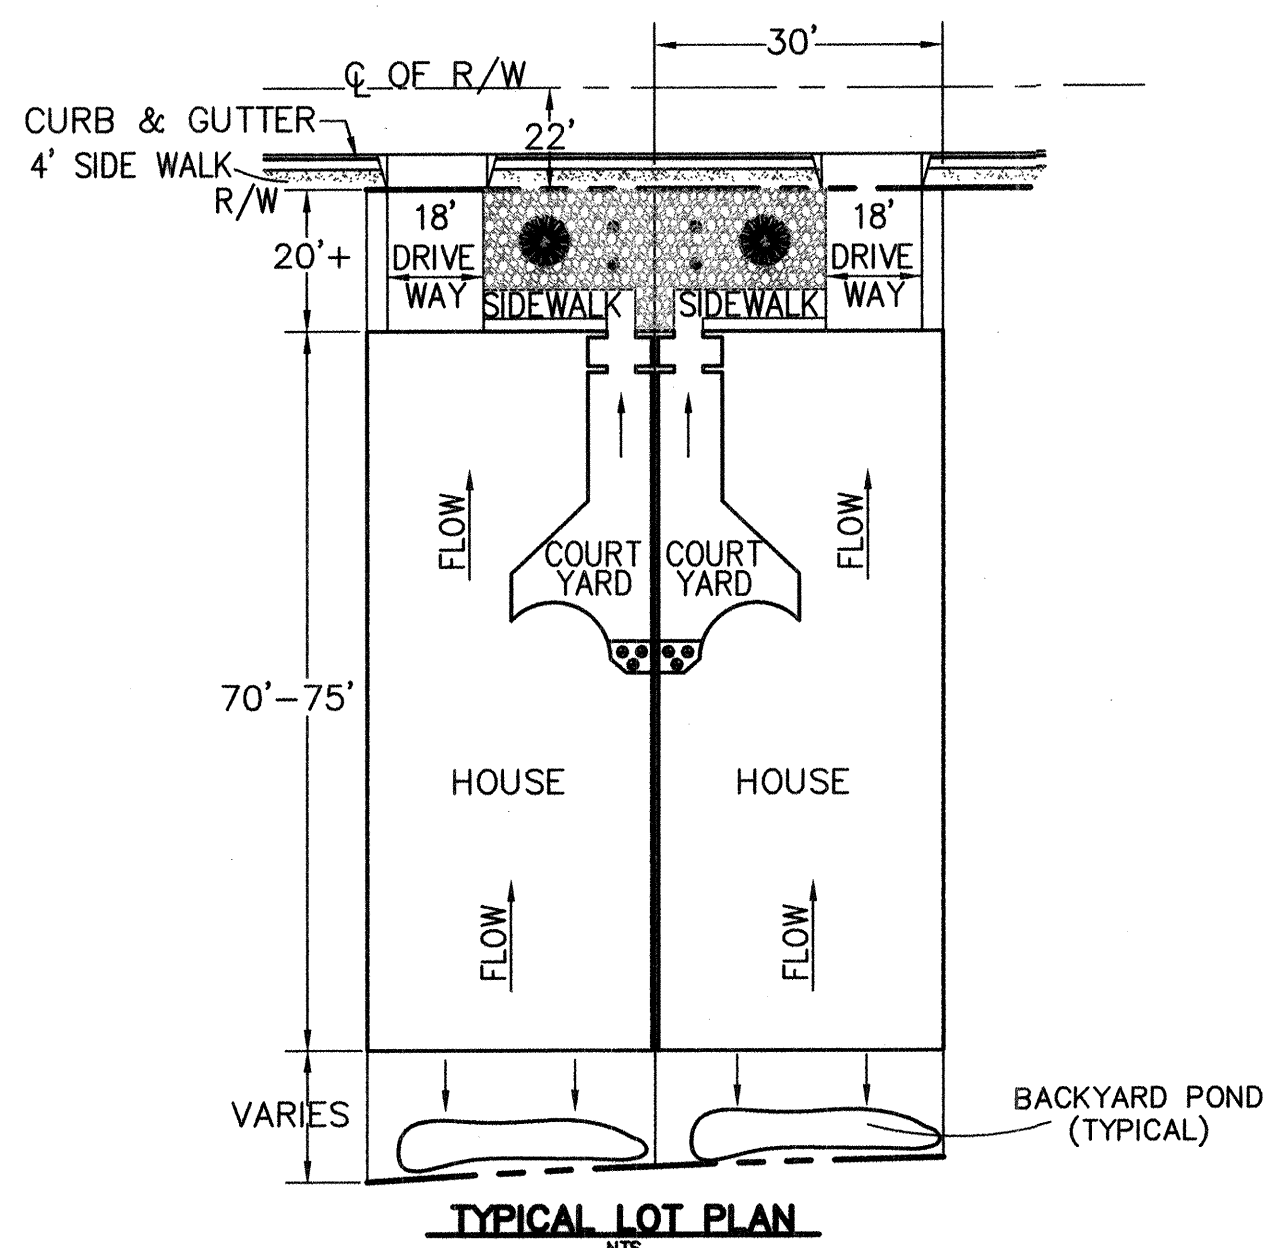


LEGEND		
FP=09.07	FINISHED PAD SITE ELEVATION	●
60.23	PROPOSED SPOT ELEVATION	=====
BW=12.51 TW=11.84	TOP OF WALL ELEVATION BOTTOM OF WALL ELEVATION	=====
	EXISTING MAJOR CONTOUR	
	EXISTING MINOR CONTOUR	
	PROPOSED RETAINING WALL	=====
		PROPOSED 4' DIA STORM DRAIN MANHOLE
		PROPOSED STORM DRAIN
		PROPOSED STANDARD CURB AND GUTTER
		PROPOSED MOUNTABLE CURB AND GUTTER
		PROPOSED INLET
		PROPOSED WHEEL CHAIR RAMPS
		PROPOSED 1.5' DEEP POND


 Thompson Engineering Consultants, Inc. tecinc@yahoo.com											
P.O. BOX 65760 ALBUQUERQUE, NM 87193		PHONE: (505) 271-2199 FAX: (505) 630-9428						NO. DATE		DESIGNED BY DBT	
										DRAWN BY DEN	
										CHECKED BY DBT	
CITY OF ALBUQUERQUE PUBLIC WORKS DEPARTMENT TRANSPORTATION DEVELOPMENT											
GRADING AND DRAINAGE PLAN BLUFFS AT ENCANTADO											
DESIGN REVIEW COMMITTEE		CITY ENGINEER APPROVAL				MO./DAY/YR.		MO./DAY/YR.			
<i>For Information Only</i>											
City Project No. 790281				Zone Map No. K & L-23-Z		Sheet 4		Of 16			

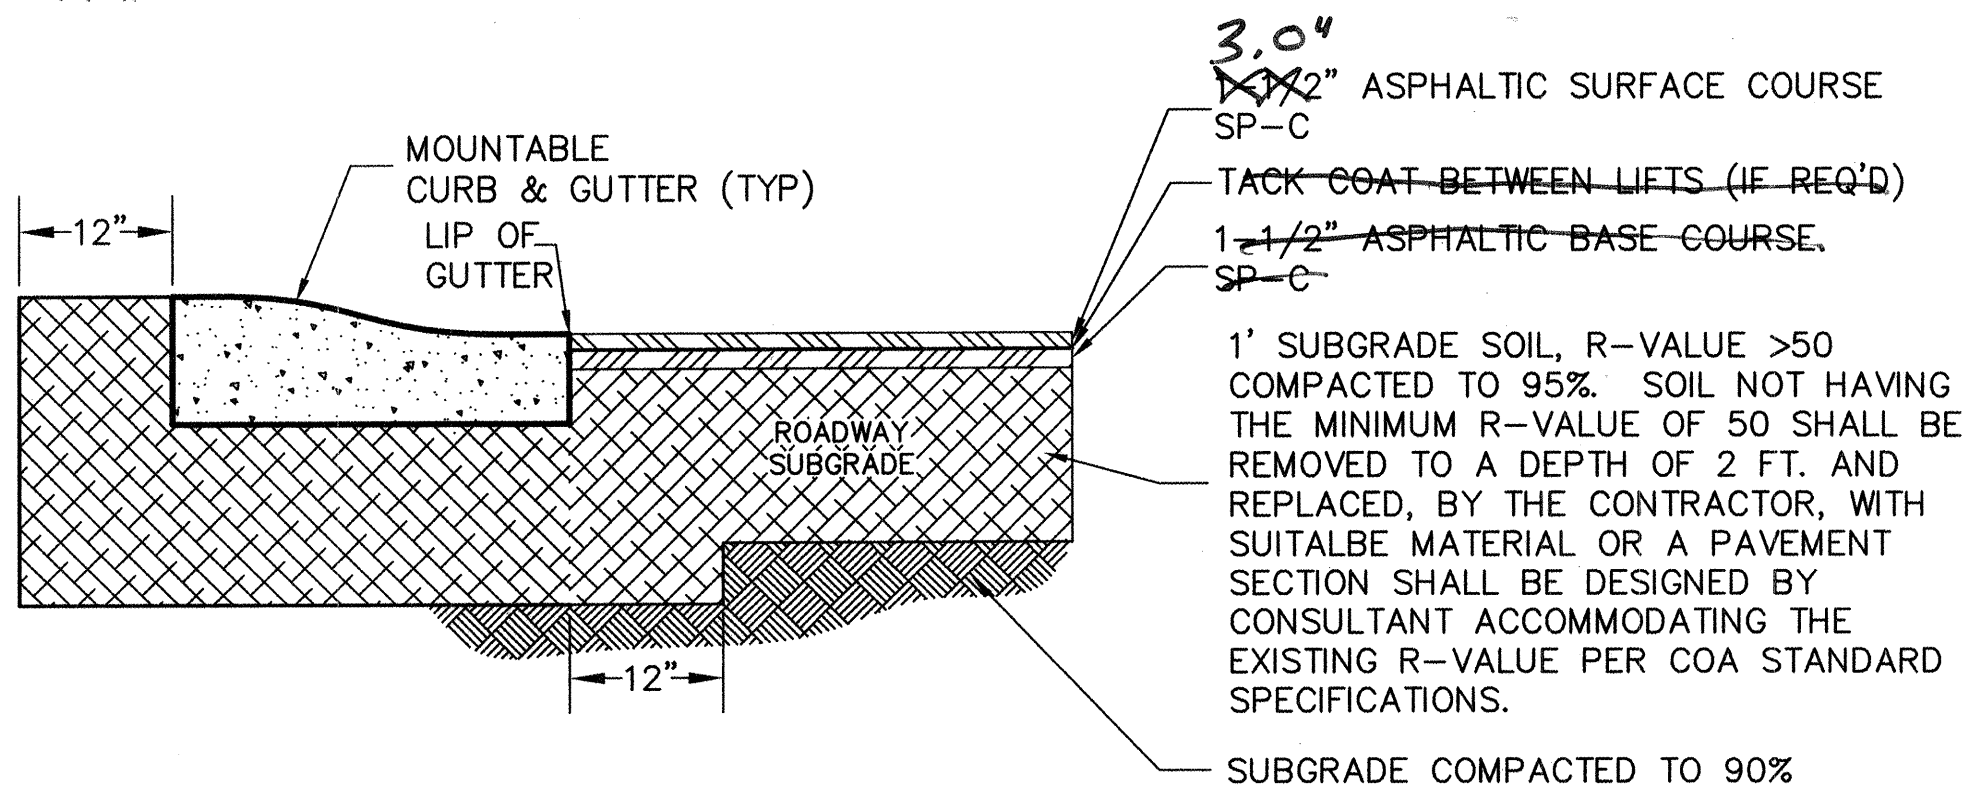


RESIDENTIAL PAVING SECTION - ROLLED CURB & GUTTER
(PER COA STD. DWG. No. 2405A) NTS

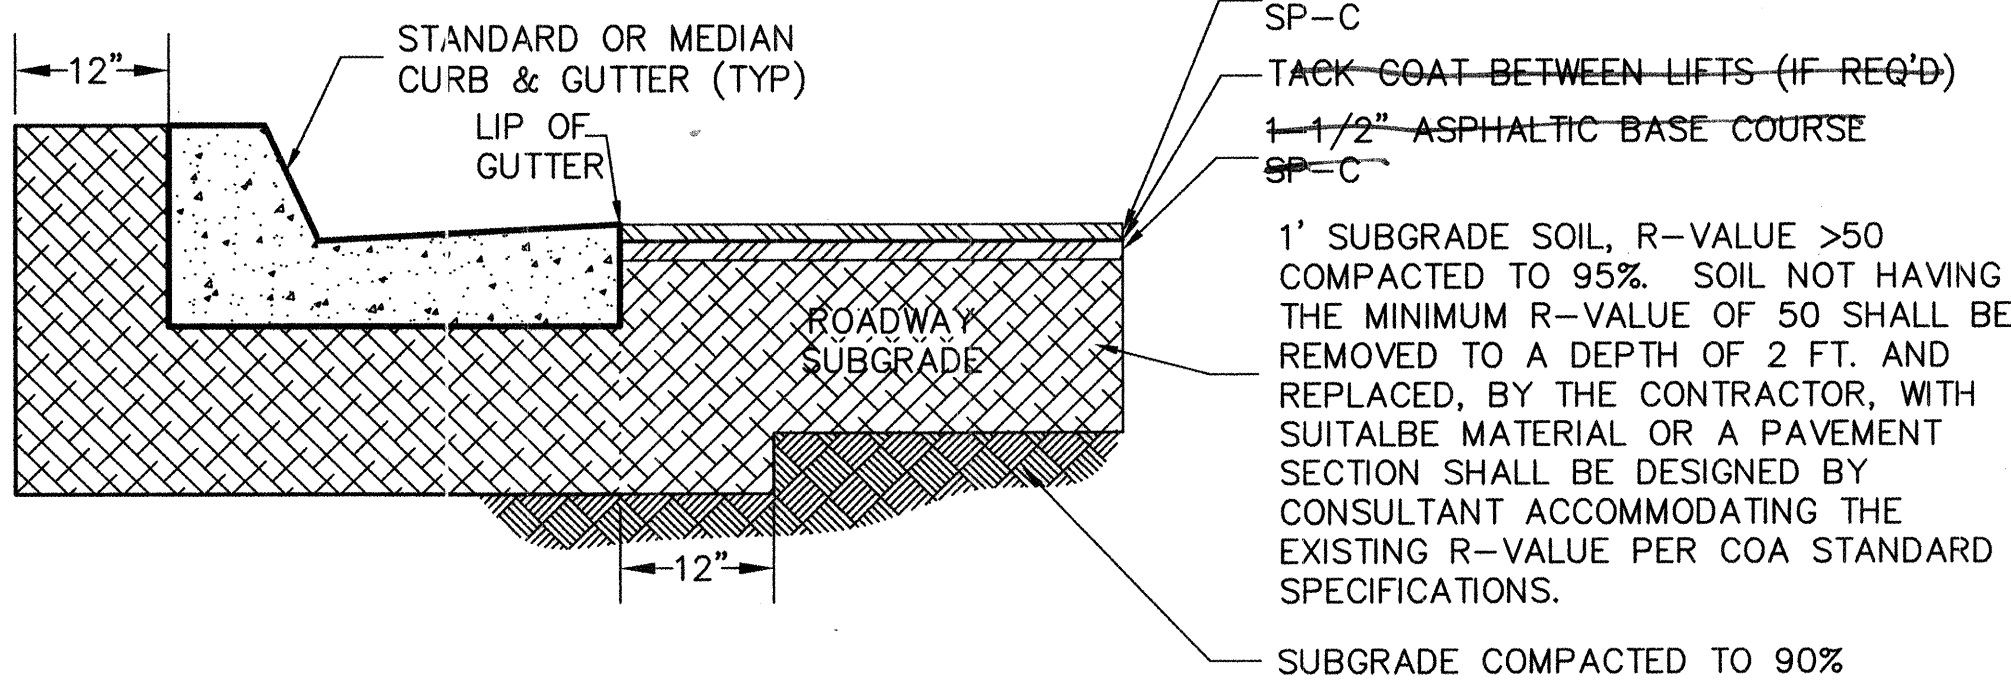


RESIDENTIAL PAVING SECTION - STANDARD CURB & GUTTER
(PER COA STD. DWG. No. 2405A) NTS

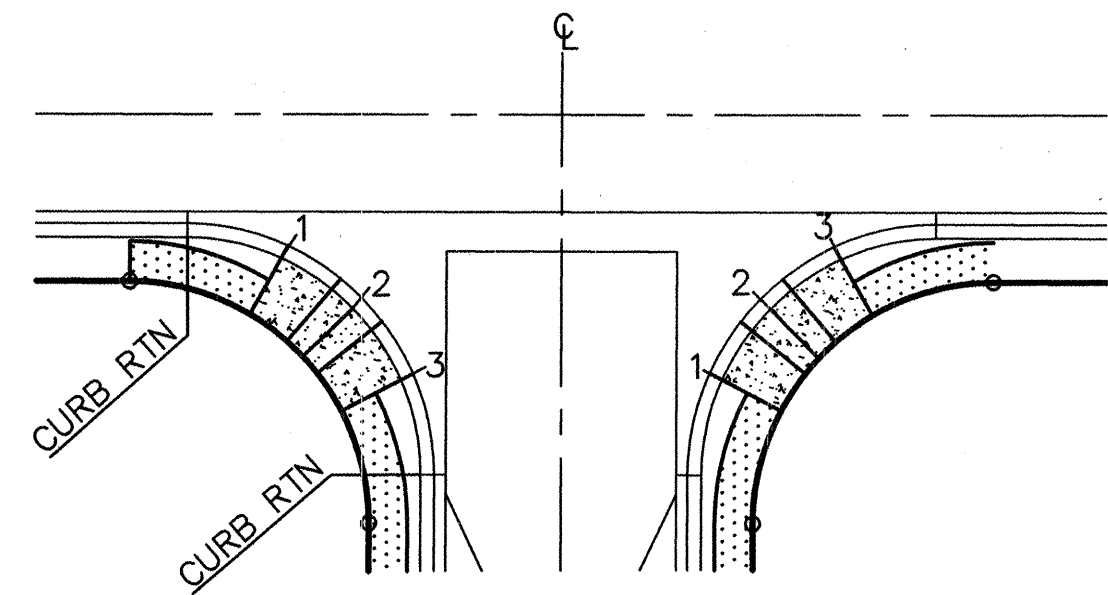


QUARTER POINT DETAIL
NTS

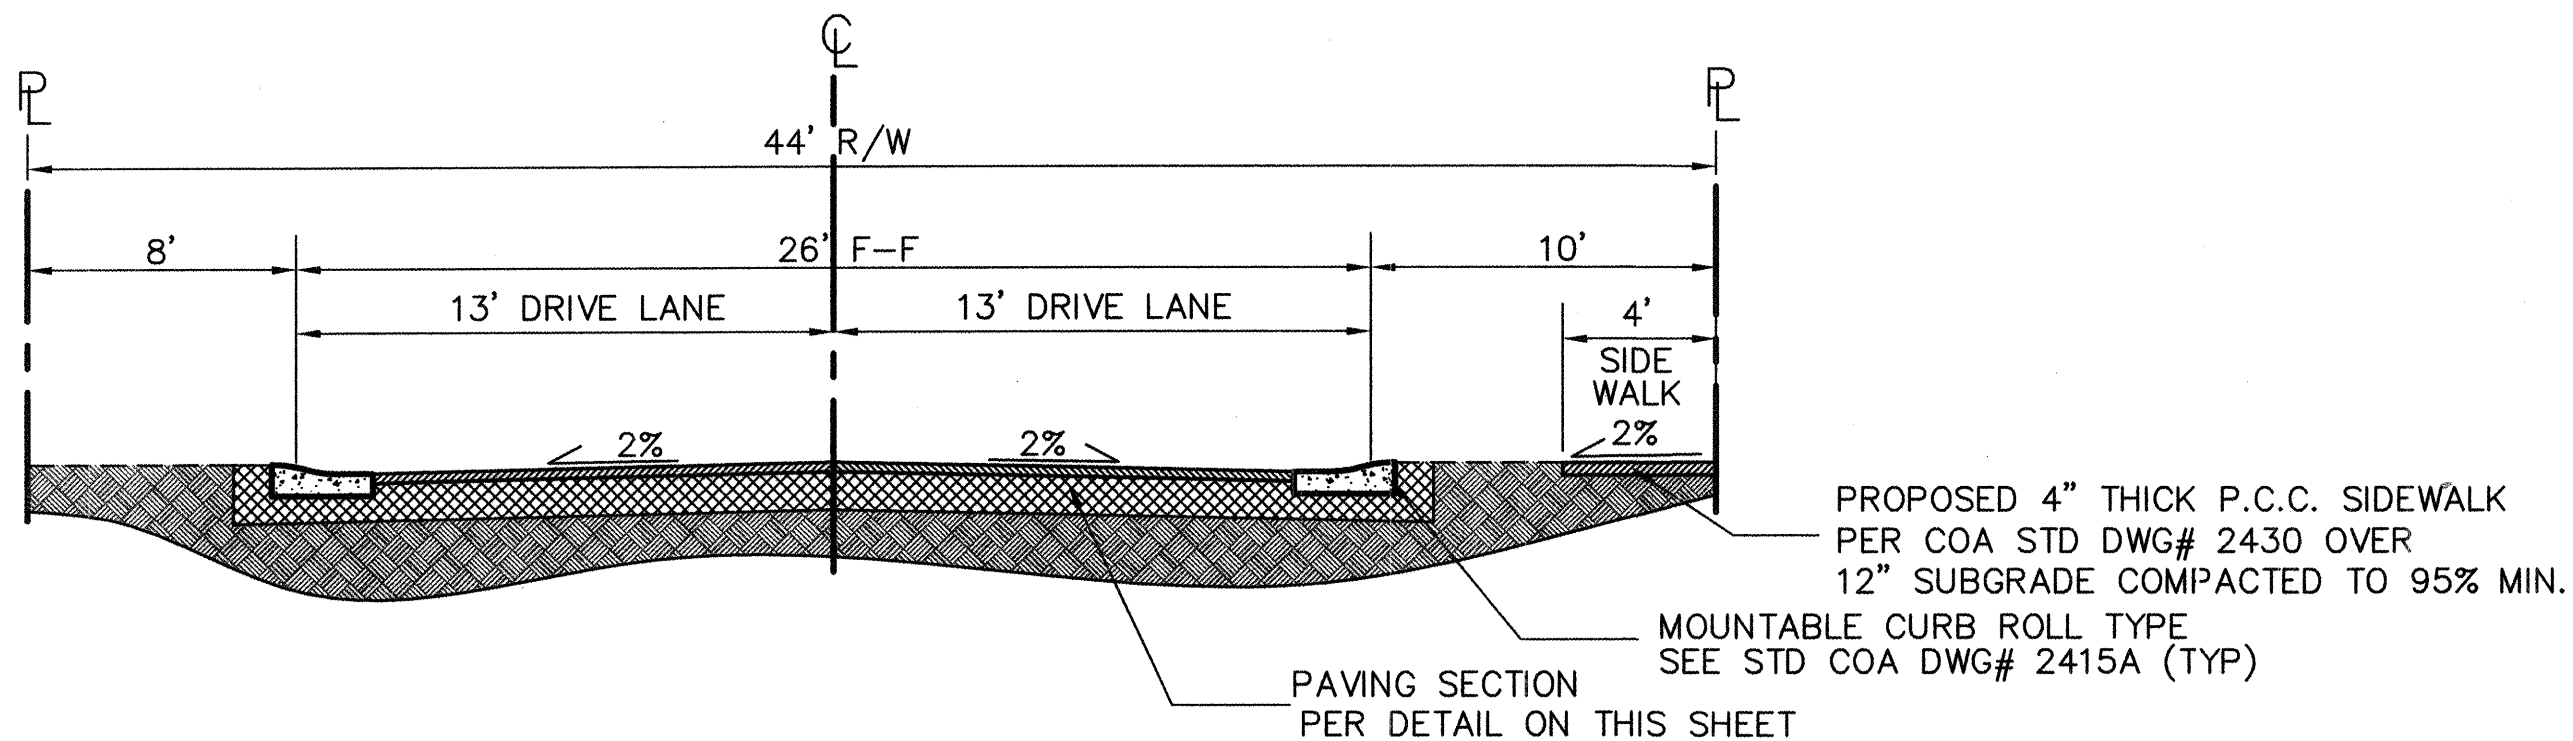


28' MOUNTABLE CURB TYPICAL SECTION
NTS

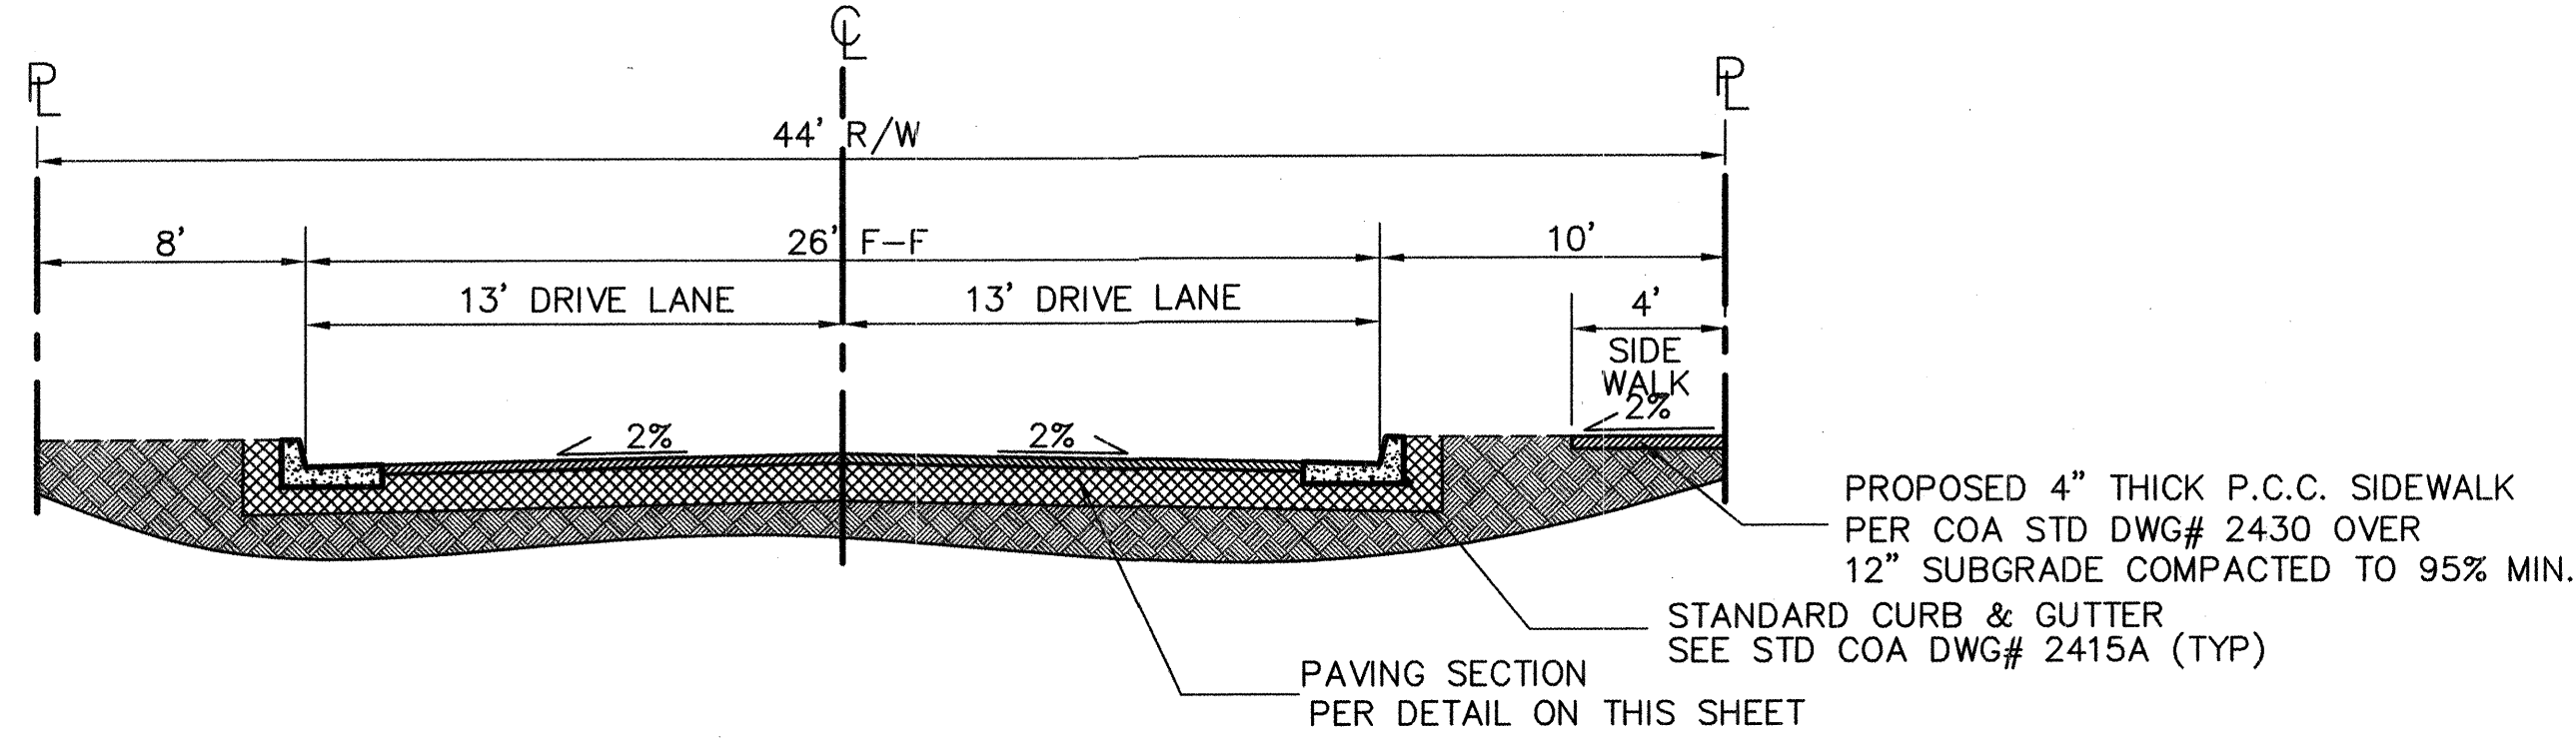

28' STANDARD CURB TYPICAL SECTION
NTS

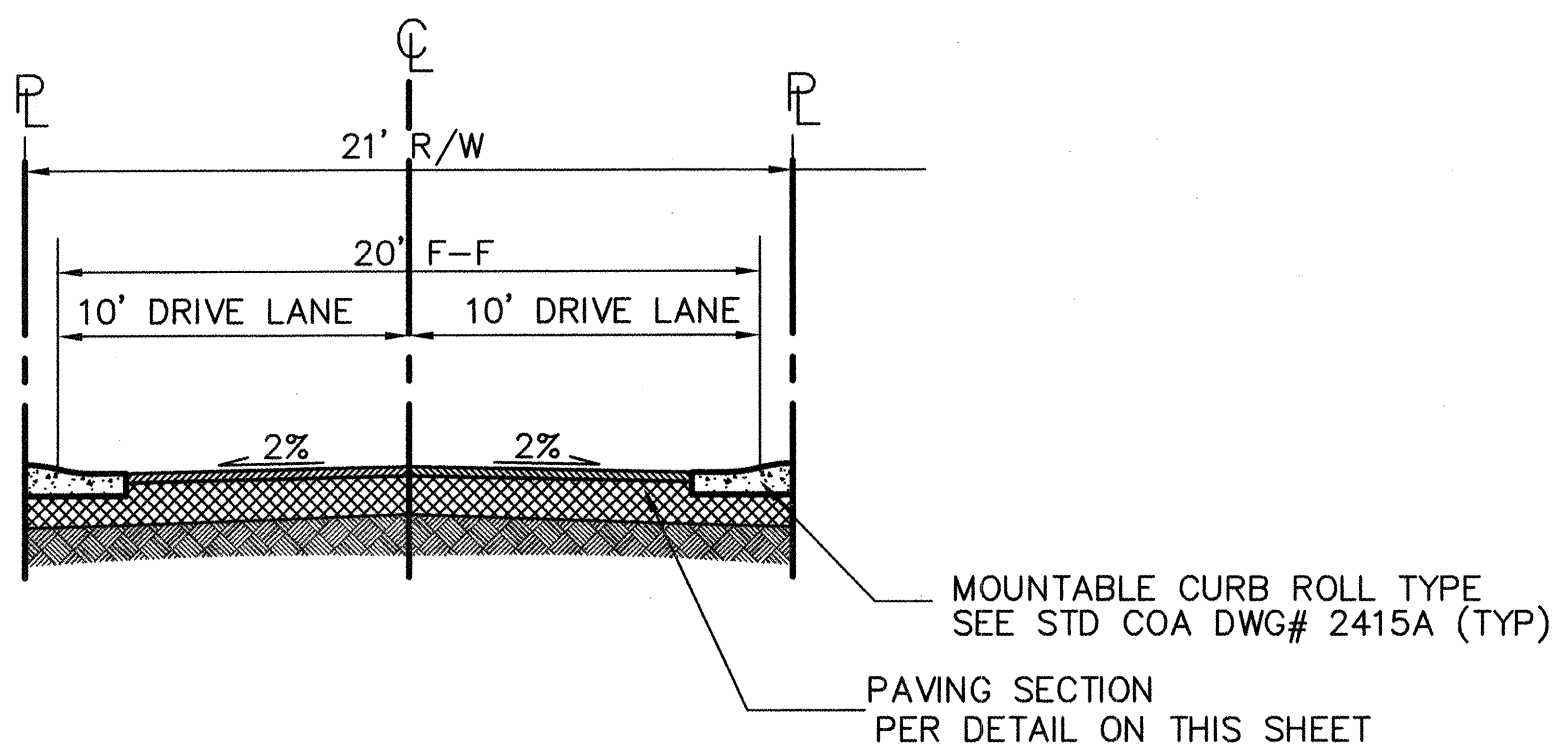

20' MOUNTABLE CURB TYPICAL SECTION
NTS

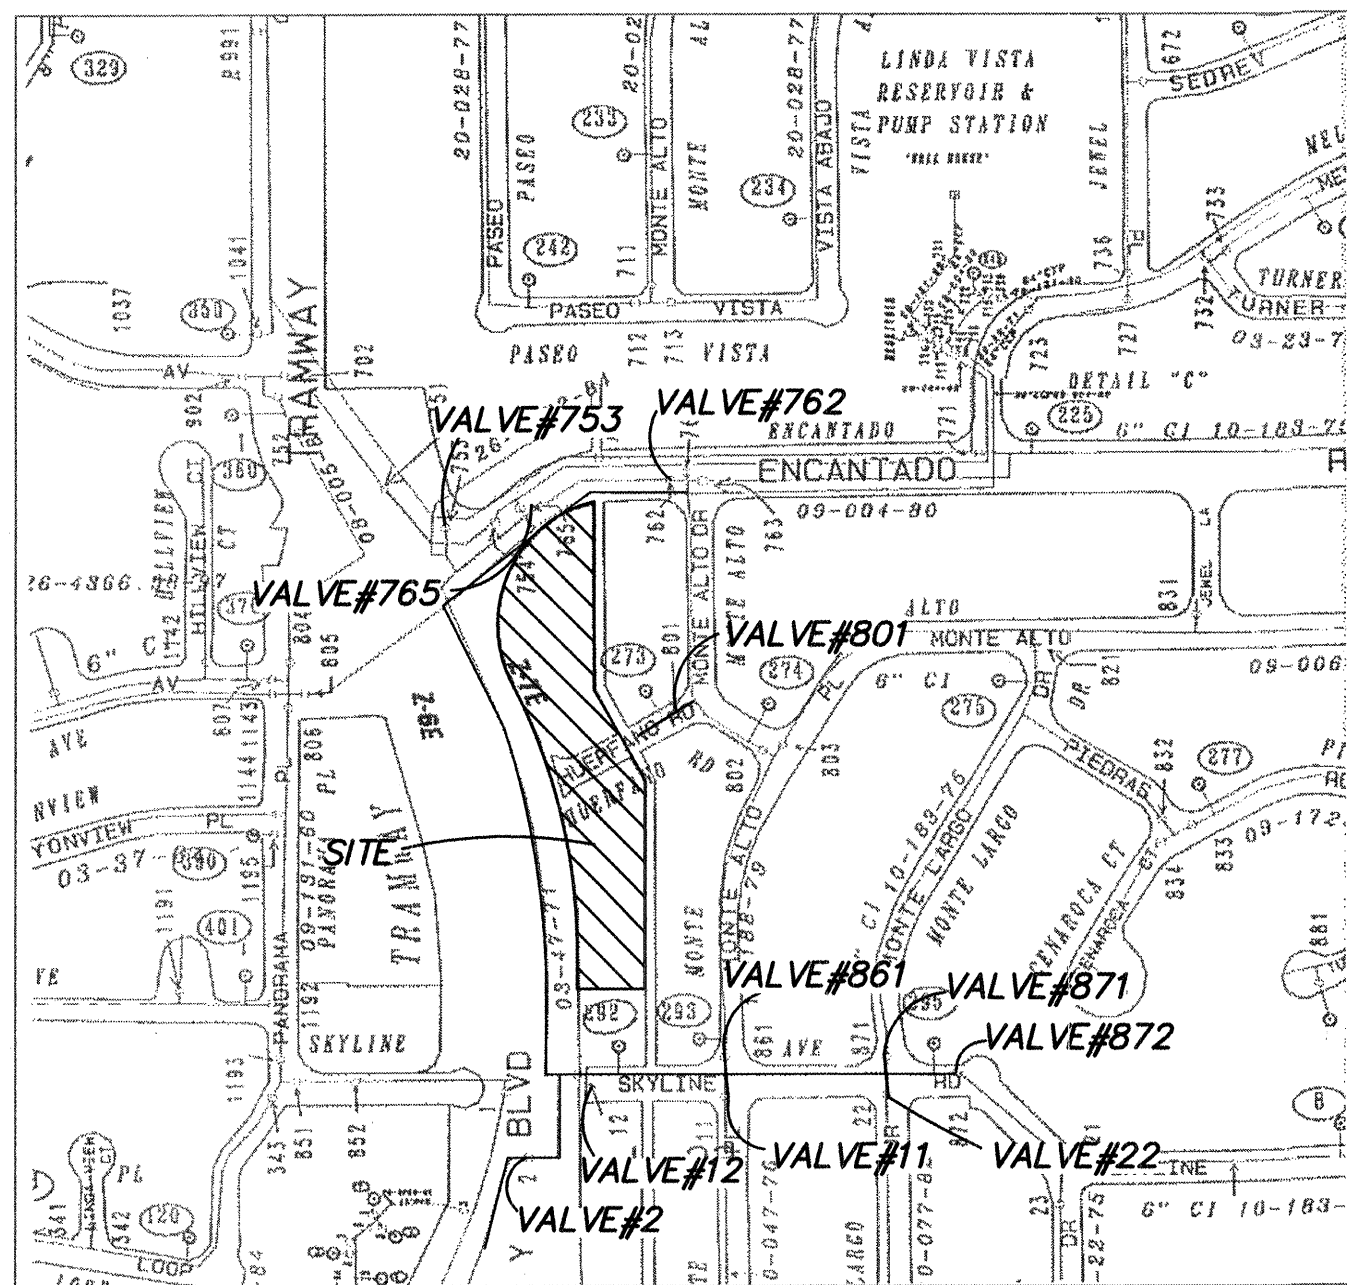


SHUT OFF PLAN NOTES:
1. CONTACT WATER SYSTEMS (857-8200) AT LEAST 7 WORKING DAYS IN ADVANCE OF CONSTRUCTION.
2. ONLY CITY CREWS MAY OPERATE VALVES.
3. IN CASE OF AN EMERGENCY SHUT OFF VALVES #'S
ENCANTADO RD.- # 2, 12, 753, 762, 765
HERFANDO RD.- # 801
SKYLINE RD.- # 2, 11, 12, 22, 861, 871, 872,

WATER SHUT-OFF PLAN
NTS

Thompson Engineering Consultants, Inc.
4800 JUAN TABO NE, SUITE C ALBUQUERQUE, NEW MEXICO 87111
PHONE: (505) 271-2199 FAX: (505) 237-8422
tecrcm@yahoo.com

CITY OF ALBUQUERQUE PUBLIC WORKS DEPARTMENT TRANSPORTATION DEVELOPMENT			
PAVING DETAILS BLUFFS & ENCANTADO			
DESIGN REVIEW COMMITTEE	CITY ENGINEER APPROVAL	MO./DAY/YR.	MO./DAY/YR.
APPROVE NOV 17 2006 DESIGN REVIEW COMMITTEE	APPROVE NOV 17 2006 CITY ENGINEER		
City Project No. 790281		Zone Map No. K & L-23-Z	Sheet 5 Of 16


AS BUILT INFORMATION		BENCH MARKS		SURVEY INFORMATION		ENGINEER'S SEAL	
CONTRACTOR	DATE	ACS MONUMENT "21-K23"	ELEV.	FIELD NOTES	DATE	NO.	BY
Sal's Bros. Const.	11/17/06	ACS 17" ALUMINUM DISK, STAMPED "ACS	5708.72				
Surf-Tek	11/17/06	BM, 21-K23, EPOXY ON TOP OF THE					
SEC - T.V.	11/17/06	CONCRETE CURB, AT THE EAST END OF					
SEC - T.V.	11/17/06	SKYLINE ROAD NE, 308 FT. ± EAST OF					
SEC - T.V.	11/17/06	THE CENTERLINE OF PANORAMA PL., ON					
SEC - T.V.	11/17/06	THE CENTERLINE (EXTENDED) OF SKYLINE RD.					

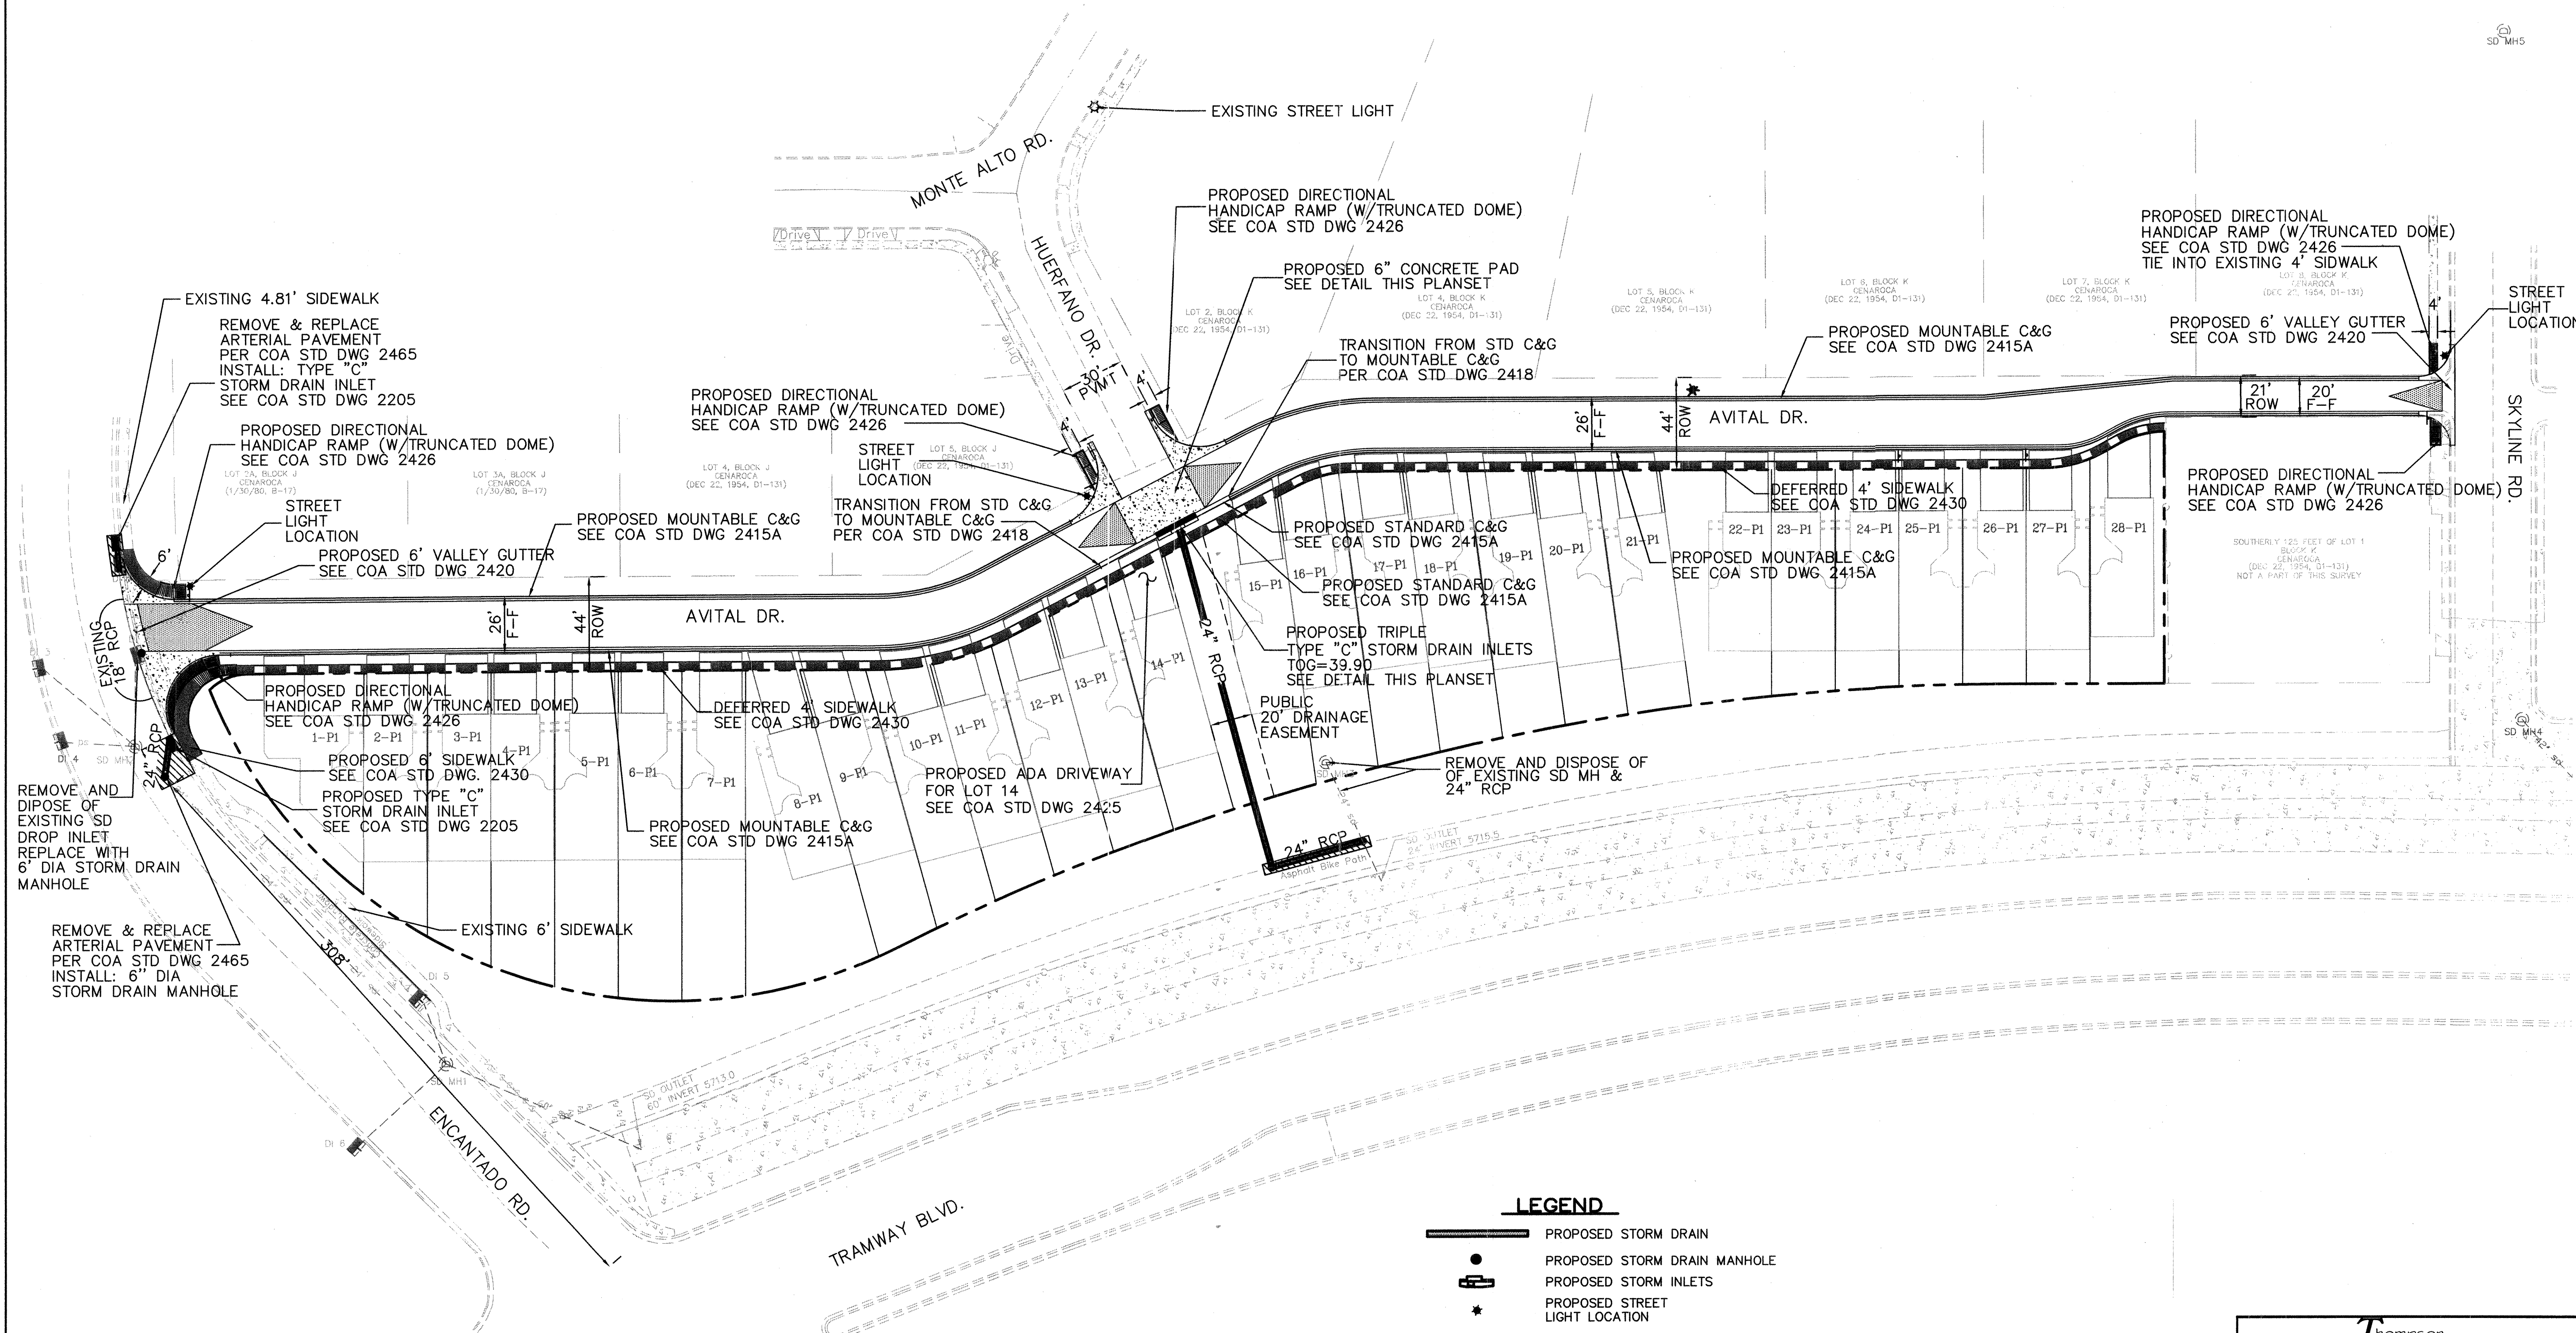

DETECTABLE WARNING SURFACE (TRUNCATED DOMES)

- DESIGN PER ADA GUIDELINES
- DESIGN & SPECIFICATIONS NEED TO BE SUBMITTED TO COA CONSTRUCTION ENGINEER FOR EVALUATION PRIOR TO CONSTRUCTION.

- LEGEND**
- PROPOSED STORM DRAIN
 - PROPOSED STORM DRAIN MANHOLE
 - PROPOSED STORM INLETS
 - PROPOSED STREET LIGHT LOCATION
 - CENTERLINE OF STREET
 - PROPOSED PROPERTY BOUNDARY
 - PROPOSED MOUNTABLE CURB & GUTTER SEE COA STD DWG 2415A
 - PROPOSED STANDARD CURB & GUTTER SEE COA STD DWG 2415A
 - DEFERRED SIDEWALK SEE COA STD DWG 2430
 - PROPOSED SIDEWALK SEE COA STD DWG 2430
 - PROPOSED VALLEY GUTTER SEE COA STD DWG 2420
 - PROPOSED CROWN TO NO CROWN TRANSITION SEE COA STD DWG 2401
 - PROPOSED HANDICAP RAMP CASE II (W/TRUNCATED DOME) SEE COA STD DWG 2441
 - EXISTING CURB & GUTTER
 - EXISTING WALL

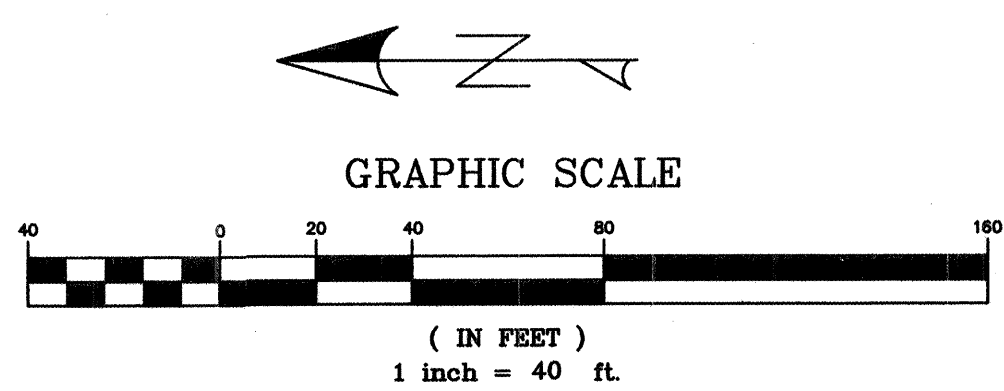

Thompson Engineering Consultants, Inc.
tecmm@yahoo.com
P.O. BOX 65760 ALBUQUERQUE, NM 87193
PHONE: (505) 271-2199 FAX: (505) 830-9428




**CITY OF ALBUQUERQUE
PUBLIC WORKS DEPARTMENT
TRANSPORTATION DEVELOPMENT**

**OVERALL PAVING PLAN AND PROFILE
BLUFFS AT ENCANTADO**

DESIGN REVIEW COMMITTEE	ENGINEER APPROVAL	MO./DAY/YR.	MO./DAY/YR.
DESIGN REVIEW COMMITTEE	CITY ENGINEER		

City Project No. 790281 Zone Map No. K & L-23-Z Sheet 7 Of 16

AS BUILT INFORMATION		BENCH MARKS		SURVEY INFORMATION		ENGINEER'S SEAL	
CONTRACTOR	DATE	ACS MONUMENT "21-K23"	ELEV. 5708.72	FIELD NOTES	DATE		
STANDARD BY	DATE	ACS 1" ALUMINUM DISK, STAMPED "ACS BM, 21-K23", EPOXYED ON TOP OF THE CONCRETE CURB, AT THE EAST END OF SKYLINE ROAD NE, 308 FT. ± EAST OF THE CENTERLINE OF PANORAMA PL., ON THE CENTERLINE (EXTENDED) OF SKYLINE RD.		NO.	BY		
INSPECTOR	DATE					REMARKS	BY
FIELD	DATE					DESIGN	DATE
REVISION	DATE					DRAWN BY	DATE
CORRECTED BY	DATE					CHECKED BY	DATE
MICRO-FILM INFORMATION							
RECORDED BY	DATE						
NO.							

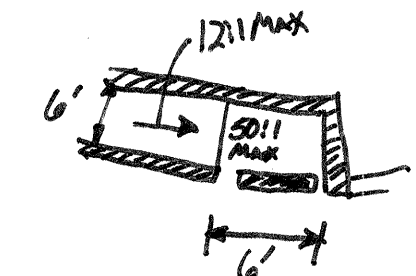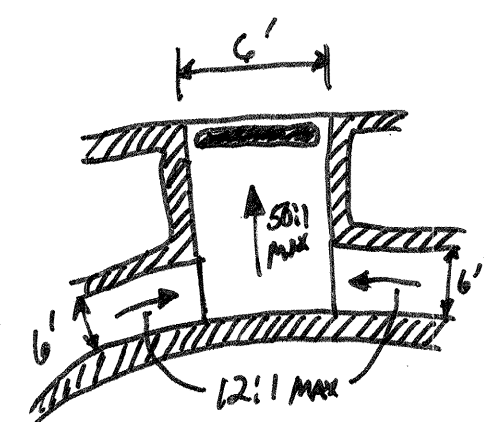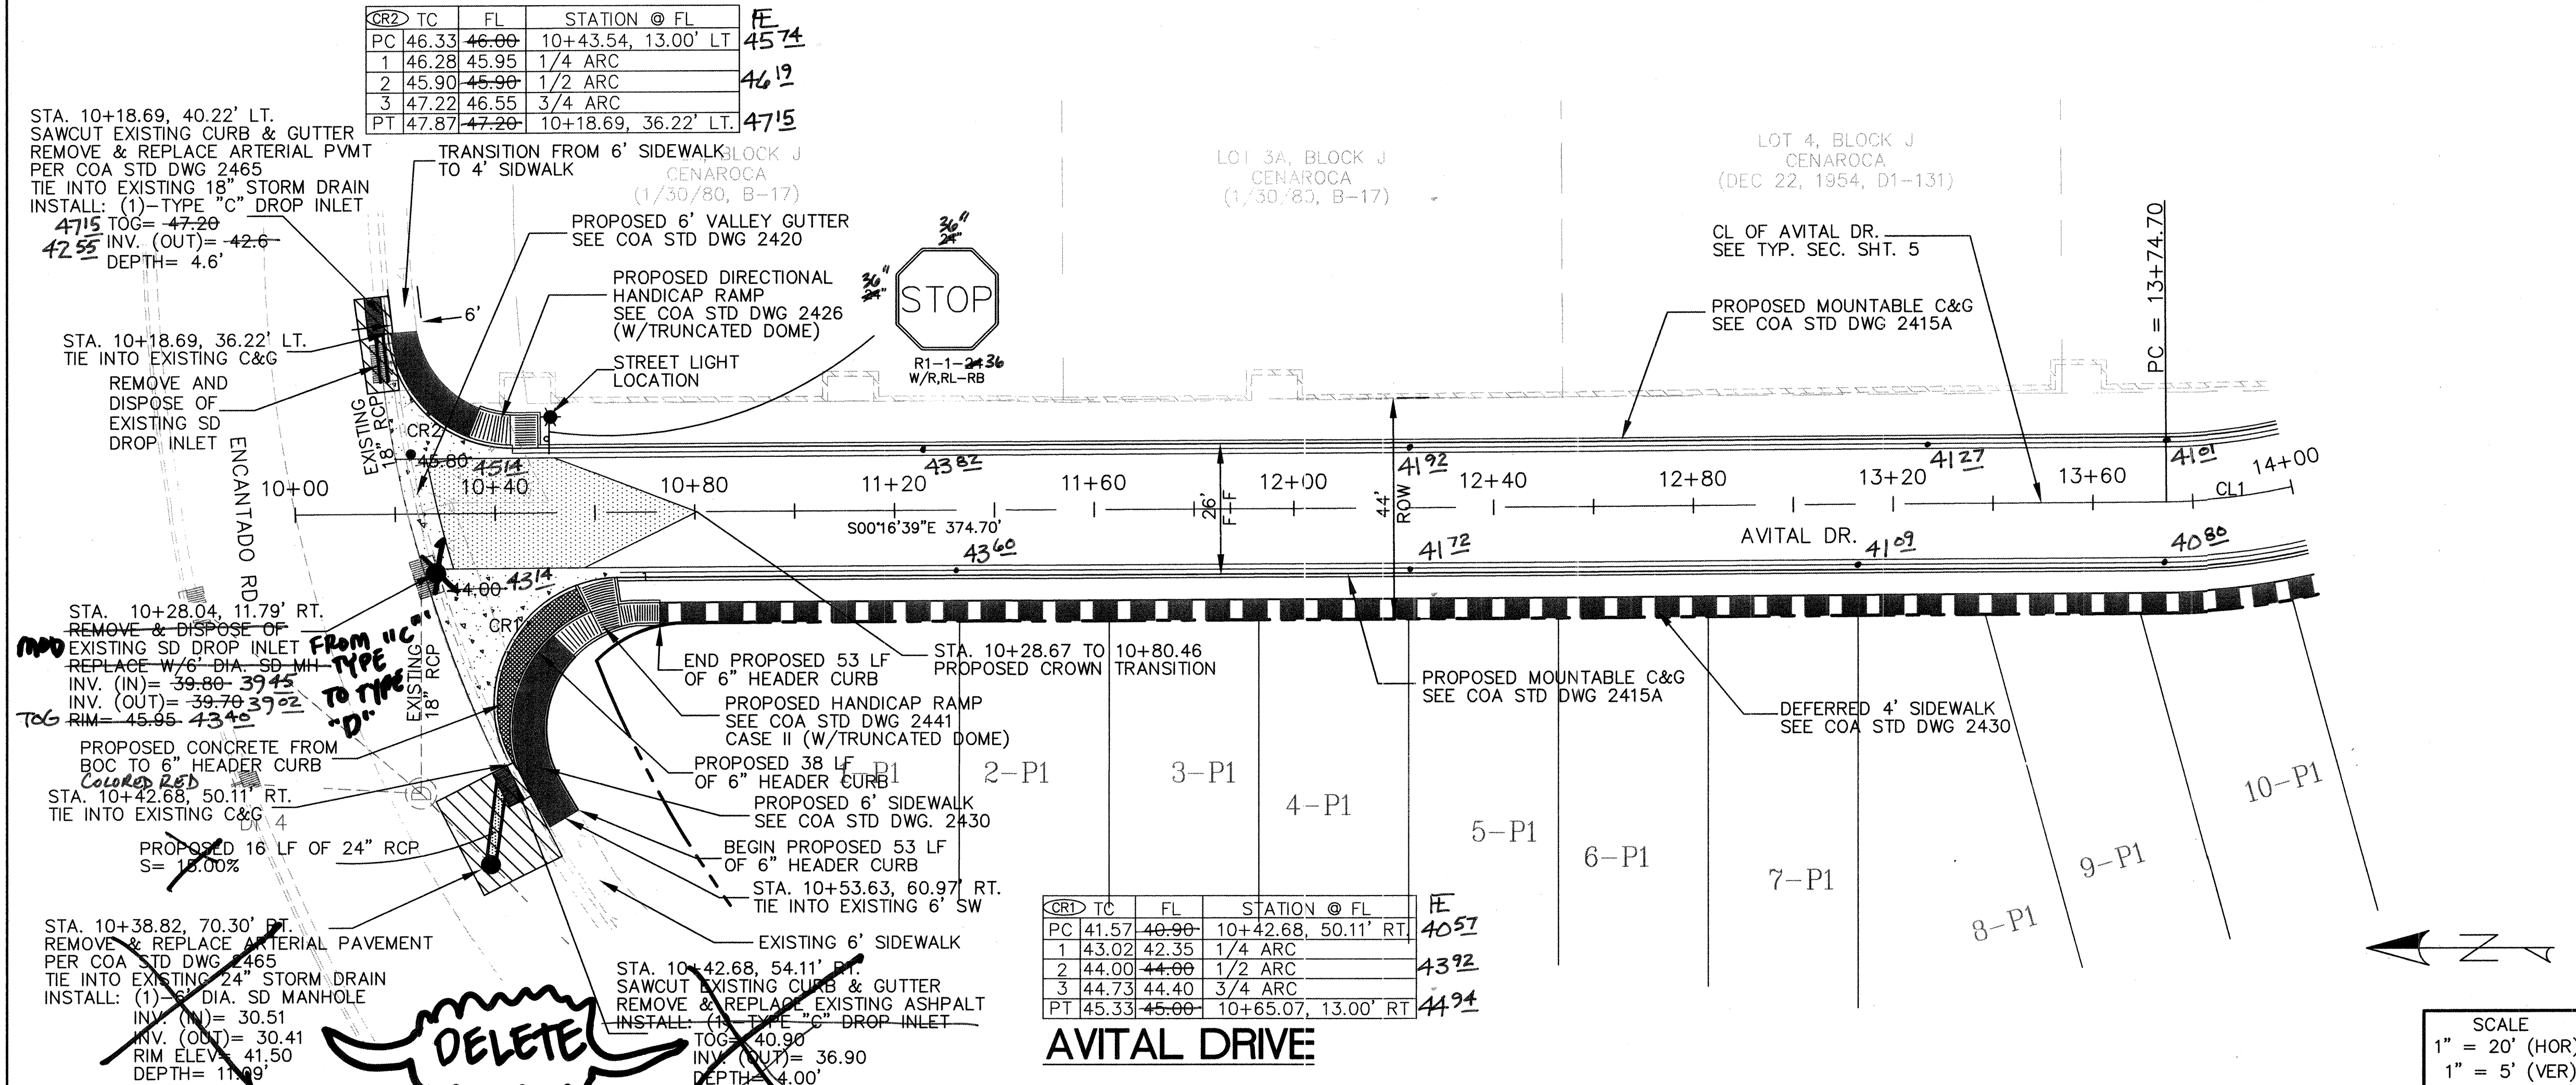

WHEELCHAIR RAMP DETAILS
MIS

CENTERLINE CURVE DATA TABLE

CURVE #	DELTA	RADIUS	TAN	LENGTH
CL1	27°21'40"	120.00'	29.21'	57.30'

CURVE DATA TABLE

CURVE #	DELTA	RADIUS	TAN	LENGTH
CR1	116°40'03"	25.00'	40.53'	50.91'
CR2	84°06'07"	25.00'	22.55'	36.70'

- LEGEND
- PROPOSED STORM DRAIN
 - PROPOSED STORM DRAIN MANHOLE
 - PROPOSED STORM INLETS
 - PROPOSED STREET LIGHT LOCATION
 - CENTERLINE OF STREET
 - PROPOSED PROPERTY BOUNDARY
 - PROPOSED MOUNTABLE CURB & GUTTER
SEE COA STD DWG 2415A
 - PROPOSED STANDARD CURB & GUTTER
SEE COA STD DWG 2415A
 - DEFERRED SIDEWALK
SEE COA STD DWG 2430
 - PROPOSED SIDEWALK
SEE COA STD DWG 2430
 - PROPOSED VALLEY GUTTER
SEE COA STD DWG 2420
 - PROPOSED CROWN TO NO. CROWN TRANSITION
SEE COA STD DWG 2401
 - PROPOSED HANDICAP RAMP
CASE II (W/TRUNCATED DOME)
SEE COA STD DWG 2441
 - EXISTING CURB & GUTTER
 - EXISTING WALL

Thompson
Engineering
Consultants, Inc.
tecum@yahoo.com

P.O. BOX 65760
ALBUQUERQUE, NM 87193

PHONE: (505) 271-2199
FAX: (505) 830-9428

CITY OF ALBUQUERQUE
PUBLIC WORKS DEPARTMENT
TRANSPORTATION DEVELOPMENT

AVITAL DRIVE PAVING PLAN AND PROFILE
BLUFFS AT ENCANTADO

DESIGN REVIEW COMMITTEE

CITY ENGINEER APPROVAL

NO. DATE

REMARKS

DESIGN

DATE


DATE

DATE

City Project No. 790281

Zone Map No. K & L-23-Z

Sheet 8 Of 16

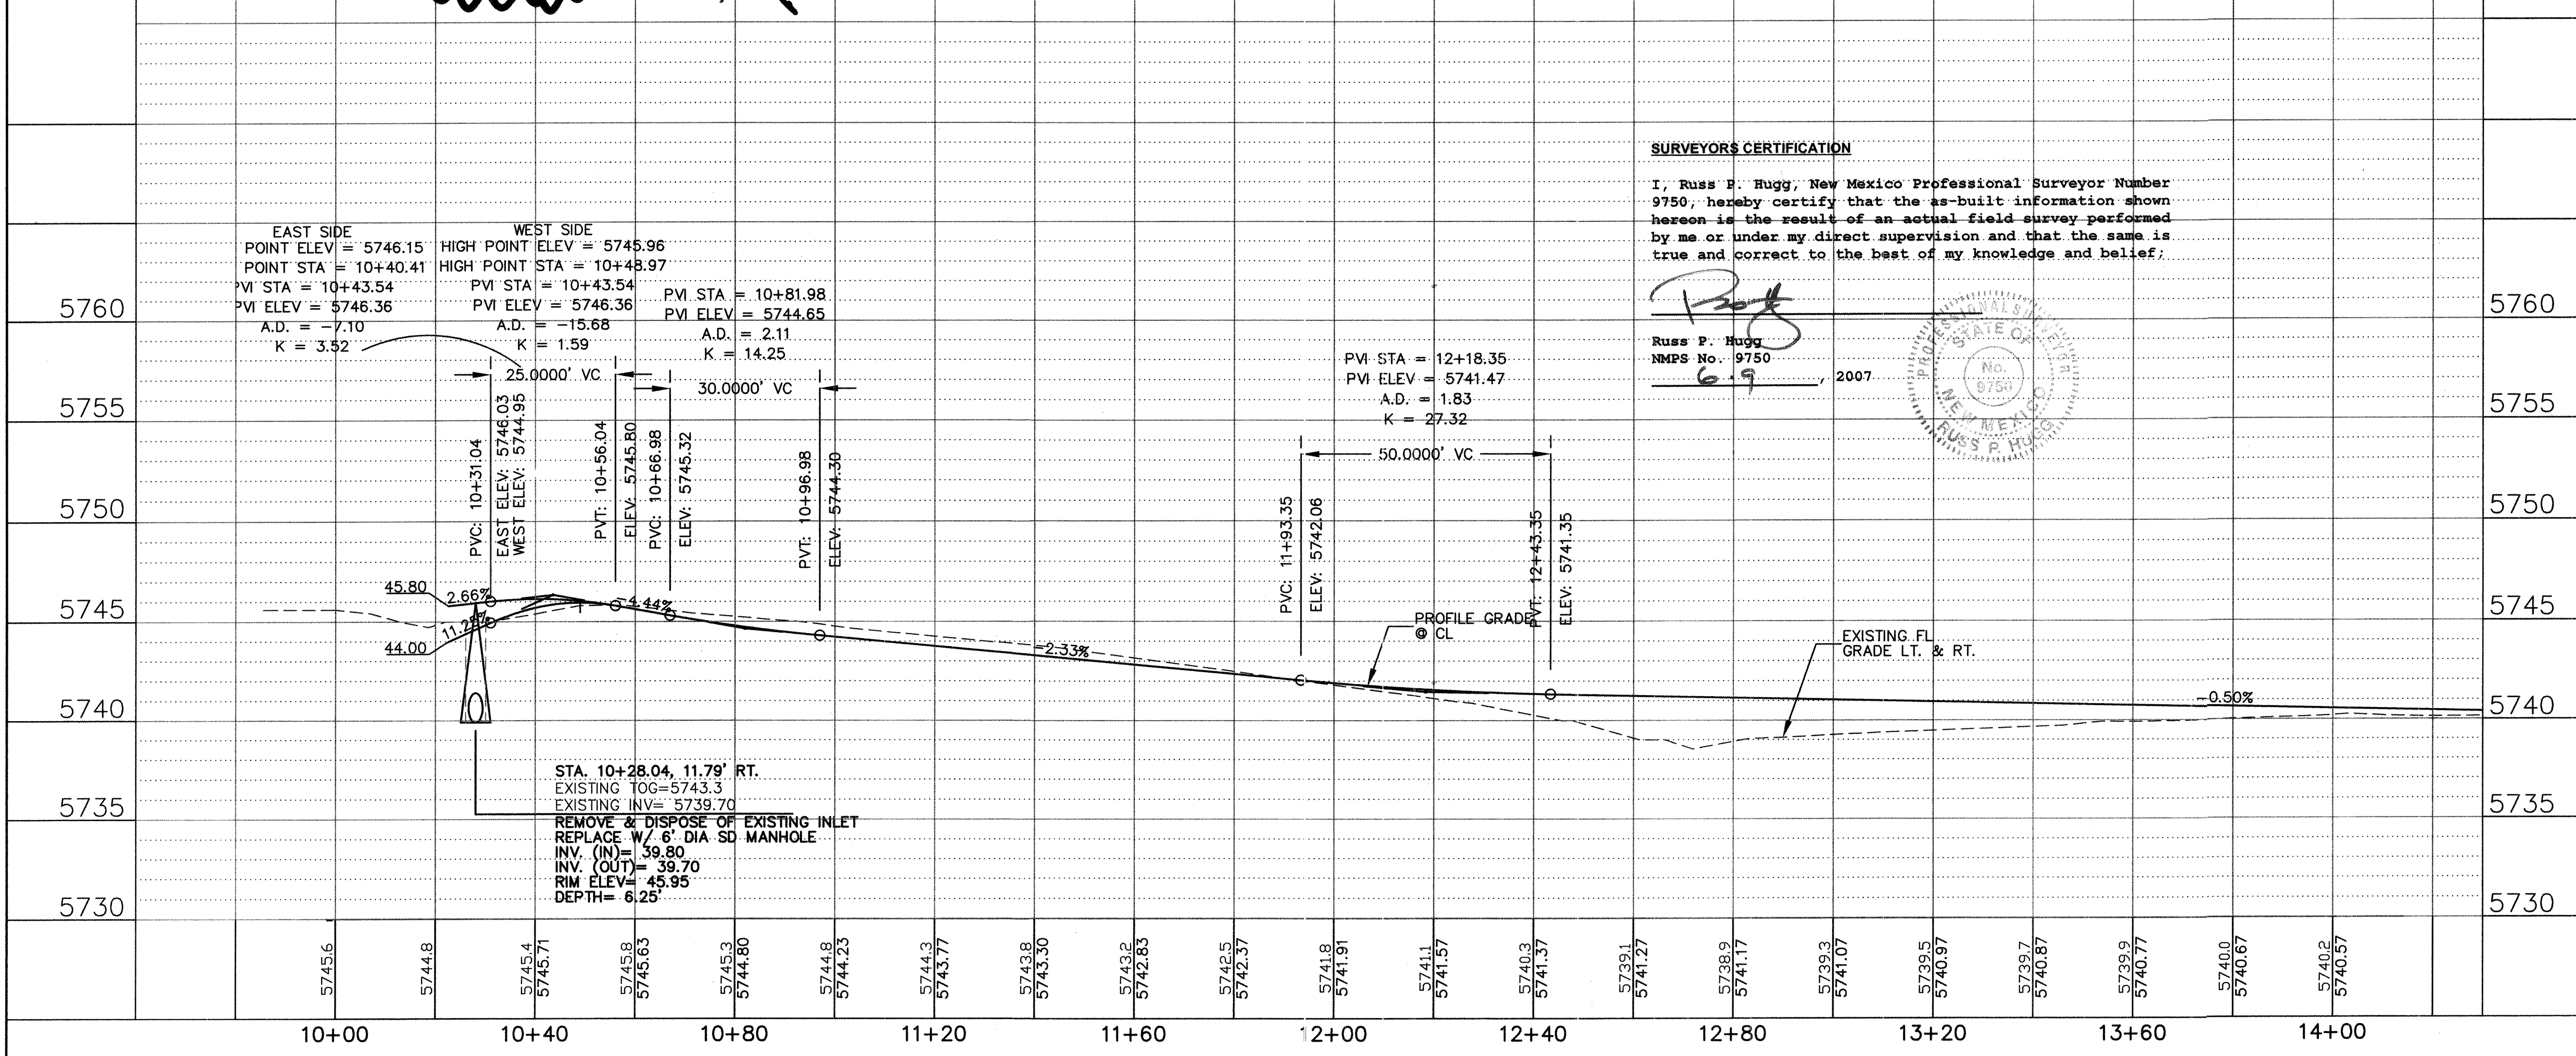


SURVEYORS CERTIFICATION

I, Russ P. Hugg, New Mexico Professional Surveyor Number 9750, hereby certify that the as-built information shown hereon is the result of an actual field survey performed by me or under my direct supervision and that the same is true and correct to the best of my knowledge and belief.

Russ P. Hugg
NMPs No. 9750
6.9 2007

CR3	TC	FL	STATION @ FL	FE
PC	42.77	42.10	15+04.49, 38.82' LT.	41 ⁷⁰
1	41.97	41.30	1/4 ARC	40 ⁹⁷
2	40.50	40.50	1/2 ARC	
3	41.17	40.50	3/4 ARC	
PT	41.17	40.50	14+79.49, 13.00' LT.	40 ²⁷



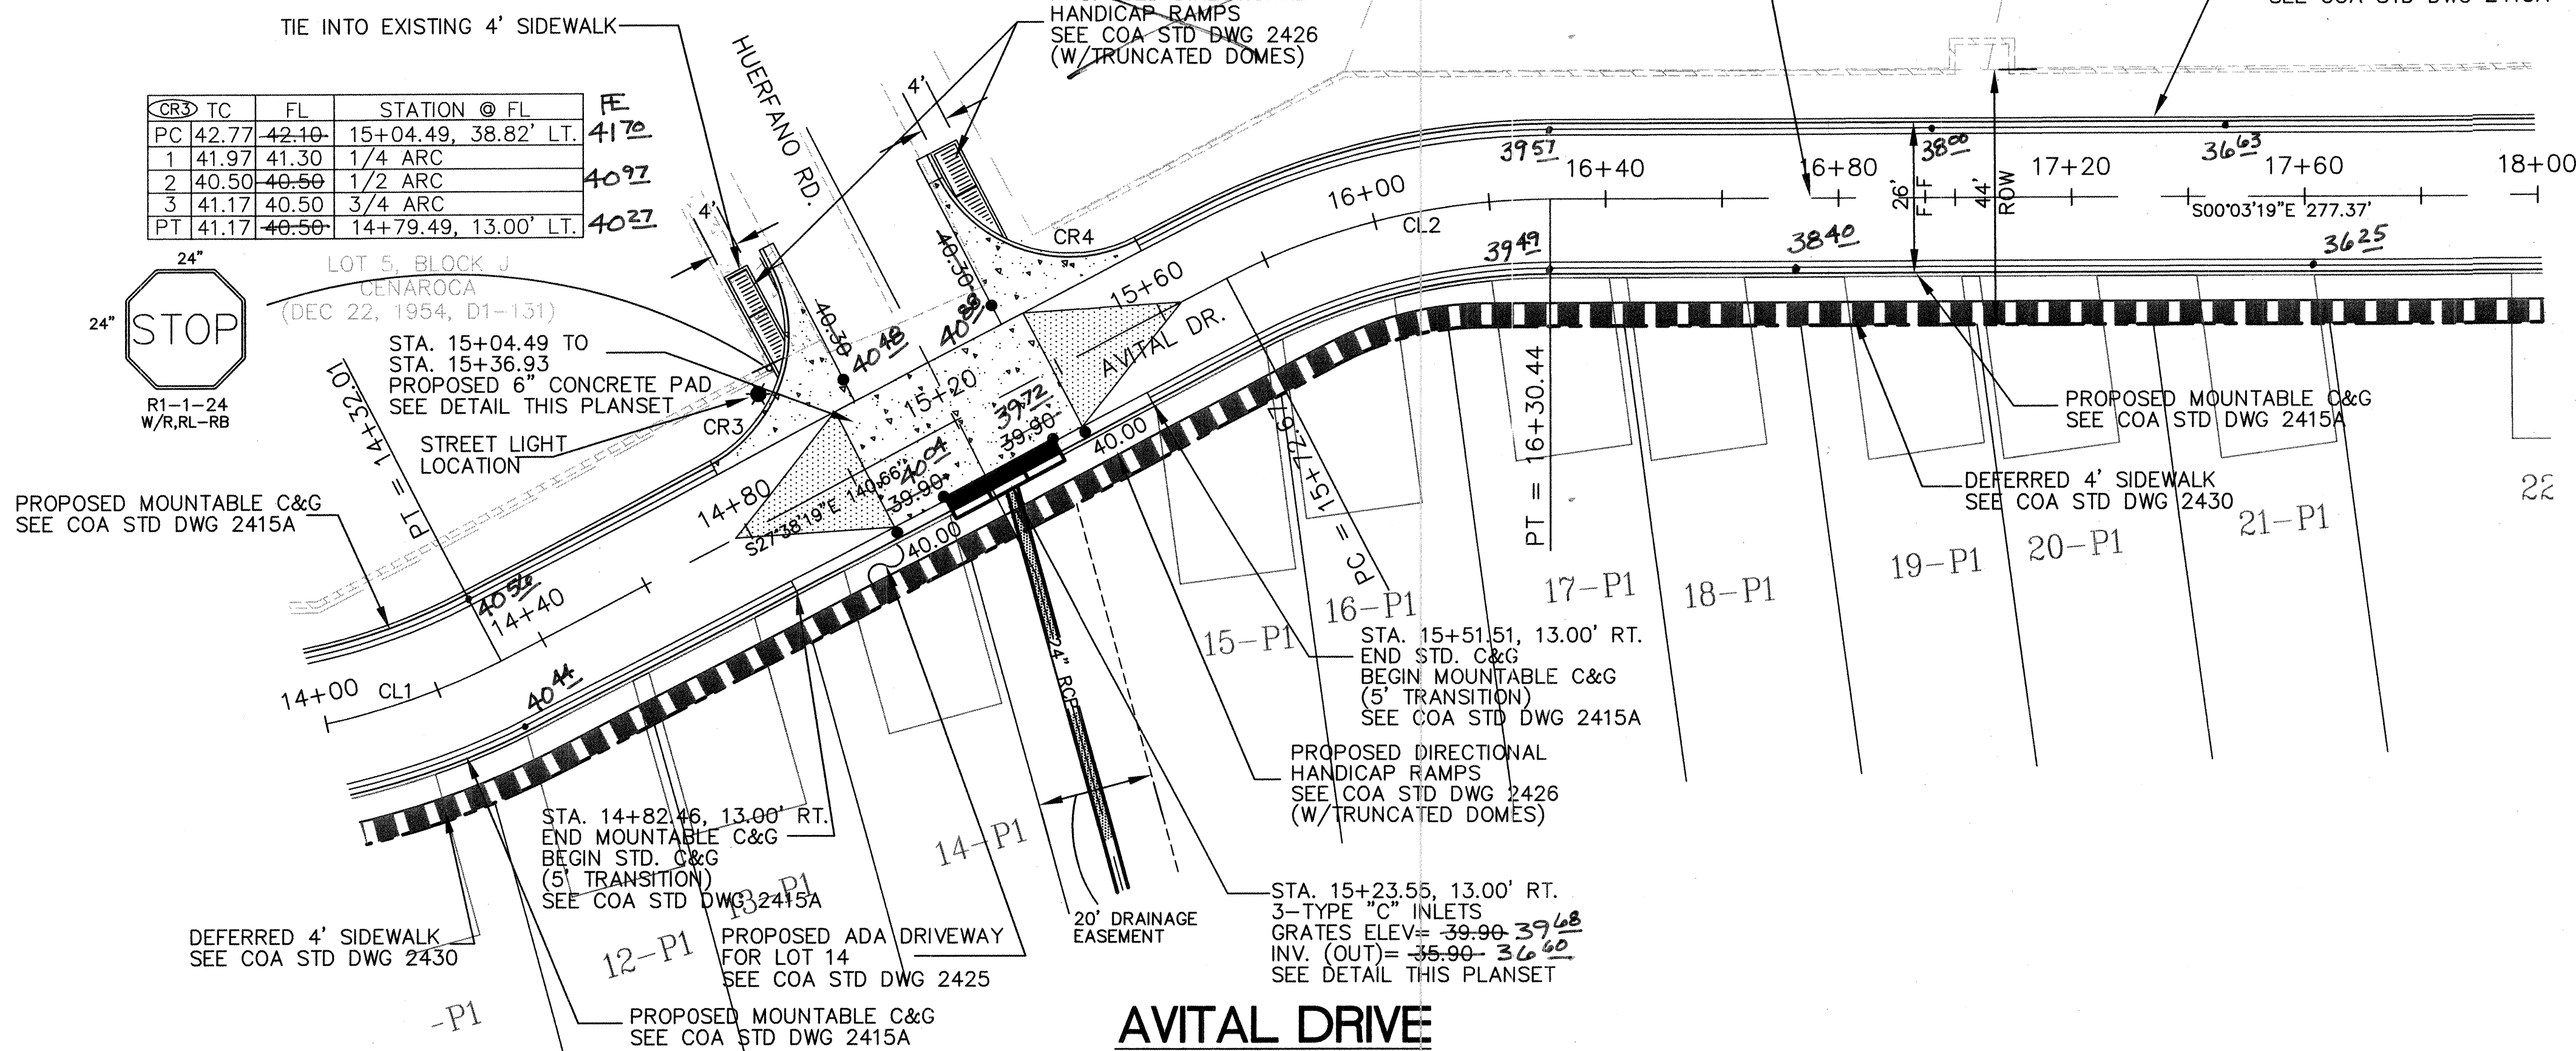


<u>CURVE #</u>	<u>DELTA</u>	<u>RADIUS</u>	<u>TAN</u>	<u>LENGTH</u>
CL1	27°21'40"	12C.00'	29.21'	57.30'
CL2	27°35'00"	120.00'	29.46'	57.77'

<u>CURVE #</u>	<u>DELTA</u>	<u>RADIUS</u>	<u>TAN</u>	<u>LENGTH</u>
CR3	89°34'56"	25.00'	24.82'	39.09'
CR4	90°25'04"	25.00'	25.18'	39.45'

SCALE
1" = 20' (HOR)
1" = 5' (VER)

LEGEND

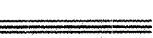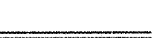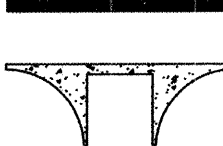-  PROPOSED STORM DRAIN
 PROPOSED STORM DRAIN MANHOLE
 PROPOSED STORM INLETS
 PROPOSED STREET LIGHT LOCATION
 CENTERLINE OF STREET
 PROPOSED PROPERTY BOUNDARY
 PROPOSED MOUNTABLE CURB & GUTTER
 SEE COA STD DWG 2415A
 PROPOSED STANDARD CURB & GUTTER
 SEE COA STD DWG 2415A
 DEFERRED SIDEWALK
 SEE COA STD DWG 2430
 PROPOSED SIDEWALK
 SEE COA STD DWG 2430
 PROPOSED VALLEY GUTTER
 SEE COA STD DWG 2420
 PROPOSED CROWN TO NO CROWN TRANSITION
 SEE COA STD DWG 2401
 PROPOSED HANDICAP RAMP CASE II (W/TRUNCATED DOME)
 SEE COA STD DWG 2441
 EXISTING CURB & GUTTER
 EXISTING WALL



Thompson
Engineering
Consultants, Inc.
tecni@yahoo.com

P.O. BOX 65760 PHONE: (505) 271-2199
ALBUQUERQUE, NM 87193 FAX: (505) 830-9428

CITY OF ALBUQUERQUE
PUBLIC WORKS DEPARTMENT
TRANSPORTATION DEVELOPMENT

AVITAL DRIVE PAVING PLAN AND PROFILE BLUFFS AT ENCANTADO

DESIGN REVIEW COMMITTEE

Oct 18 2000

DESIGN REVIEW COMMITTEE



CITY ENGINEER APPROVAL
APPROVED
NOV 17 2006
CITY ENGINEER

City Project No.
790281

Zone Map No.
K & L-23-Z

Sheet	Of
9	16


Z:\projects\lindborg-hahn\ENCANTADO\Planset\09-PAVE.dwg 8/29/2006 8:25:54 AM MST

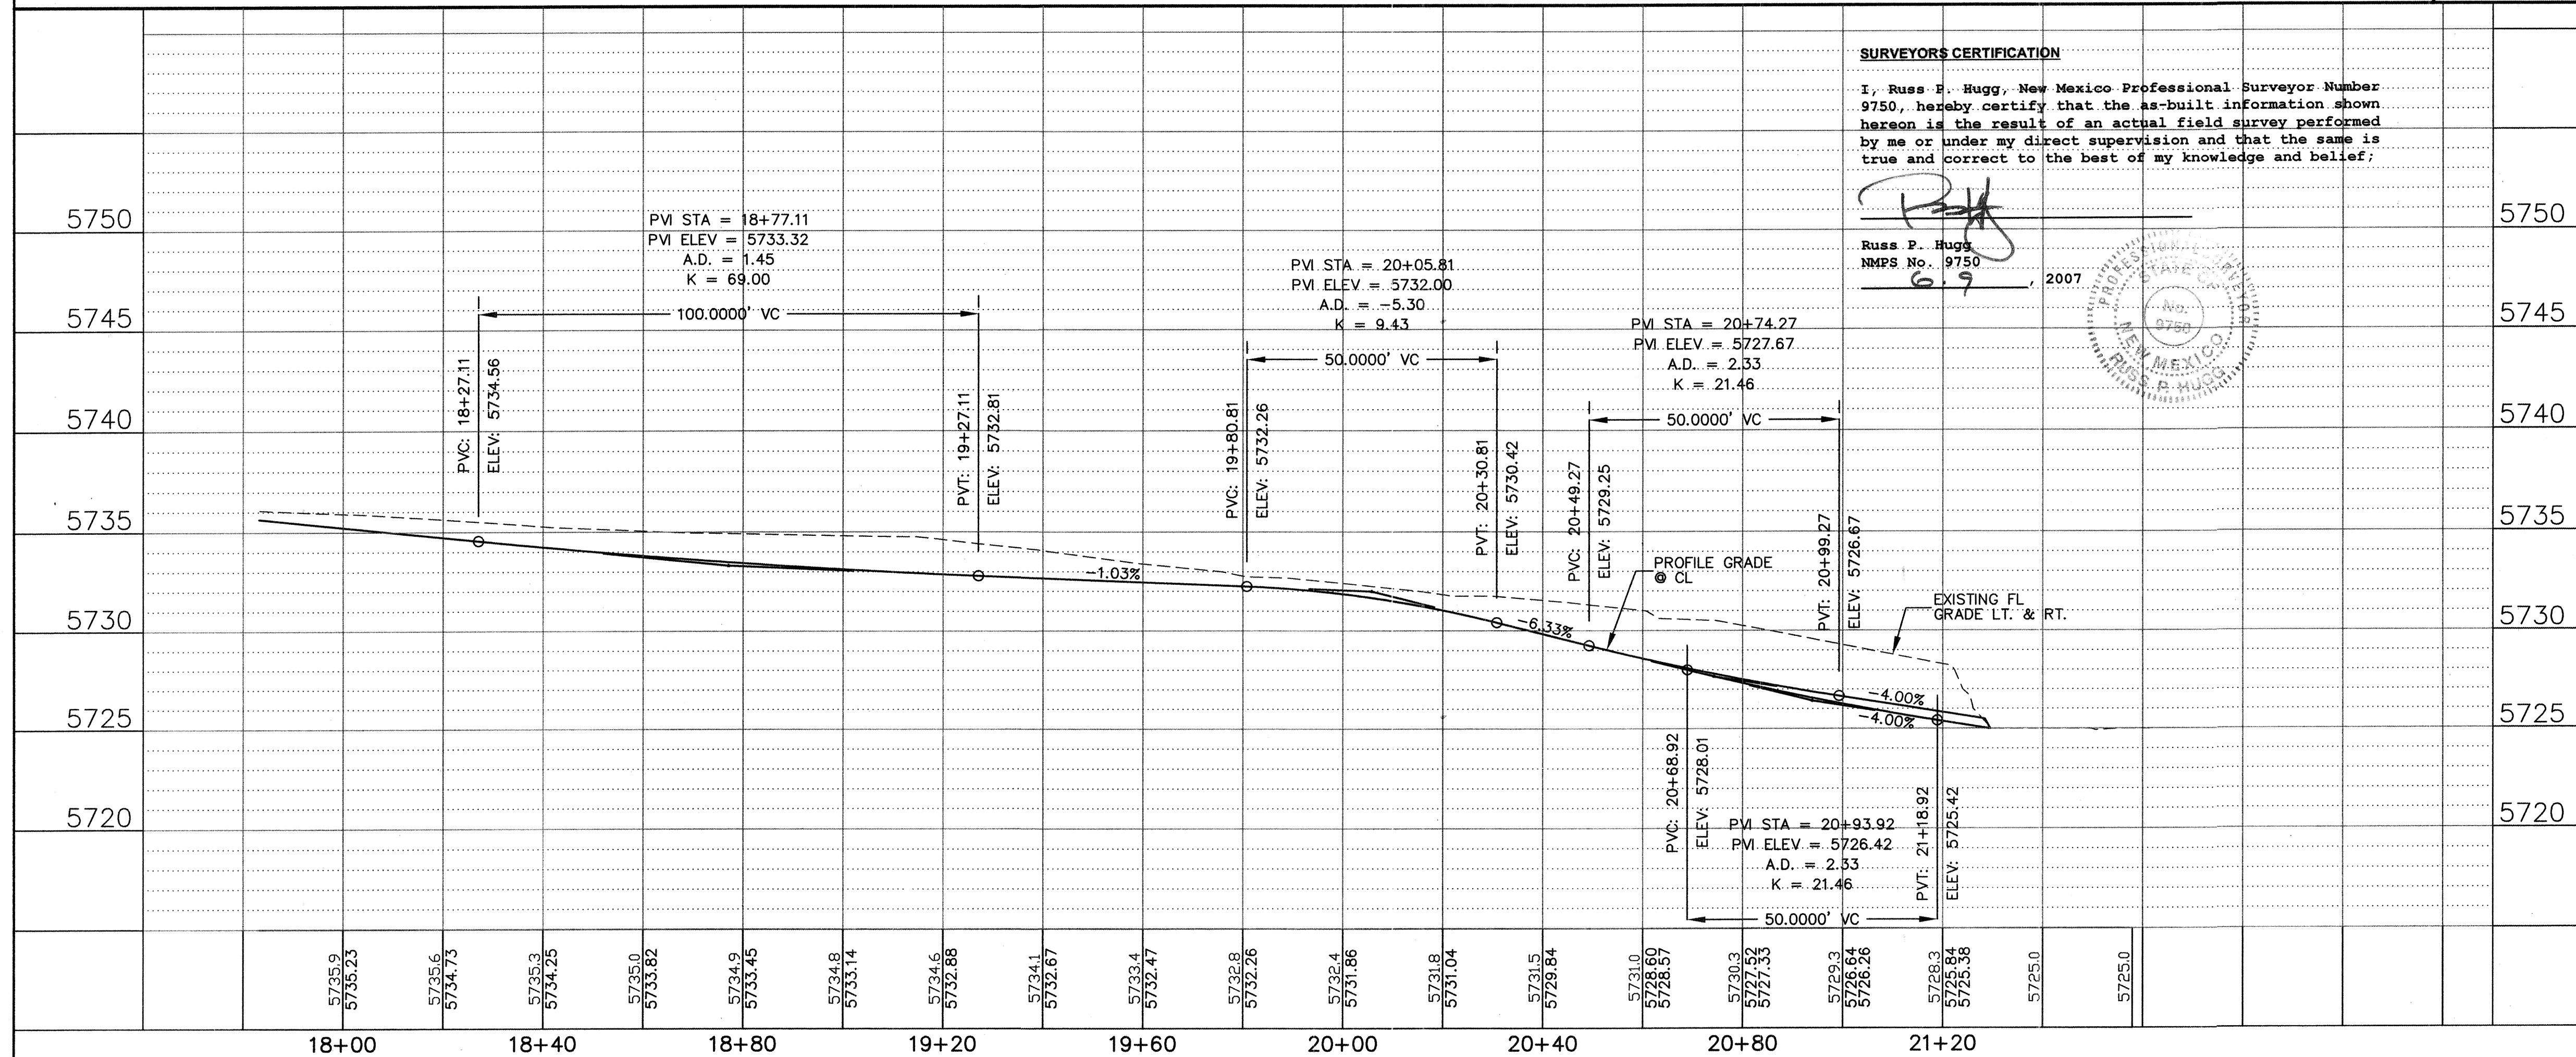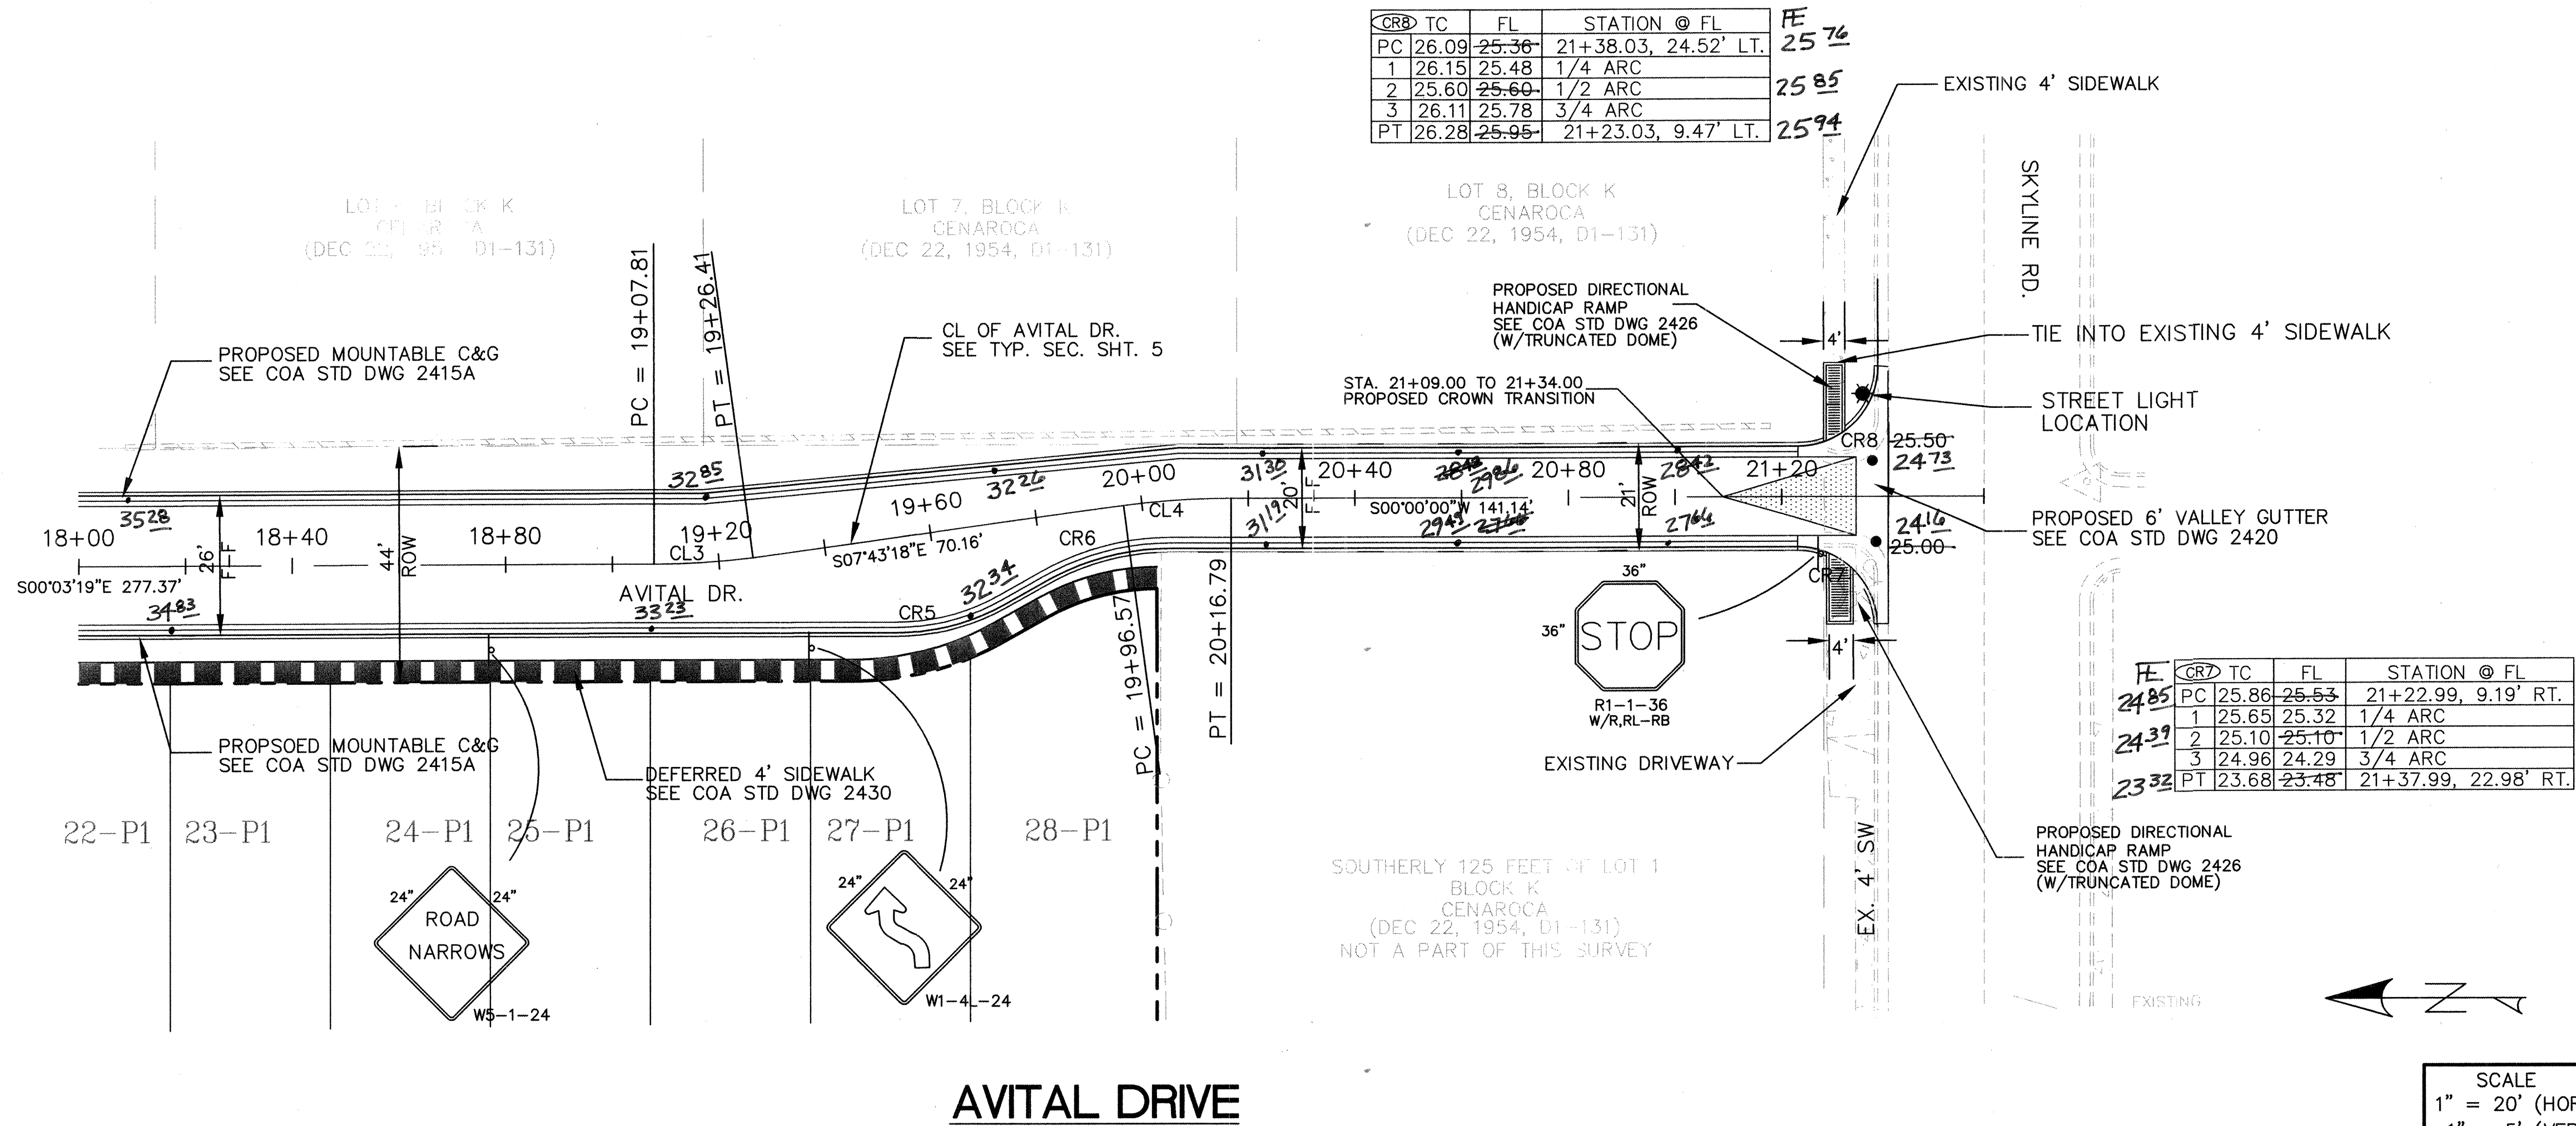

<u>CURVE #</u>	<u>DELTA</u>	<u>RADIUS</u>	<u>TAN</u>	<u>LENGTH</u>
CL3	07°06'29"	150.00'	9.32'	18.61'
CL4	07°43'18"	150.00'	10.12'	20.22'

<u>CURVE #</u>	<u>DELTA</u>	<u>RADIUS</u>	<u>TAN</u>	<u>LENGTH</u>
CR5	29°14'38"	42.00'	10.96'	21.44'
CR6	29°17'55"	48.00'	12.55'	24.55'
CR7	89°58'43"	15.00'	14.99'	23.56'
CR8	90°11'46"	15.00'	15.05'	23.61'

LEGEND

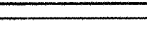- 
PROPOSED STORM DRAIN
- 
PROPOSED STORM DRAIN MANHOLE
- 
PROPOSED STORM INLETS
- 
PROPOSED STREET LIGHT LOCATION
- 
CENTERLINE OF STREET
- 
PROPOSED PROPERTY BOUNDARY
- 
PROPOSED MOUNTABLE CURB & GUTTER
 SEE COA STD DWG 2415A
- 
PROPOSED STANDARD CURB & GUTTER
 SEE COA STD DWG 2415A
- 
DEFERRED SIDEWALK
 SEE COA STD DWG 2430
- 
PROPOSED SIDEWALK
 SEE COA STD DWG 2430
- 
PROPOSED VALLEY GUTTER
 SEE COA STD DWG 2420
- 
PROPOSED CROWN TO NO CROWN TRANSITION
 SEE COA STD DWG 2401
- 
PROPOSED HANDICAP RAMP CASE II (W/TRUNCATED DOME)
 SEE COA STD DWG 2441
- 
EXISTING CURB & GUTTER
- 
EXISTING WALL



Thompson
Engineering
Consultants, Inc.
tecncm@yahoo.com

P.O. BOX 65760 PHONE: (505) 271-2199
ALBUQUERQUE, NM 87193 FAX: (505) 830-9428

CITY OF ALBUQUERQUE
PUBLIC WORKS DEPARTMENT
TRANSPORTATION DEVELOPMENT

AVITAL DRIVE PAVING PLAN AND PROFILE BLUFFS AT ENCANTADO



DESIGN REVIEW COMMITTEE
OCT 10 1999
DESIGN REVIEW COMMITTEE

CITY ENGINEER APPROVAL

APPROVED

NOV 17 2006


CITY ENGINEER

MO./DAY/YR.	MO./DAY/YR.

City Project No.	790281
------------------	--------

Zone Map No.
L & K-23-Z


Sheet	Of
10	16

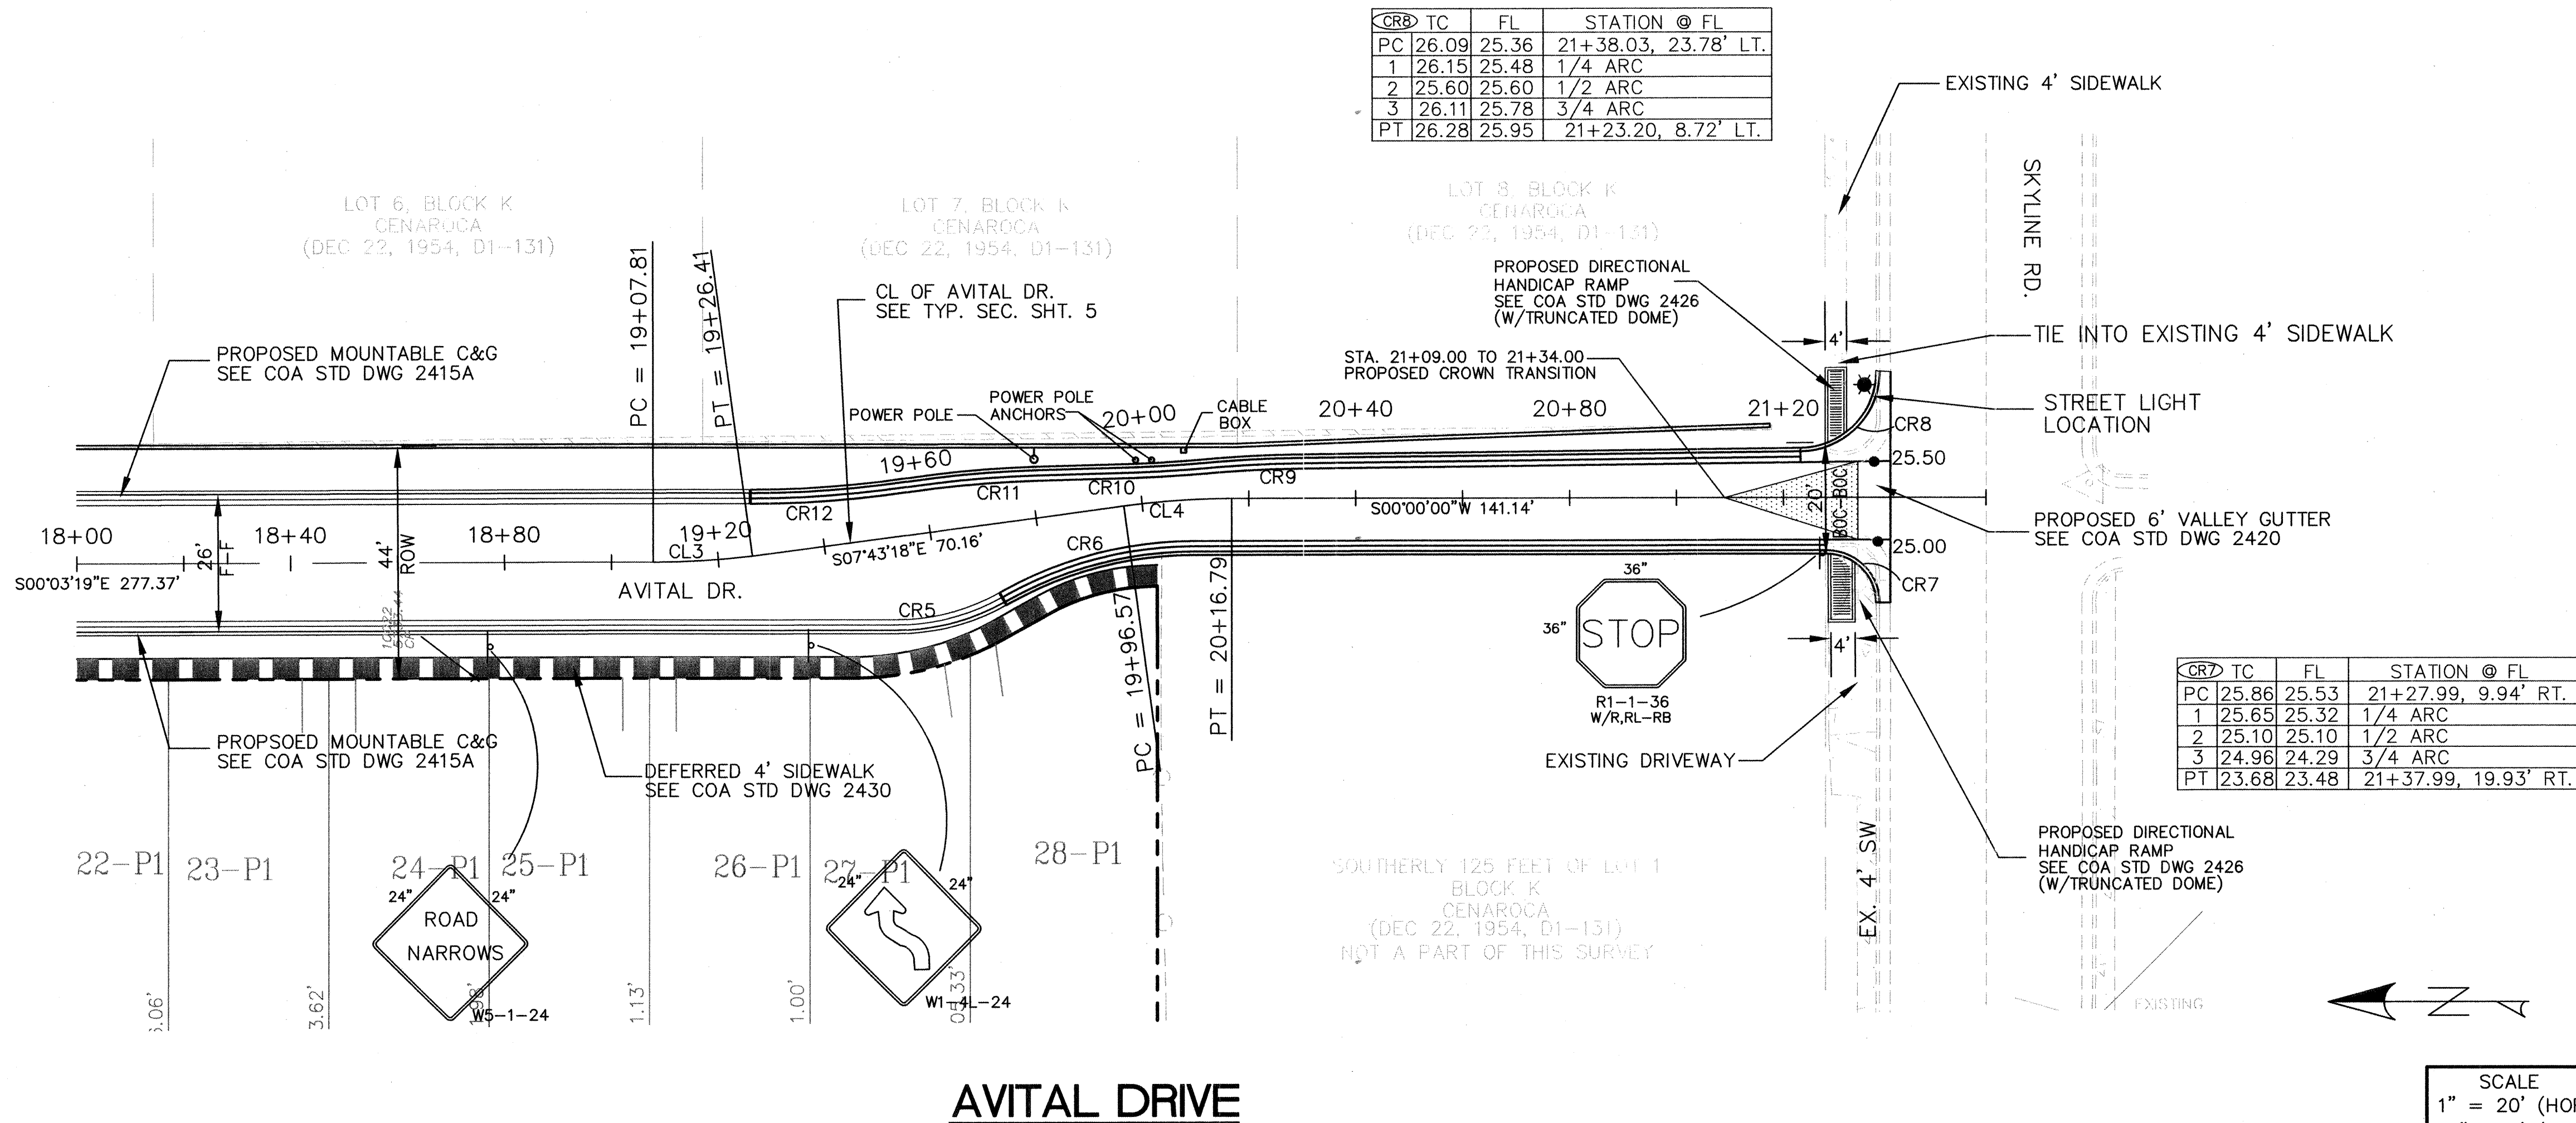

CURVE #	DELTA	RADIUS	TAN	LENGTH
CL3	07°06'29"	150.00'	9.32'	18.61'
CL4	07°43'18"	150.00'	10.12'	20.22'

CURVE #	DELTA	RADIUS	TAN	LENGTH
CR5	29°14'38"	42.00'	10.96'	21.44'
CR6	29°16'10"	70.00'	18.28'	35.76'
CR7	89°58'43"	15.00'	14.99'	23.56'
CR8	90°11'46"	15.00'	15.05'	23.61'
CR9	03°55'13"	200.00'	6.85'	13.68'
CR10	03°00'55"	200.00'	5.26'	10.53'
CR11	07°01'56"	200.00'	12.29'	24.55'
CR12	08°32'04"	200.00'	14.92'	29.79'

- LEGEND**
- PROPOSED STORM DRAIN
 - PROPOSED STORM DRAIN MANHOLE
 - PROPOSED STORM INLETS
 - PROPOSED STREET LIGHT LOCATION
 - CENTERLINE OF STREET
 - PROPOSED PROPERTY BOUNDARY
 - PROPOSED MOUNTABLE CURB & GUTTER SEE COA STD DWG 2415A
 - PROPOSED STANDARD CURB & GUTTER SEE COA STD DWG 2415A
 - DEFERRED SIDEWALK SEE COA STD DWG 2430
 - PROPOSED SIDEWALK SEE COA STD DWG 2430
 - PROPOSED VALLEY GUTTER SEE COA STD DWG 2420
 - PROPOSED CROWN TO NO CROWN TRANSITION SEE COA STD DWG 2401
 - PROPOSED HANDICAP RAMP CASE II (W/TRUNCATED DOME) SEE COA STD DWG 2441
 - EXISTING CURB & GUTTER
 - EXISTING WALL

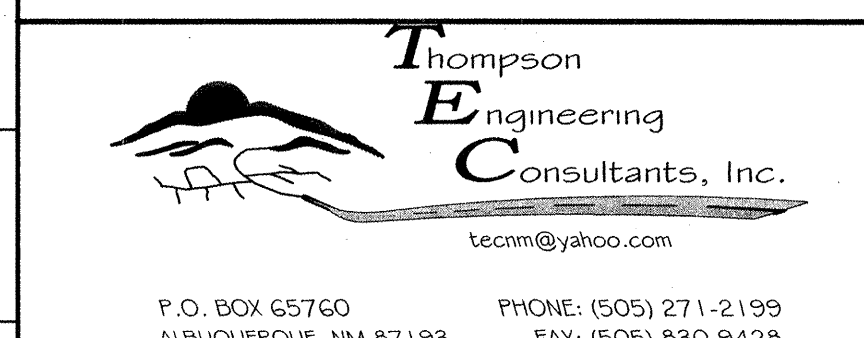




**CITY OF ALBUQUERQUE
PUBLIC WORKS DEPARTMENT
TRANSPORTATION DEVELOPMENT**

**AVITAL DRIVE PAVING PLAN AND PROFILE
BLUFFS AT ENCANTADO**

DESIGN REVIEW COMMITTEE	CITY ENGINEER APPROVAL	MO./DAY/YR.	MO./DAY/YR.



City Project No. 790281 Zone Map No. L & K-23-Z Sheet 10a Of 16

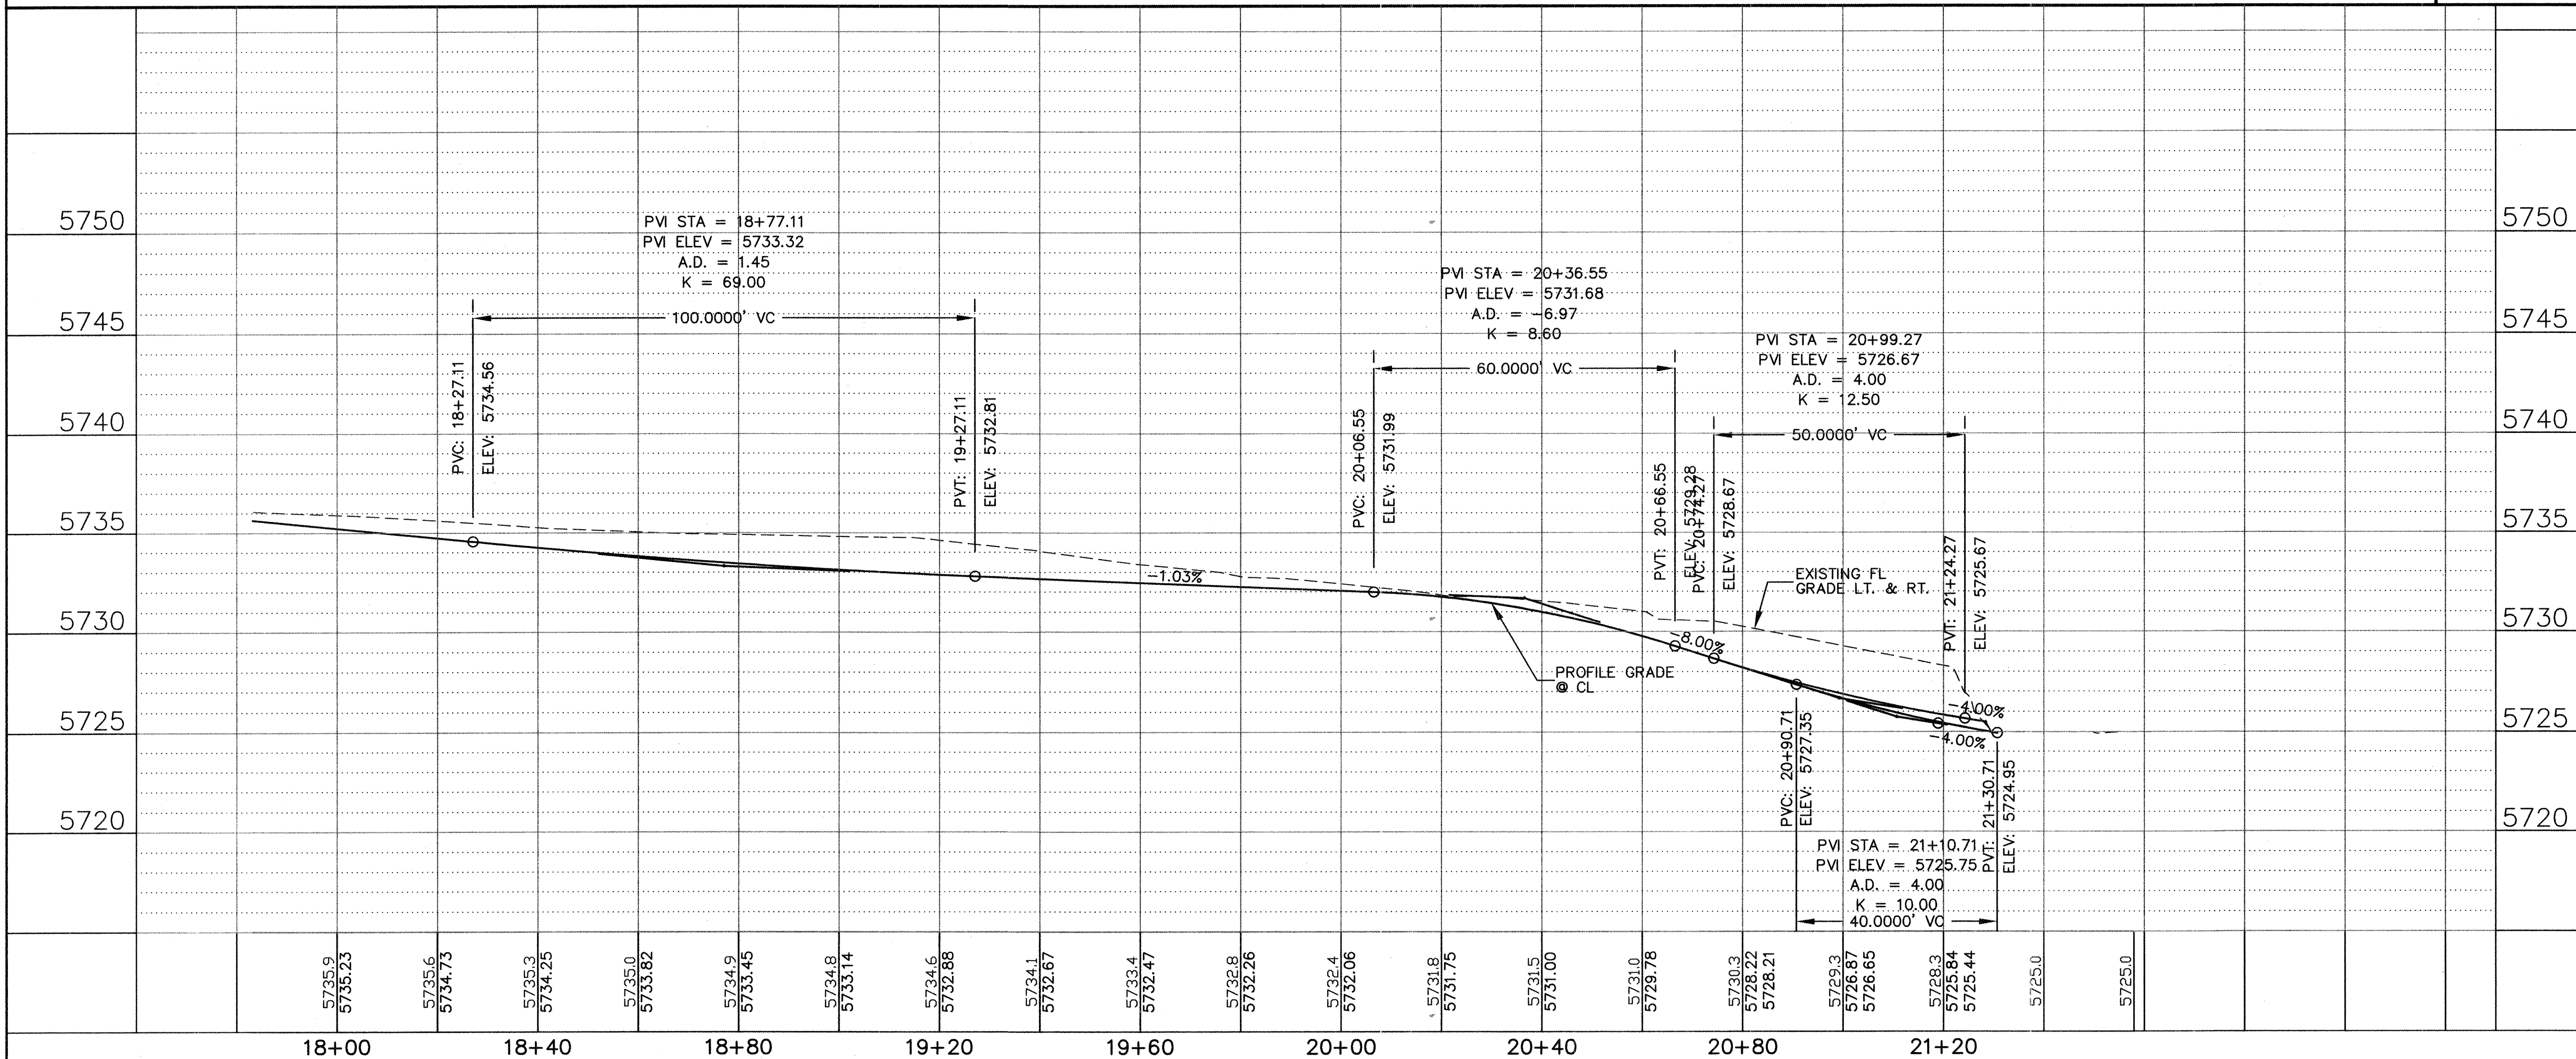

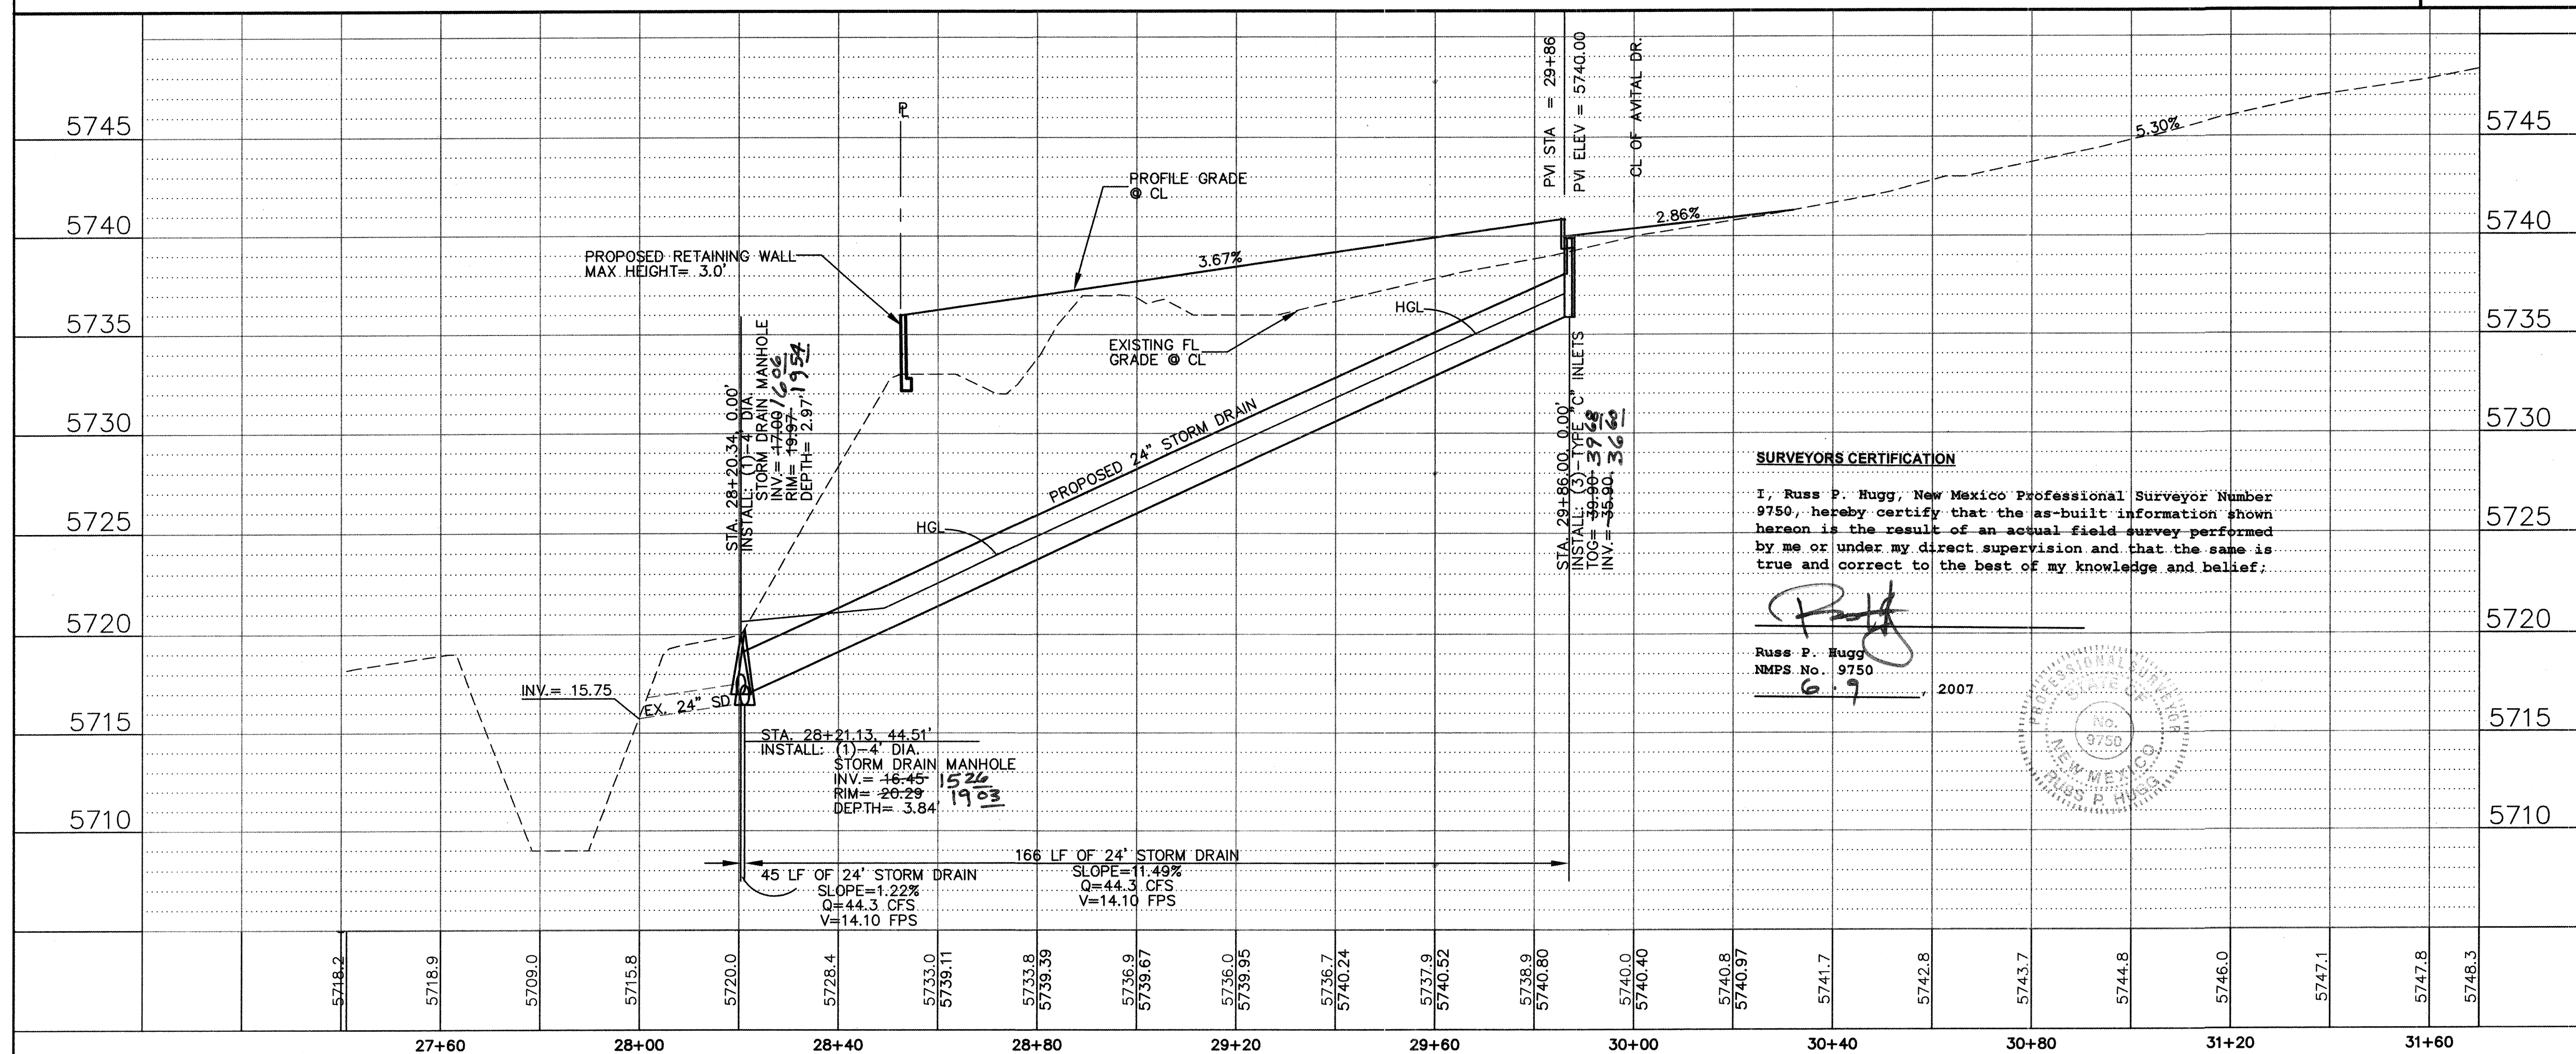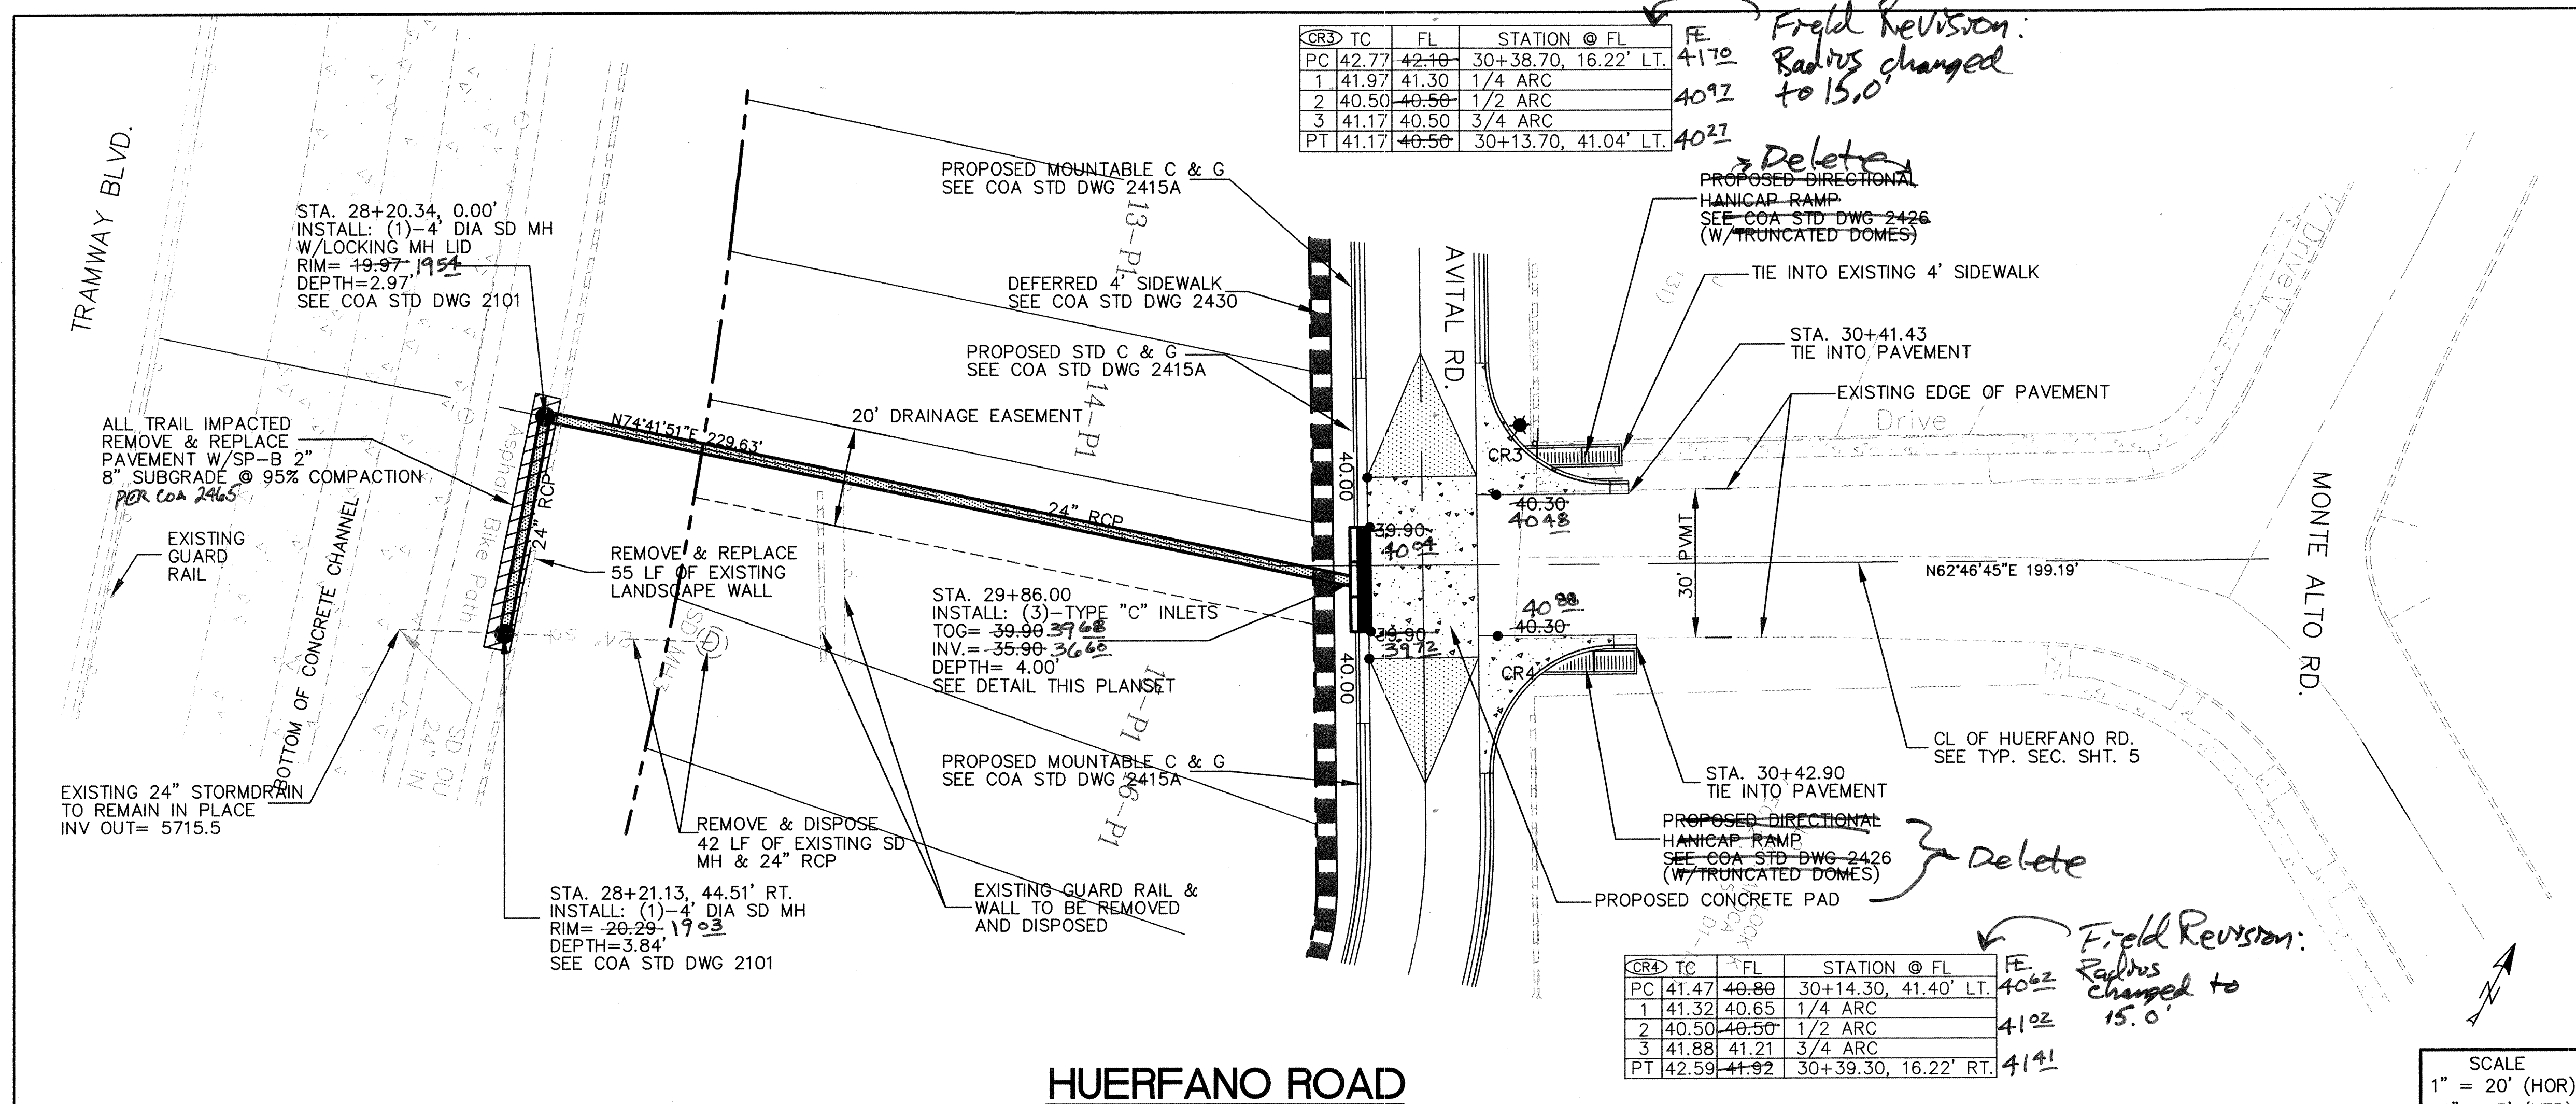

<u>CURVE #</u>	<u>DELTA</u>	<u>RADIUS</u>	<u>TAN</u>	<u>LENGTH</u>
CR3	89°34'56"	25.00'	24.82'	39.09'
CR4	90°25'04"	25.00'	25.18'	39.45'

 LEGEND

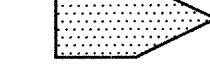- | | |
|---|--|
|  | PROPOSED STORM DRAIN |
|  | PROPOSED STORM DRAIN MANHOLE |
|  | PROPOSED STORM INLETS |
|  | PROPOSED STREET
LIGHT LOCATION |
|  | CENTERLINE OF STREET |
|  | PROPOSED PROPERTY BOUNDARY |
|  | PROPOSED MOUNTABLE CURB & GUTTER
SEE COA STD DWG 2415A |
|  | PROPOSED STANDARD CURB & GUTTER
SEE COA STD DWG 2415A |
|  | DEFERRED SIDEWALK
SEE COA STD DWG 2430 |
|  | PROPOSED SIDEWALK
SEE COA STD DWG 2430 |
|  | PROPOSED VALLEY GUTTER
SEE COA STD DWG 2420 |
|  | PROPOSED CROWN TO
NO CROWN TRANSITION
SEE COA STD DWG 2401 |
|  | PROPOSED HANDICAP RAMP
CASE II (TRUNCATED DOME)
SEE COA STD DWG 2441 |
|  | EXISTING CURB & GUTTER |
|  | EXISTING WALL |



Thompson
Engineering
Consultants, Inc.

tecnm@yahoo.com

P.O. BOX 65760
ALBUQUERQUE, NM 87193

CITY OF ALBUQUERQUE
PUBLIC WORKS DEPARTMENT
TRANSPORTATION DEVELOPMENT

HUERFANO ROAD PAVING PLAN AND PROFILE BLUFFS AT ENCANTADO

DESIGN REVIEW COMMITTEE
APPROVED
OCT 10 1964
DESIGN
REVIEW COMMITTEE


CITY ENGINEER APPROVAL
APPROVE
NOV 17 2006
CITY ENGINEER

MO./DAY/YR.	MO./DAY/YR.

City Project No.
790281

Zone Map No.
L & K-23-Z

Sheet	Of
11	16

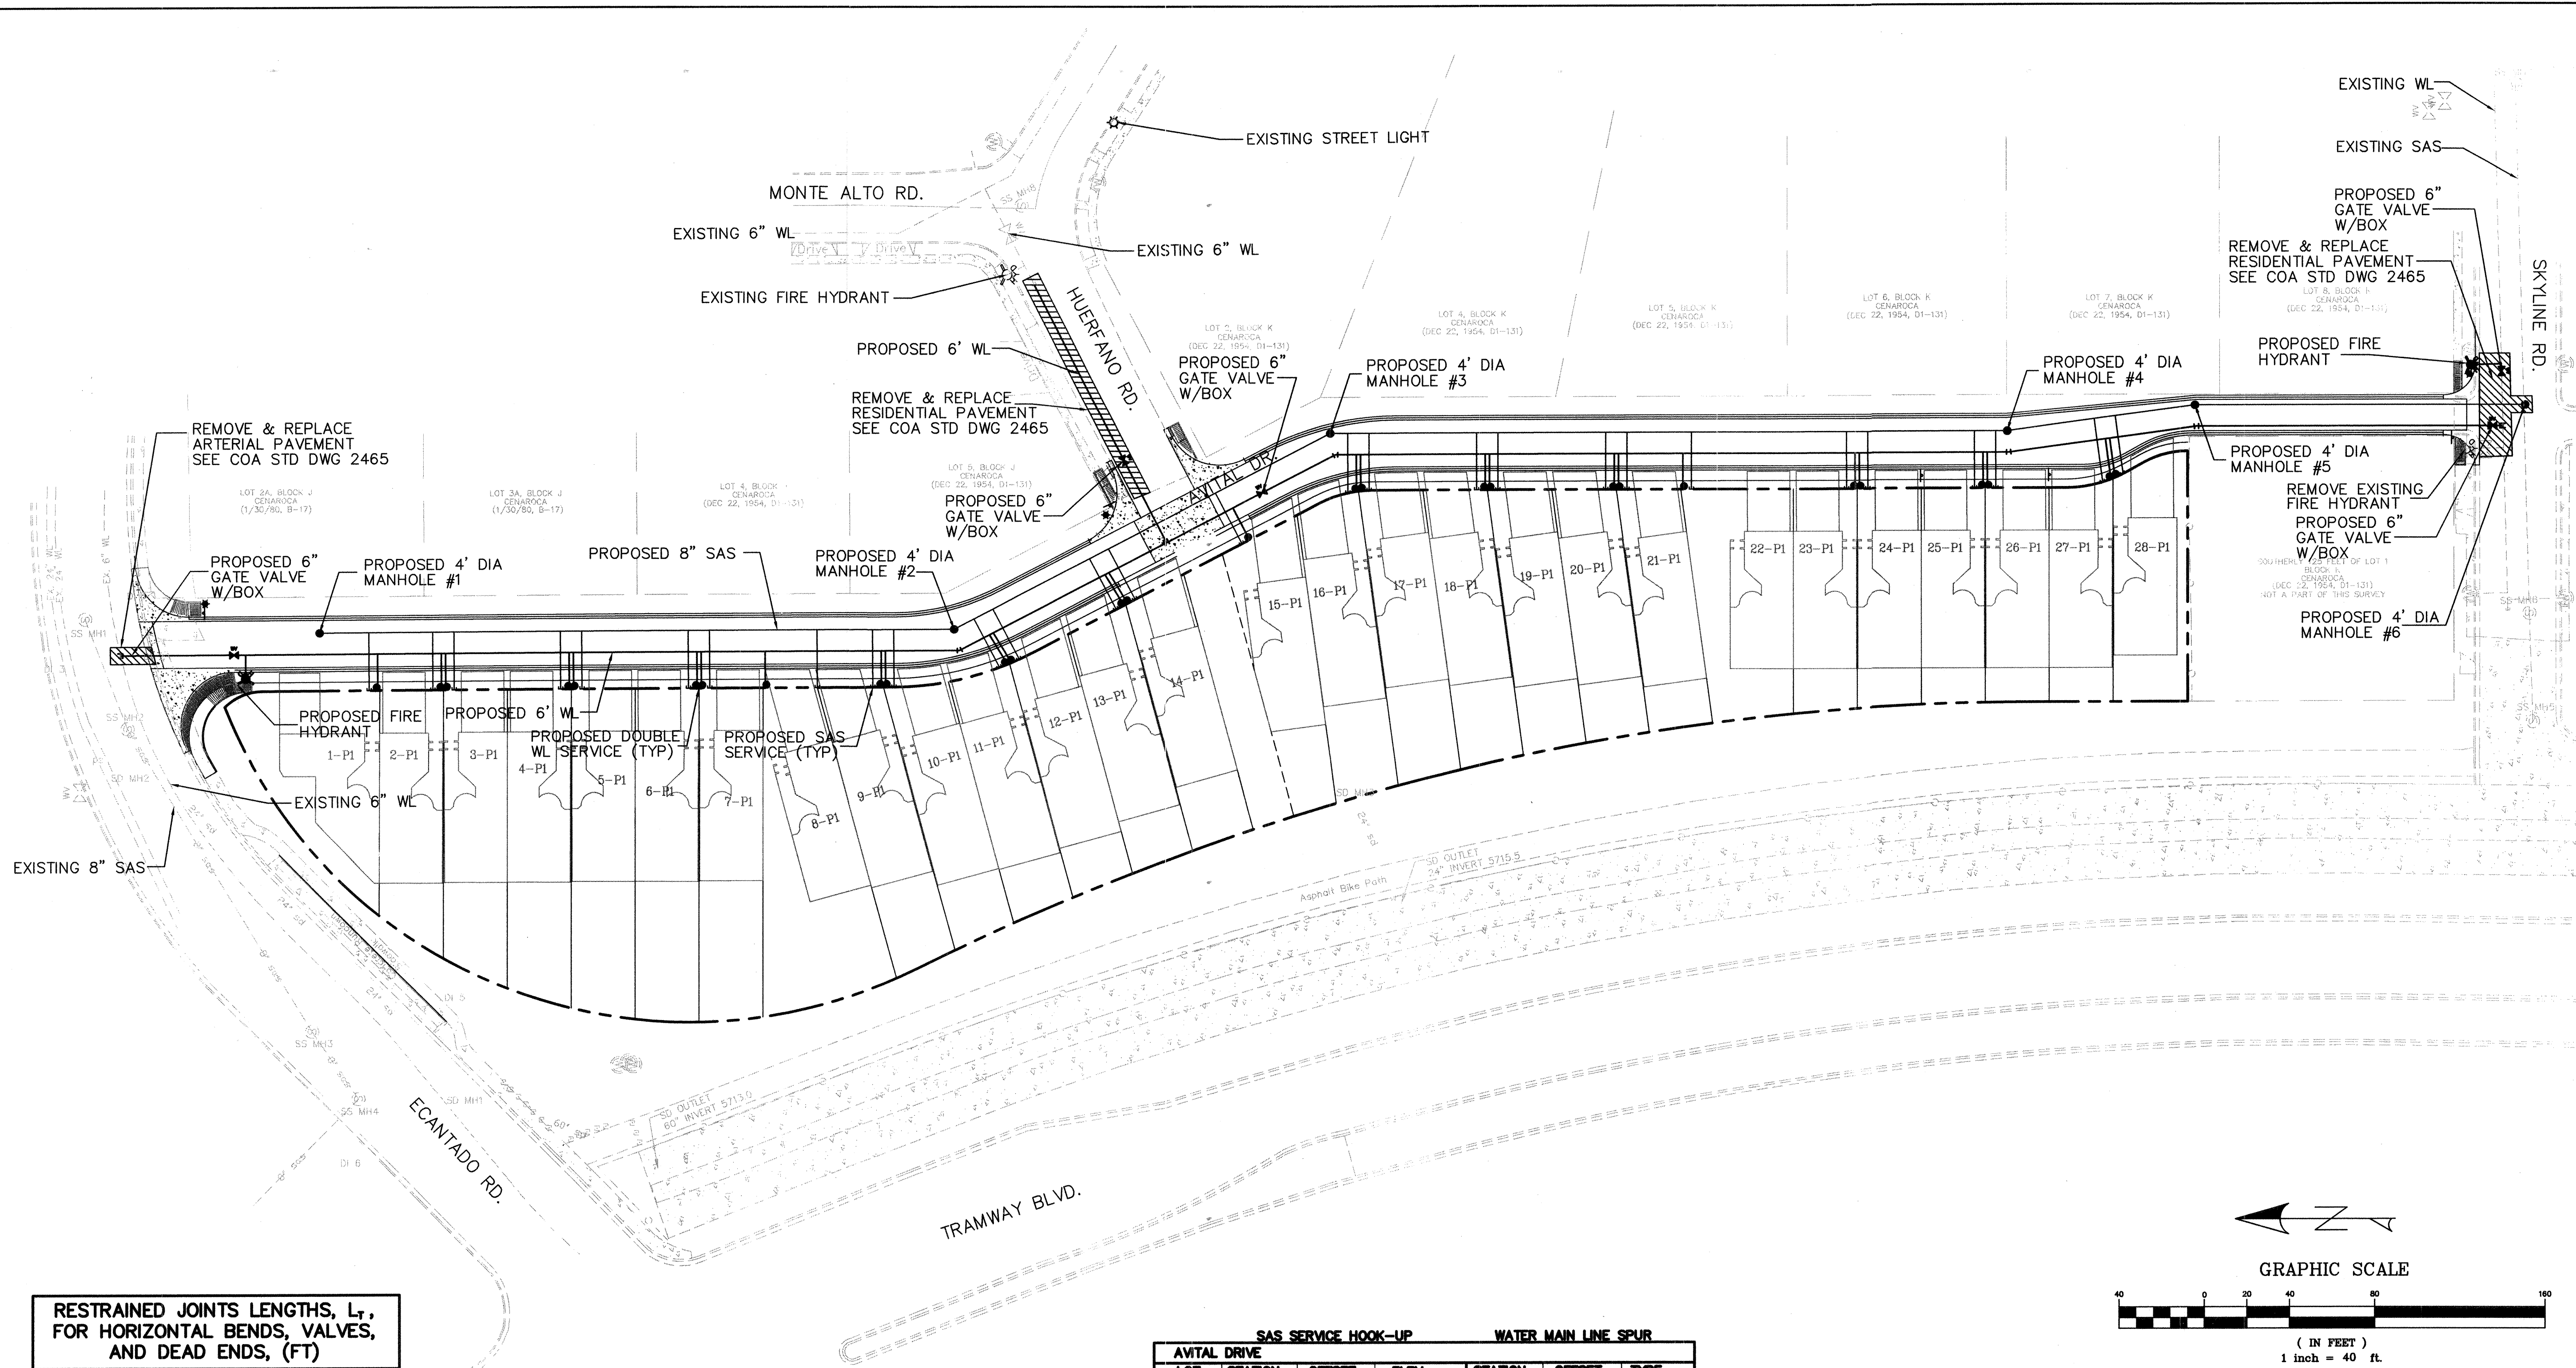

RESTRAINED JOINTS LENGTHS, L_T, FOR HORIZONTAL BENDS, VALVES, AND DEAD ENDS, (FT)

SIZE	VERT. BENDS			
	HIGH END	LOW END	HIGH END	LOW END
8"	27	5	10	1

RESTRAINED JOINTS LENGTHS, L_T, FOR HORIZONTAL BENDS, VALVES, AND DEAD ENDS, (FT)

SIZE	HORZ. BENDS			
	90°	45°	22 1/2°	11 1/4°
8	22	9	4	2
6	17	7	3	2
4	12	5	2	1

RESTRAINED JOINTS LENGTHS, L_T, FOR REDUCERS, (FT.)

SIZE	RUN	BRANCH
8x8x8	9	20
8x8x6	5	17
8x8x4	2	15
6x6x6	6	20
6x6x4	2	20


UTILITY NOTES:

- CONTRACTOR RESPONSIBLE FOR LOCATION OF ALL EXISTING UTILITIES PRIOR TO WORK.
- PROPOSED 6" & 8" WL HAS 3" MIN. COVER
- ALL PROPOSED MANHOLE LIDS TO MATCH WITH PROPOSED PAVEMENT
- CITY STANDARDS TO BE USED ON ALL UTILITIES UNLESS OTHERWISE NOTED.
- ELECTRONIC MARKER DISCS (EMD'S) MUST BE INSTALLED ON WATER LINE AND SANITARY SEWER LINE APPURTENANCES AS PER CITY SPEC. SECTION 170.
- ALL WATER SERVICE LINES AND WATER METERS SHALL BE 3/4".
- ALL METER BOXES LID SHALL BE HEAVY WEIGHT/TRAFFIC BEARING.
- WATER SHUT-OFF PLAN SEE SHEET 3 OF THIS PLANSET.
- ALL SEWERS SERVICES SHALL BE 4" DIA.

SAS SERVICE HOOK-UP				WATER MAIN LINE SPUR			
LOT	STATION	OFFSET	ELEV.	STATION	OFFSET	TYPE	
1	11+27.92	22.00 RT.	37.73	11+31.92	22.00 RT.	SINGLE	
2	11+57.89	22.00 RT.	37.40	11+61.88	22.00 RT.	SINGLE	
3	11+67.89	22.00 RT.	37.29	11+63.88	22.00 RT.	SINGLE	
4	12+17.85	22.00 RT.	36.74	12+21.85	22.00 RT.	SINGLE	
5	12+27.85	22.00 RT.	36.63	12+23.85	22.00 RT.	SINGLE	
6	12+77.85	22.00 RT.	36.08	12+81.85	22.00 RT.	SINGLE	
7	12+87.85	22.00 RT.	35.97	12+83.85	22.00 RT.	SINGLE	
8	13+38.33	22.00 RT.	35.42	13+13.85	22.00 RT.	SINGLE	
9	13+64.39	22.00 RT.	35.14	13+68.39	22.00 RT.	SINGLE	
10	13+74.39	22.00 RT.	35.03	13+70.39	22.00 RT.	SINGLE	
11	14+17.22	22.00 RT.	34.62	14+20.61	22.00 RT.	SINGLE	
12	14+25.71	22.00 RT.	34.56	14+22.33	22.00 RT.	SINGLE	
13	14+75.85	22.00 RT.	34.24	14+79.85	22.00 RT.	SINGLE	
14	14+85.85	22.00 RT.	34.18	14+81.86	22.00 RT.	SINGLE	
15	15+42.51	22.00 RT.	33.82	15+46.51	22.00 RT.	SINGLE	
16	16+03.08	20.67 RT.	33.46	16+07.99	20.79 RT.	SINGLE	
17	16+15.27	21.23 RT.	33.27	16+10.42	20.90 RT.	SINGLE	
18	16+68.47	22.00 RT.	32.45	16+72.47	22.00 RT.	SINGLE	
19	16+78.47	22.00 RT.	32.29	16+74.47	22.00 RT.	SINGLE	
20	17+29.01	22.00 RT.	31.50	17+33.01	22.00 RT.	SINGLE	
21	17+39.01	22.00 RT.	31.34	17+35.01	22.00 RT.	SINGLE	
22	17+69.28	22.00 RT.	30.08	17+65.28	22.00 RT.	SINGLE	
23	18+42.11	22.00 RT.	29.74	18+46.11	22.00 RT.	SINGLE	
24	18+52.11	22.00 RT.	29.58	18+48.11	22.00 RT.	SINGLE	
25	19+02.11	22.00 RT.	28.80	19+06.11	22.00 RT.	SINGLE	
26	19+11.56	22.05 RT.	28.65	19+08.07	22.00 RT.	SINGLE	
27	19+59.29	25.16 RT.	28.09	19+63.29	24.34 RT.	SINGLE	
28	19+69.29	22.53 RT.	27.89	19+65.29	23.82 RT.	SINGLE	

LEGEND

- EXISTING SAS MANHOLE
- EXISTING WATER VALVE
- EXISTING FIRE HYDRANT
- EXISTING STORM DRAIN MANHOLE
- EXISTING WATER LINE
- EXISTING SAS LINE
- PROPOSED SANITARY SEWER
- PROPOSED SAS MANHOLE PER COA STD DWG 2102
- PROPOSED SANITARY SEWER SERVICE LINE PER COA STD DWGS
- PROPOSED WATER LINE
- PROPOSED FIRE HYDRANT PER COA STD DWG 2340
- PROPOSED GATE VALVE PER COA STD DWGS
- PROPOSED CROSS, TEE, OR ELBOW PER COA STD DWGS
- PROPOSED SINGLE METER, WATER SERVICE LINE PER COA STD DWGS

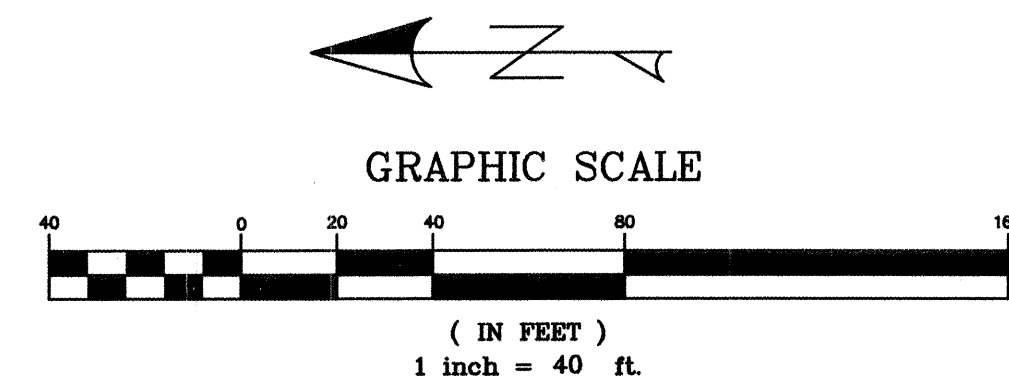

Tompson Engineering Consultants, Inc.
P.O. BOX 65760 ALBUQUERQUE, NM 87193
PHONE: (505) 271-2199 FAX: (505) 830-9428
tccm@yahoo.com


CITY OF ALBUQUERQUE PUBLIC WORKS DEPARTMENT TRANSPORTATION DEVELOPMENT

OVERALL UTILITY PLAN AND PROFILE BLUFFS AT ENCANTADO

DESIGN REVIEW COMMITTEE	CITY ENGINEER APPROVAL	MO./DAY/YR.	MO./DAY/YR.
DESIGN REVIEW COMMITTEE	CITY ENGINEER		

City Project No. 790281 Zone Map No. K & L-23-Z Sheet 12 Of 16


AS BUILT INFORMATION		BENCH MARKS		SURVEY INFORMATION	
CONTRACTOR	DATE	ACS MONUMENT	"21-K23"	FIELD NOTES	DATE
Salisbury Bros. Const.	5/10/06	ACS ELEV. 5708.72			
INSPECTOR'S	DATE	ACS 12" ALUMINUM DISK, STAMPED "ACS			
FIELD	DATE	BM, 21-K23", EPOXYED ON TOP OF THE			
VERIFICATION BY	DATE	CONCRETE CURB, AT THE EAST END OF			
CORRECTED BY	DATE	SKYLINE ROAD NE, 308 FT. ± EAST OF			
MICRO-FILM INFORMATION	DATE	THE CENTERLINE OF PANORAMA PL., ON			
RECORDED BY	DATE	THE CENTERLINE (EXTENDED) OF SKYLINE RD.			

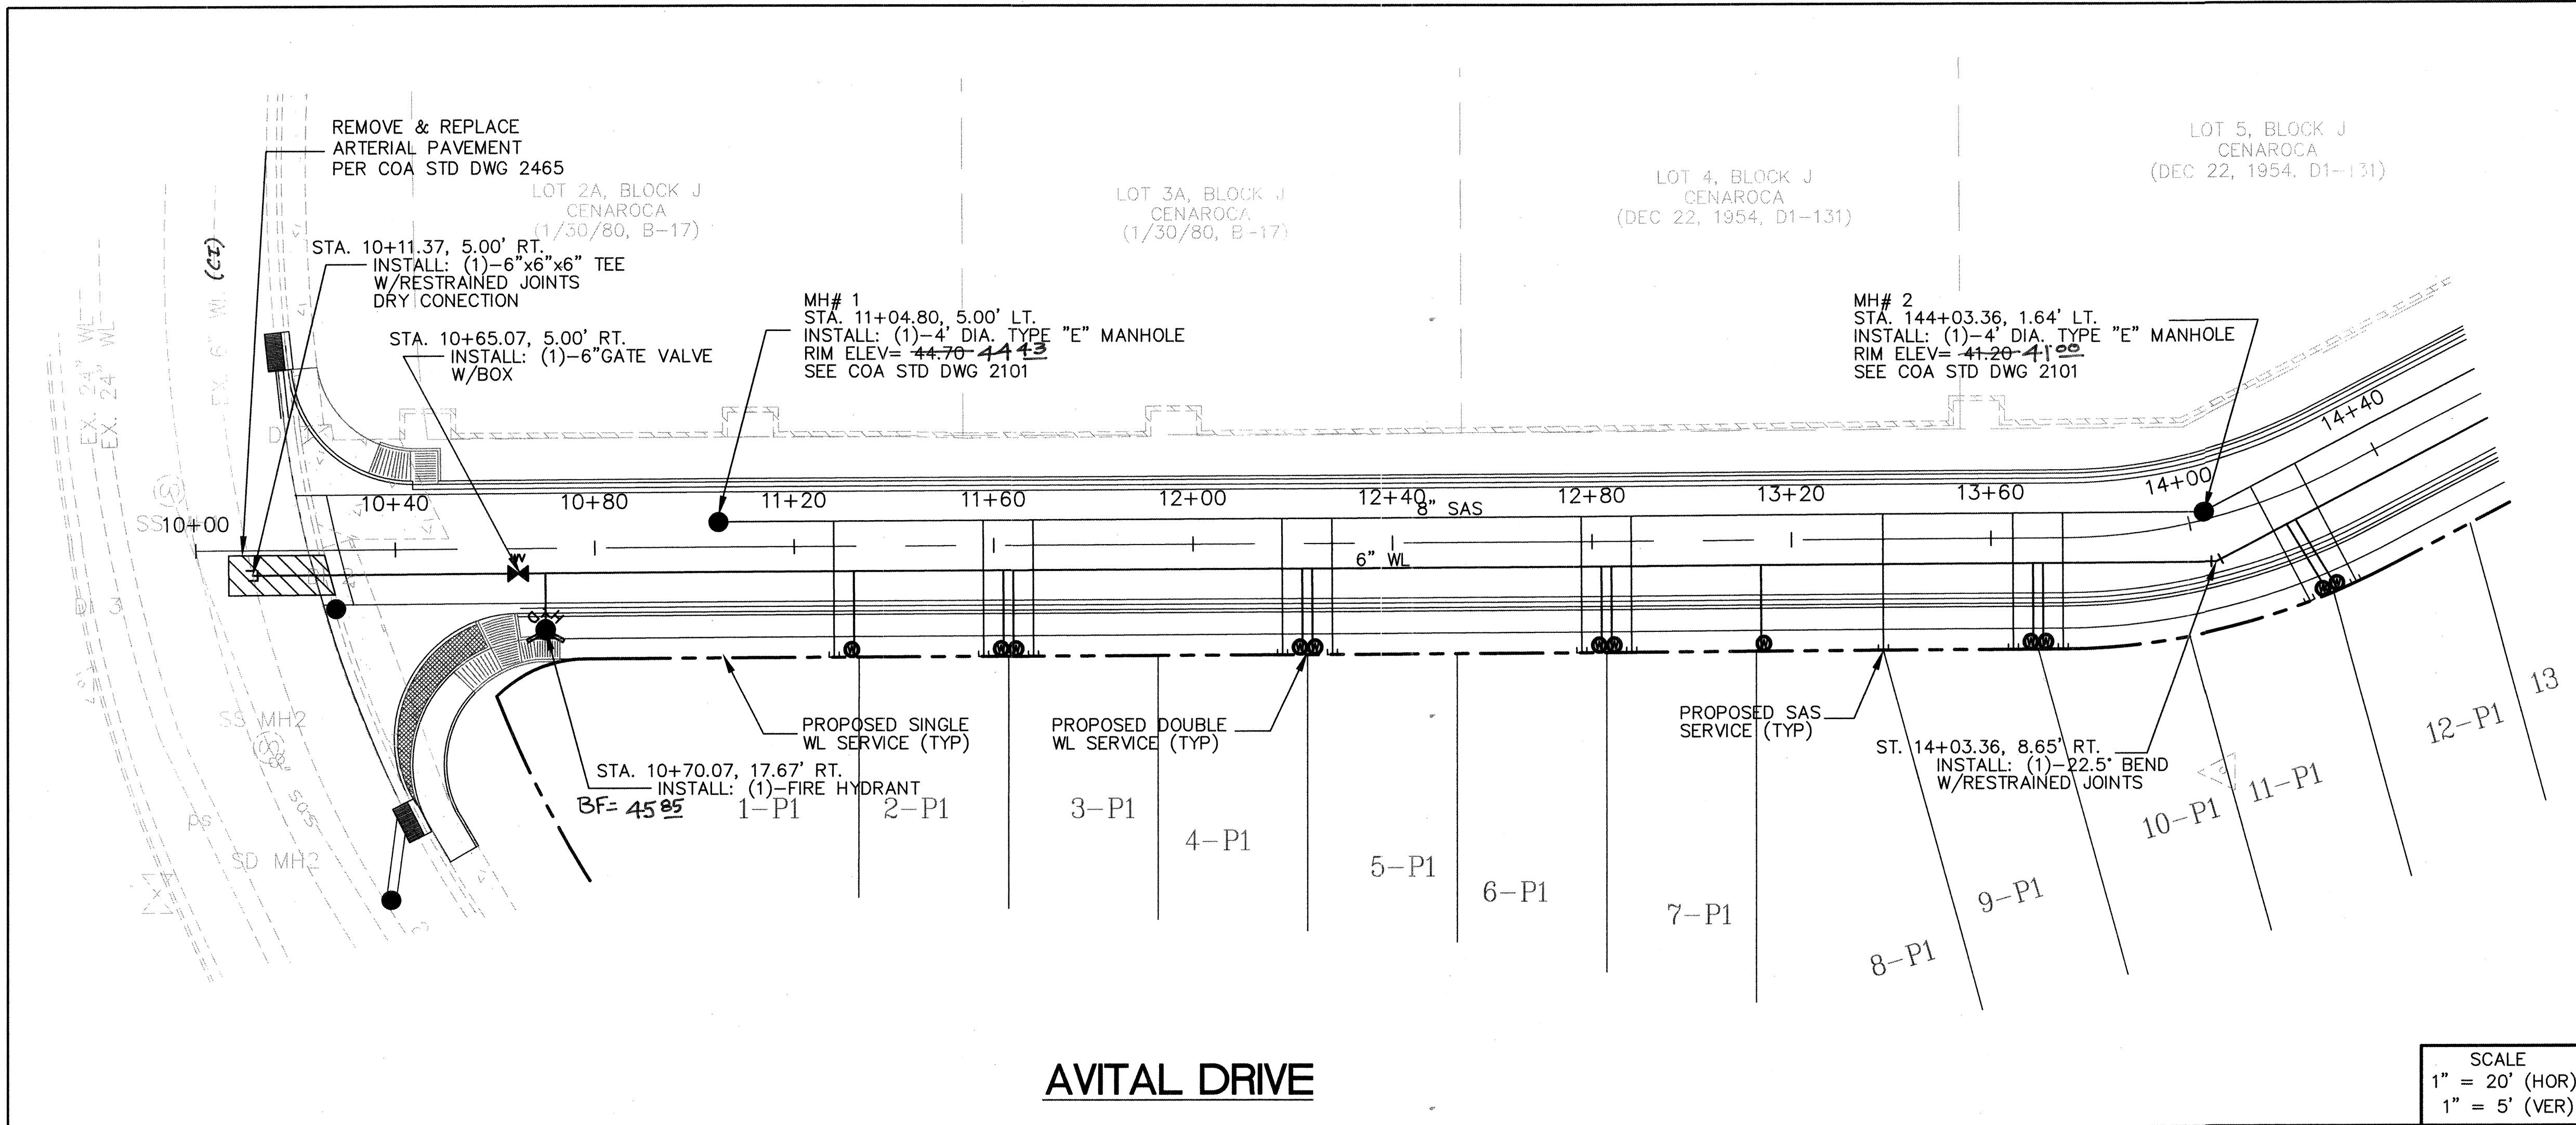

SCALE
1" = 20' (HOR)
1" = 5' (VER)

- LEGEND**
- EXISTING SAS MANHOLE
 - EXISTING WATER VALVE
 - EXISTING FIRE HYDRANT
 - EXISTING STORM DRAIN MANHOLE
 - EXISTING WATER LINE
 - EXISTING SAS LINE
 - PROPOSED SANITARY SEWER
 - PROPOSED SAS MANHOLE PER COA STD DWG 2102
 - PROPOSED SANITARY SEWER SERVICE LINE PER COA STD DWGS
 - PROPOSED WATER LINE
 - PROPOSED FIRE HYDRANT PER COA STD DWG 2340
 - PROPOSED GATE VALVE PER COA STD DWGS
 - PROPOSED CROSS, TEE, OR ELBOW PER COA STD DWGS
 - PROPOSED SINGLE METER, WATER SERVICE LINE PER COA STD DWGS

- UTILITY NOTES:**
- CONTRACTOR RESPONSIBLE FOR LOCATION OF ALL EXISTING UTILITIES PRIOR TO WORK.
 - PROPOSED 6" WL HAS 3' MIN. COVER
 - ALL PROPOSED MANHOLE LIDS TO MATCH WITH PROPOSED PAVEMENT
 - CITY STANDARDS TO BE USED ON ALL UTILITIES UNLESS OTHERWISE NOTED.
 - ALL METER BOXES LID SHALL BE HEAVY WEIGHT.

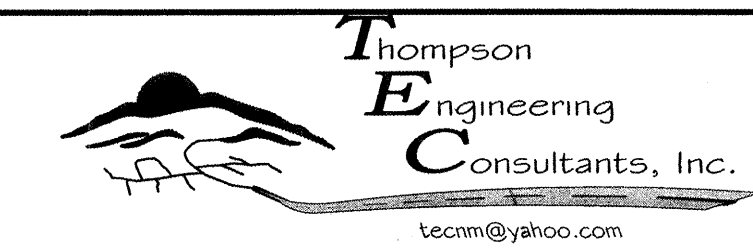



**CITY OF ALBUQUERQUE
PUBLIC WORKS DEPARTMENT
TRANSPORTATION DEVELOPMENT
AVITAL DRIVE UTILITY PLAN AND PROFILE
BLUFFS AT ENCANTADO**



DESIGN REVIEW COMMITTEE	CITY ENGINEER APPROVAL	MO./DAY/YR.	MO./DAY/YR.
City Project No. 790281	Zone Map No. K & L-23-Z	Sheet 13	Of 16

SURVEYORS CERTIFICATION

I, Russ P. Hugg, New Mexico Professional Surveyor Number 9750, hereby certify that the as-built information shown hereon is the result of an actual field survey performed by me or under my direct supervision and that the same is true and correct to the best of my knowledge and belief.

Russ P. Hugg
NMPS No. 9750
2007

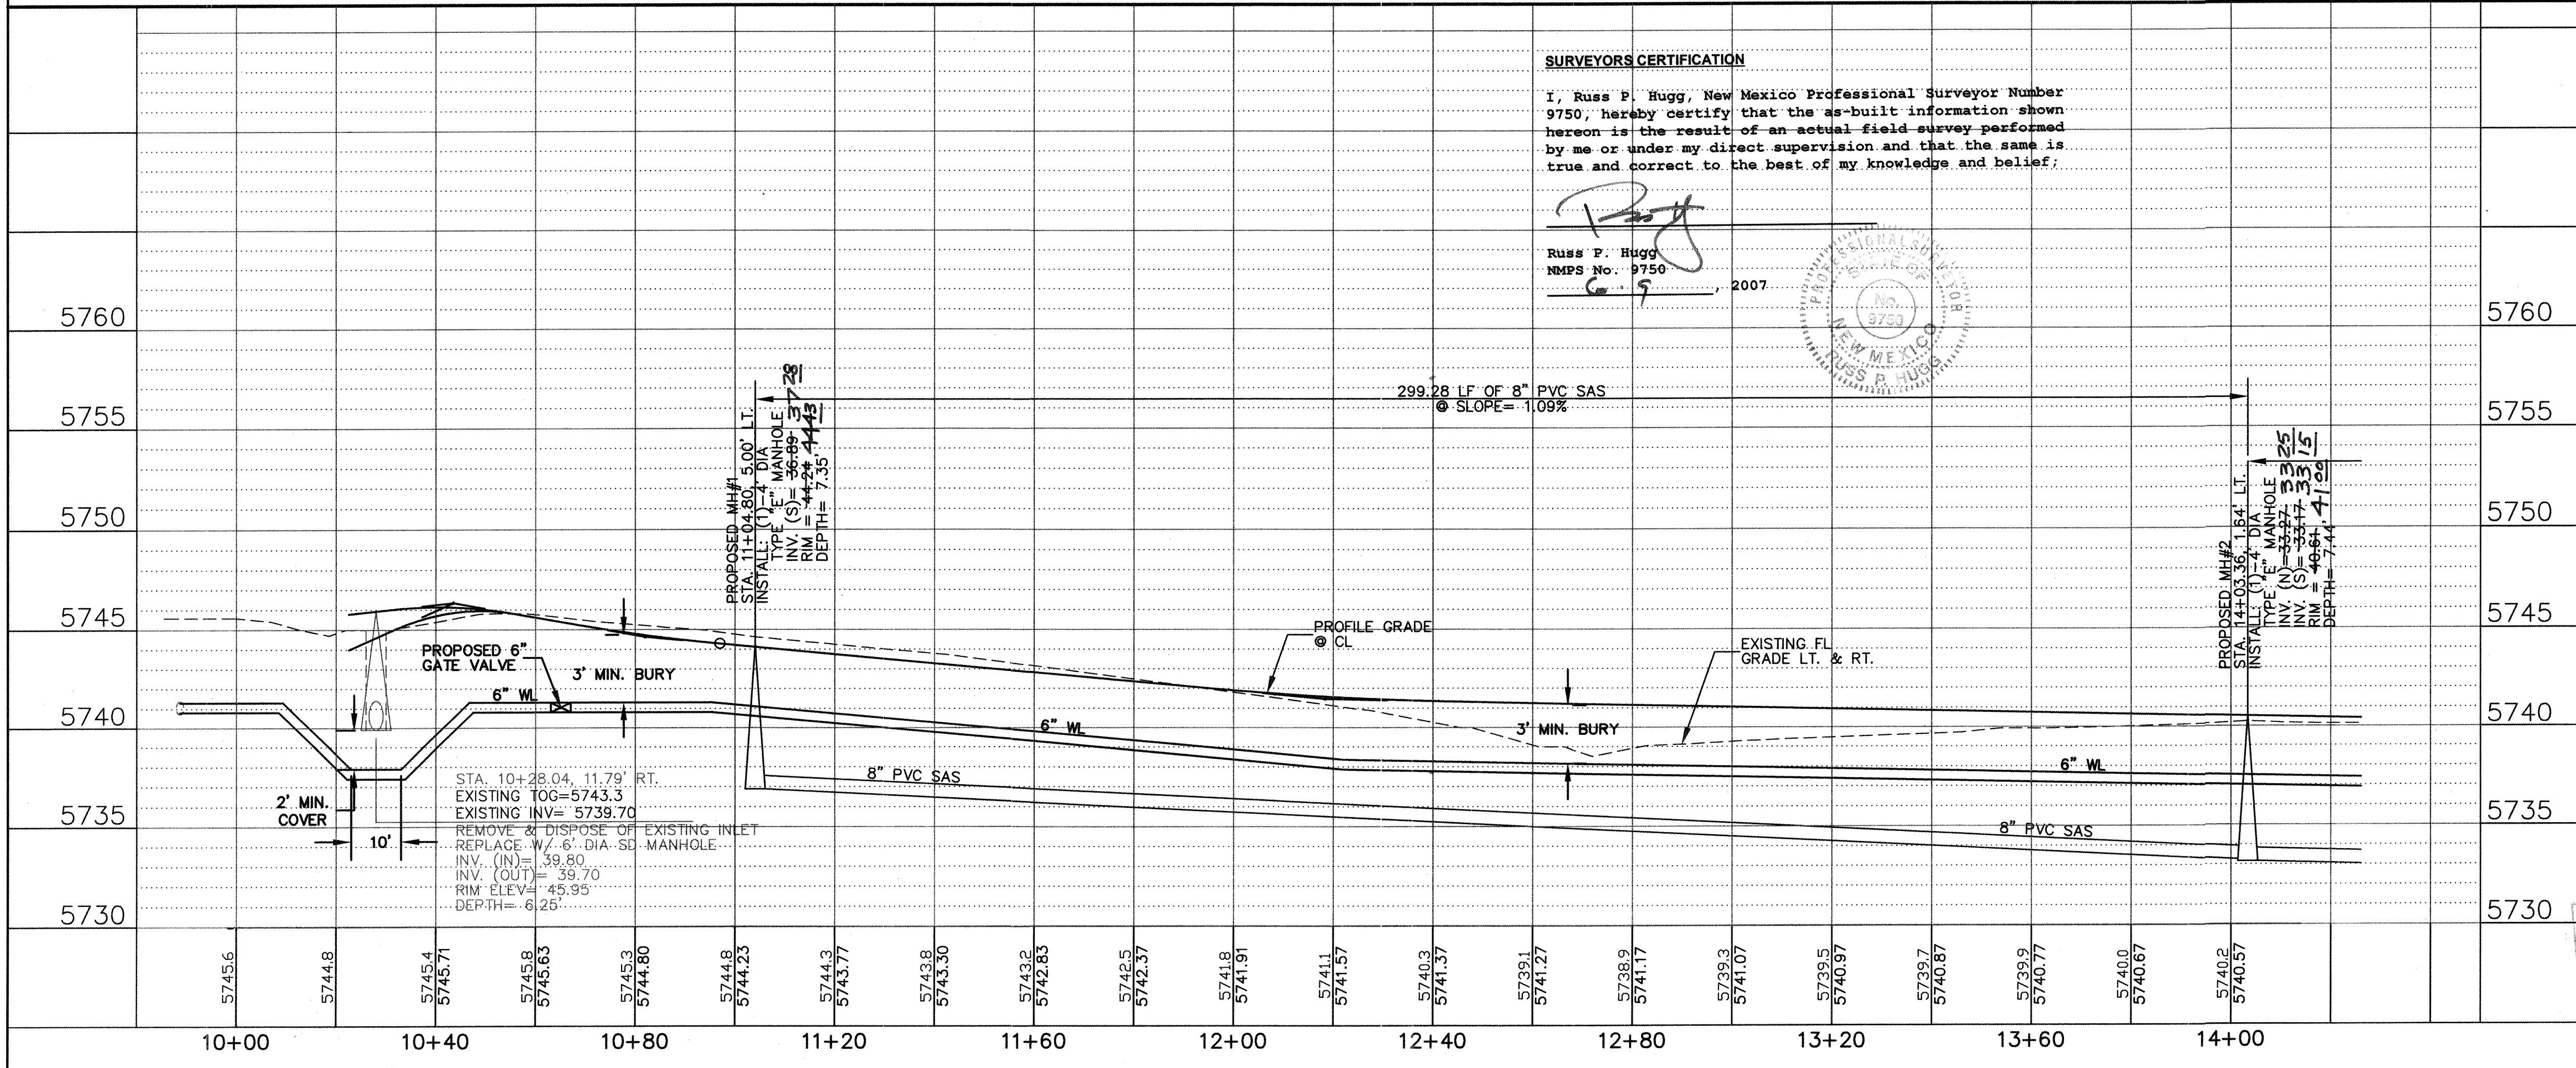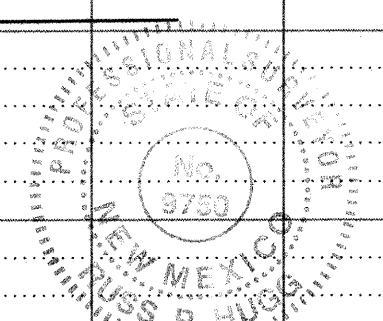

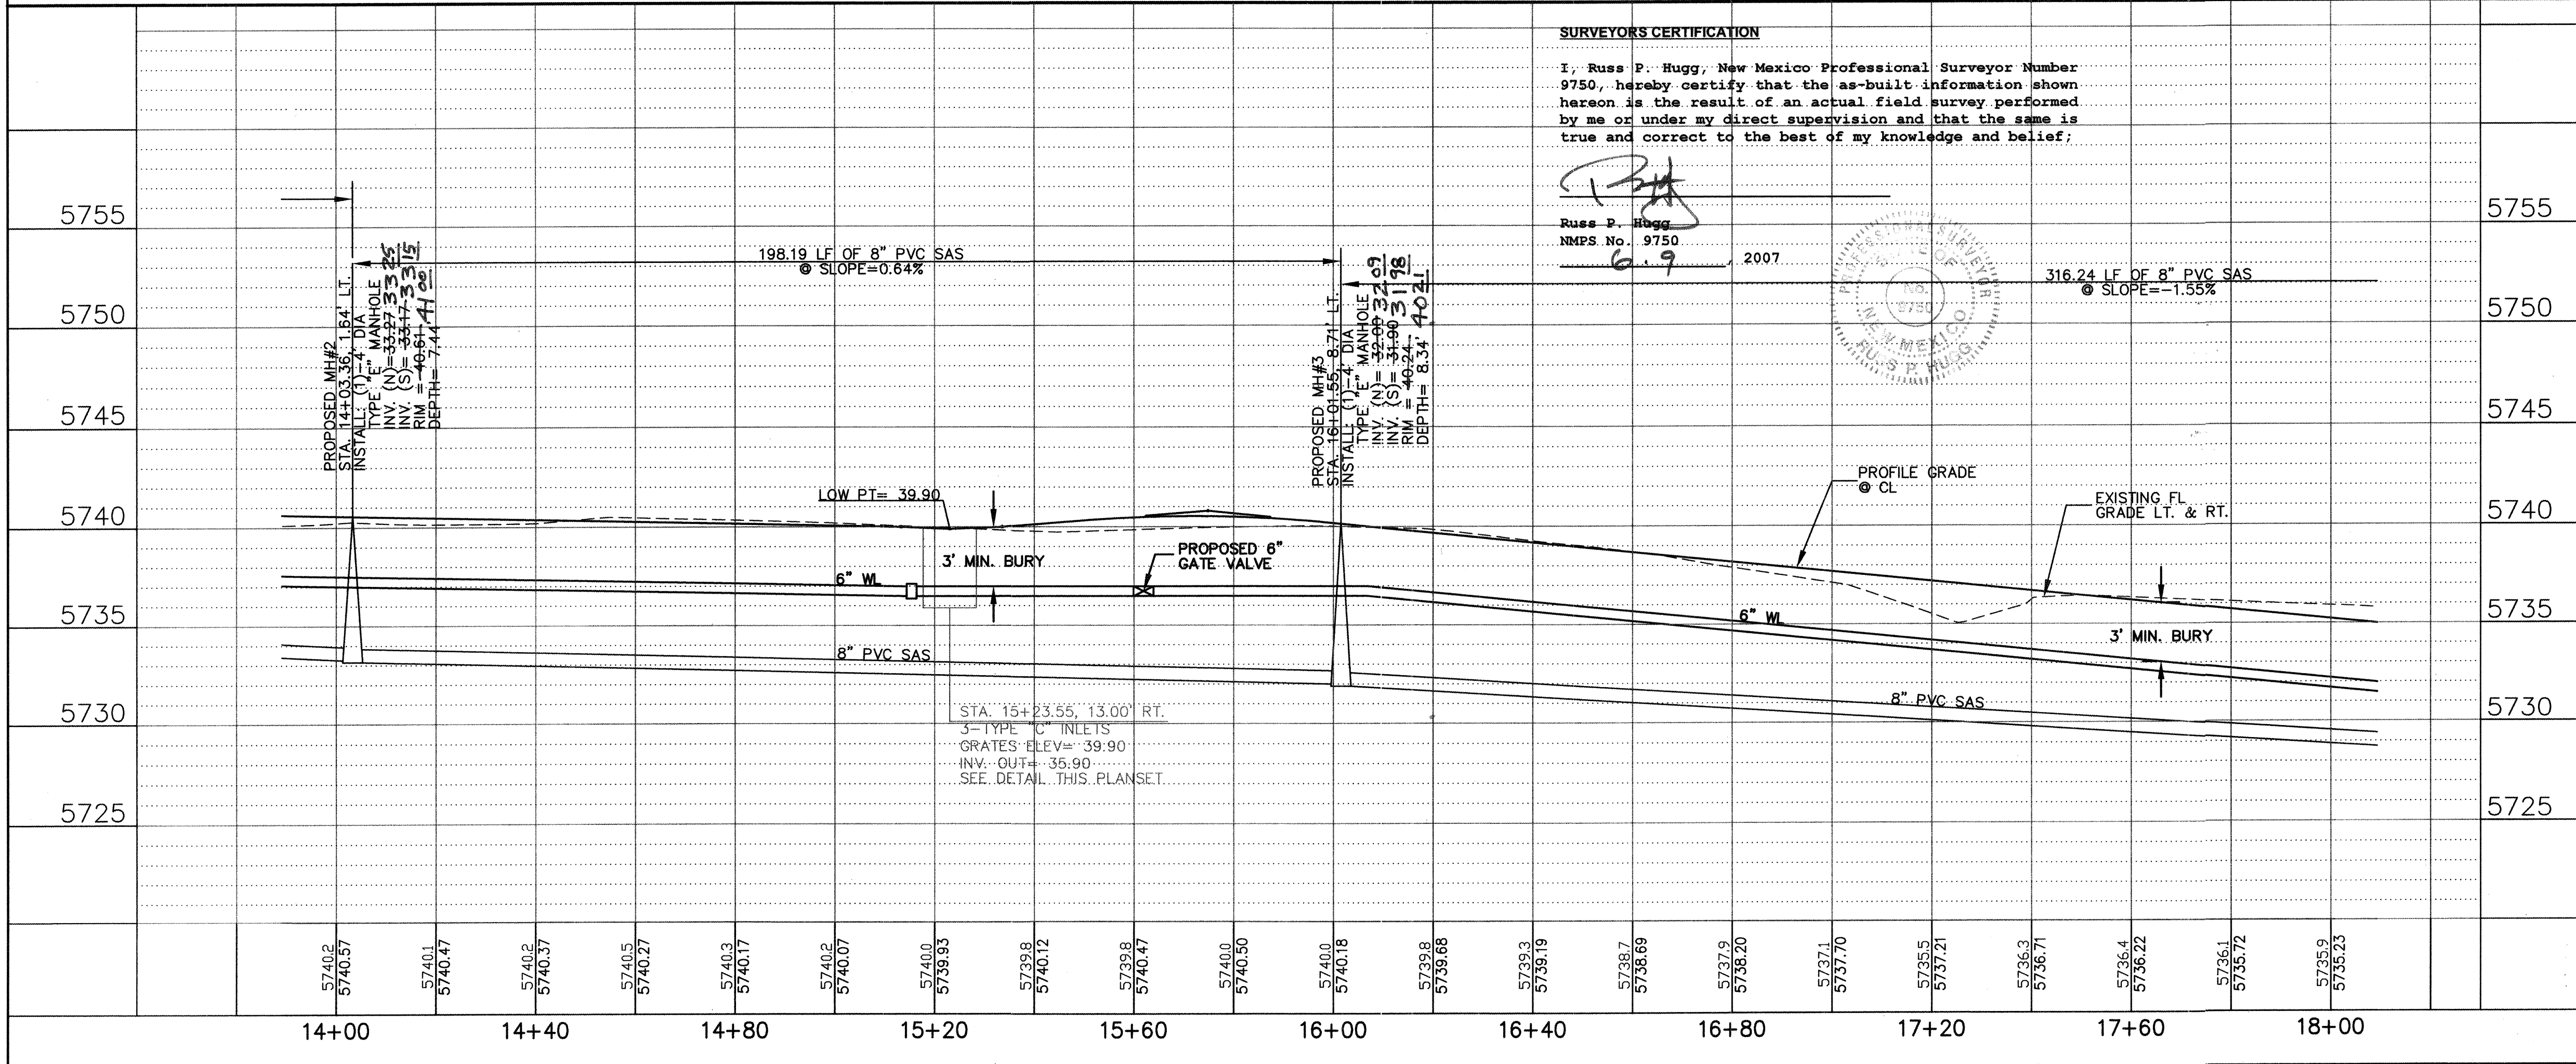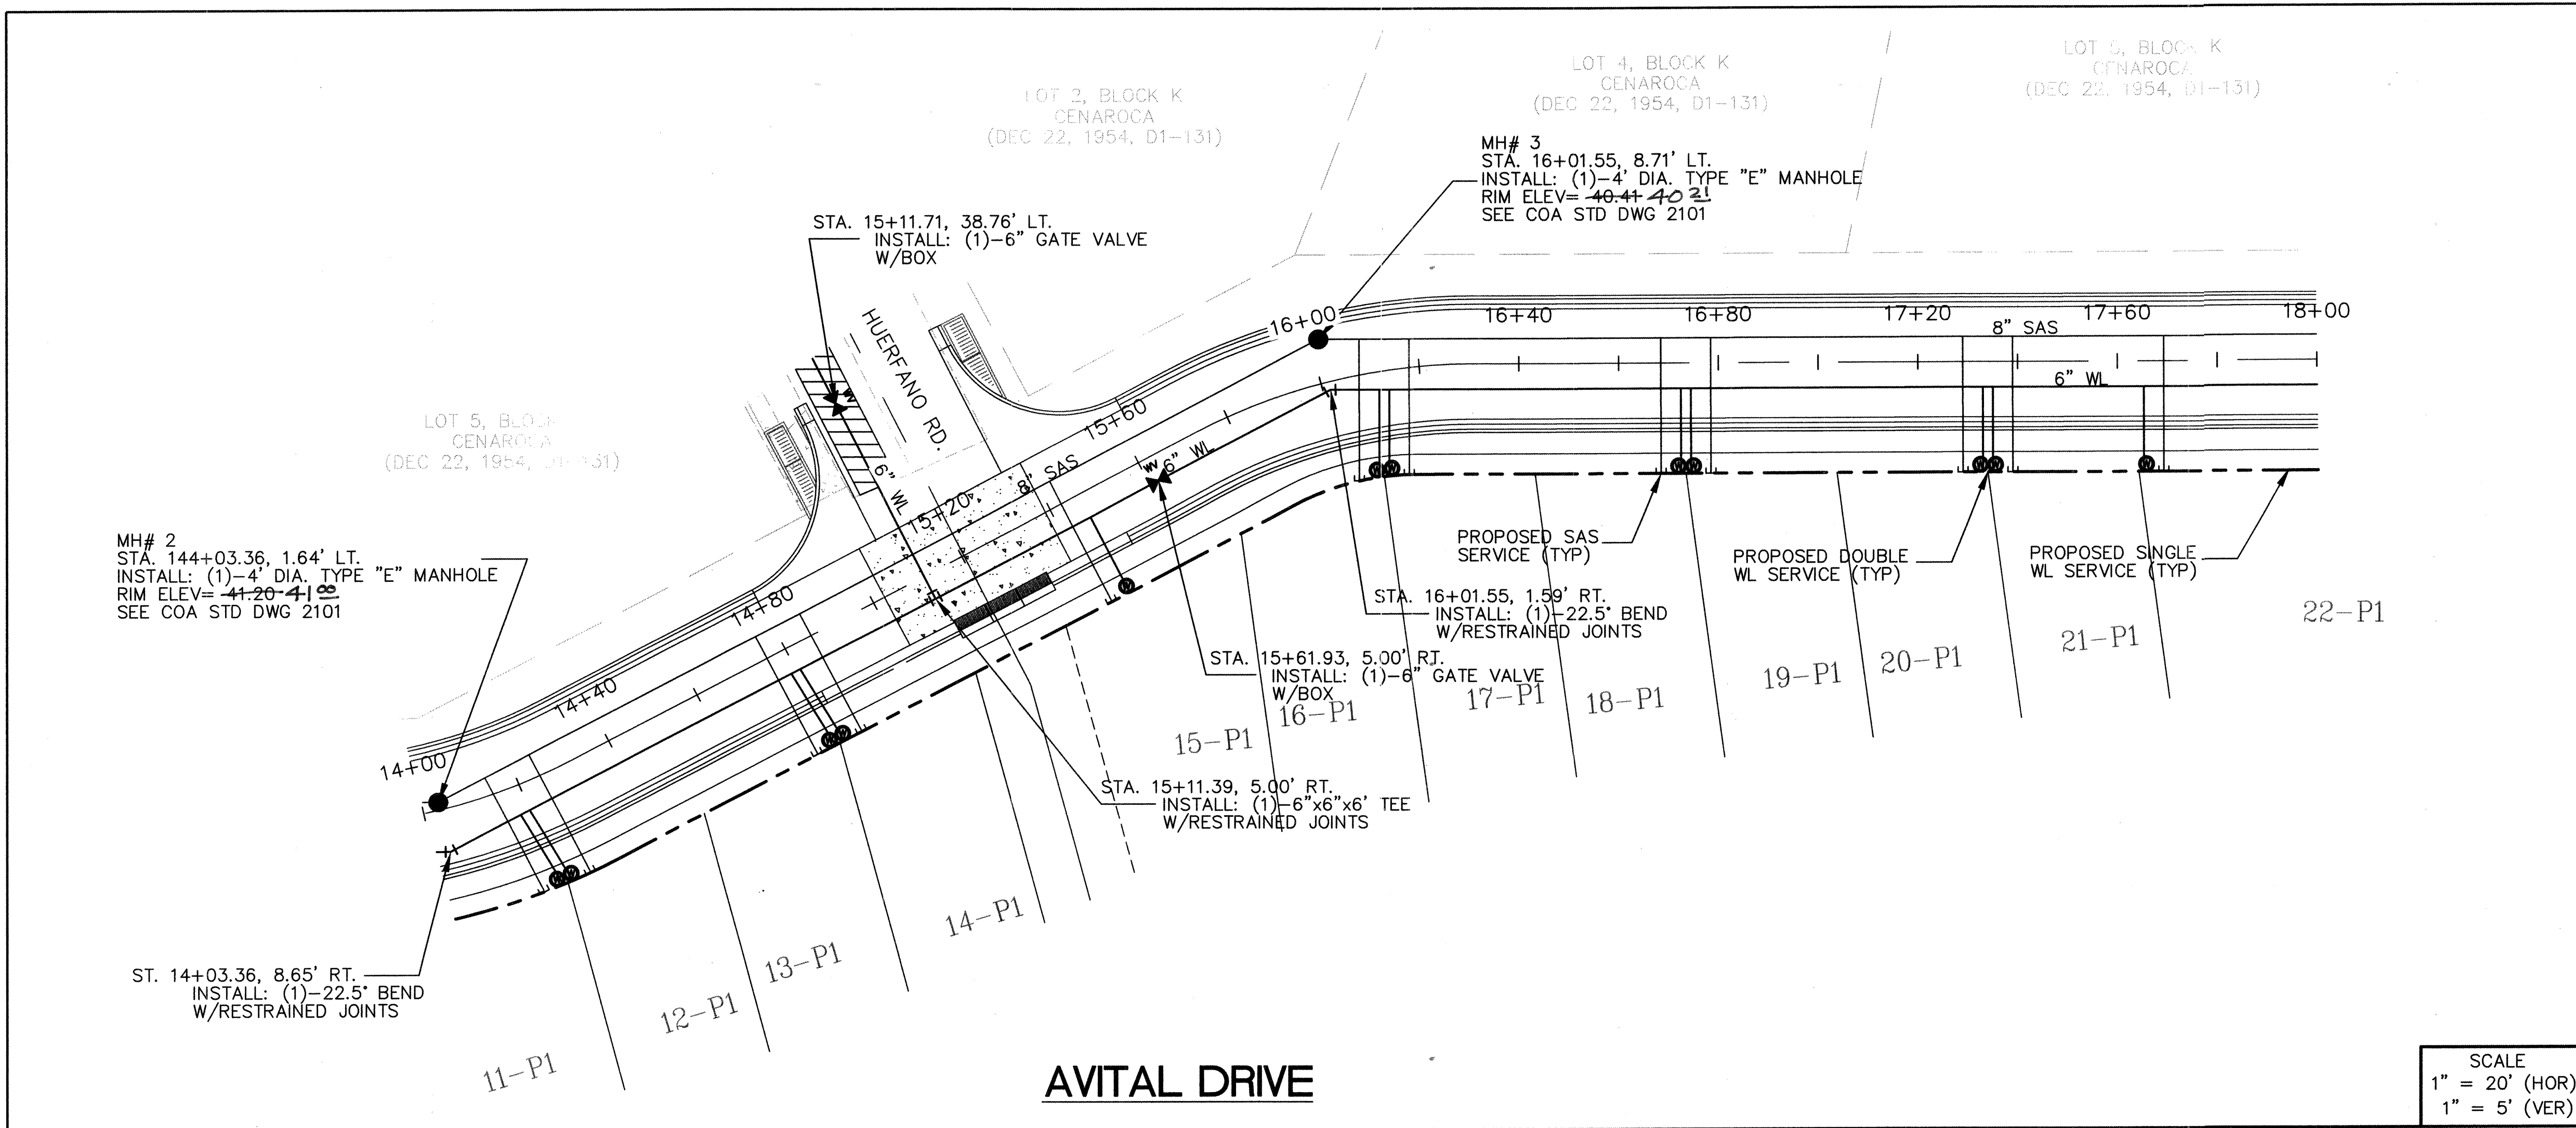

- LEGEND**
- EXISTING SAS MANHOLE
 - EXISTING WATER VALVE
 - EXISTING FIRE HYDRANT
 - EXISTING STORM DRAIN MANHOLE
 - EXISTING WATER LINE
 - EXISTING SAS LINE
 - PROPOSED SANITARY SEWER
 - PROPOSED SAS MANHOLE PER COA STD DWG 2102
 - PROPOSED SANITARY SEWER SERVICE LINE PER COA STD DWGS
 - PROPOSED WATER LINE
 - PROPOSED FIRE HYDRANT PER COA STD DWG 2340
 - PROPOSED GATE VALVE PER COA STD DWGS
 - PROPOSED CROSS, TEE, OR ELBOW PER COA STD DWGS
 - PROPOSED SINGLE METER, WATER SERVICE LINE PER COA STD DWGS
- UTILITY NOTES:**
- CONTRACTOR RESPONSIBLE FOR LOCATION OF ALL EXISTING UTILITIES PRIOR TO WORK.
 - PROPOSED 6" WL HAS 3' MIN. COVER
 - ALL PROPOSED MANHOLE LIDS TO MATCH WITH PROPOSED PAVEMENT
 - CITY STANDARDS TO BE USED ON ALL UTILITIES UNLESS OTHERWISE NOTED.
 - ALL METER BOXES LID SHALL BE HEAVY WEIGHT.

ENGINEER'S SEAL

[Signature]

AS BUILT INFORMATION

CONTRACTOR: *Sells Bros. Const.*
WORK STARTED BY: *SURV. TEK*
DATE: *06/04/07*
INSPECTED BY: *SEC. - T.V.*
DATE: *06/04/07*
FIELD REVISIONS BY: *SURV. TEK*
DATE: *05/01/07*
CORRECTED BY: *SURV. TEK*
DATE: *06/06/07*
RECORDED BY: *[Blank]*
DATE: *[Blank]*

SURVEY INFORMATION

FIELD NOTES BY: *[Blank]* DATE: *[Blank]*

NO. DATE

REMARKS

DESIGN

DESIGNED BY DBT DATE *[Blank]*
DRAWN BY DEM DATE *[Blank]*
CHECKED BY DBT DATE *[Blank]*

Thompson Engineering Consultants, Inc.
P.O. BOX 65760 ALBUQUERQUE, NM 87193
PHONE: (505) 271-2199 FAX: (505) 630-9426

**CITY OF ALBUQUERQUE
PUBLIC WORKS DEPARTMENT
TRANSPORTATION DEVELOPMENT**

**AVITAL DRIVE UTILITY PLAN AND PROFILE
BLUFFS AT ENCANTADO**


DESIGN REVIEW COMMITTEE

CITY ENGINEER APPROVAL

[Signature] 1.7.2006
CITY ENGINEER

MO./DAY/YR.

City Project No. 790281 Zone Map No. L & K-23-Z Sheet 14 Of 16


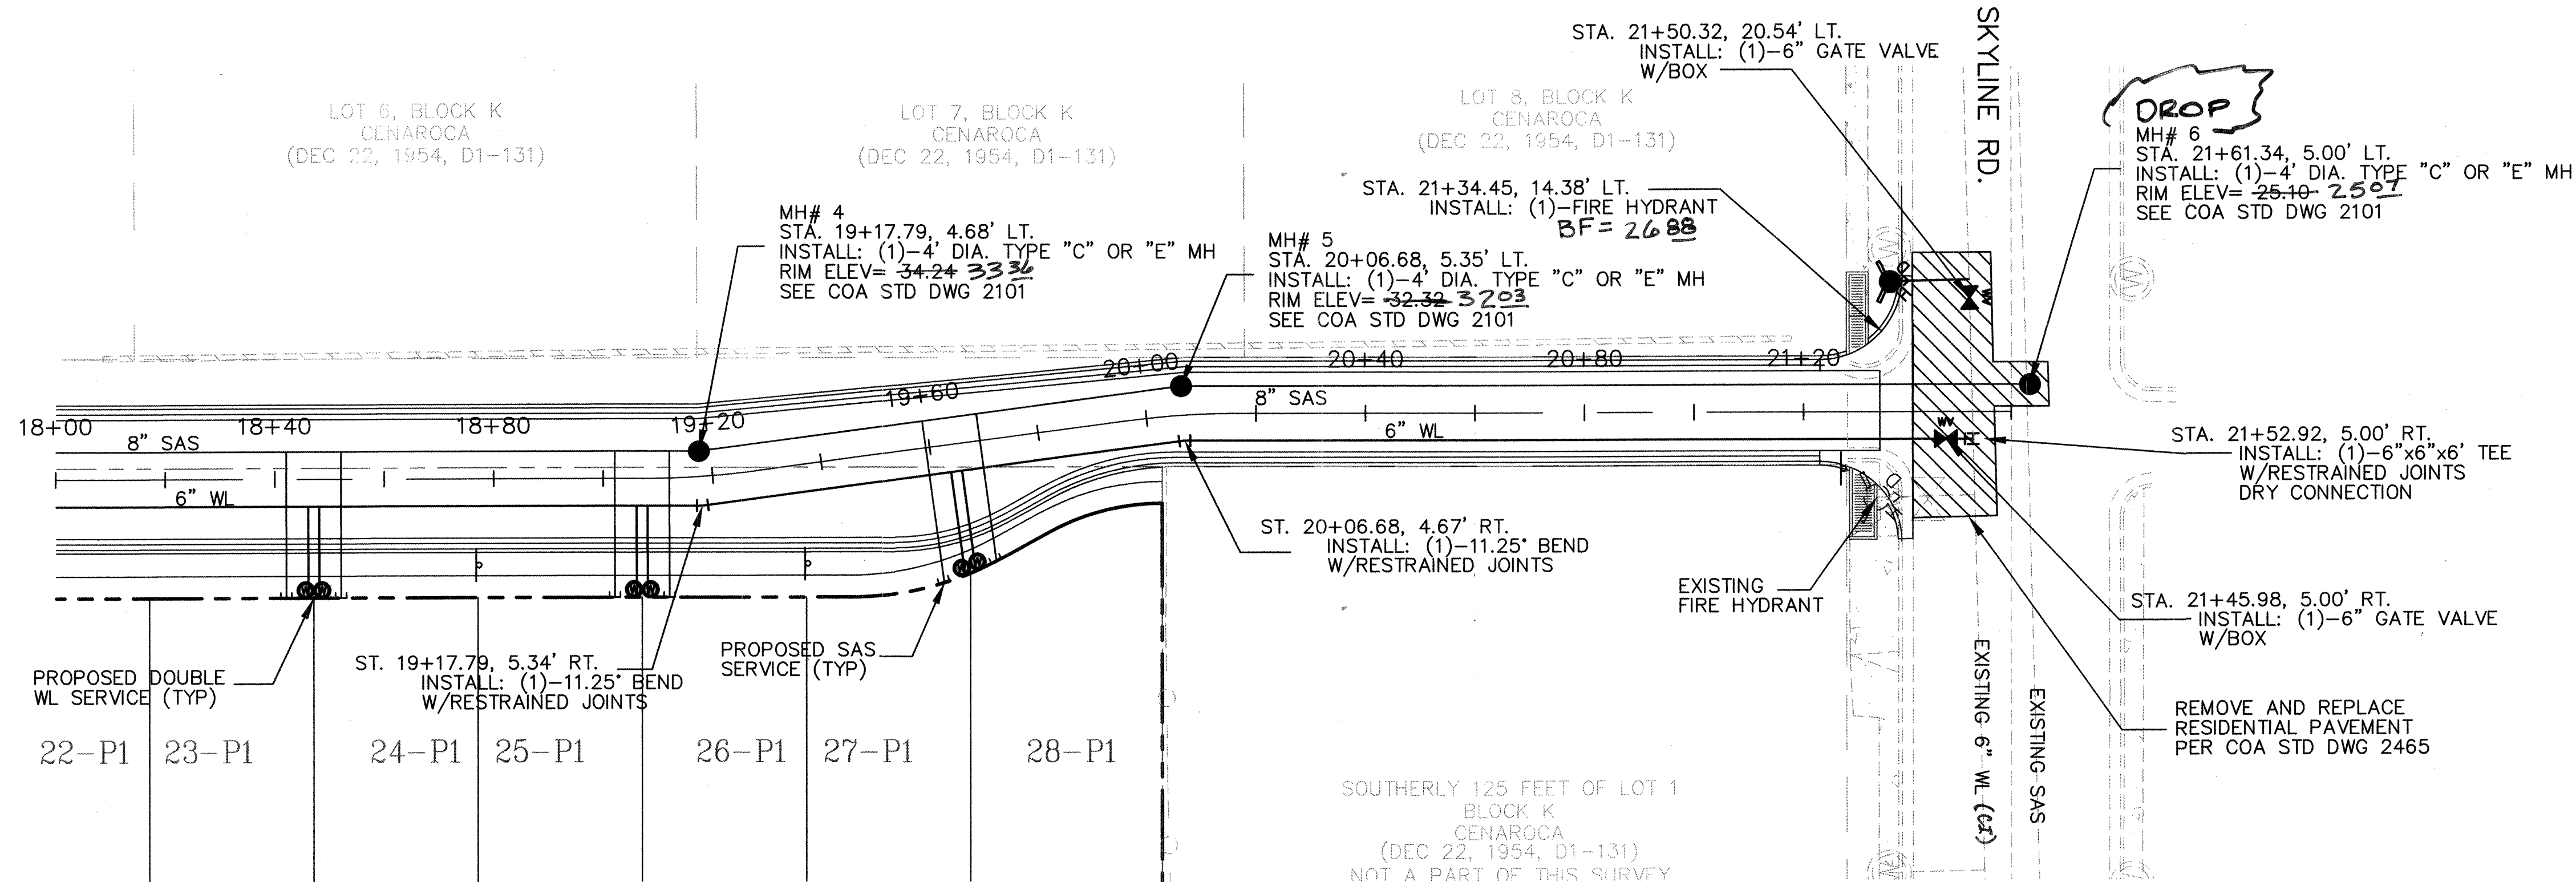


- LEGEND**
- o EXISTING SAS MANHOLE
 - o EXISTING WATER VALVE
 - o EXISTING FIRE HYDRANT
 - o EXISTING STORM DRAIN MANHOLE
 - EXISTING WATER LINE
 - EXISTING SAS LINE
 - PROPOSED SANITARY SEWER
 - o PROPOSED SAS MANHOLE PER COA STD DWG 2102
 - PROPOSED SANITARY SEWER SERVICE LINE PER COA STD DWGS
 - PROPOSED WATER LINE
 - o PROPOSED FIRE HYDRANT PER COA STD DWG 2340
 - o PROPOSED GATE VALVE PER COA STD DWGS
 - o PROPOSED CROSS, TEE, OR ELBOW PER COA STD DWGS
 - o PROPOSED SINGLE METER, WATER SERVICE LINE PER COA STD DWGS
- UTILITY NOTES:**
- CONTRACTOR RESPONSIBLE FOR LOCATION OF ALL EXISTING UTILITIES PRIOR TO WORK.
 - PROPOSED 6" & 8" WL HAS 3' MIN. COVER
 - ALL PROPOSED MANHOLE LIDS TO MATCH WITH PROPOSED PAVEMENT
 - CITY STANDARDS TO BE USED ON ALL UTILITIES UNLESS OTHERWISE NOTED.
 - ALL METER BOXES LID SHALL BE HEAVY WEIGHT.

SURVEYOR'S CERTIFICATION

I, Russ P. Hugg, New Mexico Professional Surveyor Number 9750, hereby certify that the as-built information shown hereon is the result of an actual field survey performed by me or under my direct supervision and that the same is true and correct to the best of my knowledge and belief.

Russ P. Hugg
NMPS No. 9750

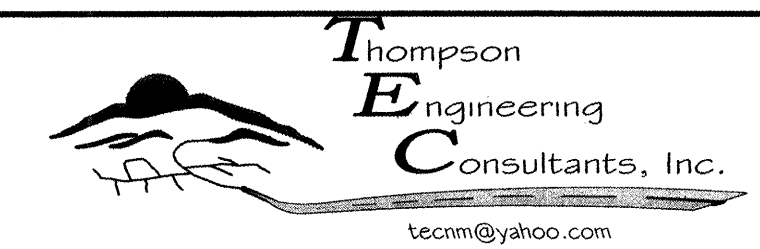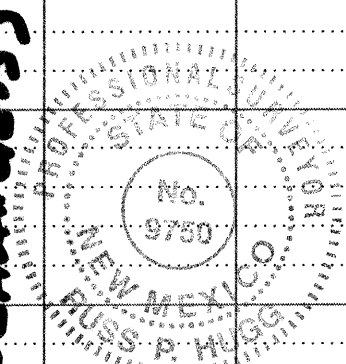


**CITY OF ALBUQUERQUE
PUBLIC WORKS DEPARTMENT
TRANSPORTATION DEVELOPMENT**

**AVITAL DRIVE UTILITY PLAN AND PROFILE
BLUFFS AT ENCANTADO**

DESIGN REVIEW COMMITTEE	CITY ENGINEER APPROVAL	MO./DAY/YR.	MO./DAY/YR.
APPROVED NOV 17 2006	APPROVED NOV 17 2006		


City Project No. 790281 Zone Map No. K & L-23-Z Sheet 15 of 16

AS BUILT INFORMATION		BENCH MARKS		SURVEY INFORMATION		ENGINEER'S SEAL	
CONTRACTOR	DATE	ACS MONUMENT	DATE	NO.	DATE	NO.	DATE
SAIC	4/1/07	ELEV. 5708.72					
WORK STATIONED BY	DATE	ACS 12" ALUMINUM DISK, STAMPED "ACS					
BY SURV. TEK	DATE	BM, 21-K23, EPOXYED ON TOP OF THE					
DATE 4/1/07	DATE	CONCRETE CURB, AT THE EAST END OF					
BY SURV. TEK	DATE	SKYLINE ROAD NE, 308 FT. ± EAST OF					
DATE 4/1/07	DATE	THE CENTERLINE OF PANORAMA PL., ON					
BY SURV. TEK	DATE	THE CENTERLINE (EXTENDED) OF SKYLINE RD.					
DATE 4/1/07	DATE						

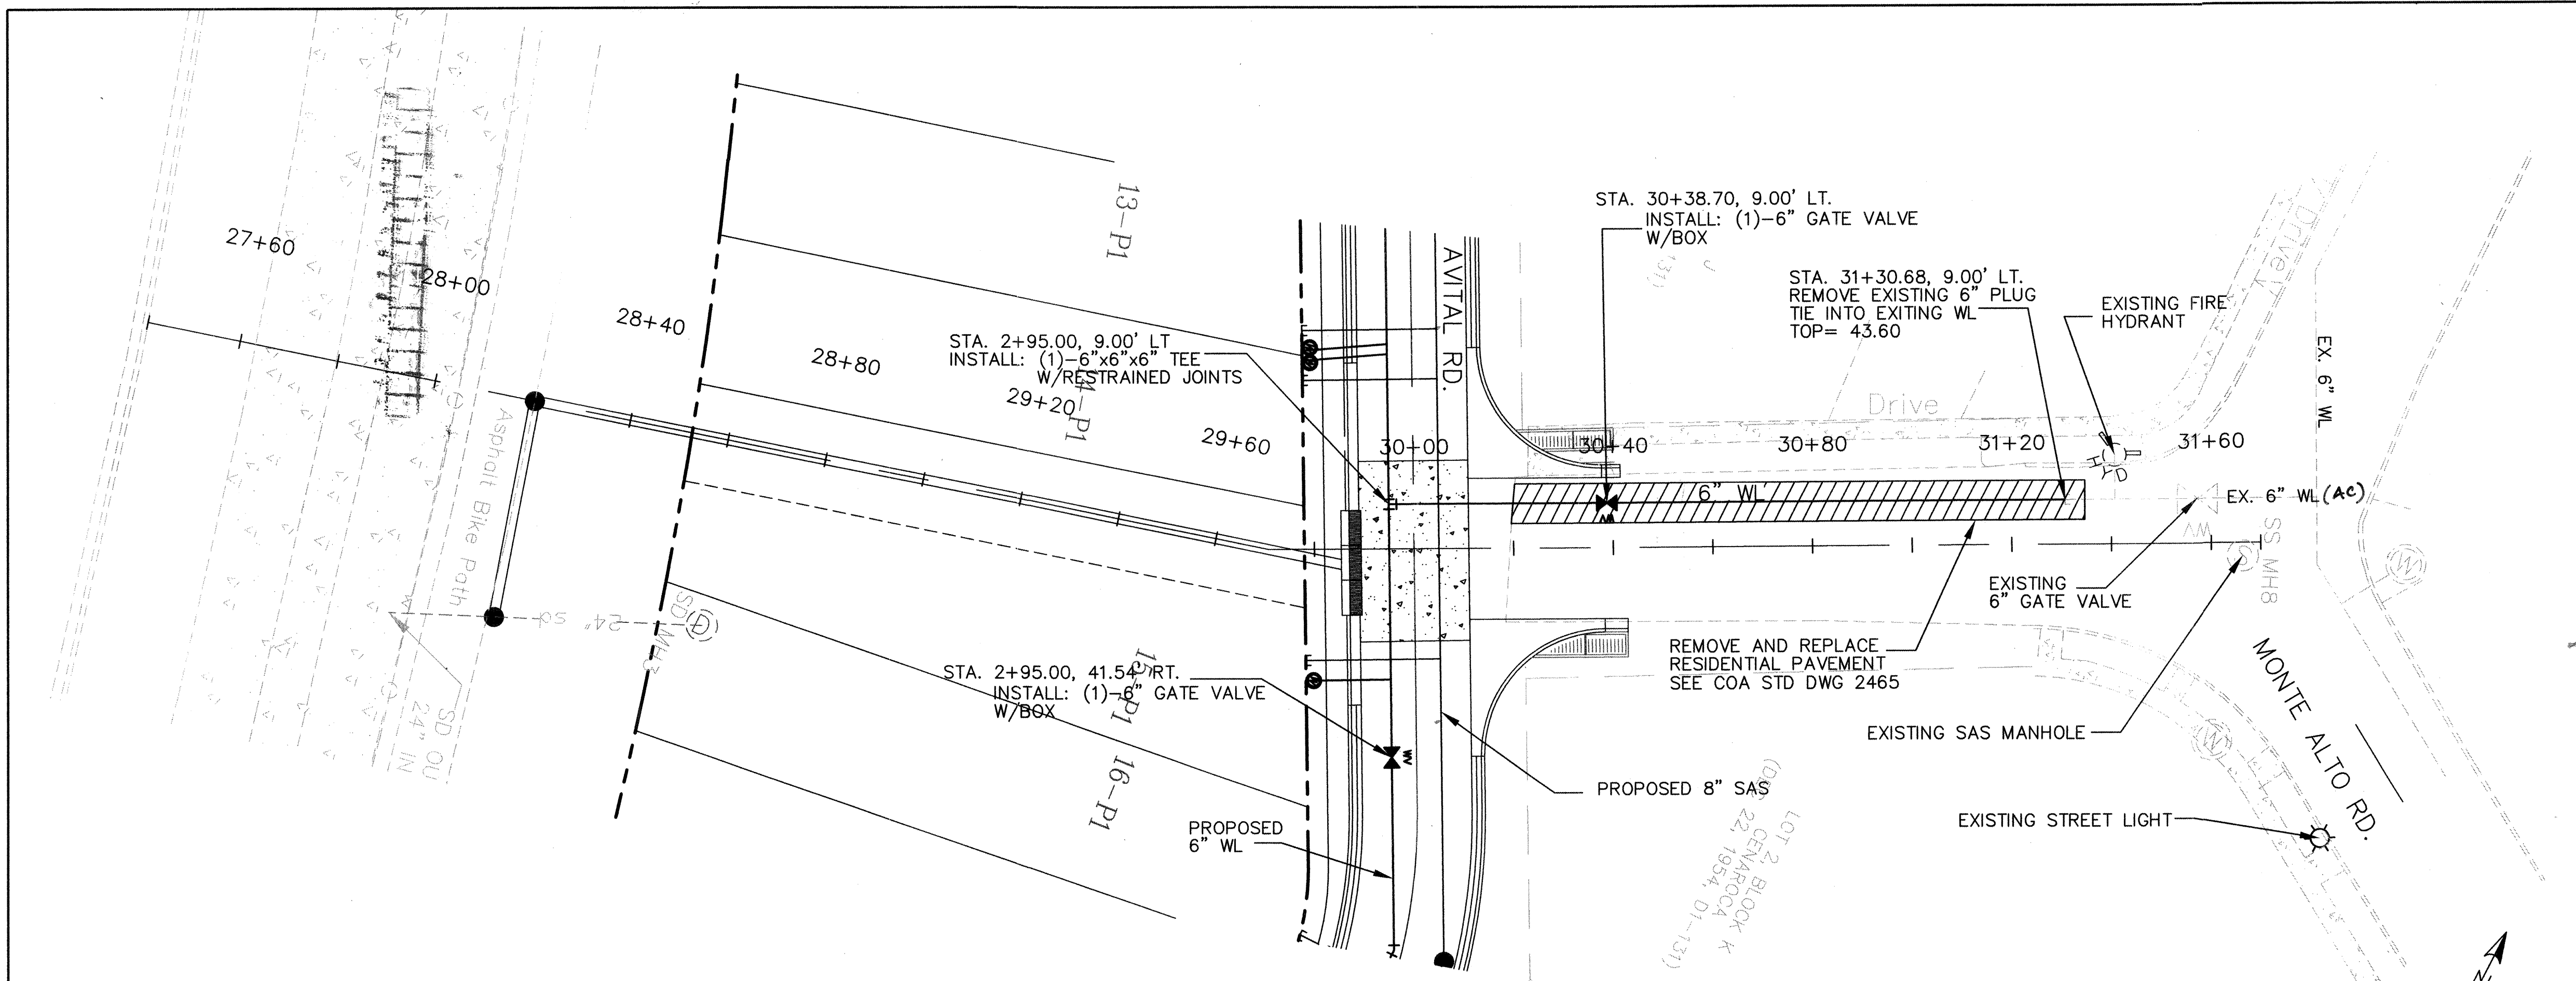

HUERFANO ROAD

SCALE
1" = 20' (HOR)
1" = 5' (VER)

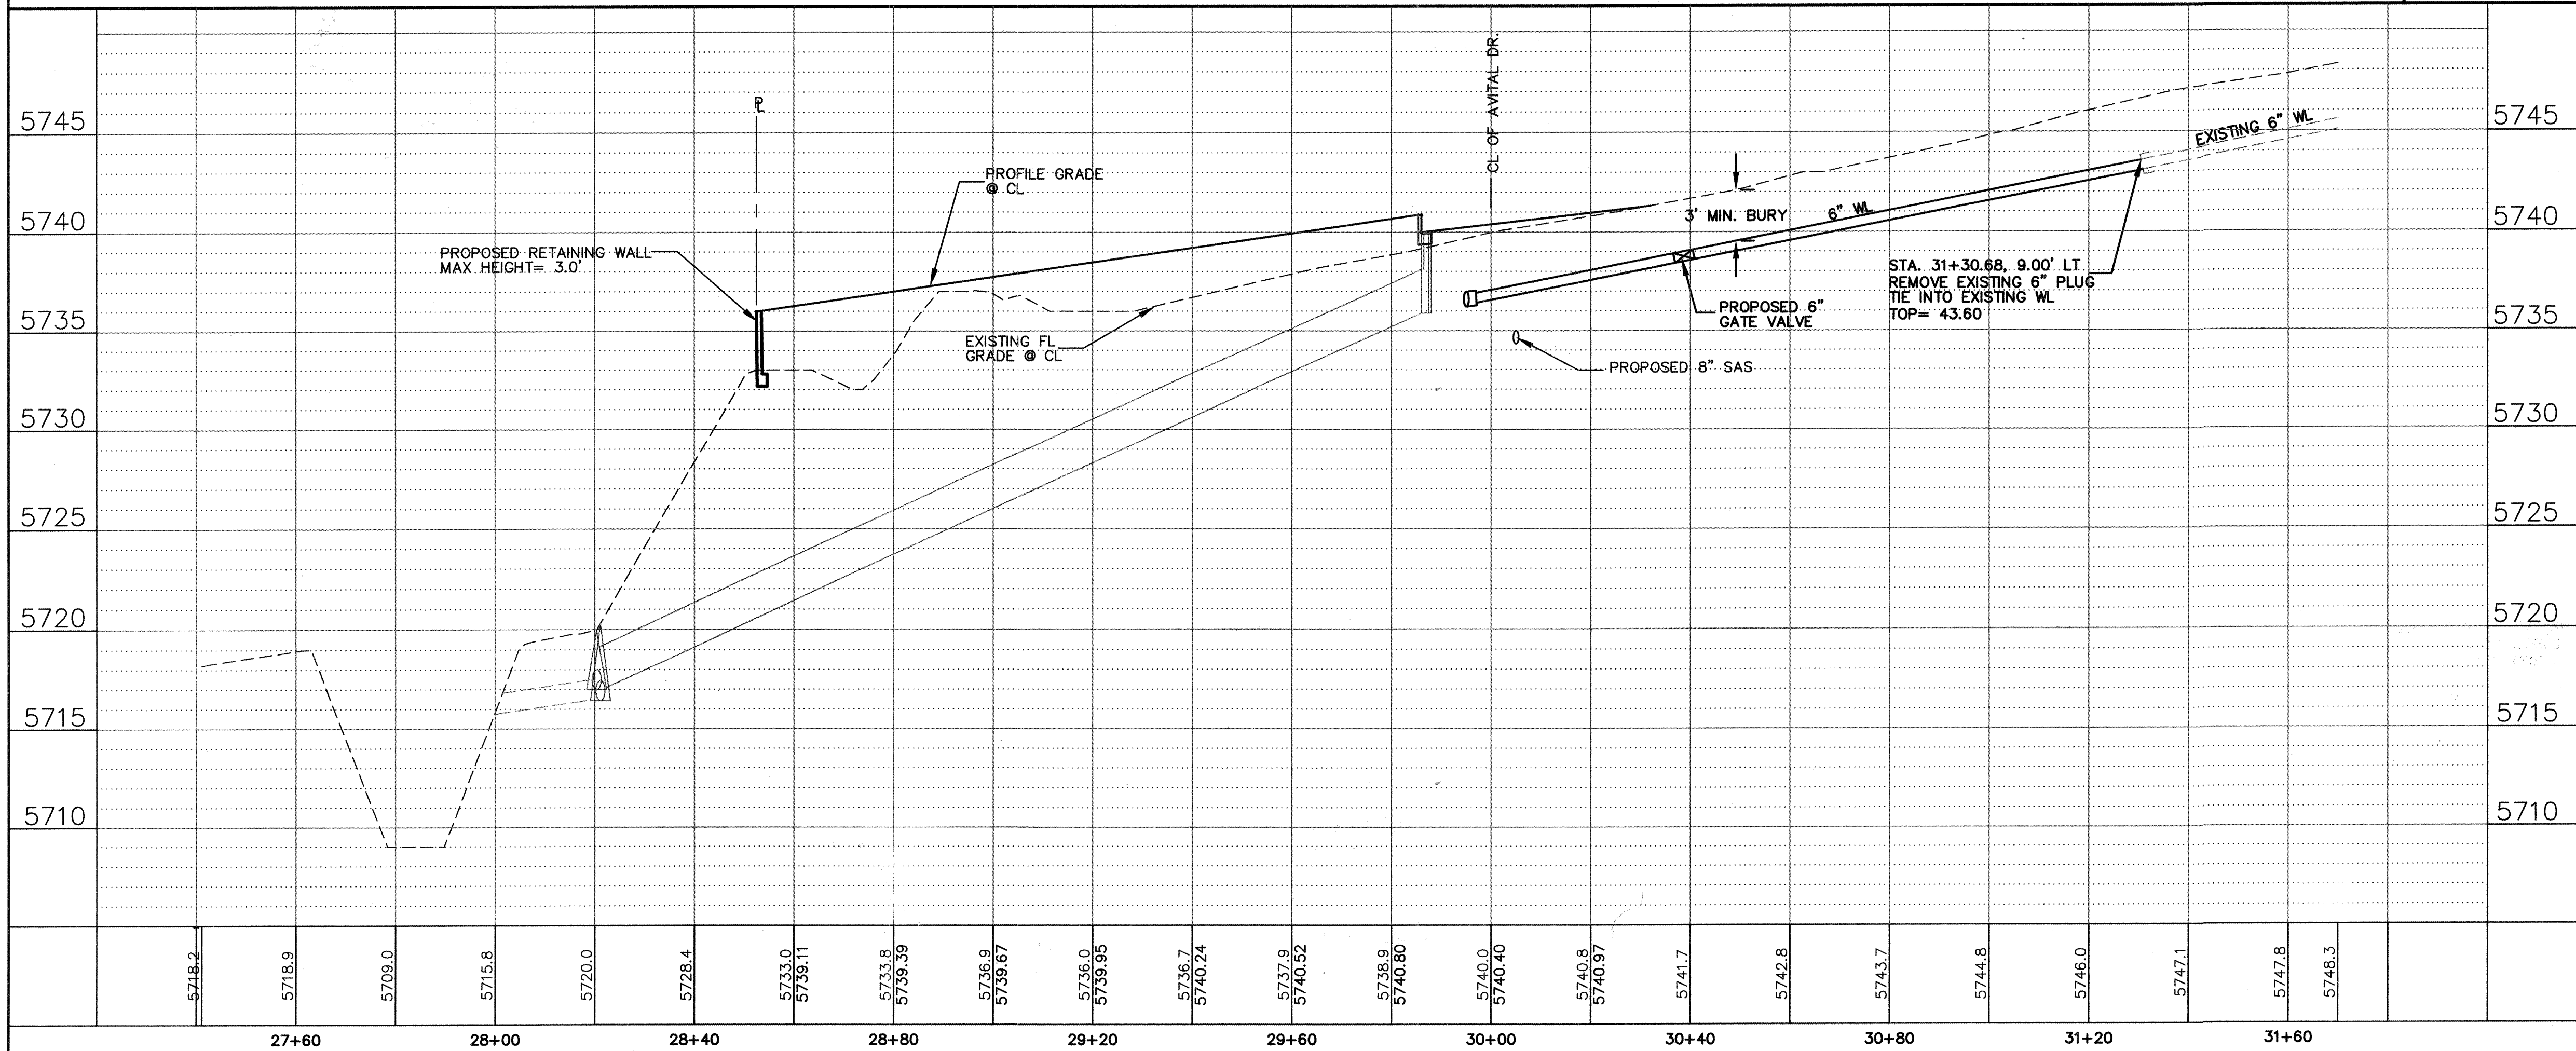

- LEGEND**
- EXISTING SAS MANHOLE
 - EXISTING WATER VALVE
 - EXISTING FIRE HYDRANT
 - EXISTING STORM DRAIN MANHOLE
 - EXISTING WATER LINE
 - EXISTING SAS LINE
 - PROPOSED SANITARY SEWER
 - PROPOSED SAS MANHOLE PER COA STD DWG 2102
 - PROPOSED SANITARY SEWER SERVICE LINE PER COA STD DWGS
 - PROPOSED WATER LINE
 - PROPOSED FIRE HYDRANT PER COA STD DWG 2340
 - PROPOSED GATE VALVE PER COA STD DWGS
 - PROPOSED CROSS, TEE, OR ELBOW PER COA STD DWGS
 - PROPOSED SINGLE METER, WATER SERVICE LINE PER COA STD DWGS

- UTILITY NOTES:**
- CONTRACTOR RESPONSIBLE FOR LOCATION OF ALL EXISTING UTILITIES PRIOR TO WORK.
 - PROPOSED 6" & 8" WL HAS 3' MIN. COVER
 - ALL PROPOSED MANHOLE LIDS TO MATCH WITH PROPOSED PAVEMENT
 - CITY STANDARDS TO BE USED ON ALL UTILITIES UNLESS OTHERWISE NOTED.
 - ALL METER BOXES LID SHALL BE HEAVY WEIGHT.

Tompson Engineering Consultants, Inc.
P.O. BOX 65760 ALBUQUERQUE, NM 87193
PHONE: (505) 271-2199 FAX: (505) 830-9426
tecrcm@yahoo.com

CITY OF ALBUQUERQUE PUBLIC WORKS DEPARTMENT TRANSPORTATION DEVELOPMENT			
HUERFANO ROAD UTILITY PLAN AND PROFILE BLUFFS AT ENCANTADO			
DESIGN REVIEW COMMITTEE	CITY ENGINEER APPROVAL	NO./DAY/YR.	NO./DAY/YR.
DESIGNED BY DBT	DRAWN BY DEM	CHECKED BY DBT	DATE
City Project No. 790281		Zone Map No. K & L-23-Z	Sheet 16 of 16

SURVEY INFORMATION		BENCH MARKS		AS BUILT INFORMATION	
NO.	DATE	NO.	DATE	NO.	DATE
		ACS MONUMENT "21-K23"		CONTRACTOR	
				WORK	
				STAMPED BY	
				ACCEPTANCE BY	
				FIELD	
				DRAWINGS	
				CORRECTED BY	
				RECORDED BY	
				NO.	

ENGINEER'S SEAL
9977
9977