


CONSTRUCTION PLANS
FOR
VISTA DE LA LUZ
ALBUQUERQUE, NEW MEXICO

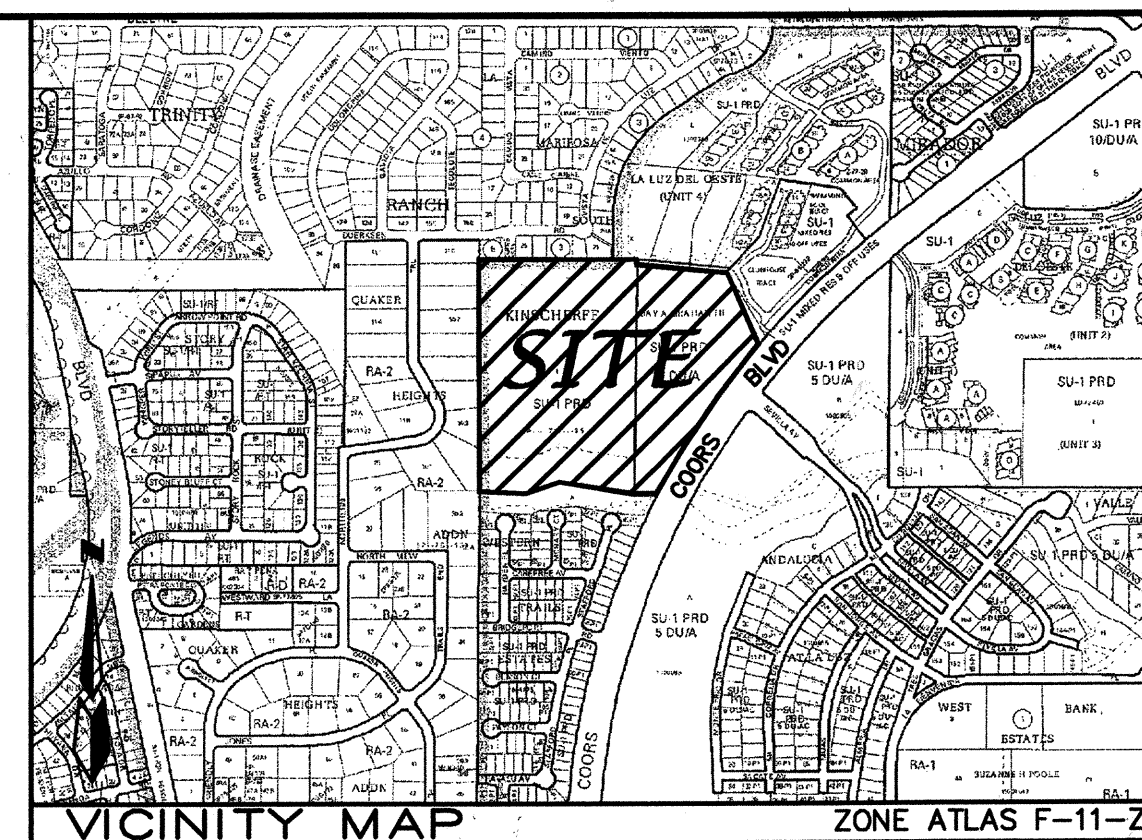

GENERAL NOTES

NOTICE TO CONTRACTORS

1. AN EXCAVATION/CONSTRUCTION PERMIT WILL BE REQUIRED BEFORE BEGINNING ANY WORK WITHIN THE CITY RIGHT-OF-WAY.
2. ALL WORK DETAILED ON THESE PLANS TO BE PERFORMED UNDER CONTRACT SHALL, EXCEPT AS OTHERWISE STATED OR PROVIDED FOR HEREON, BE CONSTRUCTED IN ACCORDANCE WITH THE CITY OF ALBUQUERQUE STANDARD SPECIFICATIONS FOR PUBLIC WORKS CONSTRUCTION, 1986 EDITION AS REVISED THROUGH UPDATE #7, INCLUDING AMENDMENT #1.
3. TWO WORKING DAYS PRIOR TO ANY EXCAVATION, THE CONTRACTOR MUST CONTACT NEW MEXICO ONE CALL SYSTEM (260-1990) FOR LOCATION OF EXISTING UTILITIES.
4. PRIOR TO CONSTRUCTION, THE CONTRACTOR SHALL EXCAVATE AND VERIFY THE HORIZONTAL AND VERTICAL LOCATIONS OF ALL OBSTRUCTIONS. SHOULD A CONFLICT EXIST, THE CONTRACTOR SHALL NOTIFY THE CITY IMMEDIATELY SO THAT THE CONFLICT CAN BE RESOLVED WITH A MINIMUM AMOUNT OF DELAY.
5. FIVE (5) WORKING DAYS PRIOR TO BEGINNING OF CONSTRUCTION, THE CONTRACTOR SHALL SUBMIT TO CONSTRUCTION COORDINATION DIVISION A DETAILED CONSTRUCTION SCHEDULE. TWO (2) WORKING DAYS PRIOR TO THE START OF CONSTRUCTION, THE CONTRACTOR SHALL OBTAIN A BARRICADING PERMIT FROM THE CONSTRUCTION COORDINATION DIVISION. CONTRACTOR SHALL NOTIFY THE CONSTRUCTION COORDINATION ENGINEER (924-3400) PRIOR TO OCCUPANCY OF ANY SECTION. REFER TO SECTION 19 OF THE GENERAL CONDITIONS OF THE STANDARD SPECIFICATIONS.
6. ALL WORK AFFECTING ARTERIAL ROADWAYS REQUIRES TWENTY-FOUR HOUR CONSTRUCTION.
7. ALL STREET STRIPS ALTERED OR DESTROYED SHALL BE REPLACED WITH PLASTIC REFLECTORIZED PAVEMENT MARKING BY CONTRACTOR TO THE SAME LOCATION AS WAS EXISTING, OR AS INDICATED BY THIS PLAN SET.
8. CONTRACTOR SHALL NOTIFY THE ENGINEER NOT LESS THAN SEVEN (7) DAYS PRIOR TO STARTING WORK IN ORDER THAT THE CITY SURVEYOR MAY TAKE NECESSARY MEASURES TO INSURE THE PRESERVATION OF SURVEY MONUMENTS. CONTRACTOR SHALL NOT DISTURB PERMANENT SURVEY MONUMENTS WITHOUT THE CONSENT OF THE CITY SURVEYOR AND SHALL NOTIFY THE CITY SURVEYOR AND THE ENGINEER PRIOR TO REPLACING ANY THAT MAY BE DISTURBED. WITHOUT PERSONAL REIMBURSEMENT SHALL BE DONE ONLY BY THE CITY SURVEYOR WHEN A CHANGE IS MADE IN THE FINISHED ELEVATIONS OF THE PAVEMENT OF ANY ROADWAY IN WHICH A PERMANENT SURVEY MONUMENT IS LOCATED, CONTRACTOR SHALL, AT HIS OWN EXPENSE, ADJUST THE MONUMENT TO COVER THE NEW GRADE UNLESS OTHERWISE SPECIFIED. REPAIR OF ANY SECTION OF THE GENERAL CONDITIONS OF THE STANDARD SPECIFICATIONS.
9. CONTRACTOR SHALL RECORD DATA ON ALL UTILITY LINES AND ACCESSORIES AS REQUIRED BY THE CITY OF ALBUQUERQUE FOR THE PREPARATION OF "AS CONSTRUCTED" DRAWINGS. CONTRACTOR SHALL NOT COVER UTILITY LINES AND ACCESSORIES UNTIL ALL DATA HAVE BEEN RECORDED.
10. CONTRACTOR SHALL MAINTAIN A GRAFFITI-FREE WORK SITE. CONTRACTOR SHALL PROMPTLY REMOVE ANY GRAFFITI FROM ALL EQUIPMENT, WHETHER PERMANENT OR TEMPORARY.
11. CONTRACTOR SHALL COORDINATE WITH THE CITY OF ALBUQUERQUE WATER SYSTEMS DIVISION (857-8200) SEVEN (7) WORKING DAYS IN ADVANCE OF ANY WORK THAT MAY AFFECT EXISTING PUBLIC WATER OR SEWER UTILITIES. EXISTING VALVES TO BE OPERATED BY CITY PERSONNEL. CONTRACTOR SHALL BE RESPONSIBLE FOR THE PROTECTION OF ALL SYSTEMS DIVISION SEVEN (7) WORKING DAYS PRIOR TO BEGINNING VALVES TURNED ON OR OFF.
12. FOR STORM DRAIN CONSTRUCTION, JOINT JOINTS SHALL NOT BE GROUTED PRIOR TO FINAL INSPECTION. FINAL INSPECTION WILL DETERMINE JOINTS TO BE GROUTED FOR FINAL ACCEPTANCE OF THE CONSTRUCTION.
13. ALL EXCAVATION, TRENCHING AND SHORING ACTIVITIES MUST BE CARRIED-OUT IN ACCORDANCE WITH OSHA 29 CFR 1926.658, SUPPORT P.
14. ELECTRONIC MARKER DISKS (EMD) WILL BE PLACED ACCORDING TO SECTION 170 OF THE CITY OF ALBUQUERQUE STANDARD SPECIFICATIONS FOR PUBLIC WORKS CONSTRUCTION, 1986 EDITION AS REVISED THROUGH UPDATE #7.
15. CONTRACTOR WILL BE RESPONSIBLE FOR PROVIDING AND MAINTAINING ALL CONSTRUCTION SIGNING UNTIL THE PROJECT HAS BEEN ACCEPTED BY THE CITY OF ALBUQUERQUE.
16. CONTRACTOR SHALL ASSUME RESPONSIBILITY FOR ANY DAMAGE TO EXISTING PAVEMENT, PAVEMENT MARKINGS, CURB AND GUTTER, HANDICAPPED RAMPS AND SIDEWALKS DURING CONSTRUCTION. ALL DAMAGE TO THESE SECTIONS INDICATED FOR REMOVAL ON THE PLANS AND SHALL REPAIR OR REPLACE PER CITY OF ALBUQUERQUE STANDARDS, AT HIS OWN EXPENSE.

THE FOLLOWING NOTES ALSO APPLY WHEN CHECKED

- ☒ ALL UTILITIES AND UTILITY SERVICE LINES SHALL BE INSTALLED PRIOR TO PAVING.
- ☒ BACKFILL COMPACTION SHALL BE ACCORDING TO SPECIFIED STREET USE.
- ☒ TACK COAT REQUIREMENTS SHALL BE DETERMINED BY THE ENGINEER.
- ☒ SIDEWALK AND WHEELCHAIR RAMPS WITHIN THE CURB RETURNS SHALL BE CONSTRUCTED WHEREVER A NEW CURB RETURN IS CONSTRUCTED.
- ☐ IF CURB IS DERESSED FOR A DRIVEPAD, THE DRIVEPAD SHALL BE CONSTRUCTED PRIOR TO ACCEPTANCE OF CURB AND OUTLET.
- ☒ ALL STORM DRAINAGE FACILITIES SHALL BE COMPLETED PRIOR TO FINAL ACCEPTANCE.

CAUTION:

NOTE THAT ALL EXISTING UTILITIES MAY NOT BE SHOWN. ALL EXISTING SERVICE CONNECTIONS ARE NOT SHOWN. ANY EXISTING UTILITIES THAT ARE SHOWN ARE APPROXIMATE LOCATION ONLY. IT SHALL BE THE SOLE RESPONSIBILITY OF THE CONTRACTOR TO CONTACT ALL THE UTILITY OWNERS AND TO CONDUCT ALL NECESSARY FIELD INVESTIGATIONS PRIOR TO ANY EXCAVATIONS TO DETERMINE THE ACTUAL LOCATION OF UTILITIES AND OTHER IMPROVEMENTS.


dmg D. MARK GOODWIN & ASSOCIATES, -A-
CONSULTING ENGINEERS
P. O. BOX 90606
ALBUQUERQUE, NEW MEXICO 87199
(505) 828-2200. FAX (505) 797-8535

APPROVED AS RECORD DRAWINGS
DESIGN REVIEW SECTION
CITY CONSTRUCTION ENGINEER
Paul O. Olson
DATE: 7-02-2009

* Staircase on Sheet 11 no part of work order and not built per these plans

DRB PROJECT NO.

1004675

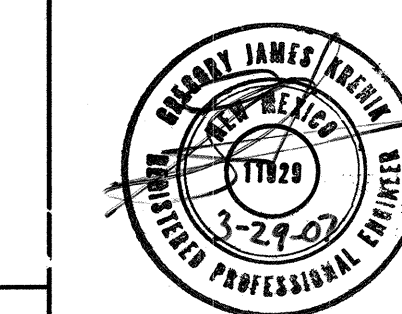

	DRC CHAIRMAN
	TRANSPORTATION
	WATER/WASTEWATER
	HYDROLOGY
	CIF
	CONSTR. MNGMT.
	CONSTR. COORD.
	AMA/EA

APPROVED FOR CONSTRUCTION

Keith W. [Signature] 5-28-07
ENGINEER DATE

A.M.A.F.C.A.	<i>[Signature]</i>
CITY PROJECT NO.	791487

SHEET OF
1 24

A05:JOBS\A5080 VISTA DE : A LUZ\dwg\plans\A5080 Title Sheet.dwg 03-23-07 R00

RECORD DRAWINGS
CERTIFICATE OF SUBSTANTIAL COMPLIANCE ON PLANS

I, Gregory J. Krenik, NMPE # 11999, of the firm Mark Goodwin & Associates, PA, a Registered Professional Engineer in the State of New Mexico, do hereby certify, to the best of my knowledge and belief, that the infrastructure installed as part of this project has been inspected by me or by a qualified person under my direct supervision, and has been constructed in accordance with the plans and specifications approved by the City Engineer and that the original design intent of the approved plans has been met, except as noted by me on the as-built construction drawings. This Certification is based on site inspections by me or personnel under my direct supervision, and survey information provided by Timothy Aldrich, NMPS # 77119.

I, Gregory J. Krenik, certify that this electronic version is identical to the original reproducible APPROVED FOR CONSTRUCTION drawings signed by me on 5-7-08 5-29-08 2007.

This set of drawings is accepted for RECORD purposes by _____ on _____, 2007

SURVEYOR'S CERTIFICATION

"I, Timothy Aldrich, a duly qualified Registered Professional Land Surveyor under the laws of the State of New Mexico, do hereby certify that the 'as-built' information shown on these drawings was obtained from field construction and 'as-built' surveys performed by me or under my supervision, that the 'as-built' information shown on these drawings was added to the drawings by me or under my supervision, and that this 'as-built' information is true and correct to the best of my knowledge and belief. I, Timothy Aldrich Land Surveying is not responsible for any of the design concepts,

Timothy Aldrich, P., No. 7719

INDEX TO DRAWINGS


SHEET NO.	SHEET
1	TITLE SHEET
2-4	PLAT
5-6	GRADING AND DRAINAGE PLAN
7-8	<u>PAVING IMPROVEMENTS</u>
9-10	MASTER PAVING PLAN & DETAILS
11	SEVILLA AVENUE NW
12	COSTA UASCA DRIVE NW
13	SALA DE TOMAS DRIVE NW & OJOS AZUL COURT NW
14	COSTA MARESME DRIVE NW
15	COSTA ALMERIA DRIVE NW
16	COSTA UERDE ROAD NW & COSTA GARRAF ROAD NW
16B	COORS BOULEVARD N.W.
	TRAFFIC SIGNAL PLAN
	<u>UTILITY IMPROVEMENTS</u>
17	MASTER UTILITY PLAN
18	SEVILLA AVENUE N.W.
19	COSTA UASCA DRIVE N.W.
20	SALA DE TOMAS DR. & OJOS AZUL CT. N.W.
21, 21A	COSTA MARESME DRIVE N.W.
22	COSTA ALMERIA DRIVE N.W.
23	COSTA UERDE ROAD NW
24	COSTA GARRAF ROAD NW

PLAT FOR
VISTA DE LA LUZ
WITHIN
SECTION 35
TOWNSHIP 11 NORTH, RANGE 2 EAST, NMPM
CITY OF ALBUQUERQUE
BERNALILLO COUNTY, NEW MEXICO
OCTOBER, 2006

LINE TABLE			
LINE	LENGTH	BEARING	
L1	116.93	N89°43'20"W	
L2	286.29	N81°11'45"W	
L3	93.12	N76°03'18"W	
L4	176.82	S71°30'46"W	
L5	229.77	N66°31'44"W	
L6	1118.12	N00°18'18"E	
L7	750.85	S00°18'51"W	
L8	440.13	S83°09'22"E	
L9	387.04	S30°56'43"E	
L10	6.47	N58°46'43"E	
L11	0.85	S85°09'22"E	
L12	24.00	S30°56'43"E	
L13	7.04	N58°46'43"E	
L14	6.83	S85°09'22"E	
L15	34.42	S33°11'18"E	
L16	20.91	S85°09'22"E	
L17	39.36	S73°51'18"E	
L18	2.21	N28°52'23"E	
L19	104.12	S81°07'37"E	
L20	102.23	S81°07'37"E	
L21	20.63	N93°52'37"E	
L22	95.79	S81°07'37"E	
L23	85.95	S81°07'37"E	

CURVE TABLE			
CURVE	LENGTH	RADIUS	DELTA
C26	106.31	225.50	27°00'42"
C27	119.98	274.50	25°02'32"
C28	156.05	225.50	39°38'58"
C29	48.59	213.00	13°04'12"
C30	30.08	213.00	8°05'33"
C31	7.83	213.00	2°08'24"
C32	86.50	213.00	23°16'08"
C33	61.19	92.39	37°56'46"
C34	30.26	20.00	86°41'17"
C35	58.55	324.00	10°21'17"
C36	37.70	25.00	88°23'57"
C37	31.42	20.00	90°00'40"
C38	16.09	20.00	46°04'51"
C39	15.33	20.00	43°54'28"
C40	11.05	20.00	89°59'20"
C41	11.05	20.00	31°40'06"
C42	20.36	20.00	90°00'00"
C43	31.42	20.00	90°00'00"
C44	20.36	20.00	91°08'21"
C45	11.05	20.00	31°40'06"
C46	31.42	20.00	90°00'00"
C47	4.41	20.00	12°37'23"
C48	27.01	20.00	77°23'18"
C49	31.42	20.00	90°00'40"
C50	4.39	20.00	12°34'20"

CURVE TABLE			
CURVE	LENGTH	RADIUS	DELTA
C1	918.04	3894.72	13°30'20"
C2	149.58	300.00	25°42'05"
C3	134.64	300.00	28°42'50"
C4	49.02	300.00	9°21'42"
C5	333.24	300.00	63°38'37"
C6	139.78	300.00	26°41'43"
C7	127.72	75.00	97°34'09"
C8	323.85	300.00	61°51'04"
C9	12.30	300.00	22°10'00"
C10	356.18	300.00	64°12'04"
C11	164.97	250.00	37°48'29"
C12	173.00	250.00	39°38'58"
C13	467.01	3894.72	6°52'13"
C14	84.14	3894.72	1°14'16"
C15	79.49	3894.72	1°10'10"
C16	193.33	3894.72	2°50'39"
C17	46.61	30.00	89°01'20"
C18	85.34	250.00	19°33'29"
C19	47.26	257.00	77°21'34"
C20	22.46	287.00	4°29'00"
C21	35.12	287.00	6°20'04"
C22	31.73	287.00	7°00'39"
C23	100.56	287.00	20°34'44"
C24	188.18	287.00	37°34'00"
C25	188.96	274.50	39°38'58"

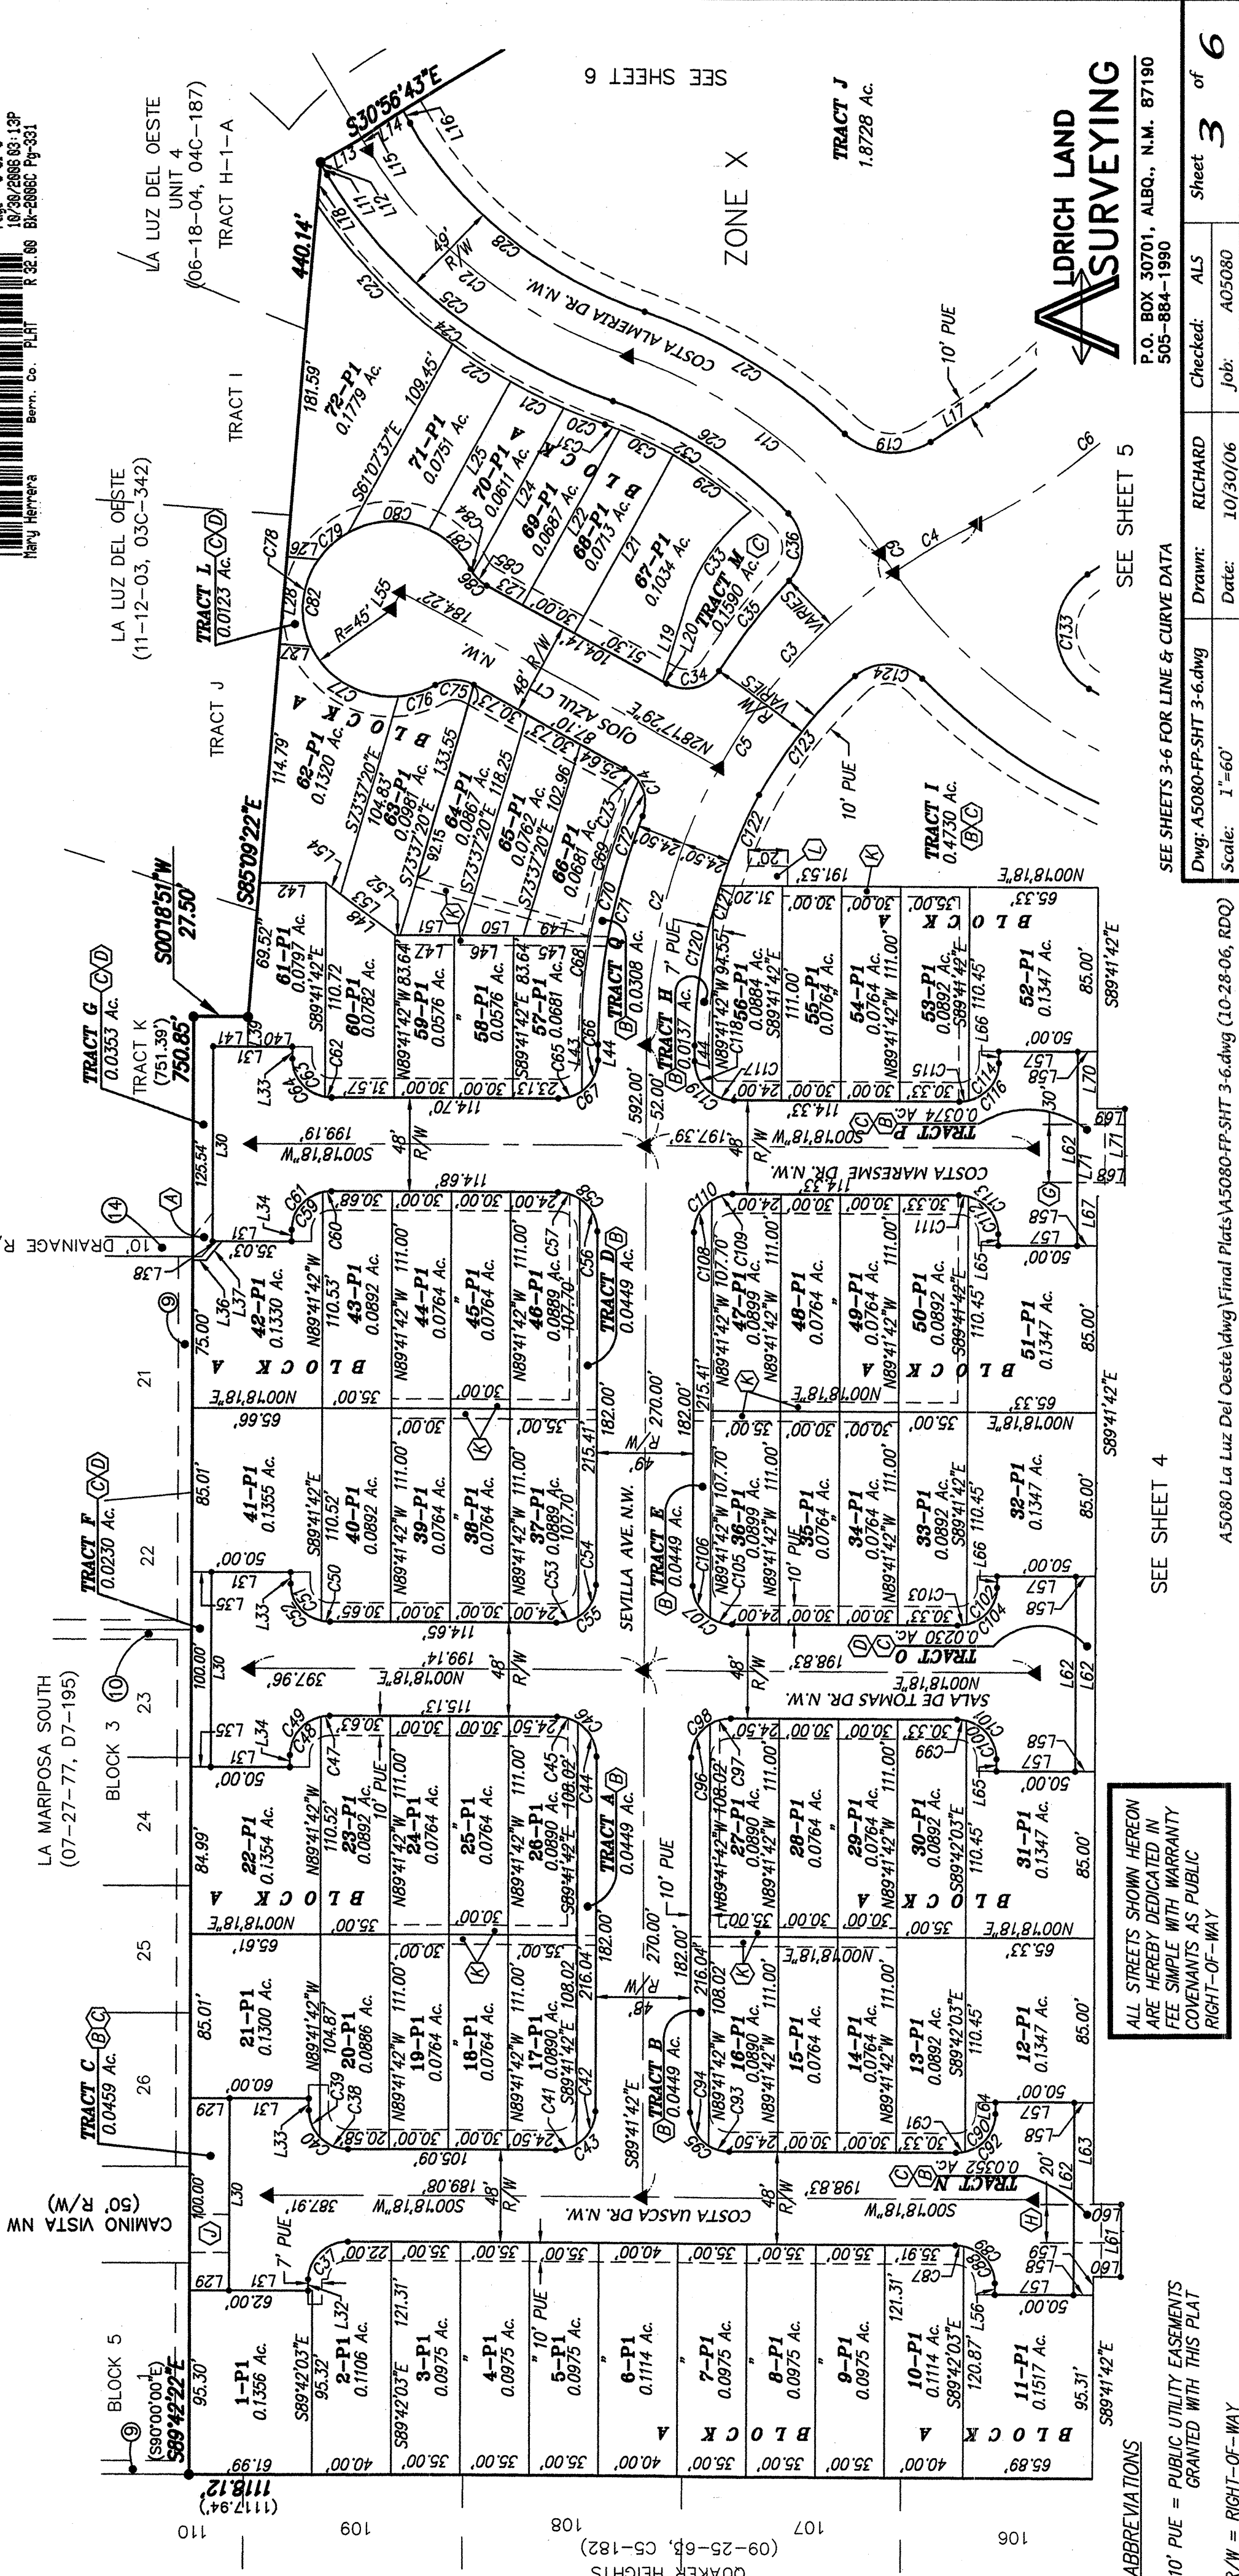

ALL STREETS SHOWN HEREON
ARE HEREBY DEDICATED IN
FEE SIMPLE WITH WARRANTY
COMMITMENTS AS PUBLIC
RIGHT-OF-WAY

SEE SHEET 4

SEE SHEET 5

SEE SHEET 6

SEE SHEETS 3-6 FOR LINE & CURVE DATA


45080 La Luz Del Oeste (dwg) Final Plats V5080-FP-SHT 3-6.dwg (10-28-06, RDQ)

45080 La Luz Del Oeste (dwg) Final Plats V5080-FP-SHT 3-6.dwg (10-28-06, RDQ)

Sheet 3 of 6

PLAT FOR
VISTA DE LA LUZ
WITHIN
SECTION 35
TOWNSHIP 11 NORTH, RANGE 2 EAST, NMPM
CITY OF ALBUQUERQUE
BERNALILLO COUNTY, NEW MEXICO
OCTOBER, 2006

LINE TABLE			
LINE	LENGTH	BEARING	
L26	18.03	N04°50'38"E	
L27	16.03	N04°50'38"E	
L28	45.00	S83°09'22"E	
L29	20.00	N00°17'36"E	
L30	100.00	S89°42'22"E	
L31	40.00	N00°17'36"E	
L32	5.99	S89°42'22"E	
L33	5.99	S89°42'22"E	
L34	5.99	S89°42'22"E	
L35	10.00	N00°17'36"E	
L36	12.85	N00°17'36"E	
L37	12.85	N00°17'36"E	
L38	13.53	S89°42'22"E	
L39	22.50	N00°17'36"E	
L40	17.50	N00°17'36"E	
L41	33.57	N00°17'36"E	
L42	48.00	S89°42'22"E	
L43	6.00	S89°42'22"E	
L44	38.81	N00°17'36"E	
L45	30.00	N00°17'36"E	
L46	30.00	N00°17'36"E	
L47	30.00	N00°17'36"E	
L48	44.44	N38°20'32"E	
L49	33.75	N00°17'36"E	
L50	31.22	N00°17'36"E	
L51	2.62	N00°17'36"E	
L52	35.03	N38°20'32"E	
L53	9.92	N61°42'31"W	
L54	6.00	S89°41'42"E	
L55	40.00	N00°18'18"E	
L56	10.00	S00°18'18"W	
L57	9.69	S89°41'42"E	
L58	14.00	S00°18'18"W	
L59	38.00	S89°41'42"E	
L60	100.00	S89°41'42"E	
L61	52.31	S89°41'42"E	
L62	6.00	N89°41'42"W	
L63	6.00	N89°41'42"W	
L64	6.00	N89°41'42"W	
L65	25.69	S00°18'18"W	
L66	14.00	S00°18'18"W	
L67	29.31	S89°41'42"E	
L68	45.00	S89°41'42"E	
L69	9.31	S89°41'42"E	
L70	20.50	S89°41'42"E	
L71	24.50	S89°41'42"E	
L72	20.50	S89°41'42"E	
L73	20.50	S89°41'42"E	
L74	20.50	S89°41'42"E	
L75	20.50	S89°41'42"E	
L76	20.50	S89°41'42"E	
L77	20.50	S89°41'42"E	
L78	20.50	S89°41'42"E	
L79	20.50	S89°41'42"E	
L80	20.50	S89°41'42"E	
L81	20.50	S89°41'42"E	
L82	20.50	S89°41'42"E	
L83	20.50	S89°41'42"E	
L84	20.50	S89°41'42"E	
L85	20.50	S89°41'42"E	
L86	20.50	S89°41'42"E	
L87	20.50	S89°41'42"E	
L88	20.50	S89°41'42"E	

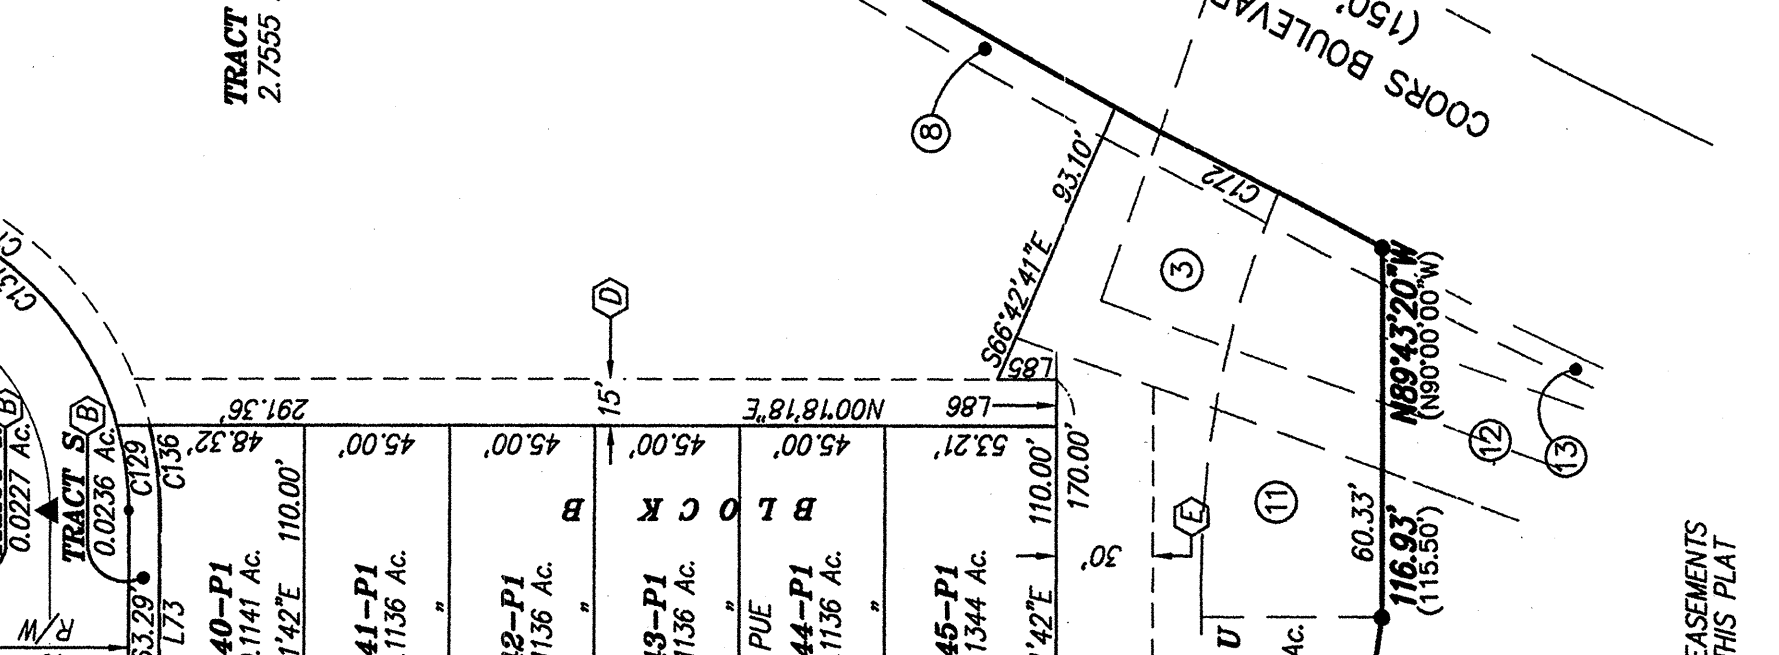

ALL STREETS SHOWN HEREON
ARE HEREBY DEDICATED IN
FEE SIMPLE WITH WARRANTY
COMMITMENTS AS PUBLIC
RIGHT-OF-WAY

SEE SHEET 4

SEE SHEET 5

SEE SHEET 6

SEE SHEETS 3-6 FOR LINE & CURVE DATA

45080 La Luz Del Oeste (dwg) Final Plats V5080-FP-SHT 3-6.dwg (10-28-06, RDQ)

45080 La Luz Del Oeste (dwg) Final Plats V5080-FP-SHT 3-6.dwg (10-28-06, RDQ)

Sheet 4 of 6

PLAT FOR
VISTA DE LA LUZ

SECTION 35
TOWNSHIP 11 NORTH, RANGE 2 EAST, NMPM
CITY OF ALBUQUERQUE
BERNALILLO COUNTY, NEW MEXICO
OCTOBER, 2006

NOTES:


- Bearings are New Mexico State Plane Grid Bearings (Central Zone).
- Distances are ground distances.
- Bearings and distances in parenthesis are record.
- Basis of boundary are the following plats of record entitled:
 - PLAT OF KINSCHERFF LANDS, (01-25-78, B14-44)
 - PLAT OF QUAKER HEIGHTS ADDITION, (06-17-75, A5-140)
 - PLAT OF LA LUZ DEL OESTE, (11-12-03, 00C-340)
 - PLAT OF LA LUZ DEL OESTE, UNIT 4, (08-18-04, 04C-187)
 - PLAT OF WESTERN TRAILS ESTATES, (01-13-05, 05C-14)
- Title Report: Provided by First American Title Insurance Co. No. NM03163693-AL02, VC (Effective date: 06-01-05)
- Flood Zone Designation: Zone X and A (100-Year Flood Confined To Constructed Channel) of Panel 114 of 825, Flood Insurance Rate Map, City of Albuquerque, Bernalillo County, New Mexico, dated September 20, 1986. (This Property does not lie within the 100 Year Flood Plain.)
- Unless otherwise noted all boundary corners are set #5 rebar with cap "ALS LS 7719" (TYP).
- All street centerline Monumentation shall be installed at all pc's, pt's, angle points and street intersections and shown thus (▲) and will be marked by (4") Aluminum Cap stamped:
"CITY OF ALBUQUERQUE
CENTERLINE MONUMENTATION
DO NOT DISTURB PS 7719"
- All lots shown with the P-1 designation shall conform to intermittent parking design criteria.
- Tracts A, B, C, D, E, F, G, H, I, M, N, O, P, Q, R, S, T, and U are for the benefit of and to be owned and maintained by the Homeowners Association.
- Tracts J and K are reserved for future development.

- NEW EASEMENTS**
- NEW 10' PUBLIC DRAINAGE EASEMENT GRANTED TO THE COA WITH THIS PLAT.
 - NEW LANDSCAPE AND PUBLIC ACCESS EASEMENTS TO BE OWNED AND MAINTAINED BY THE HOMEOWNERS ASSOCIATION.
 - NEW PRIVATE COMMON AREA TO BE OWNED AND MAINTAINED BY THE HOMEOWNERS ASSOCIATION.
 - NEW LANDSCAPE EASEMENTS TO BE OWNED AND MAINTAINED BY THE HOMEOWNERS ASSOCIATION.
 - NEW 30' PUBLIC WATERLINE & SANITARY SEWER EASEMENT GRANTED TO COA WITH THIS PLAT.
 - NEW 45' PUBLIC DRAINAGE & TRAIL ACCESS EASEMENT GRANTED TO COA WITH THIS PLAT.
 - NEW 30' PUBLIC ACCESS, SANITARY SEWER & DRAINAGE EASEMENT GRANTED TO THE COA WITH THIS PLAT.
 - NEW PUBLIC ACCESS & WATERLINE EASEMENT GRANTED TO THE COA WITH THIS PLAT.
 - NEW 38' PUBLIC TRAIL ACCESS EASEMENT GRANTED TO COA WITH THIS PLAT.
 - NEW 20' PUBLIC WATERLINE EASEMENT GRANTED TO COA WITH THIS PLAT.
 - NEW 5' PRIVATE CROSS LOT DRAINAGE EASEMENT GRANTED TO THE ADJACENT LOTS WITH THIS PLAT.
 - NEW 10x20' UTILITY EASEMENT GRANTED EXCLUSIVELY TO ONEST WITH THIS PLAT.

ALL STREETS SHOWN HEREON
ARE HEREBY DEDICATED IN
FEE SIMPLE WITH WARRANTY
COVENANTS AS PUBLIC
RIGHT-OF-WAY

ABBREVIATIONS
10' PUE = PUBLIC UTILITY EASEMENTS
GRANTED WITH THIS PLAT
R/W = RIGHT-OF-WAY

SEE SHEETS 3-6 FOR LINE & CURVE DATA
Dwg: A5080-PP-SHT 3-6.dwg
Scale: 1"=60'

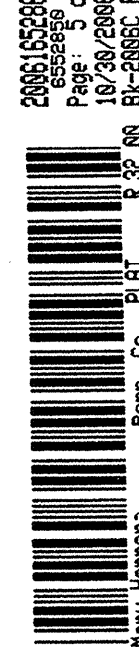

ALDRICH LAND
SURVEYING
P.O. BOX 30701, ALBU., N.M. 87190
505-884-1980

SEE SHEETS 3-6 FOR LINE & CURVE DATA
Dwg: A5080-PP-SHT 3-6.dwg
Scale: 1"=60'

AS080 La Luz Del Oeste.dwg/Vfinal Plots/A5080-PP-SHT 3-6.dwg (10-28-06, RD0)

Drawn: 10/30/06
Date: 10/30/06
Job: A05080
Checked: ALS
Sheet 5 of 6

ALDRICH LAND
SURVEYING
P.O. BOX 30701, ALBU., N.M. 87190
505-884-1980

SEE SHEETS 3-6 FOR LINE & CURVE DATA
Dwg: A5080-PP-SHT 3-6.dwg
Scale: 1"=60'

AS080 La Luz Del Oeste.dwg/Vfinal Plots/A5080-PP-SHT 3-6.dwg (10-28-06, RD0)

Drawn: 10/30/06
Date: 10/30/06
Job: A05080
Checked: ALS
Sheet 5 of 6

PLAT FOR
VISTA DE LA LUZ

SECTION 35
TOWNSHIP 11 NORTH, RANGE 2 EAST, NMPM
CITY OF ALBUQUERQUE
BERNALILLO COUNTY, NEW MEXICO
OCTOBER, 2006

NOTES:

- Bearings are New Mexico State Plane Grid Bearings (Central Zone).
- Distances are ground distances.
- Bearings and distances in parenthesis are record.
- Basis of boundary are the following plats of record entitled:
 - PLAT OF KINSCHERFF LANDS, (01-25-78, B14-44)
 - PLAT OF QUAKER HEIGHTS ADDITION, (06-17-75, A5-140)
 - PLAT OF LA LUZ DEL OESTE, (11-12-03, 00C-340)
 - PLAT OF LA LUZ DEL OESTE, UNIT 4, (08-18-04, 04C-187)
 - PLAT OF WESTERN TRAILS ESTATES, (01-13-05, 05C-14)
- Title Report: Provided by First American Title Insurance Co. No. NM03163693-AL02, VC (Effective date: 06-01-05)
- Flood Zone Designation: Zone X and A (100-Year Flood Confined To Constructed Channel) of Panel 114 of 825, Flood Insurance Rate Map, City of Albuquerque, Bernalillo County, New Mexico, dated September 20, 1986. (This Property does not lie within the 100 Year Flood Plain.)
- Unless otherwise noted all boundary corners are set #5 rebar with cap "ALS LS 7719" (TYP).
- All street centerline Monumentation shall be installed at all pc's, pt's, angle points and street intersections and shown thus (▲) and will be marked by (4") Aluminum Cap stamped:
"CITY OF ALBUQUERQUE
CENTERLINE MONUMENTATION
DO NOT DISTURB PS 7719"
- All lots shown with the P-1 designation shall conform to intermittent parking design criteria.
- Tracts A, B, C, D, E, F, G, H, I, M, N, O, P, Q, R, S, T, and U are for the benefit of and to be owned and maintained by the Homeowners Association.
- Tracts J and K are reserved for future development.

- NEW EASEMENTS**
- NEW 10' PUBLIC DRAINAGE EASEMENT GRANTED TO THE COA WITH THIS PLAT.
 - NEW LANDSCAPE AND PUBLIC ACCESS EASEMENTS TO BE OWNED AND MAINTAINED BY THE HOMEOWNERS ASSOCIATION.
 - NEW PRIVATE COMMON AREA TO BE OWNED AND MAINTAINED BY THE HOMEOWNERS ASSOCIATION.
 - NEW LANDSCAPE EASEMENTS TO BE OWNED AND MAINTAINED BY THE HOMEOWNERS ASSOCIATION.
 - NEW 30' PUBLIC WATERLINE & SANITARY SEWER EASEMENT GRANTED TO COA WITH THIS PLAT.
 - NEW 45' PUBLIC DRAINAGE & TRAIL ACCESS EASEMENT GRANTED TO COA WITH THIS PLAT.
 - NEW 30' PUBLIC ACCESS, SANITARY SEWER & DRAINAGE EASEMENT GRANTED TO THE COA WITH THIS PLAT.
 - NEW PUBLIC ACCESS & WATERLINE EASEMENT GRANTED TO THE COA WITH THIS PLAT.
 - NEW 38' PUBLIC TRAIL ACCESS EASEMENT GRANTED TO COA WITH THIS PLAT.
 - NEW 20' PUBLIC WATERLINE EASEMENT GRANTED TO COA WITH THIS PLAT.
 - NEW 5' PRIVATE CROSS LOT DRAINAGE EASEMENT GRANTED TO THE ADJACENT LOTS WITH THIS PLAT.
 - NEW 10x20' UTILITY EASEMENT GRANTED EXCLUSIVELY TO ONEST WITH THIS PLAT.

ALL STREETS SHOWN HEREON
ARE HEREBY DEDICATED IN
FEE SIMPLE WITH WARRANTY
COVENANTS AS PUBLIC
RIGHT-OF-WAY

ABBREVIATIONS
10' PUE = PUBLIC UTILITY EASEMENTS
GRANTED WITH THIS PLAT
R/W = RIGHT-OF-WAY

SEE SHEETS 3-6 FOR LINE & CURVE DATA
Dwg: A5080-PP-SHT 3-6.dwg
Scale: 1"=60'



ALDRICH LAND
SURVEYING
P.O. BOX 30701, ALBU., N.M. 87190
505-884-1980

SEE SHEETS 3-6 FOR LINE & CURVE DATA
Dwg: A5080-PP-SHT 3-6.dwg
Scale: 1"=60'

AS080 La Luz Del Oeste.dwg/Vfinal Plots/A5080-PP-SHT 3-6.dwg (10-28-06, RD0)

Drawn: 10/30/06
Date: 10/30/06
Job: A05080
Checked: ALS
Sheet 5 of 6

ALDRICH LAND
SURVEYING
P.O. BOX 30701, ALBU., N.M. 87190
505-884-1980






SEE SHEETS 3-6 FOR LINE & CURVE DATA
Dwg: A5080-PP-SHT 3-6.dwg
Scale: 1"=60'

AS080 La Luz Del Oeste.dwg/Vfinal Plots/A5080-PP-SHT 3-6.dwg (10-28-06, RD0)

Drawn: 10/30/06
Date: 10/30/06
Job: A05080
Checked: ALS
Sheet 5 of 6

SCANNED BY
PLANNING

SEE DETAIL THIS SHEET

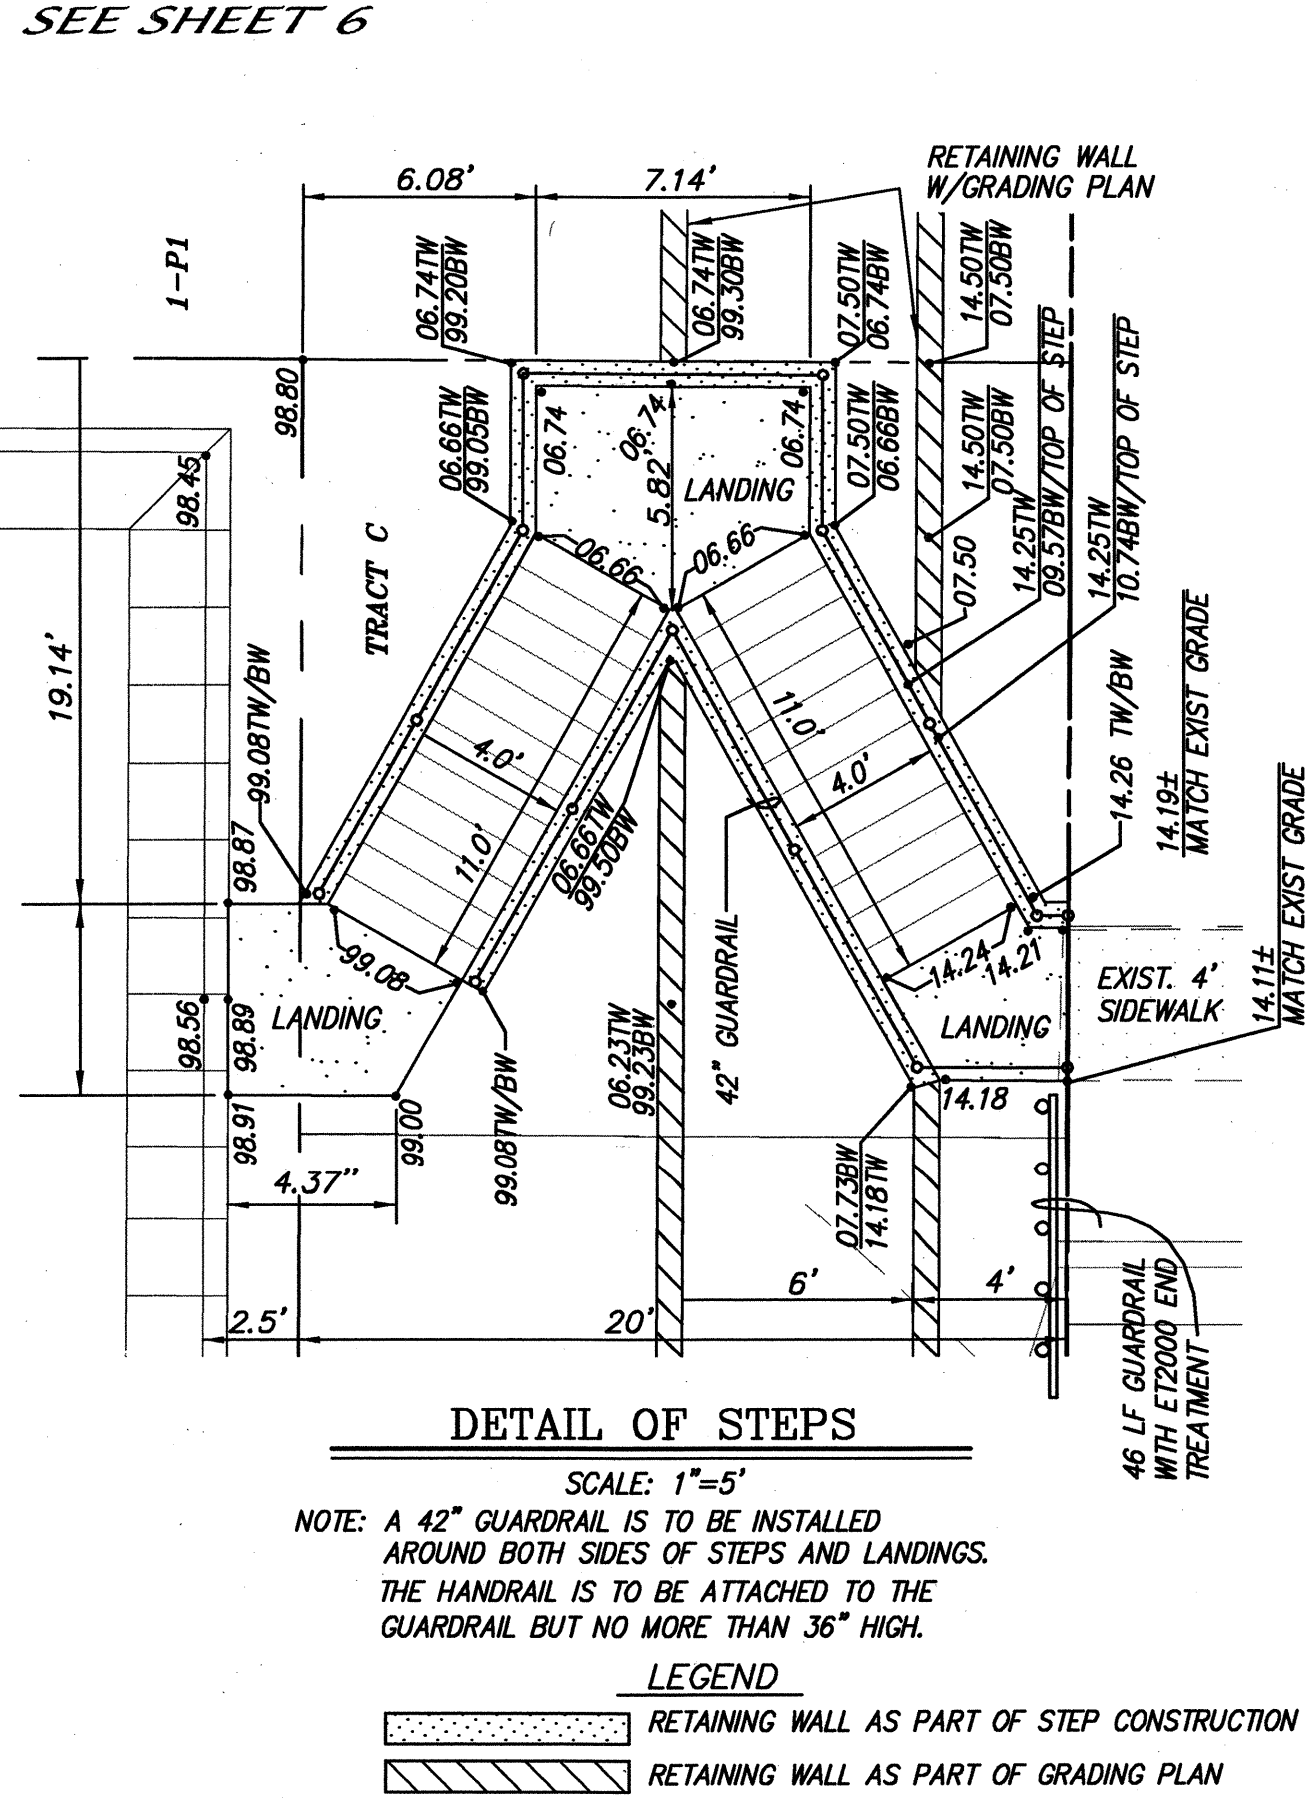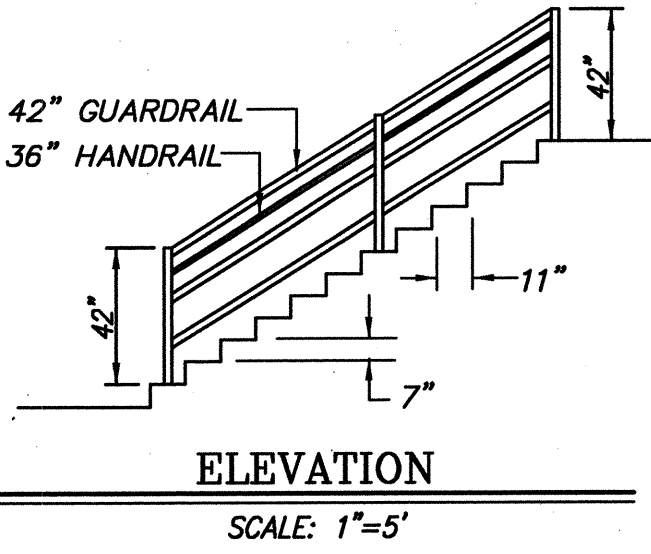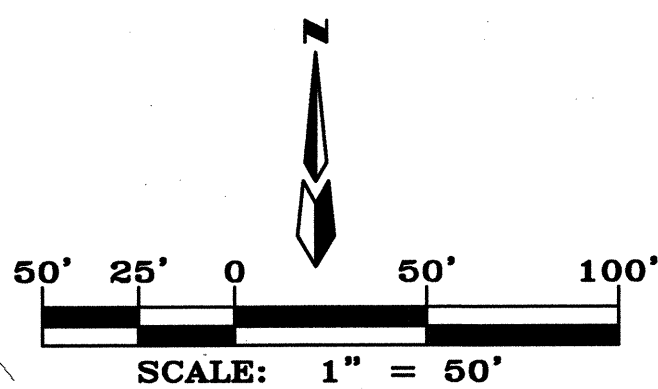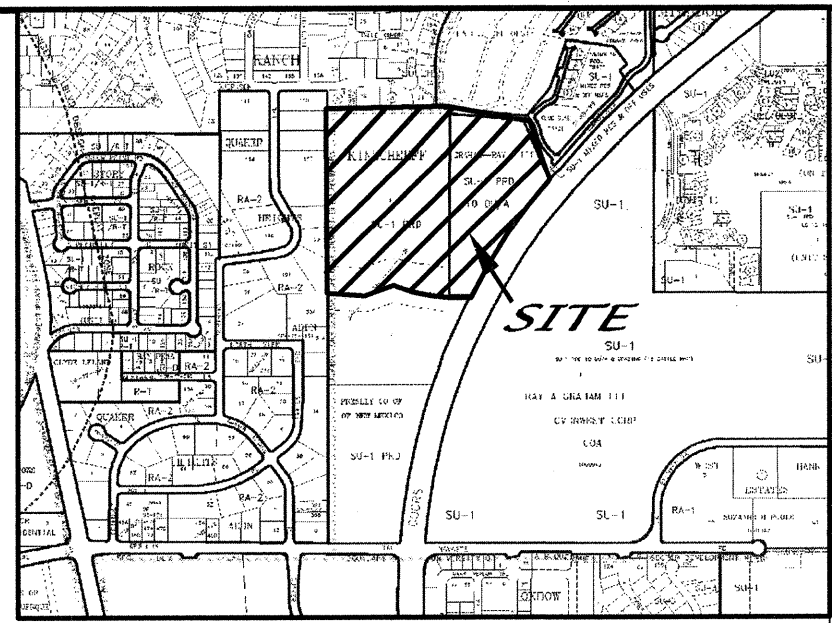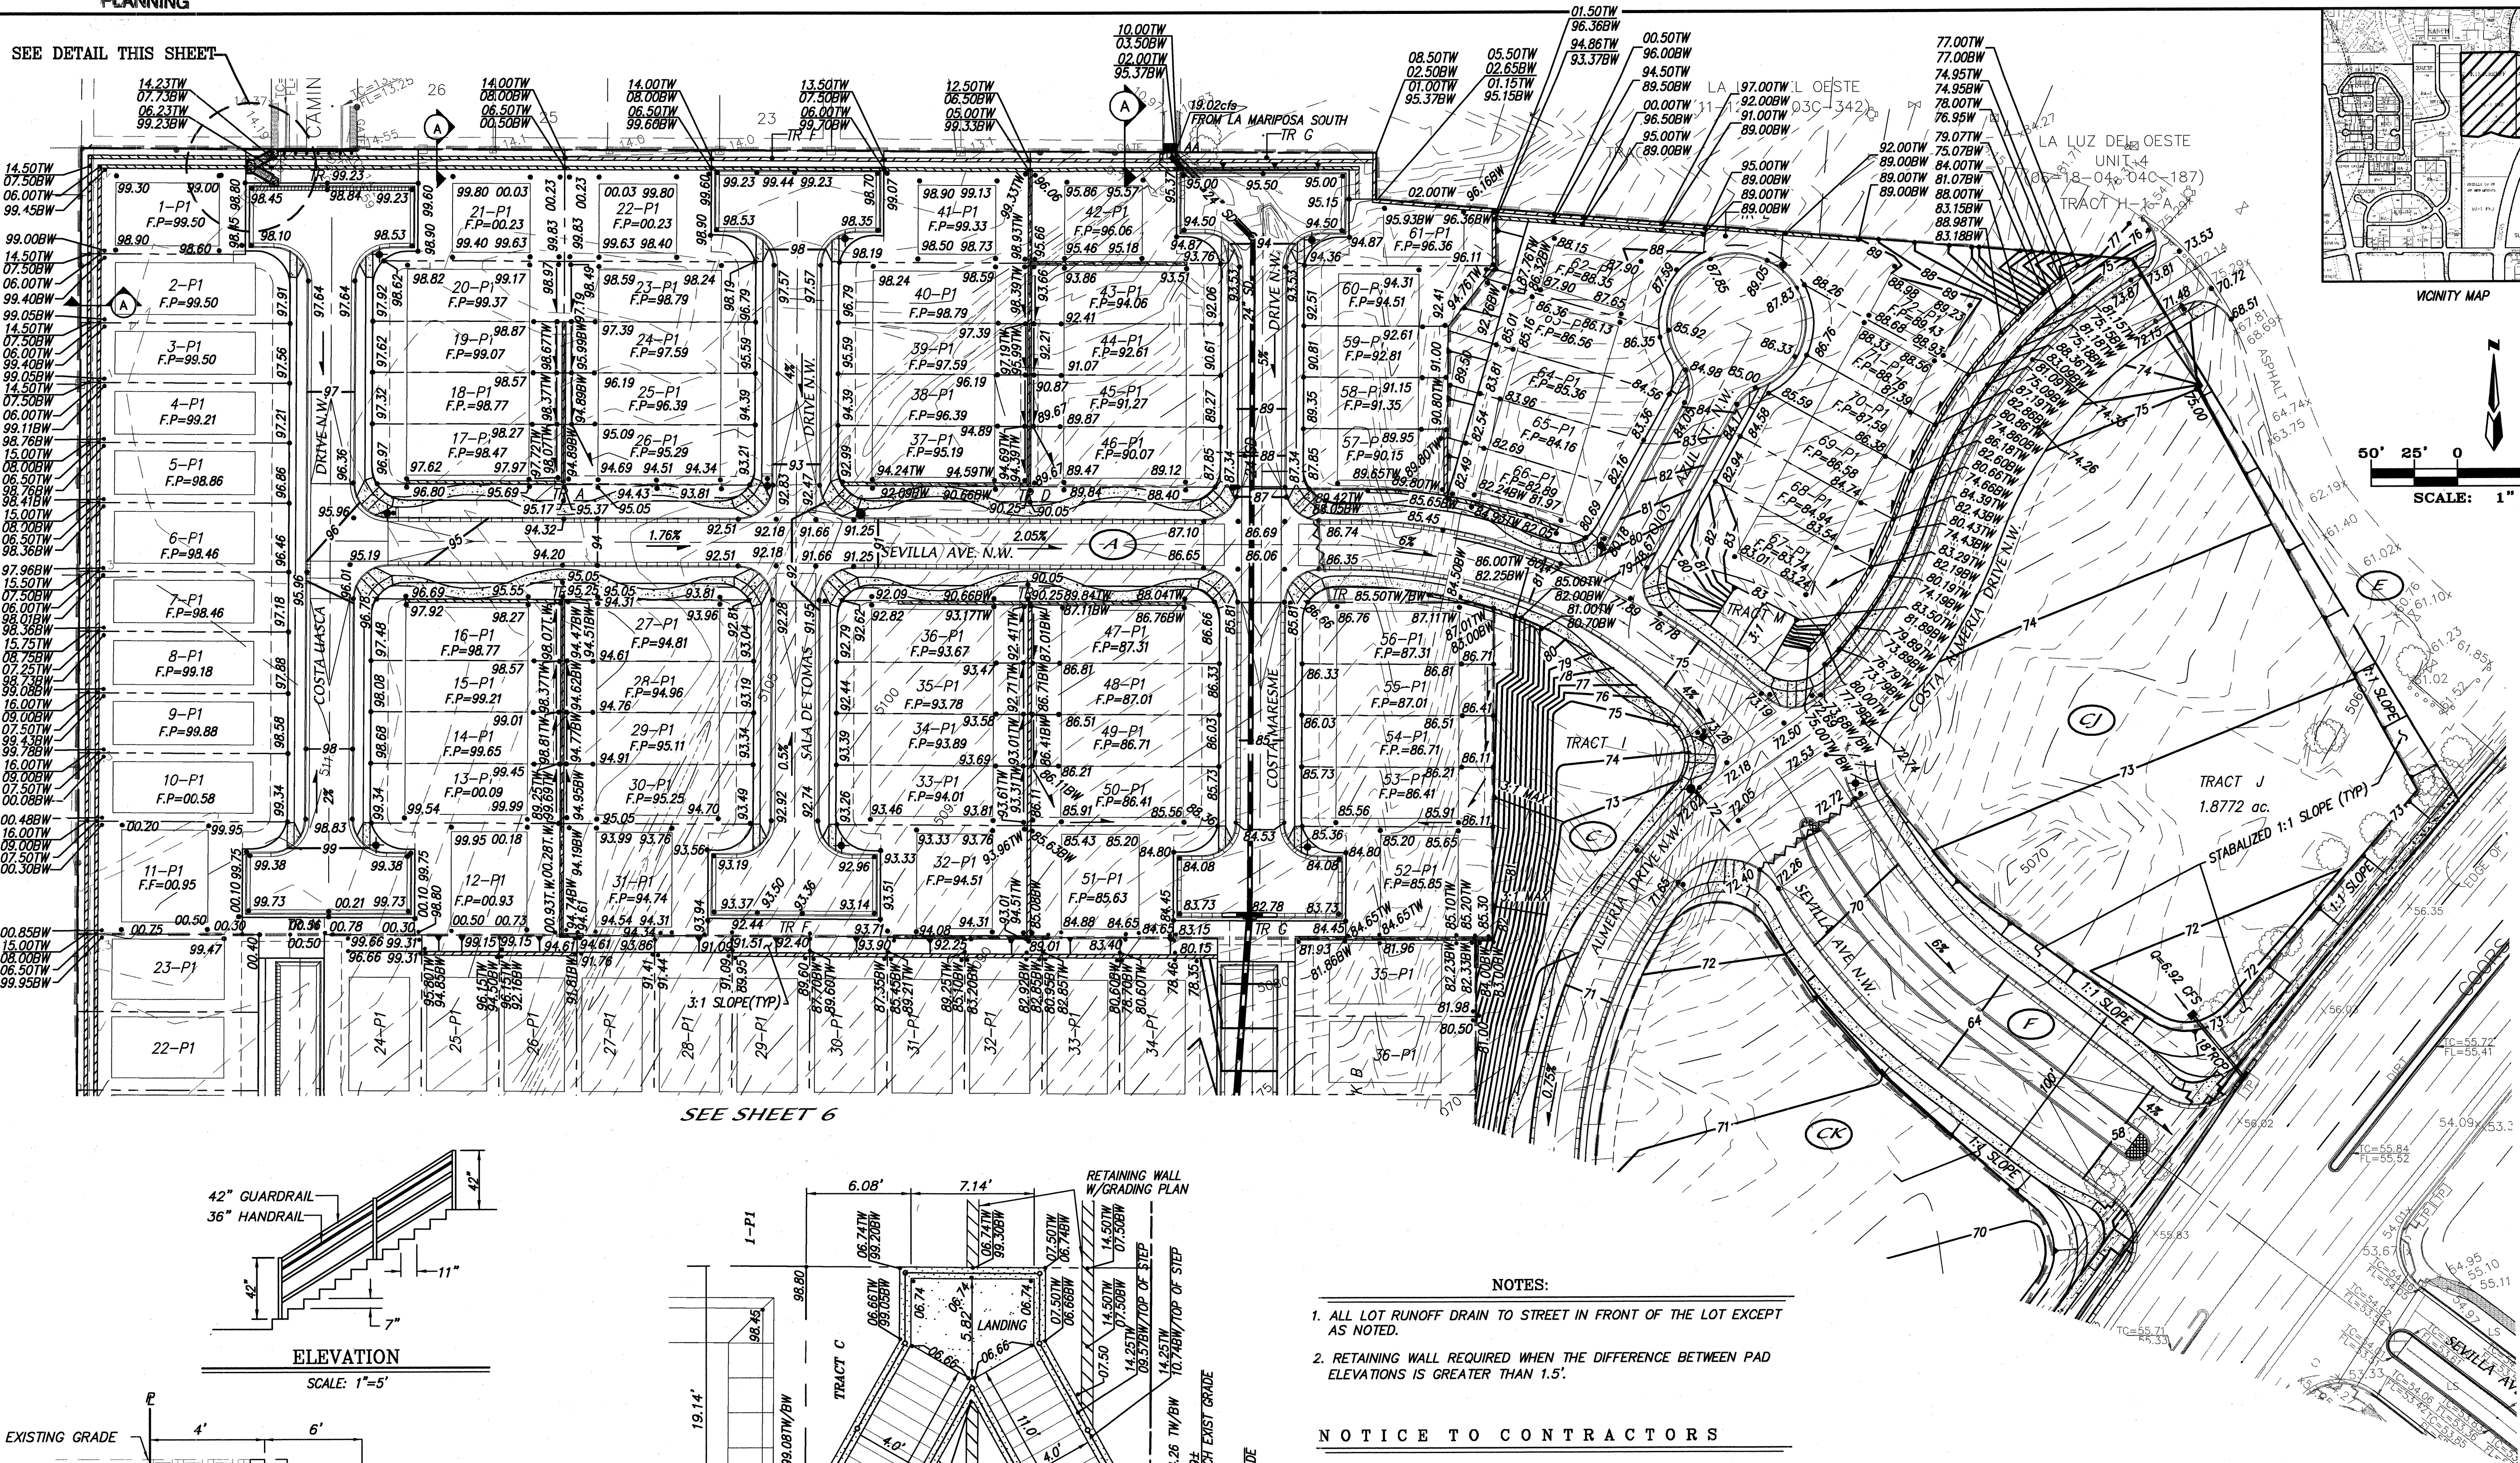

- NOTES:
1. ALL LOT RUNOFF DRAIN TO STREET IN FRONT OF THE LOT EXCEPT AS NOTED.
 2. RETAINING WALL REQUIRED WHEN THE DIFFERENCE BETWEEN PAD ELEVATIONS IS GREATER THAN 1.5'.
- NOTICE TO CONTRACTORS
1. AN EXCAVATION/CONSTRUCTION PERMIT WILL BE REQUIRED BEFORE BEGINNING ANY WORK WITHIN CITY RIGHT OF WAY.
 2. ALL WORK DETAILED ON THESE PLANS TO BE PERFORMED, EXCEPT AS OTHERWISE STATED OR PROVIDED HEREON, SHALL BE CONSTRUCTED IN ACCORDANCE WITH "CITY OF ALBUQUERQUE STANDARD SPECIFICATIONS FOR PUBLIC WORKS CONSTRUCTION" (1985 EDITION).
 3. TWO WORKING DAYS PRIOR TO ANY EXCAVATION, CONTRACTOR MUST CONTACT THE LINE LOCATING SERVICE, 765-1234, FOR LOCATION OF EXISTING UTILITIES.
 4. PRIOR TO CONSTRUCTION, THE CONTRACTOR SHALL EXCAVATE AND VERIFY THE HORIZONTAL AND VERTICAL LOCATIONS OF ALL OBSTRUCTIONS. SHOULD A CONFLICT EXIST, THE CONTRACTOR SHALL NOTIFY THE ENGINEER SO THAT THE CONFLICT CAN BE RESOLVED WITH A MINIMUM AMOUNT OF DELAY.
 5. BACKFILL COMPACTION SHALL BE ACCORDING TO TRAFFIC/STREET USE.
 6. MAINTENANCE OF THESE FACILITIES SHALL BE THE RESPONSIBILITY OF THE OWNER OF THE PROPERTY SERVED.
 7. WORK ON ARTERIAL STREETS SHALL BE PERFORMED ON A 24 HOUR BASIS.

LEGEND

---	EXISTING CONTOUR MAJOR
---	EXISTING CONTOUR MINOR
---	EXISTING SPOT ELEVATIONS
---	EXISTING CURB
---	PROPOSED STD CURB & GUTTER
---	PROPOSED MOUNTABLE CURB & GUTTER
---	PROPERTY LINE
---	DRAINAGE BASIN BOUNDARY
---	DRAINAGE BASIN I.D.
---	NEW RETAINING WALL
---	PROPOSED GRADE
---	PROPOSED CONTOURS
---	PROPOSED WATER BLOCK
---	PROPOSED TOP OF WALL
---	PROPOSED BOTTOM OF WALL

MARK GOODWIN & ASSOCIATES, P.A.
CONSULTING ENGINEERS
P.O. BOX 90606
ALBUQUERQUE, NEW MEXICO 87199
(505) 828-2200, FAX (505) 797-9539




CITY OF ALBUQUERQUE
PUBLIC WORKS DEPARTMENT

TITLE: VISTA DE LA LUZ
GRADING & DRAINAGE PLAN


DESIGN REVIEW COMMITTEE	CITY ENGINEER APPROVAL	MO./DAY/YR.	MO./DAY/YR.
For Information Only			
CITY PROJECT NO.	ZONE MAP NO.	SHEET	OF
791481	F-11	5	24

SCANNED BY
PLANNING

SEE SHEET 5

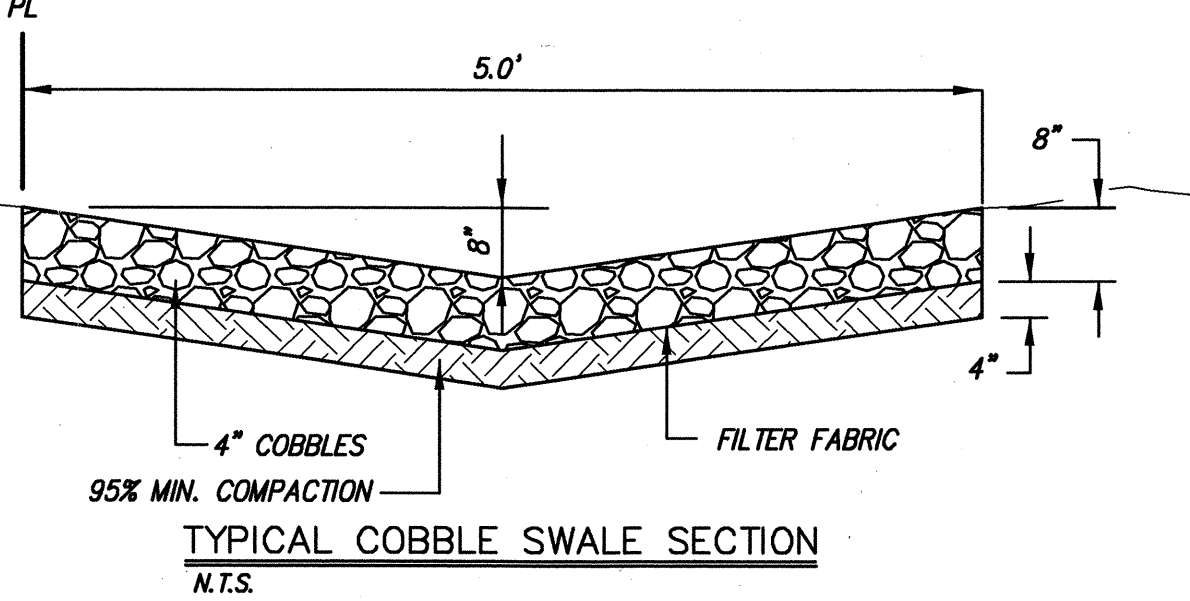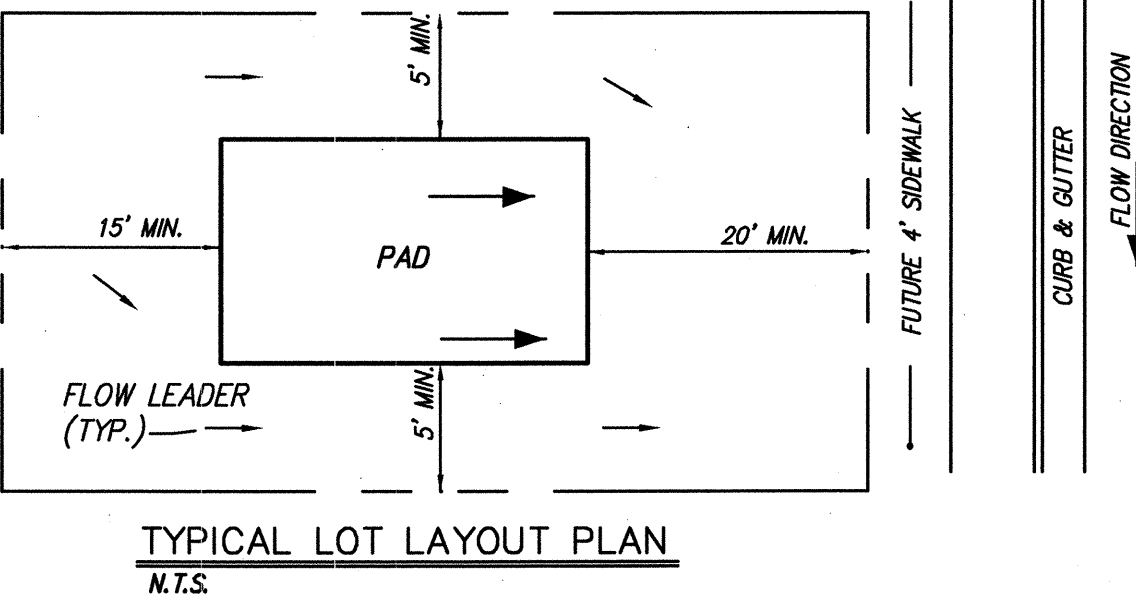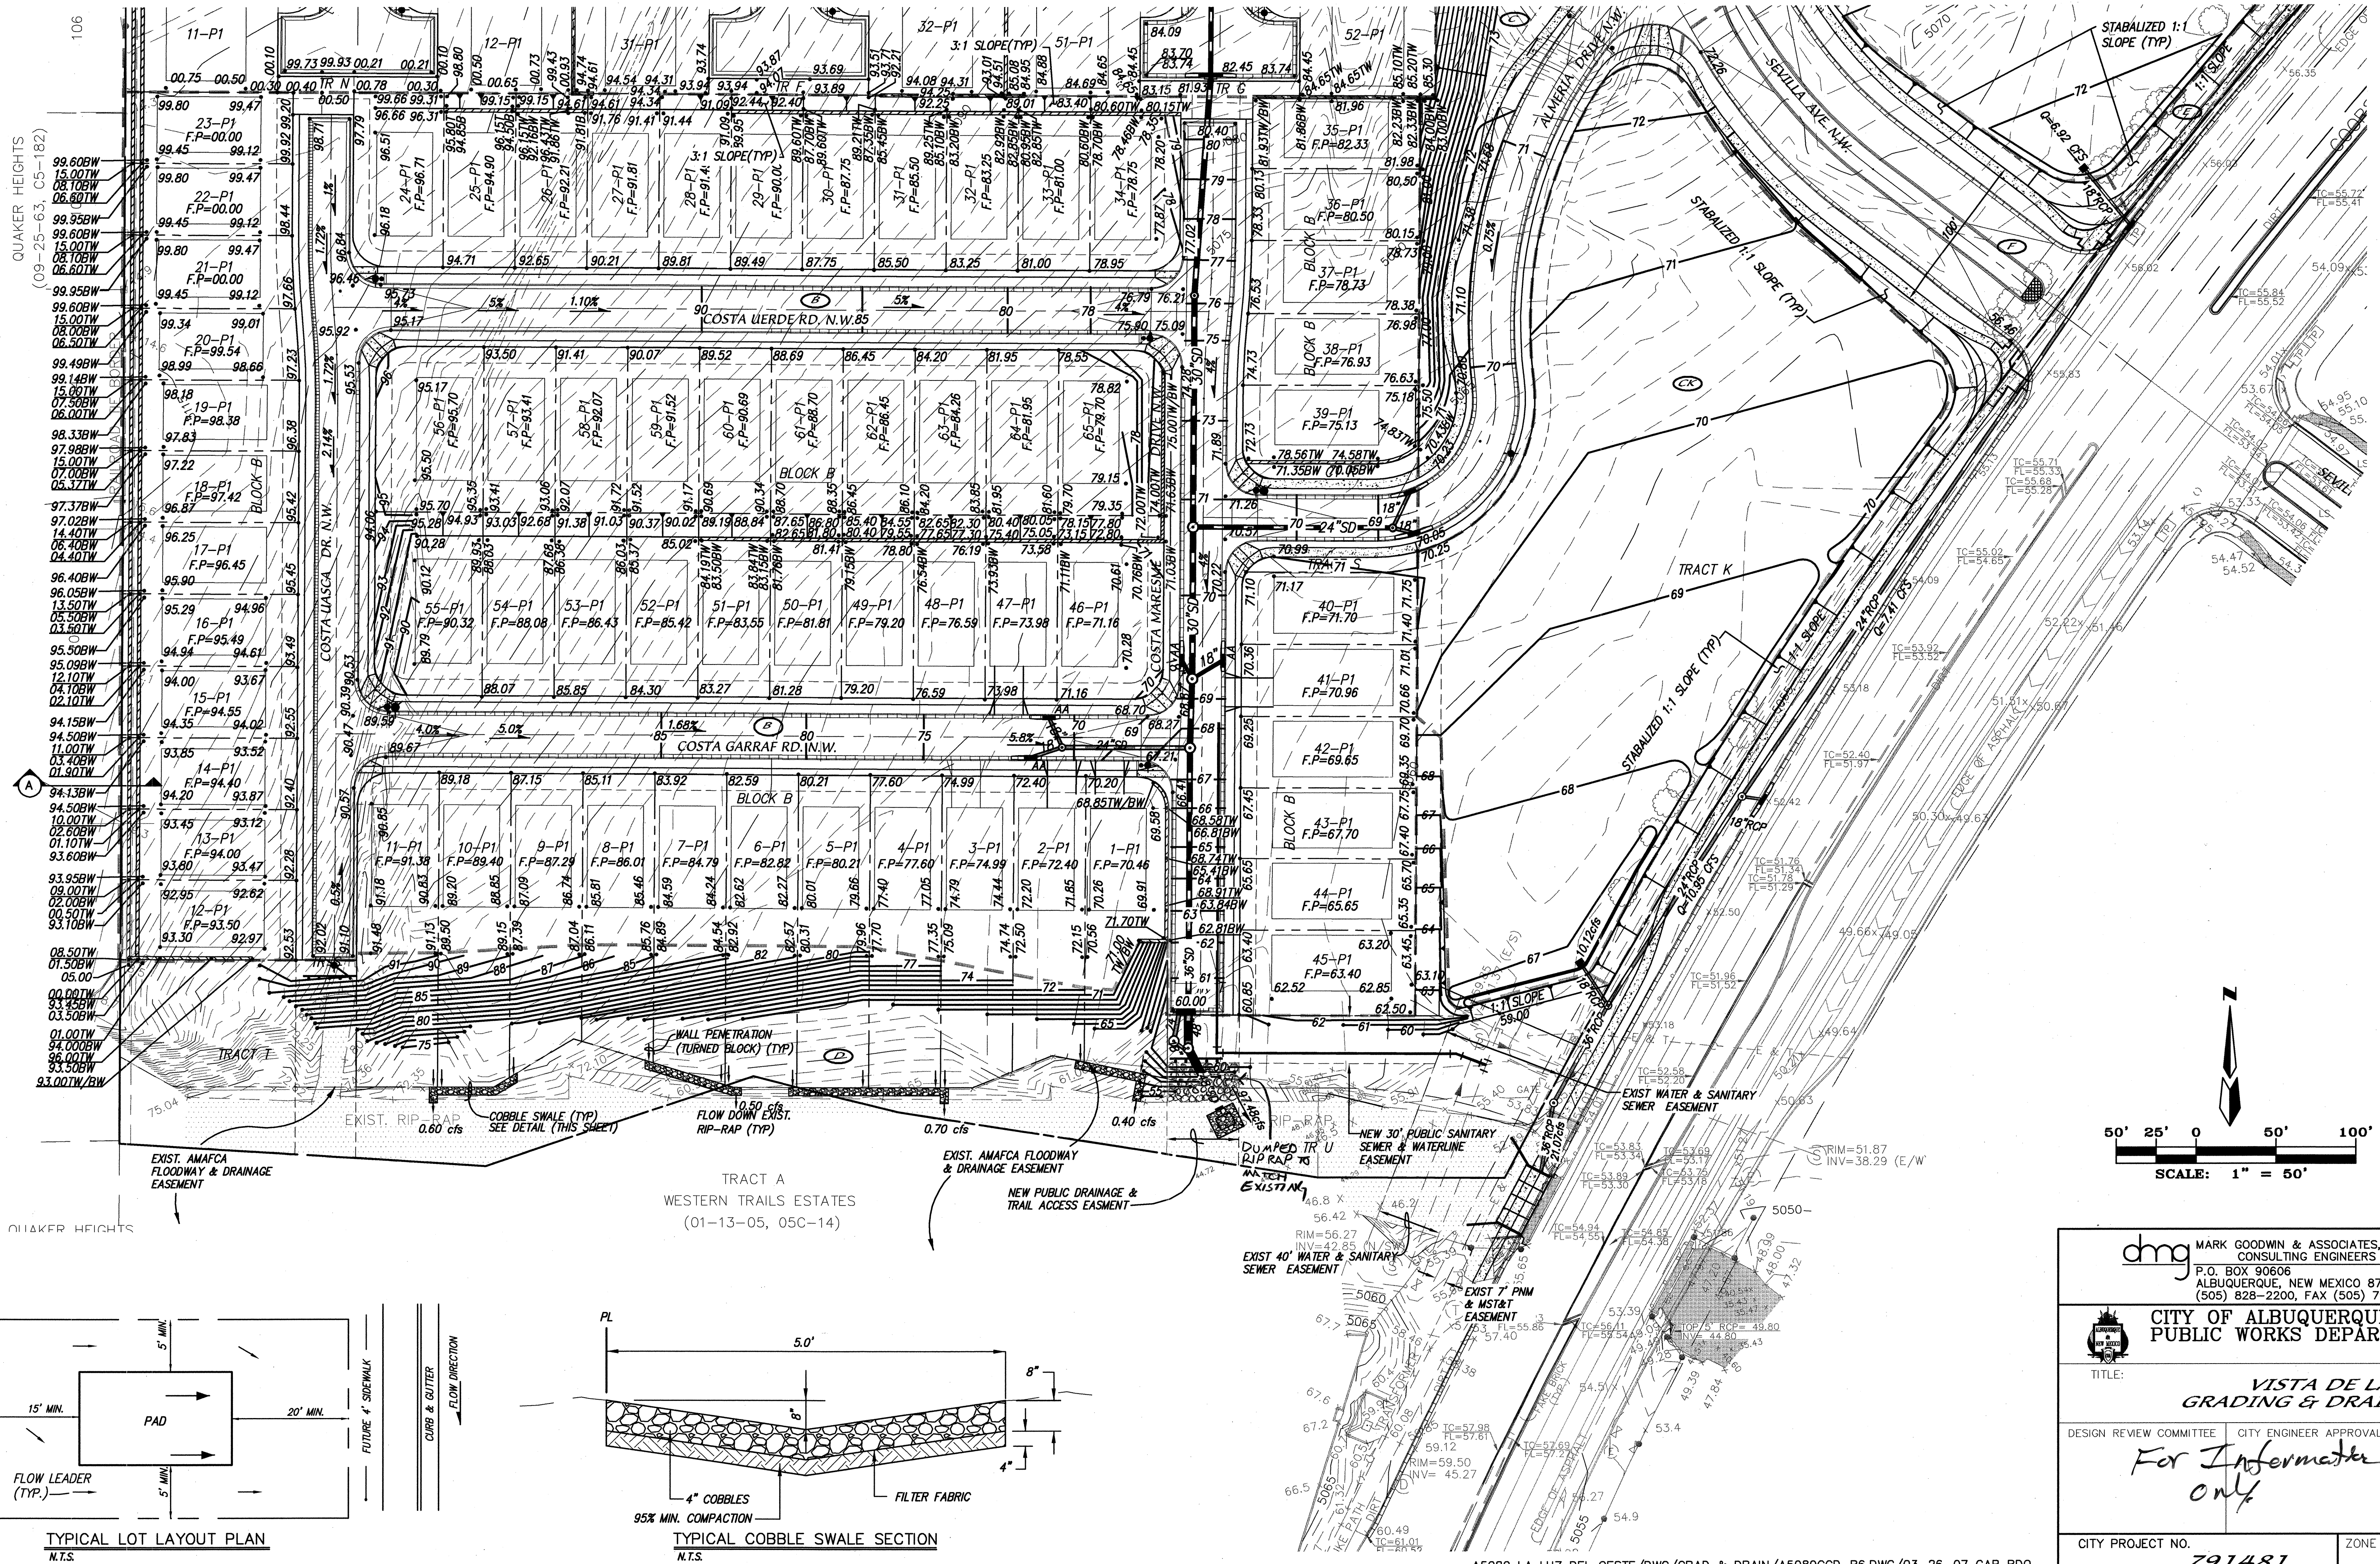

AS BUILT INFORMATION		BENCH MARKS		SURVEY INFORMATION		ENGINEER'S SEAL		REMARKS		DESIGN		REVISIONS		DATE		DATE	
CONTRACTOR	Sundance	CENTERLINE OF ENTRANCE TO LA LUZ CONDOMINIUM	DATE	NO.	BY	NO.	BY	NO.	DATE	NO.	DATE	NO.	DATE	NO.	DATE	NO.	DATE
WORK BY	ALS	GEOGRAPHIC POSITION (NAD 1927), IN FEET 71'	DATE														
SUPERVISOR'S	ALS	FROM CENTERLINE OF COORS BLD. AND 3' FROM	DATE														
ACCEPTANCE BY	ALS	ACS BRASS CAP STAMPED "NM448-N6-A"	DATE														
VEED	ALS	ELEVATION-5058.889 (NGVD29) IN FEET	DATE														
DRAWINGS	ALS	X=566840.72 Y=1507308.30 N.M. STATE PLANE	DATE														
CORRECTED BY	ALS	COORDINATES (CENTRAL ZONE)	DATE														
MICRO-FILM INFORMATION																	
RECORDED BY																	
NO.																	

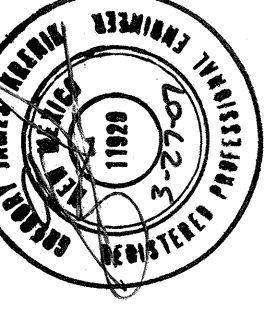

MARK GOODWIN & ASSOCIATES, P.A.
CONSULTING ENGINEERS
P.O. BOX 90806
ALBUQUERQUE, NEW MEXICO 87199
(505) 828-2200, FAX (505) 797-9539

CITY OF ALBUQUERQUE
PUBLIC WORKS DEPARTMENT

TITLE: VISTA DE LA LUZ
GRADING & DRAINAGE PLAN


DESIGN REVIEW COMMITTEE CITY ENGINEER APPROVAL
For Informative only

CITY PROJECT NO. 791481 ZONE MAP NO. F-11 SHEET 6 OF 24

I, Gregory J. Krenik, NMPE 11922, of the firm Mark Goodwin & Associates, P.A., a Registered Professional Engineer in the State of New Mexico, do hereby certify, to the best of my knowledge and belief, that the infrastructure installed as part of this project has been inspected by me or by a qualified person under my direct supervision, and that the infrastructure was installed in accordance with the plans and specifications approved by the City Engineer and that the original design intent of the approved plans and specifications has been followed, except as noted by me on the as-built construction drawings. This Certification is based on site inspections by me or persons under my direct supervision, and is not intended to constitute a warranty or a representation of the accuracy of the information provided by Timothy Aldrich, NMPS number 7719.

Gregory J. Krenik, NMPE 11922
5-7-08
3-2-9 20-07

I, Gregory J. Krenik, certify that the electronic version is identical to the original reproducible APPROVED FOR CONSTRUCTION drawings signed by me on 5-7-08.

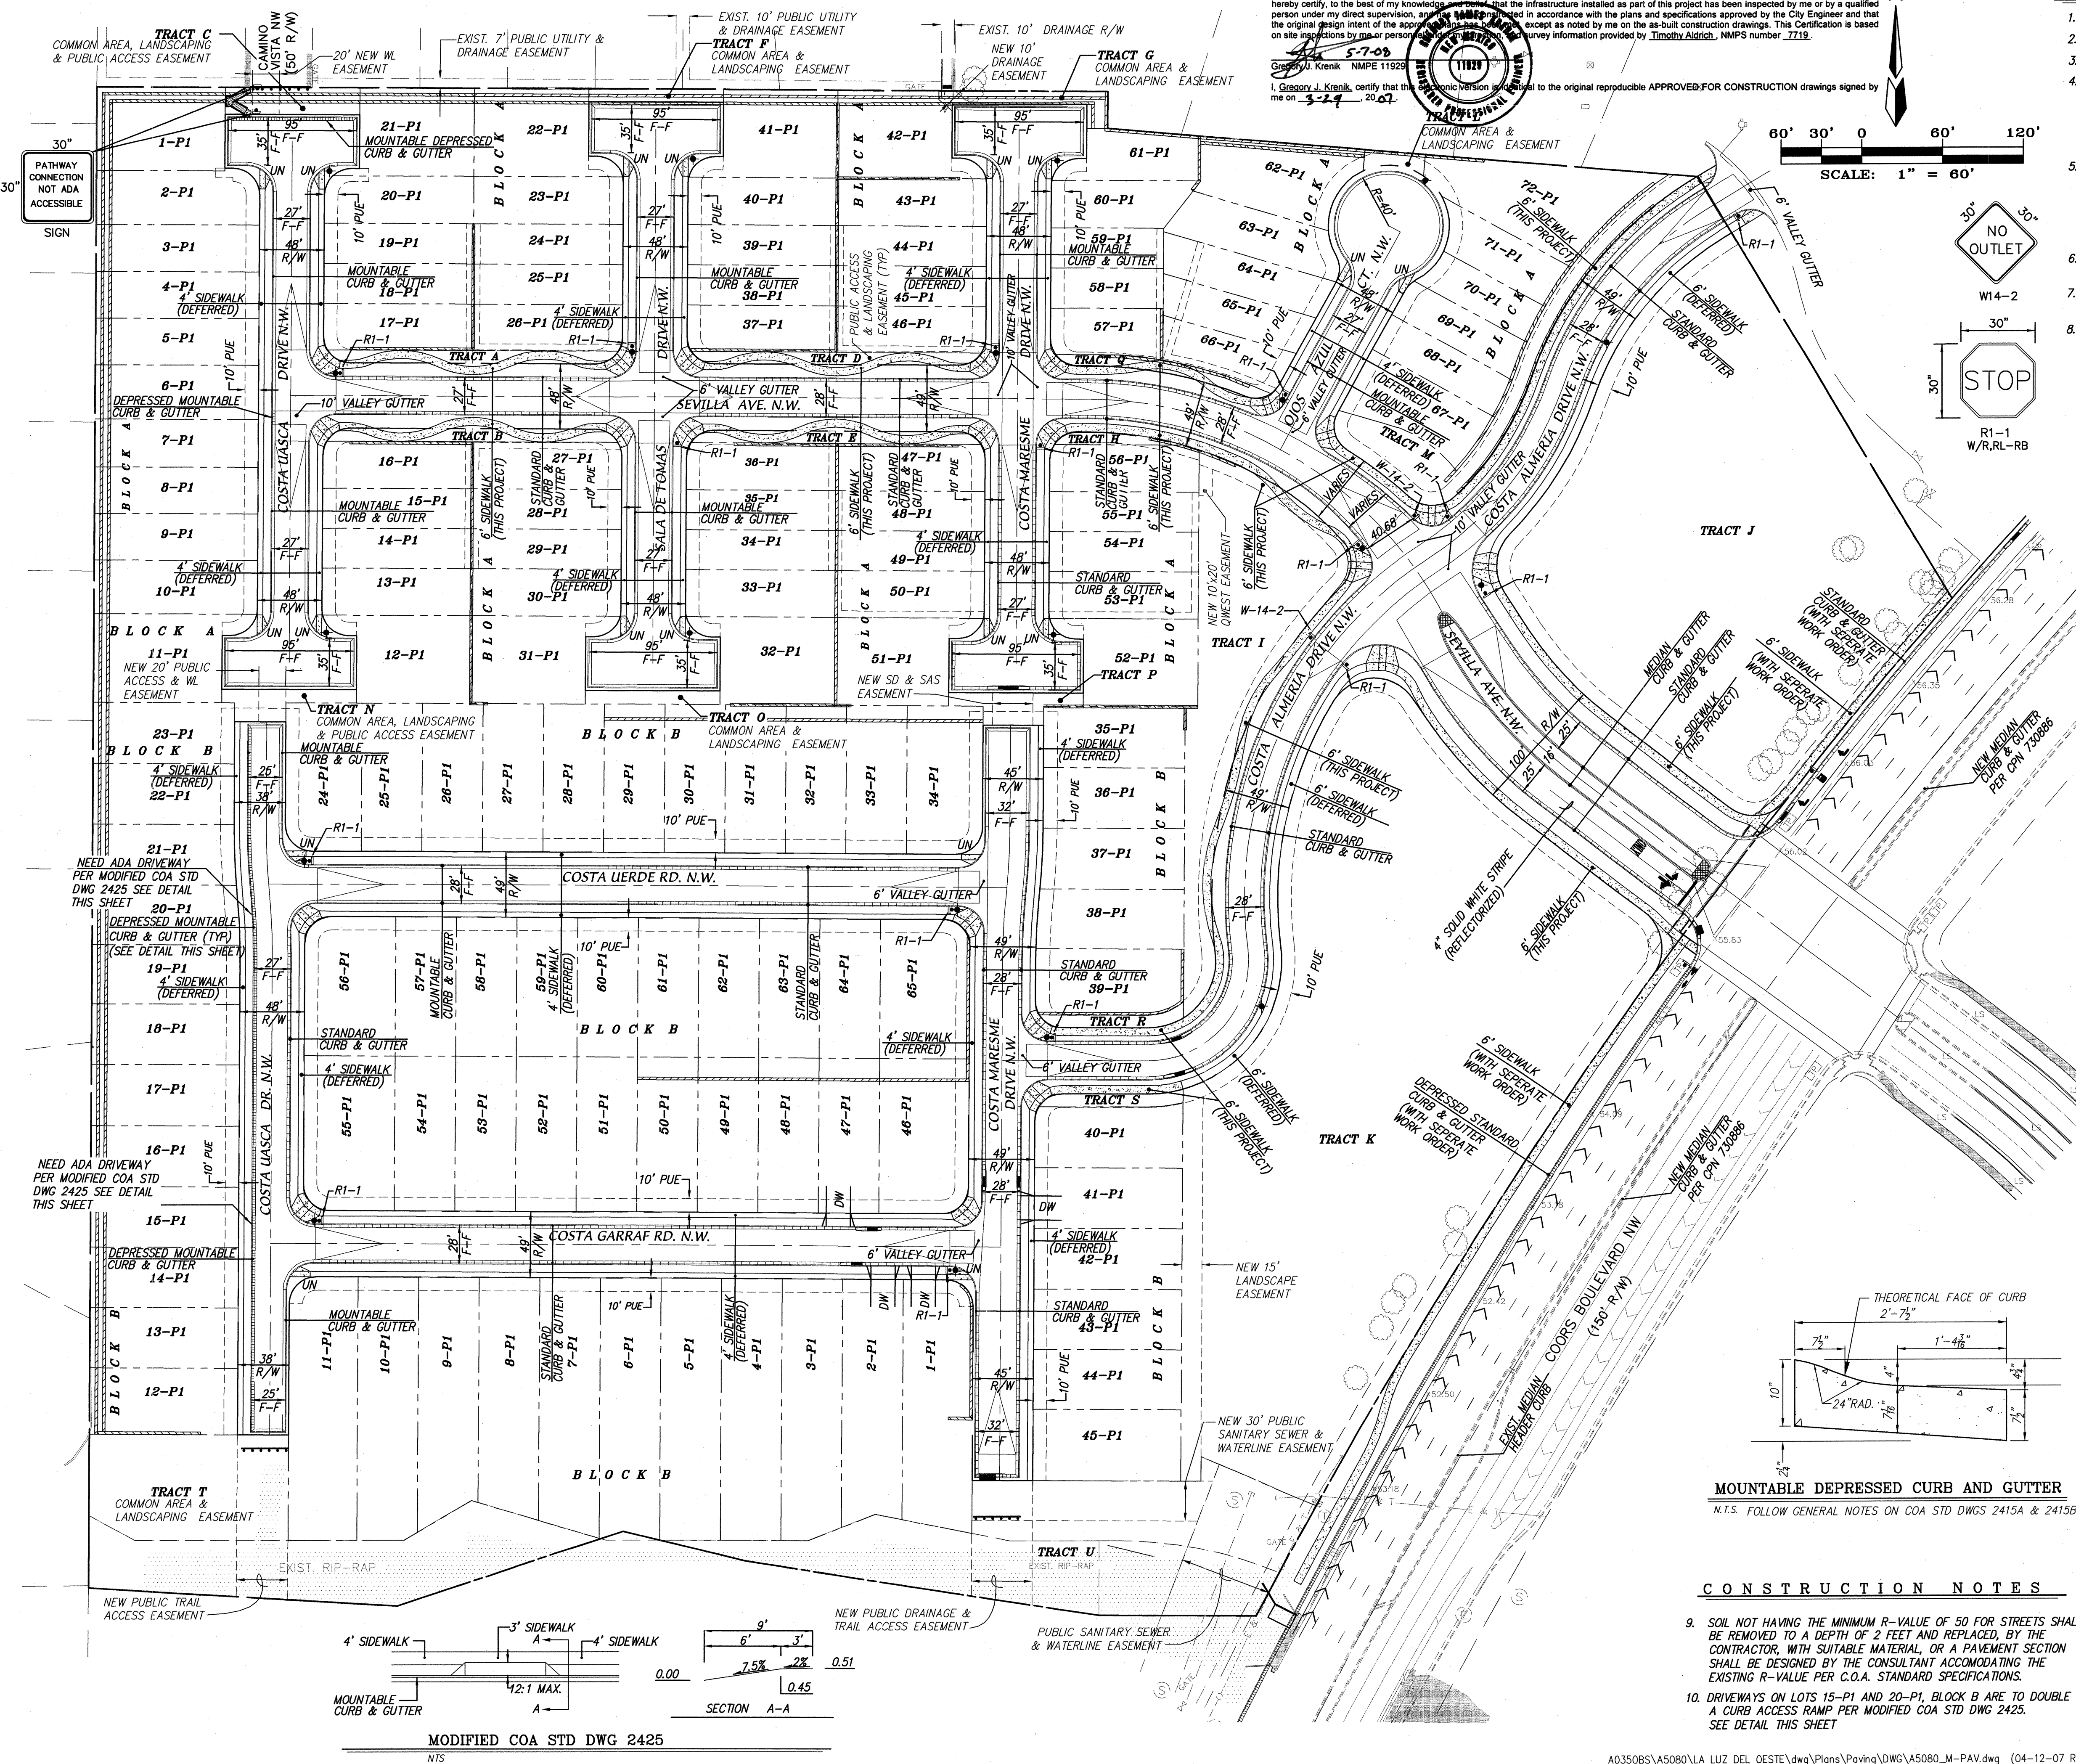

CONSTRUCTION NOTES

- ALL SIDEWALKS PER CITY OF ALBUQUERQUE STANDARD DRAWING 2430.
- ALL 6" VALLEY GUTTERS PER C.O.A. STANDARD DRAWING 2420.
- ALL 10" VALLEY GUTTERS PER C.O.A. STANDARD DRAWING 2422.
- ALL HANDICAP RAMPS ARE PER C.O.A. STANDARD DRAWING 2441, CASE II WITH TRUNCATED DOMES UNLESS NOTED OTHERWISE.
 - TRUNCATED DOMES DESIGNED PER ADA GUIDELINE
 - SUBMIT SPEC'S TO CITY OF ALBUQUERQUE CONSTRUCTION ENGINEER FOR EVALUATION PRIOR TO CONSTRUCTION
- ALL UNI-DIRECTIONAL HANDICAP RAMPS ARE PER C.O.A. STANDARD DRAWING 2426 WITH TRUNCATED DOMES UNLESS NOTED OTHERWISE.
 - TRUNCATED DOMES DESIGNED PER ADA GUIDELINE
 - SUBMIT SPEC'S TO CITY OF ALBUQUERQUE CONSTRUCTION ENGINEER FOR EVALUATION PRIOR TO CONSTRUCTION
- TRANSITION FROM MOUNTABLE CURB TO STANDARD CURB SHALL BE 10 FEET PER C.O.A. STANDARD DRAWING 2418.
- TRANSITION SECTION FROM FULL CROWN TO NO CROWN TO BE A MINIMUM OF 50 FEET PER C.O.A. STD DETAIL #2401.
- TRANSITION FROM MOUNTABLE CURB TO STANDARD CURB AT INTERSECTIONS SHALL OCCUR THROUGH THE H.C. RAMP PER C.O.A. STANDARD DRAWING 2418.

LEGEND

- NEW DEPRESSED CURB & GUTTER
- NEW MEDIAN CURB & GUTTER
- NEW STANDARD CURB & GUTTER
- NEW MOUNTABLE CURB & GUTTER
- NEW FULL 50' CROWN TRANSITION
- NEW 25' 1/2 CROWN TRANSITION
- SIDEWALK THIS PROJECT AS PER COA STD DWG 2430
- DEFERRED SIDEWALK
- NEW LOT LINE
- NEW RIGHT-OF-WAY LINE
- CENTERLINE
- NEW EASEMENTS
- NEW RETAINING WALL
- PROPOSED DRIVEWAY LOCATION (BY OTHERS)
- NEW UNI-DIRECTIONAL RAMP WITH TRUNCATED DOMES PER COA STD. DWG 2426
- NEW GENERAL WHEEL CHAIR RAMP WITH TRUNCATED DOMES - DESIGN PER ADA GUIDELINES - SUBMIT SPEC'S TO CITY CONSTRUCTION ENGINEER FOR EVALUATION PRIOR TO CONSTRUCTION
- NEW OFFSITE PAVING THIS PROJECT
- REMOVE & DISPOSE EXISTING PAVEMENT
- RED PATTERNED CONC. PER COA STD. DWG. 2408
- GUARDRAIL W/ STD TERMINAL PER STD DWG 2610
- NEW SIGN R1-1 OR W-14-2 AS NOTED
- NEW STREET LIGHT (19)
- STORM DRAIN INLET THIS PROJECT
- EXISTING CHAIN LINK/WIRE FENCE
- EXISTING BARBED WIRE FENCE
- EXISTING WOOD FENCE
- EXISTING OVERHEAD ELECTRIC LINE
- EXISTING POWER POLE
- EXISTING GUY WIRE
- EXISTING TELEPHONE MANHOLE
- EXISTING TELEPHONE PEDESTAL
- EXISTING WATER VALVE
- EXISTING FIRE HYDRANT
- EXISTING UG TELEPHONE MARKER
- EXISTING CABLE PEDESTAL
- EXISTING TRAFFIC SIGNAL PULLBOX
- SANITARY SEWER MANHOLE
- EXISTING GUY WIRE
- EXISTING CONCRETE CURB
- EXISTING WALL OR HEAD WALL
- EXISTING GUARDRAIL
- EXISTING CONCRETE/SIDEWALK

MOUNTABLE DEPRESSED CURB AND GUTTER

N.T.S. FOLLOW GENERAL NOTES ON COA STD DWGS 2415A & 2415B

CONSTRUCTION NOTES

- SOIL NOT HAVING THE MINIMUM R-VALUE OF 50 FOR STREETS SHALL BE REMOVED TO A DEPTH OF 2 FEET AND REPLACED, BY THE CONTRACTOR, WITH SUITABLE MATERIAL, OR A PAVEMENT SECTION SHALL BE DESIGNED BY THE CONSULTANT ACCOMMODATING THE EXISTING R-VALUE PER C.O.A. STANDARD SPECIFICATIONS.
- DRIVEWAYS ON LOTS 15-P1 AND 20-P1, BLOCK B ARE TO DOUBLE AS A CURB ACCESS RAMP PER MODIFIED COA STD DWG 2425. SEE DETAIL THIS SHEET

MARK GOODWIN & ASSOCIATES, P.A.
CONSULTING ENGINEERS
P.O. BOX 90606
ALBUQUERQUE, NEW MEXICO 87199
OFFICE (505) 828-2200, FAX (505) 797-9539



CITY OF ALBUQUERQUE
PUBLIC WORKS DEPARTMENT

TITLE: VISTA DE LA LUZ
MASTER PAVING PLAN & DETAILS
PAVING IMPROVEMENTS










DESIGN REVIEW COMMITTEE APPROVED MAY 17 2007
CITY ENGINEER APPROVAL MAY 25 2007

DESIGNED BY G/K
DRAWN BY RDQ
CHECKED BY DMG








DATE 10/06
DATE 10/06
DATE 10/06

CITY PROJECT NO. 791481
ZONE MAP NO. F-11-Z
SHEET 7 OF 24

F:\AG\JOBS\A5080 LA LUZ DEL OESTE.dwg\Plans\PAV.dwg, 4/10/2007 7:21:12 AM, PLOTTED BY RDQ

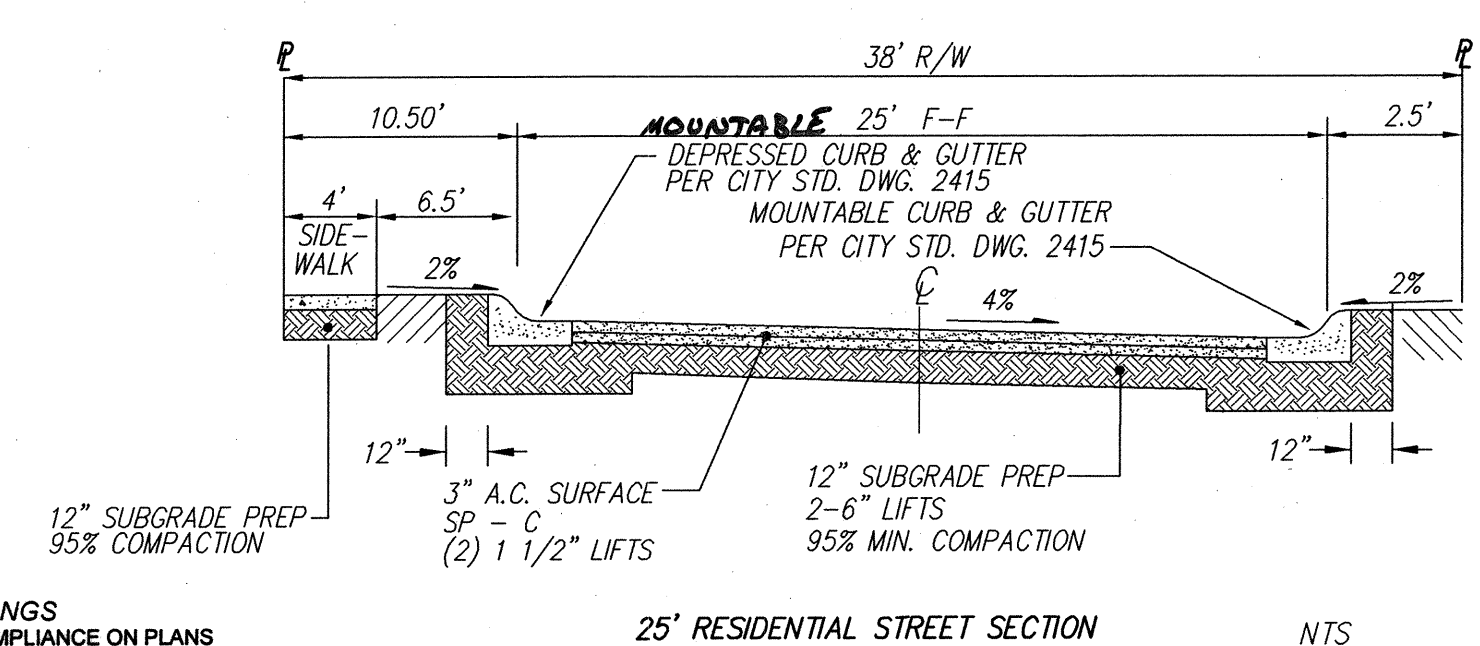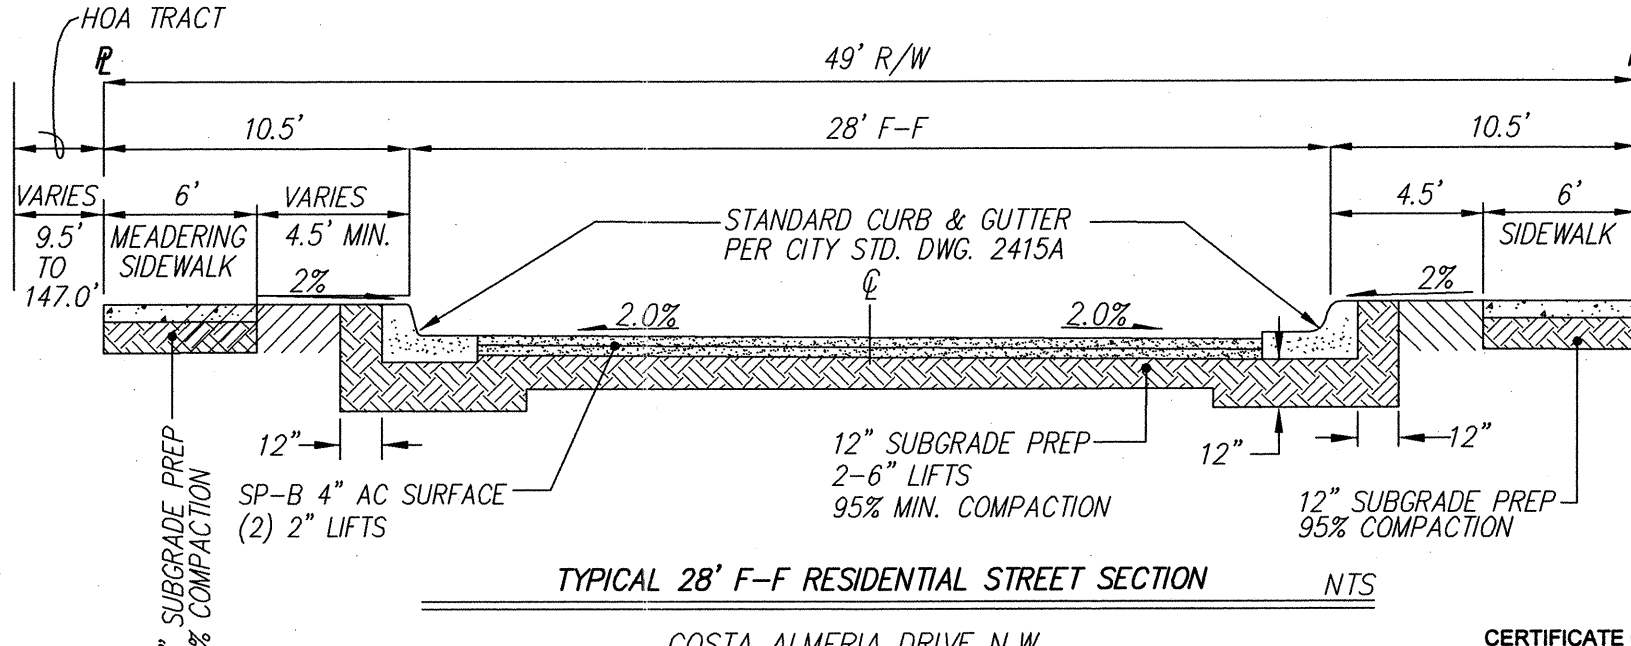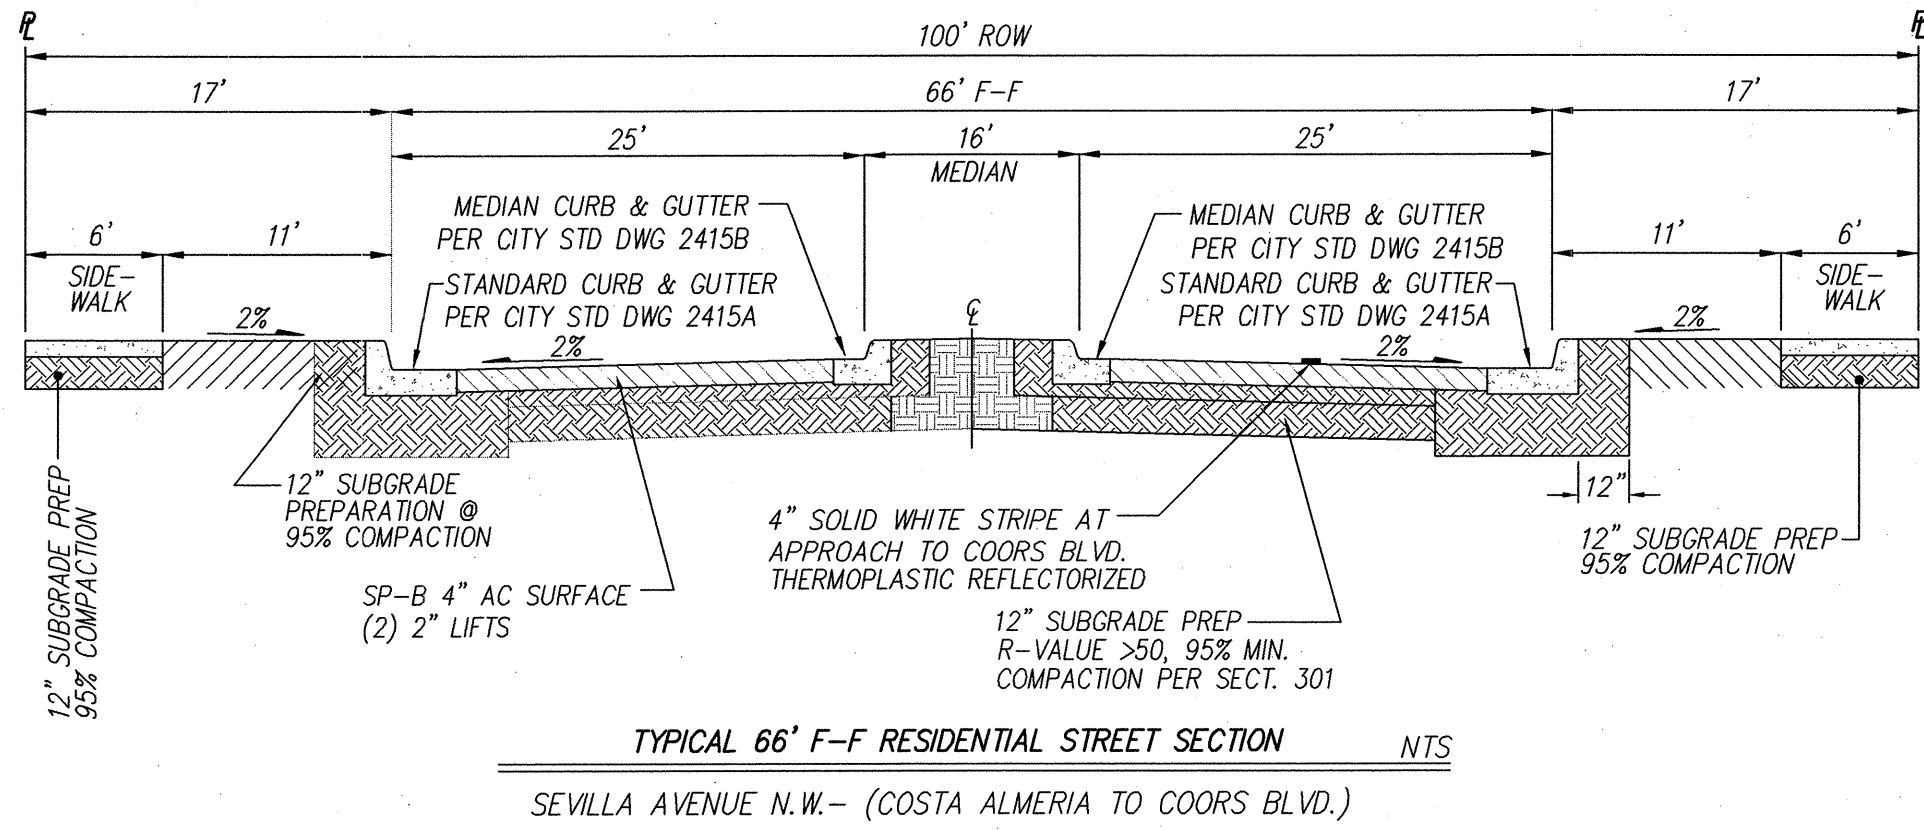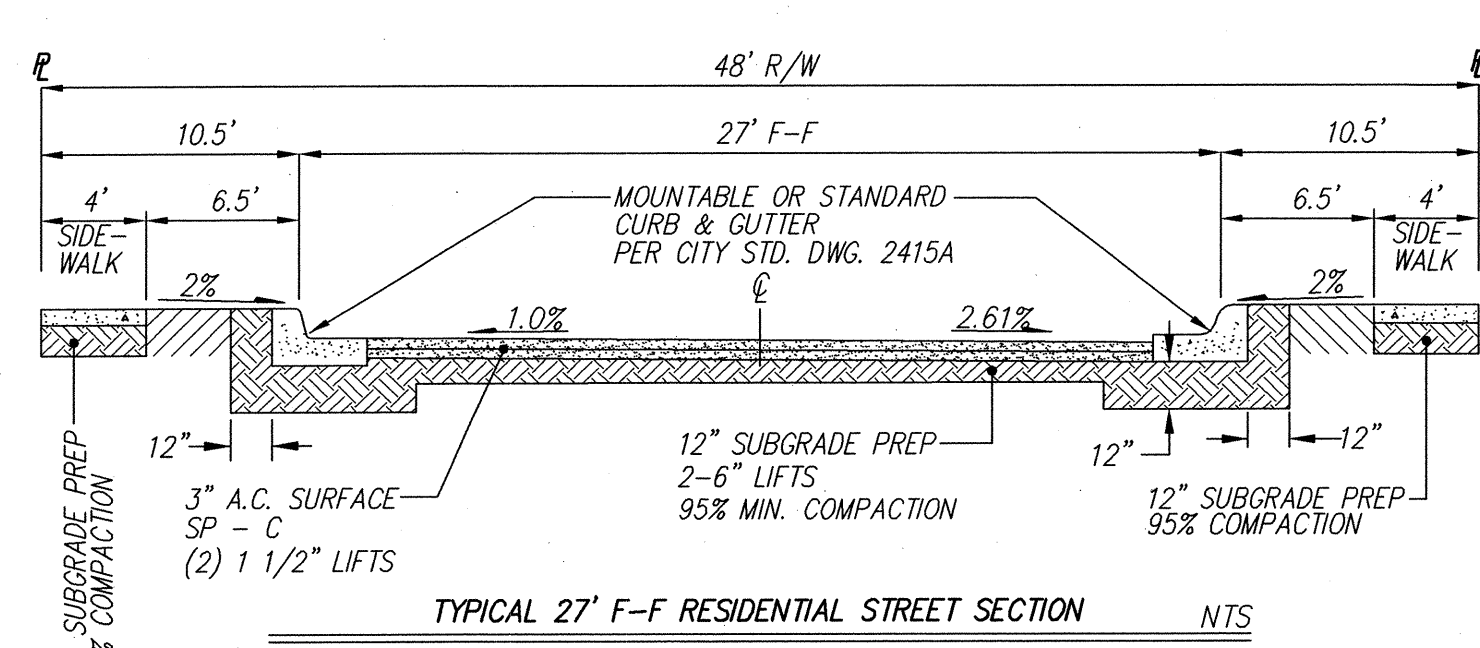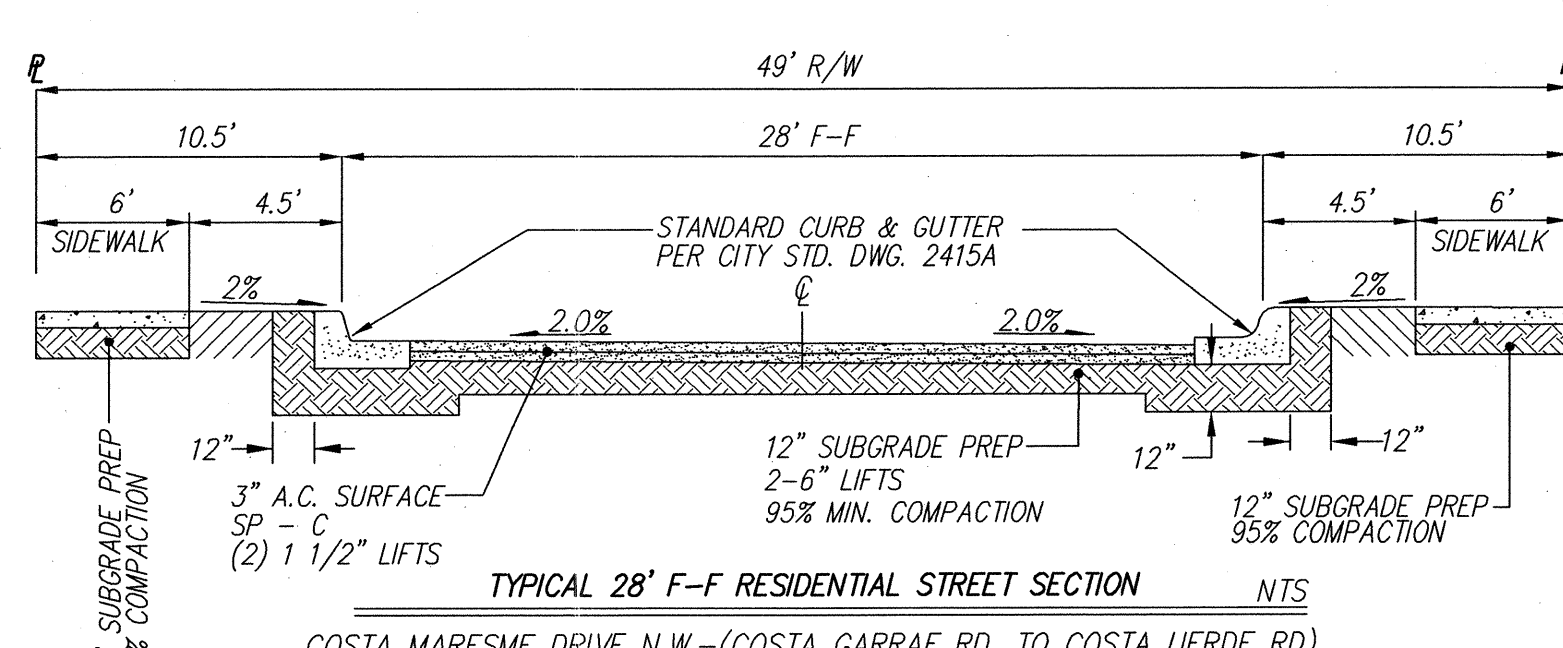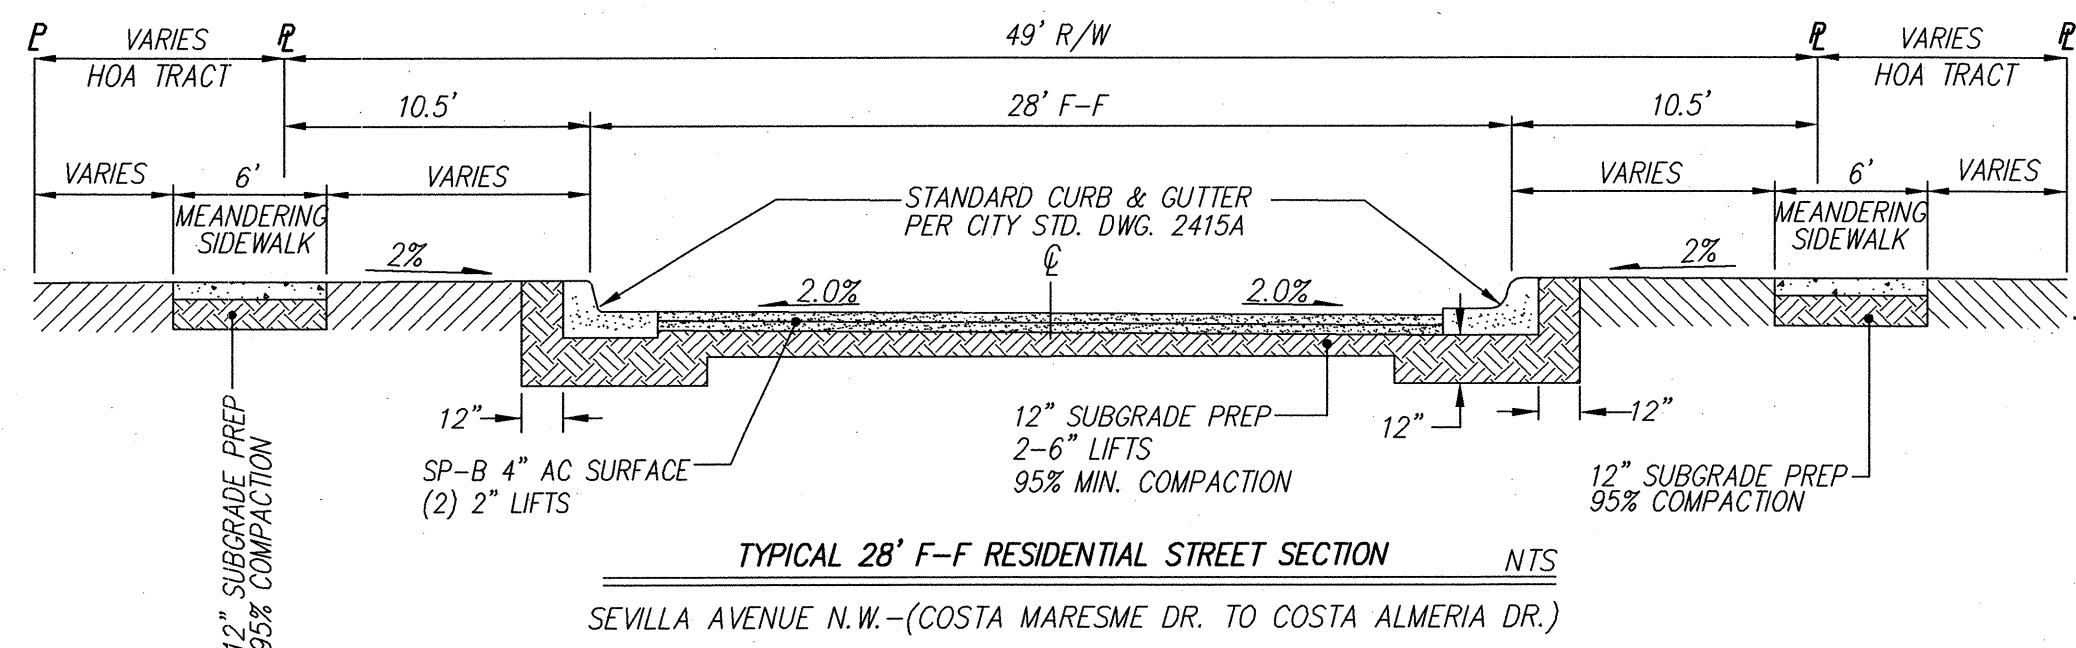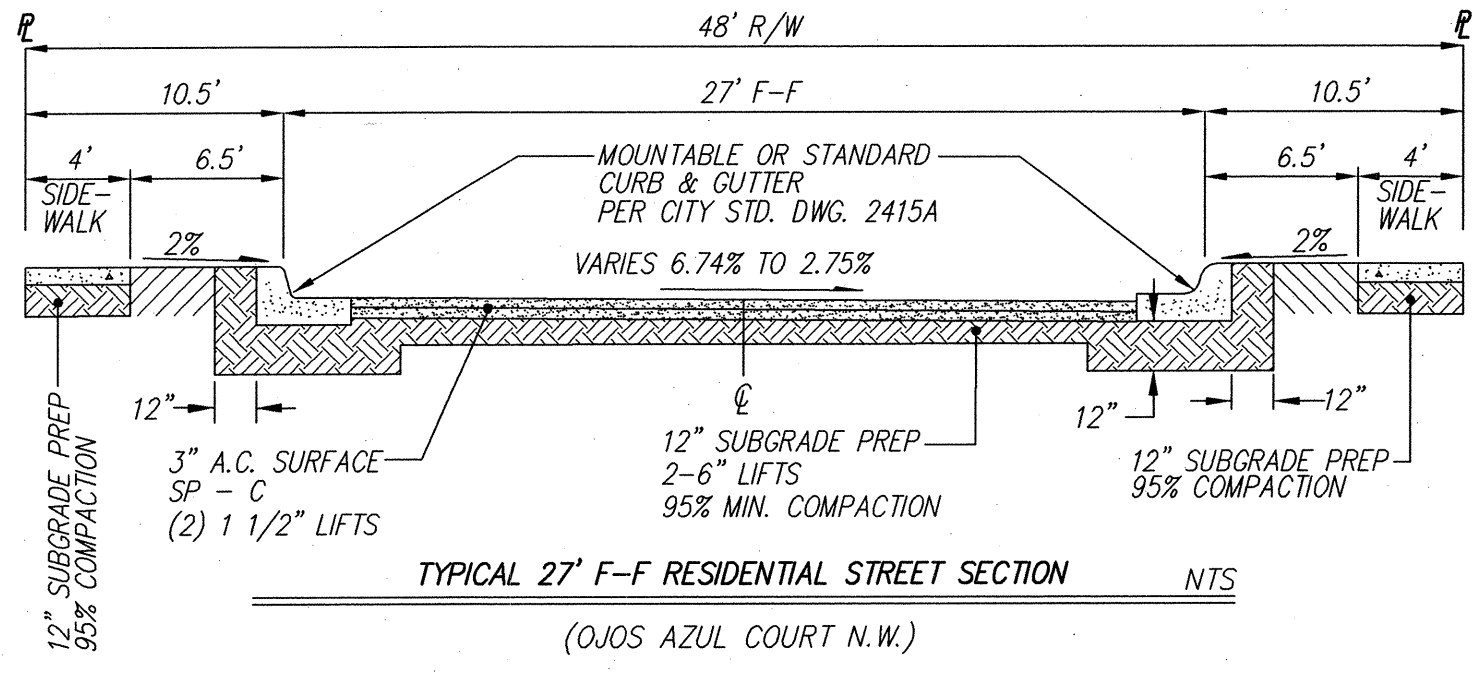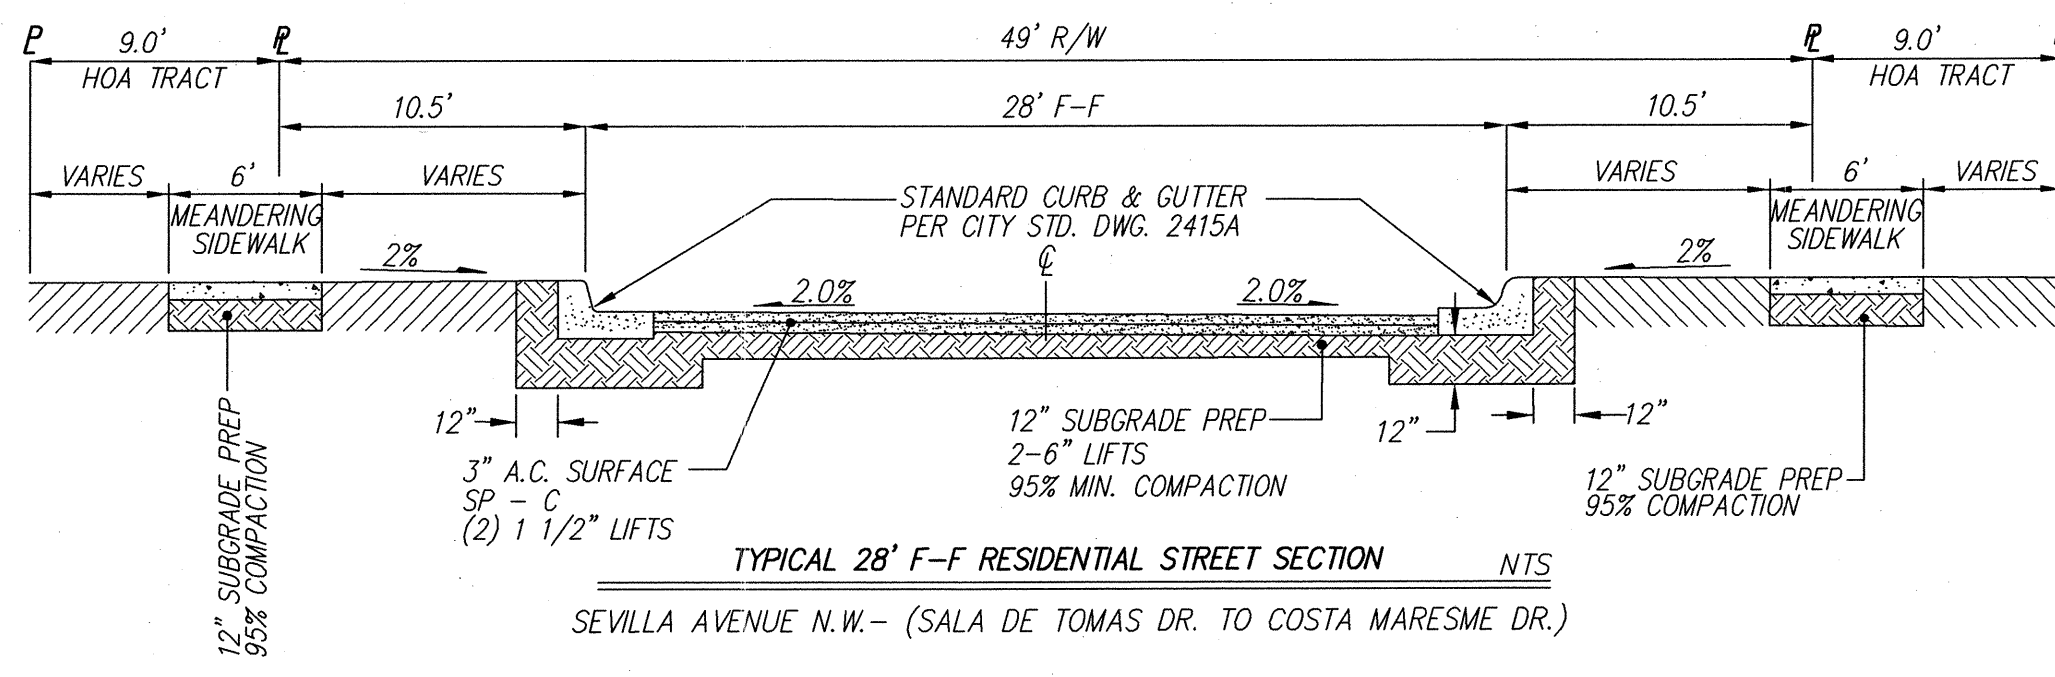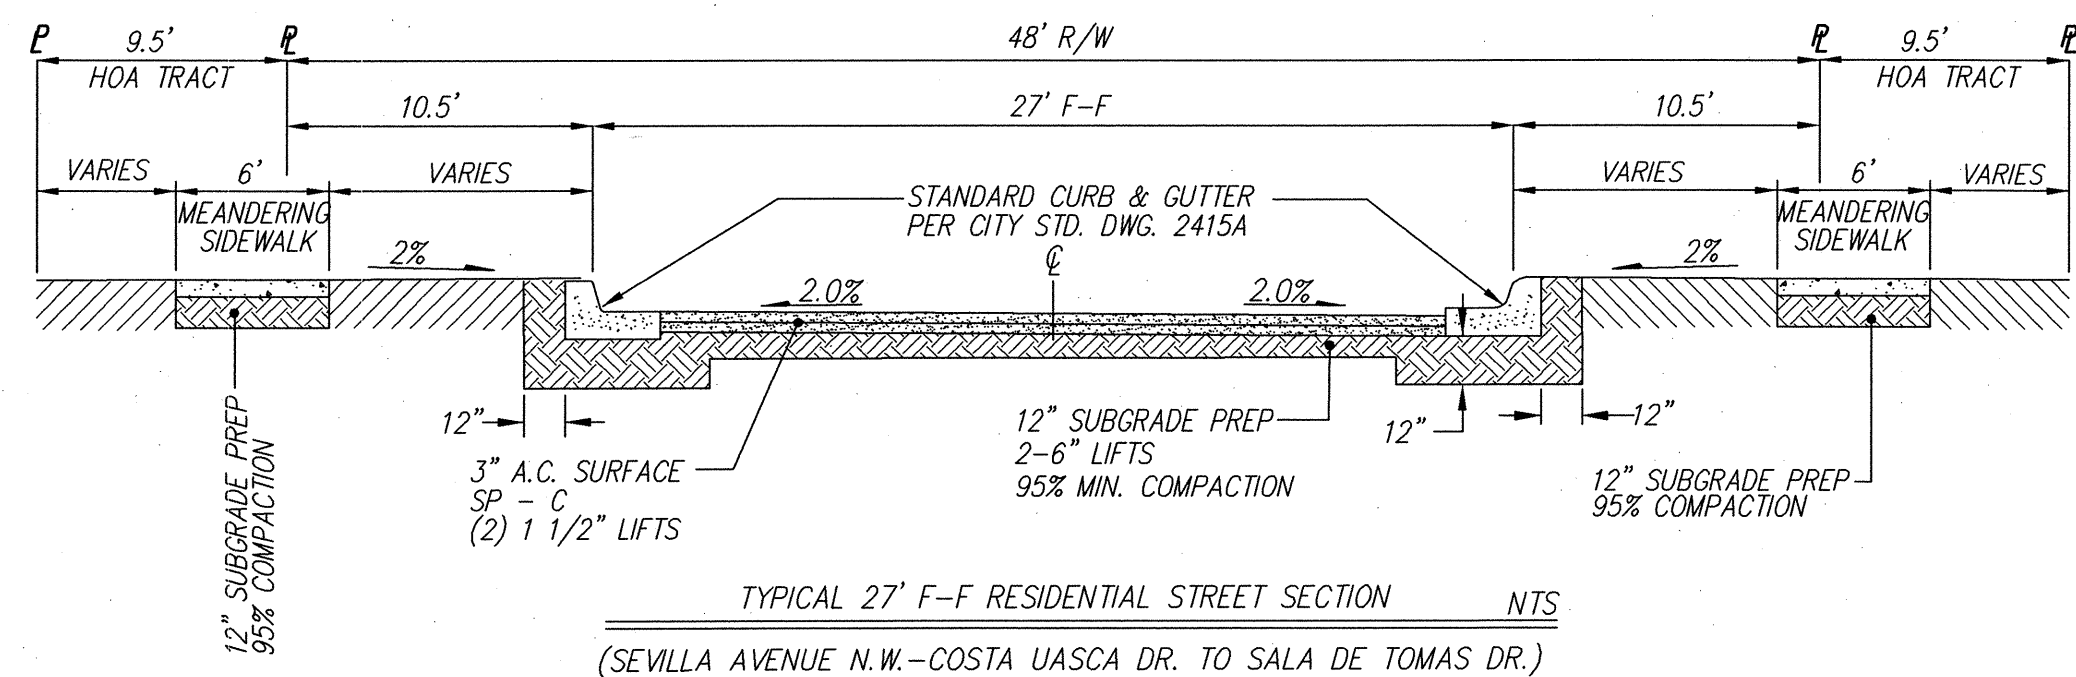

RECORD DRAWINGS
CERTIFICATE OF SUBSTANTIAL COMPLIANCE ON PLANS
I, Gregory J. Krenik, NMPE 11929, of the firm, Mark Goodwin & Associates, P.A., a Registered Professional Engineer in the State of New Mexico, do hereby certify, to the best of my knowledge and belief, that the infrastructure installed as part of this project has been inspected by me or by a qualified person under my direct supervision, and that the same has been constructed in accordance with the plans and specifications approved by the City Engineer and that the original design intent of the approved plans and specifications has been followed, except as noted by me on the as-built construction drawings. This Certification is based on site inspections by me or persons authorized by me to conduct such inspections and on the survey information provided by Timothy Aldrich, NMPS number 7719.
I, Gregory J. Krenik, certify that the electronic version is identical to the original reproducible APPROVED FOR CONSTRUCTION drawings signed by me on 3-29-07.

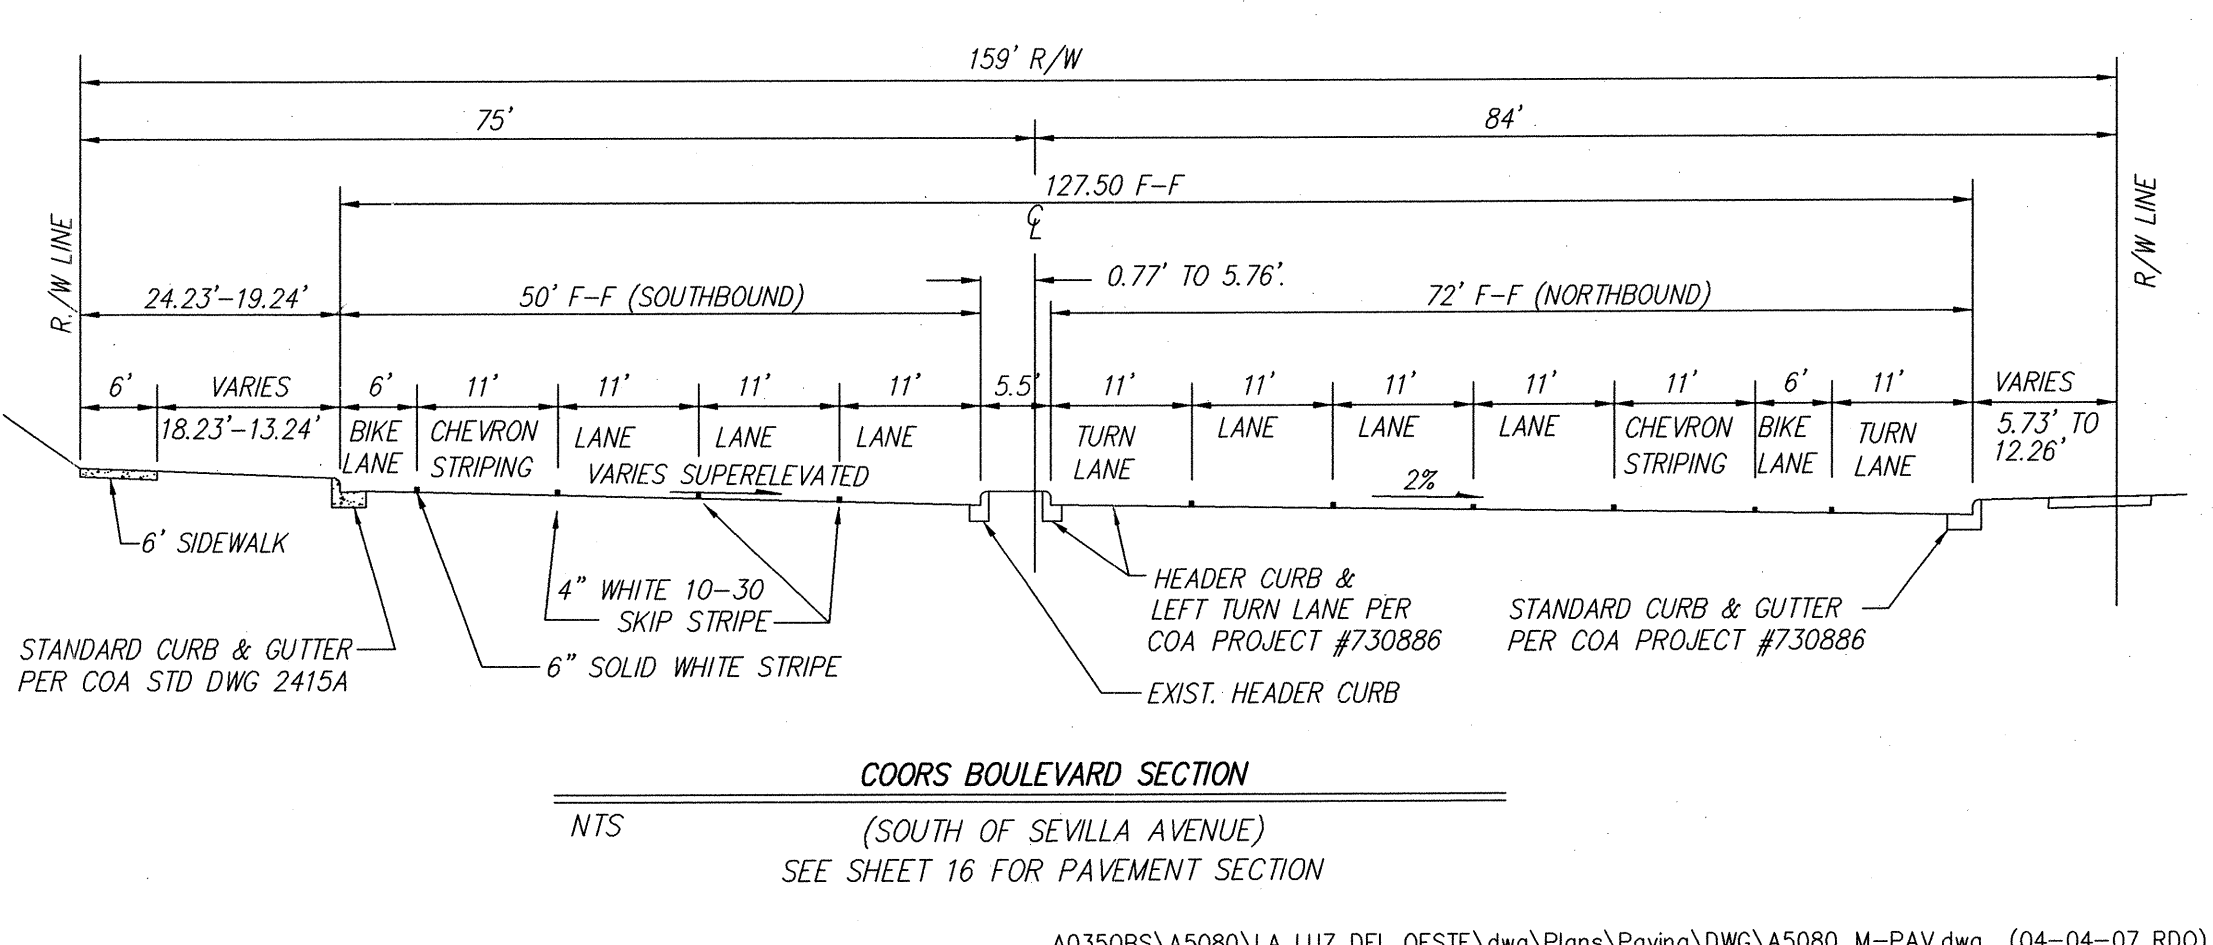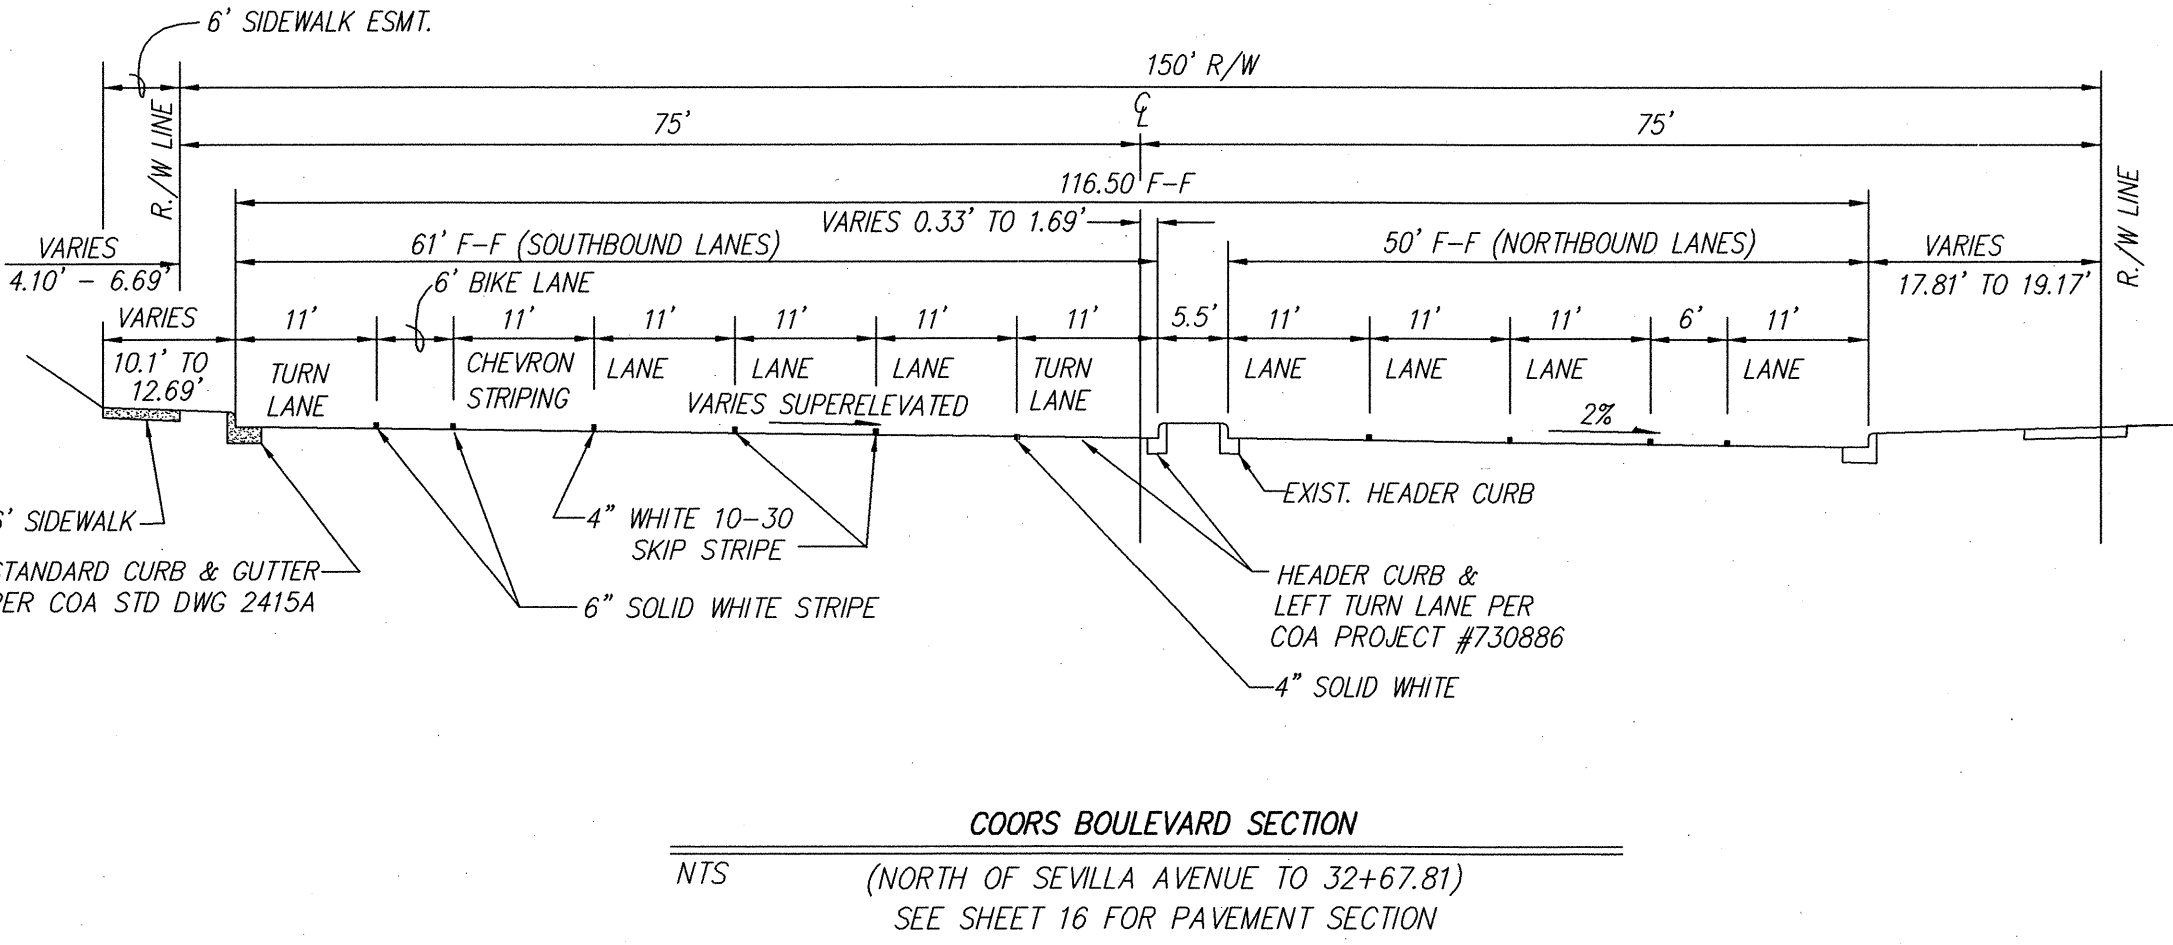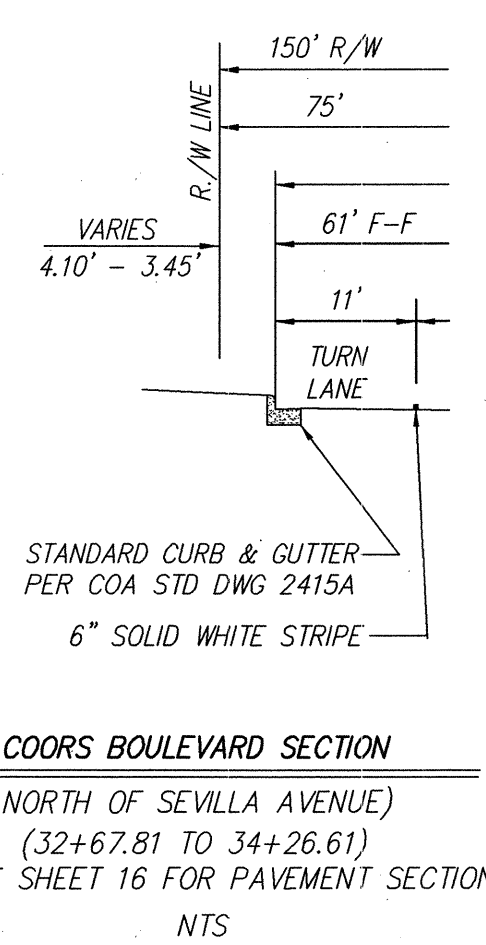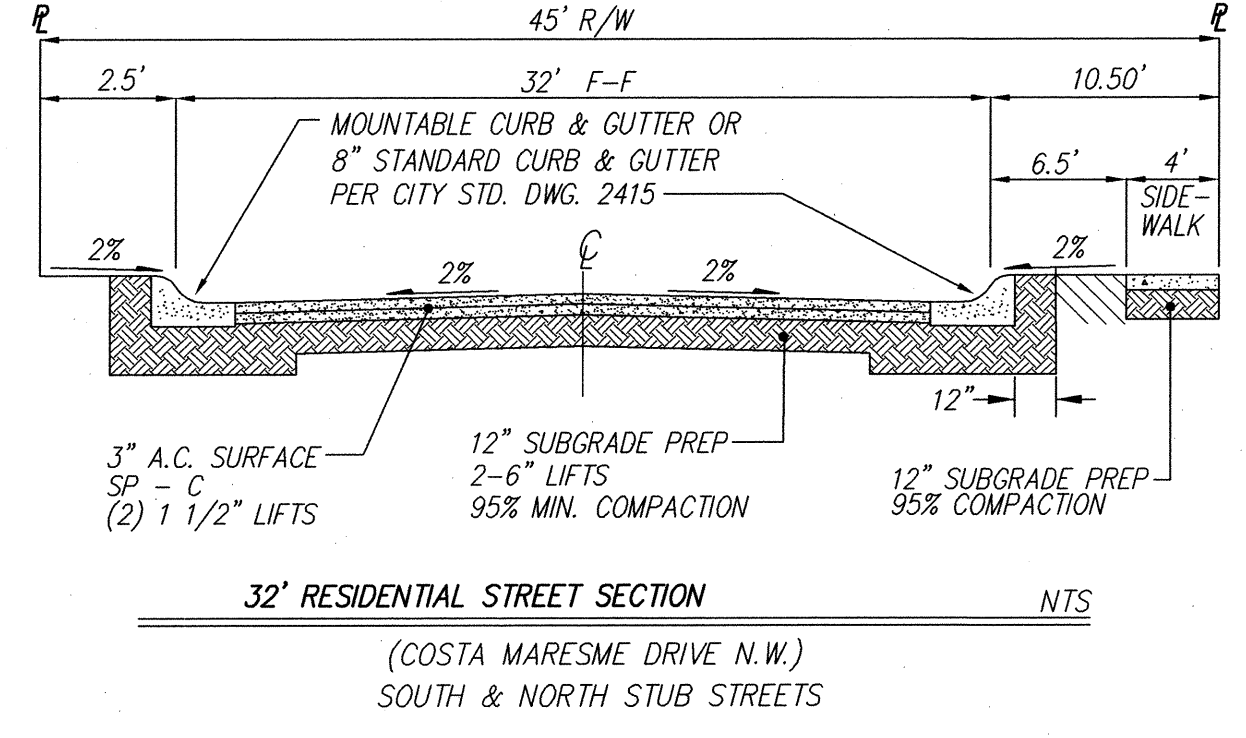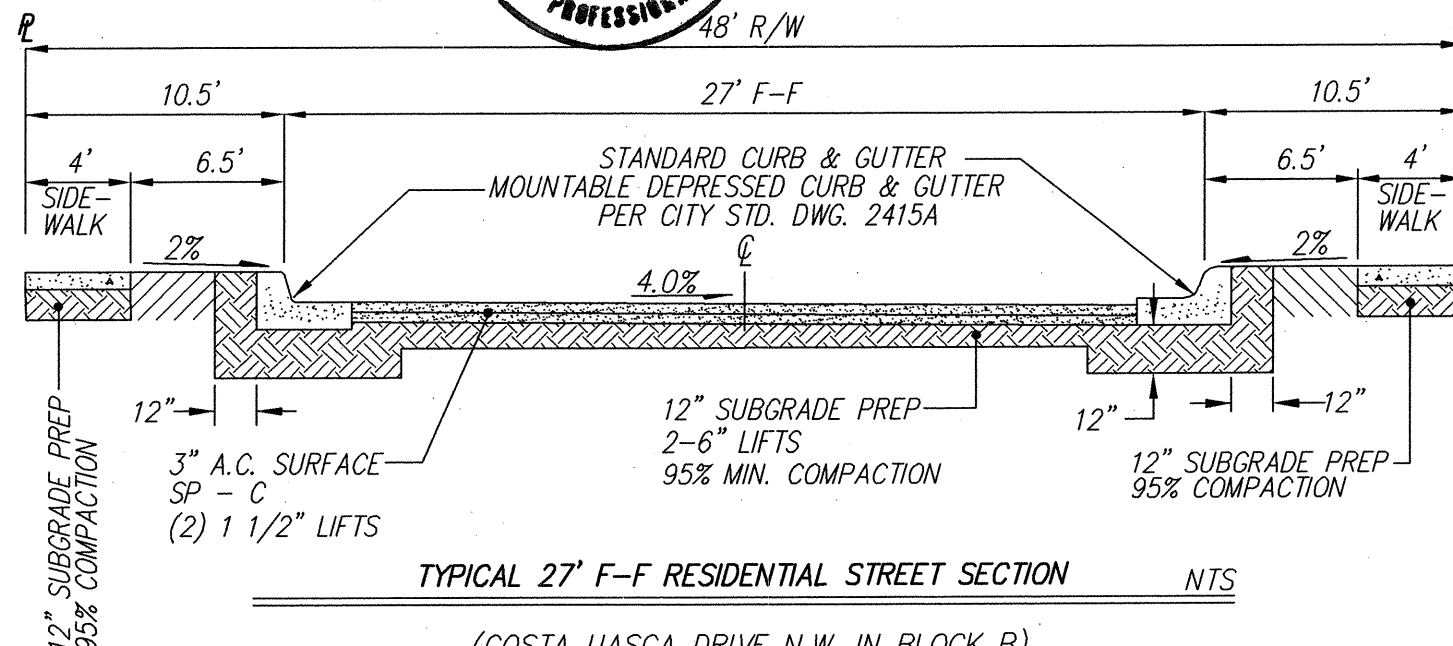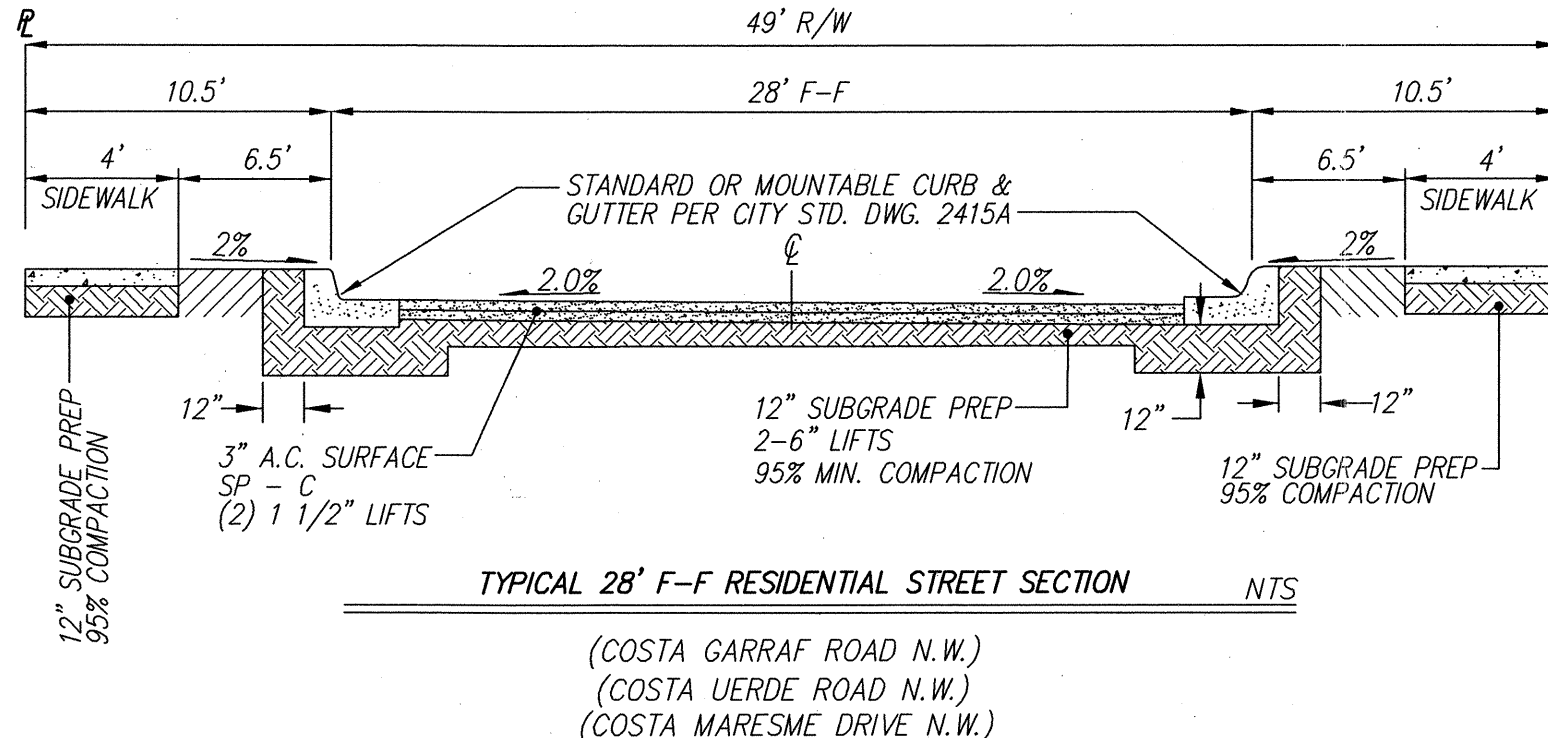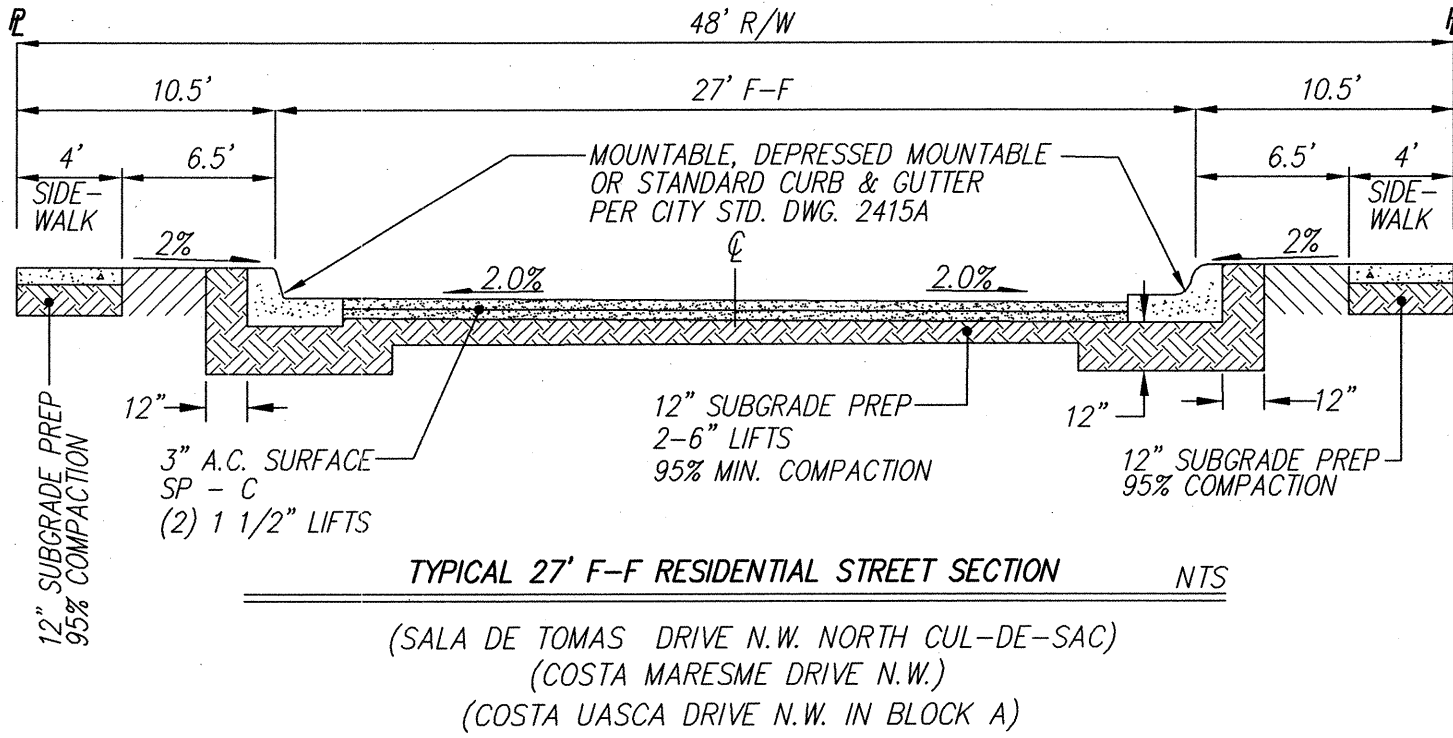

MARK GOODWIN & ASSOCIATES, P.A.
CONSULTING ENGINEERS
P.O. BOX 90606
ALBUQUERQUE, NEW MEXICO 87199
OFFICE (505) 828-2200, FAX (505) 797-9539

CITY OF ALBUQUERQUE
PUBLIC WORKS DEPARTMENT

TITLE: VISTA DE LA LUZ
MASTER PAVING PLAN & DETAILS
PAVING IMPROVEMENTS


DESIGN REVIEW COMMITTEE
APPROVED
MAY 17 2007
CITY ENGINEER
APPROVED
MAY 25 2007
CITY ENGINEER

CITY PROJECT NO. 791481
ZONE MAP NO. F-11-Z
SHEET 8 OF 24





10


CITY PROJECT NO.	791481	ZONE MAP NO.	F-11-7	SHEET	9	OF	2
------------------	--------	--------------	--------	-------	---	----	---

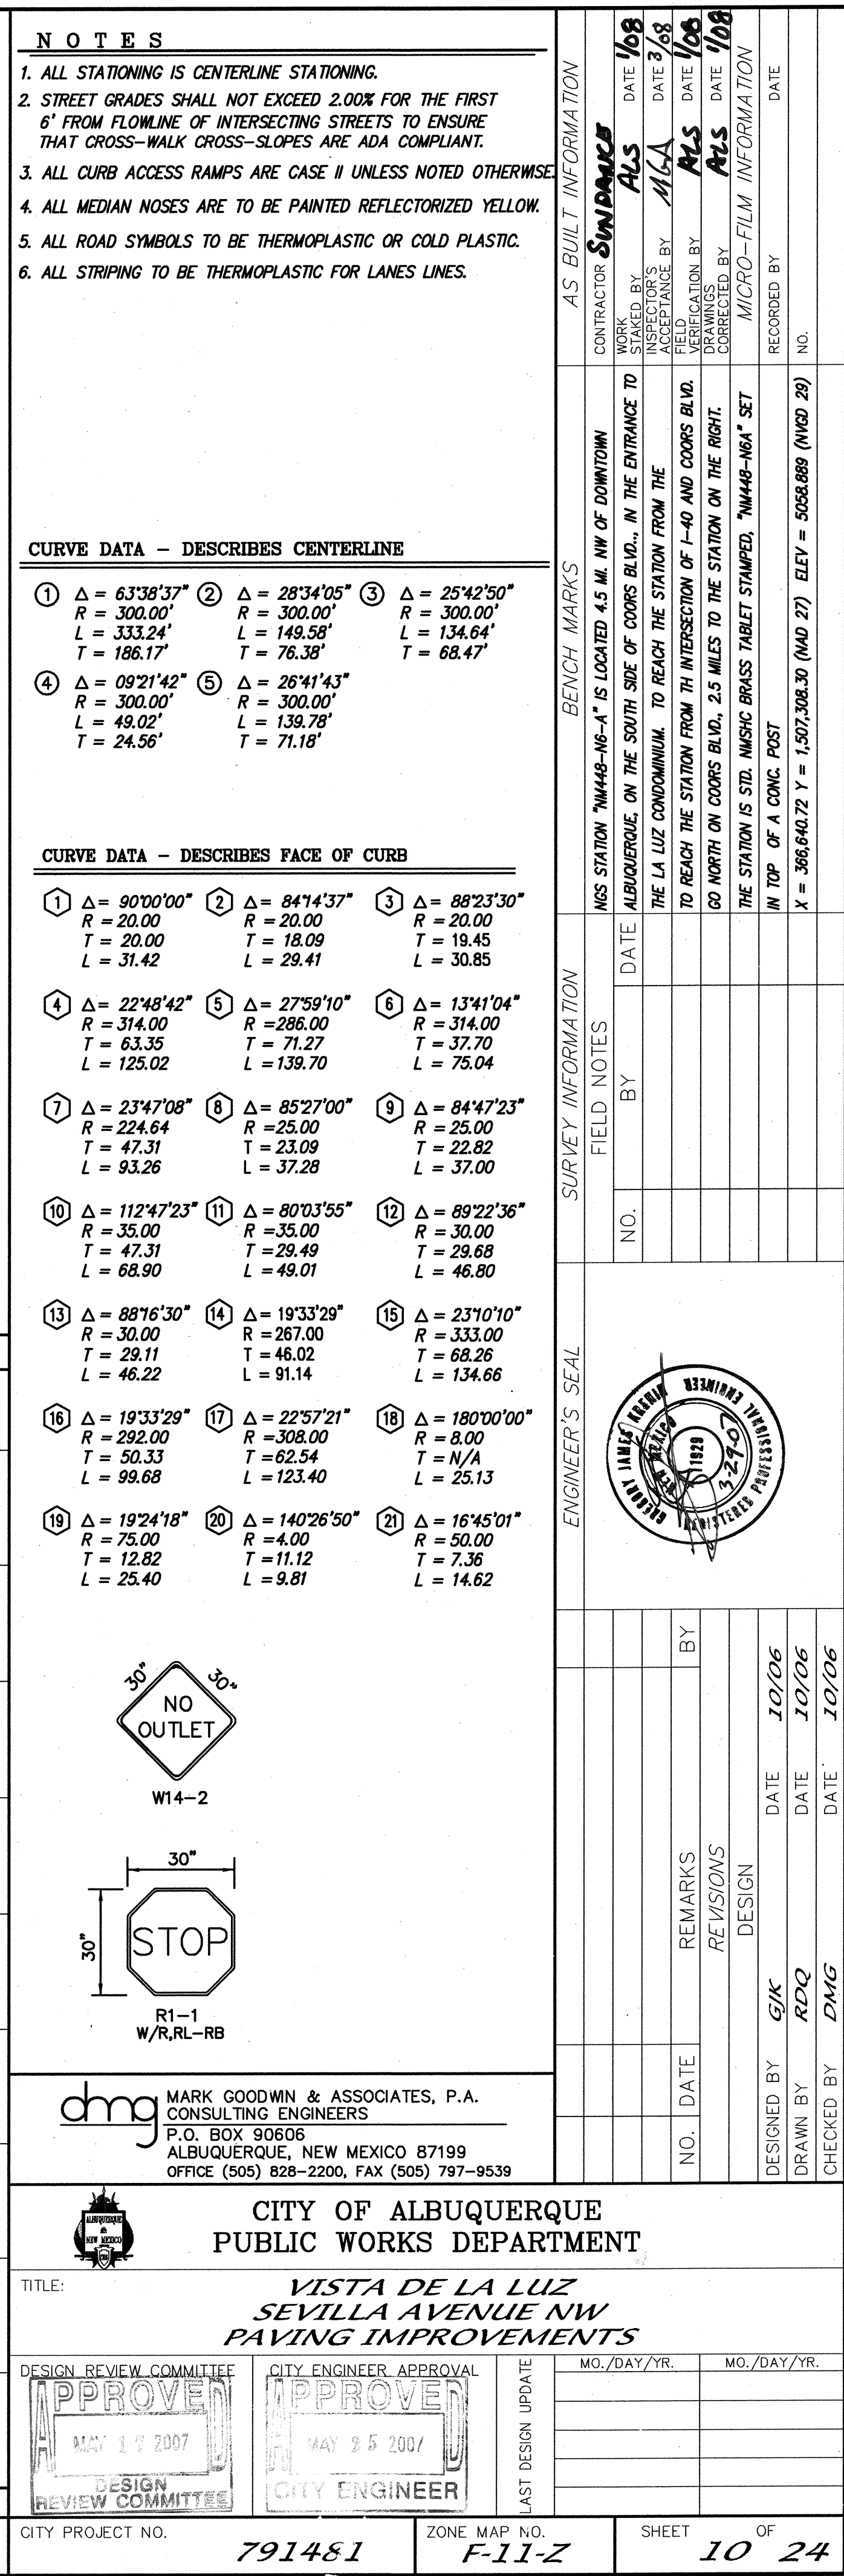



NOTE: ON LOTS 1, 11, 12 & 21 THE DRIVEWAYS WILL BE NO STEEPER THAN 5.0% WITHIN THE CITY ROW.

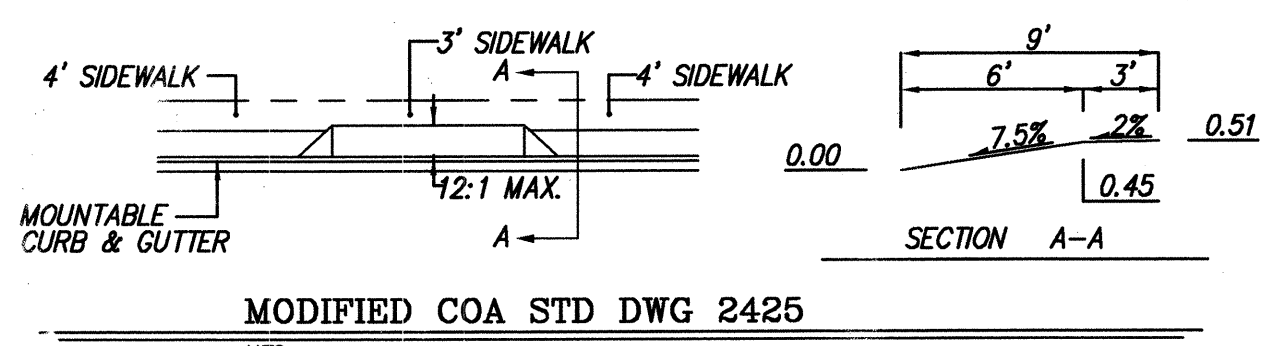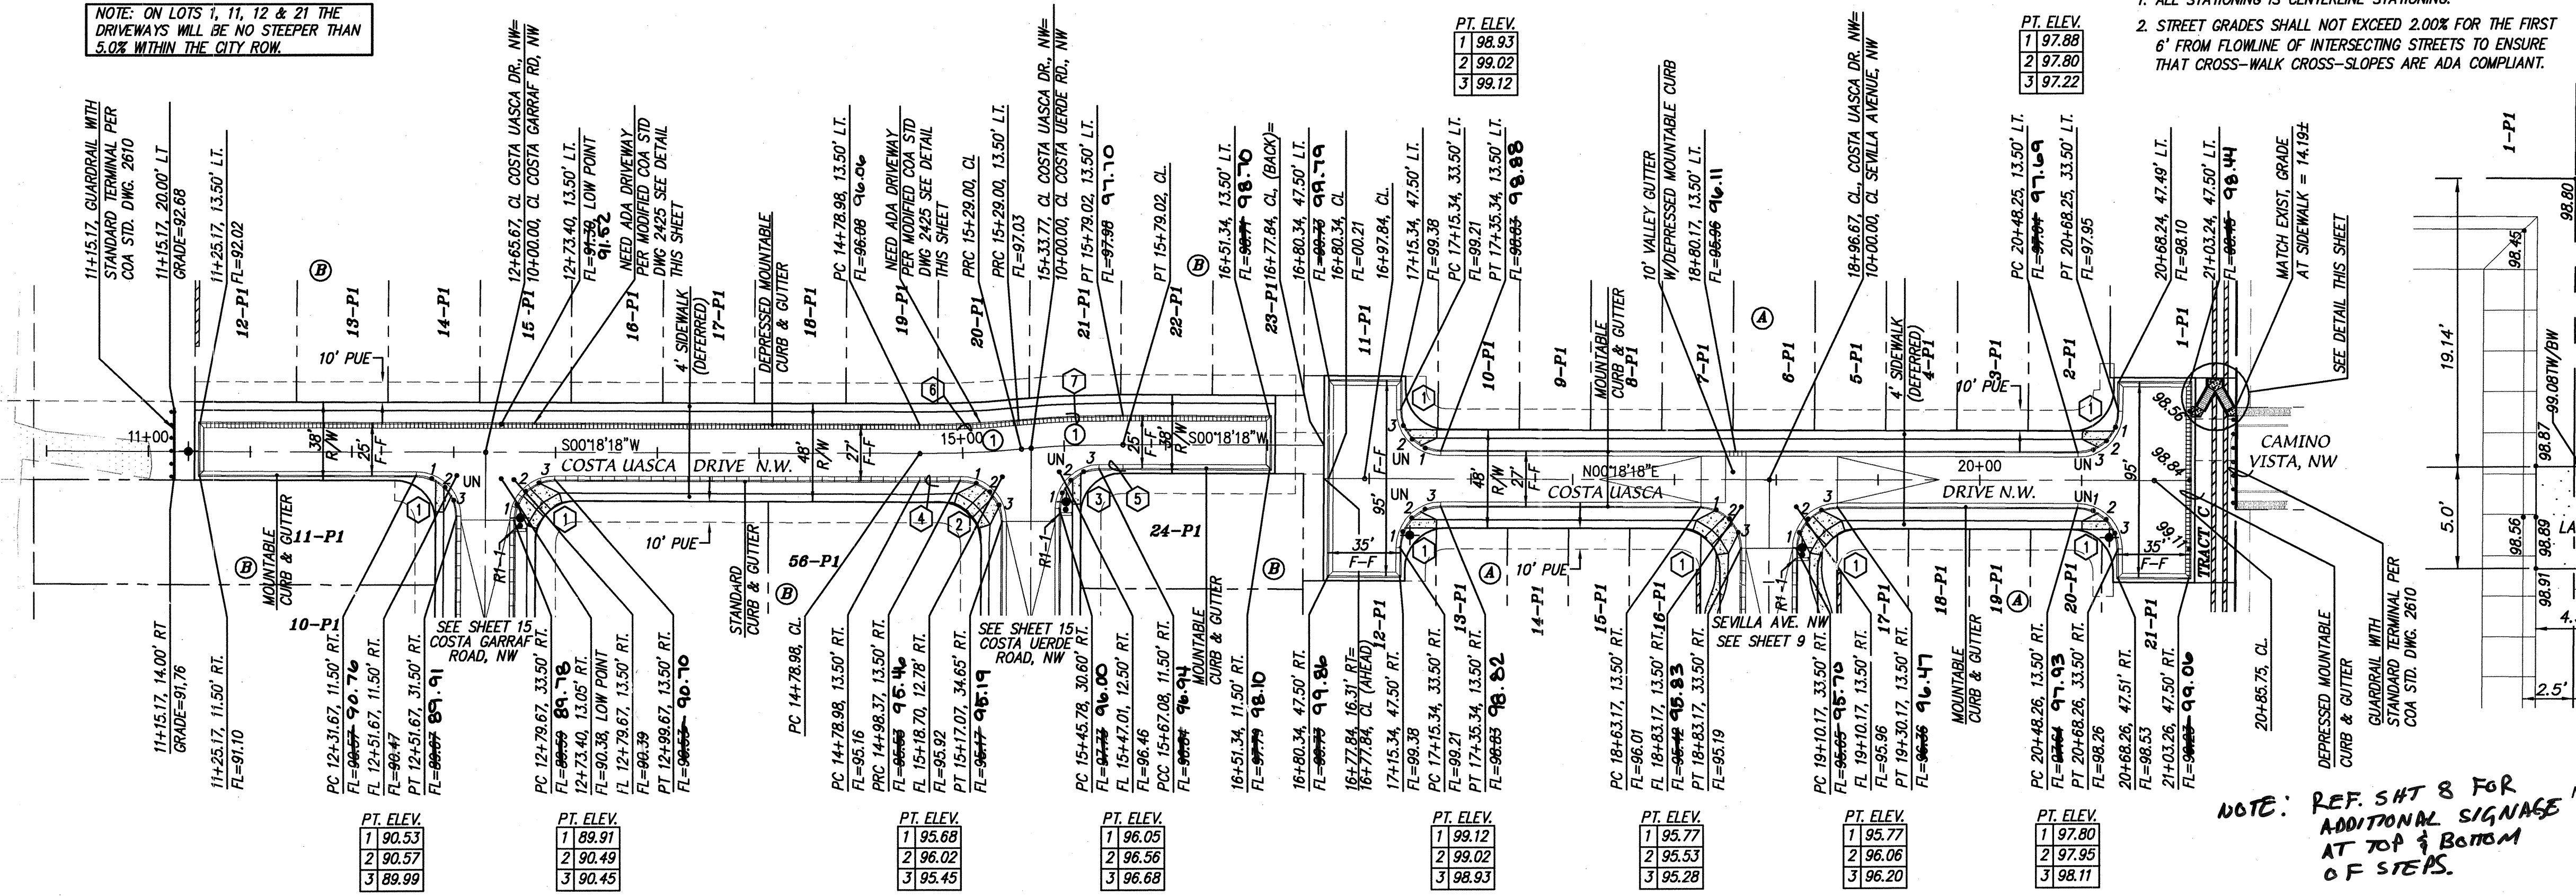

- NOTES
1. ALL STATIONING IS CENTERLINE STATIONING.
 2. STREET GRADES SHALL NOT EXCEED 2.00% FOR THE FIRST 6' FROM FLOWLINE OF INTERSECTING STREETS TO ENSURE THAT CROSS-WALK CROSS-SLOPES ARE ADA COMPLIANT.

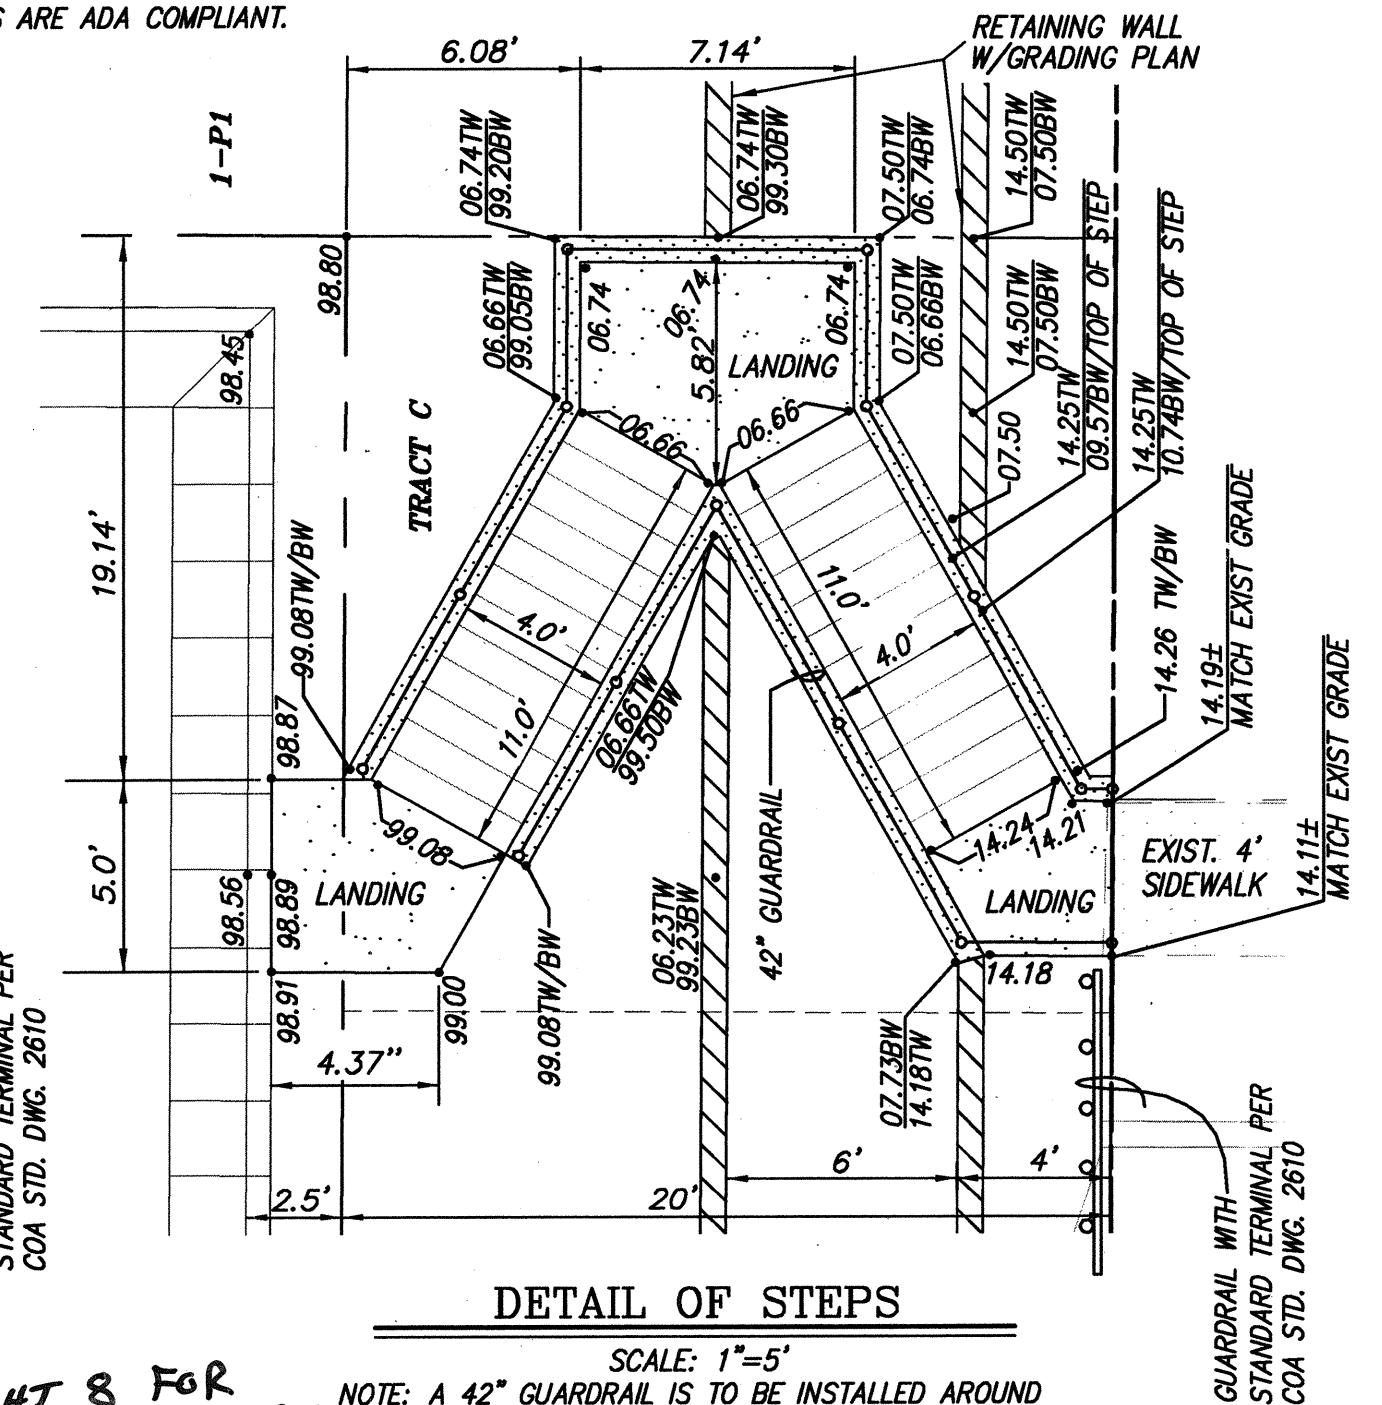

NOTE: REF. SHT 8 FOR ADDITIONAL SIGNAGE AT TOP & BOTTOM OF STEPS.

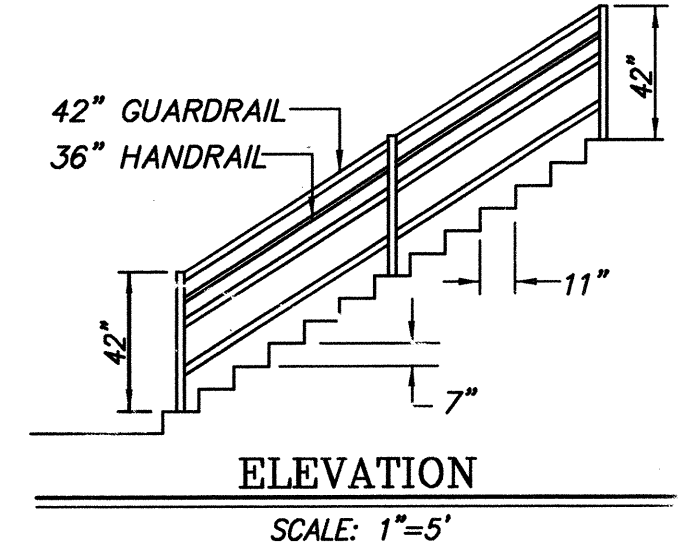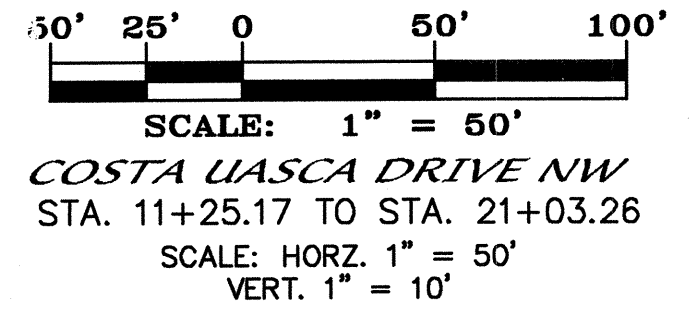


CURVE DATA - DESCRIBES CENTERLINE

1	$\Delta = 05^{\circ}43'55''$ $R = 500.00'$ $L = 50.02'$ $T = 25.03'$
---	---

CURVE DATA - DESCRIBES FACE OF CURB RETURNS

1	$\Delta = 90^{\circ}00'00''$ $R = 20.00$ $T = 20.00$ $L = 31.42$	2	$\Delta = 92^{\circ}13'21''$ $R = 20.00$ $T = 20.79$ $L = 32.19$	3	$\Delta = 88^{\circ}37'55''$ $R = 20.00$ $T = 19.53$ $L = 30.94$
4	$\Delta = 02^{\circ}13'21''$ $R = 513.50$ $T = 9.96$ $L = 19.92$	5	$\Delta = 01^{\circ}22'05''$ $R = 488.50$ $T = 5.83$ $L = 11.66$	6	$\Delta = 05^{\circ}43'55''$ $R = 513.50$ $T = 25.71$ $L = 51.37$

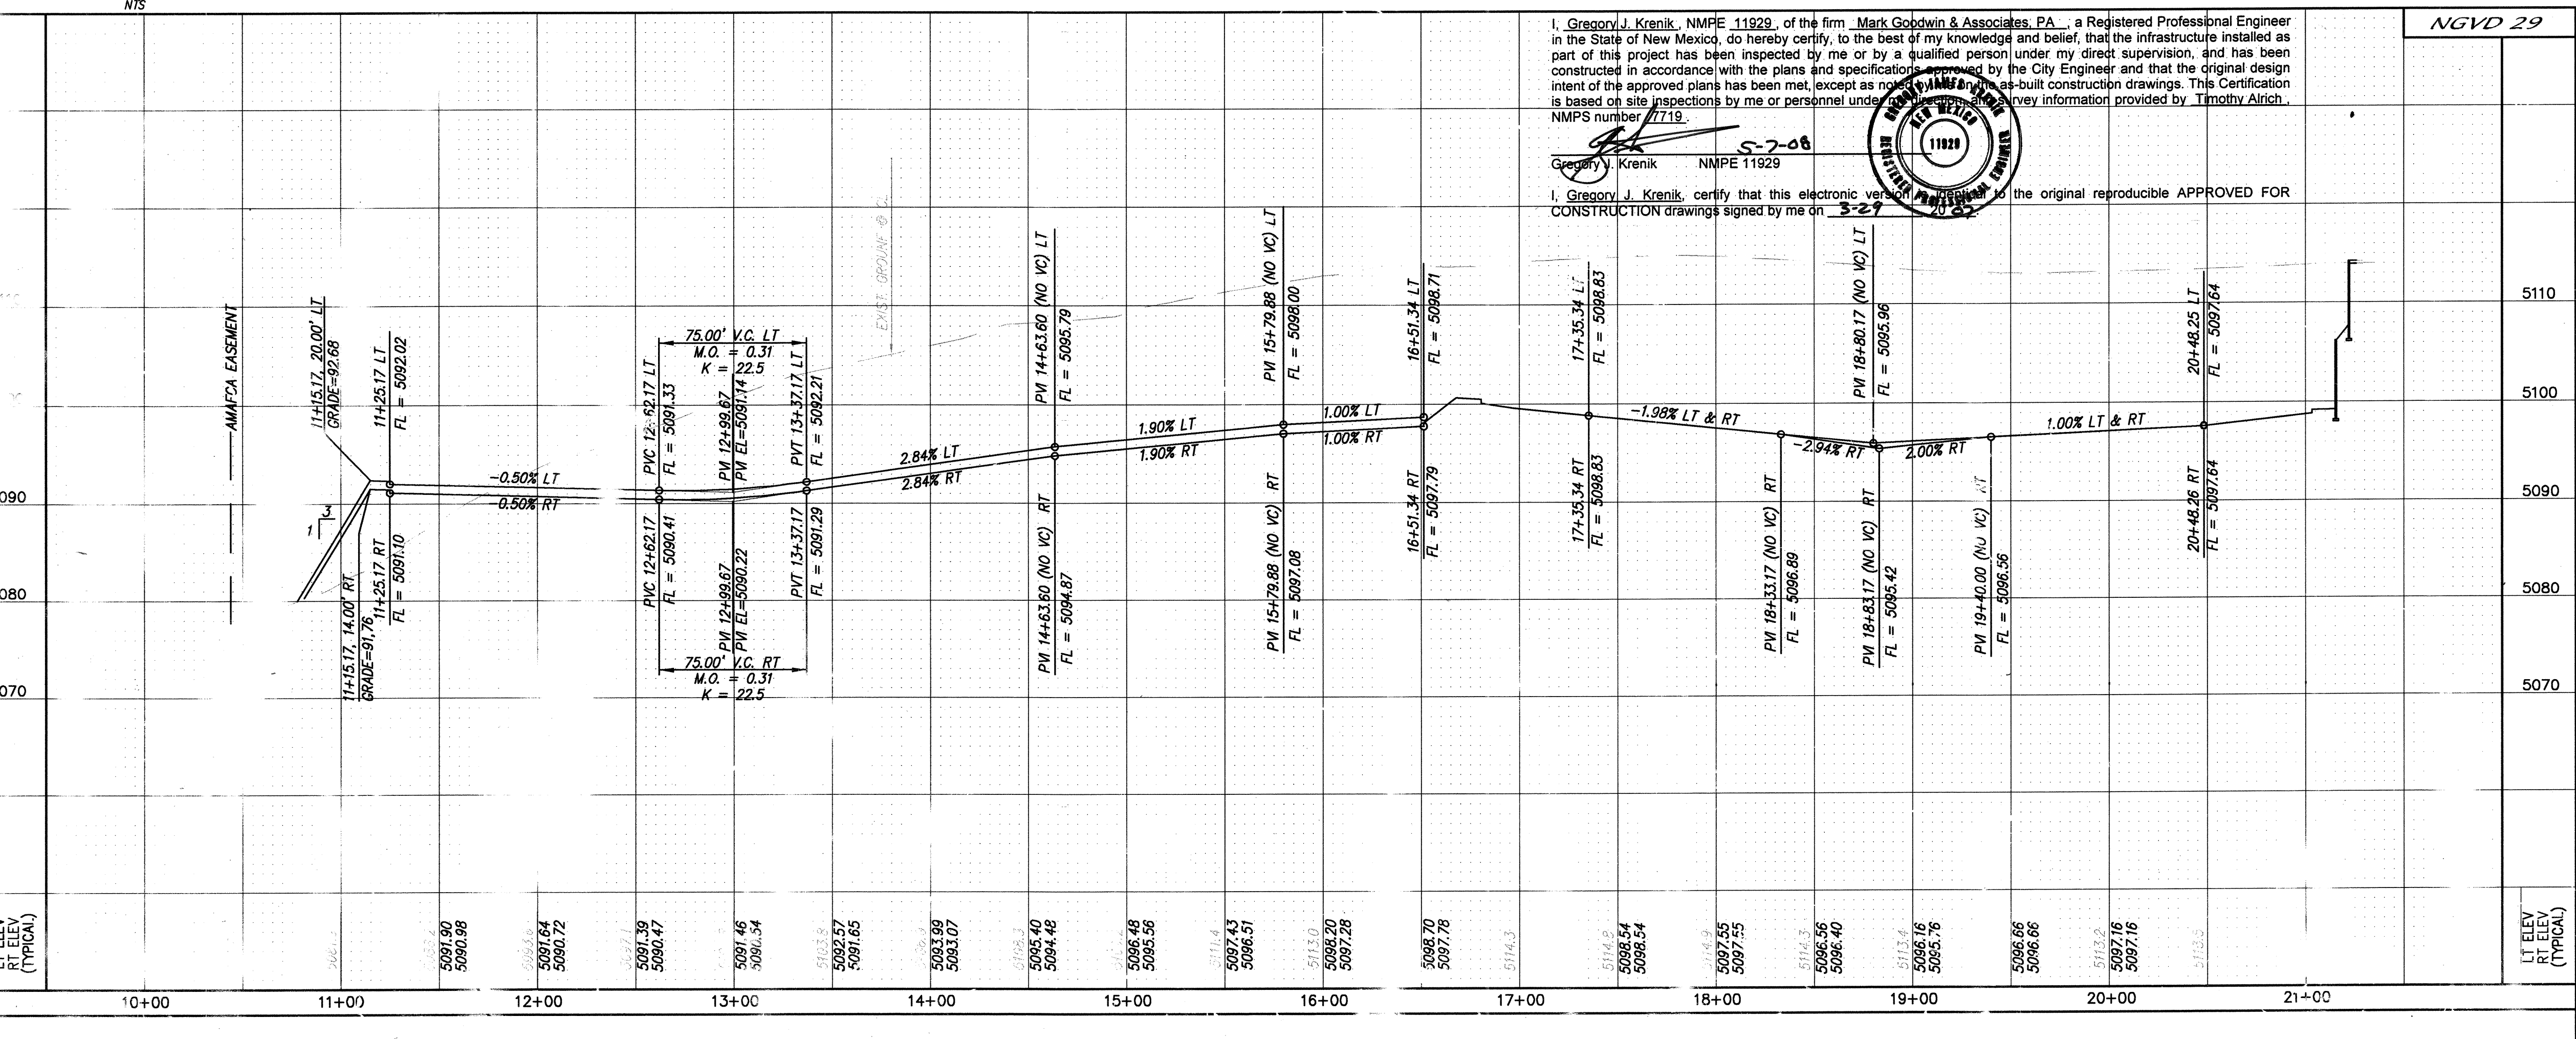

I, Gregory J. Krenik, NMPE 11929, of the firm Mark Goodwin & Associates, P.A., a Registered Professional Engineer in the State of New Mexico, do hereby certify, to the best of my knowledge and belief, that the infrastructure installed as part of this project has been inspected by me or by a qualified person under my direct supervision, and has been constructed in accordance with the plans and specifications approved by the City Engineer and that the original design intent of the approved plans has been met, except as noted on the as-built construction drawings. This Certification is based on site inspections by me or personnel under my direct supervision and survey information provided by Timothy Alrich, NMPS number 17719.

I, Gregory J. Krenik, certify that this electronic version is a true and correct reproduction of the original reproducible APPROVED FOR CONSTRUCTION drawings signed by me on 3-2-08.



MARK GOODWIN & ASSOCIATES, P.A.
CONSULTING ENGINEERS
P.O. BOX 90606
ALBUQUERQUE, NEW MEXICO 87199
OFFICE (505) 828-2200, FAX (505) 797-9539

CITY OF ALBUQUERQUE
PUBLIC WORKS DEPARTMENT

TITLE: VISTA DE LA LUZ
COSTA UASCA DRIVE NW
PAVING IMPROVEMENTS

APPROVED
MAY 17 2007
CITY ENGINEER

AS BUILT INFORMATION			SURVEY INFORMATION			FIELD NOTES			BENCH MARKS		
CONTRACTOR	DATE	BY	NO.	DATE	BY	NO.	DATE	BY	NO.	DATE	BY
SUNDANCE	10/8	ALS		10/8	ALS						
INSPECTOR'S FIELD LABEL	DATE	BY	NO.	DATE	BY	NO.	DATE	BY	NO.	DATE	BY
VERIFICATION BY	DATE	BY	NO.	DATE	BY	NO.	DATE	BY	NO.	DATE	BY
CORRECTED BY	DATE	BY	NO.	DATE	BY	NO.	DATE	BY	NO.	DATE	BY
RECORDED BY	DATE	BY	NO.	DATE	BY	NO.	DATE	BY	NO.	DATE	BY
MICRO-FILM INFORMATION											
NO.											

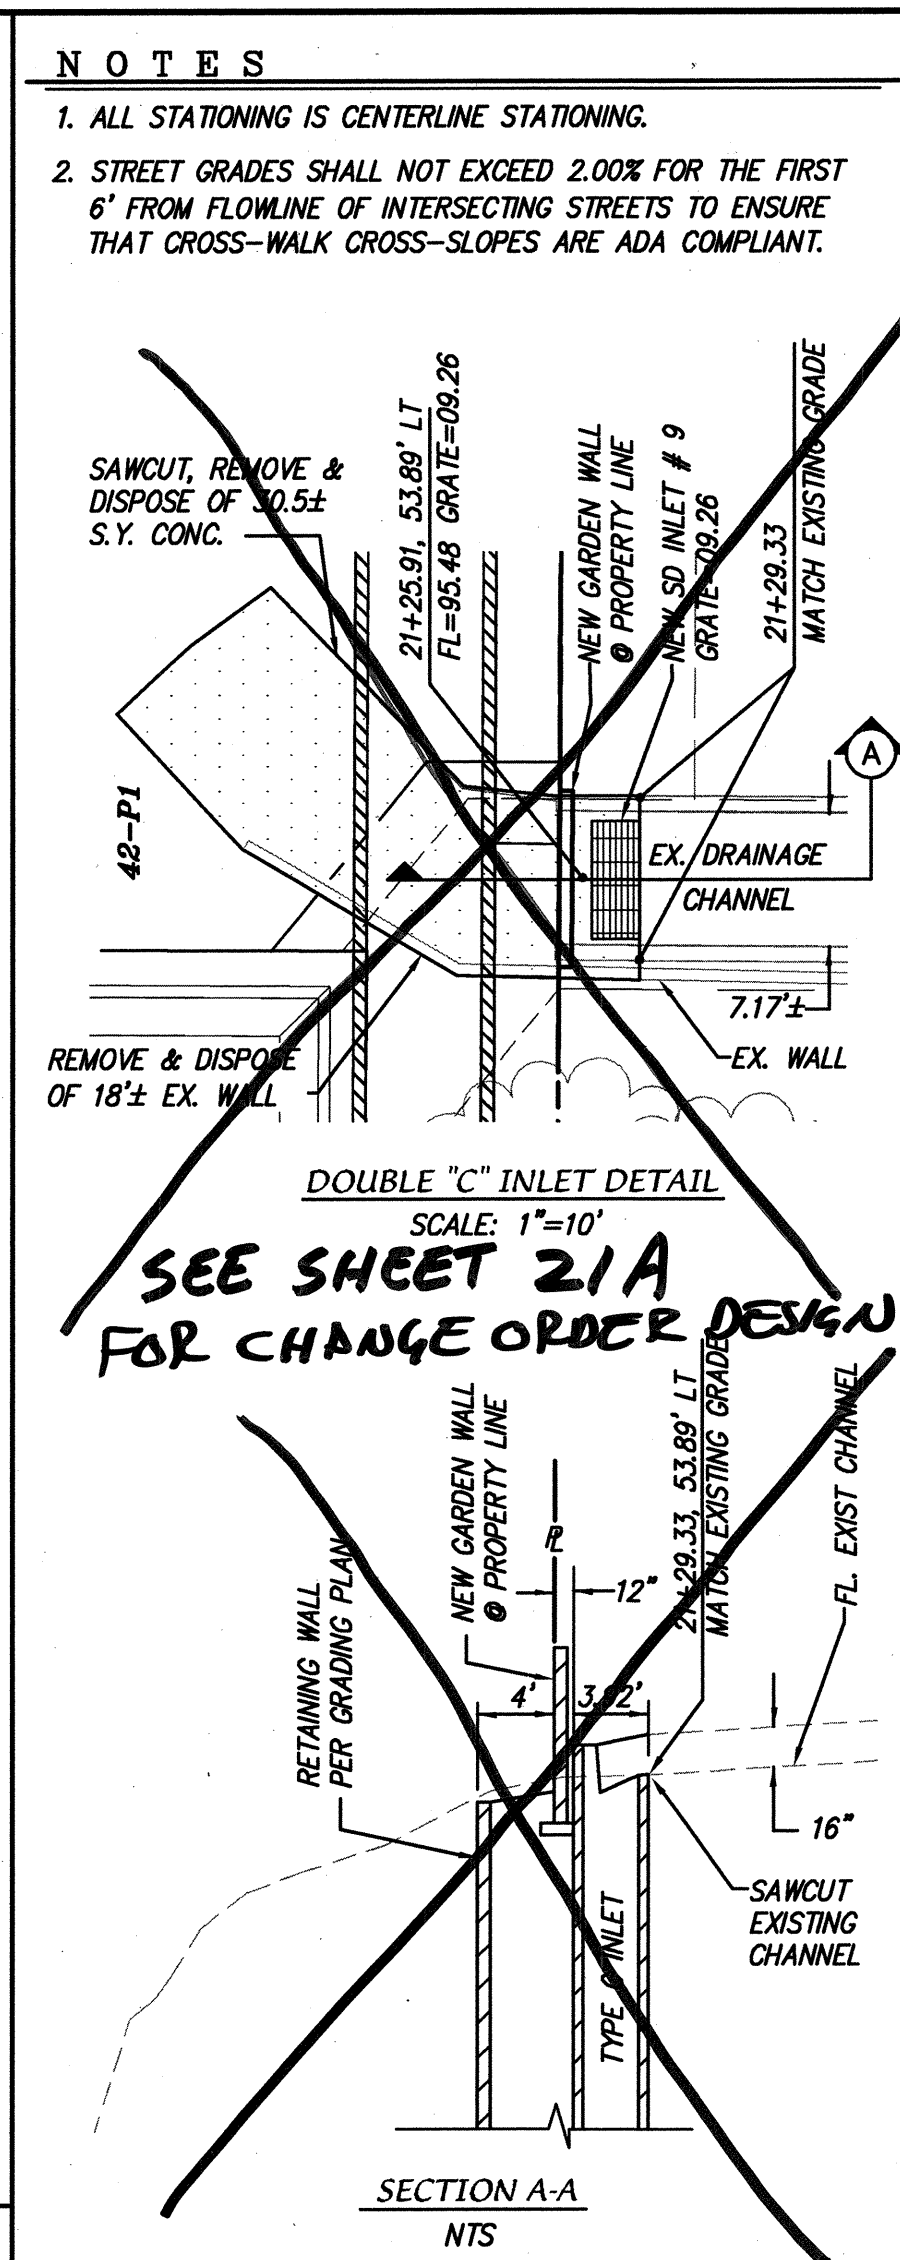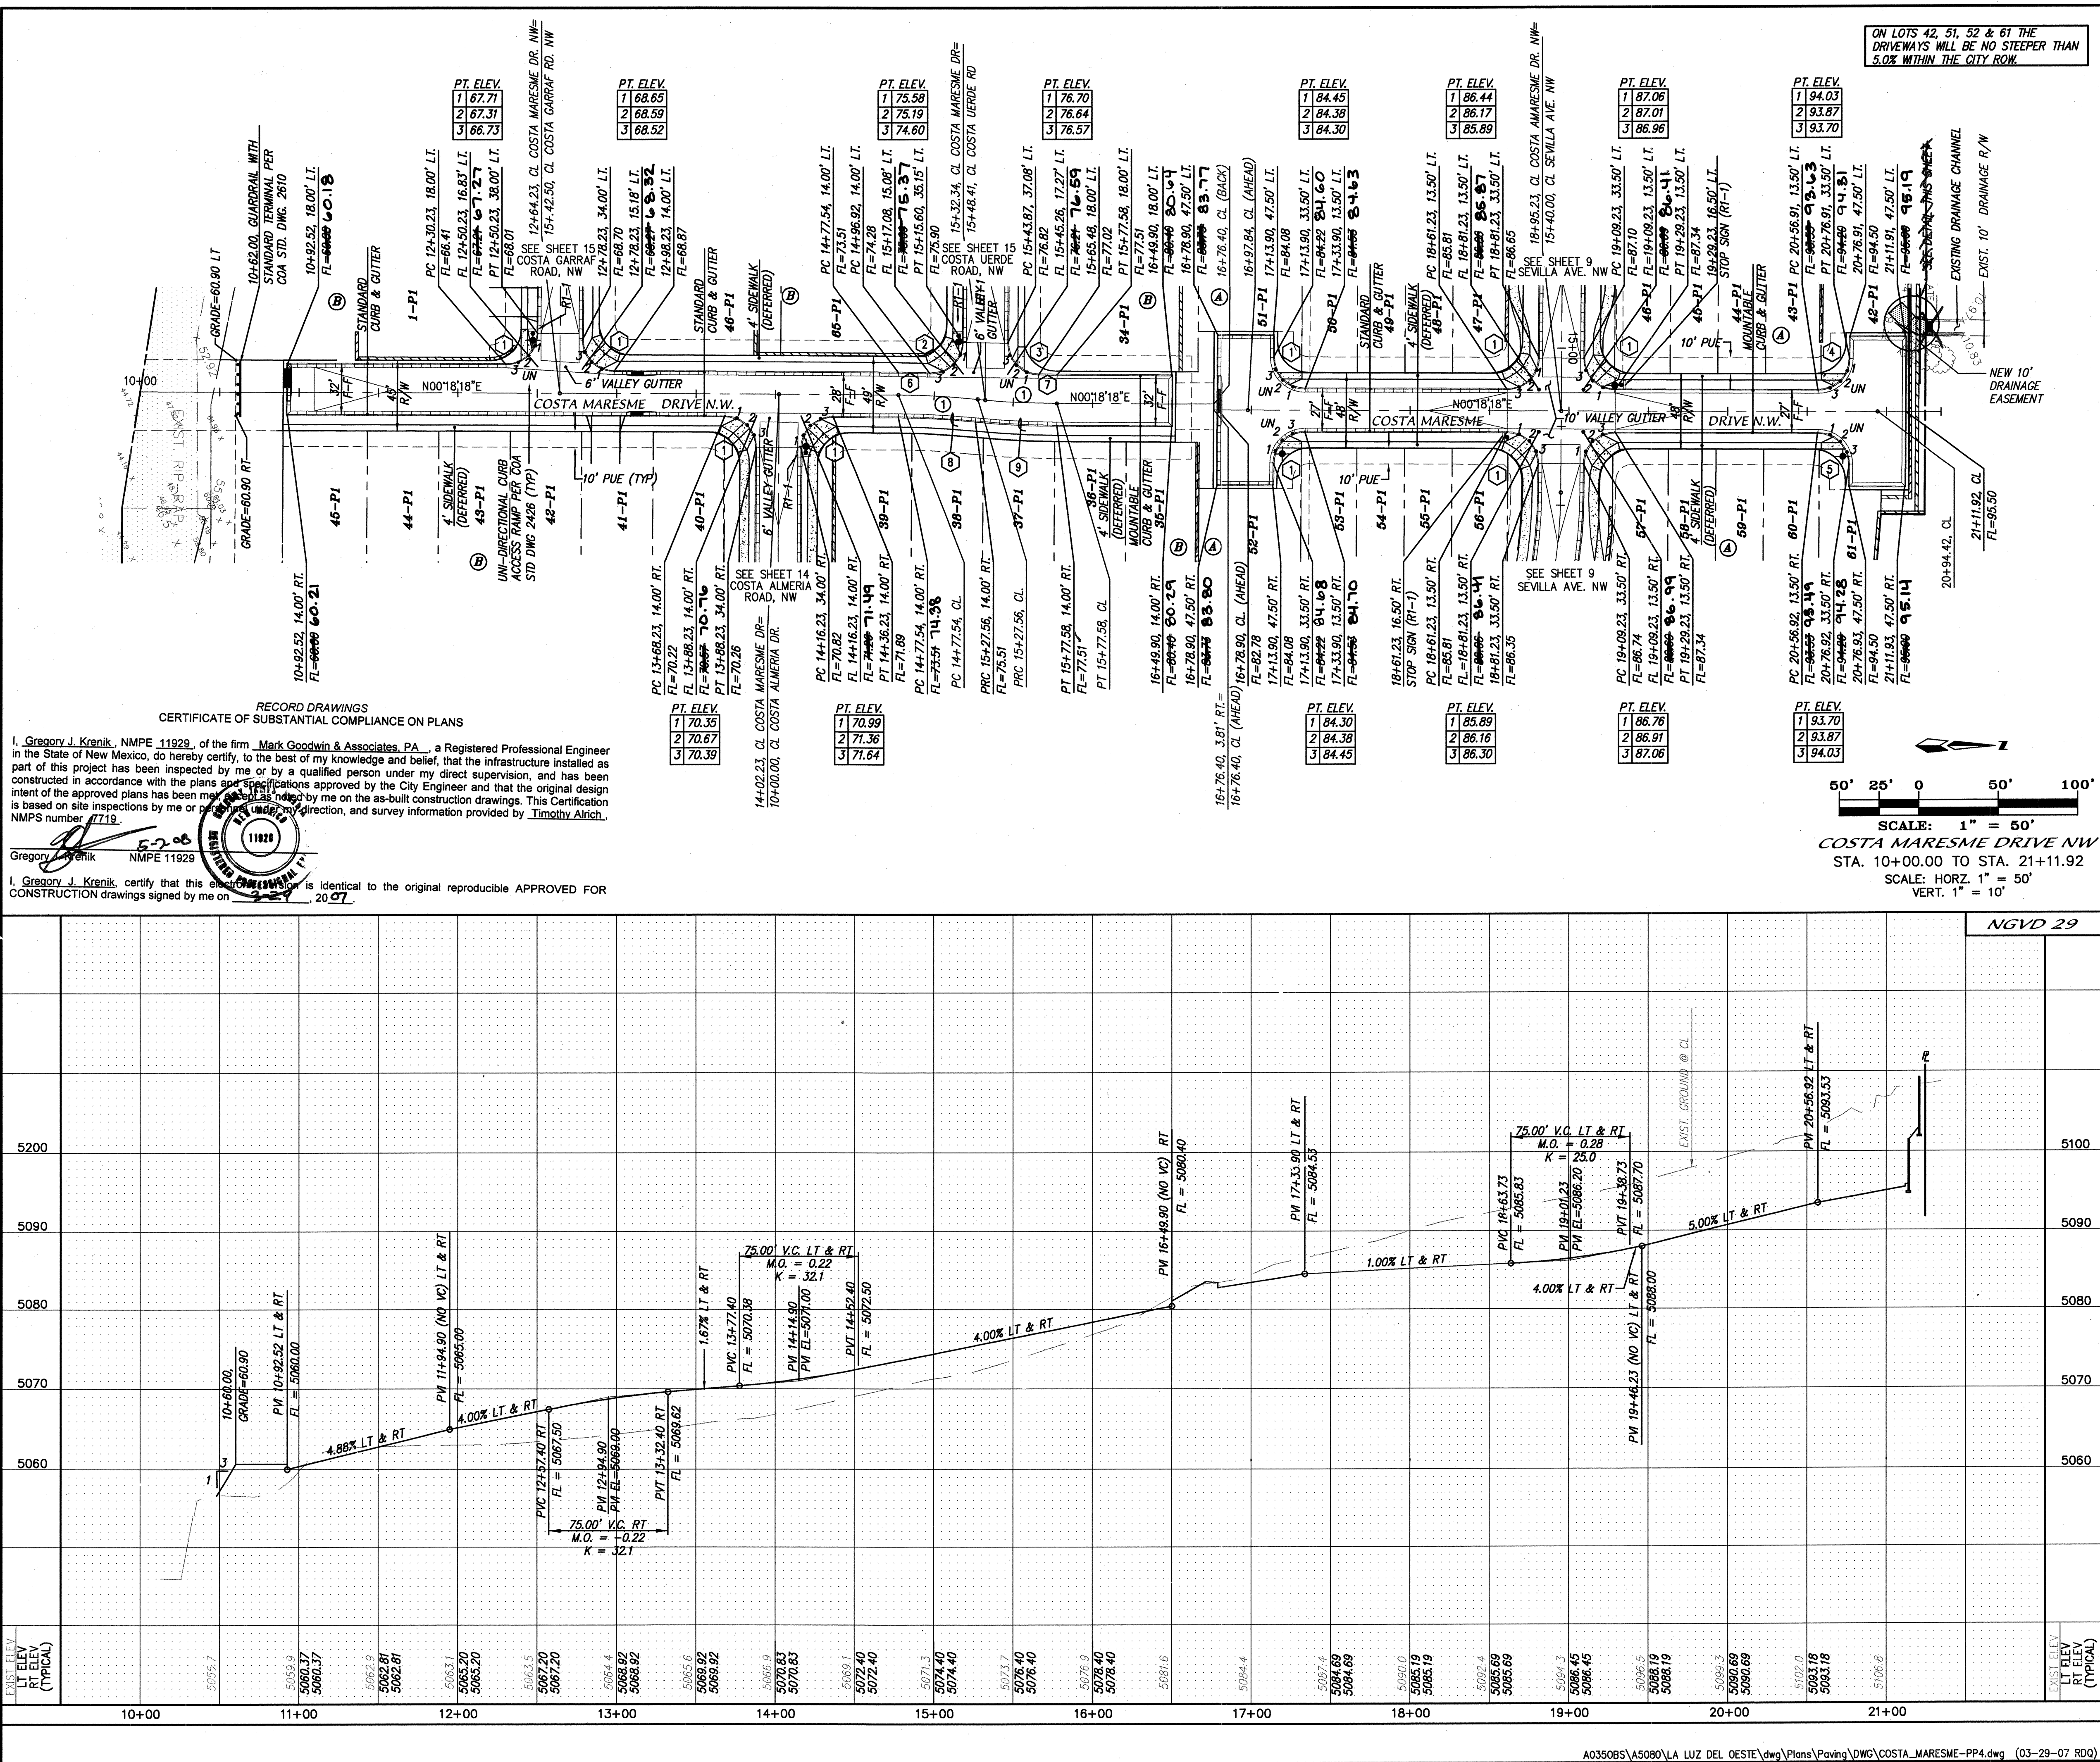

CURVE DATA - DESCRIBES CENTERLINE			
①	$\Delta = 05^{\circ}43'55''$ $R = 500.00'$ $L = 50.02'$ $T = 25.03'$		
CURVE DATA - DESCRIBES FACE OF CURB RETURNS			
①	$\Delta = 90^{\circ}00'00''$ $R = 20.00'$ $T = 20.00'$ $L = 31.42'$	②	$\Delta = 92^{\circ}13'14''$ $R = 20.00'$ $T = 20.79'$ $L = 32.19'$
③	$\Delta = 88^{\circ}36'46''$ $R = 20.00'$ $T = 19.52'$ $L = 30.93'$	④	$\Delta = 90^{\circ}00'40''$ $R = 20.00'$ $T = 20.00'$ $L = 31.42'$
⑤	$\Delta = 89^{\circ}59'40''$ $R = 20.00'$ $T = 20.00'$ $L = 31.41'$	⑥	$\Delta = 02^{\circ}13'14''$ $R = 514.00'$ $T = 9.96'$ $L = 19.92'$
⑦	$\Delta = 01^{\circ}23'14''$ $R = 482.00'$ $T = 5.84'$ $L = 11.67'$	⑧	$\Delta = 05^{\circ}43'55''$ $R = 486.00'$ $T = 24.33'$ $L = 48.62'$
⑨	$\Delta = 05^{\circ}43'55''$ $R = 514.00'$ $T = 25.73'$ $L = 51.42'$		

CITY OF ALBUQUERQUE
PUBLIC WORKS DEPARTMENT

TITLE:

VISTA DE LA LUZ
COSTA MARESME DRIVE N.W.
PAVING IMPROVEMENTS

DESIGN REVIEW COMMITTEE

APPROVED
MAY 17 2007

DESIGN REVIEW COMMITTEE

CITY ENGINEER APPROVAL

APPROVED
MAY 25 2007

CITY ENGINEER

LAST DESIGN UPDATE

MO./DAY/YR.

MO./DAY/YR.

CITY PROJECT NO.

791481

ZONE MAP NO.

F-11-Z

SHEET

13

OF


24

AS-BUILT INFORMATION			
CONTRACTOR	Sundance	DATE	1/08
WORKED BY	ALSA	DATE	3/08
INSPECTED BY	ALSA	DATE	1/08
ACCEPTANCE BY	ALSA	DATE	1/08
MICRO-FILM INFORMATION			
DATE		RECORDED BY	
NO.		NO.	
BENCH MARKS			
MS STATION "MM48-N6-A" IS LOCATED 4.5 M. NW OF DOWNTOWN ALBUQUERQUE, ON THE SOUTH SIDE OF COORS BLVD., IN THE ENTRANCE TO THE LA LUZ CONDOMINIUM. TO REACH THE STATION FROM THE GO NORTH ON COORS BLVD., 2.5 MILES TO THE STATION ON THE RIGHT. THE STATION IS STD. MUSH BRASS TABLET STAMPED, "MM48-N6-A" SET IN TOP OF A CONC. POST			
X = 366,640.72 Y = 1,507,308.30 (NAD 27) ELEV = 5058.889 (NAD 29)			
SURVEY INFORMATION			
FIELD NOTES	DATE	BY	
NO.			
ENGINEER'S SEAL			
NO.	DATE	REMARKS	BY
		DESIGN	
		REVISIONS	
DESIGNED BY	G/K	DATE	10/06
DRAWN BY	RDQ	DATE	10/06
CHECKED BY	LMAG	DATE	10/06

1. ALL STATIONING IS CENTERLINE STATIONING.
2. STREET GRADES SHALL NOT EXCEED 2.00% FOR THE FIRST 6' FROM FLOWLINE OF INTERSECTING STREETS TO ENSURE THAT CROSS-WALK CROSS-SLOPES ARE ADA COMPLIANT.

① $\Delta = 97^{\circ}34'09''$ $R = 75.00'$ $L = 127.72'$ $T = 85.63'$	② $\Delta = 64^{\circ}12'04''$ $R = 300.00'$ $L = 336.16'$ $T = 188.19'$	③ $\Delta = 37^{\circ}48'29''$ $R = 250.00'$ $L = 164.97'$ $T = 85.61'$
---	---	--


1	2	3
$\Delta = 90^{\circ}00'00''$	$\Delta = 84^{\circ}16'31''$	$\Delta = 112^{\circ}47'23''$
$R = 20.00$	$R = 20.00$	$R = 35.00$
$T = 20.00$	$T = 18.10$	$T = 52.67$
$L = 31.42$	$L = 29.42$	$L = 68.90$

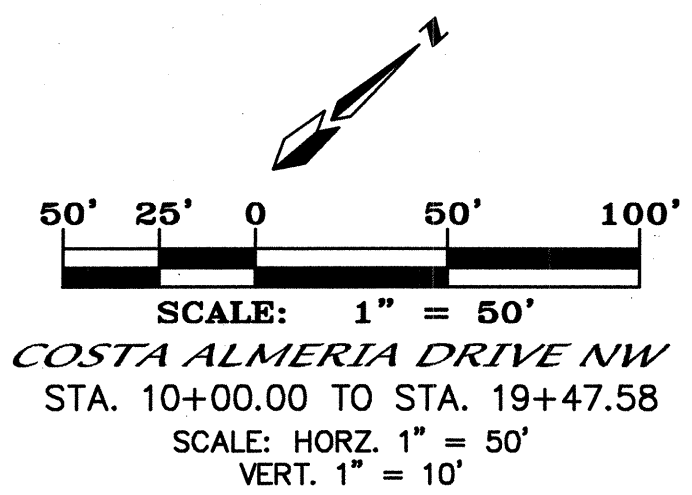

CERTIFICATE OF SUBSTANTIAL COMPLIANCE ON PLANS				
--	--	--	--	--

Gregory J. Krenik NMPE 11929

I, Gregory J. Krenik, certify that this electronic version is identical to the original reproducible APPROVED FOR CONSTRUCTION drawings signed by me on 5-7-08 2007

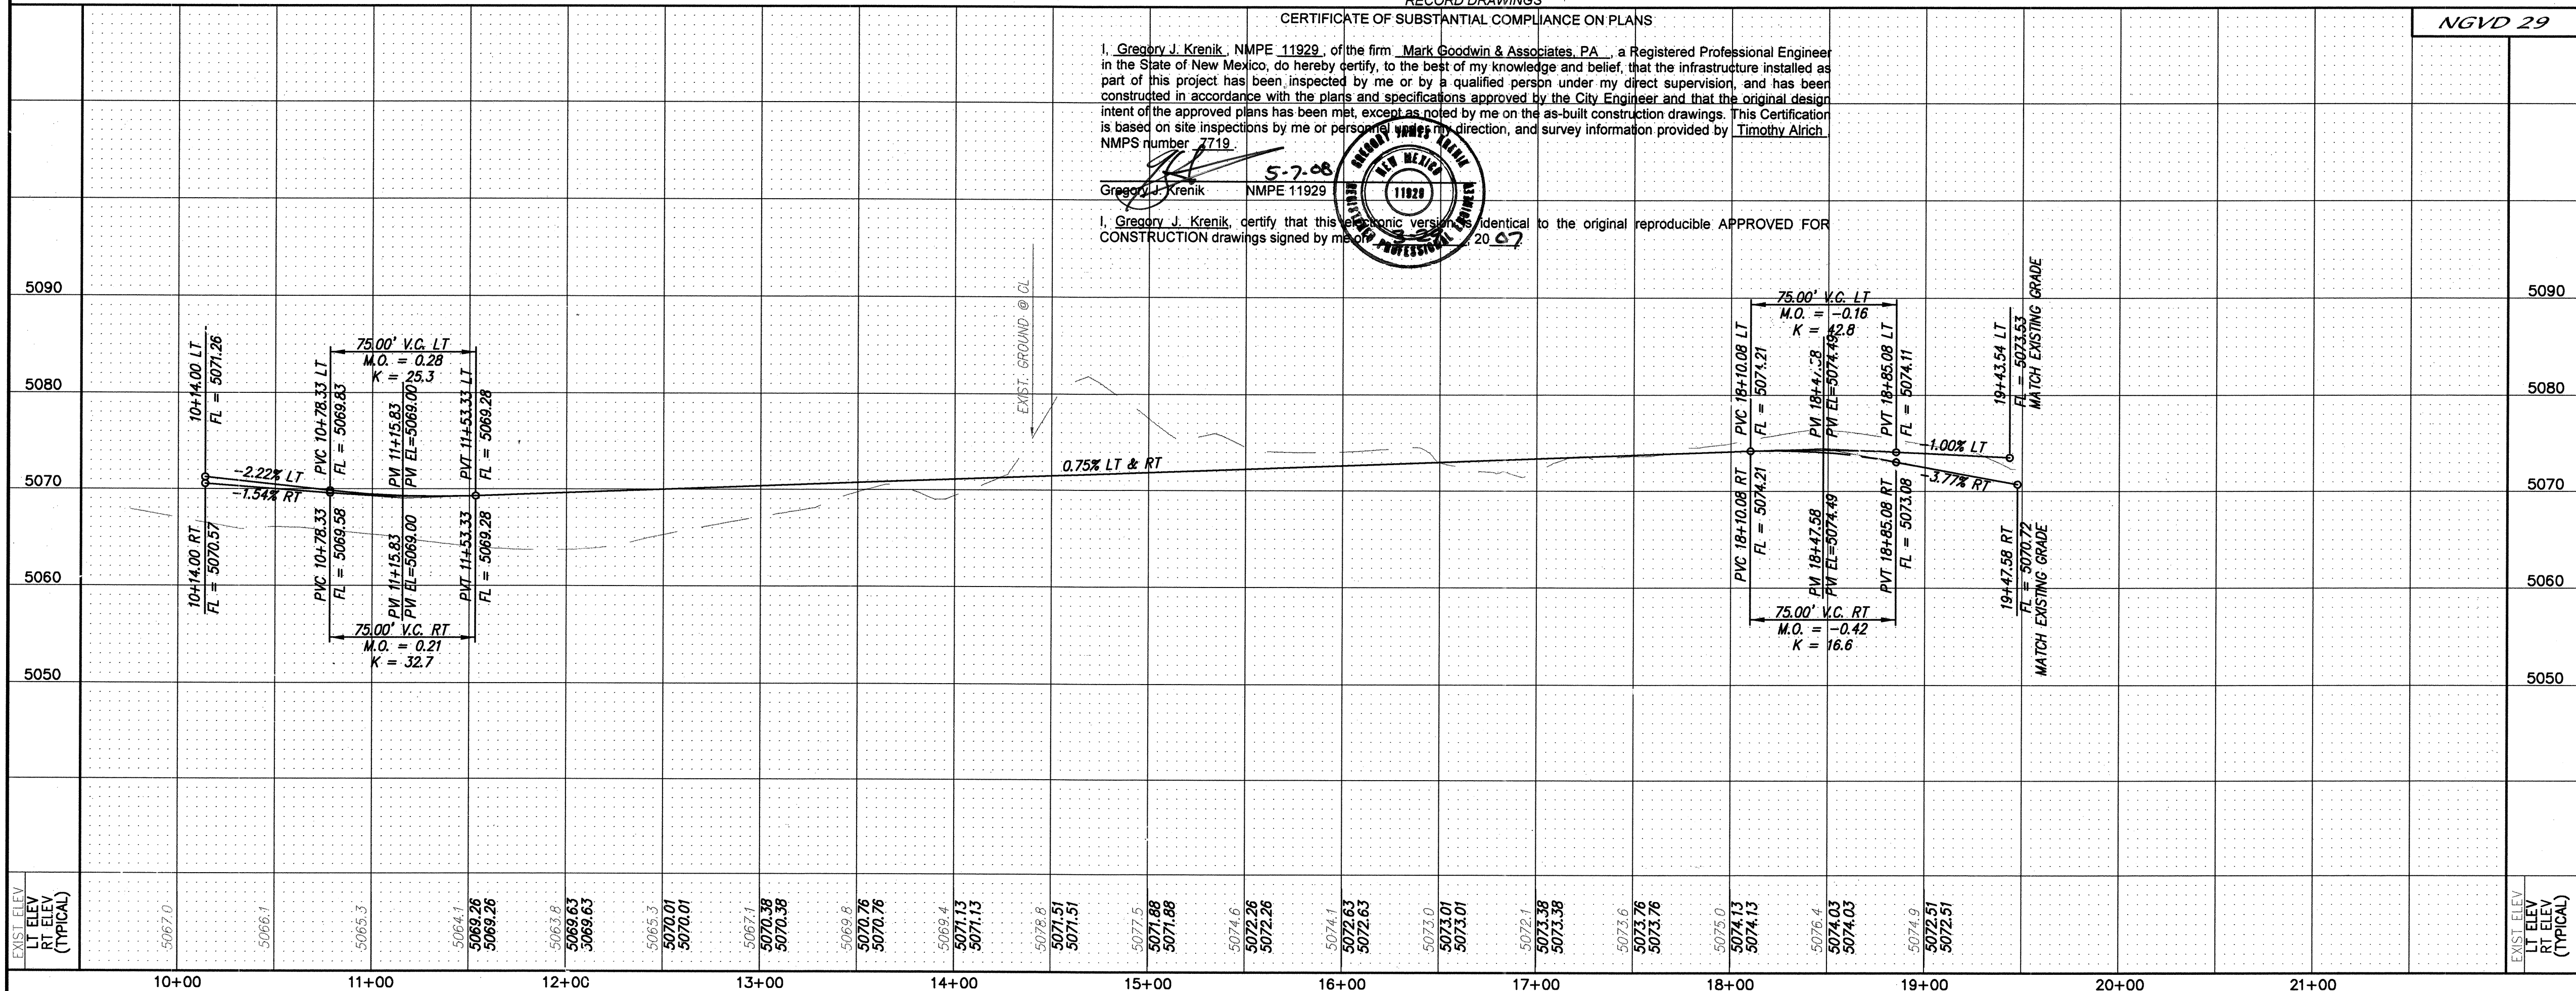

dmg MARK GOODWIN & ASSOCIATES, P.A.
CONSULTING ENGINEERS
P.O. BOX 90606
ALBUQUERQUE, NEW MEXICO 87199
OFFICE (505) 828-2200, FAX (505) 797-9539



CITY OF ALBUQUERQUE
PUBLIC WORKS DEPARTMENT

TITLE:

VISTA DE LA LUZ
COSTA ALMERIA DRIVE N.W.
PAVING IMPROVEMENTS

DESIGN REVIEW COMMITTEE

APPROVED

MAY 17 2007

DESIGN REVIEW COMMITTEE

CITY ENGINEER APPROVAL

APPROVED

MAY 25 1987



CITY ENGINEER

LAST DESIGN UPDATE

CITY PROJECT NO.

ZONE MAP NO.

SHEET OF

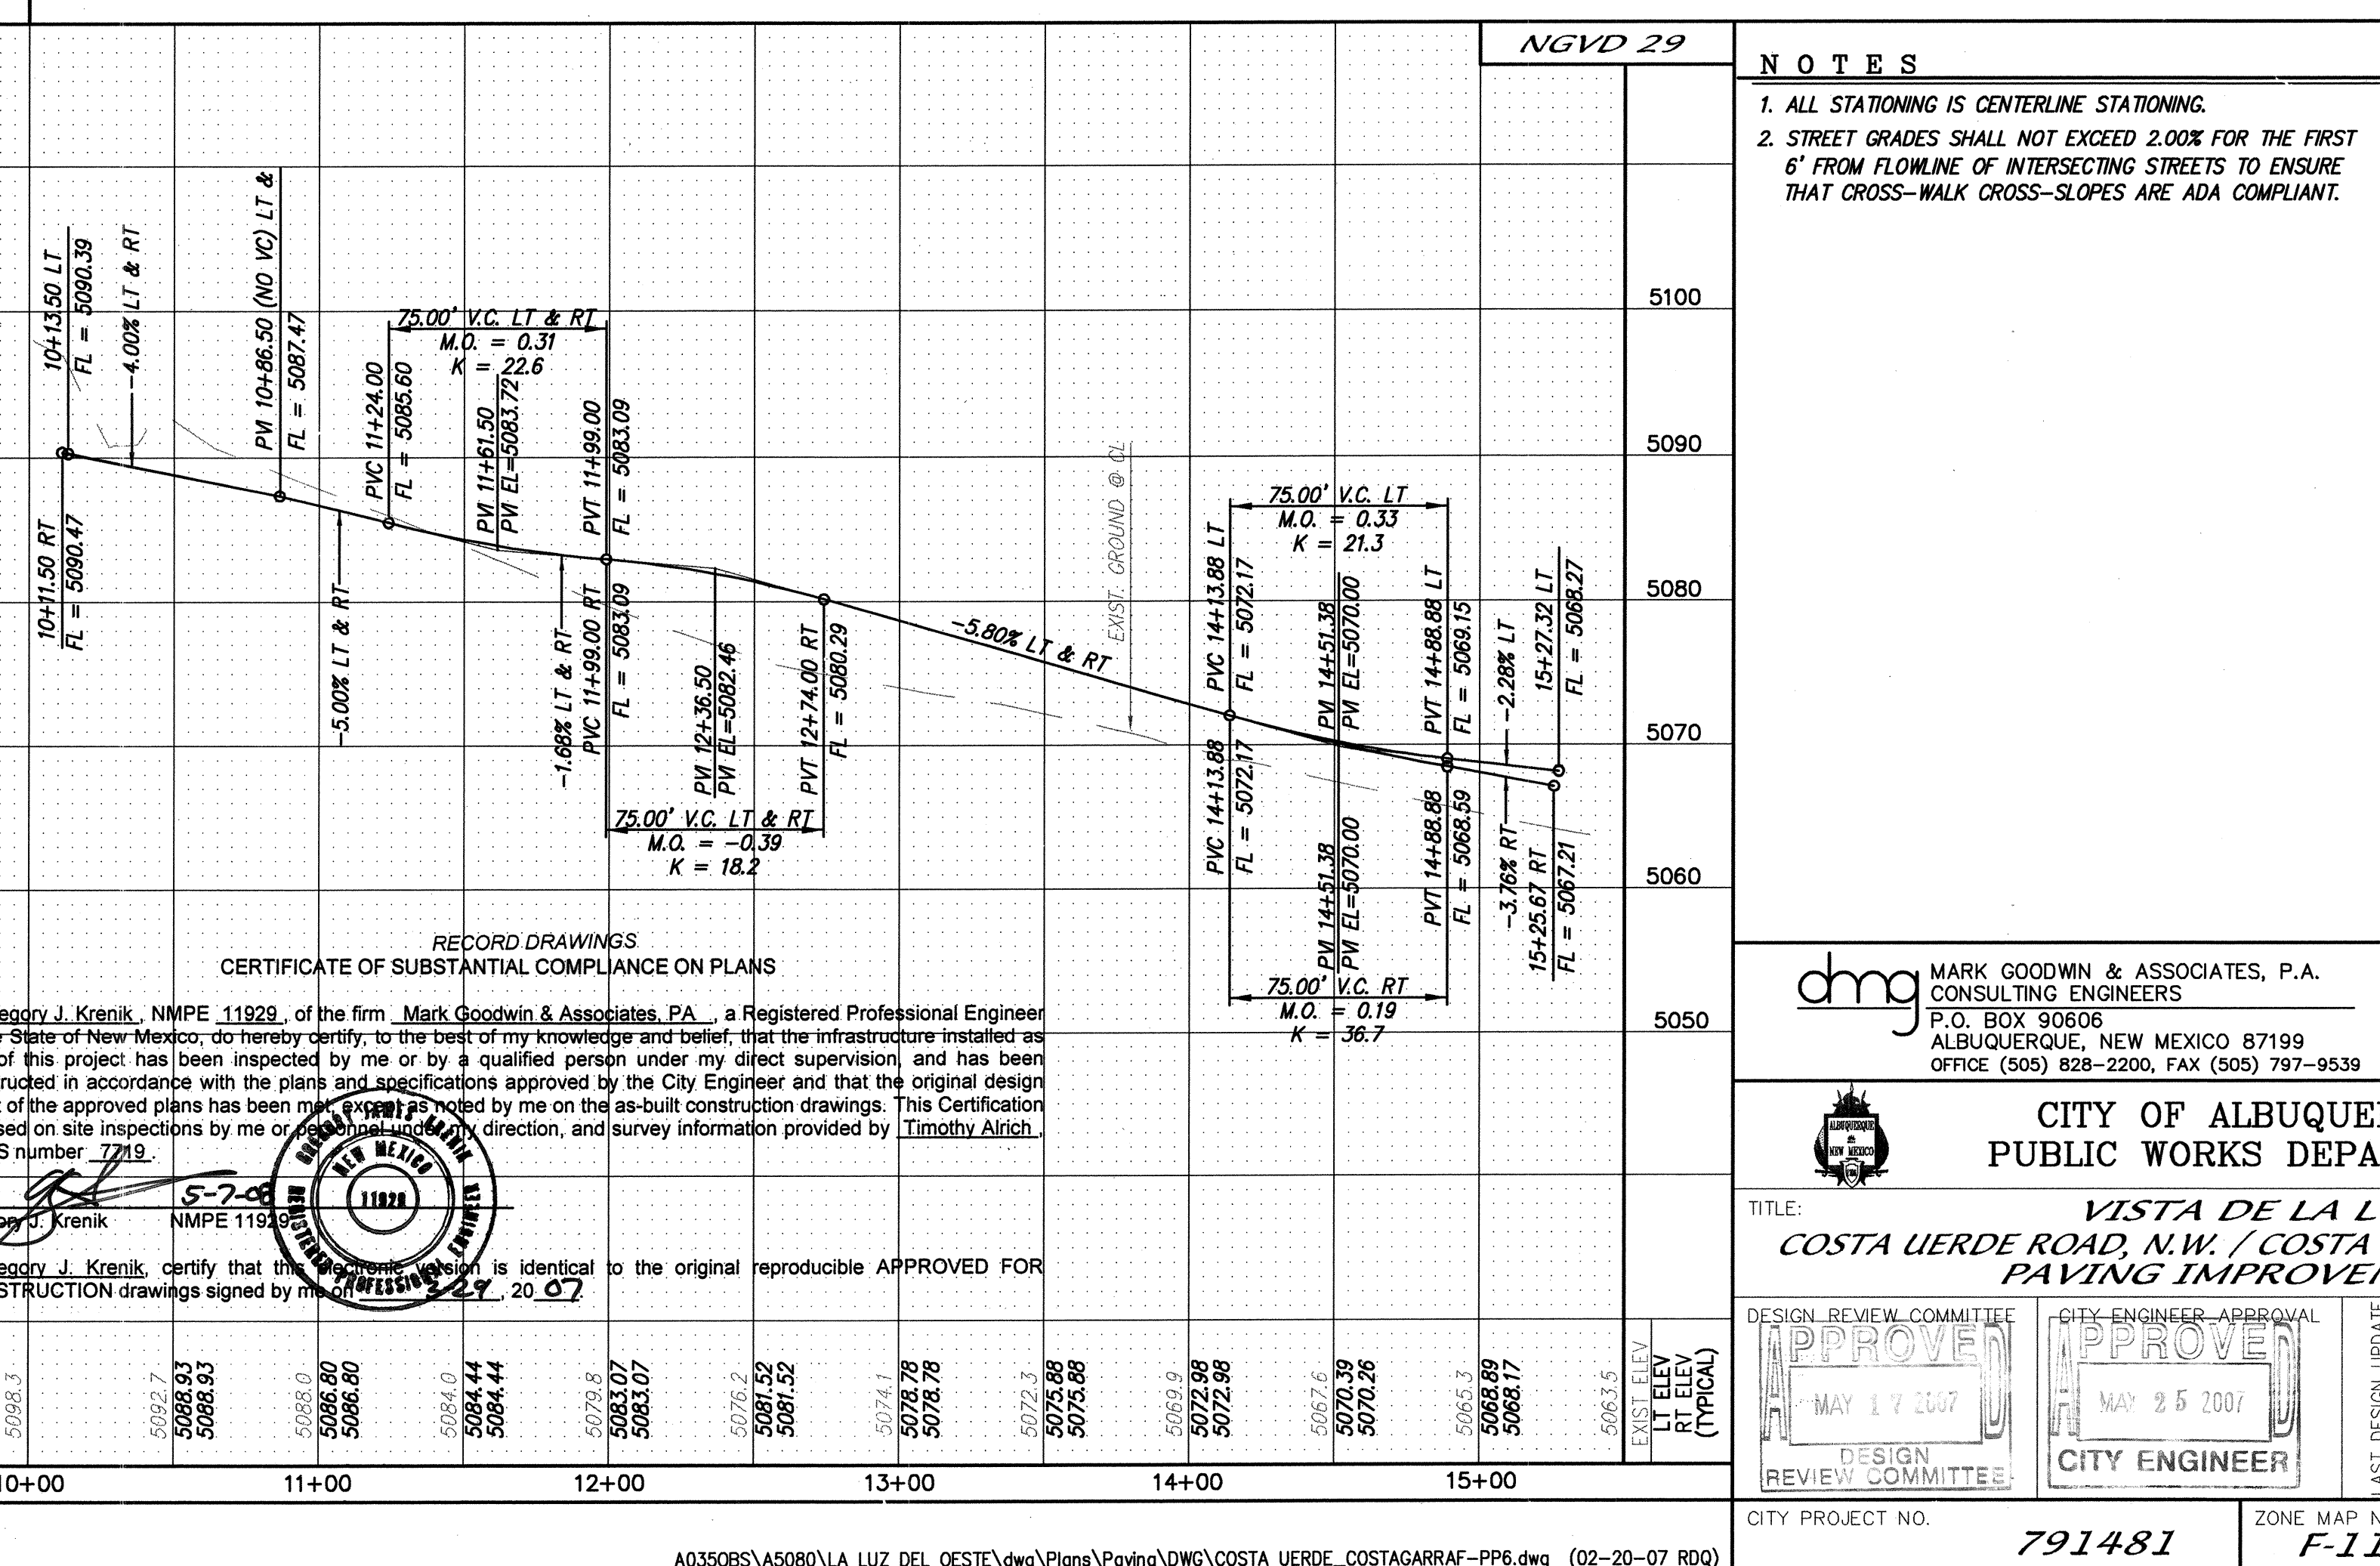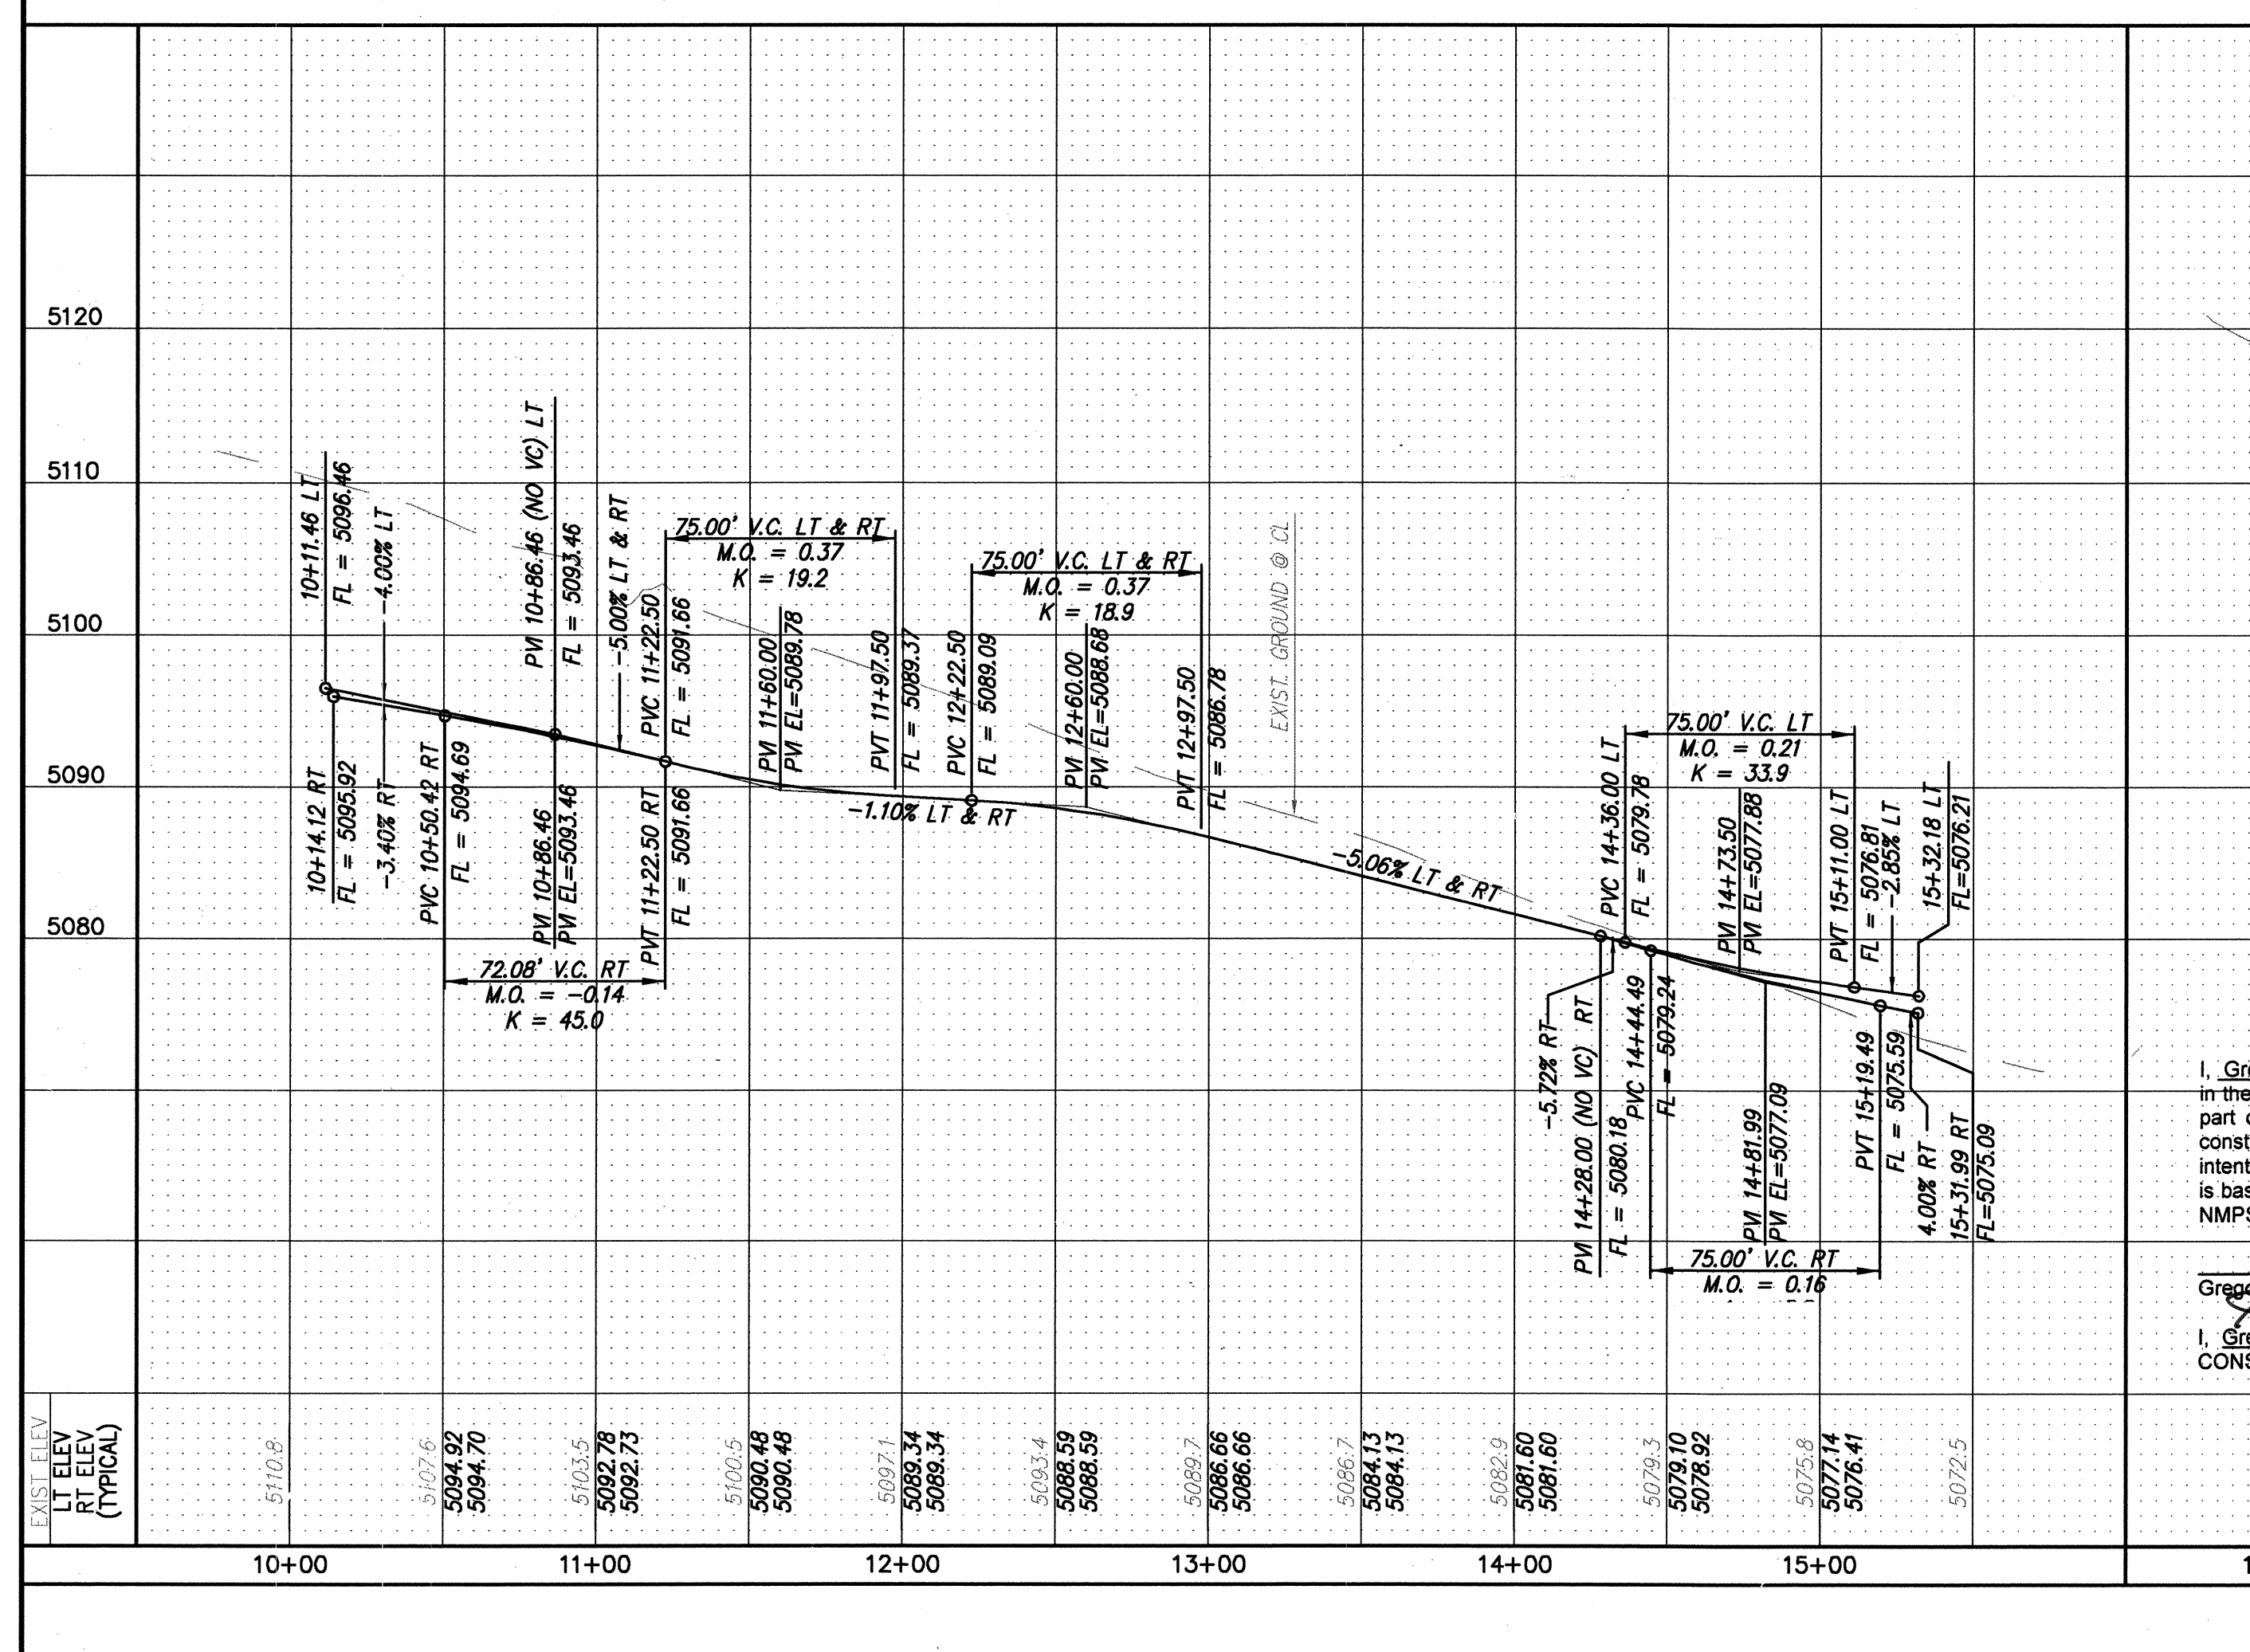[illegible]

CURVE DATA - DESCRIBES CENTERLINE

- $$\begin{array}{ll} \textcircled{1} \quad \Delta = 15^{\circ}00'00'' & \textcircled{2} \quad \Delta = 08^{\circ}15'00'' \\ R = 3819.72' & R = 3819.72' \\ L = 1000.00' & L = 550.00' \\ T = 502.88' & T = 275.48' \end{array}$$



- (A) 1" QUIET ASPHALT
- (B) 2.5" ARTERIAL ASPHALT CONCRETE. TYPICAL FINISH COURSE PLACED AFTER ALL MANHOLE & VALVE COVERS/RINGS ARE SET TO GRADE. SP-III GRADATION.
- (C) TACK COAT AS REQUIRED BY THE ENGINEER BETWEEN ASPHALT/AGGREGATE MATERIAL LIFTS.
- (D) 3" ARTERIAL ASPHALT CONCRETE. SP-III GRADATION
- (E) 4" ARTERIAL ASPHALT CONCRETE. SP-III GRADATION
- (F) AGGREGATE BASE COURSE
2 - 4" LIFTS
- (G) 1' SUBGRADE SOIL, R-VALUE>50. PLACED IN 2 - 6" LIFTS. 95% MIN. COMPACTION AT OPT MOISTURE +2.0% ASTM D698 FOR SOIL WITH 35% OR MORE PASSING 200. SIEVE.

FINISH SURFACES OF SUBGRADE SHALL BE MOISTURE CONTROLLED AT THE COMPACTION MOISTURE RANGE, OR A PRIME COAT APPLIED AS REQUIRED BY THE ENGINEER UNTIL NEXT/FINAL SURFACING IS COMPLETED. SUBGRADE PREPARATION SHALL BE PERFORMED AFTER ALL SUBSURFACE R/W UTILITIES CONSTRUCTION ARE COMPLETED.



- ① $\Delta = 01^{\circ}28'19''$
 $R = 533.42$
 $T = 68.84$
 $L = 132.36$

② $\Delta = 06^{\circ}29'14''$
 $R = 3074.72$
 $T = 219.59$
 $L = 438.71$

③ $\Delta = 88^{\circ}16'30''$
 $R = 30.00$
 $T = 29.11$
 $L = 46.22$

④ $\Delta = 89^{\circ}22'36''$
 $R = 30.00$
 $T = 29.68$
 $L = 46.80$

⑤ $\Delta = 05^{\circ}18'25''$
 $R = 4011.95$
 $T = 185.93$
 $L = 371.60$


⑥ $\Delta = 170^{\circ}3'50''$
 $R = 150.00$
 $T = 22.50$
 $L = 44.67$

⑦ $\Delta = 15^{\circ}33'34''$
 $R = 150.00$
 $T = 20.49$
 $L = 40.73$



SCALE: 1" = 50'
 HORS BOULEVARD, N.W.
 21+18.33 TO STA. 35+03.30
 SCALE: HORZ. 1" = 50'
 VERT. 1" = 10'

FOR INFORMATION ONLY
THIS PORTION IS TO BE PERMITTED THROUGH NMDOT

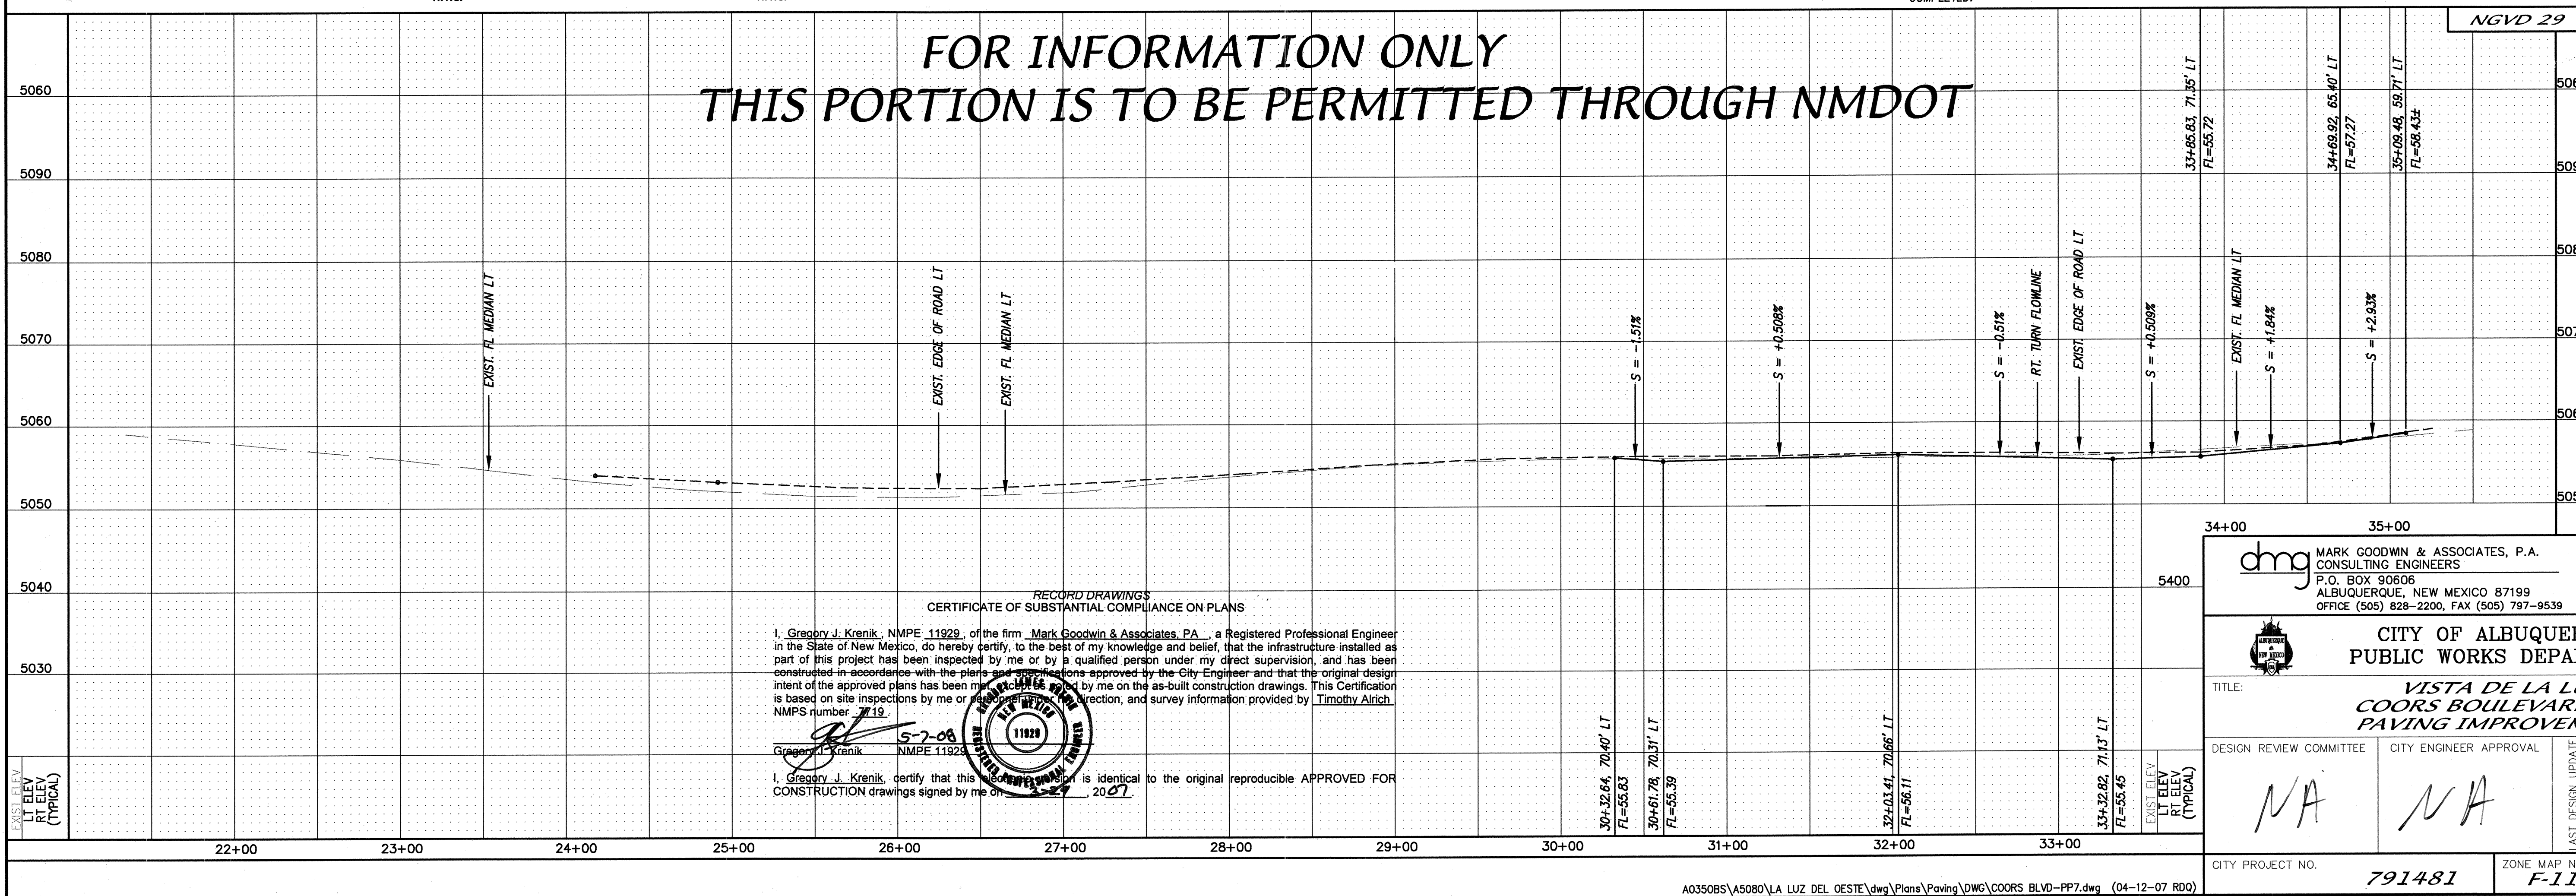

I, Gregory J. Krenik, NMPE 11929, of the firm Mark Goodwin & Associates, P.A., a Registered Professional Engineer in the State of New Mexico, do hereby certify, to the best of my knowledge and belief, that the infrastructure installed as part of this project has been inspected by me or by a qualified person under my direct supervision, and has been constructed in accordance with the plans and specifications approved by the City Engineer and that the original design intent of the approved plans has been met. This certification is based on the as-built construction drawings. This Certification is based on site inspections by me or my representative, and the direction, and survey information provided by Timothy Alrich, NMPS number 7719.

JK **5-2-08**

Gregory J. Krenik NMPE 11929

I, Gregory J. Krenik, certify that this as-built is identical to the original reproducible **APPROVED FOR CONSTRUCTION** drawings signed by me on 5-2-08.

dmg MARK GOODWIN & ASSOCIATES, P.A.
CONSULTING ENGINEERS
P.O. BOX 90606
ALBUQUERQUE, NEW MEXICO 87199
OFFICE (505) 828-2200, FAX (505) 797-9531


 CITY OF ALBUQUERQUE
PUBLIC WORKS DEPARTMENT

TITLE: *VISTA DE LA LUZ
COORS BOULEVARD N.W.
PAVING IMPROVEMENTS*


DESIGN REVIEW COMMITTEE	CITY ENGINEER APPROVAL	LATEST DESIGN UPDATE MO./DAY
NA	NA	

CITY PROJECT NO.	791481	ZONE MAP NO.	F-11-Z
------------------	--------	--------------	--------

ENGINEER'S SEAL

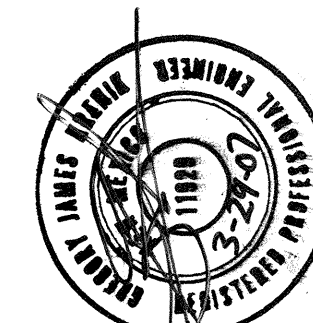[illegible]

DATE TIME	
QUESTIONS MENT MO./DAY/YR. MO./DAY/YR.	
QUESTIONS MENT MO./DAY/YR. MO./DAY/YR.	
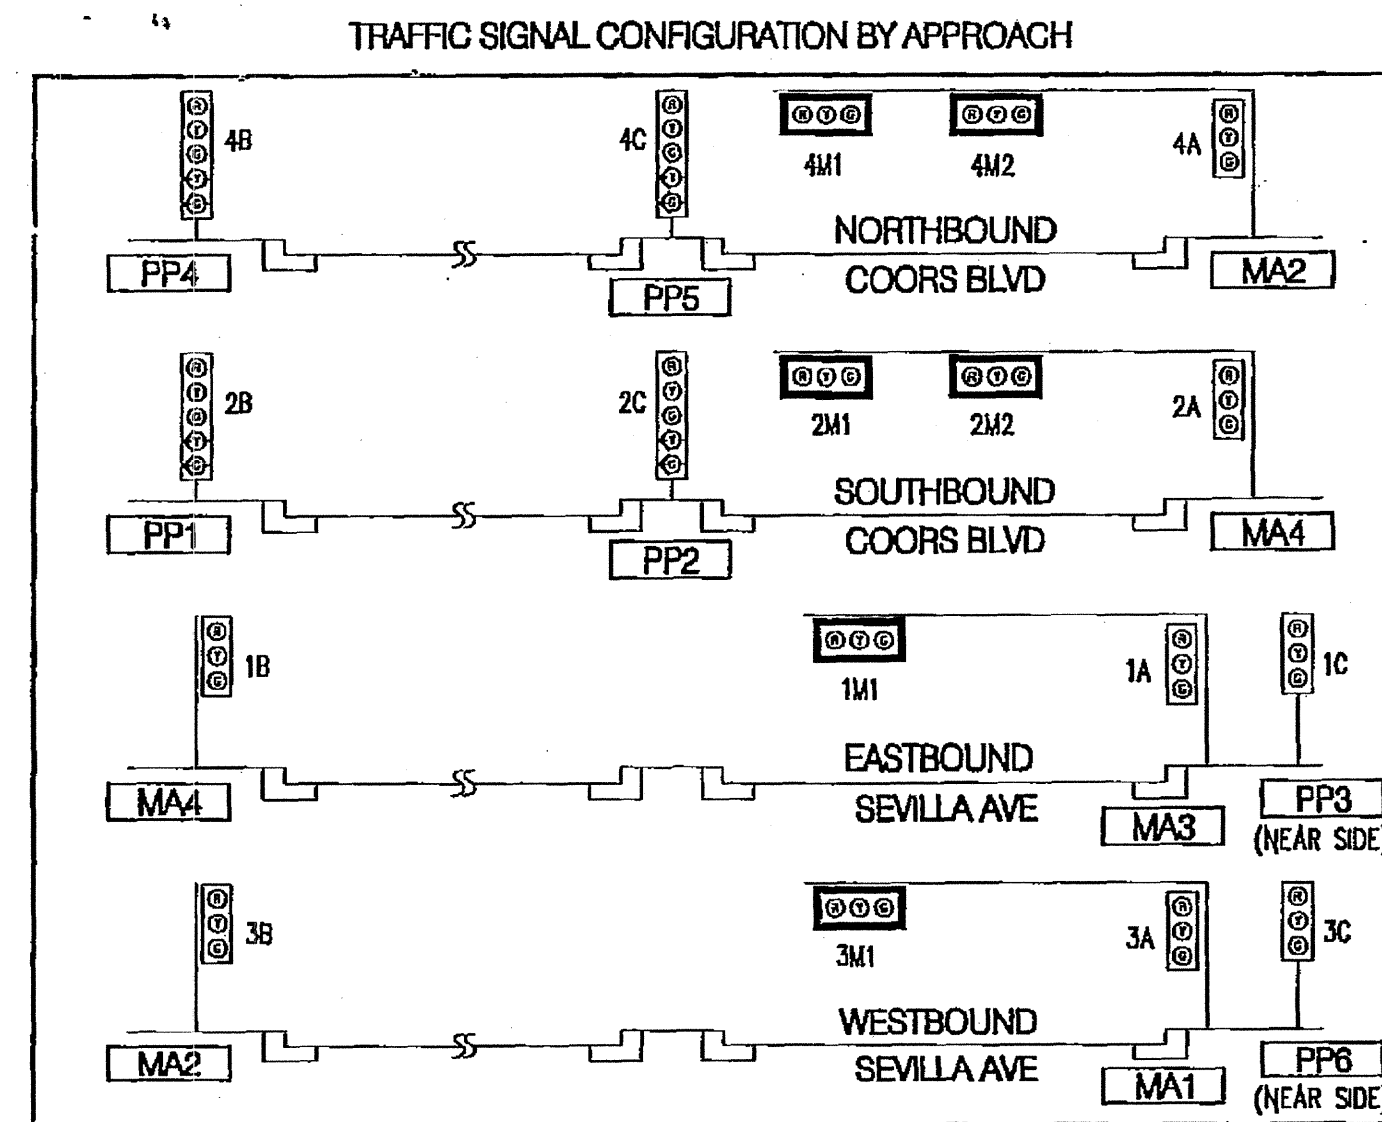


FLASH CONDITION
RED BALL 1A, 1B, 1C, 1M1, 2A, 2B, 2C, 2M1, 2M2, 3A, 3B, 3C, 3M1, 4A, 4B, 4C, 4M1, 4M2

INITIALIZATION
ALL RED, THEN PHASE 2 AND 6 GREEN


OPTICAL DETECTOR CABLE		
FROM	TO	TOTAL LENGTH
MA1	CC1	MA1-24-22-2
MA2	CC1	MA2-26-6X-4X-4-2
MA3	CC1	MA3-28-10b-11b-8-6X-4X-4-2
MA4	CC1	MA4-30-18-20b-21b-22-2
TOTAL		1115'

VIDEO DETECTOR CABLE		
FROM	TO	TOTAL LENGTH
MA1	CC1	MA1-24-22-2
MA2	CC1	MA2-26-6X-4X-4-2
MA3	CC1	MA3-28-10b-11b-8-6X-4X-4-2
MA4	CC1	MA4-30-18-20b-21b-22-2
TOTAL		1185'

- NOTES
- PULL BOXES PB1 THRU PB11 ARE LARGE SIZE.
 - REMOVE AND DISPOSE EXISTING PULL BOX. EXTEND EXISTING CONDUIT IN KIND TO NEW MANHOLE.
 - REMOVE AND DISPOSE EXISTING PULL BOX.
 - REMOVE AND DISPOSE EXISTING PULL BOX. INSTALL NEW PULL BOX (LARGE).
 - INTERCEPT EXISTING CONDUIT RUNS. INSTALL NEW PULL BOX (LARGE).
 - SEE SHEET S-7 FOR INTERCONNECT PLAN.
 - SEE SHEET S-8 FOR LIGHTING PLAN.
 - CONTRACTOR SHALL VERIFY THE CONDITION OF EXISTING CONDUITS 4X, 5X, 6X, AND 7X PRIOR TO INSTALLATION OF NEW WIRING. IF THE CONDUIT IS DAMAGED, THE OLD CONDUIT SHALL BE REPLACED WITH APPROPRIATE SIZES OF NEW CONDUIT.

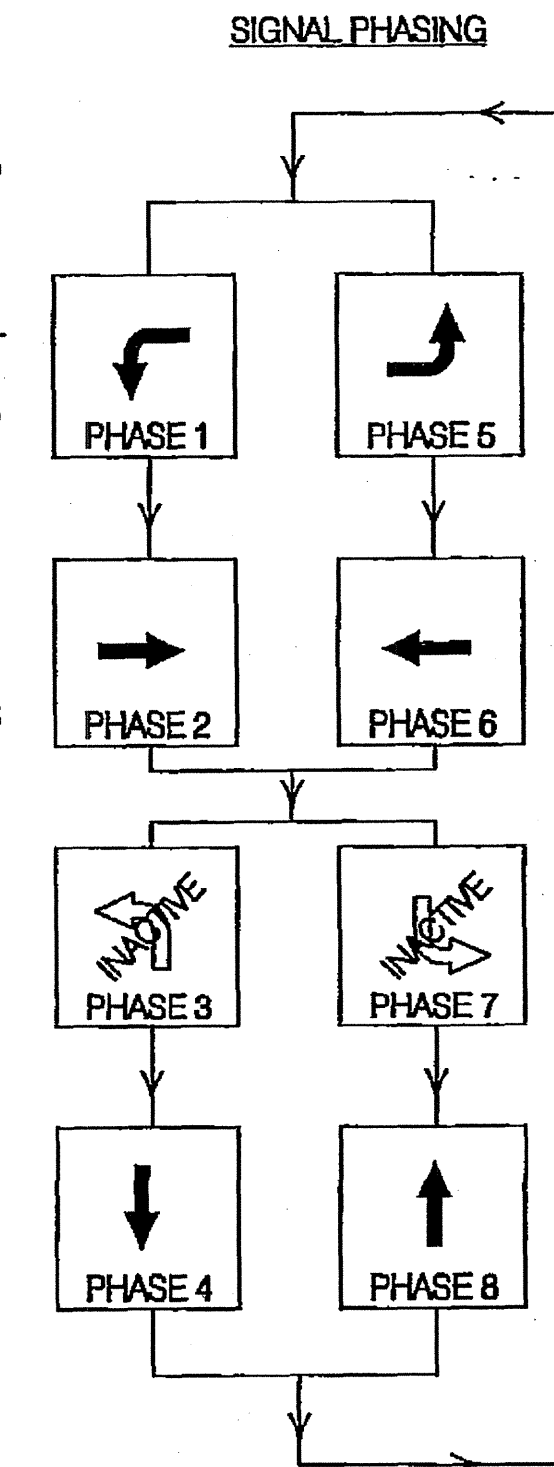


TYPICAL SIGNAL FACE
LENS ARRANGEMENTS

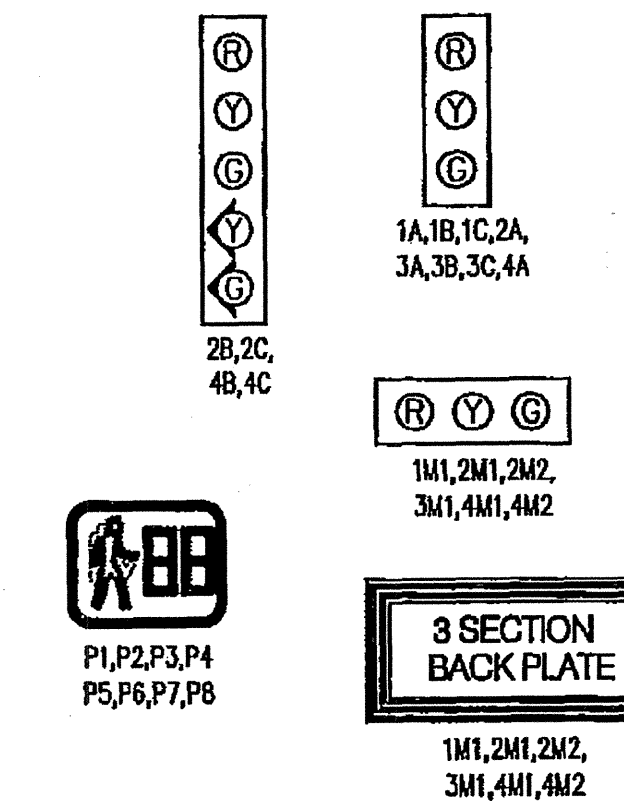

- ABBREVIATIONS
- MA1 MASTARM NUMBER
 - PP1 PEDESTAL POLE NUMBER
 - PPB1 PEDESTRIAN PUSH BUTTON NUMBER
 - CC1 CONTROL CABINET NUMBER
 - SC1 SPLICE CABINET NUMBER
 - PB1 PULL BOX NUMBER (SIGNALS)
 - PBS1 PULL BOX NUMBER (POWER)
 - 3A SIGNAL HEAD NUMBER
 - P1 PEDESTRIAN SIGNAL NUMBER
 - MH1 TRAFFIC MANHOLE NUMBER

SYMBOL KEY

- MAX SIGNAL & CABINET ID
- 1 CONDUIT RUN ID (NEW)
 - 1X CONDUIT RUN ID (EXISTING)
 - SI CONDUIT RUN ID (POWER SERVICE)

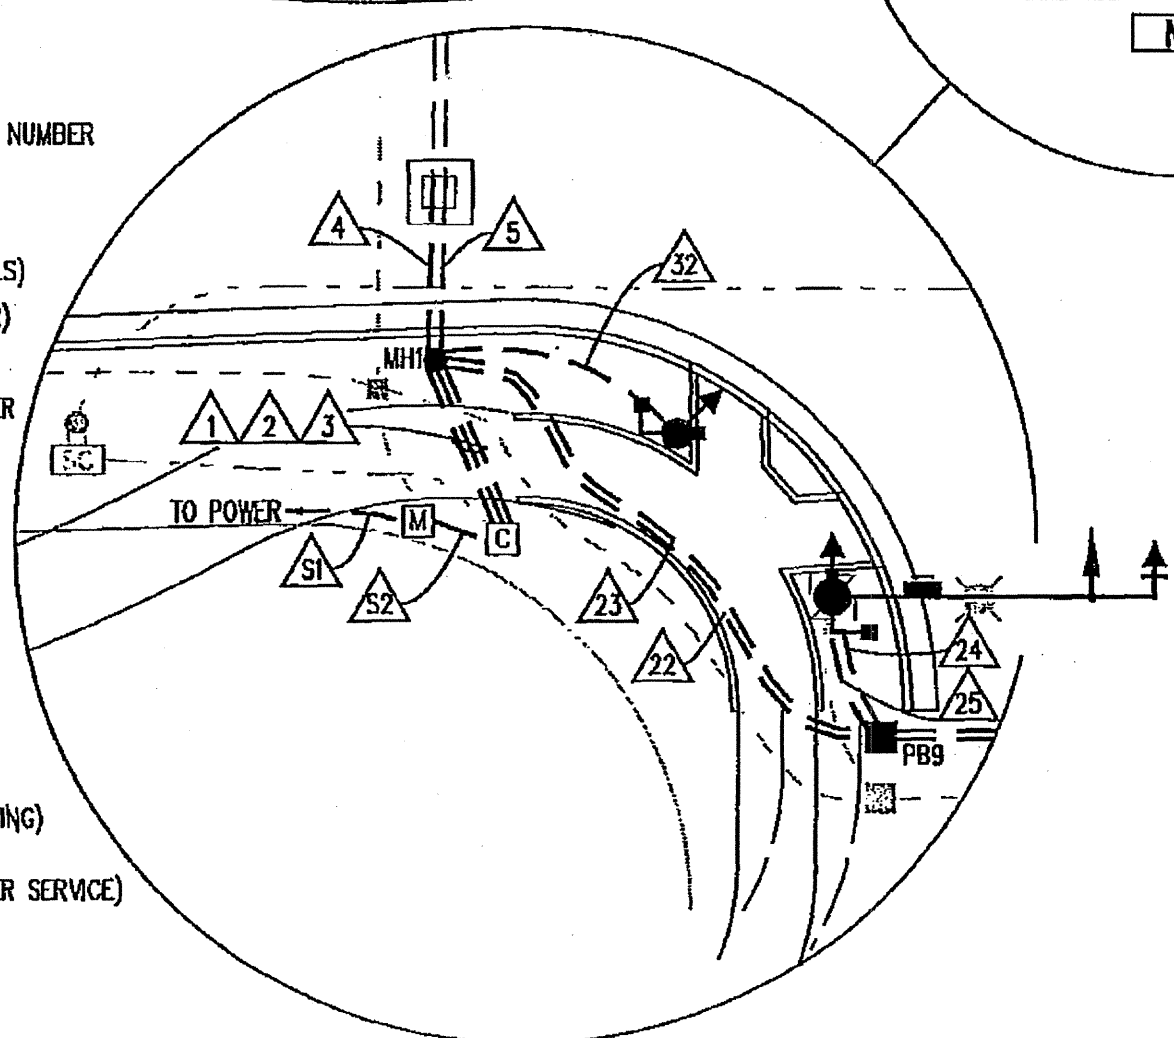

SIGNAL POLES AND MASTARMS					
ID#	TYPE	STATION	OFFSET	LUMINAIRE MOUNTING HEIGHT	LUMINAIRE ARM
MA1	MASTARM-25' TYPE III	22+08.7	90.1' RT	40'	20'
MA2	MASTARM-40' TYPE III	21+95.9	67.9' LT	40'	20'
MA3	MASTARM-25' TYPE III	22+90.6	88.9' LT	40'	20'
MA4	MASTARM-40' TYPE III	23+08.7	59.3' RT	40'	20'
PP1	PEDESTAL-15'	21+98.5	71.2' RT	-	-
PP2	PEDESTAL-15'	21+84.4	6.3' LT	-	-
PP3	PEDESTAL-15'	22+11.6	88.2' LT	-	-
PP4	PEDESTAL-15'	23+03.9	80.3' LT	-	-
PP6	PEDESTAL-15'	23+15.9	1.7' RT	-	-
PP8	PEDESTAL-15'	22+87.6	83.7' RT	-	-
CC1	CONTROLLER	22+77.7	80.6' RT	-	-

FOR INFORMATION ONLY

TO BE INSTALLED WITH CITY PROJECT NO. 730886

MARK GOODWIN & ASSOCIATES, P.A.
CONSULTING ENGINEERS
P.O. BOX 90606
ALBUQUERQUE, NEW MEXICO 87199
OFFICE (505) 828-2200, FAX (505) 797-9539

CITY OF ALBUQUERQUE
PUBLIC WORKS DEPARTMENT

TITLE: VISTA DE LA LUZ
COORS BOULEVARD IMPROVEMENTS
TRAFFIC SIGNAL PLAN-COORS/SEVILLA AVENUE


DESIGN REVIEW COMMITTEE CITY ENGINEER APPROVAL

DESIGNED BY G/K DATE 10/06
DRAWN BY RDQ DATE 10/06
CHECKED BY DMG DATE 10/06

CITY PROJECT NO. 791481 ZONE MAP NO. F-11-Z SHEET 16B OF 24

RECORD DRAWINGS
CERTIFICATE OF SUBSTANTIAL COMPLIANCE ON PLANS

I, GARY A. KRAVITZ, NMPRE 11829, of the firm MARK GOODWIN & ASSOCIATES, P.A., a Registered Professional Engineer in the State of New Mexico, do hereby certify, to the best of my knowledge and belief, that the infrastructure installed as part of this project has been inspected by me or by a qualified person under my direct supervision, and that the same has been constructed in accordance with the plans and specifications approved by the City Engineer and that the same are in accordance with the applicable laws, rules, regulations and ordinances of the City of Albuquerque, New Mexico. My information is based on the information provided by the owner and the contractor.

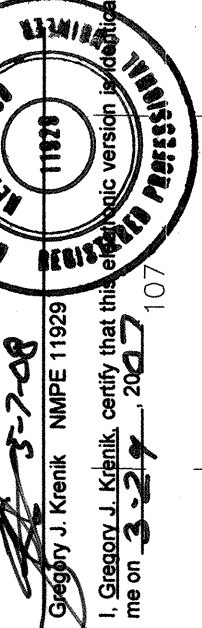

QUAKER HEIGHTS
(09-25-63, CS-182)

102 103 104 105 106 107 108 109 110

QUAKER HEIGHTS
(06-17-75, A5-140)
LOT 30A

REVISION PER CHANGE ORDER
SEE SHEET 21A

STANDARD UTILITY NOTES:

13. For stormdrain construction, RCP pipe joints shall not be grouted prior to final inspection. Final inspection will determine the joints to be grouted for final acceptance of the construction.

14. All water meter boxes adjacent to mountable curb & gutter are to have heavy duty Traffic Rated covers per City Standard Detail 2369.

RESTRAINED JOINT LENGTH FOR BENDS,
VALVES, DEAD ENDS (FT.)

PIPE SIZE	90°	45°	22.5°	11.25°	VALVE
4"	12'	5'	2'	1'	32'
6"	17'	7'	-	-	46'
8"	22'	9'	4'	2'	60'
10"	26'	11'	5'	3'	72'

LENGTH OF RESTRAINED PIPE ON EACH SIDE OF
THE BEND.

PIPE SIZE	LARGE SIDE	SMALL SIDE
10" X 8"	24'	-
8" X 6"	25'	-
6" X 4"	24'	-

RESTRAINED JOINT LENGTH FOR TEES (FT.)

PIPE SIZE	RUN	BRANCH
10"x10"x10"	15'	5'
8"x8"x8"	13'	3'
6"x6"x6"	10'	2'

LEGEND


	NEW MOUNTABLE CURB AND GUTTER
	NEW STANDARD CURB AND GUTTER
	NEW DEPRESSED MOUNTABLE CURB AND GUTTER
	LOT LINE
	RIGHT-OF-WAY LINE
	CENTERLINE
	STORM DRAIN INLET THIS PROJECT
	EXISTING STORM DRAIN INLET
	EXISTING STORM SEWER
	NEW ADDRESS
	NEW STREET LIGHT LOCATION
	NEW STORM DRAIN LINE
	NEW STORM DRAIN MANHOLE
	NEW SANITARY SEWER LINE
	NEW SANITARY SEWER MANHOLE
	EXISTING SAS
	NEW WATERLINE
	NEW WATERLINE CROSS
	NEW WATERLINE TEE
	NEW WATERLINE REDUCER
	NEW WATERLINE CAP
	NEW WATERLINE BEND
	NEW FIRE HYDRANT
	NEW GATE VALVE

STANDARD UTILITY NOTES:

- All waterline is C-900 PVC pipe and all sanitary sewer is SDR35 PVC pipe and all storm drain is RCP Class III unless noted otherwise on the plans.
- EMD's shall be installed on all waterline and sanitary sewer appurtenances as per section 170 of Standard Specifications for Public Works Construction Latest.
- All waterline services shall be 3/4" unless noted otherwise on plans.
- All Gate Valve per Std Dwg 2326 and 2328.
- Manholes Type "C" per Std Dwg 2101.
- Manholes Type "E" per Std Dwg 2102.
- Water services per Std Dwg 2362 and 2368 (for 3/4" and 1" services) and Std Dwg 2363 and 2367 (for 1-1/2" and 2" services).
- SAS services into main line per Std Dwg 2125.
- SAS services into manholes per Std Dwg 2118.
- Steps shall not be installed in sanitary sewer manholes.
- All Excavation, trenching and shoring activities must be carried out in accordance with OSHA 29 CFR 1926.650 Subpart P.
- All stormdrain inlets per Std. DWG's 2201, 2202, 2203, 2205, 2206, 2207, 2215, and 2217.

VALVE SHUT-OFF PLAN

- CONTRACTOR WILL CONTACT WATER SYSTEMS AT 857-8200, SEVEN (7) DAYS PRIOR TO NECESSARY SHUT-OFF.
- VALVES SHALL ONLY BE OPERATED BY CITY WATER EMPLOYEES SEE THIS SHEET FOR VALVE NUMBERS & LOCATIONS.
- FOR NON-PRESSURE CONNECTION AT EXIST. 10" STUBS VALVES A & B SHOULD BE SHUT ALREADY, BUT VERIFY.

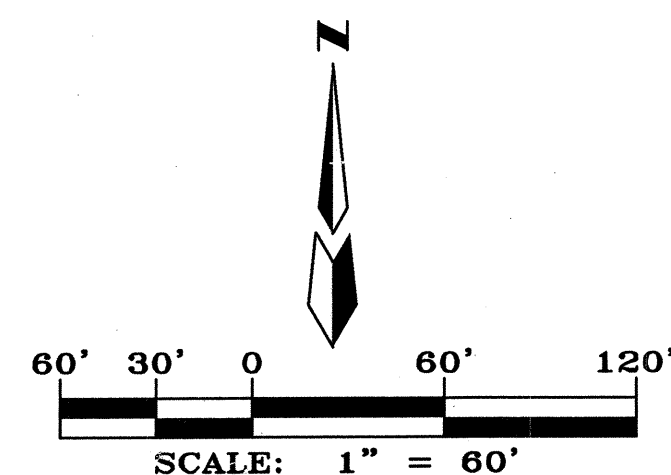


MARK GOODWIN & ASSOCIATES, P.A.
CONSULTING ENGINEERS
P.O. BOX 90606
ALBUQUERQUE, NEW MEXICO 87199
OFFICE (505) 828-2200, FAX (505) 797-9539



CITY OF ALBUQUERQUE
PUBLIC WORKS DEPARTMENT

TITLE: **VISTA DE LA LUZ
MASTER UTILITY PLAN & DETAILS
UTILITY IMPROVEMENTS**

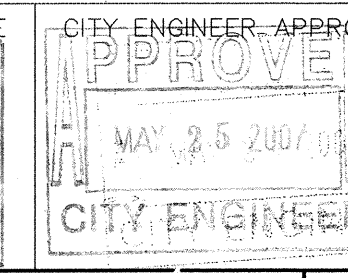

CITY PROJECT NO.


791481



ZONE MAP NO.

F-11-Z

SHEET


17 OF 24

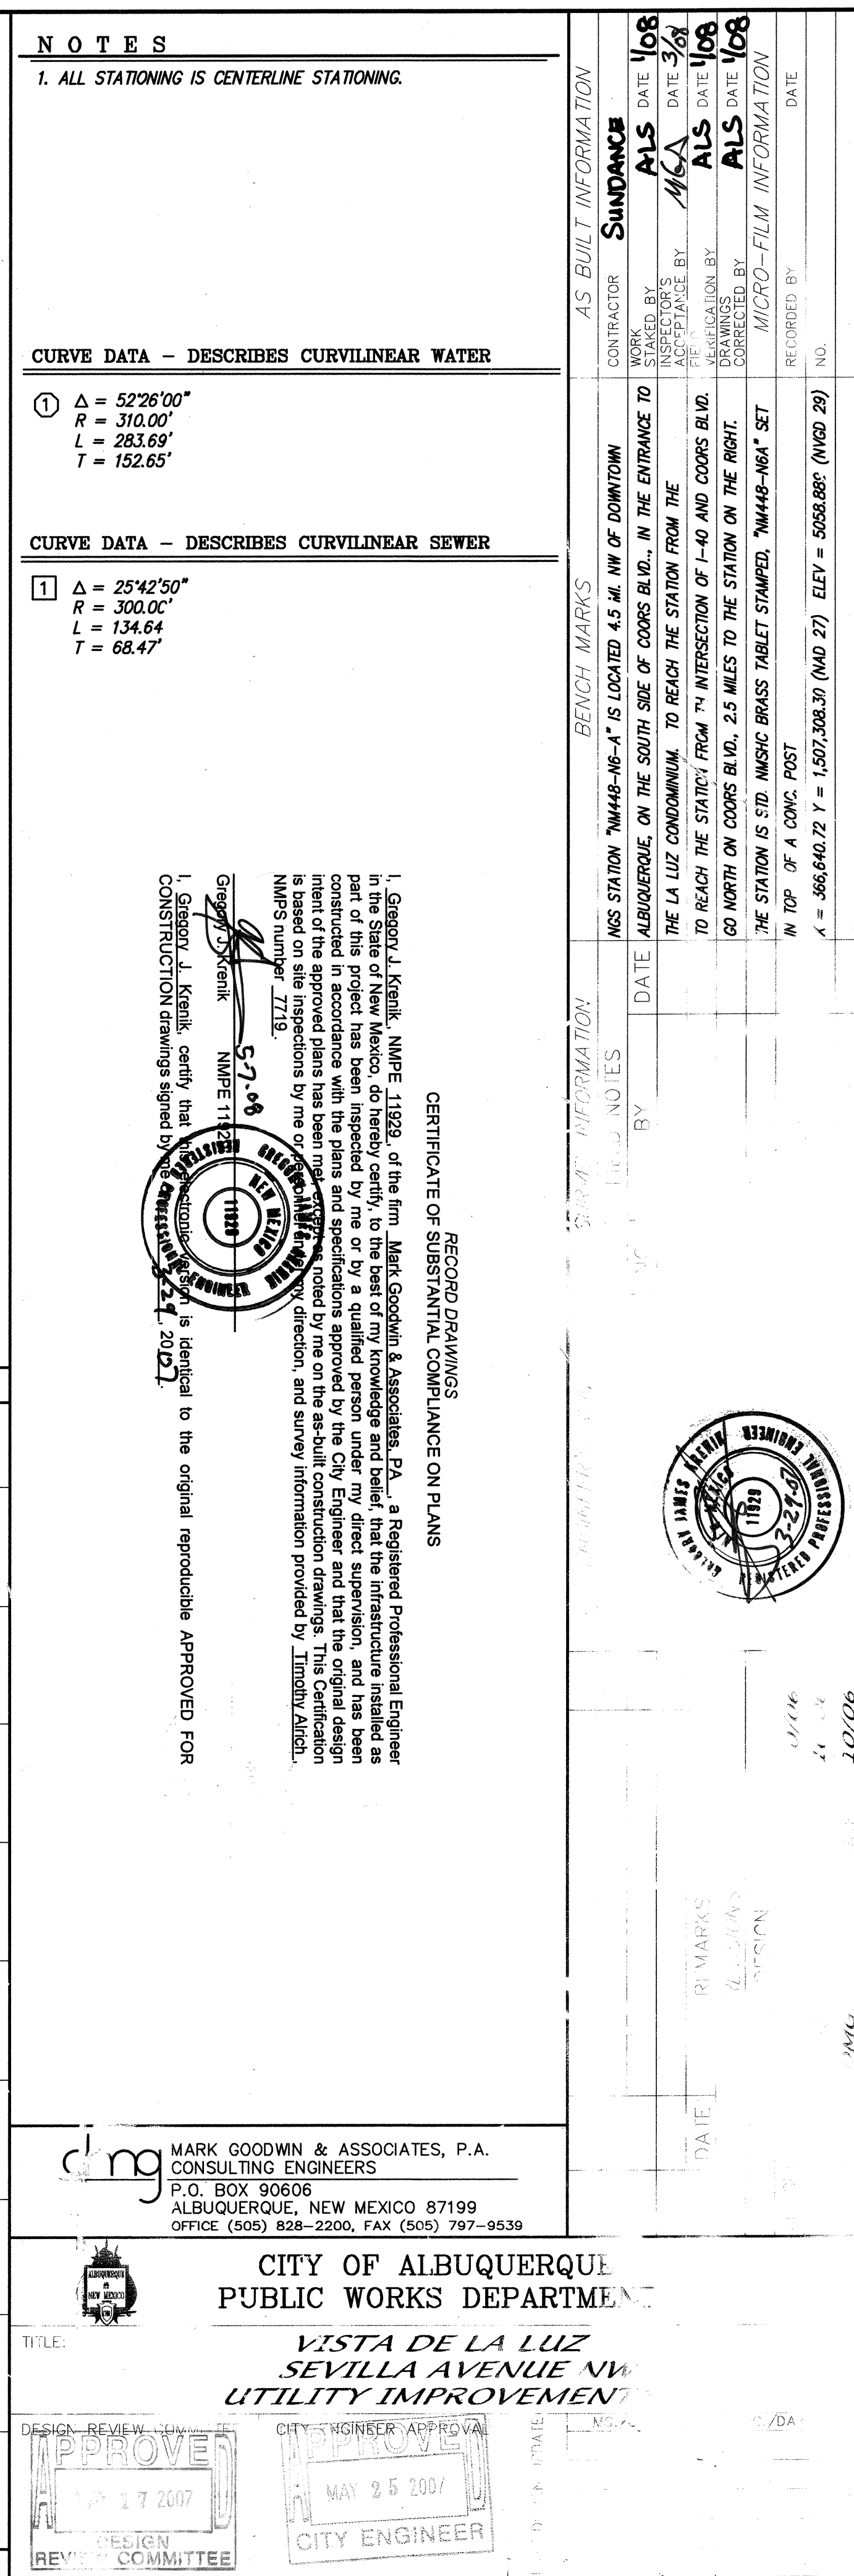

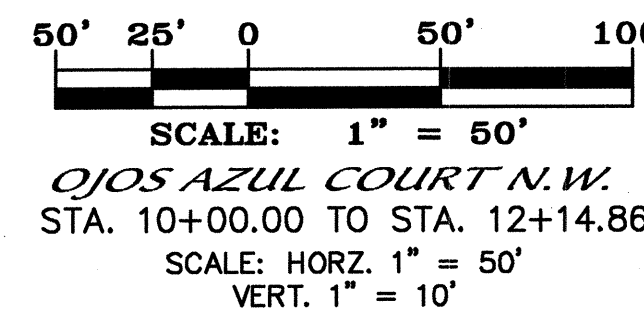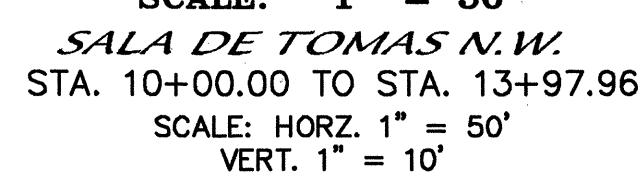

SANITARY SEWER SERVICES				
BLOCK	LOT	STATION AT PUE	INV. ELEV. AT PUE	LENGTH AT PUE
A	22-P1	134-75.33	5092.84	50.00'
A	23-P1	134-42.33	5091.85	34.00'
A	24-P1	134-12.33	5090.65	34.00'
A	25-P1	12-82.33	5089.45	34.00'
A	26-P1	12-52.33	5088.25	34.00'
A	27-P1	11-45.33	5087.15	34.00'
A	28-P1	11-15.33	5086.35	34.00'
A	29-P1	10-85.33	5087.50	34.00'
A	30-P1	10-55.33	5087.65	34.00'
A	31-P1	10-12.00	5088.05	60.00'
A	32-P1	10-09.00	5088.28	60.00'
A	33-P1	10-60.33	5087.36	34.00'
A	34-P1	10-90.33	5087.47	34.00'
A	35-P1	11-20.33	5087.33	34.00'
A	36-P1	11-55.33	5087.06	34.00'
A	37-P1	12-42.33	5087.88	34.00'
A	38-P1	13-07.33	5088.25	34.00'
A	39-P1	13-07.33	5090.45	34.00'
A	40-P1	134-37.33	5091.65	34.00'
A	41-P1	134-72.33	5092.90	50.00'
A	62-P1	11-70.19	5081.32	62.91'
A	63-P1	11-40.19	5079.03	43.00'
A	64-P1	11-13.41	5077.56	34.00'
A	65-P1	10-47.32	5075.63	34.00'
A	66-P1	10-42.47	5074.02	34.00'
A	67-P1	10-55.89	5070.60	34.00'
A	68-P1	11-07.33	5070.22	34.00'
A	69-P1	11-37.19	5078.86	34.00'
A	70-P1	11-67.19	5080.52	42.41'
A	71-P1	11-97.19	5081.75	43.51'
A	72-P1	12-32.19	5083.57	24.15'


SURVEY INFORMATION			BENCH MARKS		AS BUILT INFORMATION	
NO.	BY	FIELD NOTES			CONTRACTOR	
			NWS STATION "M448-N6-A" IS LOCATED 4.5 MI. NW OF DOWNTOWN		WORK STARTED BY	SUNDANCE
			ALBUQUERQUE ON THE SOUTH SIDE OF COORS BLD., IN THE ENTRANCE TO		INSPECTOR'S DATE	1/6/8
			THE LA LUZ CONDOMINIUM. TO REACH THE STATION FROM THE		FIELD VERIFICATION BY	ALS
			TO REACH THE STATION FROM TH INTERSECTION OF I-40 AND COORS BLD.		DATE CORRECTED BY	1/6/8
			GO NORTH ON COORS BLD., 2.5 MILES TO THE STATION ON THE RIGHT.		DATE	1/6/8
			THE STATION IS STD. MUSIC BRASS TABLET STAMPED, "M448-N6A" SET		MICRO-FILM INFORMATION	
			IN TOP OF A CONC. POST		RECORDED BY	DATE
			X = 366,640.72 Y = 1,507,308.30 (NAD 27) ELEV = 5058.889 (NVD 29)		NO.	

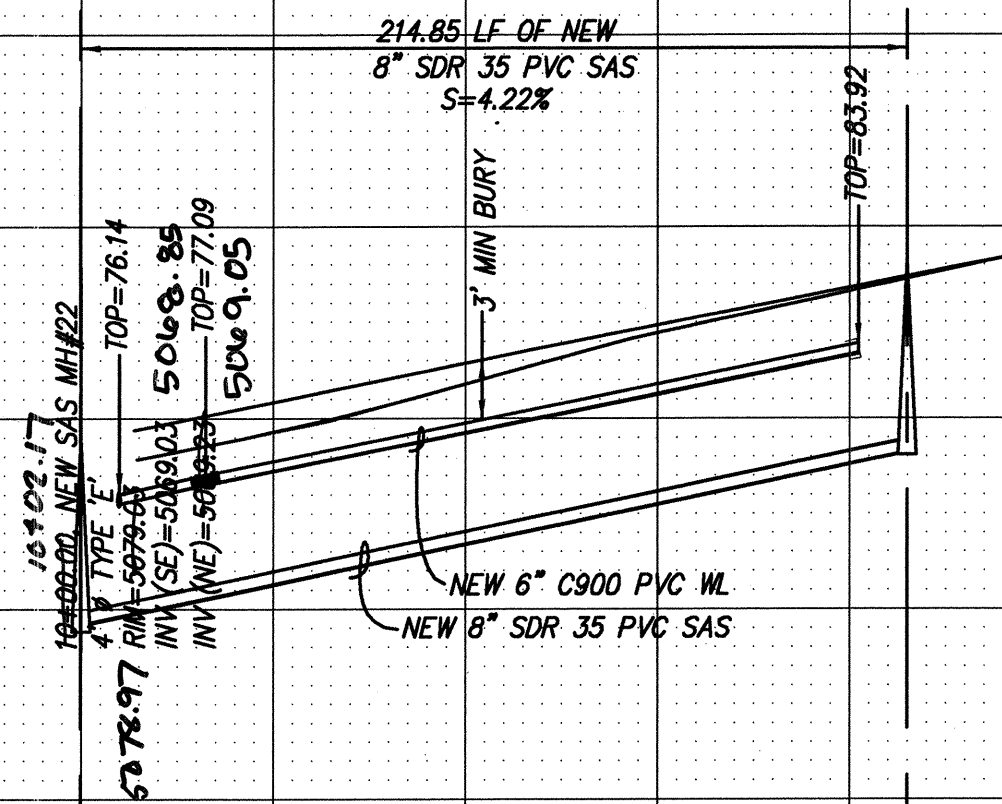

ENGINEER'S SEAL		RECORD DRAWINGS		DESIGN		REVISIONS		DESIGNED BY		DRAWN BY		CHECKED BY	
		CERTIFICATE OF SUBSTANTIAL COMPLIANCE ON PLANS		DATE		DATE		DATE		DATE		DATE	
ENGINEER'S SEAL		RECORD DRAWINGS		DATE		DATE		DATE		DATE		DATE	
ENGINEER'S SEAL		RECORD DRAWINGS		DATE		DATE		DATE		DATE		DATE	
ENGINEER'S SEAL		RECORD DRAWINGS		DATE		DATE		DATE		DATE			

NOTES		FILM INFORMATION	
1. ALL STATIONING IS CENTERLINE STATIONING, UNLESS OTHERWISE NOTED.		UNDANCE	DATE 108
2. SD INLETS # 1 & 1A ARE TO BE FORMED WITHOUT COMMON SEPERATION WALL.		AJS	DATE 2-68
		MCA	DATE 108
		AJS	DATE 108
		AJS	DATE 108
		FILM INFORMATION	DATE

E MAREMA DR.
T
3-28-68

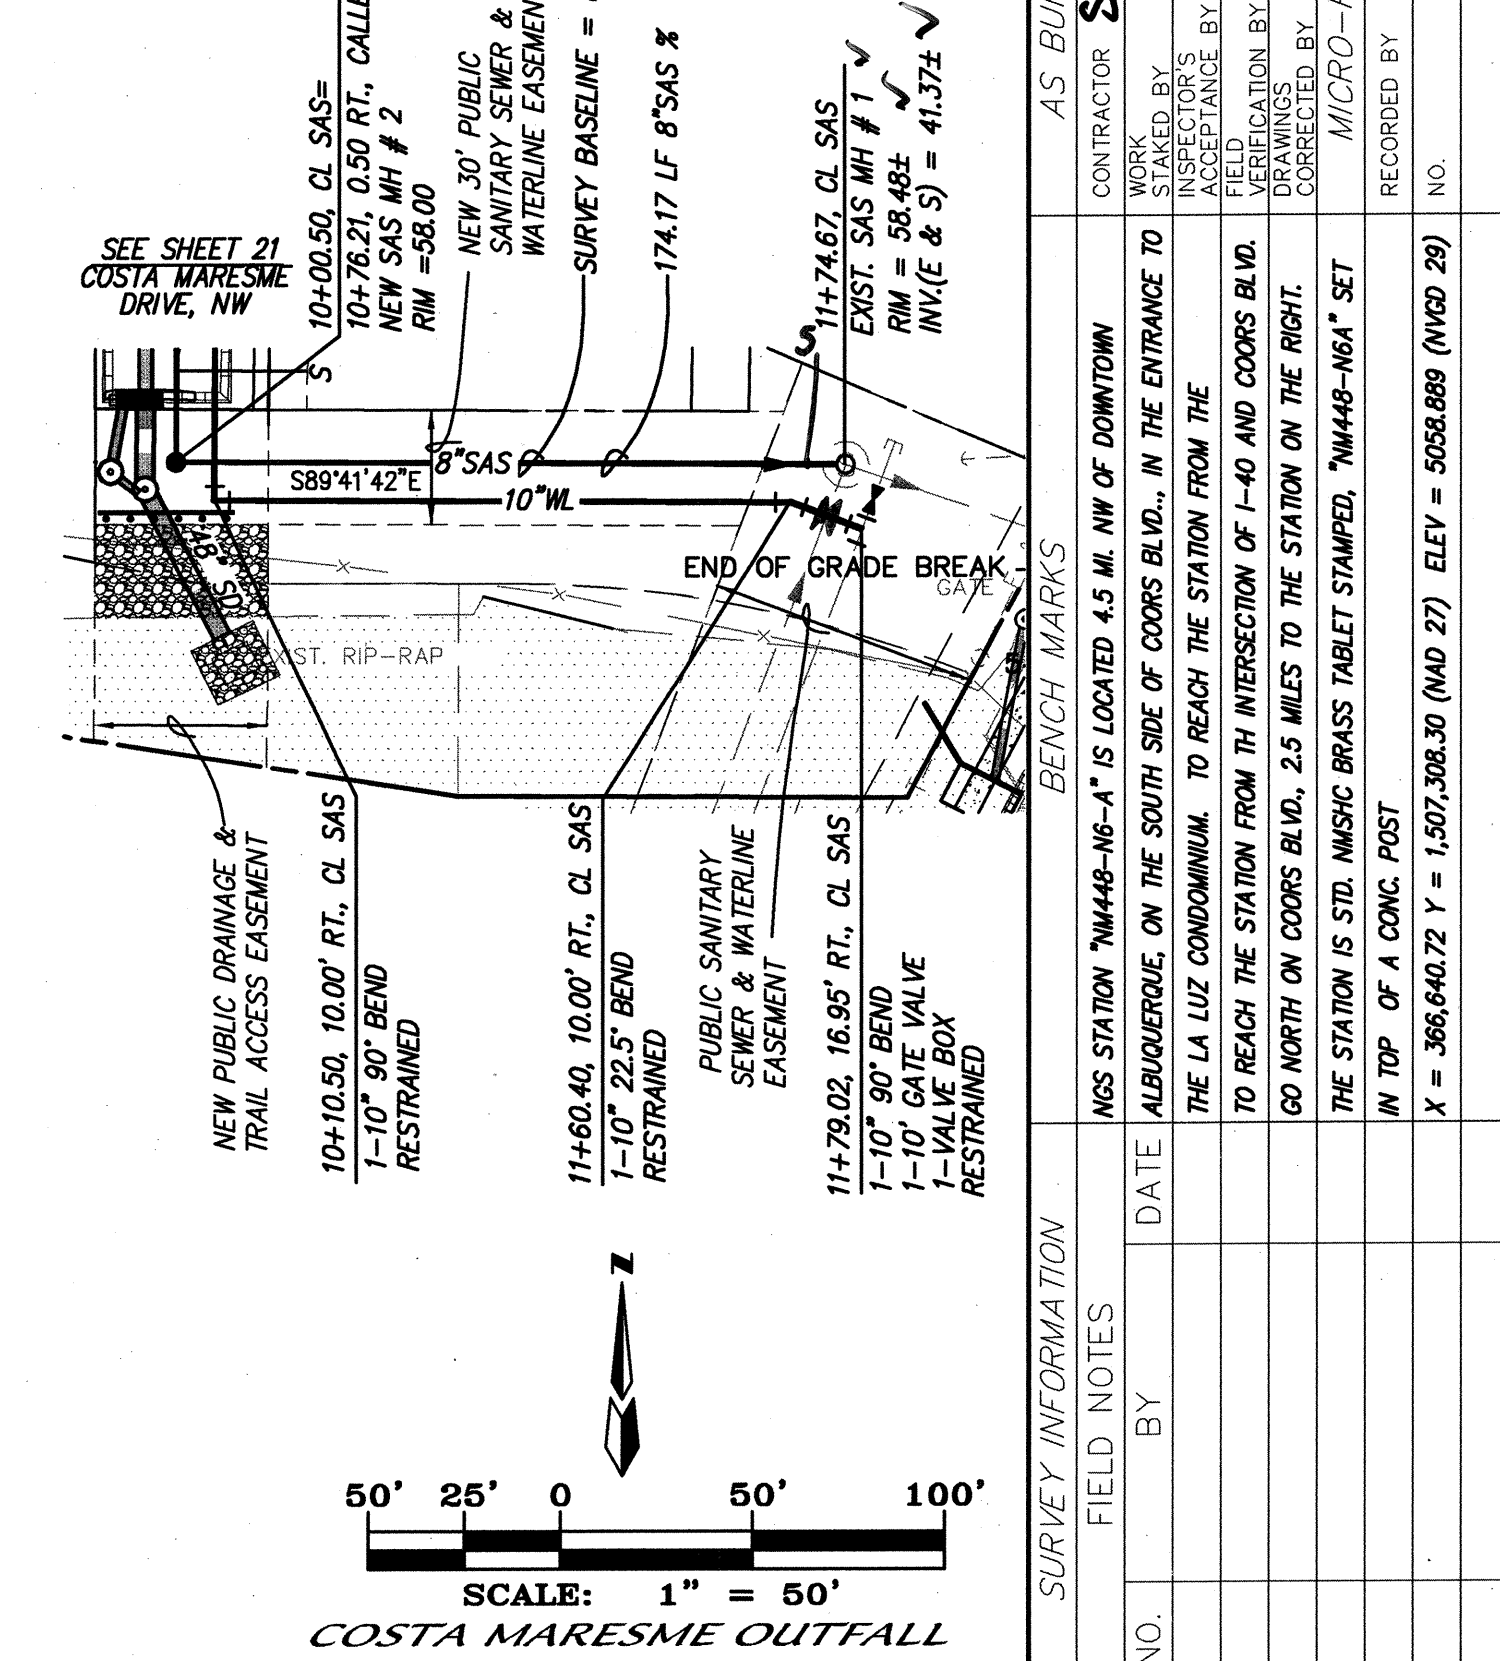

COSTA MARESME DRIVE N.W.
STA. 10+00.00 TO STA. 21+11.92
SCALE: HORZ. 1" = 50'
VERT. 1" = 10'

SCALE: 1" = 50'
COSTA MARESME OUTFALL
 STA. 10+00.00 TO STA. 11+74.67
 SCALE: HORZ. 1" = 50'
 VERT. 1" = 10'

174.17 LF OF NEW
8" SDR 35 PVC SAS
S=3.62%

TOP=-54.00

TOP=-53.50

TOP=-53.40±

NEW 10" C900 PVC WL

NEW 8" SDR 35 PVC SAS

10+00.50, NEW SAS MH#2
4" TYPE I
INV (E)=-504.800
INV (N)=-504.820

11+74.67, EX SAS MH, #1
EX RM = 5059.85±
EX. INV. = 5041.37±
INV.(H) = 5041.70 ±

5070

5060

5050

5040


11+00

12+00

ENGINEER'S SEAL

NO.	DATE	REMARKS	BY
REVISIONS			
DESIGN			
DESIGNED BY	G/K	DATE	10/06
DRAWN BY	RDQ	DATE	10/06
CHECKED BY	DMG	DATE	10/06


MARK GOODWIN & ASSOCIATES, P.A.
 CONSULTING ENGINEERS
 P.O. BOX 90606
 ALBUQUERQUE, NEW MEXICO 87199
 OFFICE (505) 828-2200, FAX (505) 797-9539

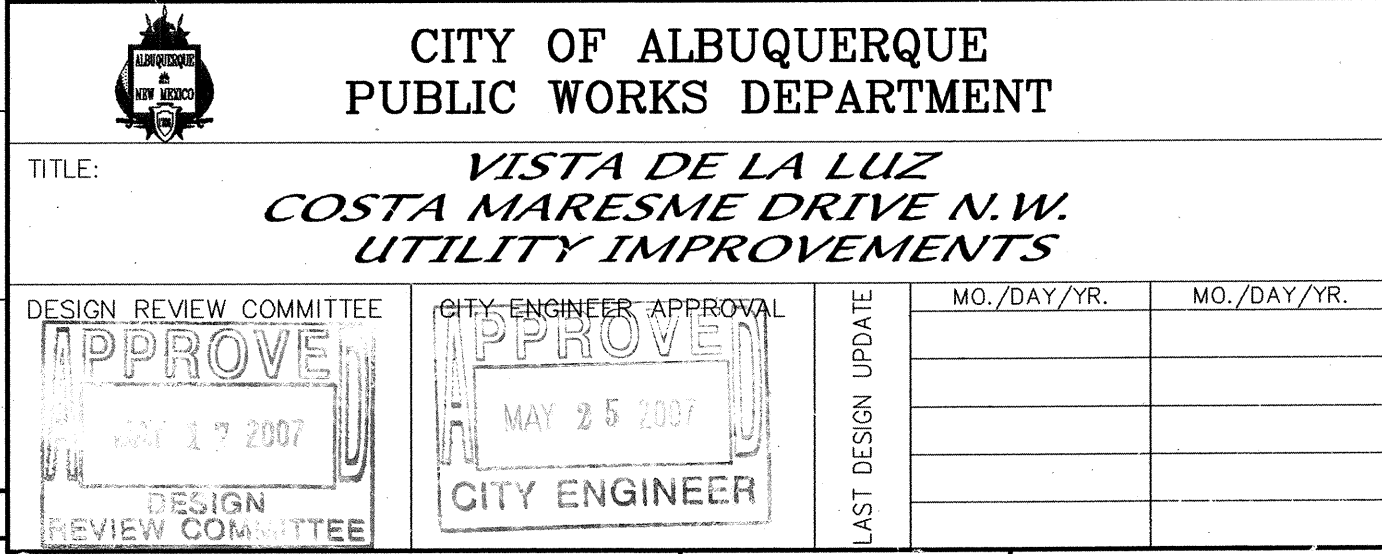

RECORD DRAWINGS
CERTIFICATE OF SUBSTANTIAL COMPLIANCE ON PLANS

I, Gregory J. Krenik, NMPE 11929, of the firm Mark Goodwin & Associates, P.A., a Registered Professional Engineer in the State of New Mexico, do hereby certify, to the best of my knowledge and belief, that the infrastructure installed as part of this project has been inspected by me or by a qualified person under my direct supervision, and has been constructed in accordance with the plans and specifications approved by the City Engineer and that the original design intent of the approved plans has been met, except as noted by me on the as-built construction drawings. This Certification is based on site inspections by me or personnel under my supervision, and any information provided by Timothy Aldrich, NMPS number 7719.

I, Gregory J. Krenik, certify that the electronic version is identical to the original reproducible APPROVED FOR CONSTRUCTION. This document is signed by me on 3-29-2007.

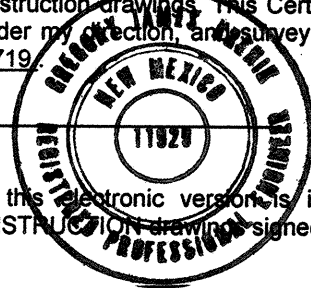

NOTES

1. ALL STATIONING IS CENTERLINE STATIONING.

CURVE DATA - DESCRIBES CURVILINEAR WATER

① $\Delta = 59^{\circ}06'56''$
 $R = 310.00'$
 $L = 319.85'$
 $T = 175.80'$




② $\Delta = 38^{\circ}59'13''$
 $R = 265.00'$
 $L = 180.32'$
 $T = 93.81'$

CURVE DATA - DESCRIBES CURVILINEAR SEWER

① $\Delta = 22^{\circ}26'12''$
 $R = 300.00'$
 $L = 117.48'$
 $T = 59.50'$

② $\Delta = 34^{\circ}51'32''$
 $R = 300.00'$
 $L = 185.52'$
 $T = 94.18'$

③ $\Delta = 40^{\circ}46'21''$
 $R = 275.00'$
 $L = 195.69'$
 $T = 102.20'$

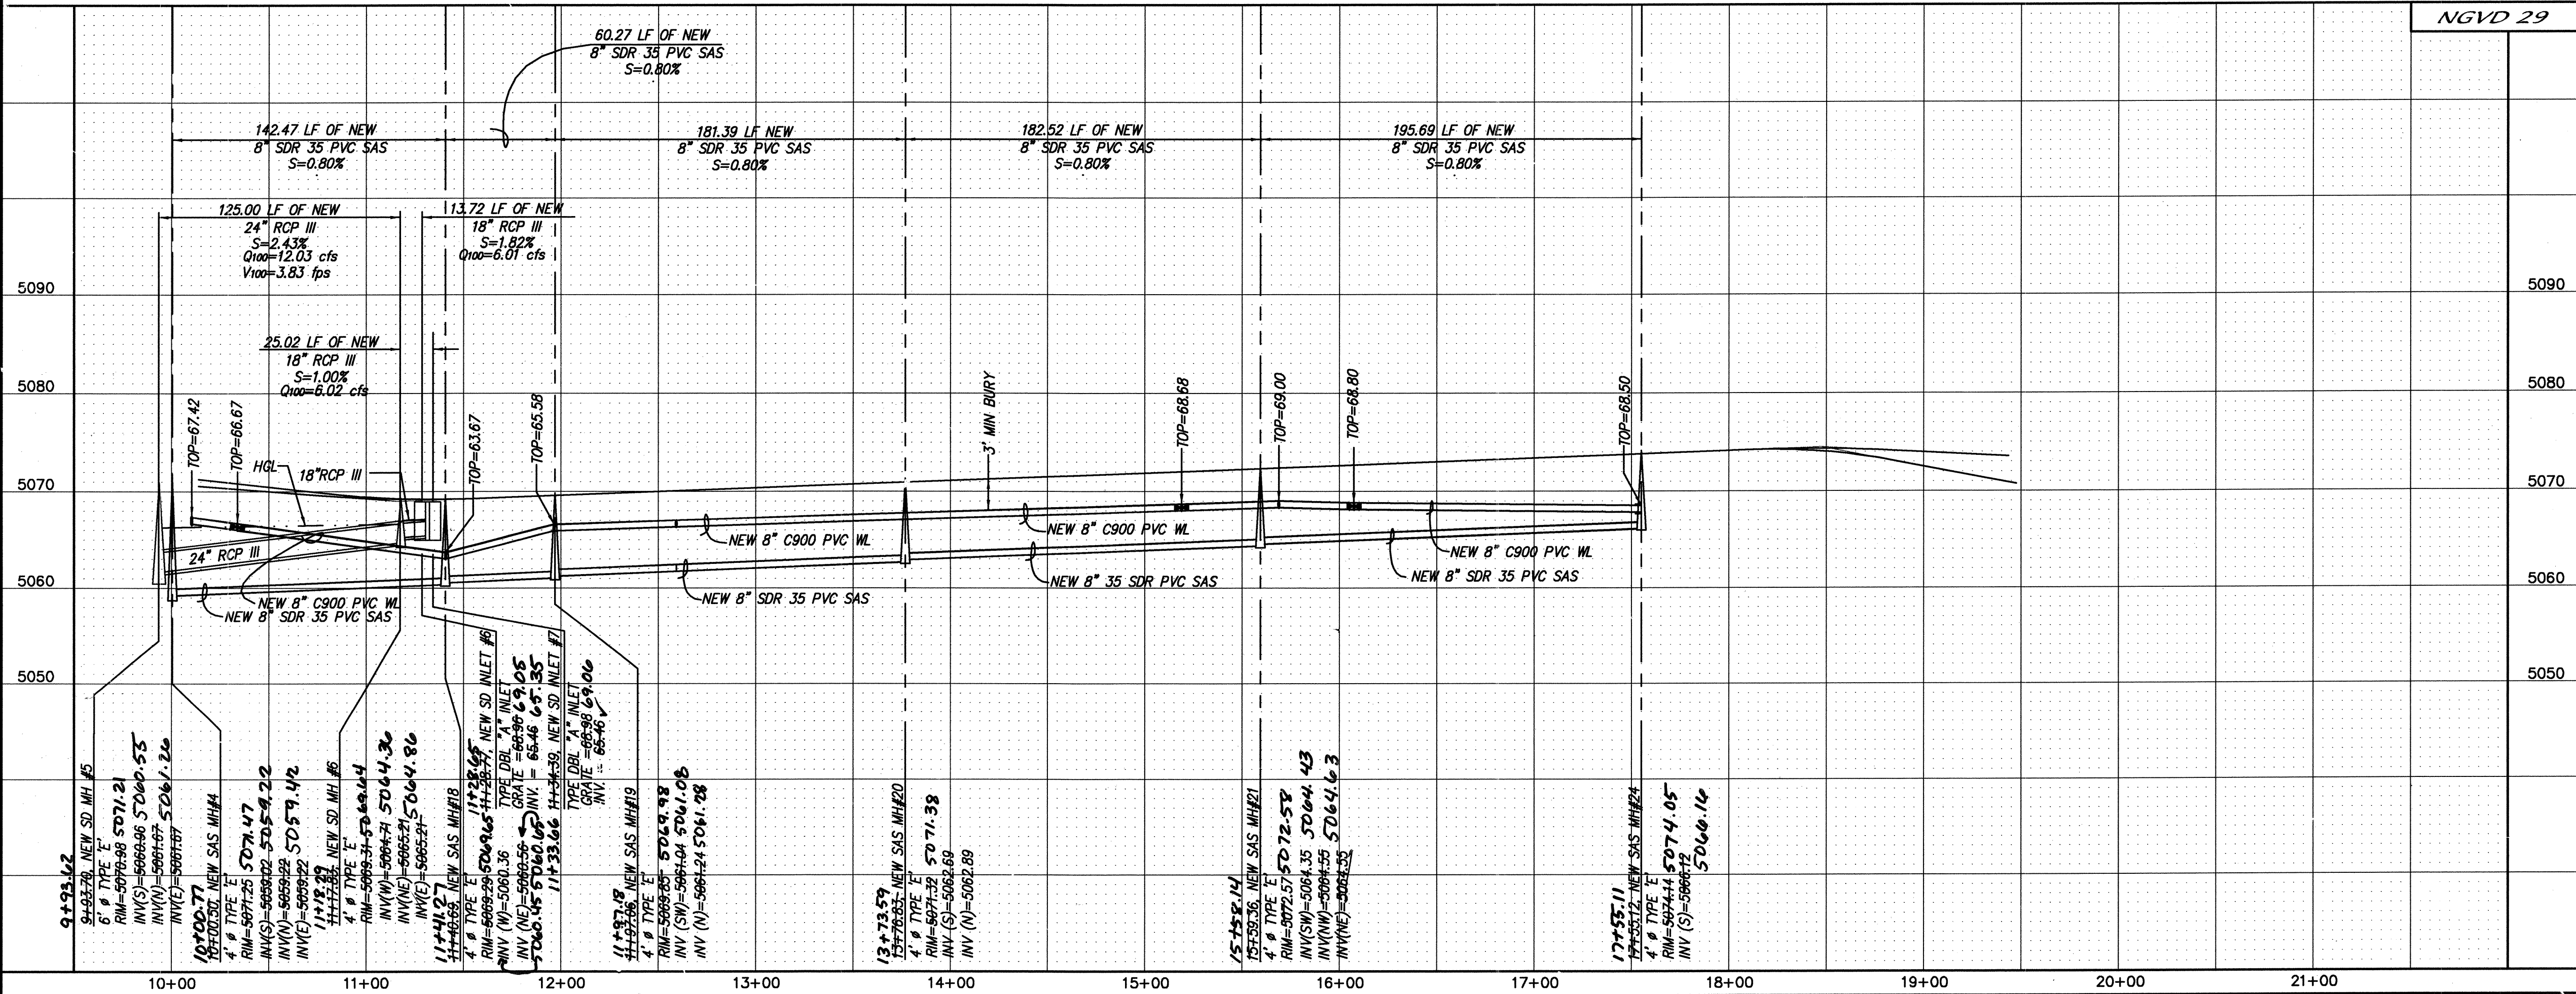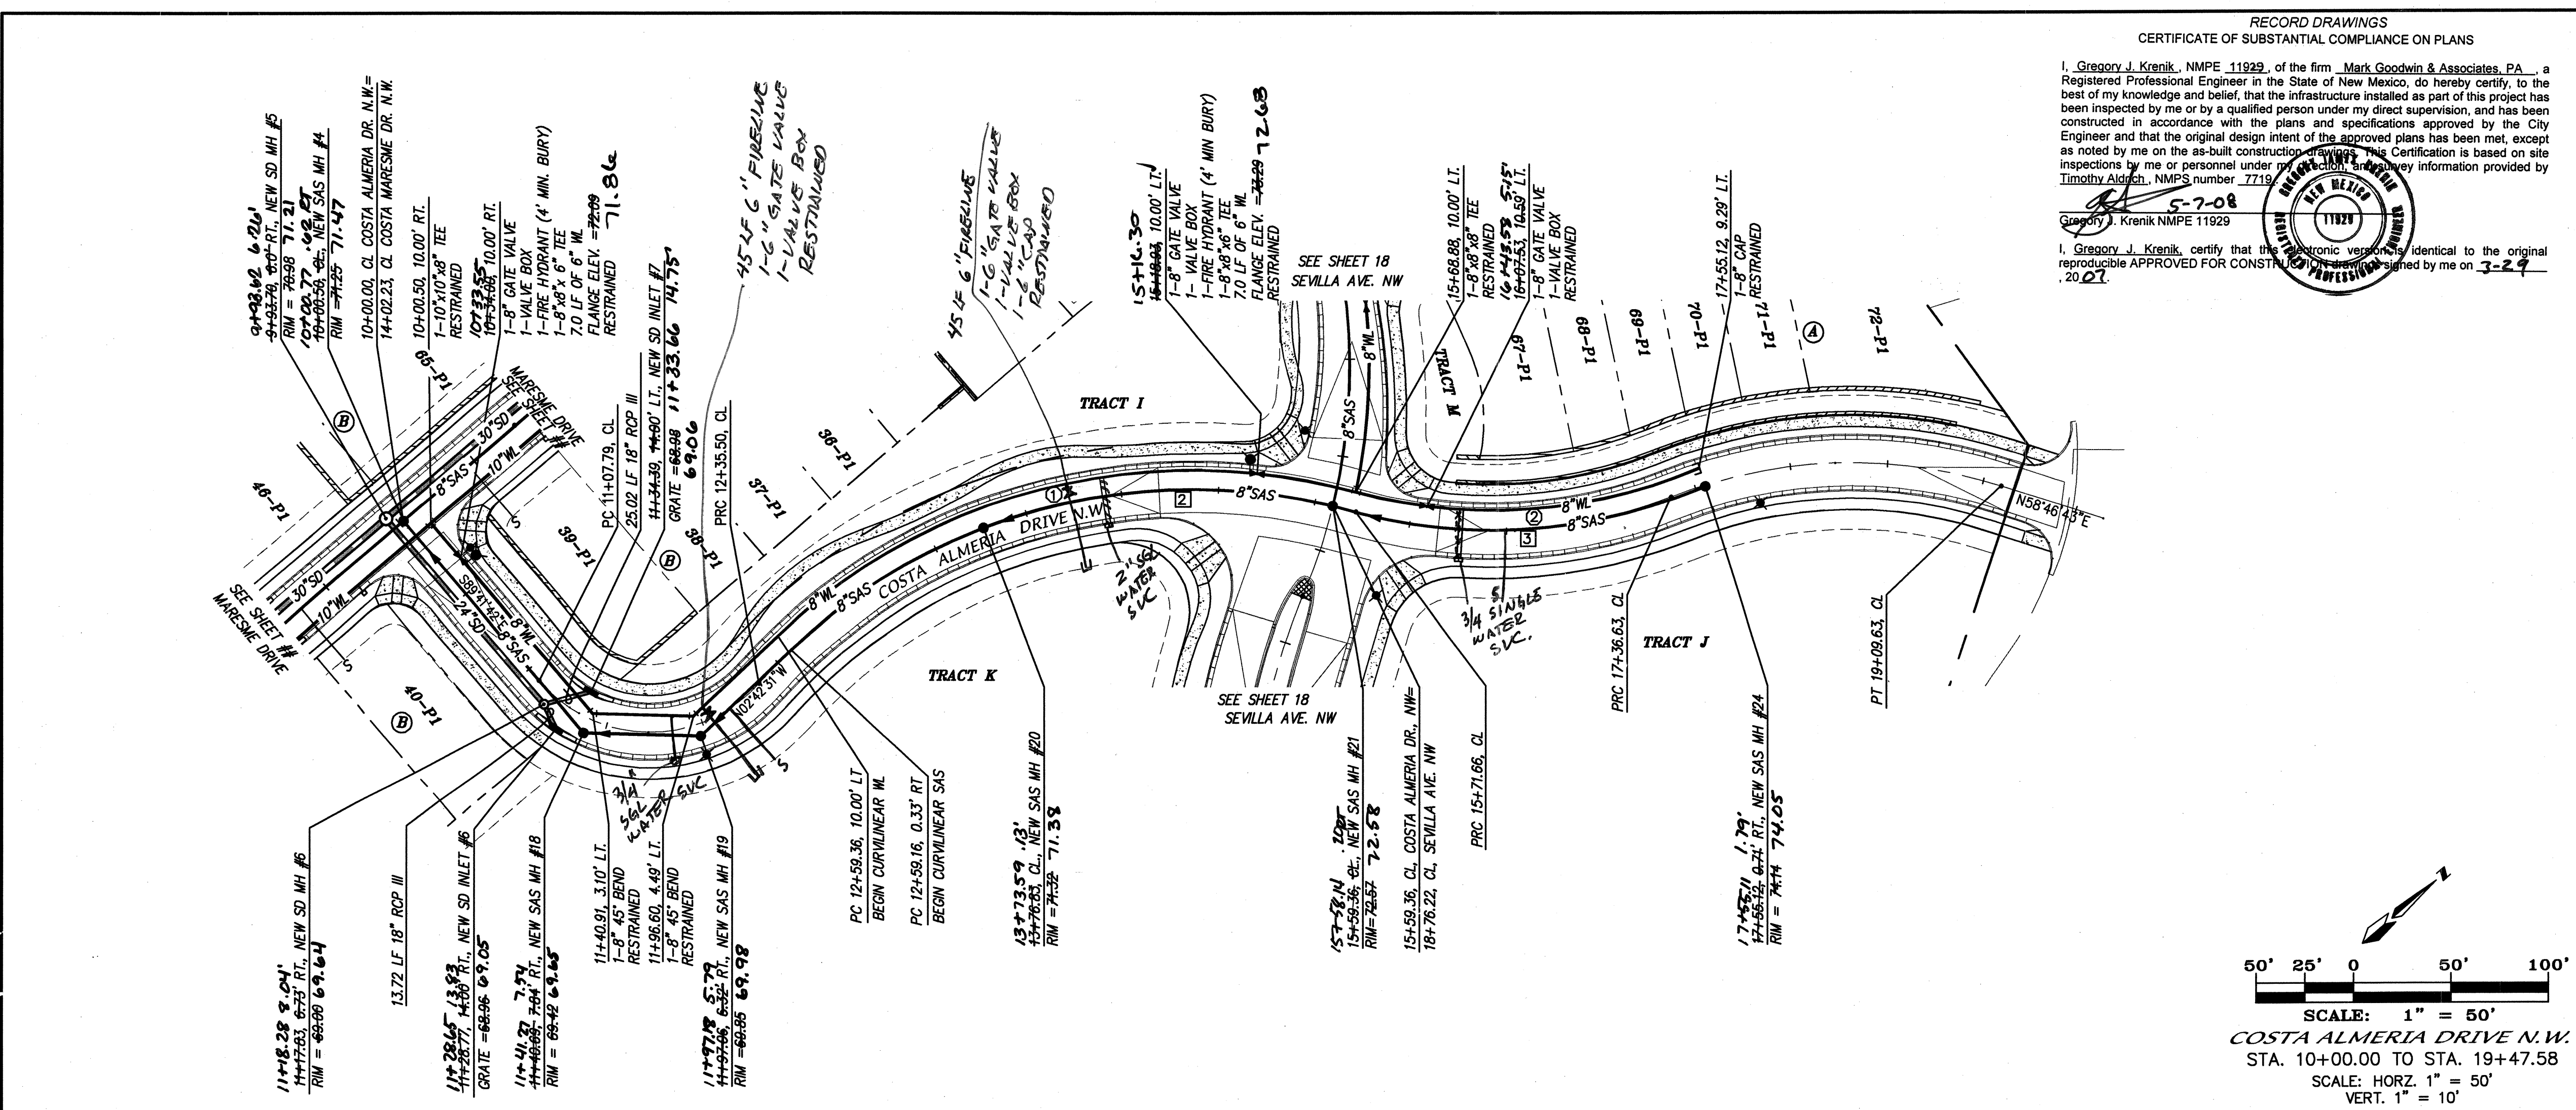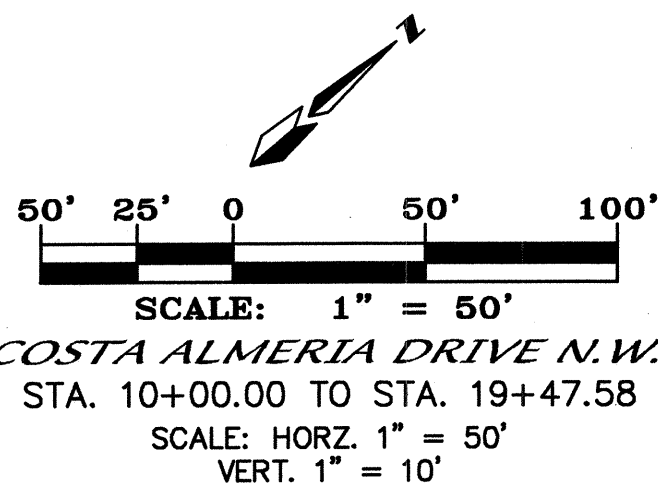

AS-BUILT INFORMATION		BENCH MARKS		SURVEY INFORMATION		ENGINEER'S SEAL	
CONTRACTOR	DATE	INS STATION	DATE	FIELD NOTES	NO.		REMARKS
WORKED BY	DATE	THE LA LUZ CONDOMINIUM	DATE	BY	BY		
INSPECTED BY	DATE	TO REACH THE STATION FROM THE	DATE	NO.	NO.		
ACCEPTANCE BY	DATE	TO REACH THE STATION FROM THE	DATE	DATE	DATE		
DRAWINGS BY		DRAWINGS BY		DESIGNED BY		DESIGNED BY	
MICRO-FILM INFORMATION		MICRO-FILM INFORMATION		DRAWN BY		DRAWN BY	
RECORDED BY		RECORDED BY		CHECKED BY		CHECKED BY	
NO.		NO.		NO.		NO.	

CITY OF ALBUQUERQUE
PUBLIC WORKS DEPARTMENT

TITLE: VISTA DE LA LUZ
COSTA ALMERIA DRIVE N.W.
UTILITY IMPROVEMENTS

DESIGN REVIEW COMMITTEE
APPROVED
MAY 17 2007




CITY ENGINEER
APPROVED
MAY 25 2007

LAST DESIGN UPDATE


CITY PROJECT NO. 791481

ZONE MAP NO. F-11-Z

SHEET 22 OF 24

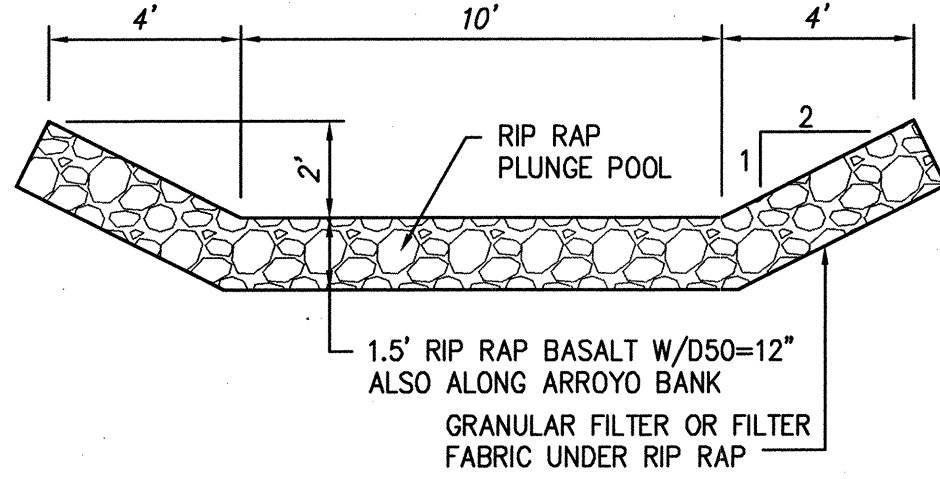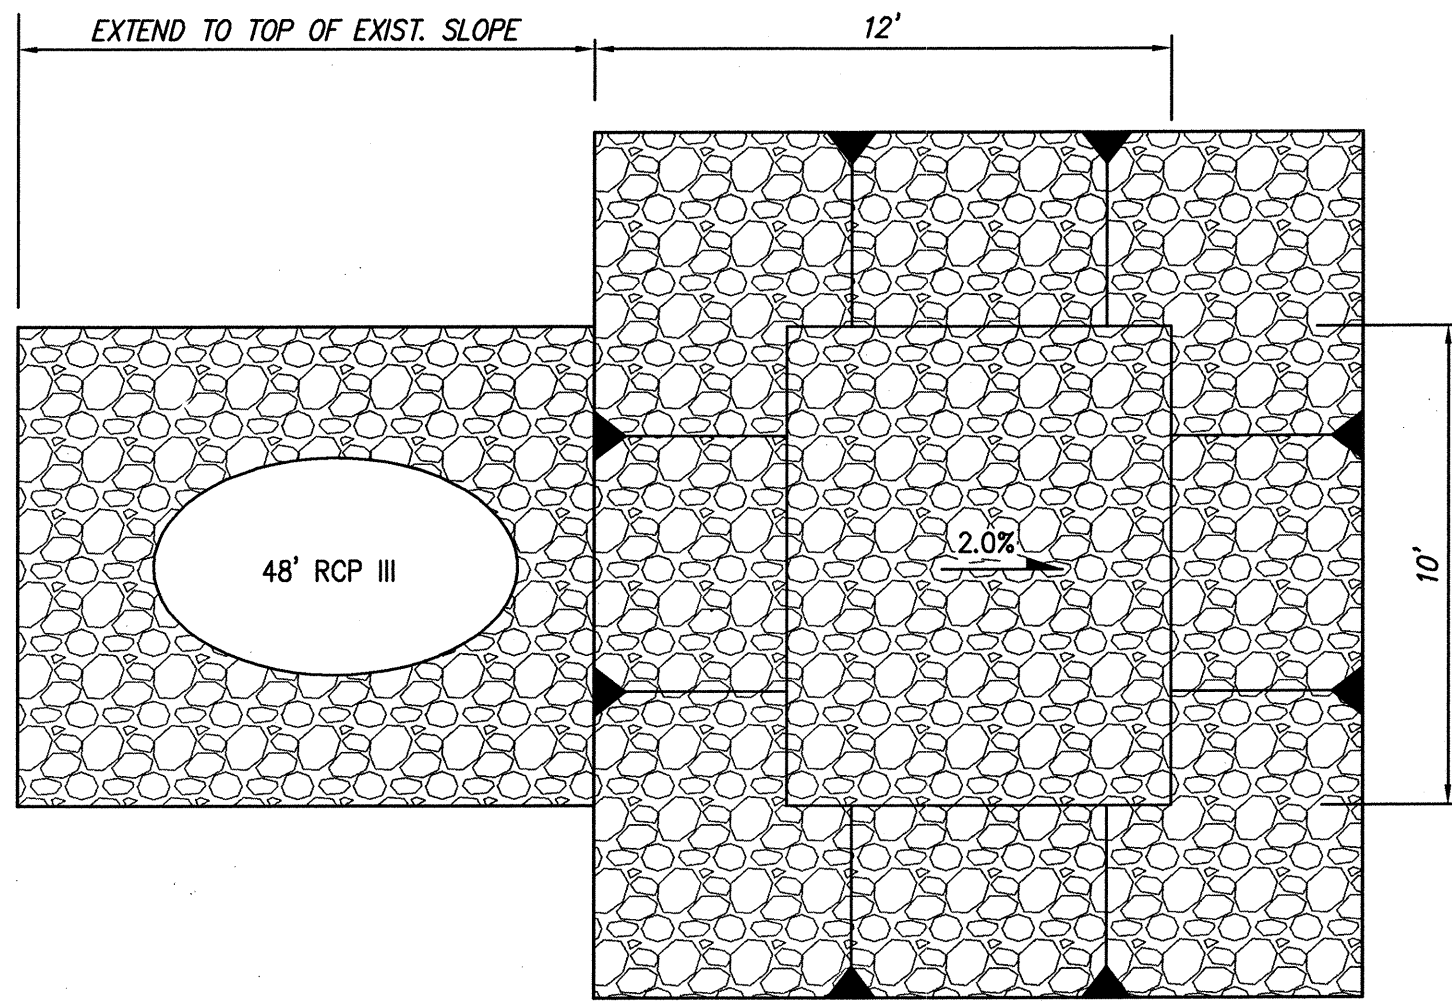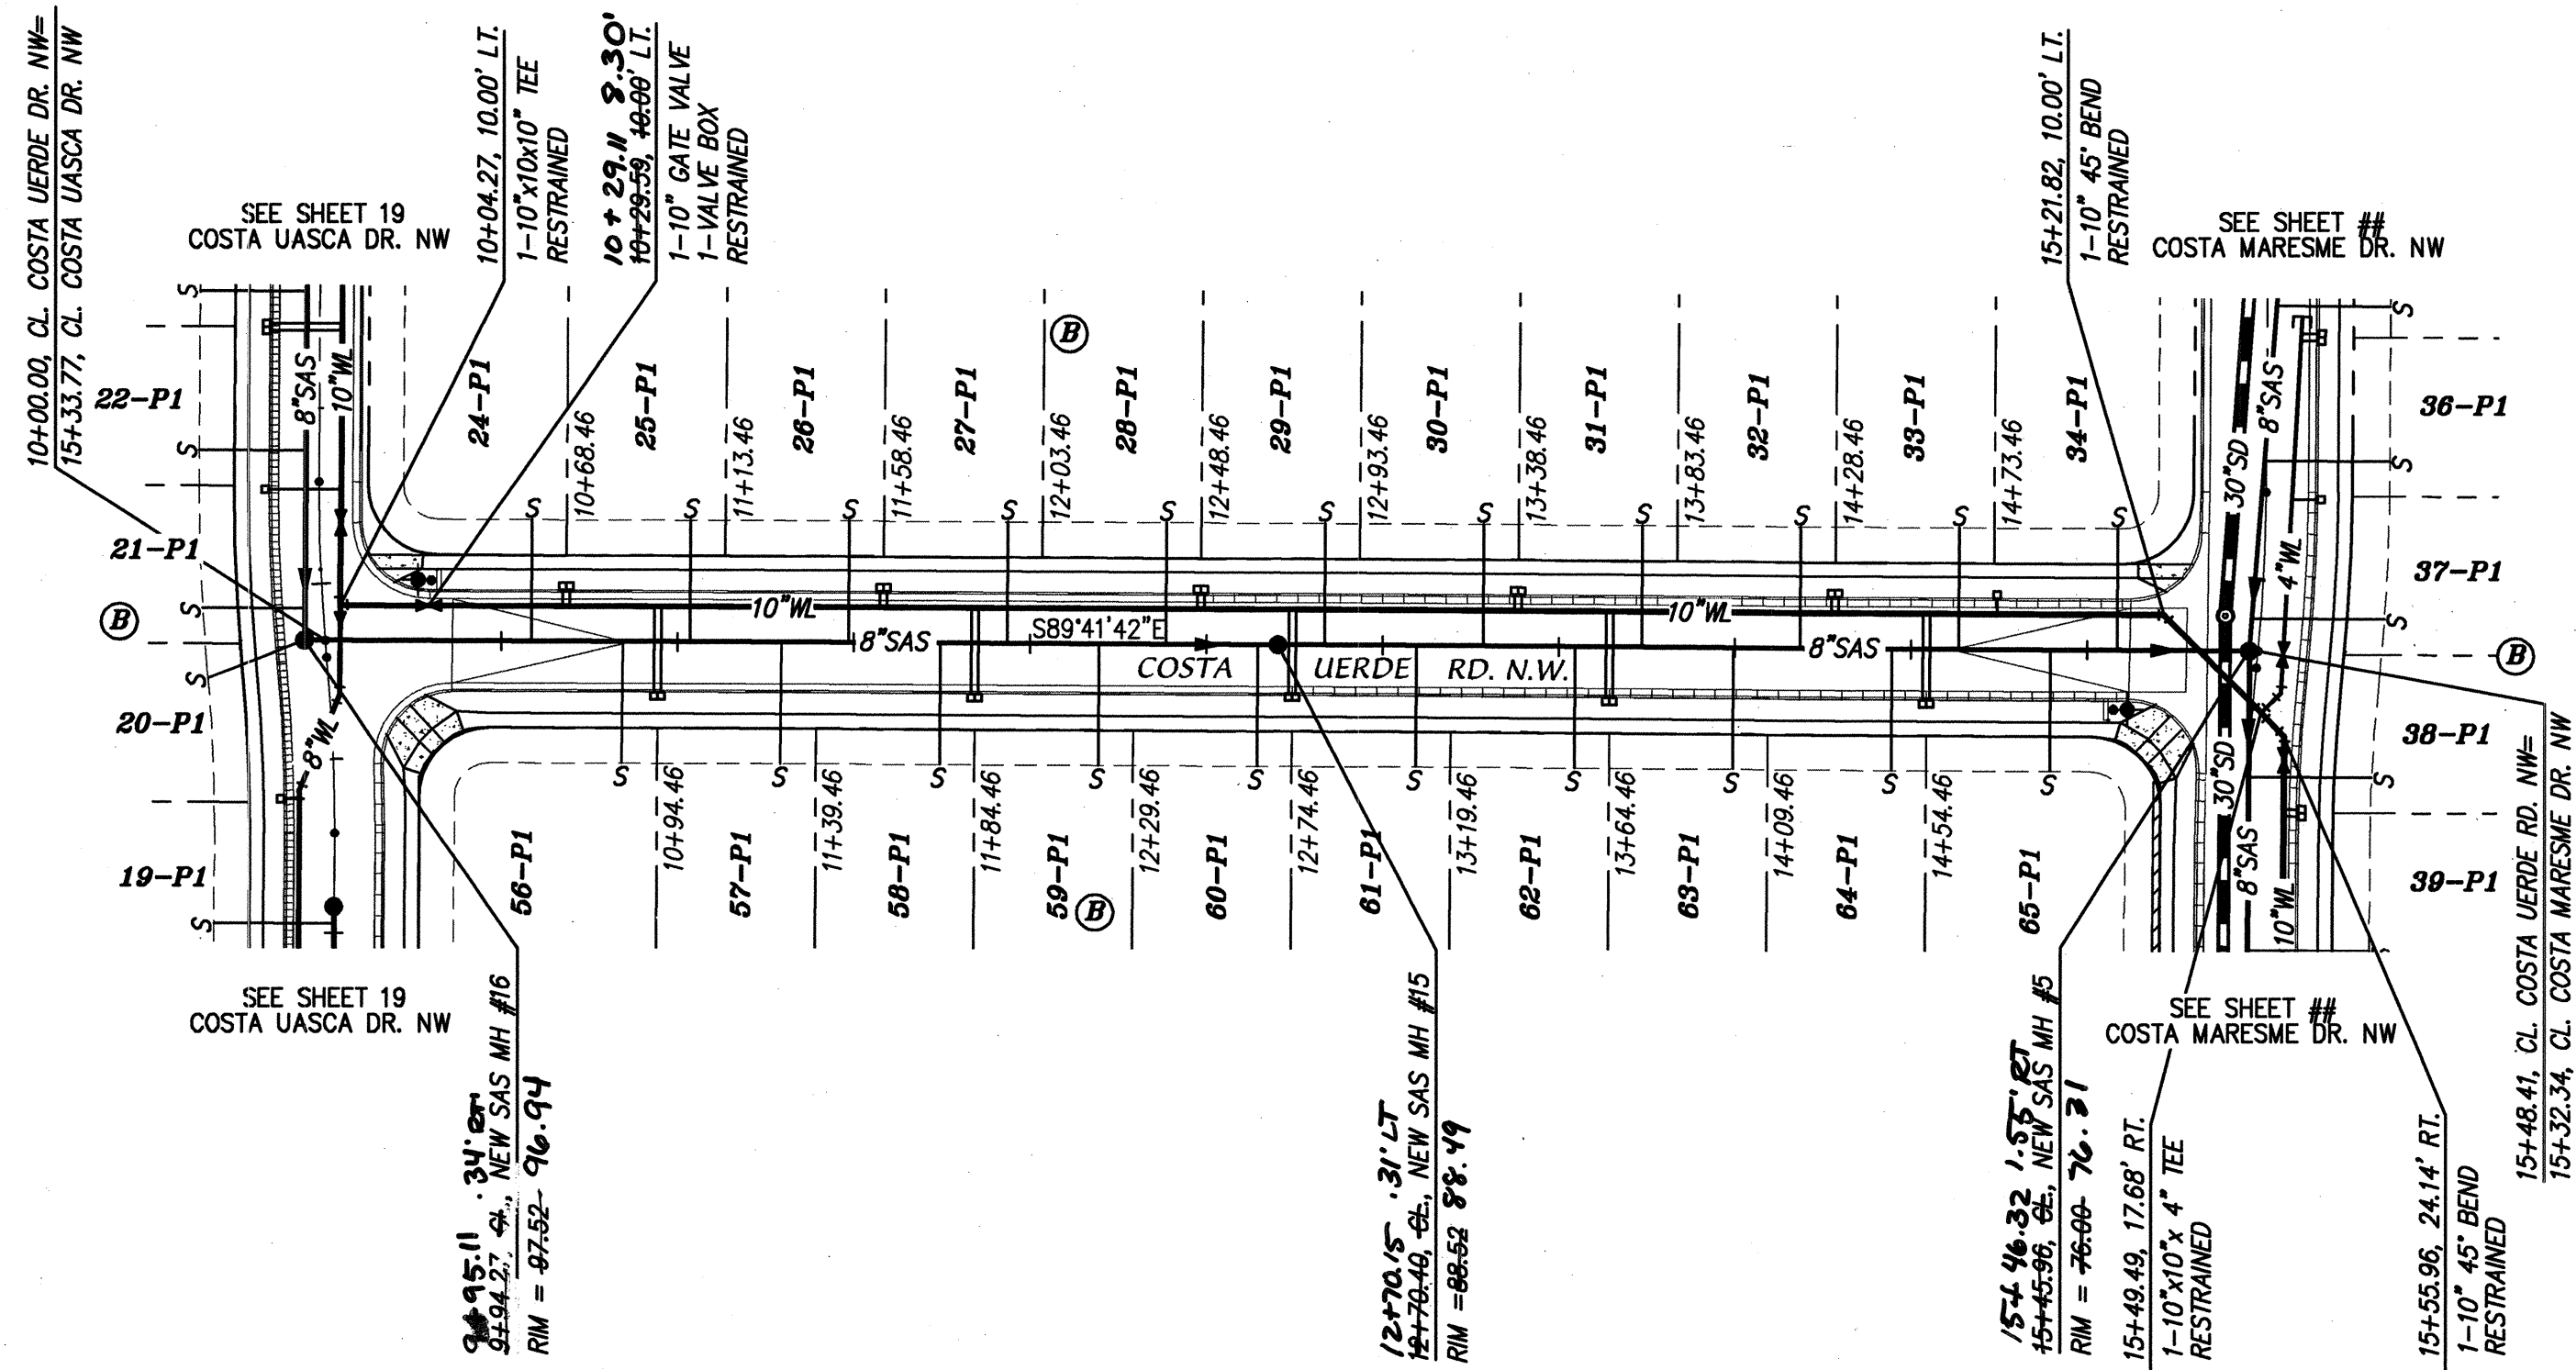

DEPRESSED RIP RAP DETAIL
NTS

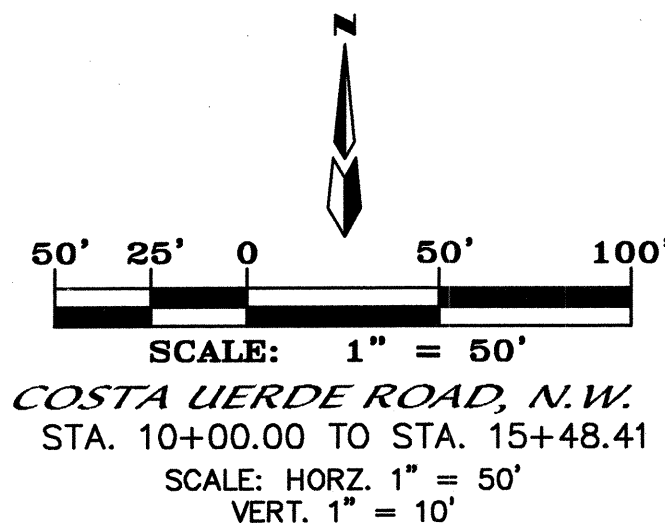


NOTES

1. ALL STATIONING IS CENTERLINE STATIONING.

SANITARY SEWER SERVICES				
BLOCK	LOT	STATION AT PUE	INV. ELEV. AT PUE	LENGTH AT PUE
B	24-P1	10+58.46	5089.38	34.50'
B	25-P1	11+03.46	5087.53	34.50'
B	26-P1	11+48.46	5085.55	34.50'
B	27-P1	11+93.46	5084.43	34.50'
B	28-P1	12+38.46	5083.84	34.50'
B	29-P1	12+83.46	5082.42	34.50'
B	30-P1	13+28.46	5080.22	34.50'
B	31-P1	13+73.46	5077.94	34.50'
B	32-P1	14+18.46	5075.66	34.50'
B	33-P1	14+63.46	5073.23	34.50'
B	34-P1	15+08.46	5071.07	34.50'
B	35-P1	15+53.46	5068.39	34.50'
B	36-P1	16+03.46	5066.34	34.50'
B	37-P1	16+53.46	5064.78	34.50'
B	38-P1	17+03.46	5064.13	34.50'
B	39-P1	17+53.46	5063.15	34.50'
B	40-P1	18+03.46	5061.17	34.50'
B	41-P1	18+53.46	5059.00	34.50'
B	42-P1	19+03.46	5056.62	34.50'
B	43-P1	19+53.46	5054.24	34.50'
B	44-P1	20+03.46	5051.92	34.50'

RECORD DRAWINGS
CERTIFICATE OF SUBSTANTIAL COMPLIANCE ON PLANS
I, Gregory J. Krenik, NMPE 11929, of the firm Mark Goodwin & Associates, P.A., a Registered Professional Engineer in the State of New Mexico, do hereby certify, to the best of my knowledge and belief, that the infrastructure installed as part of this project has been inspected by me or by a qualified person under my direct supervision, and has been constructed in accordance with the plans and specifications approved by the City Engineer and that the original design intent of the approved plans has been met. I have signed and dated this certificate, and the as-built construction drawings, this Certification is based on site inspections by me or person under my direction, and survey information provided by Timothy Alrich, NMPS number 7719.
Gregory J. Krenik NMPE 11929
I, Gregory J. Krenik, certify that this reproduction is identical to the original reproducible APPROVED FOR CONSTRUCTION drawings signed by me on 5-7-09.

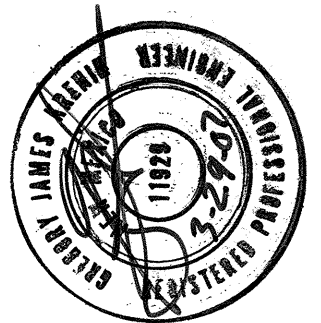

dmg MARK GOODWIN & ASSOCIATES, P.A.
CONSULTING ENGINEERS
P.O. BOX 90606
ALBUQUERQUE, NEW MEXICO 87199
OFFICE (505) 828-2200, FAX (505) 797-9539

CITY OF ALBUQUERQUE
PUBLIC WORKS DEPARTMENT

TITLE: VISTA DE LA LUZ
COSTA UERDE ROAD, N.W.
UTILITY IMPROVEMENTS

DESIGN REVIEW COMMITTEE
APPROVED
MAY 17 2009
DESIGN REVIEW COMMITTEE

CITY ENGINEER APPROVAL
APPROVED
MAY 25 2009
CITY ENGINEER

CITY PROJECT NO.

791481



ZONE MAP NO.

F-11-Z

SHEET

OF

23 24

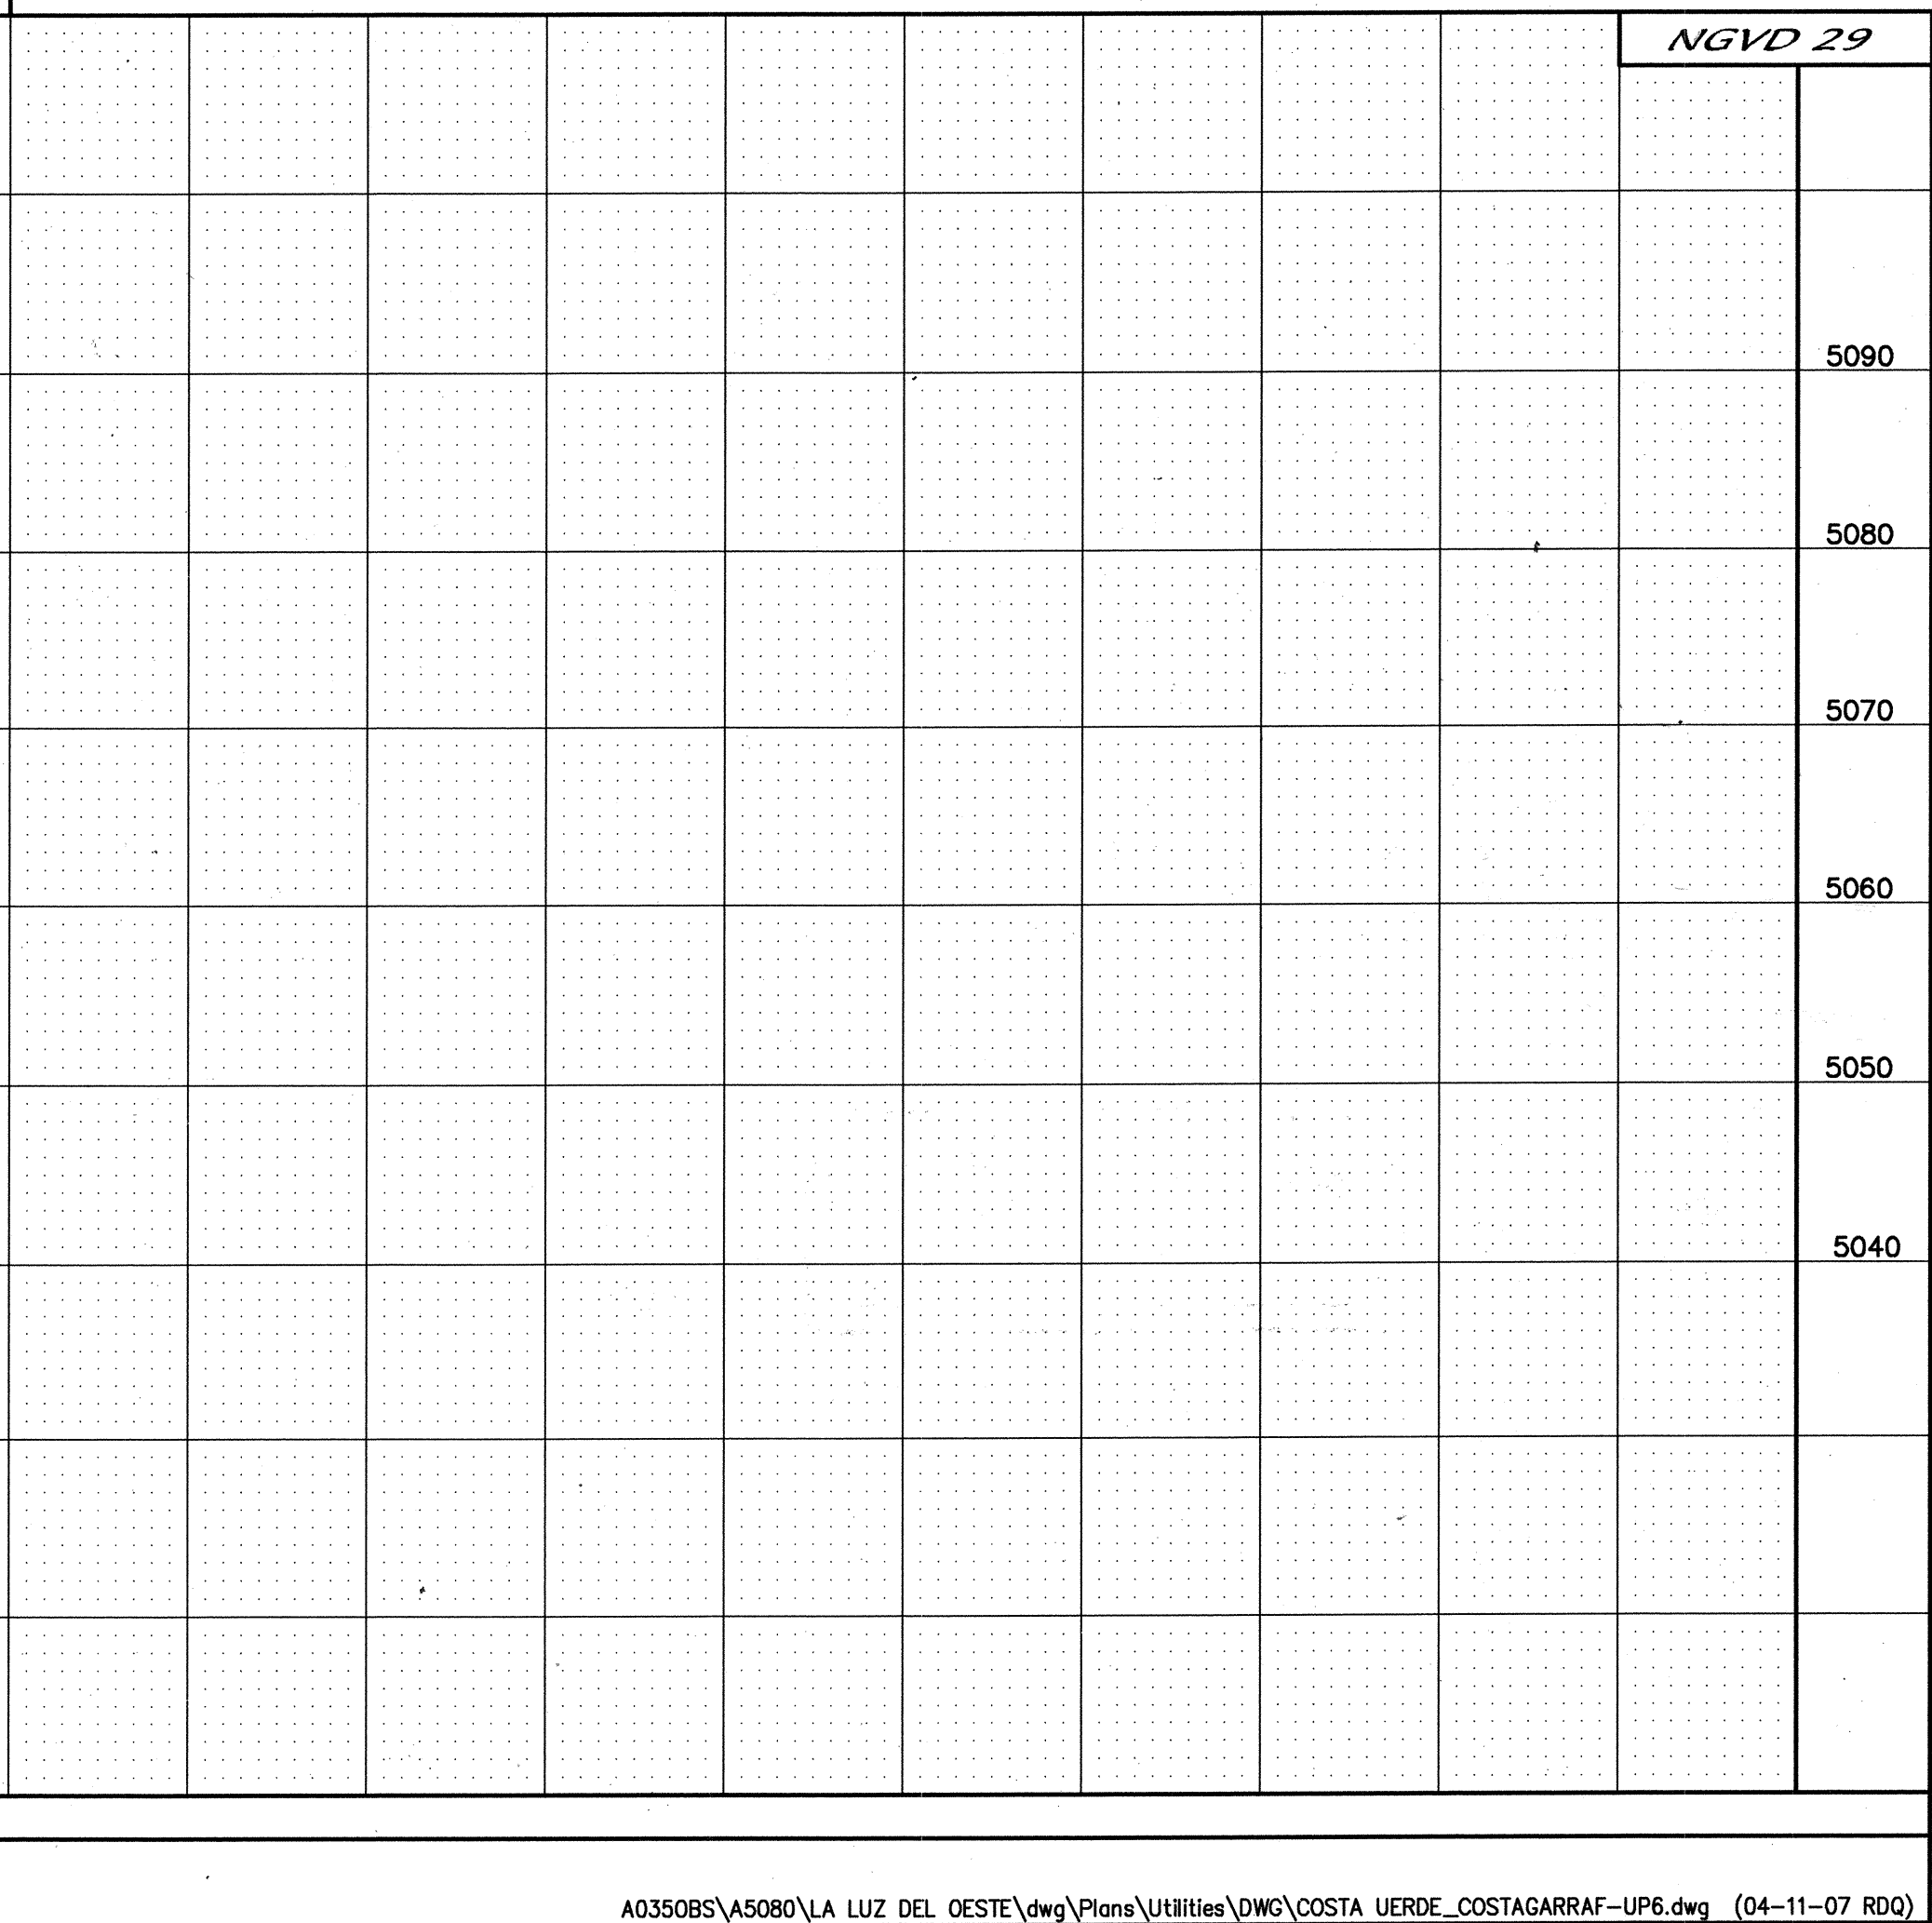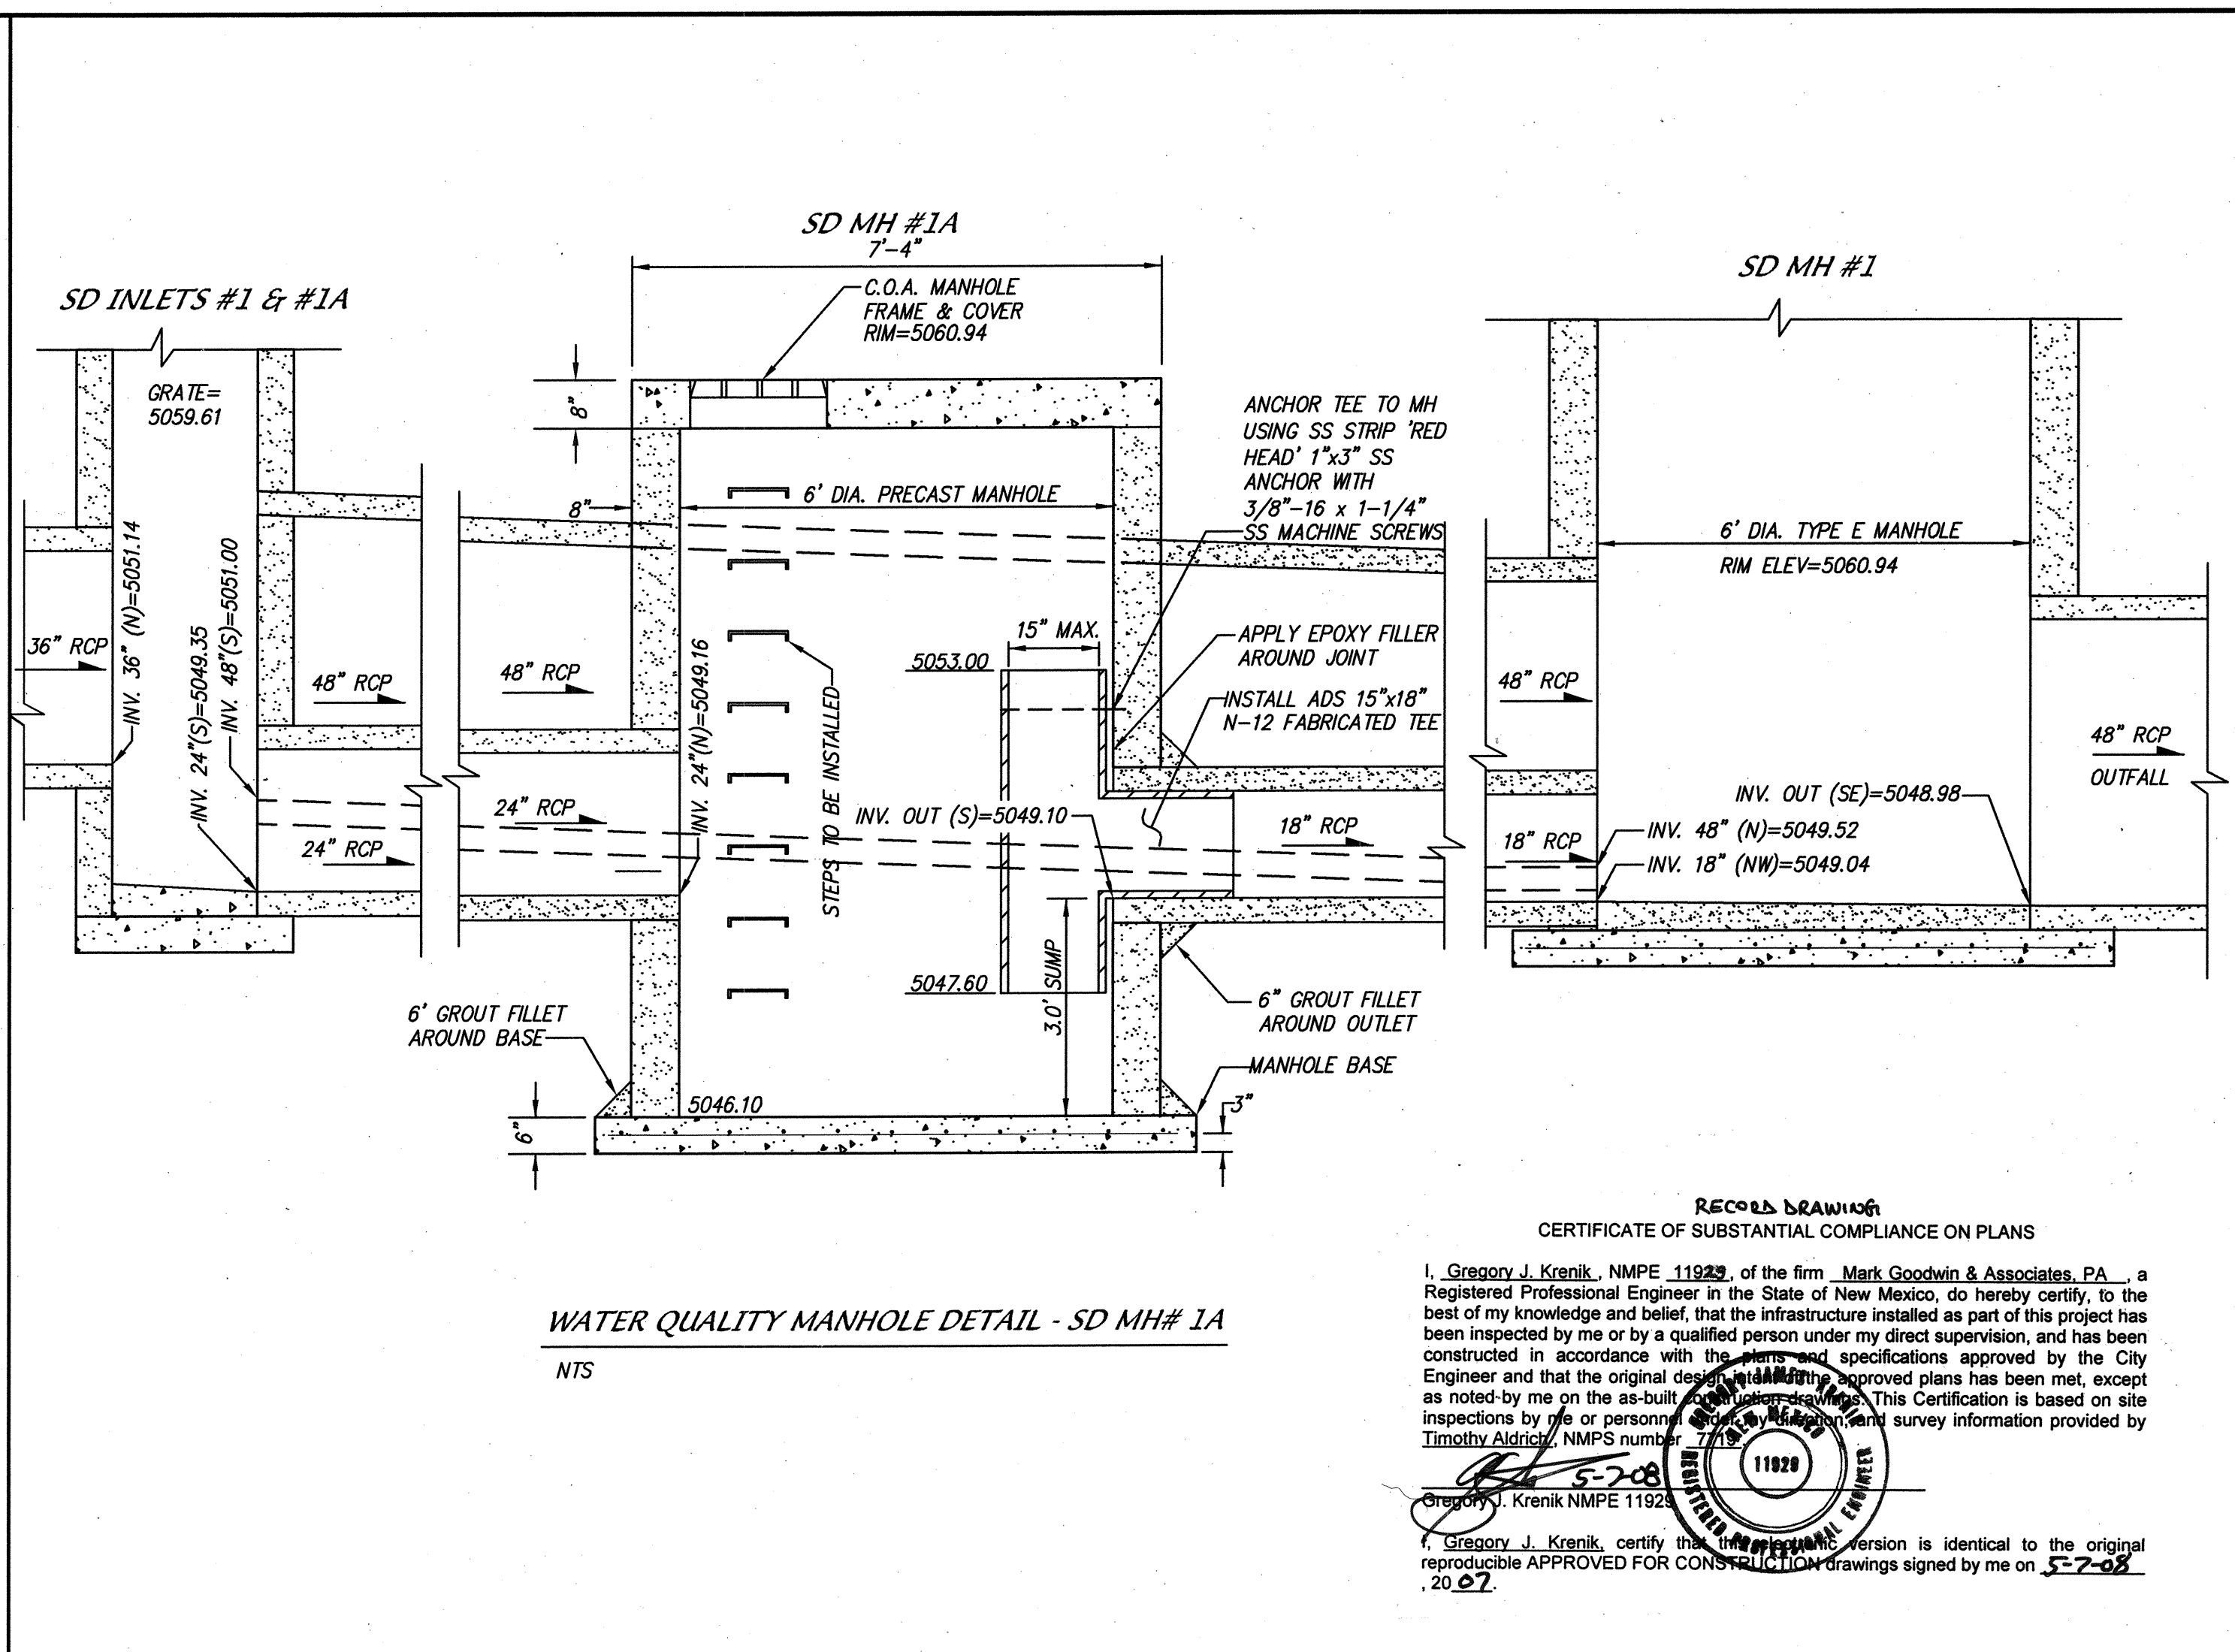[illegible]