


LEGEND


MATERIALS

CONCRETE
RIP-RAP

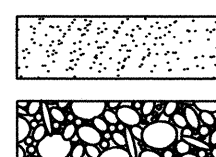


LINES

SUBDIVISION BOUNDARY
PROPERTY LINE (PLAN)
PROPERTY LINE (SECTION)
CENTERLINE
EASEMENT LINE
MATCH LINE
SECTION CUT LINE

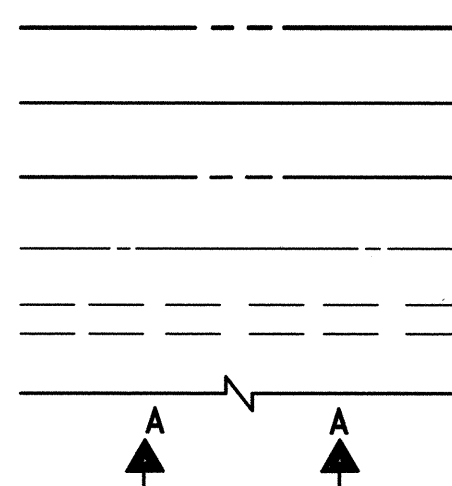


EARTHWORK

CONTOUR LINE
SPOT ELEVATION
PROJECT / PHASE BOUNDARY
FLOWLINE
DIRECTION OF FLOW

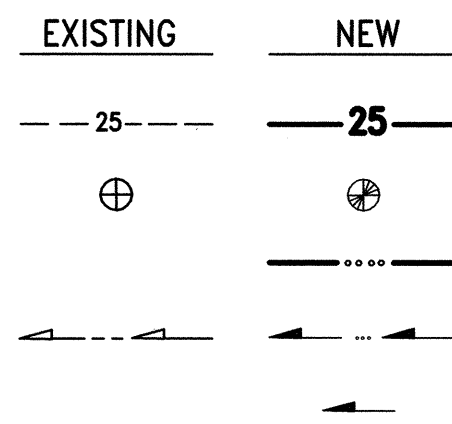


MISCELLANEOUS UTILITIES

GAS LINE
UNDERGROUND TELEPHONE
UNDERGROUND ELECTRICAL
STORM DRAIN
STORM DRAIN MANHOLE
STORM DRAIN INLET

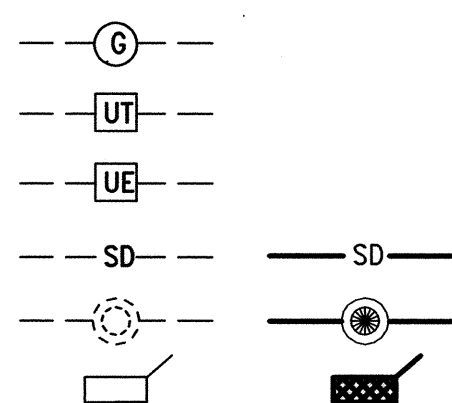


SANITARY SEWER

SANITARY SEWER LINE
SANITARY SEWER MANHOLE
SAS SERVICE CONNECTIONS
SAS CAP OR PLUG
ENCASEMENT

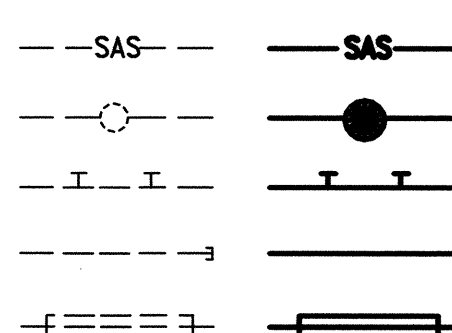


WATER

WATER LINE
WATER SERVICE CONNECTIONS
GATE VALVE
FIRE HYDRANT
BUTTERFLY VALVE
REDUCER
WATER PRESSURE ZONE BOUNDARY

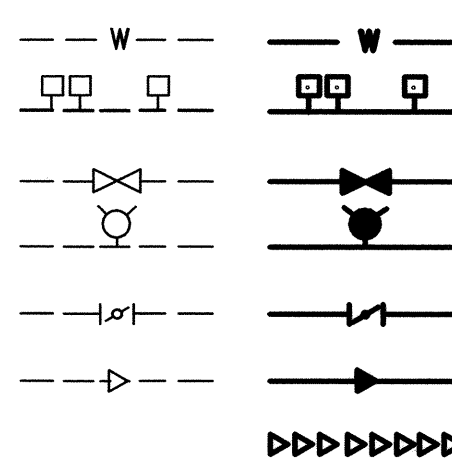


WATER FITTINGS

CAPS AND PLUGS
ELBOW
CROSS
TEE

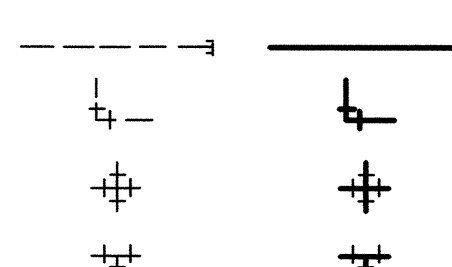

MISCELLANEOUS


CHAINLINK FENCE
FIELD FENCE
COMMON YARD WALL
RETAINING WALL
POWER OR TELEPHONE POLE

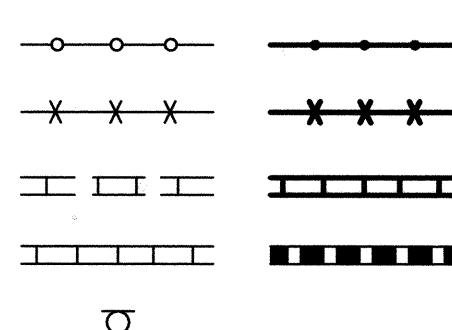

SCANNED BY
PLANNING

2 3 4 5 6 7 8 9 10 11 12 13 14 15
24-11934-62-2009

CONSTRUCTION PLANS for GEORGIA O'KEEFFE ELEMENTARY SCHOOL PUBLIC WATER LINE EXTENSION ALBUQUERQUE, NEW MEXICO FEBRUARY, 2009

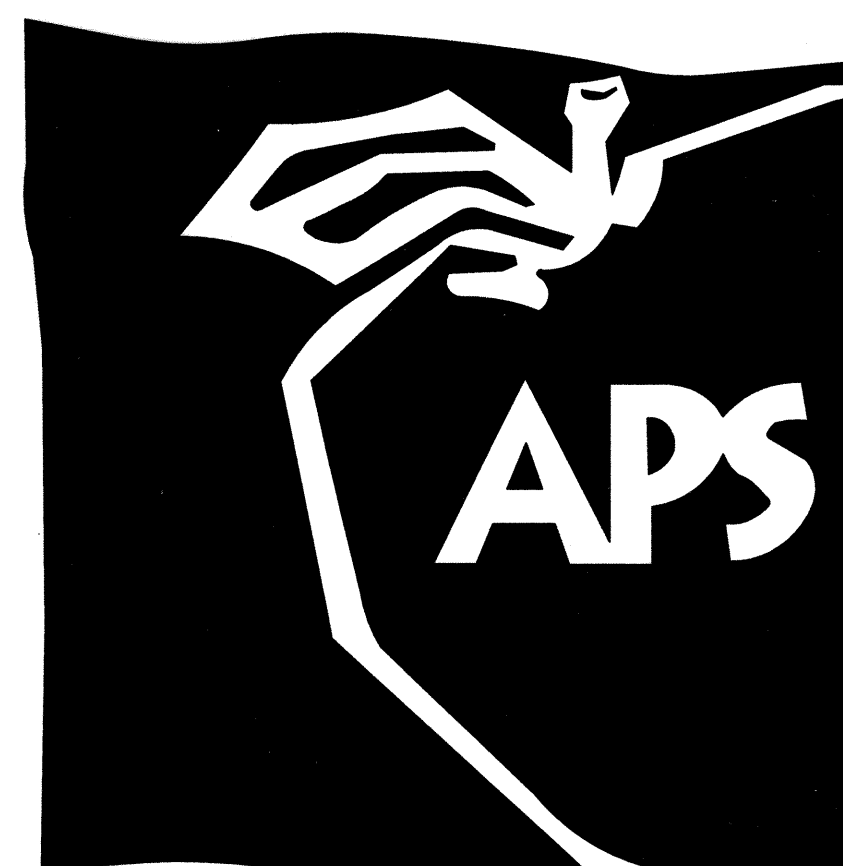

CERTIFICATE OF SUBSTANTIAL COMPLIANCE

I, J. GRAEME MEANS, NMPE 13676, OF THE FIRM HIGH MESA CONSULTING GROUP, HEREBY CERTIFY THAT THE PUBLIC INFRASTRUCTURE CONSTRUCTED AS PART OF THIS PROJECT HAS BEEN INSPECTED BY ME OR PERSONNEL UNDER MY DIRECT SUPERVISION AND, TO THE BEST OF MY KNOWLEDGE AND BELIEF, HAS BEEN CONSTRUCTED IN ACCORDANCE WITH THE PLANS AND SPECIFICATIONS AND THE ORIGINAL DESIGN INTENT OF THE CITY ENGINEER APPROVED PLANS.

THE RECORD SURVEY INFORMATION EDITED ONTO THE ORIGINAL DESIGN DOCUMENT WAS OBTAINED UNDER THE DIRECT SUPERVISION OF CHARLES G. CALA, JR., NMPS 11184, ALSO OF HIGH MESA CONSULTING GROUP.

I CERTIFY THAT THIS INFORMATION IS TRUE AND CORRECT TO THE BEST OF MY KNOWLEDGE AND BELIEF. THESE RECORD DRAWINGS ARE NOT NECESSARILY COMPLETE AND INTENDED ONLY TO VERIFY SUBSTANTIAL COMPLIANCE OF THE DESIGN INTENT OF THE PROJECT. THOSE RELYING ON THIS DOCUMENT ARE ADVISED TO OBTAIN INDEPENDENT VERIFICATION OF ITS ACCURACY BEFORE USING IT FOR ANY OTHER PURPOSE. THIS CERTIFICATION IS SUBMITTED IN SUPPORT OF A REQUEST FOR ACCEPTANCE OF THE PROJECT BY THE CITY ENGINEER AND THE WATER UTILITY AUTHORITY.




INDEX OF DRAWINGS

SHEET	DESCRIPTION
1	COVER SHEET, VICINITY MAP, GENERAL NOTES, LEGEND AND INDEX OF DRAWINGS
2	OVERALL WATER LINE PLAN, WATER VALVE SHUTOFF PLAN
3	PUBLIC WATER LINE PLAN AND PROFILE

RECORD DRAWING

APPROVED AS RECORD DRAWINGS
DESIGN REVIEW SECTION
CITY ENGINEER
DATE: 01/30/09

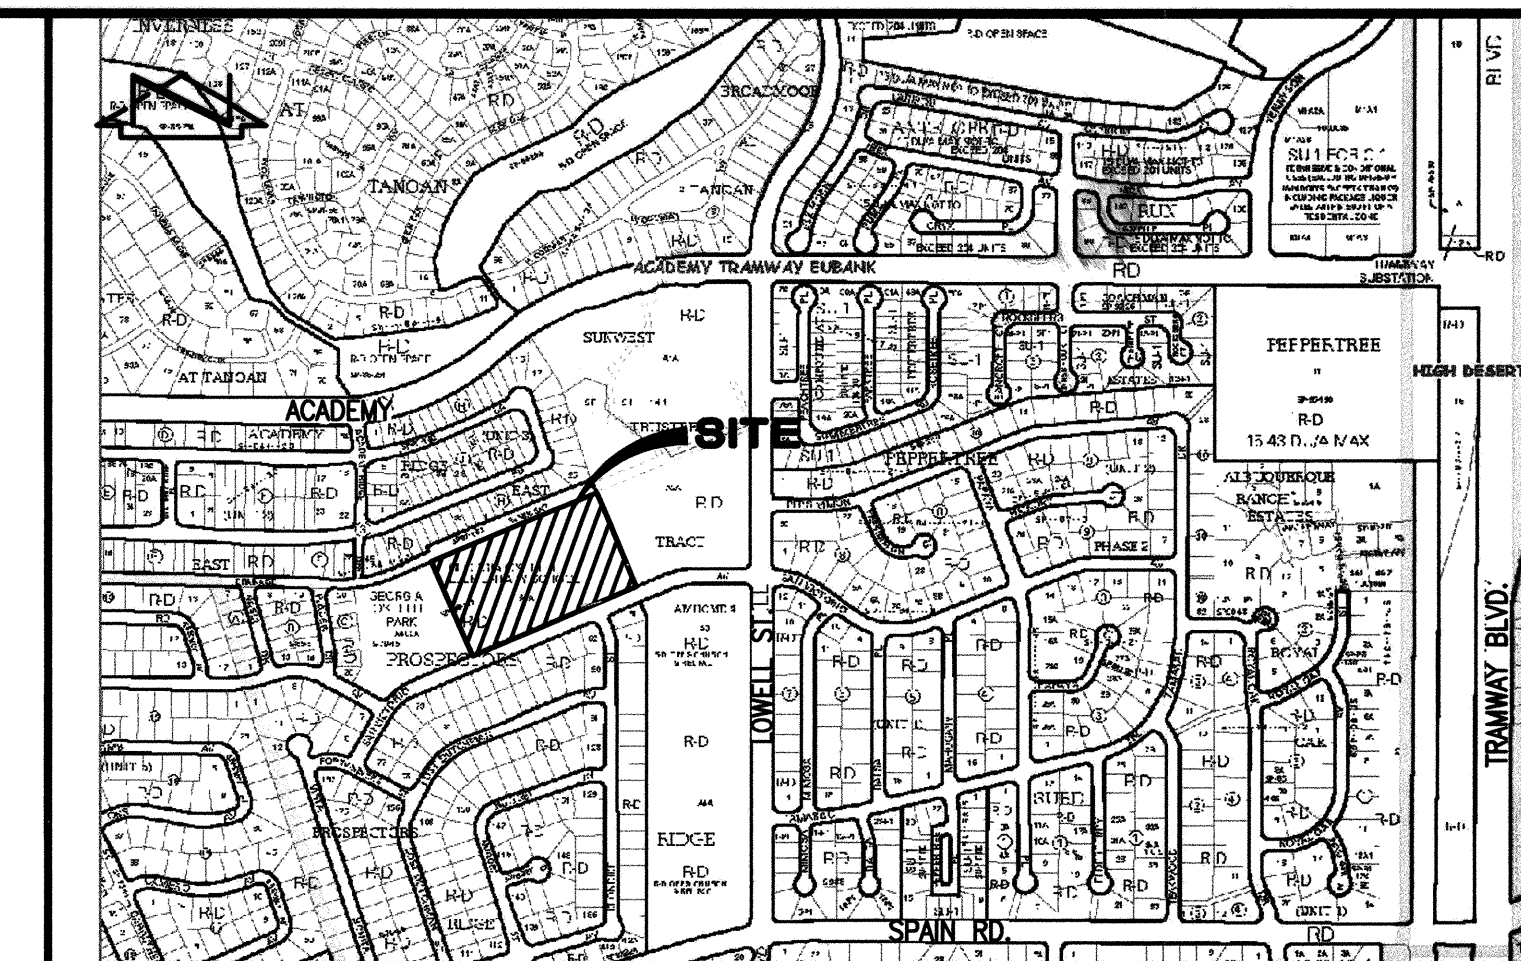

VICINITY MAP
SCALE: 1" = 750'

GENERAL NOTES:

- ALL WORK DETAILED ON THESE PLANS TO BE PERFORMED UNDER CONTRACT SHALL, EXCEPT AS OTHERWISE STATED OR PROVIDED FOR HEREON, BE CONSTRUCTED IN ACCORDANCE WITH THE CITY OF ALBUQUERQUE STANDARD SPECIFICATIONS-PUBLIC WORKS CONSTRUCTION-1986-UPDATE NO. 7, INCLUDING AMENDMENT #1.
- TWO (2) WORKING DAYS PRIOR TO ANY EXCAVATION, CONTRACTOR MUST CONTACT NEW MEXICO ONE CALL SYSTEM, 260-1990, (ALBUQUERQUE AREA) 1-800-321-ALERT (2537) (STATEWIDE) FOR LOCATION OF EXISTING PUBLIC UTILITIES AND ABASTO UTILITY LOCATING COMPANY (889-3341) FOR THE LOCATION OF EXISTING PRIVATE UTILITIES ON APS PROPERTY.
- IF ANY UTILITY LINES, PIPELINES, OR UNDERGROUND UTILITY LINES ARE SHOWN ON THESE DRAWINGS, THEY ARE SHOWN IN AN APPROXIMATE MANNER ONLY, AND SUCH LINES MAY EXIST WHERE NONE ARE SHOWN. IF ANY SUCH EXISTING LINES ARE SHOWN, THE LOCATION IS BASED UPON INFORMATION PROVIDED BY THE OWNER OF SAID UTILITY, AND THE INFORMATION MAY BE INCOMPLETE, OR MAY BE OBSOLETE BY THE TIME CONSTRUCTION COMMENCES. THE ENGINEER HAS CONDUCTED ONLY PRELIMINARY INVESTIGATION OF THE LOCATION, DEPTH, SIZE, OR TYPE OF EXISTING UTILITY LINES, PIPELINES, OR UNDERGROUND UTILITY LINES. THIS INVESTIGATION IS NOT CONCLUSIVE, AND MAY NOT BE COMPLETE. THEREFORE, MAKES NO REPRESENTATION PERTAINING THERETO, AND ASSUMES NO RESPONSIBILITY OR LIABILITY THEREFOR. THE CONTRACTOR SHALL INFORM ITSELF OF THE LOCATION OF ANY UTILITY LINE, PIPELINE, OR UNDERGROUND UTILITY LINE IN OR NEAR THE AREA OF THE WORK IN ADVANCE OF AND DURING EXCAVATION WORK. THE CONTRACTOR IS FULLY RESPONSIBLE FOR ANY AND ALL DAMAGE CAUSED BY ITS FAILURE TO LOCATE, IDENTIFY AND PRESERVE ANY AND ALL EXISTING UTILITIES, PIPELINES, AND UNDERGROUND UTILITY LINES. IN PLANNING AND CONDUCTING EXCAVATION, THE CONTRACTOR SHALL COMPLY WITH STATE STATUTES, MUNICIPAL AND LOCAL ORDINANCES, RULES AND REGULATIONS, IF ANY, PERTAINING TO THE LOCATION OF THESE LINES AND FACILITIES.
- SHOULD A CONFLICT EXIST BETWEEN THESE PLANS AND ACTUAL FIELD CONDITIONS, THE CONTRACTOR SHALL PROMPTLY NOTIFY THE ENGINEER IN WRITING SO THAT THE CONFLICT CAN BE RESOLVED WITH A MINIMUM AMOUNT OF DELAY FOR ALL PARTIES.
- THE CONTRACTOR SHALL MAINTAIN ACCESS TO ADJACENT PROPERTIES DURING CONSTRUCTION.
- ALL WORK ON THIS PROJECT SHALL BE PERFORMED IN ACCORDANCE WITH APPLICABLE FEDERAL, STATE AND LOCAL LAWS, RULES AND REGULATIONS CONCERNING SAFETY AND HEALTH.
- ALL UTILITIES AND UTILITY SERVICE LINES SHALL BE INSTALLED PRIOR TO PAVING.
- BACKFILL COMPACTION SHALL BE ACCORDING TO SPECIFIED STREET USE OR PER COA STANDARD DRAWING 2465, WHICHEVER IS MORE STRINGENT.
- TACK COAT REQUIREMENTS SHALL BE DETERMINED DURING CONSTRUCTION BY THE PROJECT ENGINEER.
- SIDEWALKS AND WHEELCHAIR RAMPS WITHIN THE CURB RETURNS SHALL BE CONSTRUCTED WHEREVER A NEW CURB RETURN IS CONSTRUCTED.
- IF CURB IS DEEPENED FOR A DRIVEPAD OR A HANDICAP RAMP, THE DRIVEPAD OR RAMP SHALL BE CONSTRUCTED PRIOR TO ACCEPTANCE OF THE CURB AND GUTTER.
- ALL STORM DRAINAGE FACILITIES SHALL BE COMPLETED PRIOR TO FINAL ACCEPTANCE.
- CONTRACTOR SHALL COORDINATE WITH THE WATER AUTHORITY FOR THE EXECUTION OF THE VALVE SHUT OFF PLAN, NOT LESS THAN SEVEN (7) WORKING DAYS IN ADVANCE OF ANY WORK THAT MAY AFFECT THE EXISTING PUBLIC WATER UTILITIES. ONLY WATER AUTHORITY PERSONNEL SHALL OPERATE EXISTING VALVES. REFER TO SECTION 18 OF THE SPECIFICATIONS. THE WATER AUTHORITY PHONE NUMBER IS 857-8200.
- CONTRACTOR SHALL NOTIFY THE CITY SURVEYOR NOT LESS THAN SEVEN (7) DAYS PRIOR TO STARTING WORK IN ORDER THAT THE CITY SURVEYOR MAY TAKE NECESSARY MEASURES TO INSURE THE PRESERVATION OF SURVEY MONUMENTS. CONTRACTOR SHALL NOT DISTURB PERMANENT SURVEY MONUMENTS WITHOUT THE CONSENT OF THE CITY SURVEYOR AND SHALL NOTIFY THE CITY SURVEYOR AND BEAR THE EXPENSE OF REPLACING ANY THAT MAY BE DISTURBED WITHOUT PERMISSION. REPLACEMENT SHALL BE DONE ONLY BY THE CITY SURVEYOR. WHEN A CHANGE IS MADE IN THE FINISHED ELEVATION OF THE PAVEMENT OF ANY ROADWAY IN WHICH A PERMANENT SURVEY MONUMENT IS LOCATED, CONTRACTOR SHALL, AT HIS OWN EXPENSE, ADJUST THE MONUMENT COVER TO THE NEW GRADE UNLESS OTHERWISE SPECIFIED. REFER TO SECTION 4.4 OF THE SPECIFICATIONS.
- SEVEN (7) WORKING DAYS PRIOR TO BEGINNING CONSTRUCTION THE CONTRACTOR SHALL SUBMIT TO THE CONSTRUCTION COORDINATION DIVISION A DETAILED CONSTRUCTION SCHEDULE TWO (2) WORKING DAYS PRIOR TO CONSTRUCTION THE CONTRACTOR SHALL OBTAIN A BARRICADE PERMIT FROM THE CONSTRUCTION COORDINATION DIVISION. CONTRACTOR SHALL NOTIFY BARRICADE ENGINEER (924-3400) PRIOR TO OCCUPYING AN INTERSECTION. CONTRACTOR MUST REFER TO SECTION 19 OF THE STANDARD SPECIFICATION FOR TRAFFIC CONTROL.
- ALL STREET STRIPING ALTERED OR DESTROYED SHALL BE REPLACED WITH PLASTIC REFLECTORIZED STRIPING BY CONTRACTOR TO EXISTING LOCATION OR AS INDICATED BY THIS PLAN SET.
- CAUTION: THESE DRAWINGS DO NOT INCLUDE NECESSARY COMPONENTS FOR CONSTRUCTION SAFETY WHICH SHALL REMAIN THE RESPONSIBILITY OF THE CONTRACTOR. ALL EXCAVATION, TRENCHING AND SHORING ACTIVITIES MUST BE CARRIED-OUT IN ACCORDANCE WITH OSHA 29 CFR 1926, SUBPART P-EXCAVATIONS.
- ANY WORK OCCURRING WITHIN AN ARTERIAL ROADWAY REQUIRES TWENTY-FOUR HOUR CONSTRUCTION.
- CONTRACTOR SHALL MAINTAIN A GRAFFITI-FREE WORK SITE. CONTRACTOR SHALL PROMPTLY REMOVE ANY AND ALL GRAFFITI FROM EQUIPMENT, WHETHER PERMANENT OR TEMPORARY.
- WHEN APPLICABLE, CONTRACTOR SHALL, ON BEHALF OF THE OWNER AND OPERATORS, SECURE "TOPSOIL DISTURBANCE PERMIT" FROM THE CITY AND/OR FILE A NOTICE OF INTENT (N.O.I.) WITH THE EPA PRIOR TO BEGINNING CONSTRUCTION.
- CONTRACTOR SHALL BE RESPONSIBLE FOR PROVIDING AND MAINTAINING ALL CONSTRUCTION SIGNING UNTIL THE PROJECT HAS BEEN ACCEPTED BY THE CITY OF ALBUQUERQUE.

J. GRAEME MEANS, NMPE 13676

06/30/09
DATE

2008.035.3 5



HIGH MESA Consulting Group

6010 MIDWAY PARK BLVD. NE • ALBUQUERQUE, NEW MEXICO 87109
PHONE: 505.345.4250 • FAX: 505.345.4254 • www.highmesacg.com

REV.	SHEETS	CITY ENGINEER	DATE	USER	DEPARTMENT	DATE	USER	DEPARTMENT	DATE
1	3		6/2009						
ENGINEERS STAMP & SIGNATURE		APPROVALS		ENGINEER		DATE		*****	
		DRC Chairman		2/17/09		APPROVED FOR CONSTRUCTION			
		Transportation		2/17/09					
		Water/Wastewater		2-17-09					
		Hydrology		2-17-09					
		C.I.P.							
Const. Mngmt.									
Const. Coord.									
City Project No.		793482		SHEET		1		OF 3	

SCANNED BY
PLANNING

SCALE: 1" = 40'

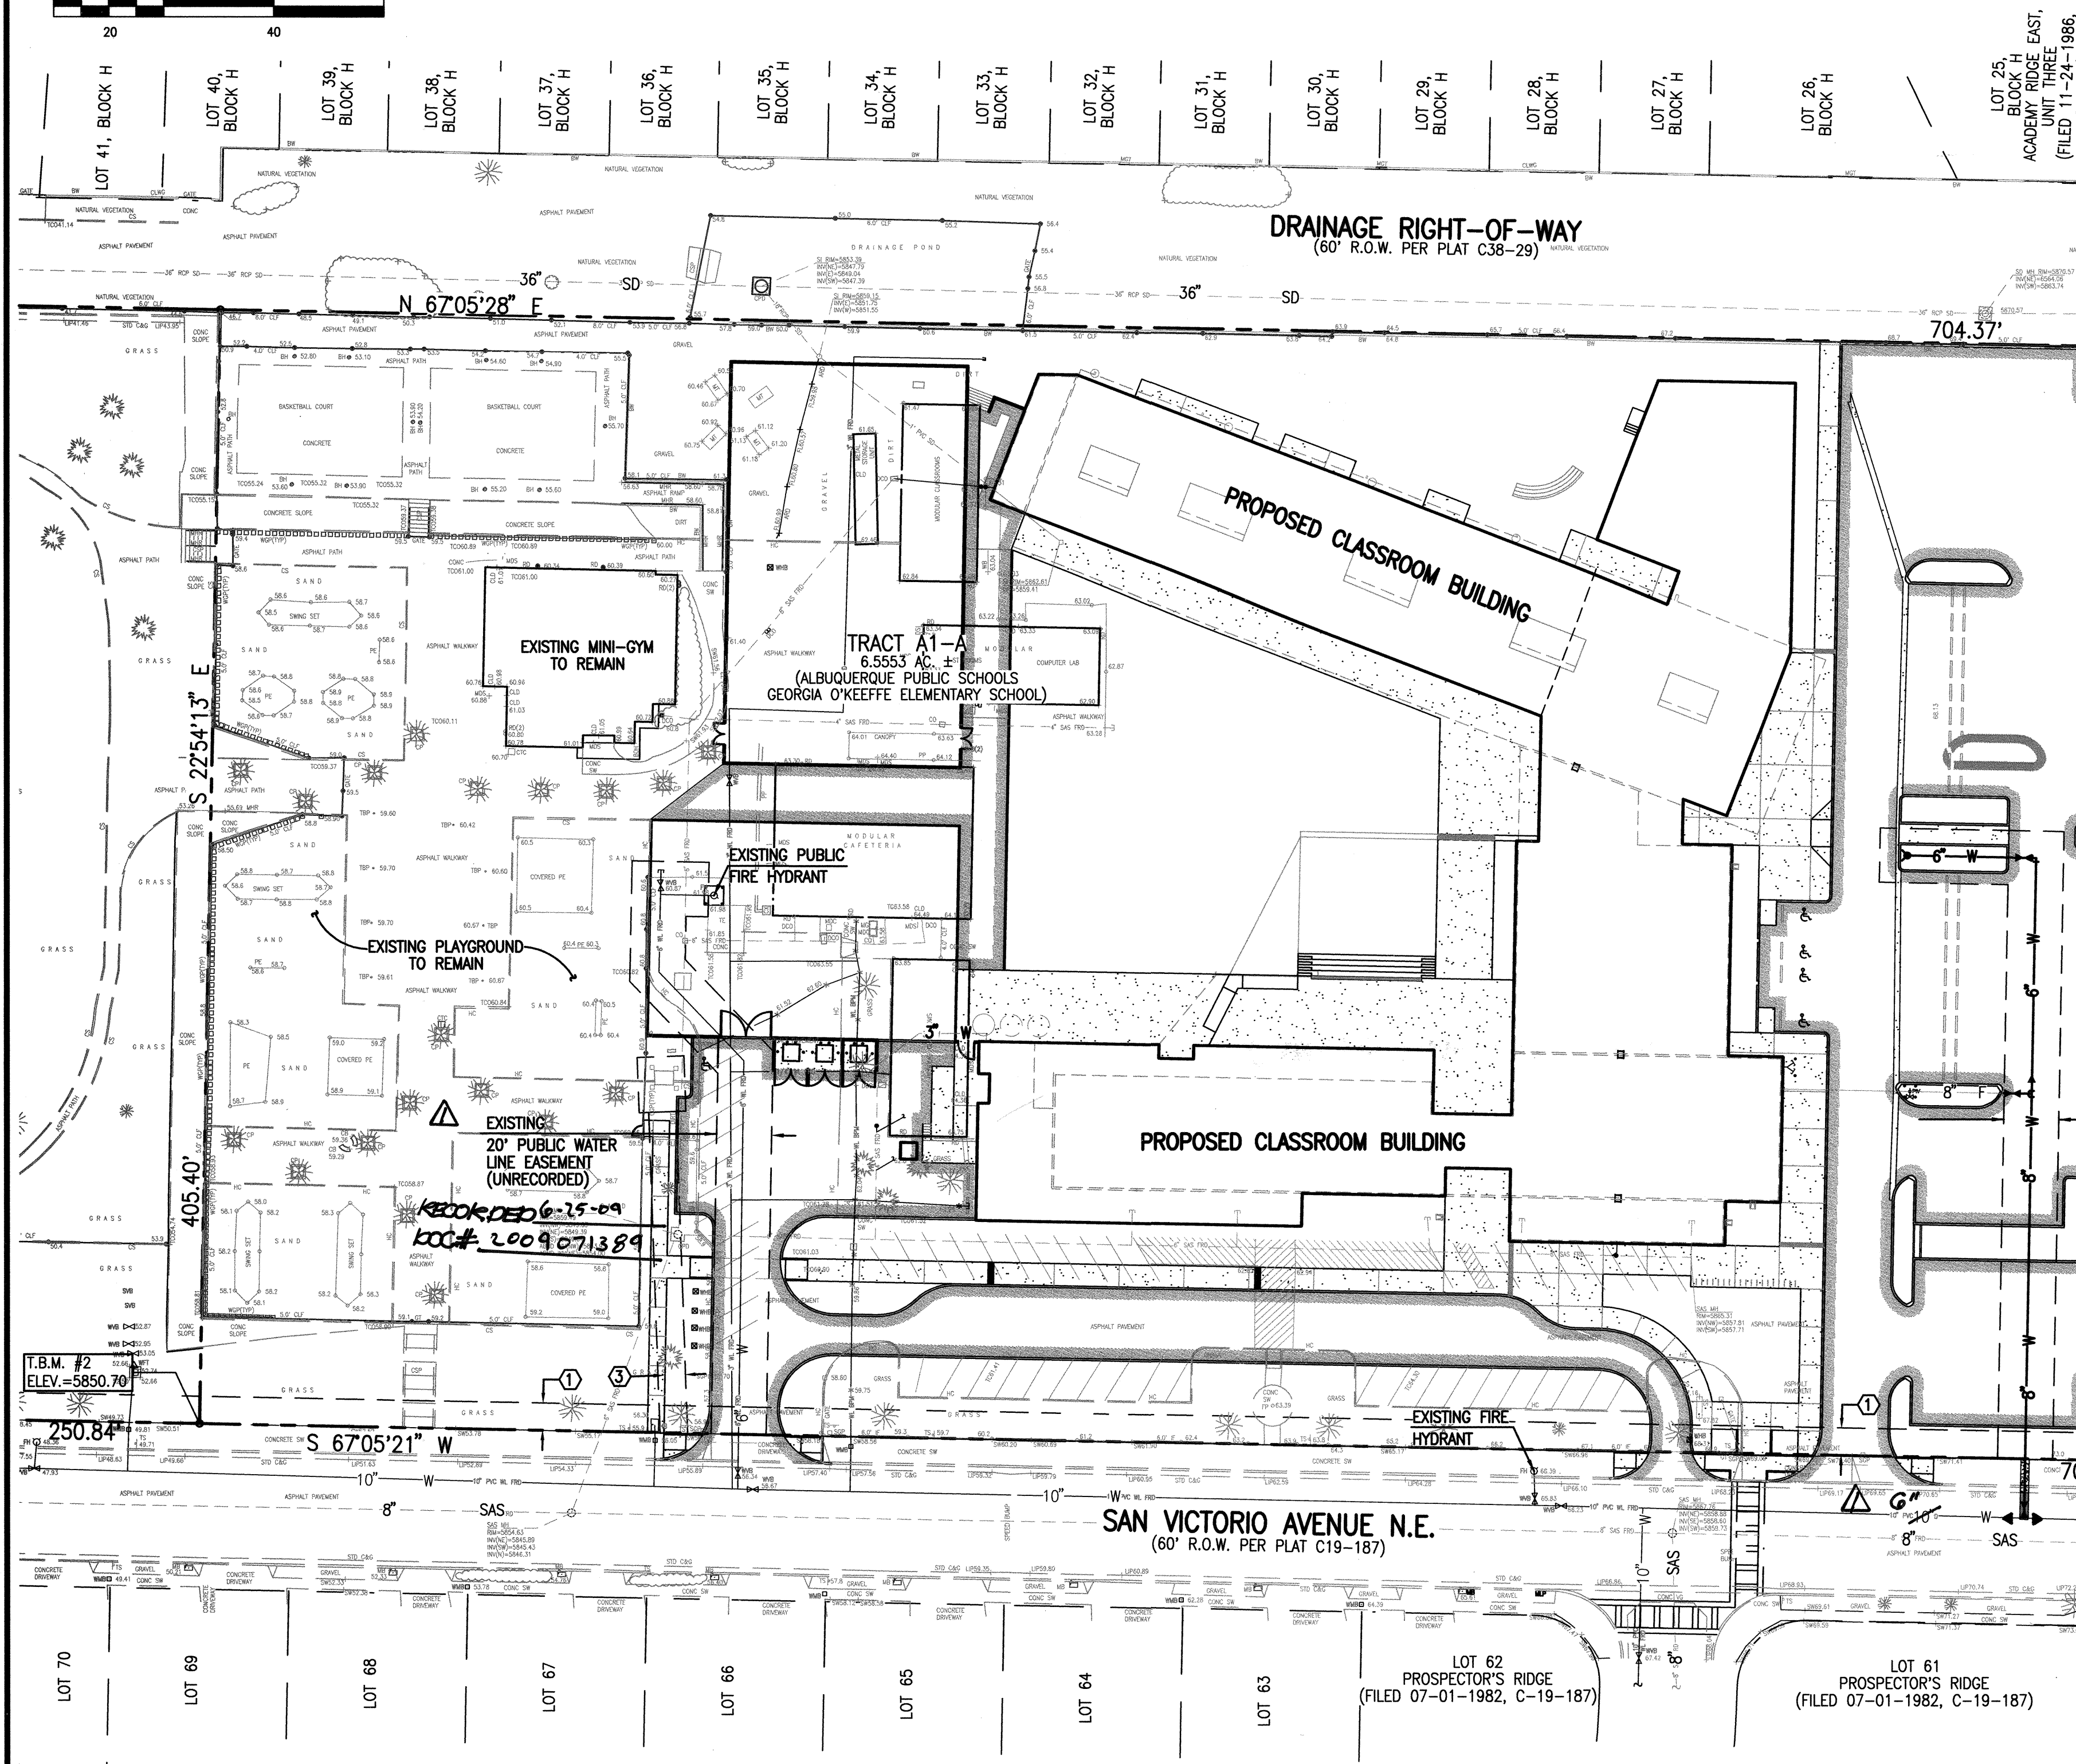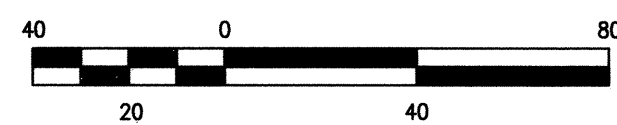

RECORD DRAWING FOR CERTIFICATION, SEE SHEET 1

LEGAL DESCRIPTION

TRACT A1-A, LANDS OF AMHOME IV, ALBUQUERQUE, NEW MEXICO, AS THE SAME IS SHOWN AND DESIGNATED ON THE PLAT FILED IN THE OFFICE OF THE COUNTY CLERK OF BERNALILLO COUNTY, NEW MEXICO ON DECEMBER 16, 1988, BOOK C38, PAGE 29.

EASEMENT KEYED NOTES


- 10' PUBLIC UTILITY EASEMENT GRANTED BY PLAT C38-29
- PNM AND MST&T EASEMENT GRANTED BY DOCUMENT EXECUTED 10-04-1989
- 10' PUBLIC UTILITY EASEMENT DEPICTED ON PLAT 91C-204
- 40' PUBLIC DRAINAGE EASEMENT DEPICTED ON PLAT 91C-204

NOTE:

THIS IS NOT A BOUNDARY SURVEY. DATA IS SHOWN FOR ORIENTATION ONLY. BOUNDARY INFORMATION DEPICTED BY THIS PLAN IS BASED UPON THE BOUNDARY SURVEY PREPARED BY HIGH MESA CONSULTING GROUP, NMPS 11184, DATED 01/28/2008. THE TOPOGRAPHIC INFORMATION DEPICTED HEREON IS BASED UPON THE TOPOGRAPHIC AND UTILITY SURVEY PREPARED BY HIGH MESA CONSULTING GROUP, NMPS 11184, DATED 01/28/2008. NOTE: PRE-EXISTING SITE IMPROVEMENTS ON THE SCHOOL SITE DEMOLISHED BY OWNER HAVE BEEN REMOVED FOR CLARITY.

- RECORD DRAWING LEGEND**
- | | |
|------------|--|
| CONSTRUCT | RECORD INFORMATION (VERIFIED BY ENGINEER) |
| ✓ | AS-CONSTRUCTED = AS-DESIGNED (VERIFIED BY ENGINEER) |
| 8" (19) | RECORD INFORMATION (VERIFIED BY ENGINEER) |
| 31.25 (22) | RECORD INFORMATION (VERIFIED BY ENGINEER) |
| ✓ | AS-CONSTRUCTED = AS-DESIGNED (VERIFIED BY AS-BUILT SURVEY) |
| 31.25 (22) | RECORD INFORMATION FROM AS-BUILT SURVEY |
| 31.25 (22) | RECORD INFORMATION FROM AS-BUILT SURVEY |
| 31.25 (22) | RECORD INFORMATION FROM AS-BUILT SURVEY |

PROPOSED 20' PUBLIC
WATER LINE EASEMENT
BY DOCUMENT FILED 06/25/2009
DOC # 2009071389

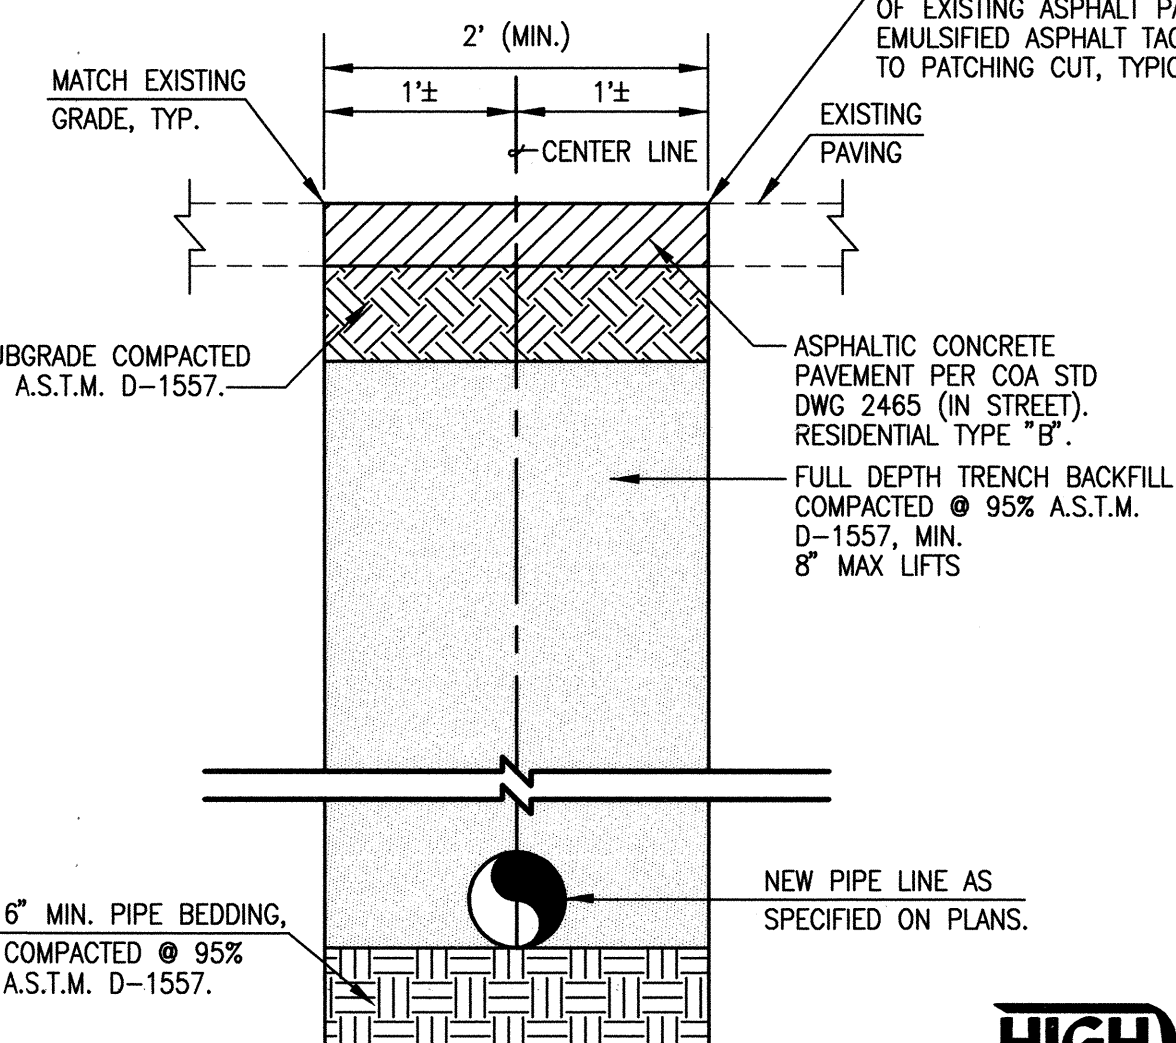

TYPICAL TRENCH SECTION
SCALE: 1" = 1'

BENCHMARK INFORMATION

PROJECT BENCHMARK

ACS 3 1/4" ALUMINUM DISK STAMPED "3-E22A" SET FLUSH IN THE CONCRETE OF THE MEDIAN NOSE AT THE NORTH SIDE OF THE INTERSECTION OF LOWELL STREET N.E. AND SAN VICTORIO AVENUE N.E.
ELEVATION = 5894.051 FEET (NAVD 1988)

T.B.M. #1

A CHISELED "4" ON CONCRETE JUST EAST OF A FENCE CORNER BEING THE SOUTHEAST PROPERTY CORNER OF TRACT A1-A, A.K.A. GEORGIA O'KEEFE ELEMENTARY SCHOOL SITE. AS SHOWN ON THIS SHEET.
ELEVATION=5873.87 (NAVD 1988)

T.B.M. #2

A #5 REBAR WITH WASHER STAMPED "NMPS 11184" BEING THE SOUTHWEST PROPERTY CORNER OF TRACT A1-A, A.K.A. GEORGIA O'KEEFE ELEMENTARY SCHOOL SITE AS SHOWN ON THIS SHEET.
ELEVATION=5850.70 (NAVD 1988)

WATER VALVE SHUTOFF PLAN

SCALE: 1" = 400'

WATER VALVE SHUTOFF PLAN NOTES:

- THE FOLLOWING VALVES CAN BE CLOSED TO ISOLATE THE PROPOSED NON-PRESSURE CONNECTION:
 - VALVES # 782, 783 & 784
- WATER AUTHORITY PERSONNEL SHALL PERFORM ALL SHUTOFFS. THE CONTRACTOR SHALL NOT OPERATE ANY VALVES THAT MAY AFFECT SYSTEM OPERATIONS.
- THE CONTRACTOR SHALL REQUEST A WATER SHUTOFF IN WRITING, AND BY TELEPHONE AT 857-8200. A MINIMUM OF SEVEN (7) DAYS IN ADVANCE PER STANDARD CITY OF ALBUQUERQUE PROCEDURES.
- WITHIN FIVE (5) DAYS AFTER RECEIPT OF CONTRACTOR'S SHUTOFF REQUEST, TRIAL SHUTOFFS WILL BE CONDUCTED. THE WATER AUTHORITY TO FURNISH LABOR AND APPURTENANCES NECESSARY TO VERIFY COMPLETENESS OF SHUTOFFS.
- THE CONTRACTOR SHALL HAVE ALL FITTINGS, MATERIALS AND EQUIPMENT ON SITE PRIOR TO VALVE SHUTOFF. ALL EXCAVATION SHALL BE COMPLETE EXCEPT AS NECESSARY TO MAINTAIN SAFE SYSTEM OPERATION WHILE UNDER PRESSURE.
- THE CONTRACTOR SHALL PROVIDE ALL RESTRAINTS AND THRUST BLOCKS NECESSARY TO EFFECT ALL NECESSARY SHUTOFFS AND CONNECTIONS.
- EXISTING WATER VALVE AND WATER LINE INFORMATION OBTAINED FROM CITY OF ALBUQUERQUE AUTOMATED WATER DISTRIBUTION SYSTEM SECTIONAL MAPS, MAP GRID E-22, 3/22/2002.
- AT THE TIME OF WATER SHUTOFF APPLICATION, THE CONTRACTOR SHALL REQUEST THAT THE WATER AUTHORITY NOTIFY ALL AFFECTED PROPERTY OWNERS AT LEAST TWENTY-FOUR (24) HOURS IN ADVANCE OF THE RESPECTIVE SHUTOFFS.
- ALL VALVES REFERENCED ABOVE, ALSO SHOWN ON SITE PLAN AT LEFT AT A LARGER SCALE FOR CLARITY.

NEATLY SAWCUT, REMOVE AND DISPOSE OF EXISTING ASPHALT PAVING. APPLY EMULSIFIED ASPHALT TACK COAT PRIOR TO PATCHING CUT, TYPICAL.

ASPHALTIC CONCRETE PAVEMENT PER COA STD DWG 2485 (ON STREET). RESIDENTIAL TYPE "B" FULL DEPTH TRENCH BACKFILL COMPACTED @ 95% A.S.T.M. D-1557, MIN. 8" MAX LIFTS

HIGH MESA Consulting Group
6010-8 MIDWAY PARK BLVD. NE • ALBUQUERQUE, NEW MEXICO 87109
PHONE: 505.345.4250 • FAX: 505.345.4254 • www.highmesacg.com
2008.035.3.5

CITY OF ALBUQUERQUE
PARKS AND GENERAL SERVICES
DESIGN & DEVELOPMENT DIVISION

TITLE: OVERALL WATER LINE PLAN, WATER VALVE SHUTOFF PLAN
PUBLIC WATER LINE EXTENSION
GEORGIA O'KEEFE ELEMENTARY SCHOOL

Design Review Committee APPROVED FEB 17 2009 DESIGN REVIEW COMMITTEE	City Engineer Approval APPROVED MAR 09 2009 CITY ENGINEER	City Project No. 793482	Zone Map No. E-22	Sheet 2	Of 3
---	--	----------------------------	----------------------	------------	---------

AS BUILT INFORMATION	CONTRACTOR	DATE
8/1/2009	8/1/2009	8/1/2009
AS BUILT INFORMATION	CONTRACTOR	DATE
8/1/2009	8/1/2009	8/1/2009
WATER LINE CONSTRUCTION NOTES:

- | CONTRACT INFORMATION | | GENERAL REMARKS | | AS BUILT INFORMATION | |
|----------------------|------------------|-----------------|---|---|---|
| NO. | BY | DATE | DESCRIPTION | CONTRACTOR | DATE |
| 71839 | HMC6, NMP5 11184 | 01-2008 | ACS 3 1/4" ALUMINUM DISK STAMPED "3-E22A" SET FLUSH IN THE CONCRETE OF THE MEDIAN NOSE AT THE NORTH SIDE OF THE INTERSECTION OF LOWELL STREET N.E. AND SAN VICTORIO AVENUE N.E. ELEVATION = 5894.051 FEET (NAVD 1986) | INSPECTOR'S NAME BY
HMC6
FIELD VERIFICATION BY
HMC6
CONTRACTOR'S NAME
HMC6 | DATE
01-2008
DATE
01-2008
DATE
01-2008 |
| | | | | RECORDED BY | DATE |
| | | | | NO. | |
| | | | | MICRO-FILM INFORMATION | |

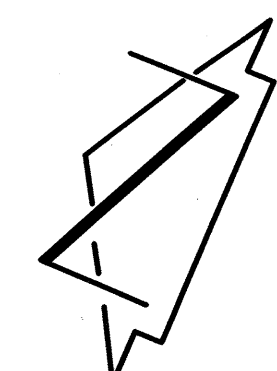

SCALE:
HORIZONTAL: 1" = 20'
VERTICAL: 1" = 5'

△

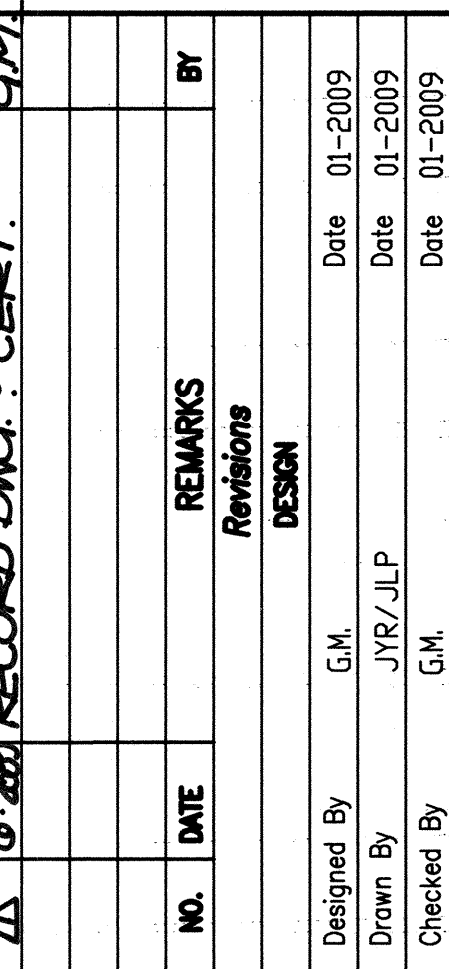

2008.035.35

Last Design Update	Mo./Day/Yr.	Mo./Day/Yr.

Sheet 3 of 3