


SAN MATEO BLVD.


ELEV.
5210'

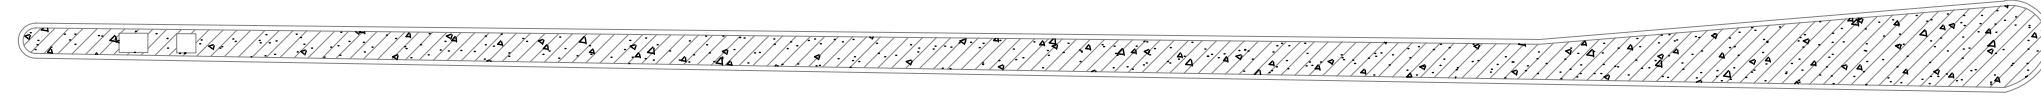

ELEV.
5214'

ORTIZ DR.


ELEV.
5216'

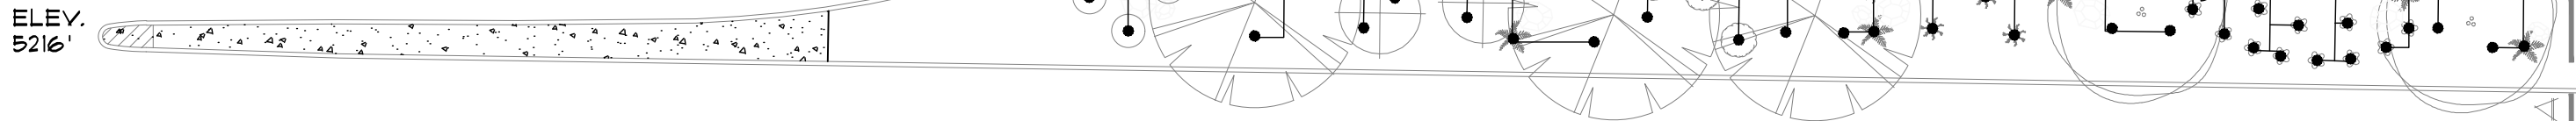

CANDELARIA RD.

MADEIRA

MITCHLINE A

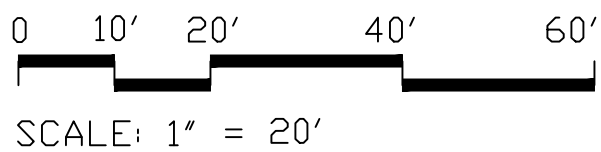

SCALE: 1" = 20'




IRRIGATION LEGEND

- IRRIGATION MAIN LINE, 2", SCH 40 BELL END, SOLVENT WELD PVC. DEPTH OF BURY SHALL BE 28".
- LATERAL PIPING, SCH. 40, BELL END, SOLVENT WELD PVC. DEPTH OF BURY, 18". SIZE PER PLAN.
- ==== MAIN LINE AND LATERAL SLEEVE PIPING, 2 SIZES LARGER THAN PIPE SIZE, CLASS 200, SDR-21, BELL-END, SOLVENT WELD PVC.
- ==== 24-VOLT IRRIGATION WIRE SLEEVE PIPING, 2", CLASS 200, SDR-21, BELL-END, SOLVENT WELD PVC.
- ⊙ REMOTE CONTROL VALVE ASSEMBLY, RAINBIRD FEB PLASTIC BODY 24-VOLT AUTOMATIC VALVE, SIZE PER PLAN, INSTALL PER C.O.A. DRAWING NO. 2703. (SIMILAR - SEE IRRIGATION NOTES #25 AND #26, SHEET 2.)
- ⊙ SOLVENT WELD CAP, SCH. 40 PVC, LINE SIZE.
- ⊙ 1" AIR RELEASE VALVE. INSTALL PER C.O.A. DRAWING NO. 2705.
- PRESSURE COMPENSATING BUBBLER ASSEMBLIES, RAIN BIRD 1400 SERIES, AS FOLLOWS: INSTALL PER C.O.A. DRAWING NUMBERS 2710, 2711, 2711-A AND 2712.
- MODEL NO. GFM FSI
1401 .25 30



AS-BUILT
02/01/10


CITY OF ALBUQUERQUE CAPITAL IMPLEMENTATION PROGRAM DEPARTMENT OF MUNICIPAL DEVELOPMENT					
PROTOTYPE MEDIAN AND INTERSTATE LANDSCAPES FY08-B CANDELARIA: SAN MATEO TO PENNSYLVANIA IRRIGATION PLAN: WORK ORDER # 1					
Design Review Committee	City Engineer Approval	Last Design Update	Mo./Day/Yr.	Mo./Day/Yr.	
City Project No. 794900		Zone Map No. H-18, H-19		Sheet 1 OF 7	

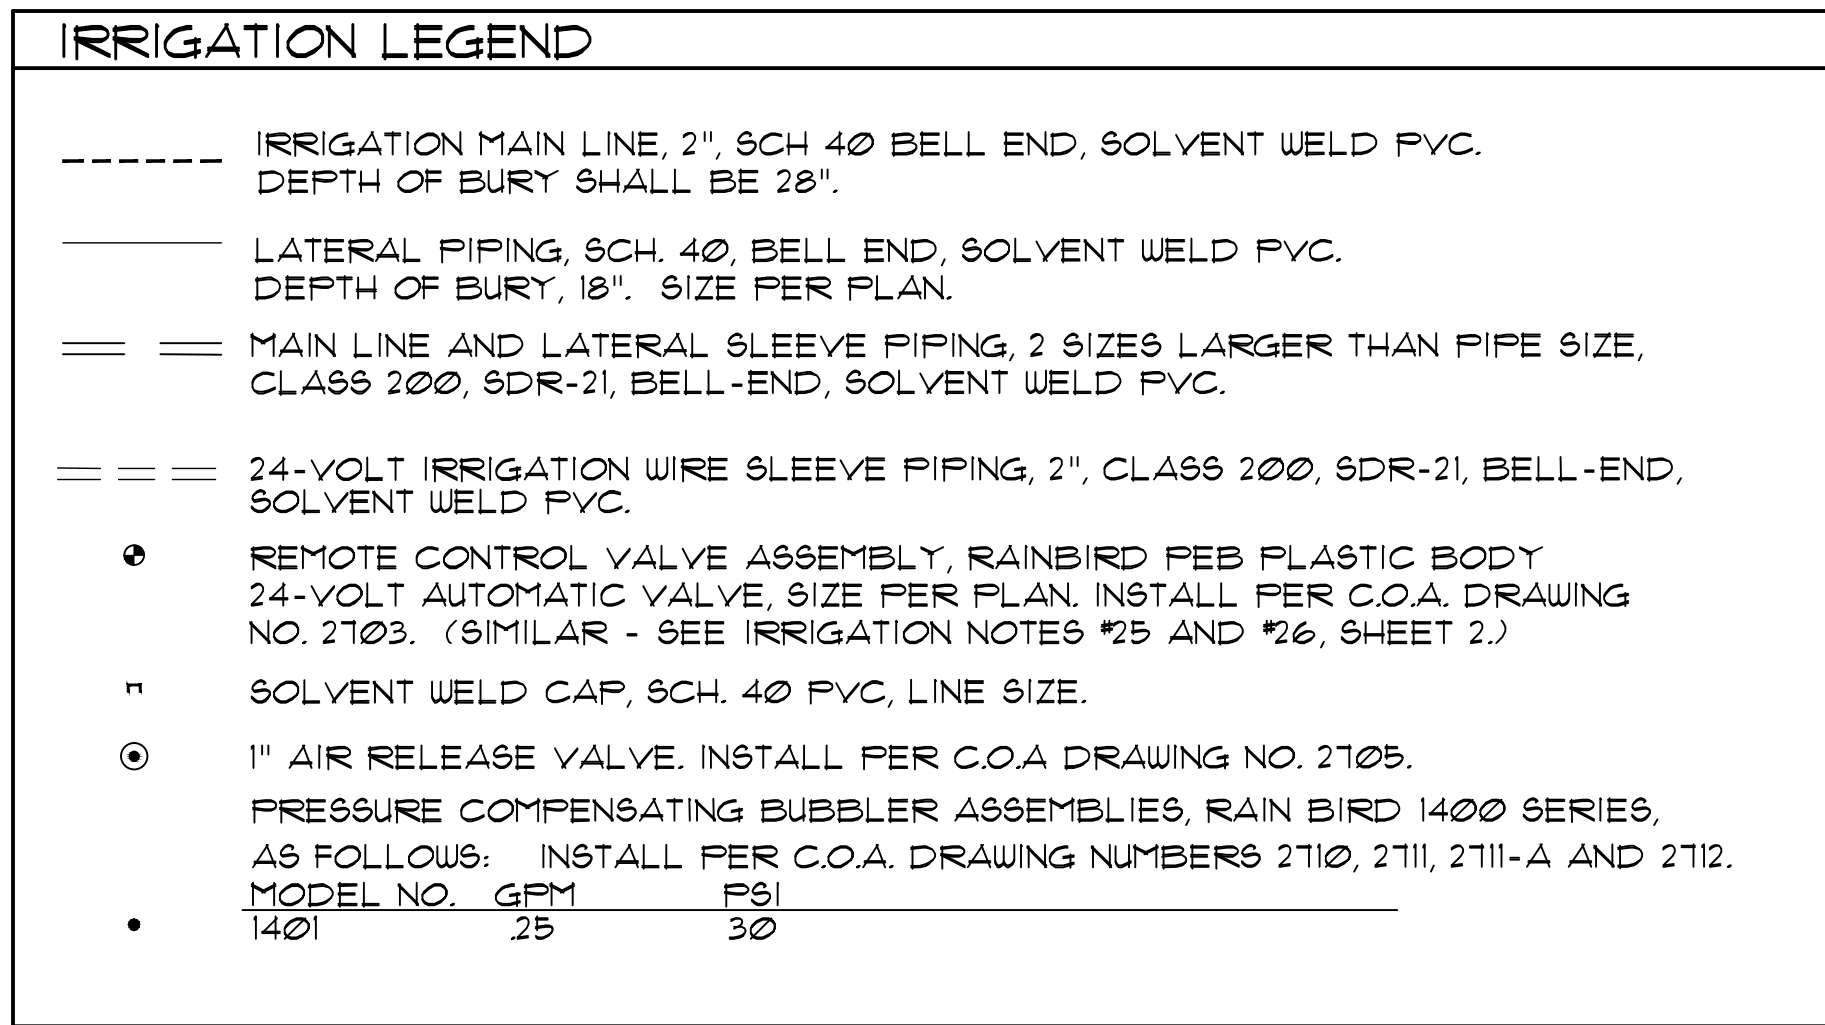

A2	1.5"
37.25-GPM	


AS-BUILT
02/01/10

QUE PROGRAM DEVELOPMENT		LANDSCAPES FY08-B PENNSYLVANIA ORDER # 1	
REVISIONS		ARCHITECTURAL SEAL	
NO. DATE		SURVEY INFORMATION	
REMARKS		FIELD NOTES	
BY		NO. BY DATE	
AS-BUILT INFORMATION		BENCH MARKS	
CONTRACTOR LEE LANDSCAPES, INC		WORK NO. BY DATE	
INSPECTOR'S ACCEPTANCE BY DATE		INSPECTOR'S DATE	
VERIFICATION BY DATE		VERIFICATION BY DATE	
DRAWINGS ML DATE 02/01/10		CORRECTED BY ML DATE 02/01/10	
MICRO-FILM INFORMATION		RECORDED BY DATE	
NO.		NO.	

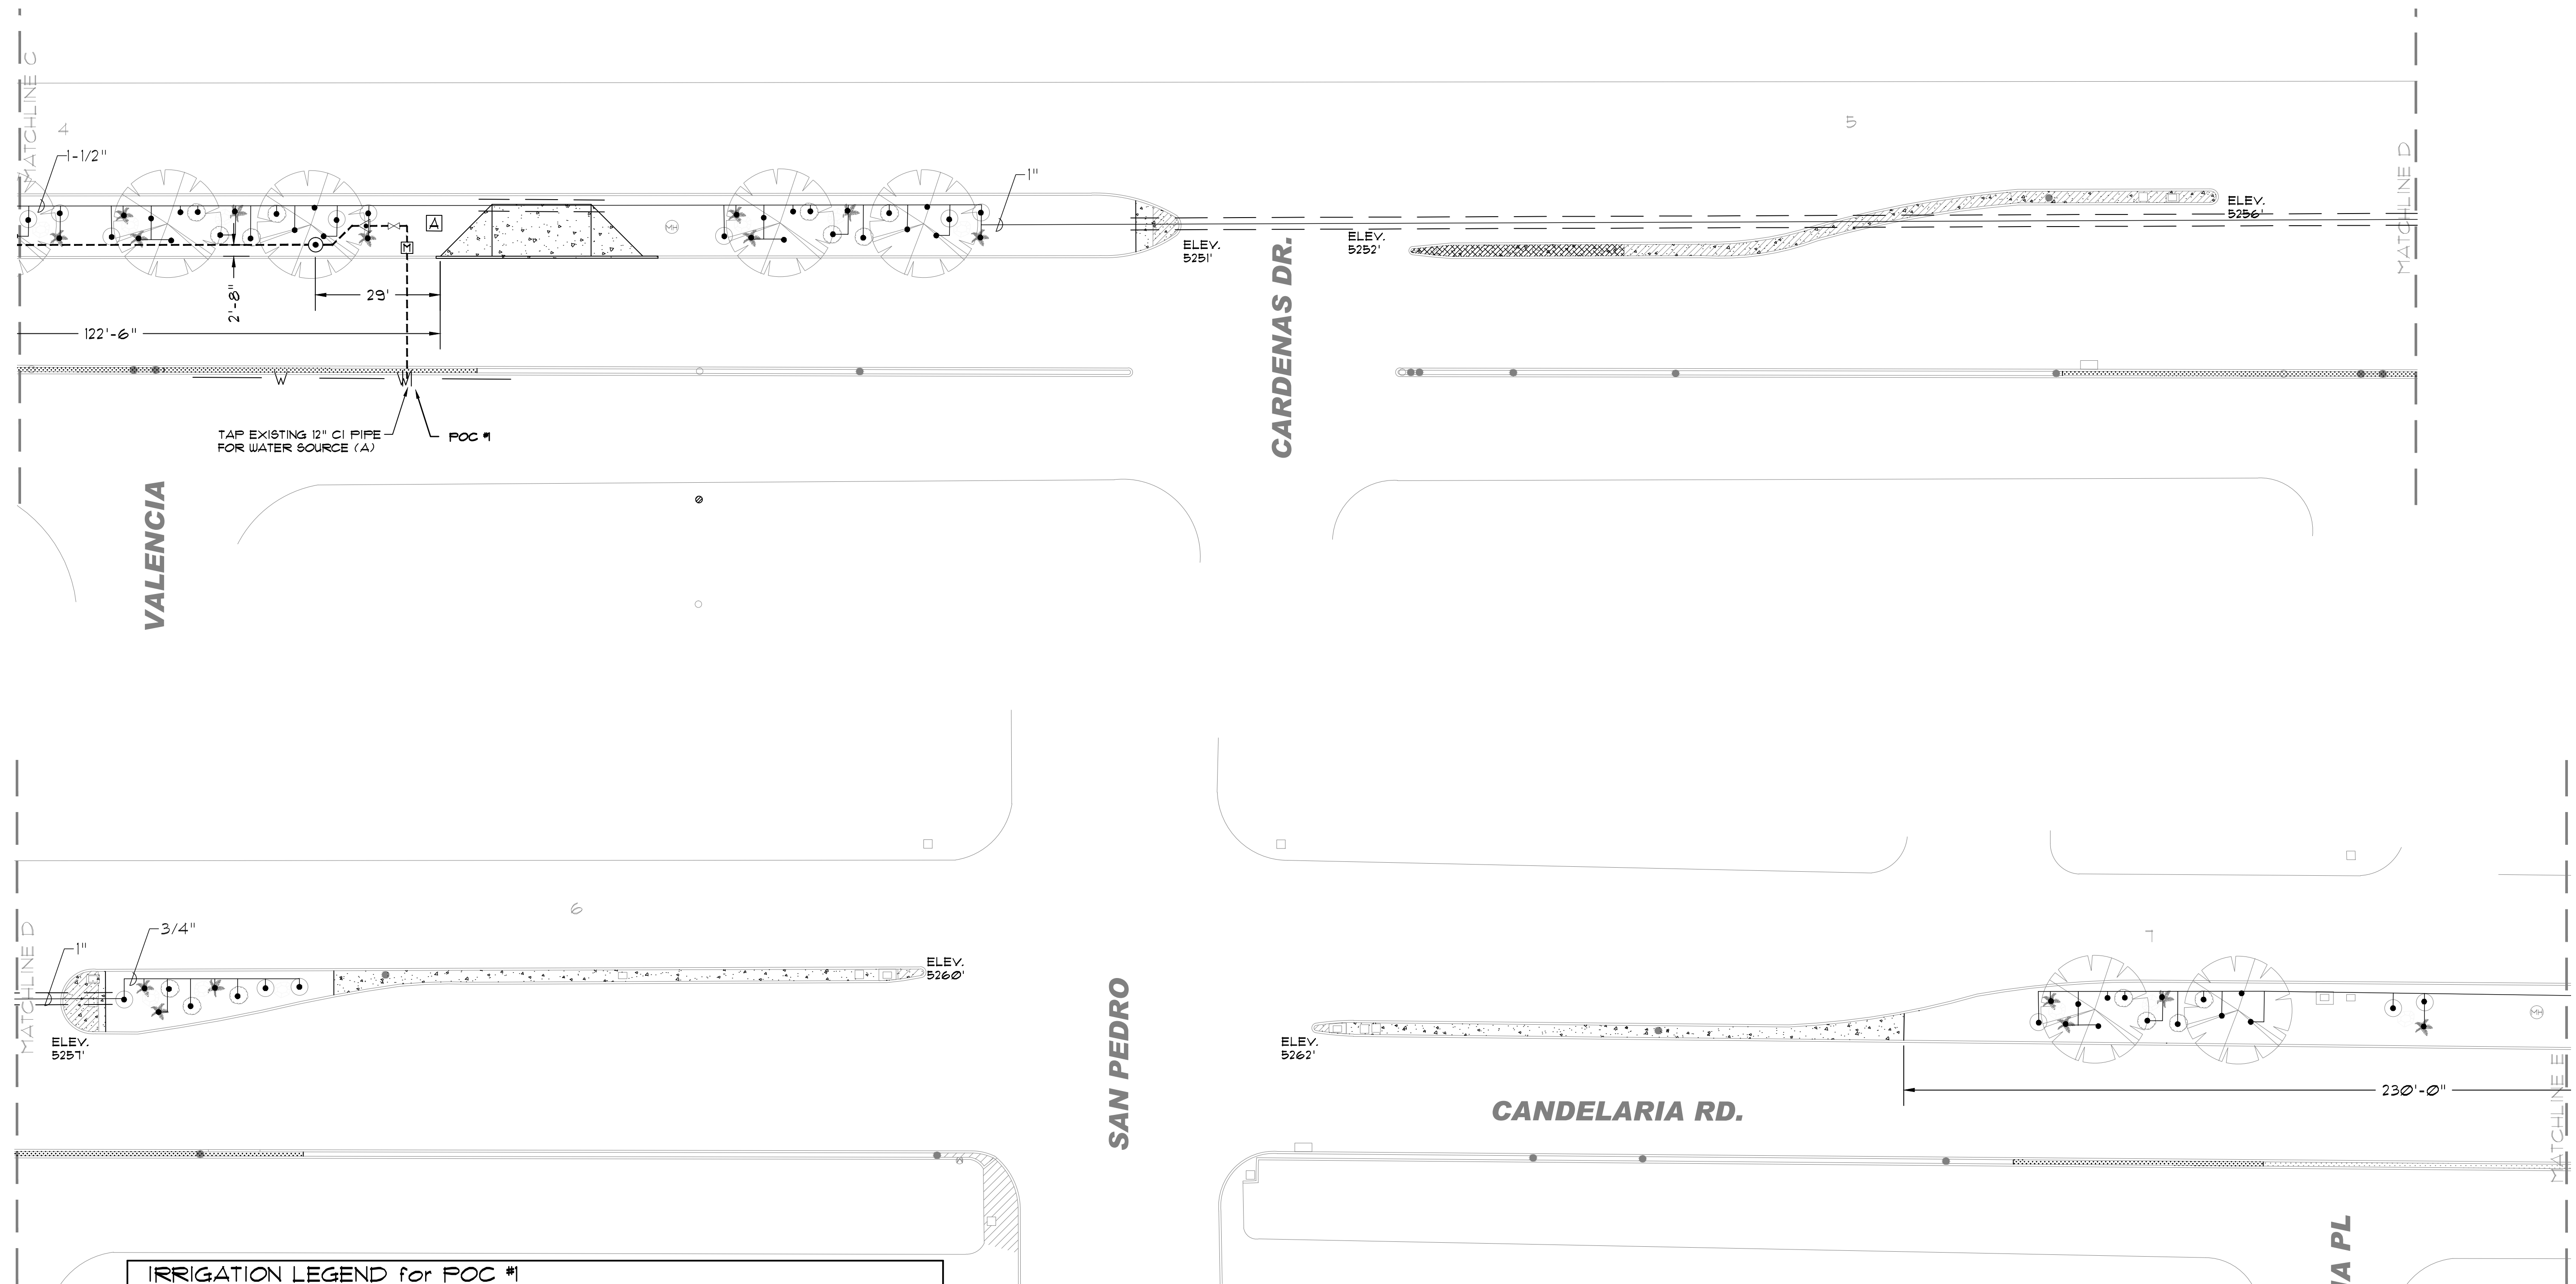

IRRIGATION LEGEND for POC #1

□	WATER METER, 2". INSTALLED PER COA DWG. 2362 OR 2363.
-----	IRRIGATION MAIN LINE, 2", SCH 40 BELL END, SOLVENT WELD PVC. DEPTH OF BURY SHALL BE 28".
-----	LATERAL PIPING, SCH. 40, BELL END, SOLVENT WELD PVC. DEPTH OF BURY, 18". SIZE PER PLAN.
=====	MAIN LINE AND LATERAL SLEEVE PIPING, 2 SIZES LARGER THAN PIPE SIZE, CLASS 200, SDR-21, BELL-END, SOLVENT WELD PVC.
=====	24-VOLT IRRIGATION WIRE SLEEVE PIPING, 2", CLASS 200, SDR-21, BELL-END, SOLVENT WELD PVC.
⊗	ISOLATION VALVE ASSEMBLY, 2". INSTALL PER C.O.A. DRAWING NO. 2107.
⊕	FEBCO 825YA-2" REDUCED PRESSURE PRINCIPAL BACKFLOW PREVENTER AND MASTER VALVE ASSEMBLY WITH BALL VALVES, INSTALLED IN HEATED AND INSULATED ENCLOSURE AND MASTER METER INSTALLED IN VALVE BOX PER DETAIL C/4. SIZE OF RP, MASTER VALVE, AND MASTER METER SHALL BE SAME AS LINE SIZE. ENCLOSURE SHALL BE SIZED TO ACCOMMODATE SIZE OF RP AND MASTER VALVE ASSEMBLY.
⊙	REMOTE CONTROL VALVE ASSEMBLY, RAINBIRD FEB PLASTIC BODY 24-VOLT AUTOMATIC VALVE, SIZE PER PLAN. INSTALL PER C.O.A. DRAWING NO. 2103. (SIMILAR - SEE IRRIGATION NOTES #25 AND #26, SHEET 2.)
⊖	SOLVENT WELD CAP, SCH. 40 PVC, LINE SIZE.
⊙	1" AIR RELEASE VALVE. INSTALL PER C.O.A. DRAWING NO. 2105.
	PRESSURE COMPENSATING BUBBLER ASSEMBLIES, RAIN BIRD 1400 SERIES, AS FOLLOWS: INSTALL PER C.O.A. DRAWING NUMBERS 2110, 2111, 2111-A AND 2112.
•	MODEL NO. GPM FSI 1401 25 30
Ⓐ	IRRINET M AC CONTROLLER.

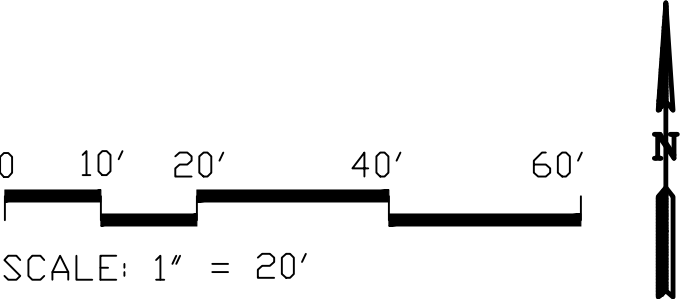


CITY OF ALBUQUERQUE
CAPITAL IMPLEMENTATION PROGRAM
DEPARTMENT OF MUNICIPAL DEVELOPMENT

PROTOTYPE MEDIAN AND INTERSTATE LANDSCAPES FY08-B
CANDELARIA: SAN MATEO TO PENNSYLVANIA
IRRIGATION PLAN: WORK ORDER # 1

Design Review Committee	City Engineer Approval	Last Design Update	Mo./Day/Yr.	Mo./Day/Yr.
City Project No. 794900	Zone Map No. H-18, H-19		Sheet 3 OF 7	


[illegible]

AS-BUILT
02/01/10

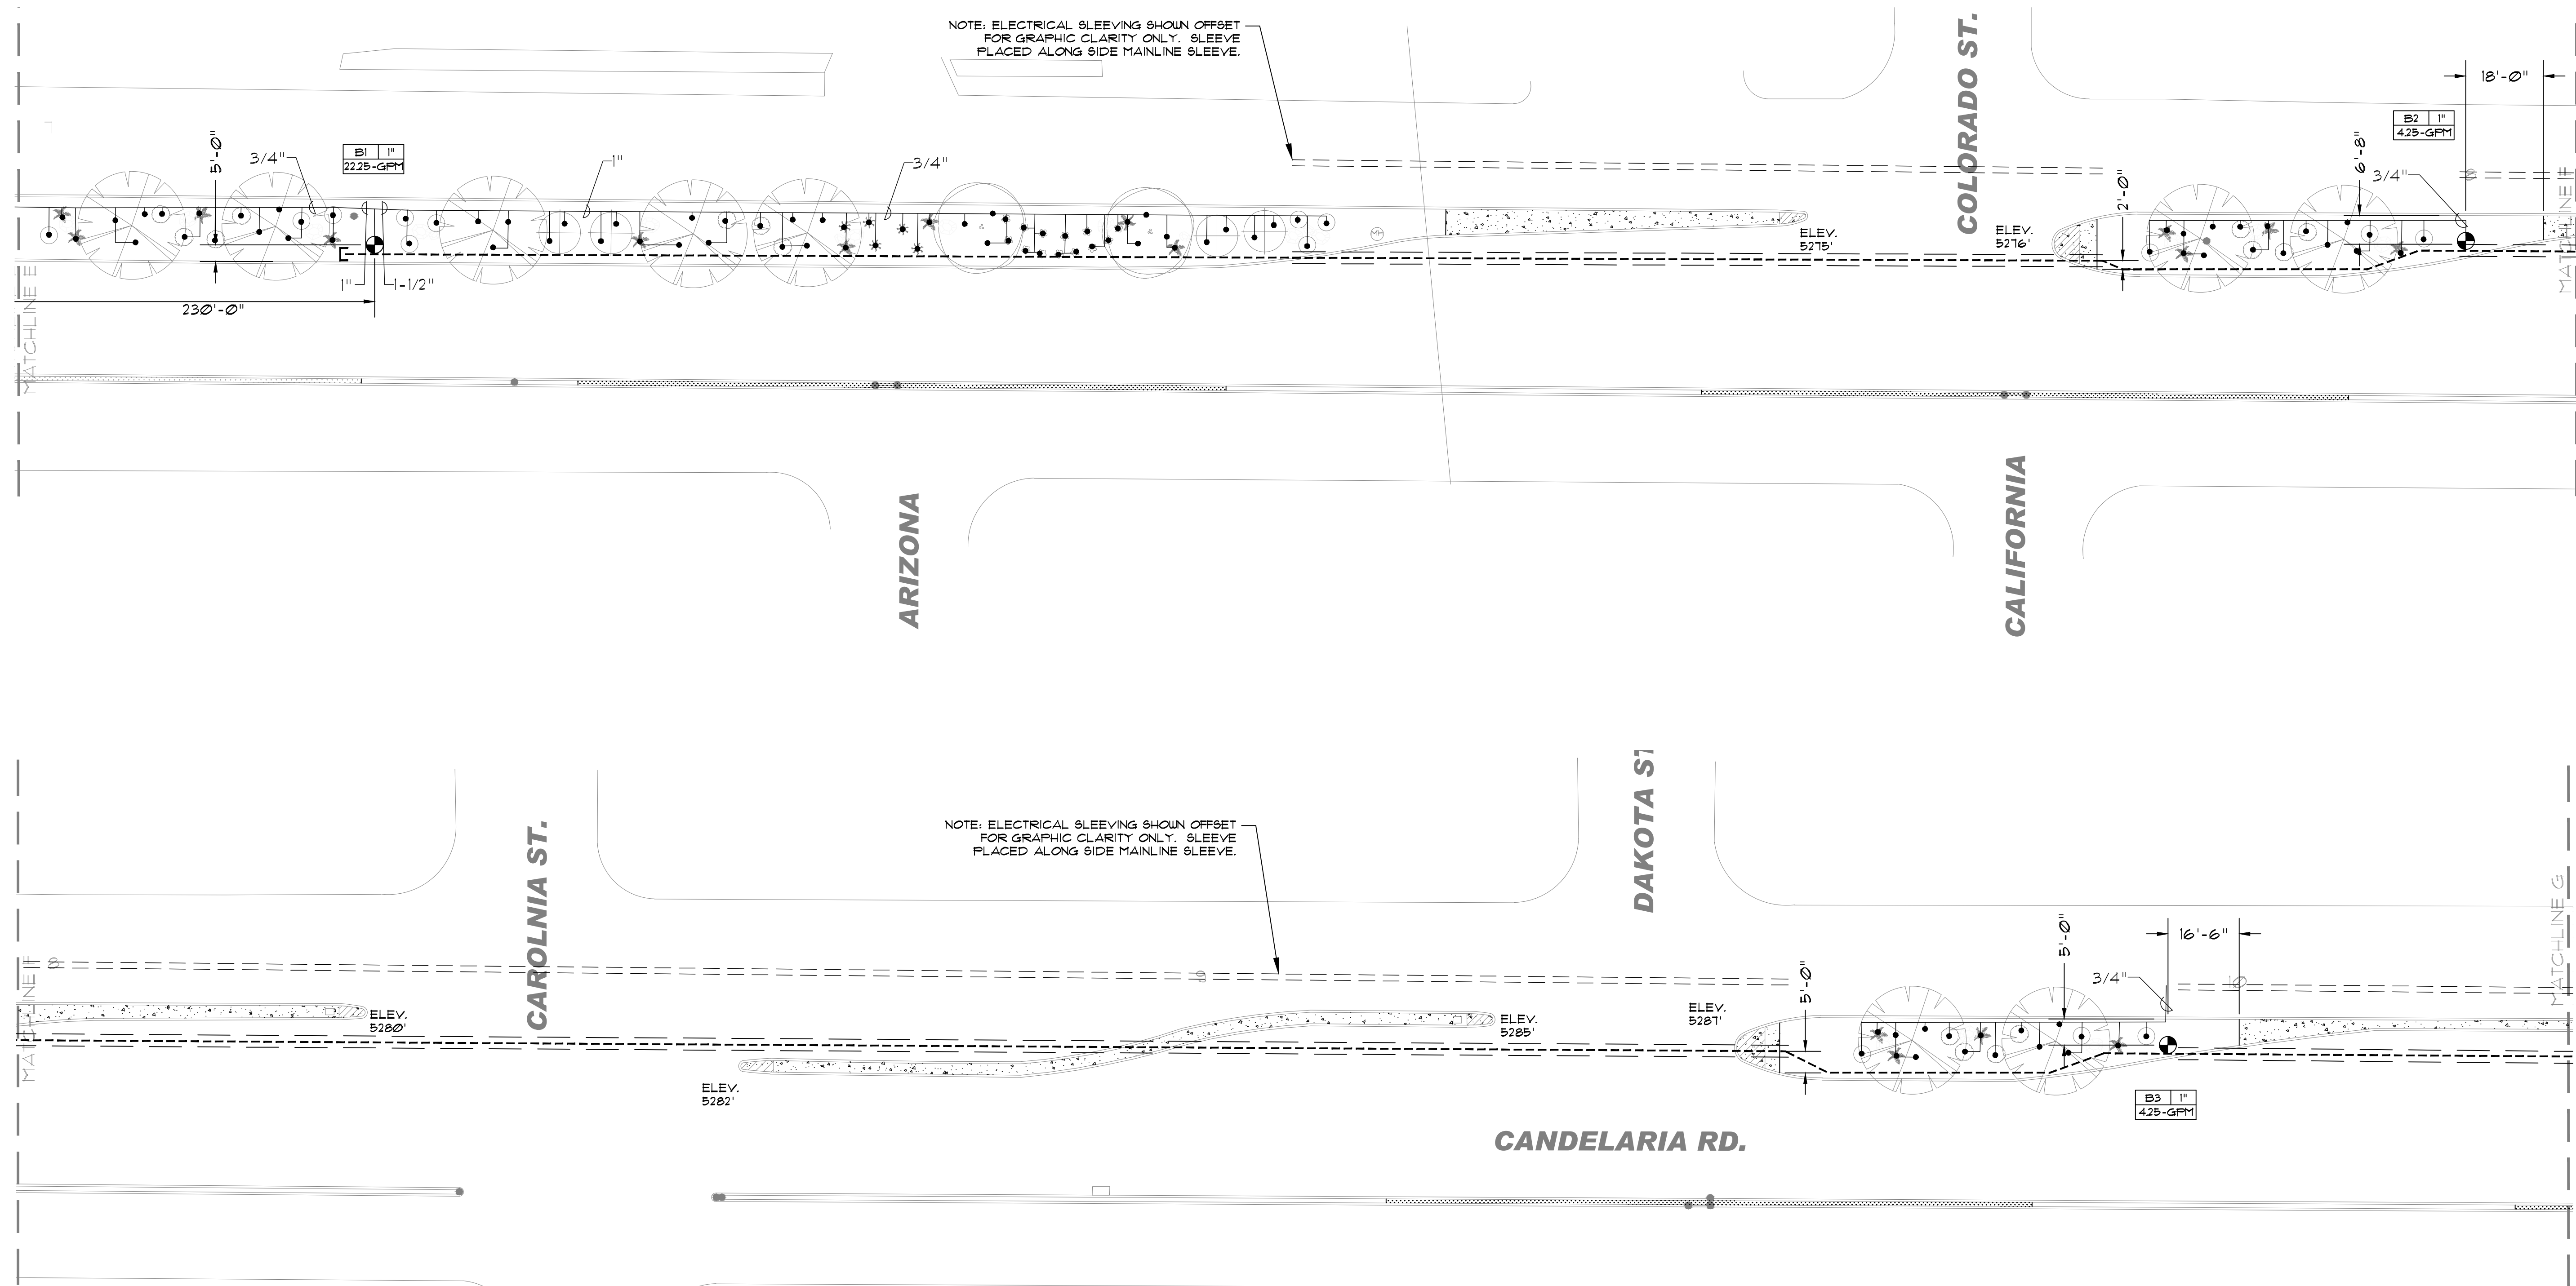

IRRIGATION LEGEND

-----	IRRIGATION MAIN LINE, 2", SCH 40 BELL END, SOLVENT WELD PVC. DEPTH OF BURY SHALL BE 28".
_____	LATERAL PIPING, SCH. 40, BELL END, SOLVENT WELD PVC. DEPTH OF BURY, 18". SIZE PER PLAN.
== ==	MAIN LINE AND LATERAL SLEEVE PIPING, 2 SIZES LARGER THAN PIPE SIZE, CLASS 200, SDR-21, BELL-END, SOLVENT WELD PVC.
== == ==	24-VOLT IRRIGATION WIRE SLEEVE PIPING, 2", CLASS 200, SDR-21, BELL-END, SOLVENT WELD PVC.
⊙	REMOTE CONTROL VALVE ASSEMBLY, RAINBIRD PEB PLASTIC BODY 24-VOLT AUTOMATIC VALVE, SIZE PER PLAN. INSTALL PER C.O.A. DRAWING NO. 2103. (SIMILAR - SEE IRRIGATION NOTES #25 AND #26, SHEET 2.)
⌞	SOLVENT WELD CAP, SCH. 40 PVC, LINE SIZE.
⊙	1" AIR RELEASE VALVE. INSTALL PER C.O.A. DRAWING NO. 2105. PRESSURE COMPENSATING BUBBLER ASSEMBLIES, RAIN BIRD 1400 SERIES, AS FOLLOWS: INSTALL PER C.O.A. DRAWING NUMBERS 2110, 2111, 2111-A AND 2112. MODEL NO. GFM PSI 1401 .25 30

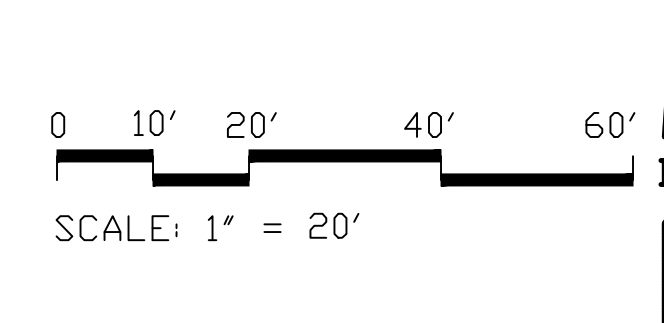

AS-BUILT
02/01/10



CITY OF ALBUQUERQUE CAPITAL IMPLEMENTATION PROGRAM DEPARTMENT OF MUNICIPAL DEVELOPMENT			
PROTOTYPE MEDIAN AND INTERSTATE LANDSCAPES FY08-B CANDELARIA: SAN MATEO TO PENNSYLVANIA IRRIGATION PLAN: WORK ORDER # 1			
Design Review Committee	City Engineer Approval	Last Design Update	Mo./Day/Yr.
City Project No. 794900	Zone Map No. H-18, H-19		Sheet 4 OF 7

[illegible]

