
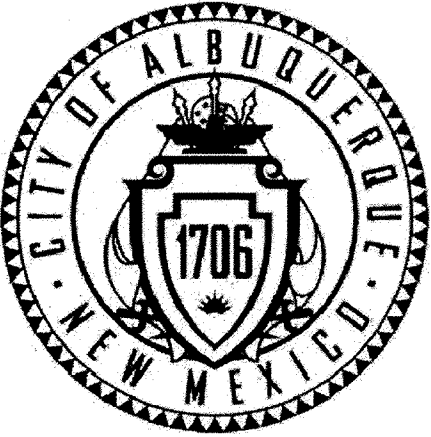


CITY OF ALBUQUERQUE
DEPARTMENT OF MUNICIPAL DEVELOPMENT

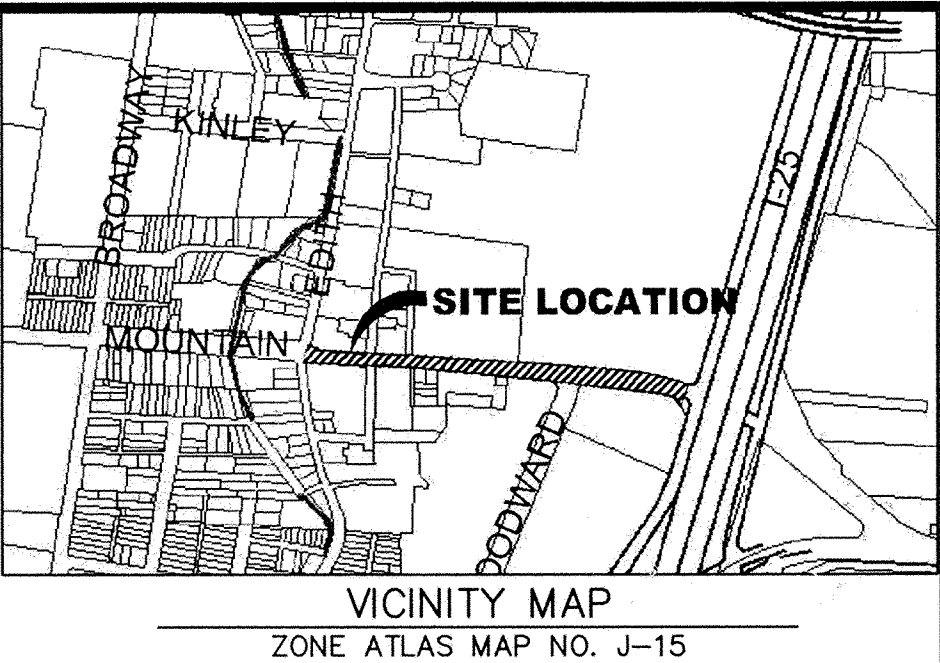


CONSTRUCTION PLANS
FOR
MOUNTAIN RD
SD IMPROVEMENTS

INDEX


DESCRIPTION	SHEET NO.
COVER SHEET	1
GENERAL NOTES	2
POTHOLE PLAN	3
DEMOLITION PLAN	4
HORIZONTAL CONTROL PLAN	5
MOUNTAIN RD STORM DRAIN PLAN & PROFILE STA 10+00 TO 14+00	6
MOUNTAIN RD STORM DRAIN PLAN & PROFILE STA 14+00 TO 18+00	7
MOUNTAIN RD STORM DRAIN PLAN & PROFILE STA 18+00 TO 22+00	8
MOUNTAIN RD STORM DRAIN PLAN & PROFILE STA 22+00 TO 26+00	9
MOUNTAIN RD STREET PLAN & PROFILE STA 10+00 TO 14+00	10
MOUNTAIN RD STREET PLAN & PROFILE STA 14+00 TO 18+00	11
MOUNTAIN RD STREET PLAN & PROFILE STA 18+00 TO 22+00	12
MOUNTAIN RD STREET PLAN & PROFILE STA 22+00 TO 26+00	13
SAS RELOCATION SITE PLAN	14
MOUNTAIN RD/WALTER ST SEWER RELOCATION PLAN & PROFILE STA 10+00 TO 13+67.68	15
SAS RELOCATION MANHOLE DETAILS	16
STRIPING PLAN	17
DETAILS	18

I, THE UNDERSIGNED, A REGISTERED PROFESSIONAL ENGINEER IN THE STATE OF NEW MEXICO, DO HEREBY CERTIFY THAT THE INDICATED RECORD DRAWINGS ARE BASED UPON INFORMATION PROVIDED BY THE CONSTRUCTION CONTRACTOR IN THE FORM OF RED-LINED CONSTRUCTION DRAWING MARKUPS TO THE ORIGINAL DESIGN DRAWINGS. THE TRANSFER OF INFORMATION HEREIN IS TRUE AND CORRECT TO THE BEST OF MY KNOWLEDGE AND BELIEF. HOWEVER, I HAVE NOT VERIFIED THE ACCURACY AND/OR COMPLETENESS OF THE INFORMATION PROVIDED BY THE CONSTRUCTION CONTRACTOR AND SHALL NOT BE RESPONSIBLE FOR ERRORS OR OMISSIONS THAT MAY BE INCORPORATED AS A RESULT OF ERRONEOUS INFORMATION PROVIDED BY OTHERS. ALL INFORMATION INCLUDING VERTICAL AND HORIZONTAL DIMENSIONS SHOULD BE FIELD VERIFIED PRIOR TO USE ON FUTURE PROJECTS.

NAME Tyler Doherty DATE 3-16-11

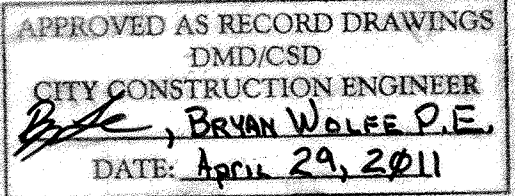


RECORD DRAWING
DATE 8/10

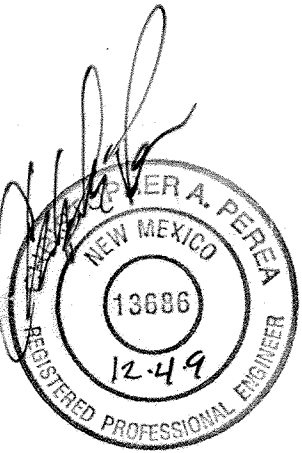

APPROVED FOR RECORD DRAWINGS

Auto Mat 5-2-11
WATER AUTHORITY ENGINEER DATE

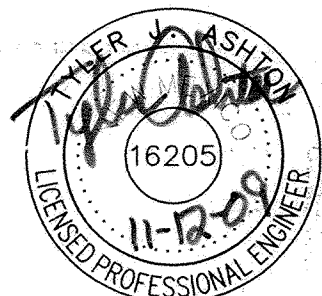△	2, 4, 6, 7, 10, 16, 18	REV	DATE	USER	DATE				
REV	SHEETS	CITY ENGINEER	DATE	USER	DEPARTMENT	DATE	USER	DEPARTMENT	DATE
ENGINEERS STAMP & SIGNATURE			APPROVALS	ENGINEER	DATE	*****			
			DRC Chairman	<i>A. Campbell</i>	11-13-09	APPROVED FOR CONSTRUCTION			
			Transportation	<i>A. Campbell</i>	11-13-09				
			Water/Wastewater	<i>A. Campbell</i>	11-13-09				
			Hydrology	<i>A. Campbell</i>	11-13-09				
			Parks	<i>A. Campbell</i>	11-13-09				
			Constr. Mngmt.	<i>A. Campbell</i>	11-13-09				
			Constr. Coord.	<i>A. Campbell</i>	11-13-09				
City Project No.			7963.93			Sheet 1 Of 18			

WILSON & COMPANY

4900 LANG AVE N.E.
SUITE 100
ALBUQUERQUE, NEW MEXICO 87109
(505) 348-4000
FAX (505) 348-4072
www.wilsonco.com

WCEA FILE NO. 0960002200

Addendum #1

GENERAL NOTES:

1. ALL WORK DETAILED ON THESE PLANS TO BE PERFORMED UNDER THIS CONTRACT SHALL, EXCEPT AS OTHERWISE STATED OR PROVIDED HEREON, BE CONSTRUCTED IN ACCORDANCE WITH THE CITY OF ALBUQUERQUE STANDARD SPECIFICATIONS FOR PUBLIC WORKS CONSTRUCTION, 1986 EDITION, AS AMENDED THROUGH UPDATE NO. 7 AND AMENDMENT NO. 1 DATED 08/19/2005.
2. THE CONTRACTOR SHALL PROVIDE INGRESS AND EGRESS TO LOCAL BUSINESSES AND RESIDENCES FOR THE DURATION OF THE PROJECT. THE CONTRACTOR SHALL ADVISE OF AND SCHEDULE ACCESS CLOSURES, AT LEAST 24 HOURS IN ADVANCE, WITH PROPERTY OWNERS AND THE CONSTRUCTION PROJECT MANAGER.
3. SEVEN (7) WORKING DAYS PRIOR TO BEGINNING CONSTRUCTION THE CONTRACTOR SHALL SUBMIT TO THE CONSTRUCTION COORDINATION DIVISION A DETAILED CONSTRUCTION SCHEDULE. TWO (2) WORKING DAYS PRIOR TO CONSTRUCTION THE CONTRACTOR SHALL OBTAIN A BARRICADING PERMIT FROM THE CONSTRUCTION COORDINATION DIVISION. CONTRACTOR SHALL NOTIFY BARRICADE ENGINEER (924-3400) PRIOR TO OCCUPYING AN INTERSECTION. REFER TO SECTION 19 OF THE GENERAL CONDITIONS OF THE STANDARD SPECIFICATIONS.
4. TWO (2) WORKING DAYS PRIOR TO ANY EXCAVATION, CONTRACTOR MUST CONTACT N.M. ONE-CALL SYSTEM, (505) 260-1990, FOR LOCATION OF EXISTING UTILITIES.
5. ALL STREET STRIPING ALTERED OR DESTROYED SHALL BE REPLACED WITH PLASTIC REFLECTORIZED PAVEMENT MARKINGS BY CONTRACTOR TO LOCATION AS EXISTING, OR AS INDICATED BY THIS PLAN SET.
6. CRITICAL INTERSECTION WORK SHALL NOT START UNTIL THE CONTRACTOR HAS ALL MATERIAL, EQUIPMENT, AND NECESSARY PERSONNEL ON-SITE. TRAFFIC CONTROL DEVICES SHALL NOT BE PLACED PREMATURELY.
7. PARKING OF CONSTRUCTION VEHICLES ON PRIVATE PROPERTY IS THE SOLE RESPONSIBILITY OF THE CONTRACTOR AND IS PROHIBITED WITHIN THE CLEAR ZONE DAY OR NIGHT.
8. THE CONSTRUCTION CLEAR ZONE FOR THIS PROJECT IS 16 FEET FROM THE EDGE OF DRIVING LANE. THE CONTRACTOR SHALL NOT STORE EQUIPMENT OR MATERIAL WITHIN THE CONSTRUCTION CLEAR ZONE UNLESS THE EQUIPMENT OR MATERIAL IS PROPERLY SHIELDED UTILIZING CURRENT SAFETY DESIGN AND INSTALLATION METHODS. THE SAFETY DESIGN FOR SHIELDING SHALL BE PROVIDED BY THE CONTRACTOR AND MUST BE APPROVED BY THE PROJECT MANAGER BEFORE IMPLEMENTING. THIS WORK, INCLUDING DESIGN, INSTALLATION, AND REMOVAL OF THE SHIELDING, SHALL BE CONSIDERED INCIDENTAL TO THE COMPLETION OF THE PROJECT AND NO ADDITIONAL PAYMENT WILL BE MADE.
9. THE CONTRACTOR SHALL NOTIFY THE ALBUQUERQUE TRAFFIC ENGINEERING DIVISION (857-8680) AND TONY ABBO, NMDOT DISTRICT 3 TRAFFIC ENGINEER (841-2700) THREE (3) WORKING DAYS IN ADVANCE OF ANY WORK REQUIRED REGARDING ALL EXISTING REGULATORY SIGNS AND SIGNALS THAT NEED TO BE REMOVED, RELOCATED, OR REINSTALLED.
10. THE CONTRACTOR WILL BE REQUIRED TO CONFINE THEIR WORK WITHIN THE CONSTRUCTION LIMITS AND/OR RIGHT OF WAY TO PRESERVE EXISTING VEGETATION AND PRIVATE PROPERTY. OVERNIGHT PARKING OF CONSTRUCTION EQUIPMENT SHALL NOT OBSTRUCT DRIVEWAY OPENINGS OR DESIGNATED TRAFFIC LANES.
11. IT SHALL BE THE CONTRACTOR'S RESPONSIBILITY TO ENSURE THAT BUILDING STRUCTURES ADJACENT TO THE PROJECT NOT BE DAMAGED DUE TO ANY CONSTRUCTION ACTIVITIES. DAMAGE CAUSED TO ANY BUILDING STRUCTURE WILL BE THE SOLE RESPONSIBILITY OF THE CONTRACTOR, INCLUDING ALL COSTS INCURRED IN RESTORING/REPAIRING SAID DAMAGE.
12. THE CONTRACTOR SHALL SUBMIT A PROPOSED WORK PLAN FOR PEDESTRIAN IMPROVEMENTS TO THE PROJECT MANAGER FOR REVIEW AND APPROVAL PRIOR TO INITIATING ANY WORK AFFECTING PEDESTRIANS. THIS PLAN SHALL INCLUDE THE METHOD PROPOSED TO MAINTAIN PEDESTRIAN ACCESS TO BUSINESSES, SCHOOLS, HOSPITALS, BUILDINGS, ETC. THROUGHOUT THE PEDESTRIAN IMPROVEMENTS CONSTRUCTION IN PARTICULAR. THE CONTRACTOR, AT MINIMUM, SHALL MAINTAIN A 36" CLEAR PATH FOR PEDESTRIANS SO AS TO MEET ADA ACCESSIBILITY REQUIREMENTS.
13. THE CONTRACTOR SHALL MAINTAIN AN UP TO DATE SET OF AS-BUILT PLANS FOR THE PROJECT. THESE PLANS SHALL BE KEPT CURRENT, WITHIN TWO WEEKS, AT ALL TIMES AND SHALL BE SUBJECT TO REVIEW BY THE PROJECT MANAGER. THE FINAL AS-BUILT PLANS SHALL BE SUBMITTED TO THE PROJECT MANAGER AND THE CITY.
14. CONTRACTOR SHALL OBTAIN A TRAFFIC CONTROL PERMIT FROM NMDOT DISTRICT 3 PRIOR TO BEGINNING ANY WORK. CALL 841-2700 FOR PERMIT APPLICATION FOR ANY WORK IN 1-25 RIGHT OF WAY.
15. MANHOLE RIM ELEVATIONS SHOWN ON THESE PLANS ARE APPROXIMATE AND WILL VARY WITH THE FINISHED PAVEMENT ELEVATIONS.
16. ALL RADII OF CURB RETURNS ARE SHOWN TO THE FACE OF CURB AND, UNLESS OTHERWISE NOTED, ALL OFFSETS AND DIMENSIONS ARE TO THE FACE OF CURB. MATCH FLOWLINES OF GUTTERS WHEN CONNECTING NEW CURB AND GUTTER WITH EXISTING CURB AND GUTTER.
17. EXACT LOCATION OF DRIVEPADS AND WHEELCHAIR RAMPS WILL BE DETERMINED IN THE FIELD BY THE FIELD ENGINEER. LOCATIONS SHOWN ON PLAN AND PROFILE SHEETS ARE APPROXIMATE.
18. WHERE PULL BOXES ABOUT THE BACK OF CURB OR ARE LOCATED IN A CONCRETE PAVED AREA, PROVIDE 3/4" EXPANSION MATERIAL AROUND THE PULL BOX. ALL PULL BOXES TO BE FLUSH WITH SURFACE OF CONCRETE.
19. WHEN ABUTTING NEW PAVEMENT TO EXISTING, CONTRACTOR SHALL SAW CUT, TO FULL PAVEMENT DEPTH, THE EXISTING PAVEMENT TO A NEAT VERTICAL STRAIGHT LINE AS REQUIRED TO REMOVE ANY BROKEN OR CRACKED PAVEMENT AND MATCH NEW TO EXISTING.
20. THE CONTRACTOR SHALL VERIFY ALL EXISTING FIRE HYDRANT FLANGES, PADS, VALVE BOXES, MANHOLE RIMS AND TOP OF PIPE ELEVATIONS IN THE FIELD. ELEVATIONS SHALL BE ADJUSTED TO COMPLY WITH THE REQUIREMENTS OF THE STANDARD CITY DETAILS.
21. WHEN APPEARING IN ANY PORTION OF THIS CONTRACT, THE WORDS "PLANT MIX BITUMINOUS PAVEMENT" (PMBP) WILL HAVE THE SAME MEANING AS AND MAY BE USED INTERCHANGEABLY WITH THE WORDS "ASPHALT CONCRETE".
22. THE CONTRACTOR SHALL WARP SLOPES WHERE NECESSARY TO STAY WITHIN THE RIGHT OF WAY OR CONSTRUCTION EASEMENT LIMITS. THE WORK SHALL BE AS DIRECTED BY THE PROJECT MANAGER.
23. THE SUBGRADE PREP SHALL EXTEND ONE (1) FOOT BEYOND THE BACK OF CURB.
24. THE CONTRACTOR SHALL ASSUME RESPONSIBILITY FOR ANY DAMAGE TO EXISTING PAVEMENTS, PAVEMENT MARKINGS, CURB AND GUTTER, DRIVEPADS, HANDICAP RAMPS, AND SIDEWALK DURING CONSTRUCTION APART FROM THOSE SECTIONS INDICATED FOR REMOVAL ON THE PLANS, AND SHALL REMOVE AND REPLACE AS PER COA STANDARDS, AS APPLICABLE, AT THEIR OWN EXPENSE.
25. WHEN REMOVAL OF EXISTING CURB AND GUTTER OR SIDEWALK IS REQUIRED, REMOVE TO NEAREST JOINT.
26. ALL CONSTRUCTION DEBRIS, SPOIL AND NON-SALVAGEABLE ITEMS BECOME THE PROPERTY OF THE CONTRACTOR AND PROPER DISPOSAL OF THESE ITEMS IS THE RESPONSIBILITY OF THE CONTRACTOR. ANY HAUL COSTS ASSOCIATED WITH THIS WORK IS CONSIDERED INCIDENTAL TO THE PROJECT.
27. ALL VALLEY GUTTERS ARE 6' WIDE UNLESS OTHERWISE NOTED.
28. ALL FINISHED GRADES AND PROFILES SHOWN ARE FLOWLINE GRADES, UNLESS OTHERWISE NOTED.
29. CURB AND GUTTER SHOWN AS EXISTING AND NOT TO BE REMOVED UNDER THIS CONTRACT WHICH IS DAMAGED OR DISPLACED BY THE CONTRACTOR SHALL BE REMOVED AND REPLACED PER STD DWG 2415A BY THE CONTRACTOR AT HIS EXPENSE.
30. ONLY ABCWUA HAS THE AUTHORITY TO OPERATE VALVES.
31. ALL TRENCH EXCAVATION BACKFILL WITHIN THE ROADWAY PRISM SHALL BE COMPACTED TO 95% OF THE MODIFIED PROCTOR PER COA STANDARDS, SECTION 701.
32. ANY EARTHWORK HAUL ON THIS PROJECT WILL BE CONSIDERED AS INCIDENTAL TO THE PROJECT AND NO SEPARATE PAYMENT WILL BE MADE THEREFOR.
33. STRUCTURAL FILL FOR EMBANKMENTS, PAVEMENTS, AND STRUCTURES SHALL BE PLACED IN LIFTS THAT, FOLLOWING COMPACTION, DO NOT EXCEED 8". FILLS SHALL BE COMPACTED AT MOISTURE CONTENTS WITHIN +/- 2% OF OPTIMUM MOISTURE CONTENT. SELECT STRUCTURAL FILL AROUND CULVERTS AND OTHER STRUCTURES SHOULD BE COMPACTED, USING HAND OPERATED COMPACTION EQUIPMENT AND IN LIFTS NOT EXCEEDING 4", TO THE DENSITY AND MOISTURE CONTENT SPECIFIED ABOVE. THE UPPER 12" OF ROADBEDS SHALL BE COMPACTED TO 95% OF MAXIMUM DRY DENSITY (ASTM 1557).


34. ALL EXISTING UTILITIES SHOWN HEREIN WERE TAKEN FROM RECORD DRAWINGS, FIELD SURVEYS, C.O.A. SYSTEMS UTILITIES MAPS AND INFORMATION PROVIDED BY THE UTILITY OWNERS AND ARE APPROXIMATE. IT WILL BE CONTRACTORS RESPONSIBILITY TO FIELD VERIFY HORIZONTAL AND VERTICAL LOCATIONS AND TYPE OF EXISTING UTILITIES TO BE ADJUSTED OR EXTENDED AND TO PROVIDE PROTECTION FOR ALL UTILITIES WITHIN THE CONSTRUCTION AREA. THE CONTRACTOR WILL BE RESPONSIBLE FOR EXPLORATORY TRENCHING AND EXPOSING OF EXISTING UTILITIES (POTHOLING) TO CONFIRM SIZE, LOCATION, ETC. THIS WORK WILL BE CONSIDERED AS INCIDENTAL TO THE PROJECT.
35. CONTRACTOR IS TO EXERCISE DUE CARE TO AVOID DISTURBING ANY EXISTING UTILITIES. IT SHALL BE THE RESPONSIBILITY OF THE CONTRACTOR TO COORDINATE WITH THE UTILITY COMPANIES IN ORDER TO PREVENT ANY SERVICE DISRUPTION THAT MIGHT RESULT FROM PROJECT CONSTRUCTION. IT SHALL BE THE RESPONSIBILITY OF THE CONTRACTOR TO PROTECT AND PRESERVE UTILITY EQUIPMENT AFFECTED BY PROJECT CONSTRUCTION. SHOULD THE CONTRACTOR BREAK AN EXISTING UTILITY LINE DURING CONSTRUCTION ACTIVITIES THE CONTRACTOR SHALL BE RESPONSIBLE FOR UTILITY REPAIR COSTS.
36. THE CONTRACTOR SHALL NOTIFY THE LOCAL FIRE DEPARTMENT AT LEAST TWO (2) WORKING DAYS IN ADVANCE OF WHEN FIRE HYDRANTS WILL BE TAKEN OUT OF SERVICE AND RETURNED TO SERVICE.
37. THE ABCWUA (768-2500) WILL BE NOTIFIED BY THE CONTRACTOR SEVEN (7) WORKING DAYS IN ADVANCE OF ANY WORK WHICH MAY AFFECT THE EXISTING PUBLIC WATER FACILITIES. REFER TO SECTION 18 OF THE COA STANDARD SPECIFICATIONS.
38. THE CONTRACTOR SHALL ADJUST TO GRADE, ALL WATER VALVE BOXES, SANITARY SEWER MANHOLES, AND STORM DRAIN MANHOLES WHICH MAY BE AFFECTED BY THIS CONTRACT.
39. ALL EXCAVATION, TRENCHING, AND SHORING ACTIVITIES MUST BE CARRIED OUT IN ACCORDANCE WITH OSHA 29 CFR 1926.650 SUBPART P.
40. ELECTRONIC MARKER SPHERES (EMS) WILL BE PLACED ACCORDING TO SECTION 170 OF THE CITY OF ALBUQUERQUE STANDARD SPECIFICATIONS FOR PUBLIC WORKS CONSTRUCTION, 1986 EDITION AS REVISED THROUGH UPDATE NO. 7.
41. THE CONTRACTOR SHALL BE RESPONSIBLE FOR DISPOSING OF DEBRIS, INCLUDING BUT NOT LIMITED TO HAZARDOUS WASTE AT DISPOSAL SITES APPROVED BY GOVERNMENTAL AGENCIES REGULATING THE DISPOSAL OF SUCH MATERIALS.
42. PERMANENT PAVEMENT STRIPING AND MARKINGS SHALL BE PLACED BY THE CONTRACTOR. THE ROAD SHALL NOT BE OPENED TO THE TRAFFIC UNTIL IT IS STRIPED. ALL STRIPING, PAVEMENT MARKINGS INCLUDING CROSSWALKS, ARROWS AND LINE MARKINGS ARE TO BE CONSTRUCTED OF HOT THERMOPLASTIC (90 MIL THICKNESS) IN ACCORDANCE WITH THE MANUAL OF UNIFORM TRAFFIC CONTROL DEVICES.
43. THE CONTRACTOR SHALL MAINTAIN A GRAFFITI-FREE WORK SITE AND SHALL PROMPTLY REMOVE ANY AND ALL GRAFFITI FROM EQUIPMENT, WHETHER PERMANENT OR TEMPORARY.
44. PRIOR TO ANY CONSTRUCTION, THE CONTRACTOR SHALL EXCAVATE AND VERIFY THE HORIZONTAL AND VERTICAL LOCATIONS OF ALL OBSTRUCTIONS. SHOULD A CONFLICT EXIST, THE CONTRACTOR SHALL NOTIFY THE ENGINEER OR THE SURVEYOR SO THAT THE CONFLICT CAN BE RESOLVED WITHOUT DELAY.
45. THE CONTRACTOR SHALL BE RESPONSIBLE FOR PROVIDING AND MAINTAINING ALL CONSTRUCTION SIGNING UNTIL THE PROJECT HAS BEEN ACCEPTED BY THE CITY.
46. STRUCTURES SHALL BE CLEAN AT THE TIME OF FINAL PROJECT ACCEPTANCE. THIS WORK WILL BE CONSIDERED AS INCIDENTAL TO THE COMPLETION OF THE PROJECT AND NO SEPARATE MEASUREMENT OR PAYMENT WILL BE MADE THEREFORE.
47. VIBRATION MONITORING AND VIDEO TAPING SHALL BE PERFORMED IN AND AROUND ALL STRUCTURES AS DEFINED IN THIS GENERAL NOTE AND AS DIRECTED BY THE PROJECT MANAGER. "STRUCTURES" IS DEFINED AS BRIDGES, CULVERTS, CATCH BASINS, DROP INLETS, RETAINING WALLS, CRIBBING, MANHOLES, ENDWALLS, BUILDINGS, SEWERS, SERVICE PIPES, UNDER DRAINS, FOUNDATION DRAINS, AND OTHER SUCH FEATURES THAT MAY BE ENCOUNTERED IN THE WORK. THE CONSTRUCTION AREA AND AREAS ADJACENT TO THE LIMITS OF CONSTRUCTION SHALL ALSO BE VIDEO TAPED. VIBRATION MONITORING, VIDEO-TAPING, AND RELATED WORK SHALL BE PERFORMED ACCORDING TO THE SPECIFICATIONS INCLUDED IN THE SUPPLEMENTAL TECHNICAL SPECIFICATIONS OF THE CONTRACT BOOK AND PAID FOR AT THE LUMP SUM CONTRACT PRICE FOR ITEM 1600.001 VIBRATION MONITORING, AND VIDEOTAPING, COMPLETE.
48. CONTRACTOR TO COORDINATE SUPPORT OF 14" GAS LINE WITH NEW MEXICO GAS COMPANY.
49. ALL CONSTRUCTION FROM STA. 18+50 EAST WILL NOT BE ALLOWED UNTIL MAY 29TH 2010 AND WILL BE COMPLETED BEFORE AUGUST 1ST 2010
50. ALL EXCAVATION, TRENCHING, AND SHORING ACTIVITIES MUST BE CARRIED-OUT IN ACCORDANCE WITH OSHA 29 CFR 1926.650 SUBPART P.
51. THE CONTRACTOR WILL BE RESPONSIBLE FOR DISPOSING OF ALL DEBRIS, INCLUDING, NOT LIMITED TO HAZARDOUS WASTE AT DISPOSAL SITES APPROVED BY GOVERNMENTAL AGENCIES REGULATING THE DISPOSAL OF SUCH MATERIALS.
52. ELECTRONIC MARKER DEVICES SHALL BE INSTALL AT ALL MANHOLES AND VALVE CANS THAT ARE CONSTRUCTED, RELOCATED OR ADJUSTED. ALL SERVICE LINES SHALL BE A CONTINUOUS. NO SPLICES ARE ALLOWED IN WATER SERVICE LINES FROM THE TAP IN THE MAIN LINE TO THE METER.

THE FOLLOWING NOTES ALSO APPLY WHEN CHECKED:

- ☒ ALL UTILITIES AND UTILITY SERVICE LINES SHALL BE INSTALLED PRIOR TO PAVING.
- ☒ BACKFILL COMPACTION SHALL BE ACCORDING TO SPECIFIED STREET USE.
- ☒ TACK COAT REQUIREMENTS SHALL BE DETERMINED BY THE ENGINEER.
- ☒ SIDEWALKS AND WHEELCHAIR RAMPS WITHIN THE CURB RETURNS SHALL BE CONSTRUCTED WHEREVER A NEW CURB RETURN IS CONSTRUCTED.
- ☒ IF CURB IS DERESSED FOR A DRIVEPAD, THE DRIVEPAD SHALL BE CONSTRUCTED PRIOR TO ACCEPTANCE OF CURB AND GUTTER.
- ☒ ALL STORM DRAINAGE FACILITIES SHALL BE COMPLETED PRIOR TO FINAL ACCEPTANCE. RCP PIPE JOINTS SHALL NOT BE GROUDED PRIOR TO FINAL INSPECTION. FINAL INSPECTION WILL DETERMINE JOINTS TO BE GROUDED FOR FINAL ACCEPTANCE OF CONSTRUCTION.

UTILITY CONTACTS

COMPANY	PHONE	MOBILE	CONTACT
ABCWUA	505-768-2713		ANTHONEY MONTOYA, JR.
NM GAS COMPANY	505-697-3529	505-362-5790	JOE DUNLOP
NM GAS COMPANY	505-697-3599	505-681-4423	TOM BULLARD
NM GAS COMPANY	505-798-3397	505-239-9826	JOE RICE
AT&T	303-620-2254	720-620-2254	DAVID STOCKTON
AT&T	714-761-6221		WALTER WERSTIUK
MCI WORLDCOM	505-346-4470		ANDY DARNELL
COMCAST	505-761-6252		MIKE MORTUS
TIME WARNER TELECOM	505-938-7339		ROYAL HARRISON
PNM ELECTRIC CO	505-241-3637		ANTHONY KOZLOWSKI
QWEST	505-245-8352		RITA JARAMILLO
MCLEOD USA	505-217-0038		RICK MUELLER
QWEST LONG DISTANCE	505-246-0501		LARRY KELLY
REDFLEX TRAFFIC SYSTEMS	623-207-2000		BRIAN KORITO

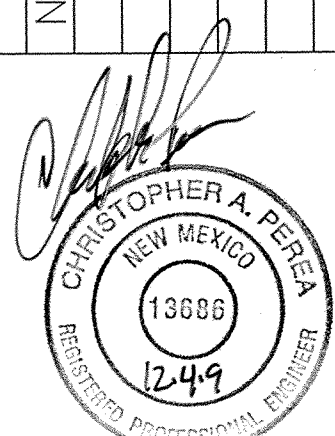ITEMS UTILITIES MAPS AND RESPONSIBILITY TO FIELD VERIFY AND TO PROVIDE PROTECTION FOR ANY TRENCHING AND EXPOSING OF INCIDENTAL TO THE PROJECT. RESPONSIBILITY OF THE PERSON THAT MIGHT RESULT FROM EXPOSED UTILITY EQUIPMENT AFFECTED PROTECTION ACTIVITIES THE CONTRACTOR ADVANCE OF WHEN FIRE HYDRANTS OF ANY WORK WHICH MAY AFFECT STORM DRAIN MANHOLES WHICH A 29 CFR 1926.650 SUBPART P. QUERQUE STANDARD SPECIFICATIONS HAZARDOUS WASTE AT DISPOSAL SITES ALL NOT BE OPENED TO THE LINE MARKINGS ARE TO BE FROM TRAFFIC CONTROL DEVICES. ALL GRAFFITI FROM EQUIPMENT, VERTICAL LOCATIONS OF ALL VEYOR SO THAT THE UNTIL THE PROJECT HAS BEEN ERED AS INCIDENTAL TO THE DEFINED IN THIS GENERAL NOTE AND INS, DROP INLETS, RETAINING WALLS, S, AND OTHER SUCH FEATURES ENTS OF CONSTRUCTION SHALL ALSO ORDING TO THE SPECIFICATIONS THE LUMP SUM CONTRACT PRICE				ENGINEER'S SEAL 				AS BUILT INFORMATION CONTRACTOR SRLS BEUS, DATE 8/10 WORK ORDER BY SUREV-TEK, DATE 8/10 INSPECTOR'S ACCEPTANCE BY COA, DATE 8/10 REVISIONS BY COA, DATE 8/10 DRAWINGS CORRECTED BY WEI, DATE 8/10 MICRO-FILM INFORMATION RECORDED BY _____, DATE _____ NO. _____			
COMPLETED BEFORE AUGUST 1ST A 29 CFR 1926.650 SUBPART P. HAZARDOUS WASTE AT DISPOSAL SITES DUCTED, RELOCATED OR ADJUSTED. THE TAP IN THE MAIN LINE TO THE				SURVEY INFORMATION FIELD NOTES NO. _____ BY _____ DATE _____				BENCH MARKS -ACS 1 1/4" ALUMINUM DISK, STAMPED "ACS BM. 11-J15", EPOXIED ON TOP OF THE CONCRETE CURB RETURN, ESE QUADRANT OF LOMAS BLVD AND WOODWARD PL, NE ELEV=5021.86 (NGVD29)			
RECORD DRAWING DATE <u>8/10</u>				REVISIONS DESIGN DESIGNED BY: TJA DATE: JUN 2007 DRAWN BY: JIF DATE: JUN 2007 CHECKED BY: MJJ DATE: JUN 2007				1-23-08 REVISED NOTES AND LINE WORK JIF			




4900 LANG AVENUE NE
ALBUQUERQUE, NEW MEXICO
87109
(505) 348-4000
FAX (505) 348-4072




CITY OF ALBUQUERQUE
DEPARTMENT OF MUNICIPAL DEVELOPMENT
ENGINEERING DIVISION


TITLE: MOUNTAIN RD. STORM DRAIN IMPROVEMENTS

GENERAL NOTES

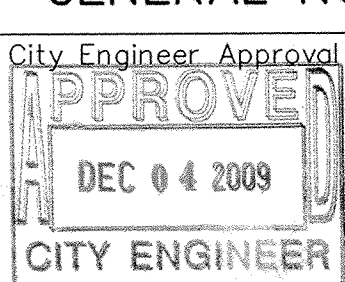Design Review Committee	City Engineer Approval	Mo./Day/Yr.	Mo./Day/Yr.
			
City Project No. 7963.93		Zone Map No. J-15	Sheet 2 Of 18

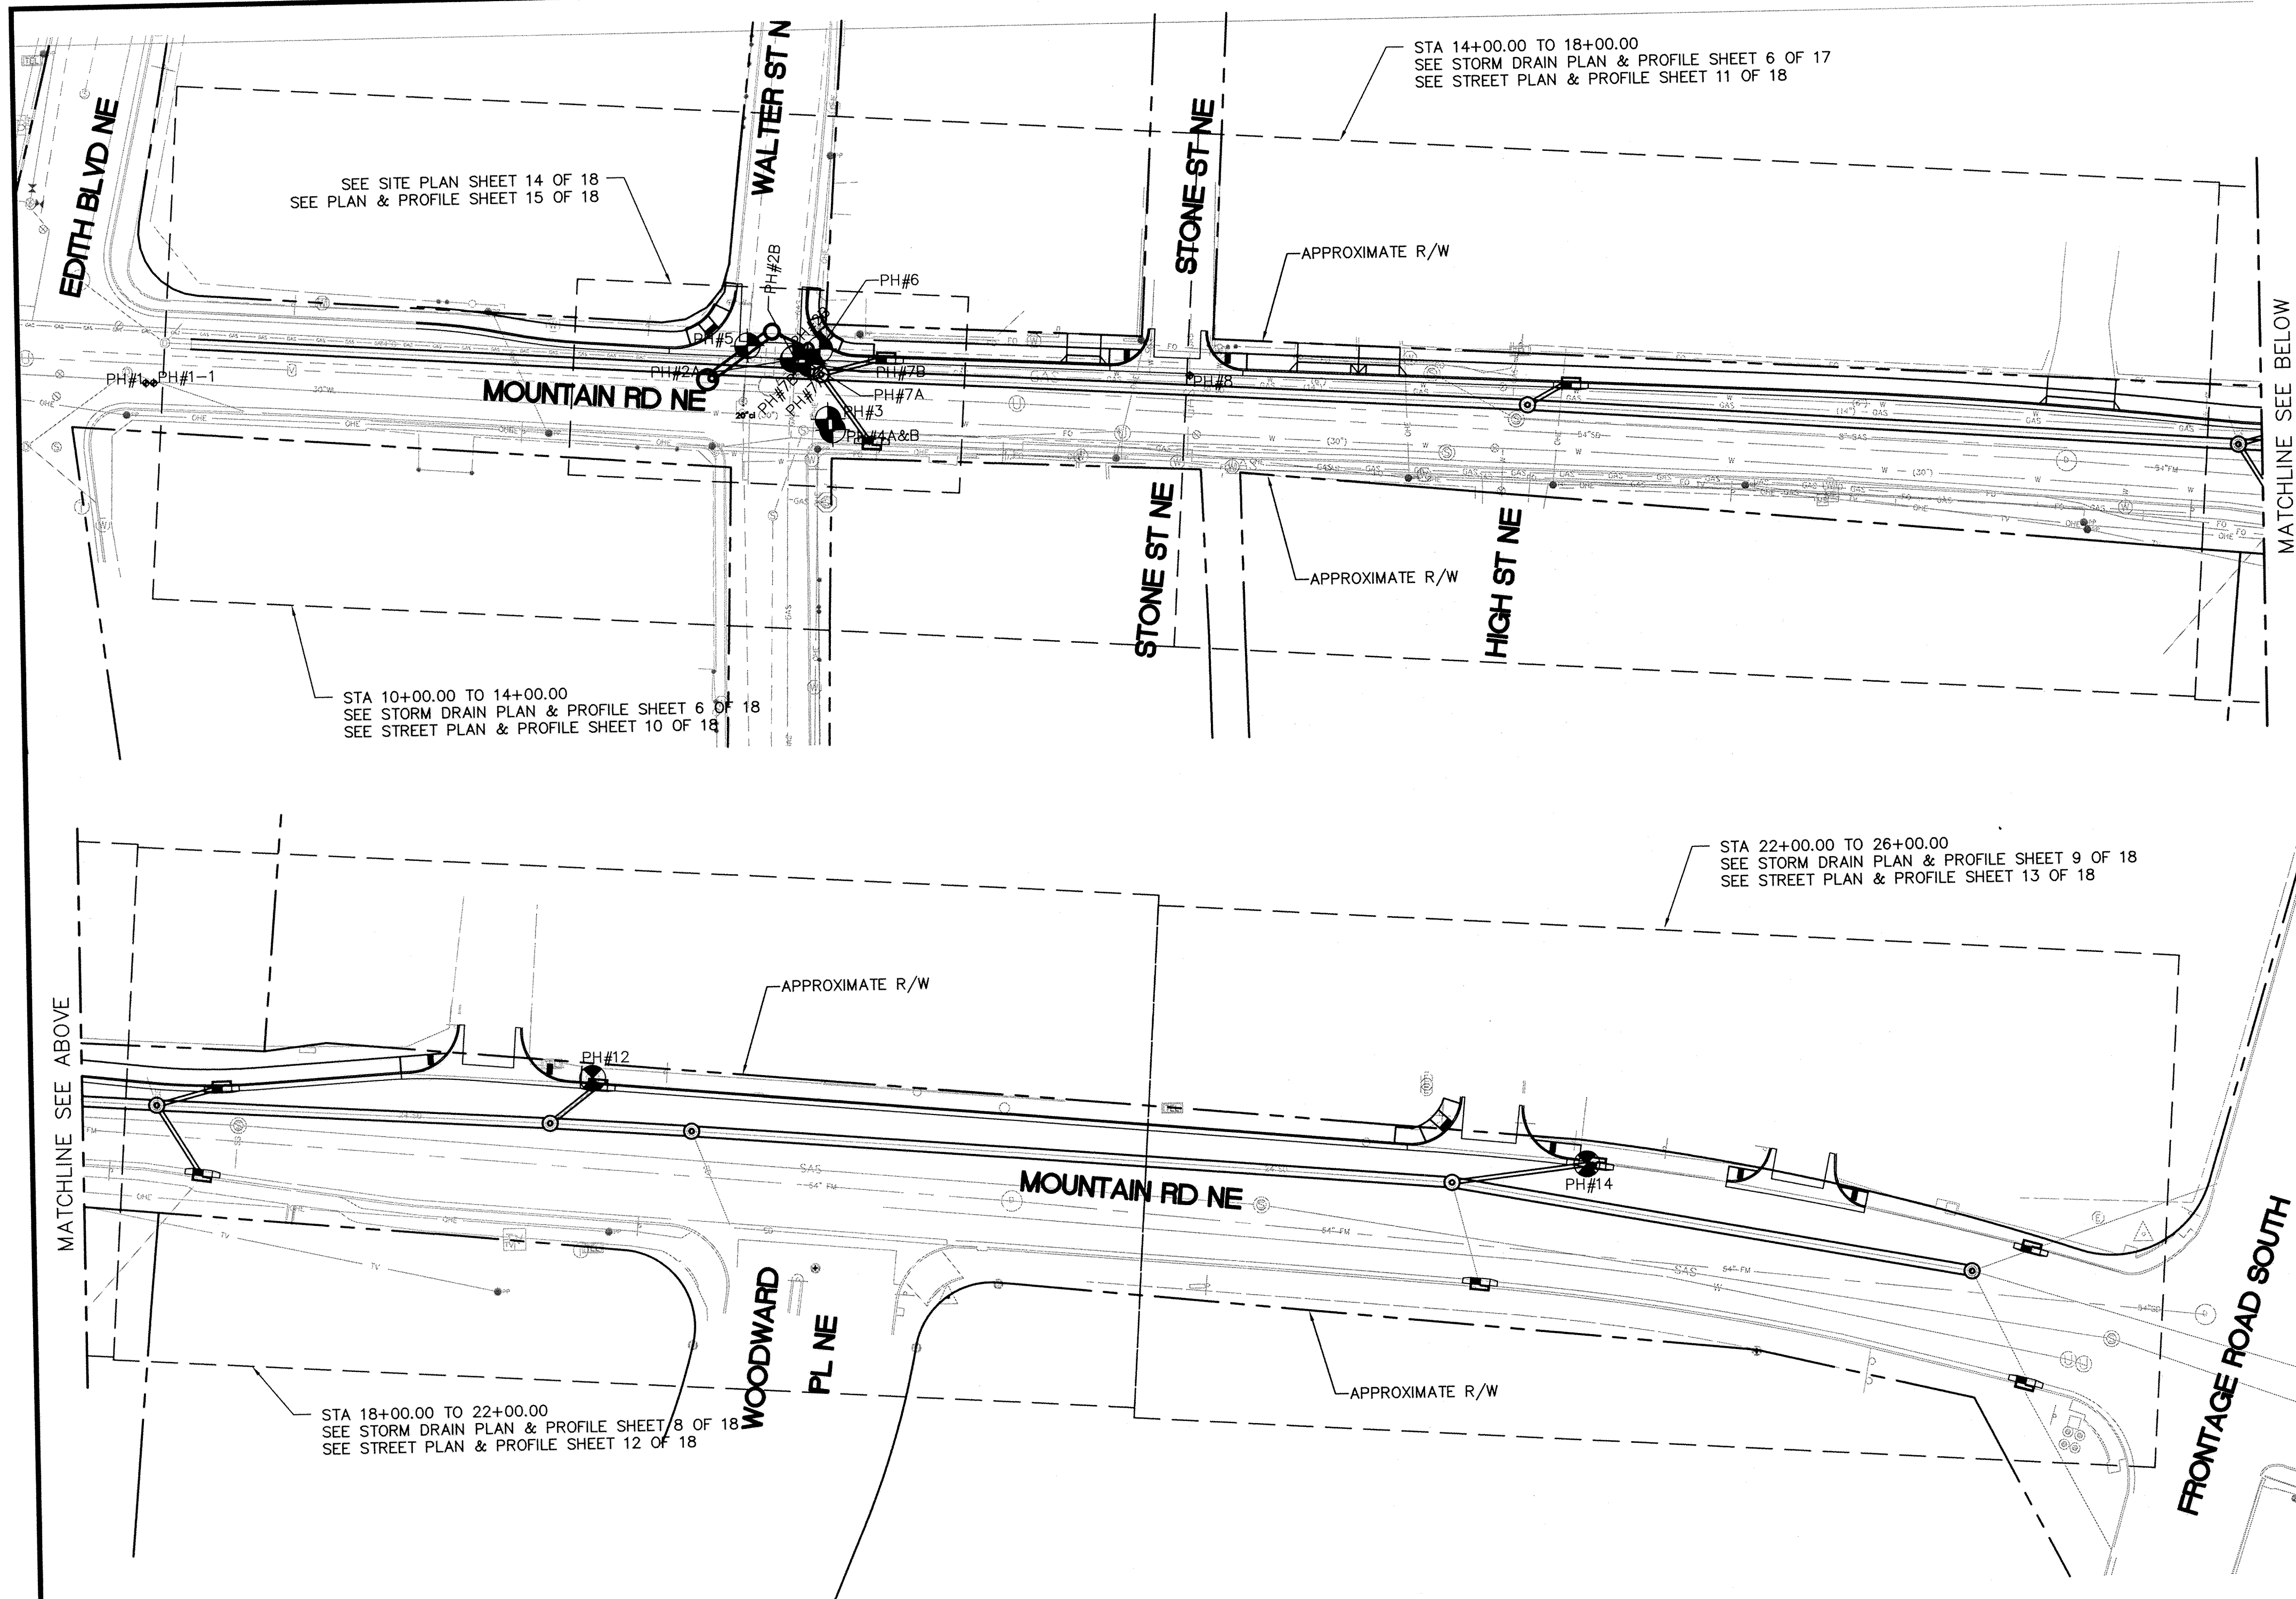

POTHOLE LISTING FOR MOUNTAIN ROAD								
08/17/09								
POTHOLE #	NORTHING	EASTING	GRND ELEV	TYPE	MATERIAL	DIA	DEPTH TO TOP TO BOTTOM	PAVEMENT THICKNESS
POTHOLE #1	1489781.716	1523897.826	4976.12	COMM	NOT FOUND	---	48"	4" ASPHALT
POTHOLE #1-1	1489781.681	1523900.878	4976.32	COMM	NOT FOUND	---	48"	4" ASPHALT
POTHOLE #4A	1489758.017	1524166.140	4985.06	SAS	PVC	10"	71"	4" ASPHALT
POTHOLE #4B	1489758.017	1524166.140	4985.06	COMM	NOT FOUND	---	96"	4" ASPHALT
POTHOLE #3	1489762.186	1524164.409	4985.05	H2O	NOT FOUND	---	120"	4" ASPHALT
POTHOLE #7A	1489783.774	1524157.934	4984.93	GAS	METAL	14"	26"	4" ASPHALT
POTHOLE #7B	1489784.354	1524157.169	4984.93	SD	PVC	8"	19"	4" ASPHALT
POTHOLE #6	1489789.666	1524161.729	4984.86	H2O	COPPER	3/4"	28"	4" ASPHALT
POTHOLE #2A	1489785.830	1524151.139	4984.57	H2O	PVC	6"	38"	4" ASPHALT
POTHOLE #2B	1489786.504	1524151.393	4984.60	GAS	WRAPPED METAL	2"	48"	4" ASPHALT
POTHOLE #5	1489791.560	1524133.393	4983.99	H2O	METAL	6"	46"	4" ASPHALT
POTHOLE #8	1489776.647	1524306.165	4990.17	GAS	WRAPPED METAL	2"	27"	4" ASPHALT
POTHOLE #12	1489749.732	1524886.668	5014.07	GAS	METAL	14"	41"	3" CONCRETE
POTHOLE #14	1489709.135	1525274.973	5028.06	GAS	NOT FOUND	---	---	CONCRETE

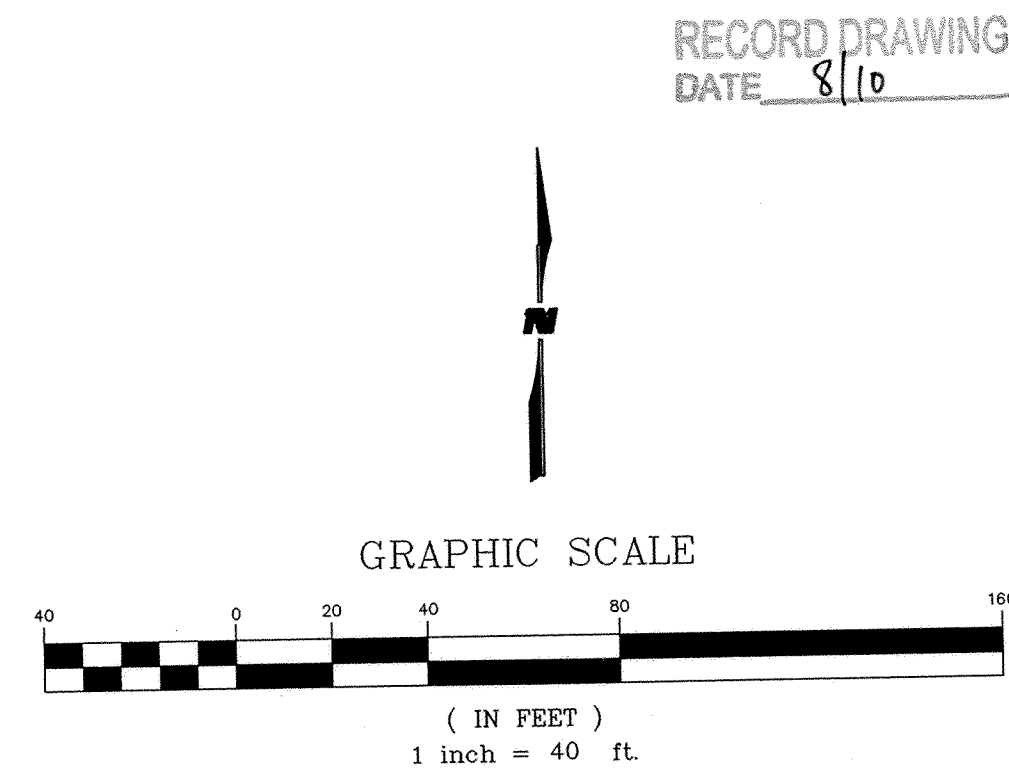

WILSON & COMPANY
4900 LANG AVENUE NE
ALBUQUERQUE, NEW MEXICO 87109
(505) 348-4000
FAX (505) 348-4072

CITY OF ALBUQUERQUE
DEPARTMENT OF MUNICIPAL DEVELOPMENT
ENGINEERING DIVISION
TITLE: MOUNTAIN RD. STORM DRAIN IMPROVEMENTS
POTHOLE PLAN

Design Review Committee: **APPROVED** NOV 13 2009
City Engineer Approval: **APPROVED** NOV 13 2009
DESIGN REVIEW COMMITTEE CITY ENGINEER

City Project No. 7963.93
Zone Map No. J-15
Sheet 3 of 18


Mo./Day/Yr.
Mo./Day/Yr.
Mo./Day/Yr.
Mo./Day/Yr.

DESIGNED BY: TJA
DRAWN BY: JIF
CHECKED BY: MJJ

DATE: JUN 2007
DATE: JUN 2007
DATE: JUN 2007


SURVEY INFORMATION		BENCH MARKS		AS BUILT INFORMATION	
FIELD NOTES	NO.	DATE	BY	CONTRACTOR	DATE
				SALLS Bros.	8/10
				STAMPED "ACS BM. 11-JIS"	8/10
				EXPOSED ON TOP OF THE	8/10
				CONCRETE CURB RETURN, ESE	8/10
				QUADRANT OF LOMAS BLVD AND	8/10
				WOODWARD PL. NE	8/10
				ELEV=5021.86 (NGVD29)	8/10
				RECORDED BY	DATE
					NO.

Addendum #1

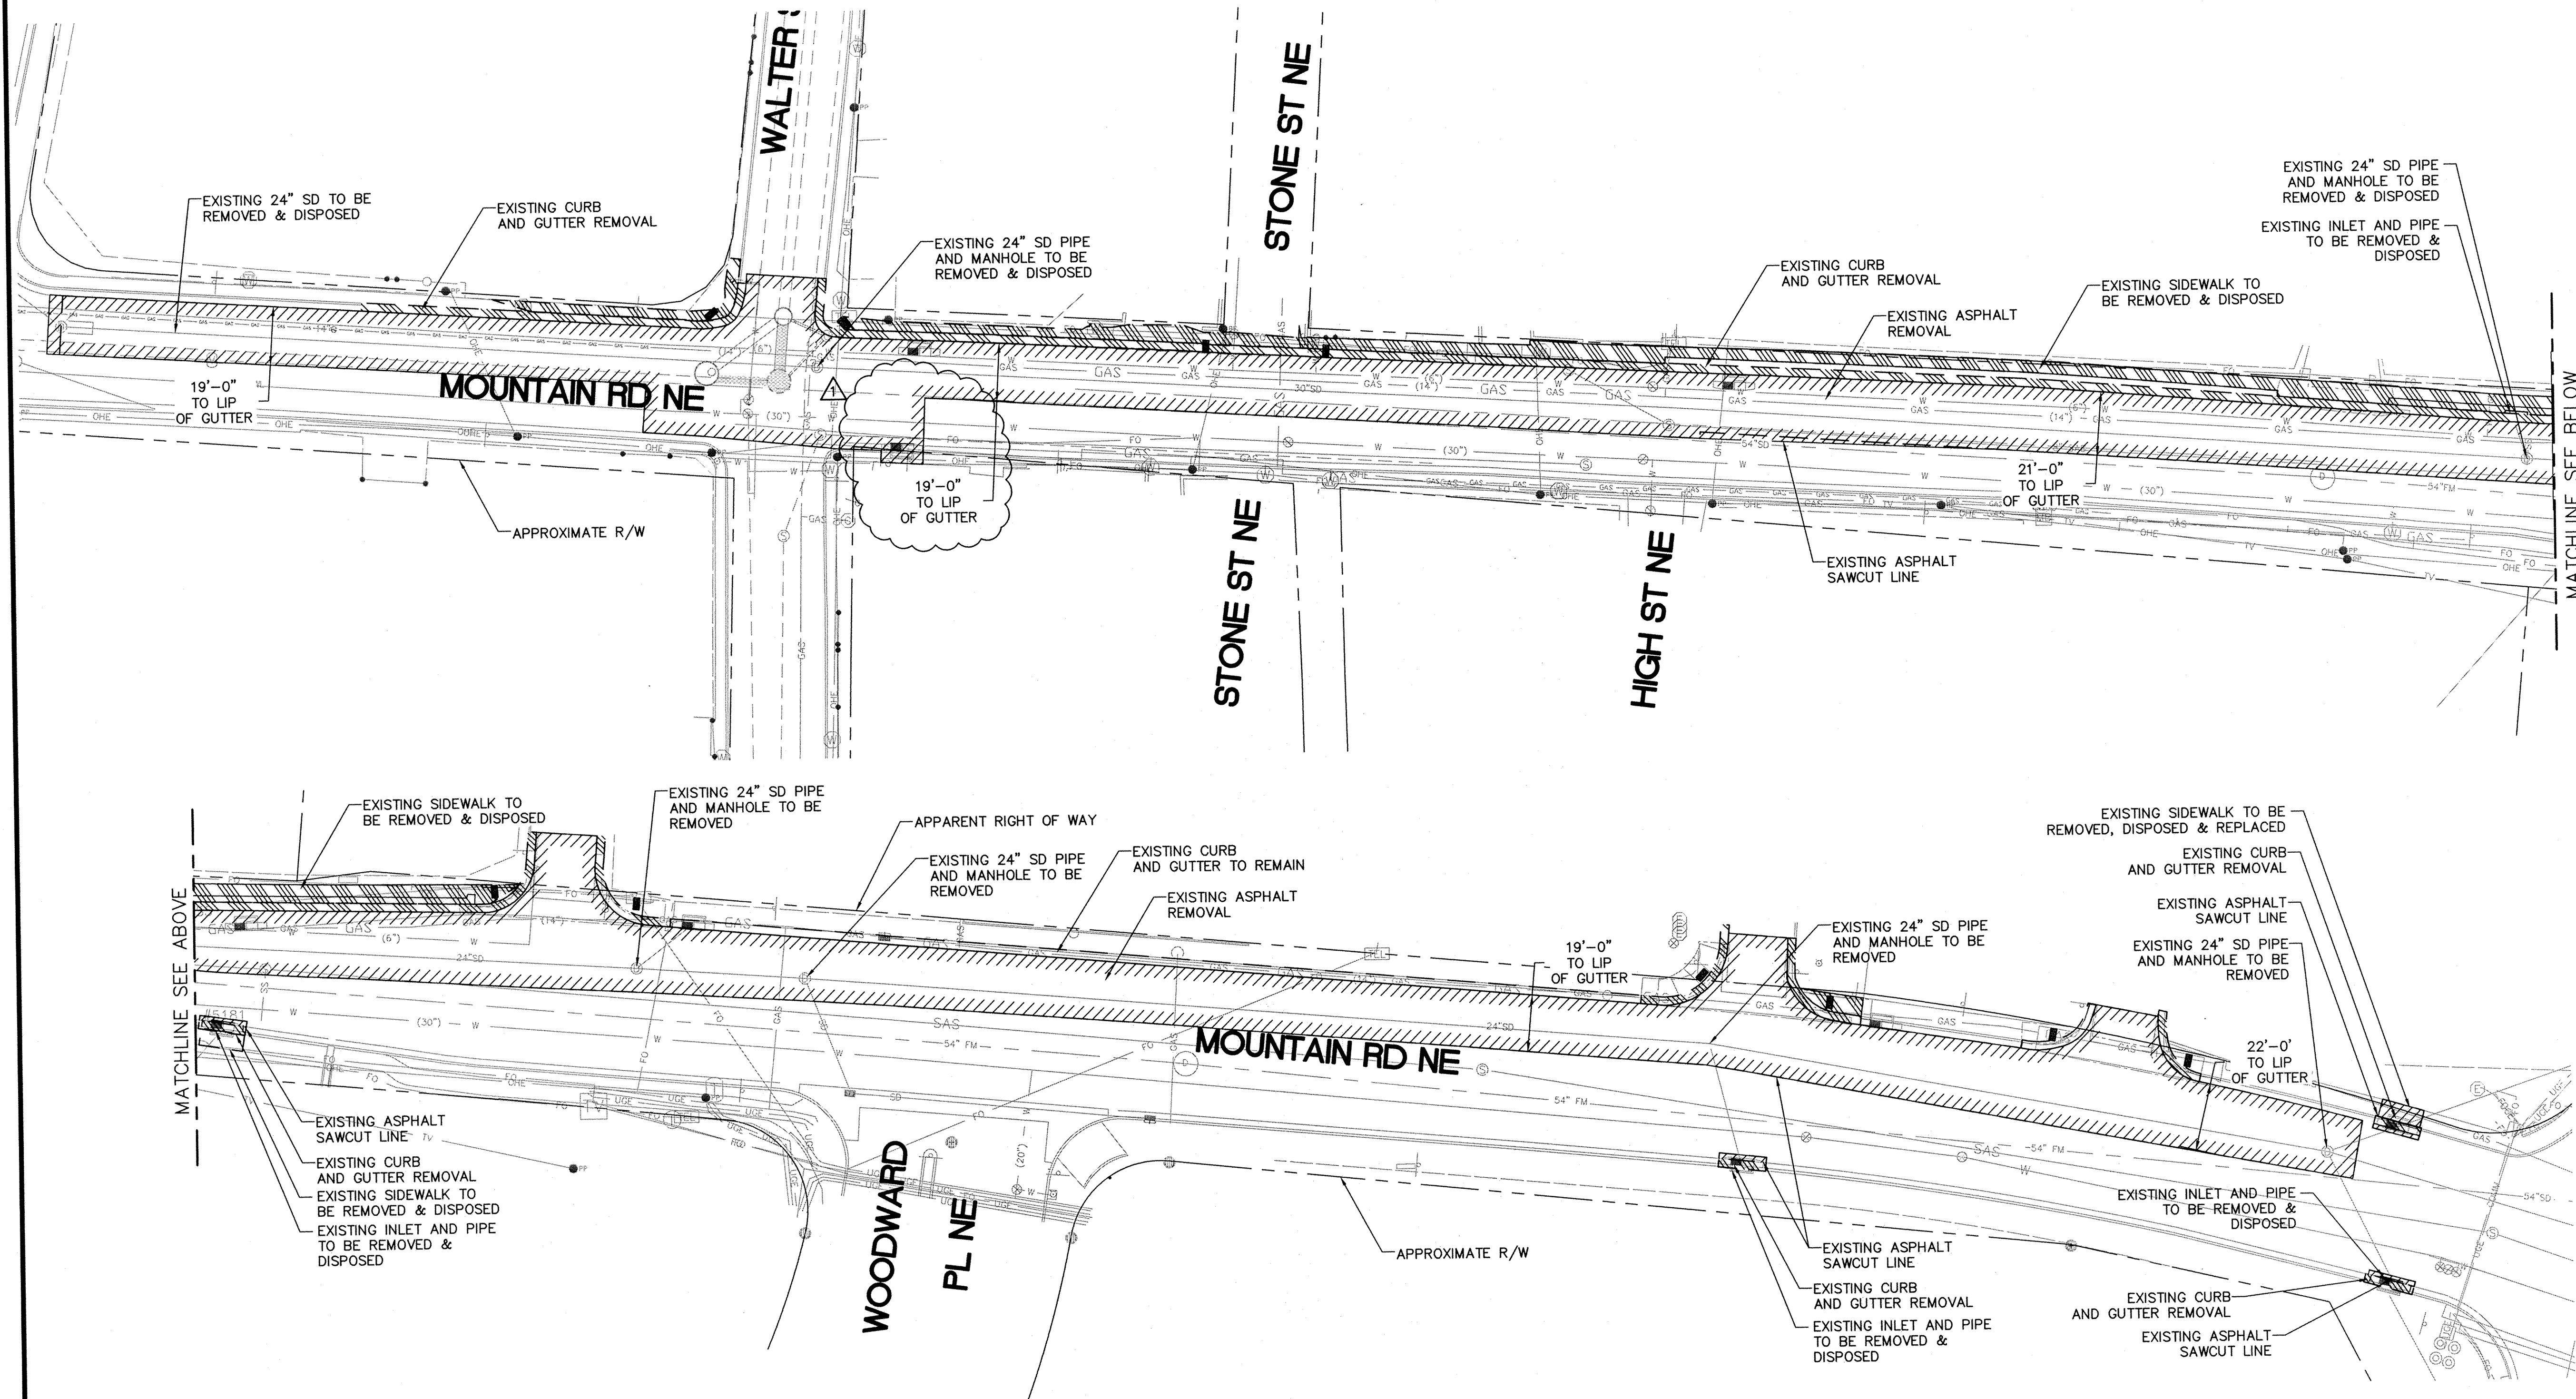


MATCHLINE SEE BELOW

MATCHLINE SEE ABOVE

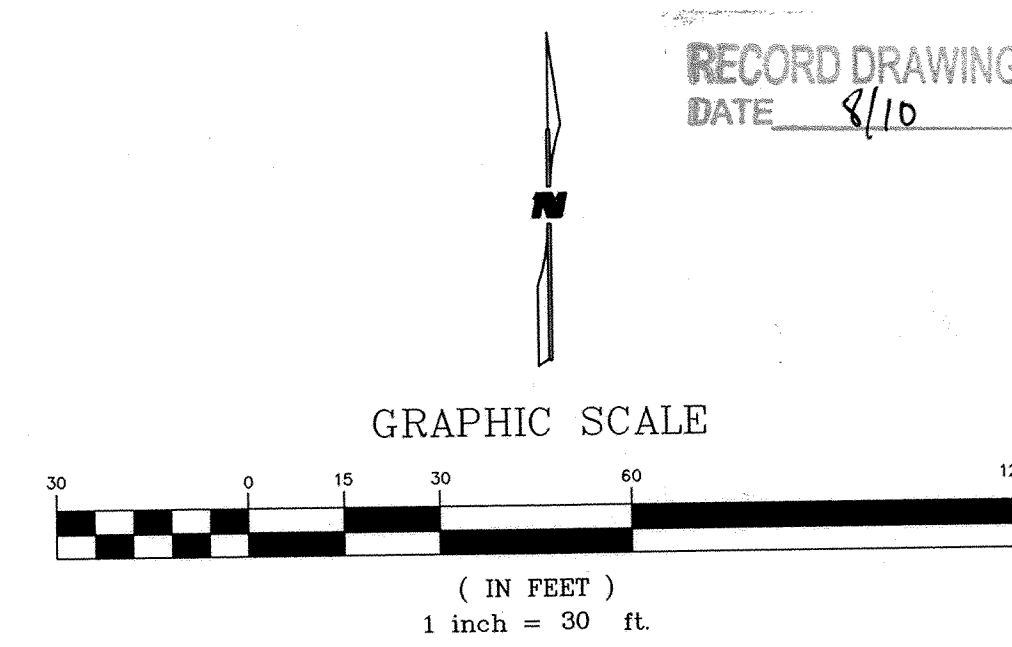

WILSON & COMPANY 4900 LANG AVENUE NE ALBUQUERQUE, NEW MEXICO 87109 (505) 348-4000 FAX (505) 348-4072	
CITY OF ALBUQUERQUE DEPARTMENT OF MUNICIPAL DEVELOPMENT ENGINEERING DIVISION	
TITLE: MOUNTAIN RD. STORM DRAIN IMPROVEMENTS DEMOLITION PLAN	
Design Review Committee APPROVED DEC 04 2009 DESIGN REVIEW COMMITTEE	City Engineer Approval APPROVED DEC 04 2009 CITY ENGINEER
City Project No. 7963.93	Zone Map No. J-15
Sheet 4	Of 18

AS BUILT INFORMATION		BENCH MARKS		SURVEY INFORMATION		ENGINEER'S SEAL		REVISED NOTES AND LINE WORK		REVISIONS		DESIGN	
CONTRACTOR	DATE	ALUMINUM DISK	STAMPED "ACS BM, 11-J15"	NO.	BY	DATE	NO.	DATE	BY	NO.	DATE	DATE	DATE
SHULS BRAS	8/10	ACS 1 1/4"	EXPLODED ON TOP OF THE CONCRETE CURB RETURN, ESE QUADRANT OF LOMAS BLVD AND WOODWARD PL, NE										
SURV-TEK	8/10		WOODWARD PL, NE										
CDP	8/10		ELEV=5021.86 (NGVD29)										
CDP	8/10												
WCI	8/10												
MICRO-FILM	8/10												
INFORMATION													
RECORDED BY	NO.												

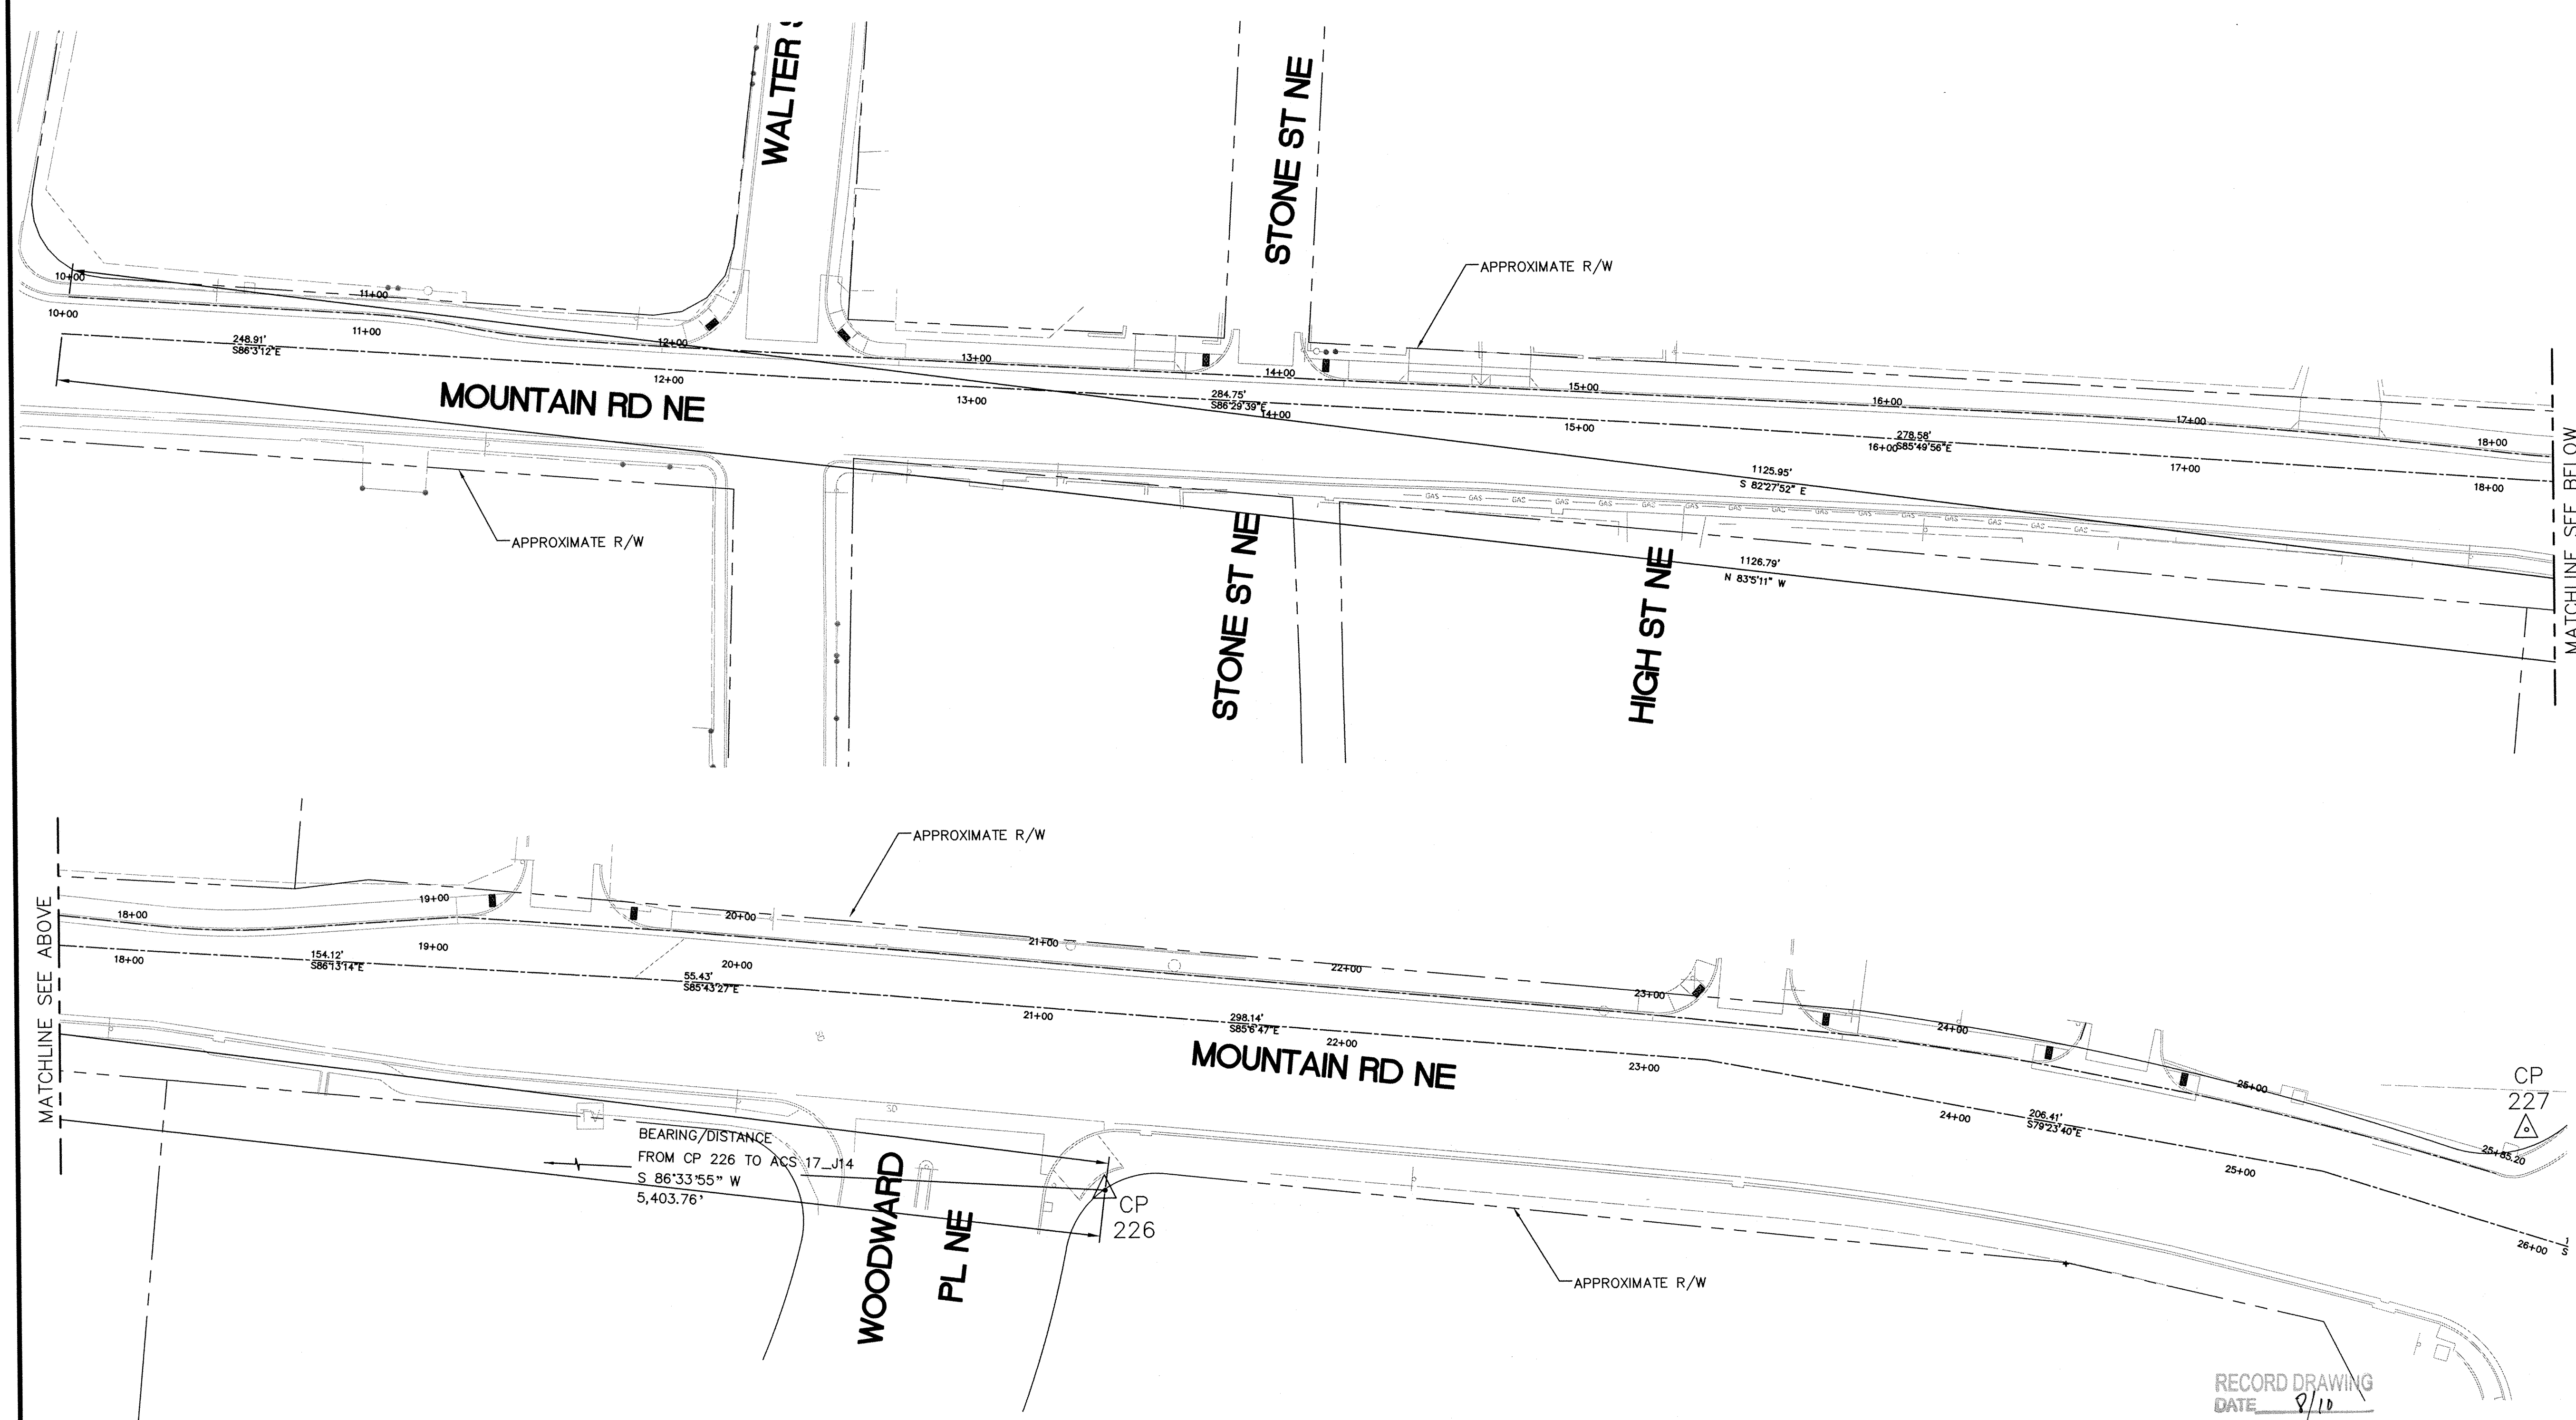

ENGINEER'S SEAL		SURVEY INFORMATION		BENCH MARKS		AS-BUILT INFORMATION	
	NO.	DATE	BY	FIELD NOTES	STAMPED "ACS BM, 11-J15", EXPOSED ON TOP OF THE CONCRETE CURB RETURN, ESE QUADRANT OF LOMAS BLVD AND WOODWARD PL, NE ELEV=5021.86 (NGVD29)	CONTRACTOR	DATE
	NO.	DATE	BY	REVISIONS	DESIGN	DESIGNED BY: TJA	DATE: JUN 2007
	NO.	DATE	BY	REVISIONS	DESIGN	DRAWN BY: JF	DATE: JUN 2007
	NO.	DATE	BY	REVISIONS	DESIGN	CHECKED BY: MJ	DATE: JUN 2007


4900 LANG AVENUE NE
ALBUQUERQUE, NEW MEXICO 87109
(505) 348-4000
FAX (505) 348-4072

CITY OF ALBUQUERQUE
DEPARTMENT OF MUNICIPAL DEVELOPMENT
ENGINEERING DIVISION
TITLE: MOUNTAIN RD. STORM DRAIN IMPROVEMENTS
HORIZONTAL CONTROL PLAN

Design Review Committee

City Engineer Approval

City Project No. 7963.93
Zone Map No. J-15
Sheet 5 Of 18

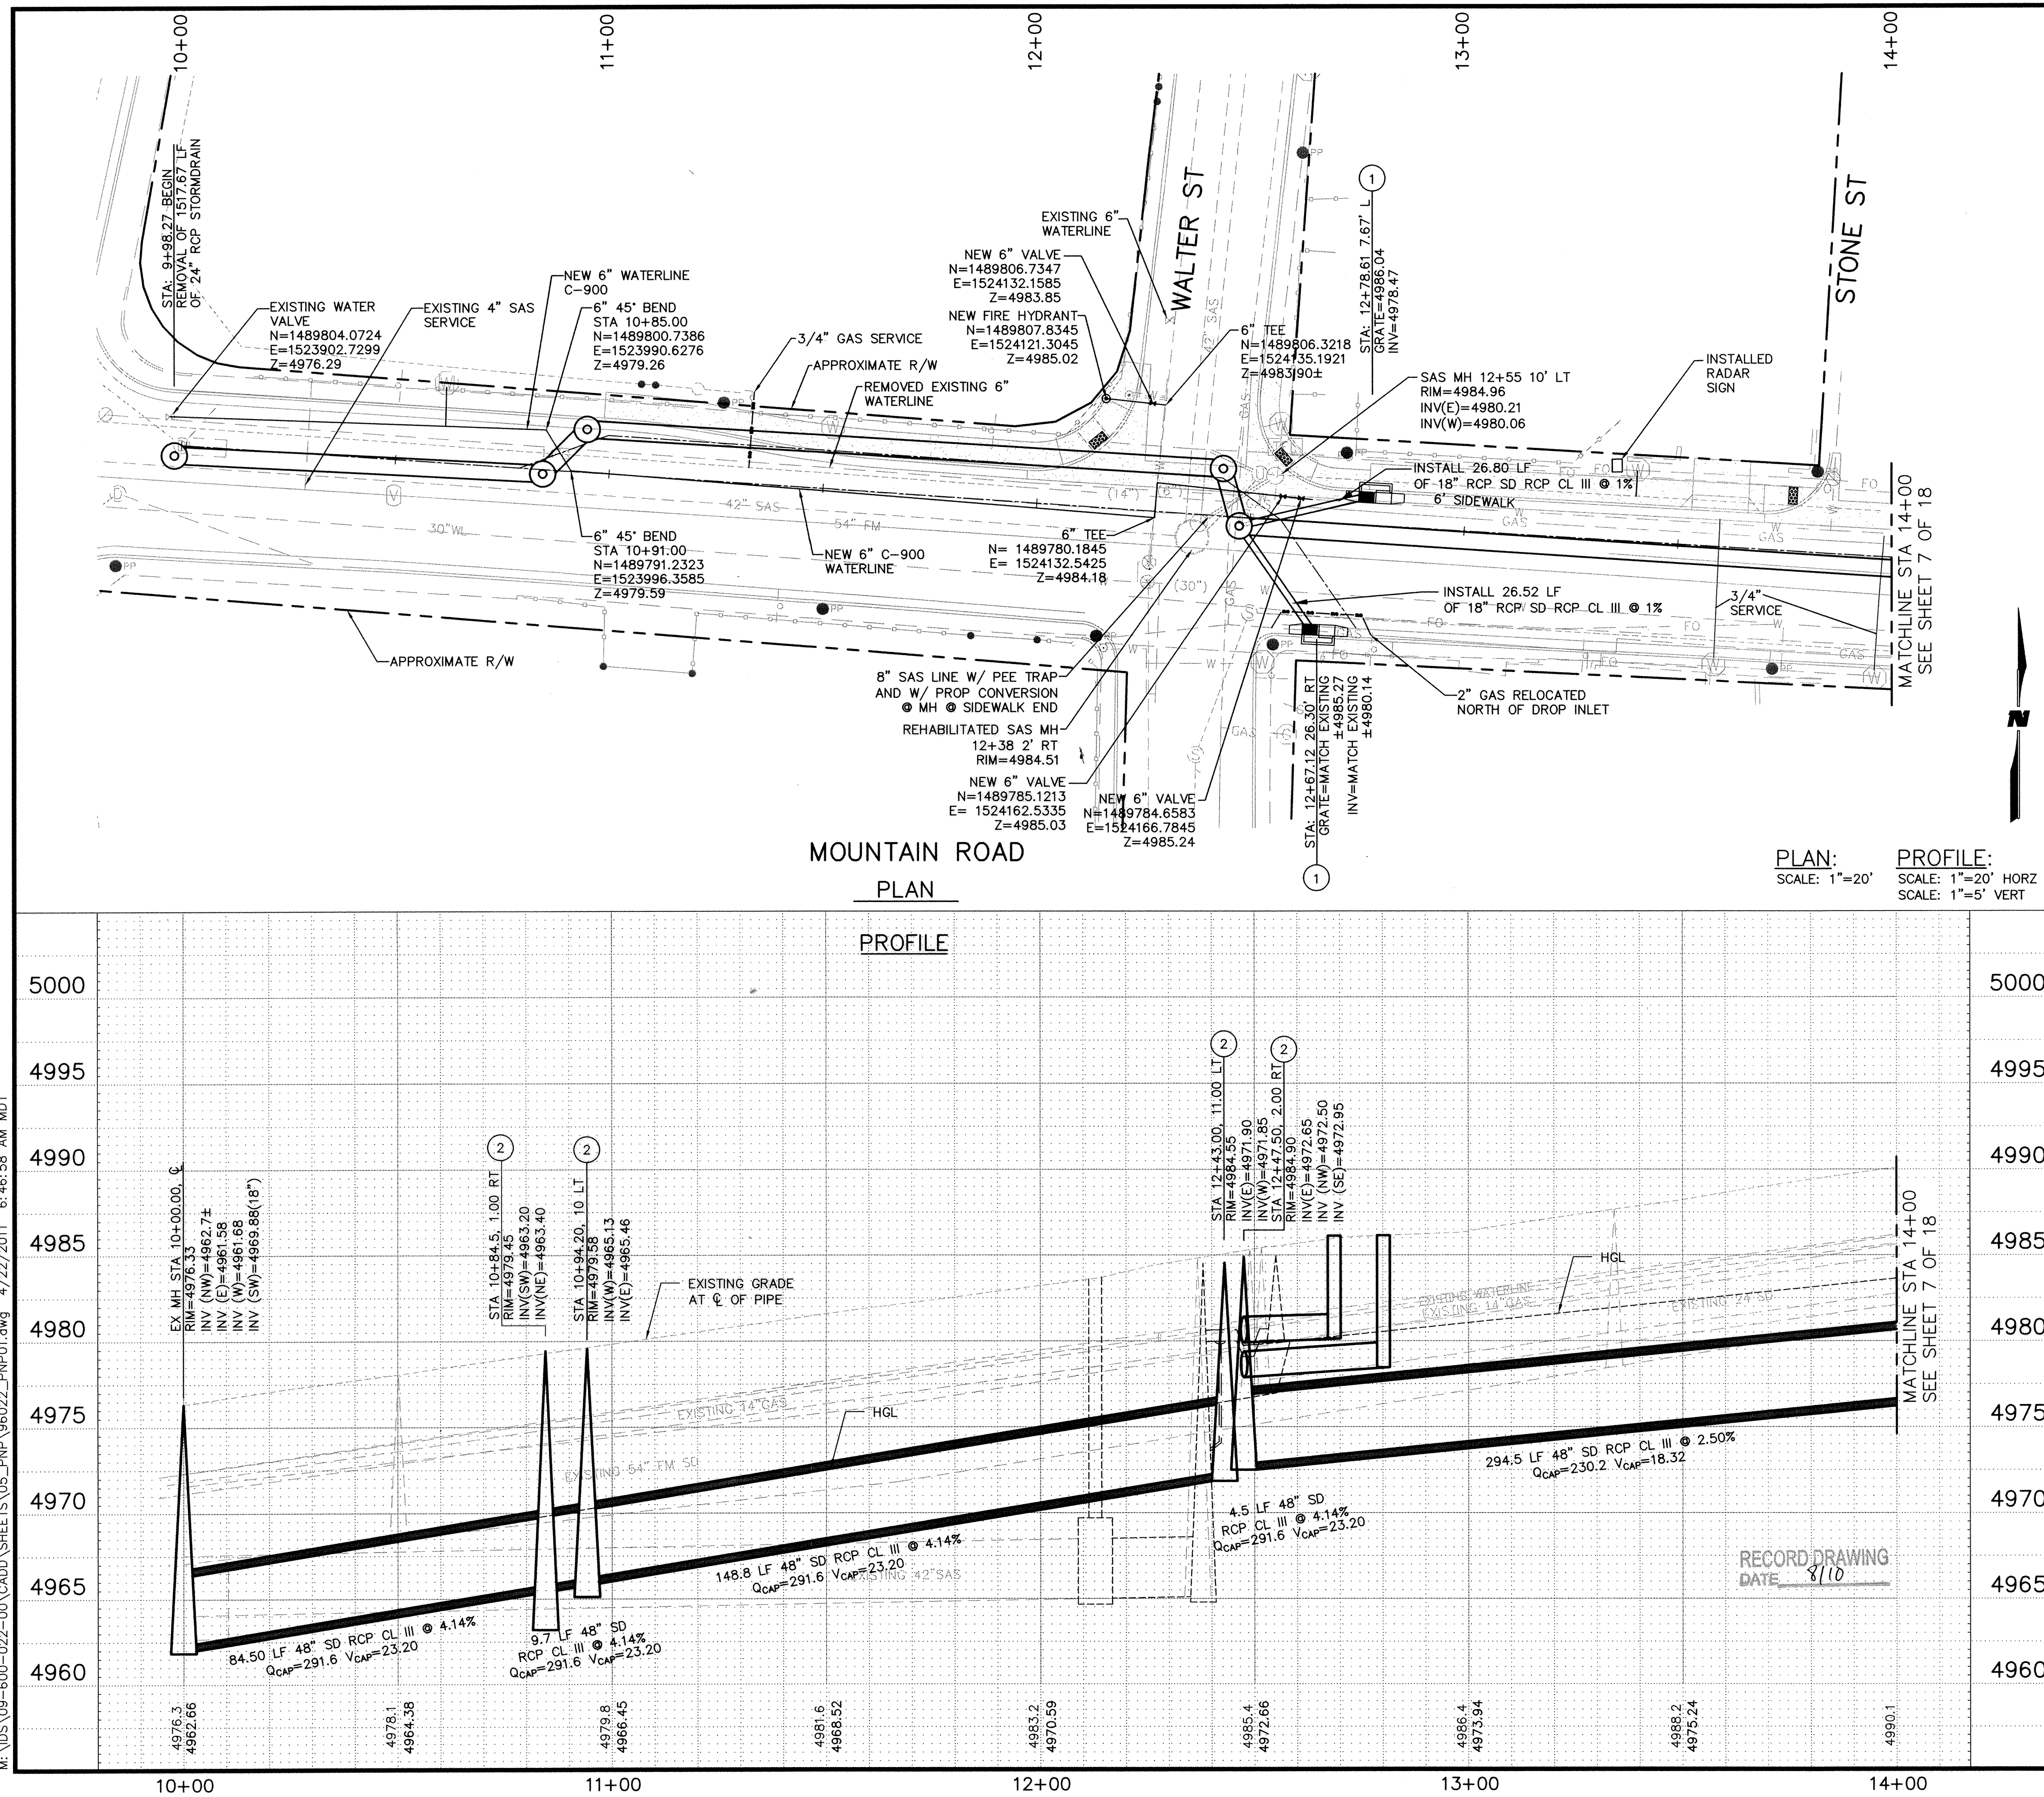

GENERAL NOTES

○ SHEET KEY NOTES


- ① BUILD STORM DRAIN INLET SINGLE TYPE "A"
PER COA STD DWG 2205 & 2220.
- ② BUILD 6' MANHOLE TYPE "C"
PER COA STD DWG 2101.

LEGEND

- INDEX CONTOUR
- INTERMEDIATE CONTOUR
- WATER METER
- UTILITY, TV PEDESTAL
- UTILITY, SANITARY MANHOLE
- UTILITY, STORM DRAINAGE MANHOLE
- UTILITY, WATER VALVE VAULT
- POWER POLE
- LIGHT POLE
- TELEPHONE PEDESTAL
- ELECTRICAL, TRANSFORMER
- UTILITY, TELEPHONE MANHOLE
- UTILITY, TELEPHONE VAULT
- PROPOSED 48" SD
- PROPOSED MH

**WILSON
& COMPANY**

4900 LANG AVENUE NE
ALBUQUERQUE, NEW MEXICO
87109
P (505) 348-4000
F (505) 348-4072


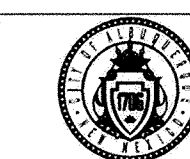


5. TITLE: MOUNTAIN RD. STORM DRAIN IMPROVEMENTS
MOUNTAIN RD STORM DRAIN PLAN & PROFILE
STA 10+00 TO STA 14+00

Design Review Committee	City Engineer Approval	Last Design Update	Mo./Day/Yr.	Mo./Day/Yr.
City Project No. 7963.93		Zone Map No. J-15	Sheet 6R	Of 18

[illegible]

M:\IDS\09-600-022-00\CADD\02-SHEETS\05_PNP\96022_PNP03.dwg 4/22/2011 7:20:34 AM MDT

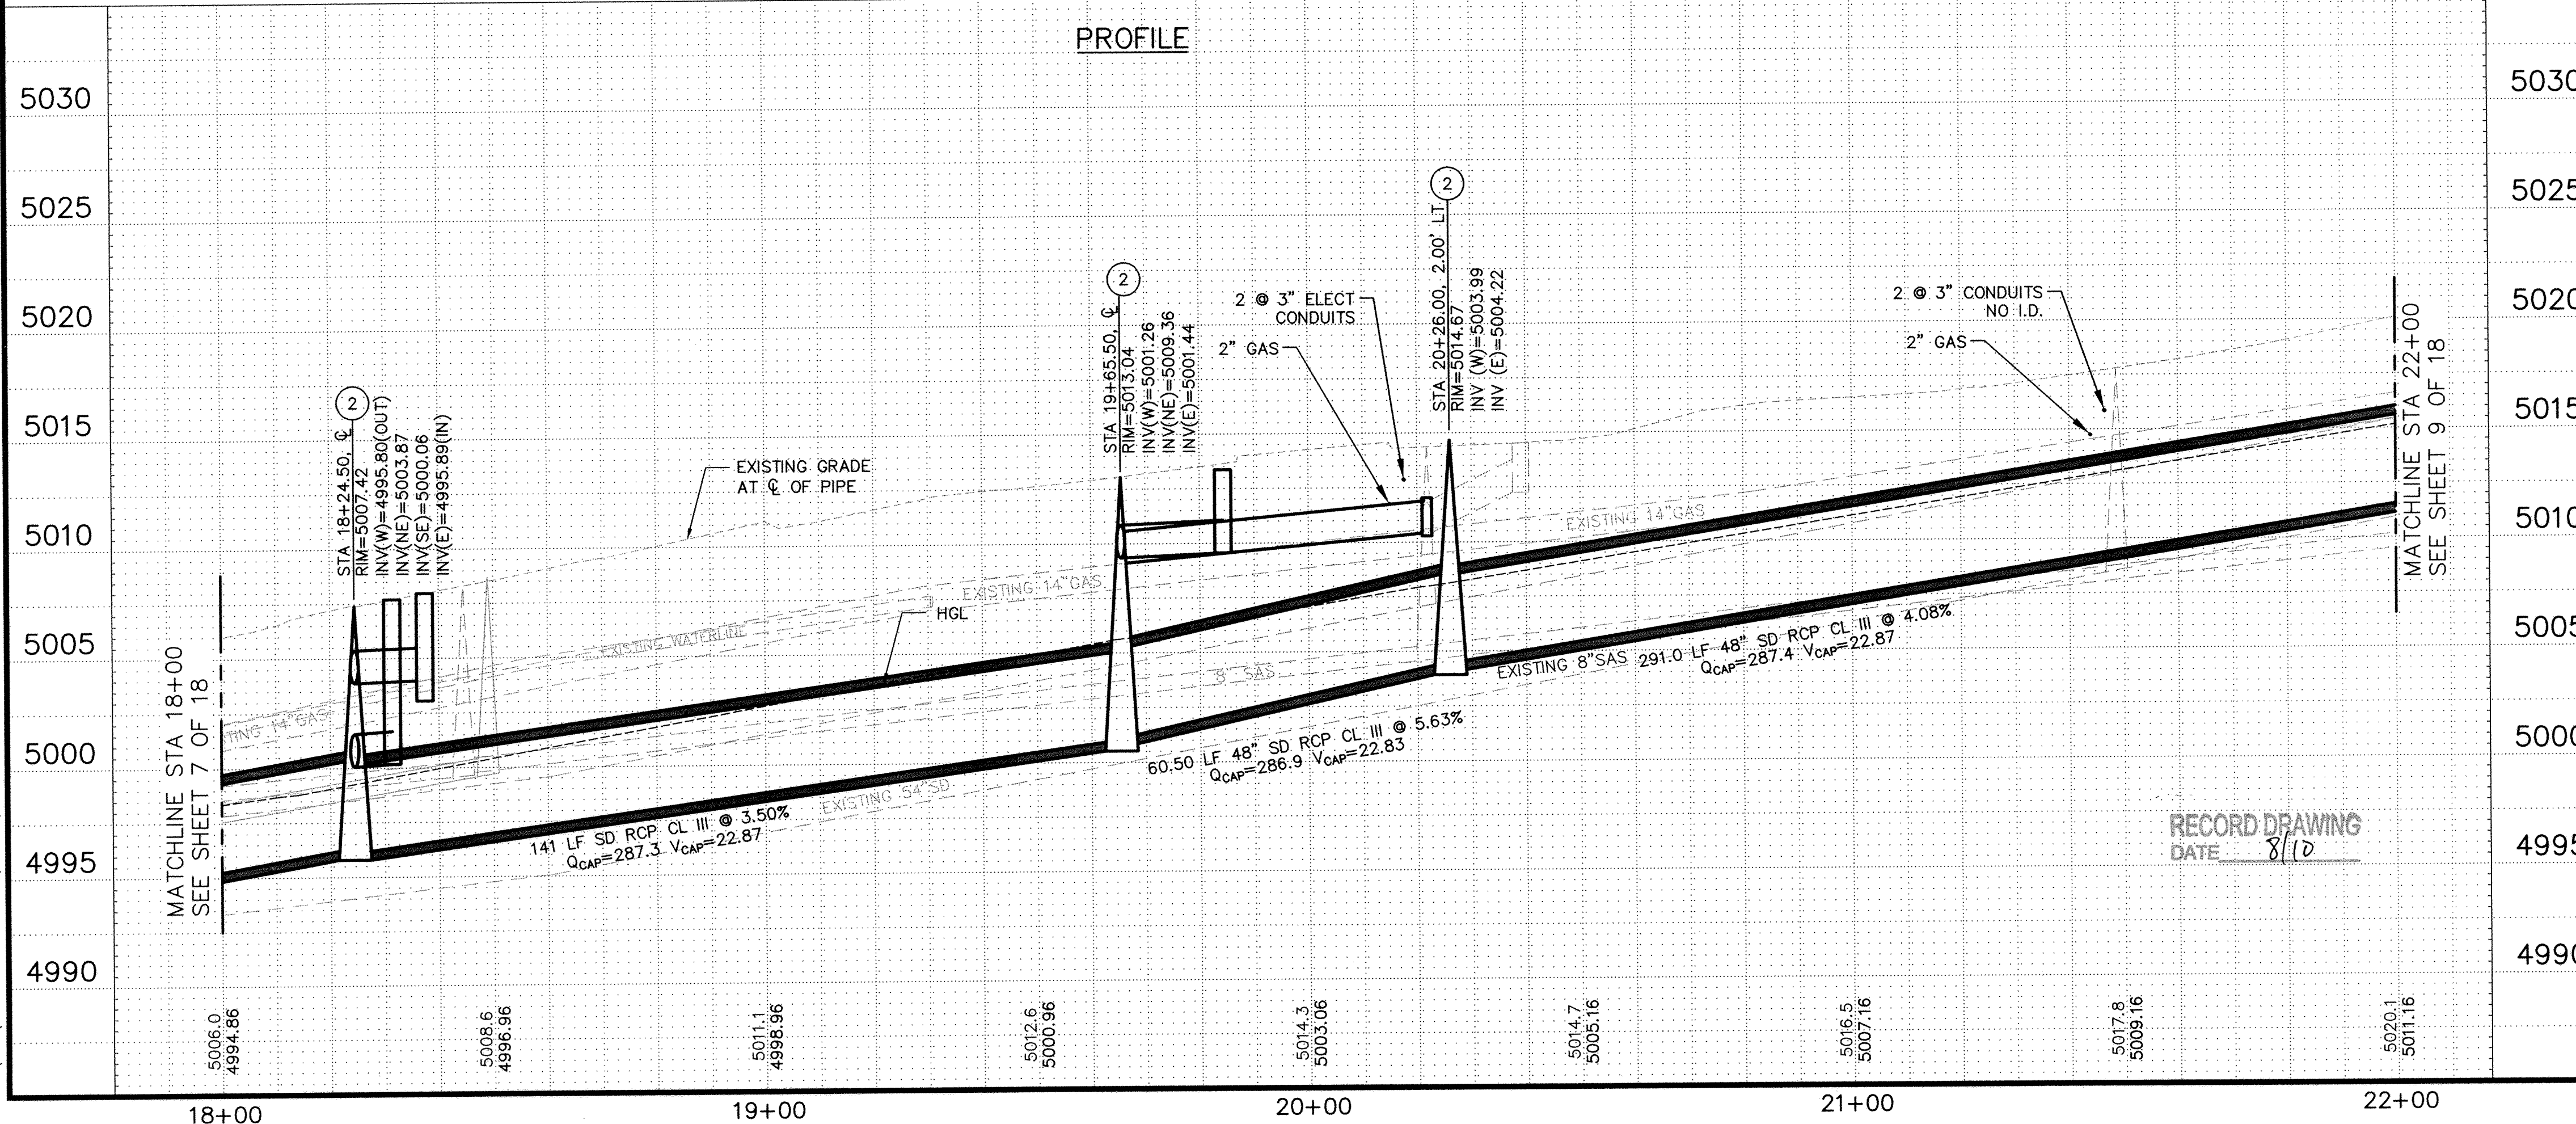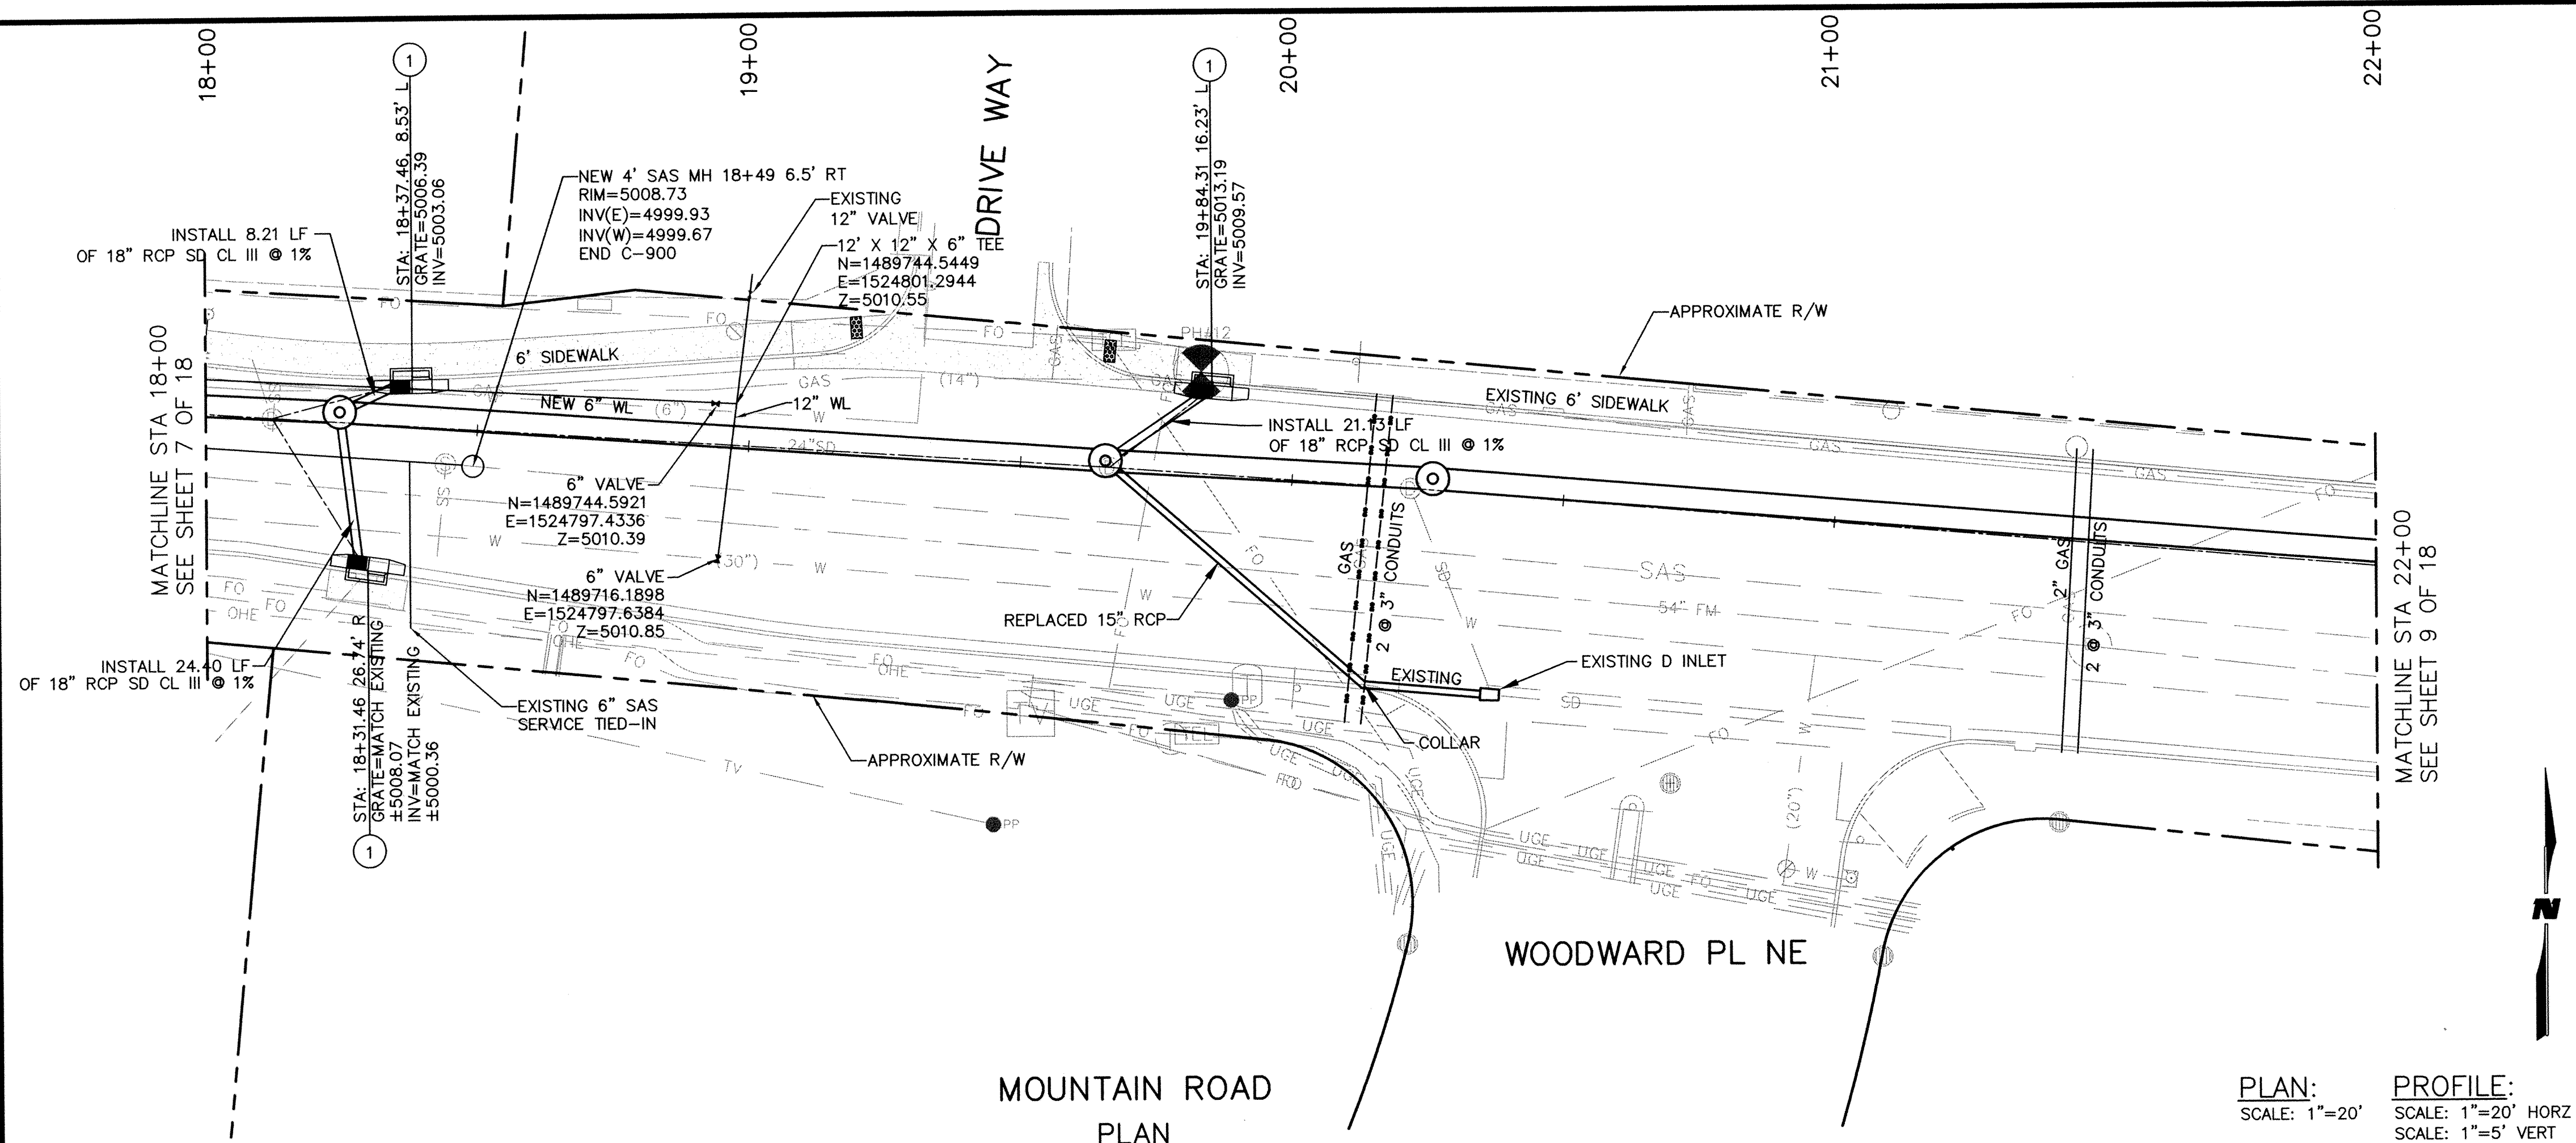

GENERAL NOTES

1

○

SHEET KEY NOTES

1

BUILD STORM DRAIN INLET SINGLE TYPE "A" PER COA STD DWG 2205.

2

BUILD 6" MANHOLE TYPE "C" PER COA STD DWG 2101.

LEGEND

INDEX CONTOUR

INTERMEDIATE CONTOUR

WATER VALVE

WATER METER

UTILITY, TV PEDESTAL

UTILITY, SANITARY MANHOLE

UTILITY, STORM DRAINAGE MANHOLE

UTILITY, WATER VALVE VAULT

POWER POLE

LIGHT POLE

TELEPHONE PEDESTAL

ELECTRICAL, TRANSFORMER

UTILITY, TELEPHONE MANHOLE

UTILITY, TELEPHONE VAULT

PROPOSED 48" SD

PROPOSED MH

AS BUILT INFORMATION

CONTRACTOR

DATE

WORK

STAMPED BY

DATE

ACCEPTANCE BY

DATE

FIELD DRAWING BY

DATE

REVISIONS

DATE

RECORDED BY

DATE

NO.

SURVEY INFORMATION

FIELD NOTES

DATE

BY

NO.

ENGINEER'S SEAL

NO. DATE

REMARKS

REVISIONS

DESIGN

DATE

DESIGNED BY: TJA

DATE: JUN 2007

DRAWN BY: JIF

DATE: JUN 2007

CHECKED BY: MJJ

DATE: JUN 2007

WILSON & COMPANY

4900 LANG AVENUE NE
ALBUQUERQUE, NEW MEXICO
87109
P (505) 348-4000
F (505) 348-4072

CITY OF ALBUQUERQUE
DEPARTMENT OF MUNICIPAL DEVELOPMENT
ENGINEERING DIVISION

TITLE: MOUNTAIN RD. STORM DRAIN IMPROVEMENTS
MOUNTAIN RD STORM DRAIN PLAN & PROFILE
STA 18+00 TO STA 22+00

Design Review Committee

City Engineer Approval

Mo./Day/Yr.


Mo./Day/Yr.

City Project No. 7963.93

Zone Map No. J-15

Sheet 8R Of 18

M:\IDS\09-600-022-00\CADD\Sheets\05_PNP\96022_PNP04.dwg 4/22/2011 7:28:25 AM MDT

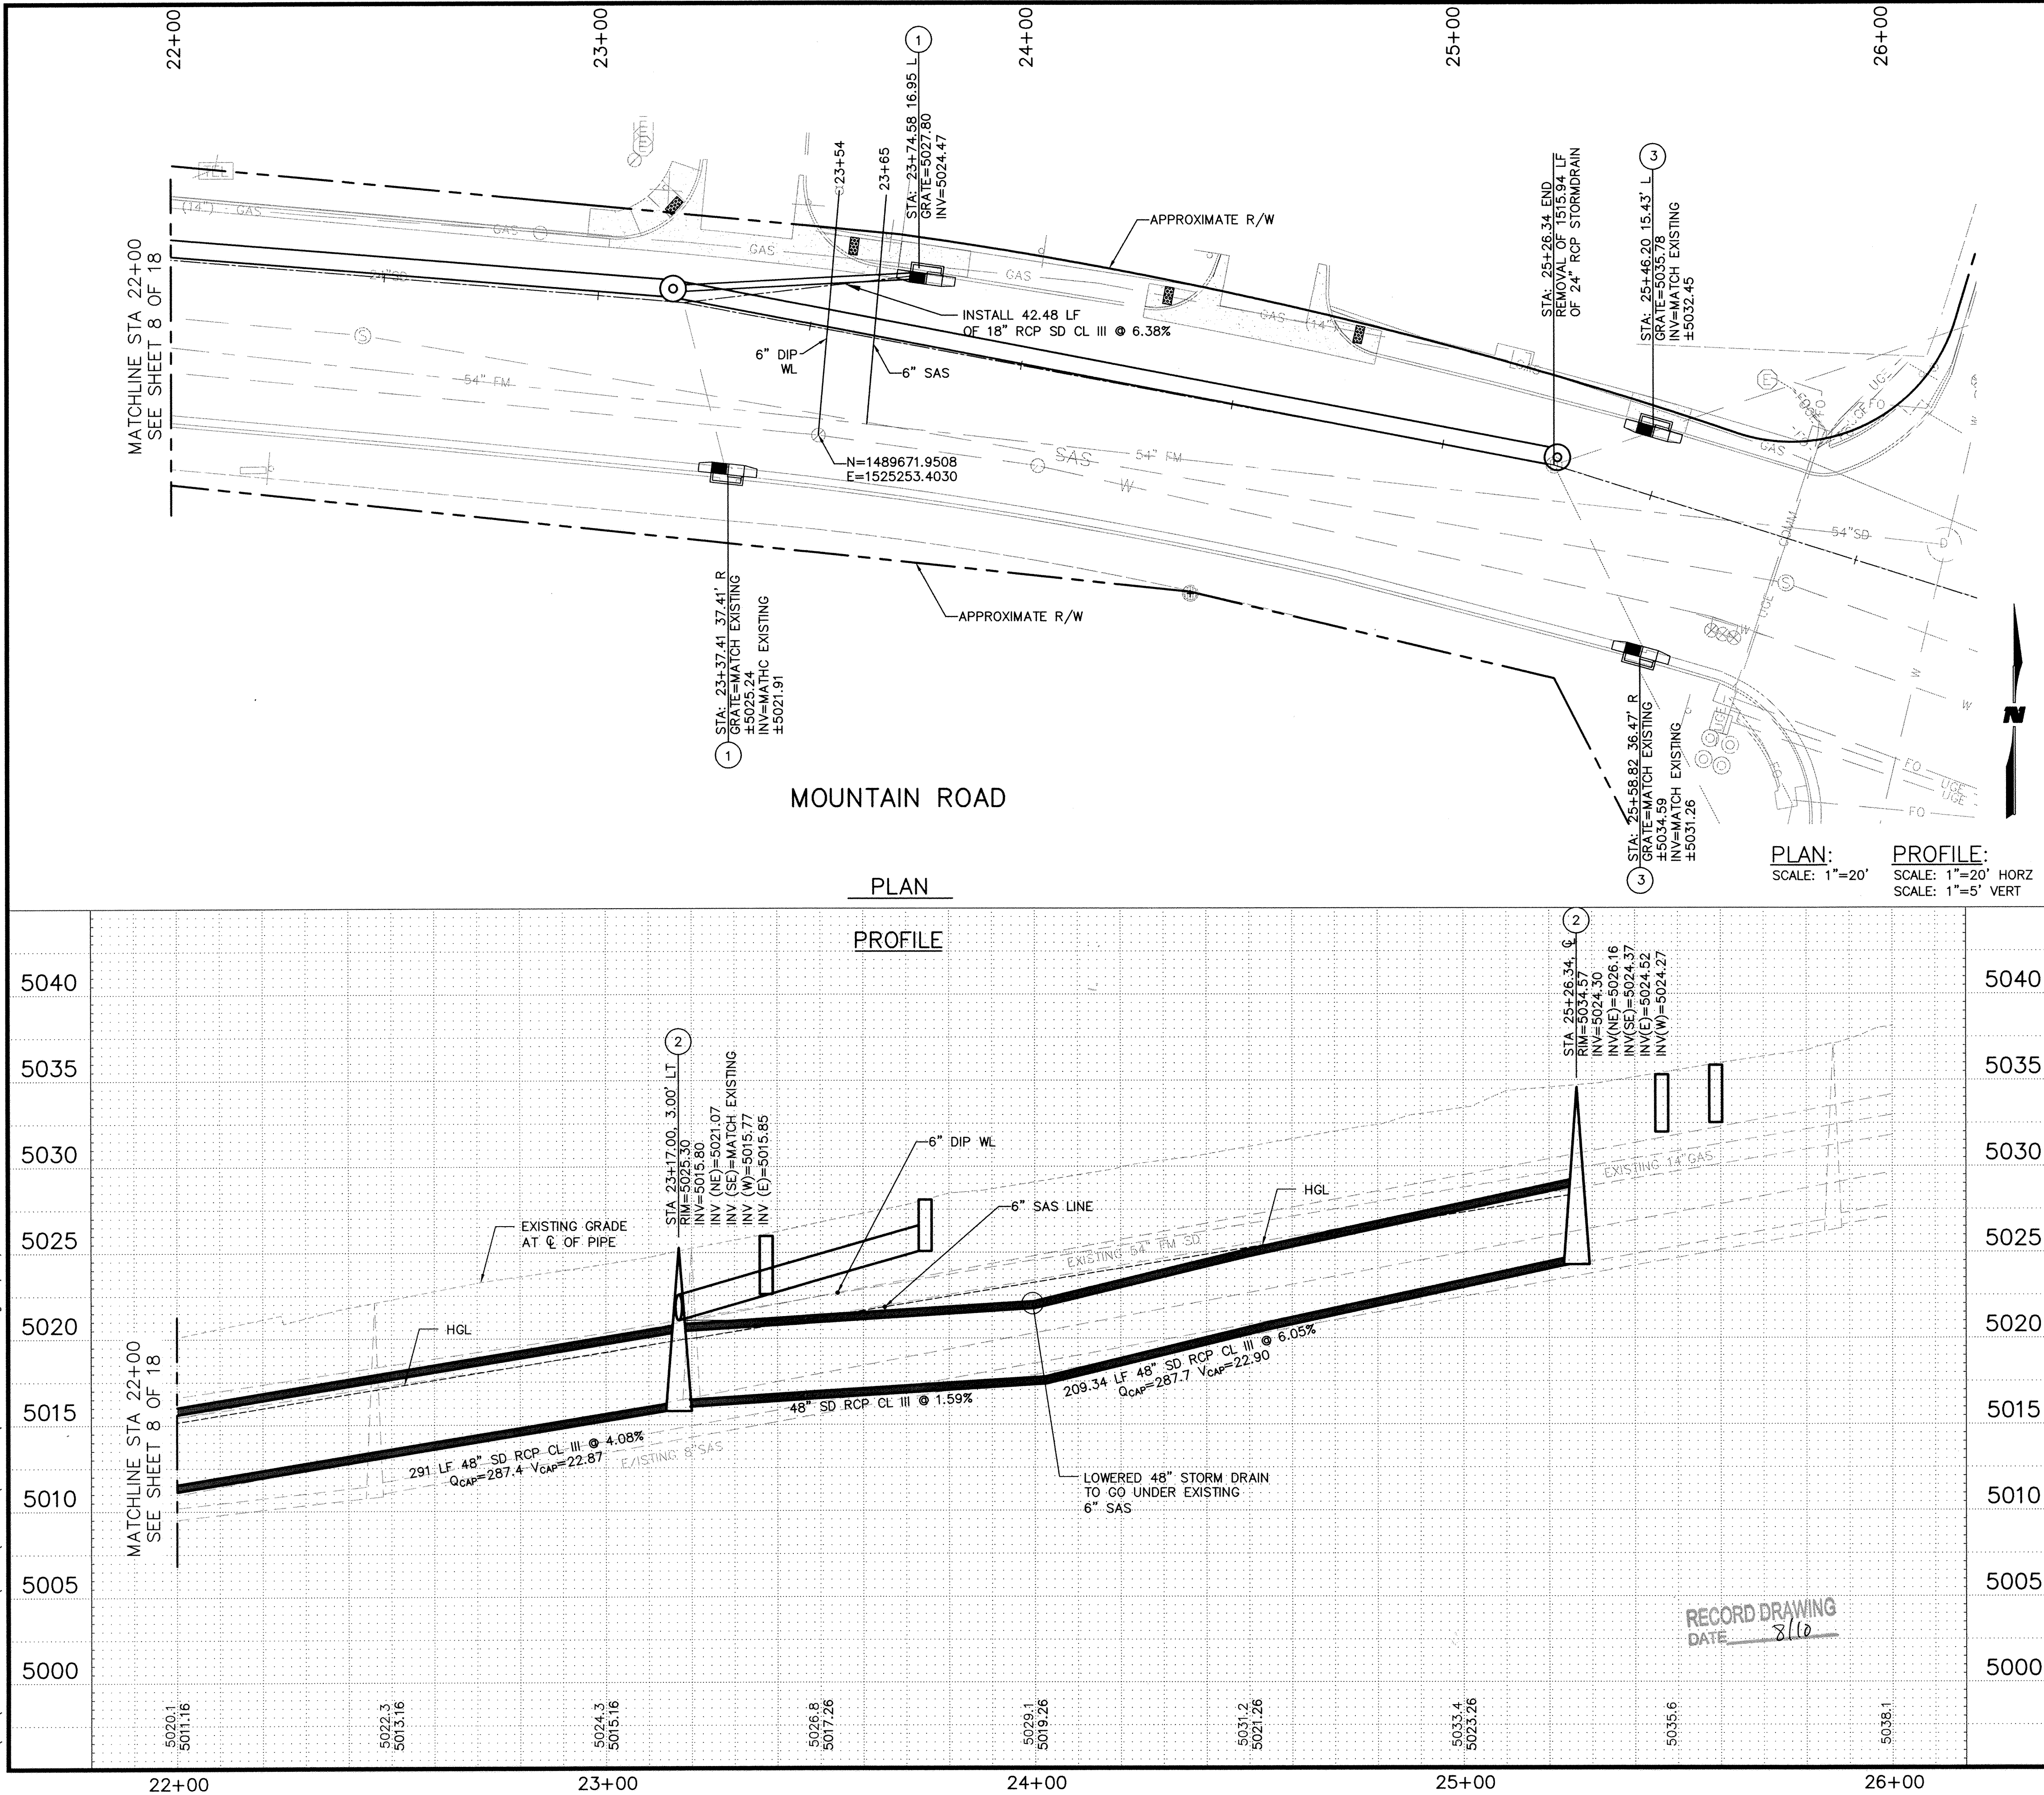

GENERAL NOTES

1

SHEET KEY NOTES

- BUILD STORM DRAIN INLET SINGLE TYPE "A" PER COA STD DWG 2201 & 2220.
- BUILD 6" MANHOLE TYPE "C" PER COA STD DWG 2101.
- BUILD STORM DRAIN INLET DOUBLE TYPE "A" PER COA STD DWG 2201 & 2220.

LEGEND

- INDEX CONTOUR
- INTERMEDIATE CONTOUR
- WATER METER
- UTILITY, TV PEDESTAL
- UTILITY, SANITARY MANHOLE
- UTILITY, STORM DRAINAGE MANHOLE
- UTILITY, WATER VALVE VAULT
- POWER POLE
- LIGHT POLE
- TELEPHONE PEDESTAL
- ELECTRICAL, TRANSFORMER
- UTILITY, TELEPHONE MANHOLE
- UTILITY, TELEPHONE VAULT
- PROPOSED 48" SD
- PROPOSED MH

AS BUILT INFORMATION

BENCH MARKS

ACS 1 1/2" ALUMINUM DISK

STAMPED "ACS BM, 11-J15", EPOXIED ON TOP OF THE CONCRETE CURB RETURN, ESE QUADRANT OF LOMAS BLVD AND WOODWARD PL, NE WOODWARD PL, NE ELEV=5021.86 (NGVD29)

SURVEY INFORMATION

FIELD NOTES

NO. BY DATE

ENGINEER'S SEAL

11-23-08

REVISIONS

DESIGNED BY: TUA
DRAWN BY: JIF
CHECKED BY: MJJ

DATE: JUN 2007
DATE: JUN 2007
DATE: JUN 2007

WILSON & COMPANY

4900 LANG AVENUE NE
ALBUQUERQUE, NEW MEXICO 87109
P (505) 348-4000
F (505) 348-4072

CITY OF ALBUQUERQUE
DEPARTMENT OF MUNICIPAL DEVELOPMENT
ENGINEERING DIVISION



TITLE: MOUNTAIN RD. STORM DRAIN IMPROVEMENTS
MOUNTAIN RD STORM DRAIN PLAN & PROFILE
STA 22+00 TO STA 26+00

Design Review Committee City Engineer Approval



City Project No. 7963.93

Zone Map No. J-15

Sheet 9R Of 18

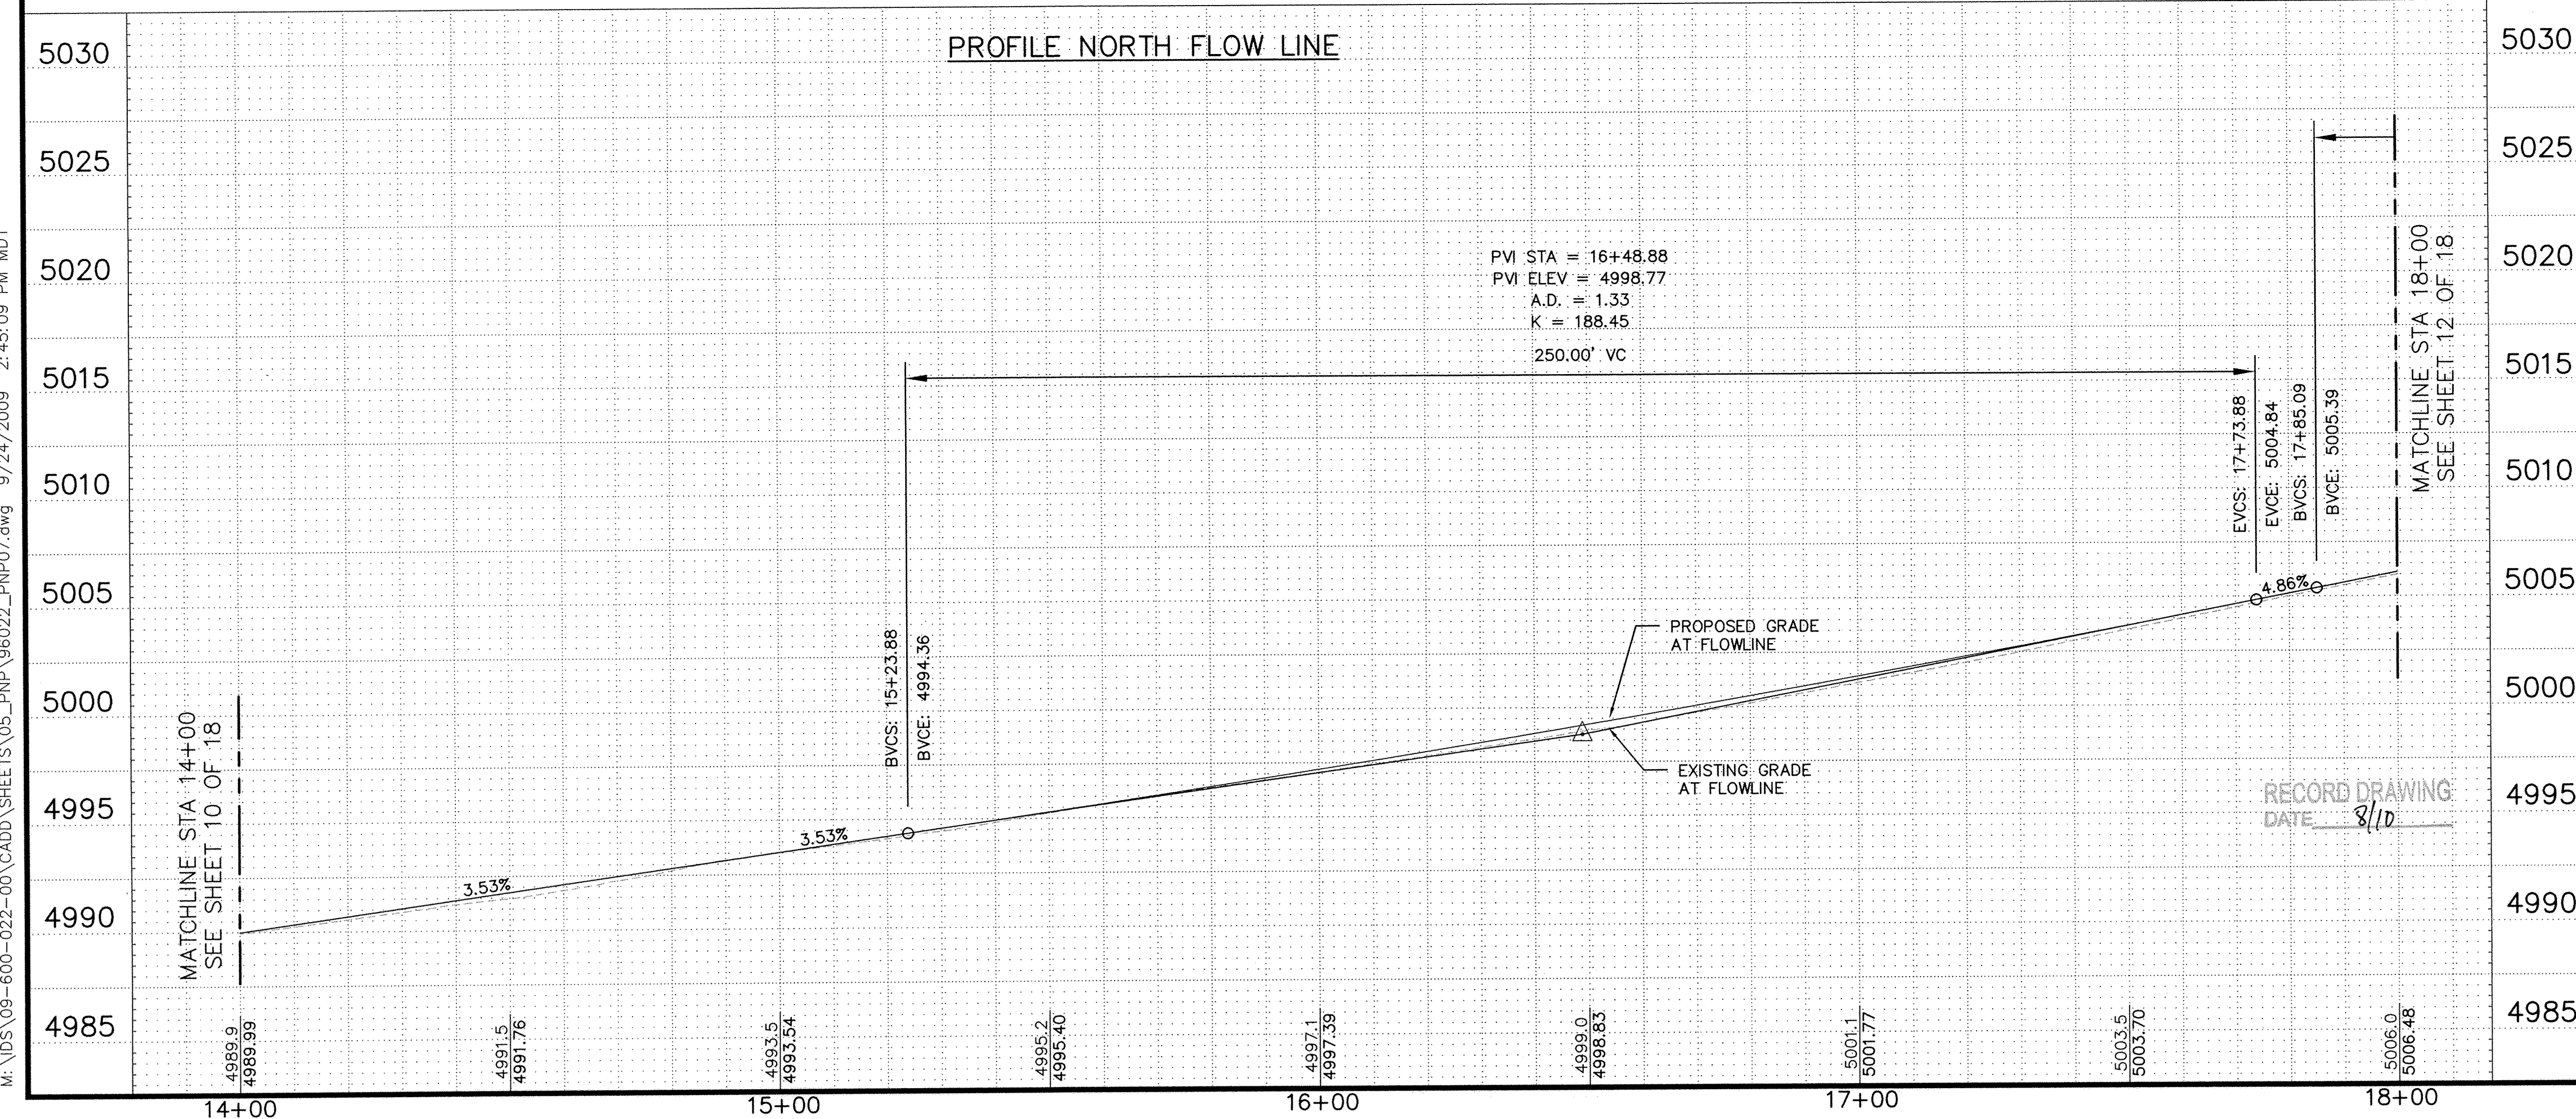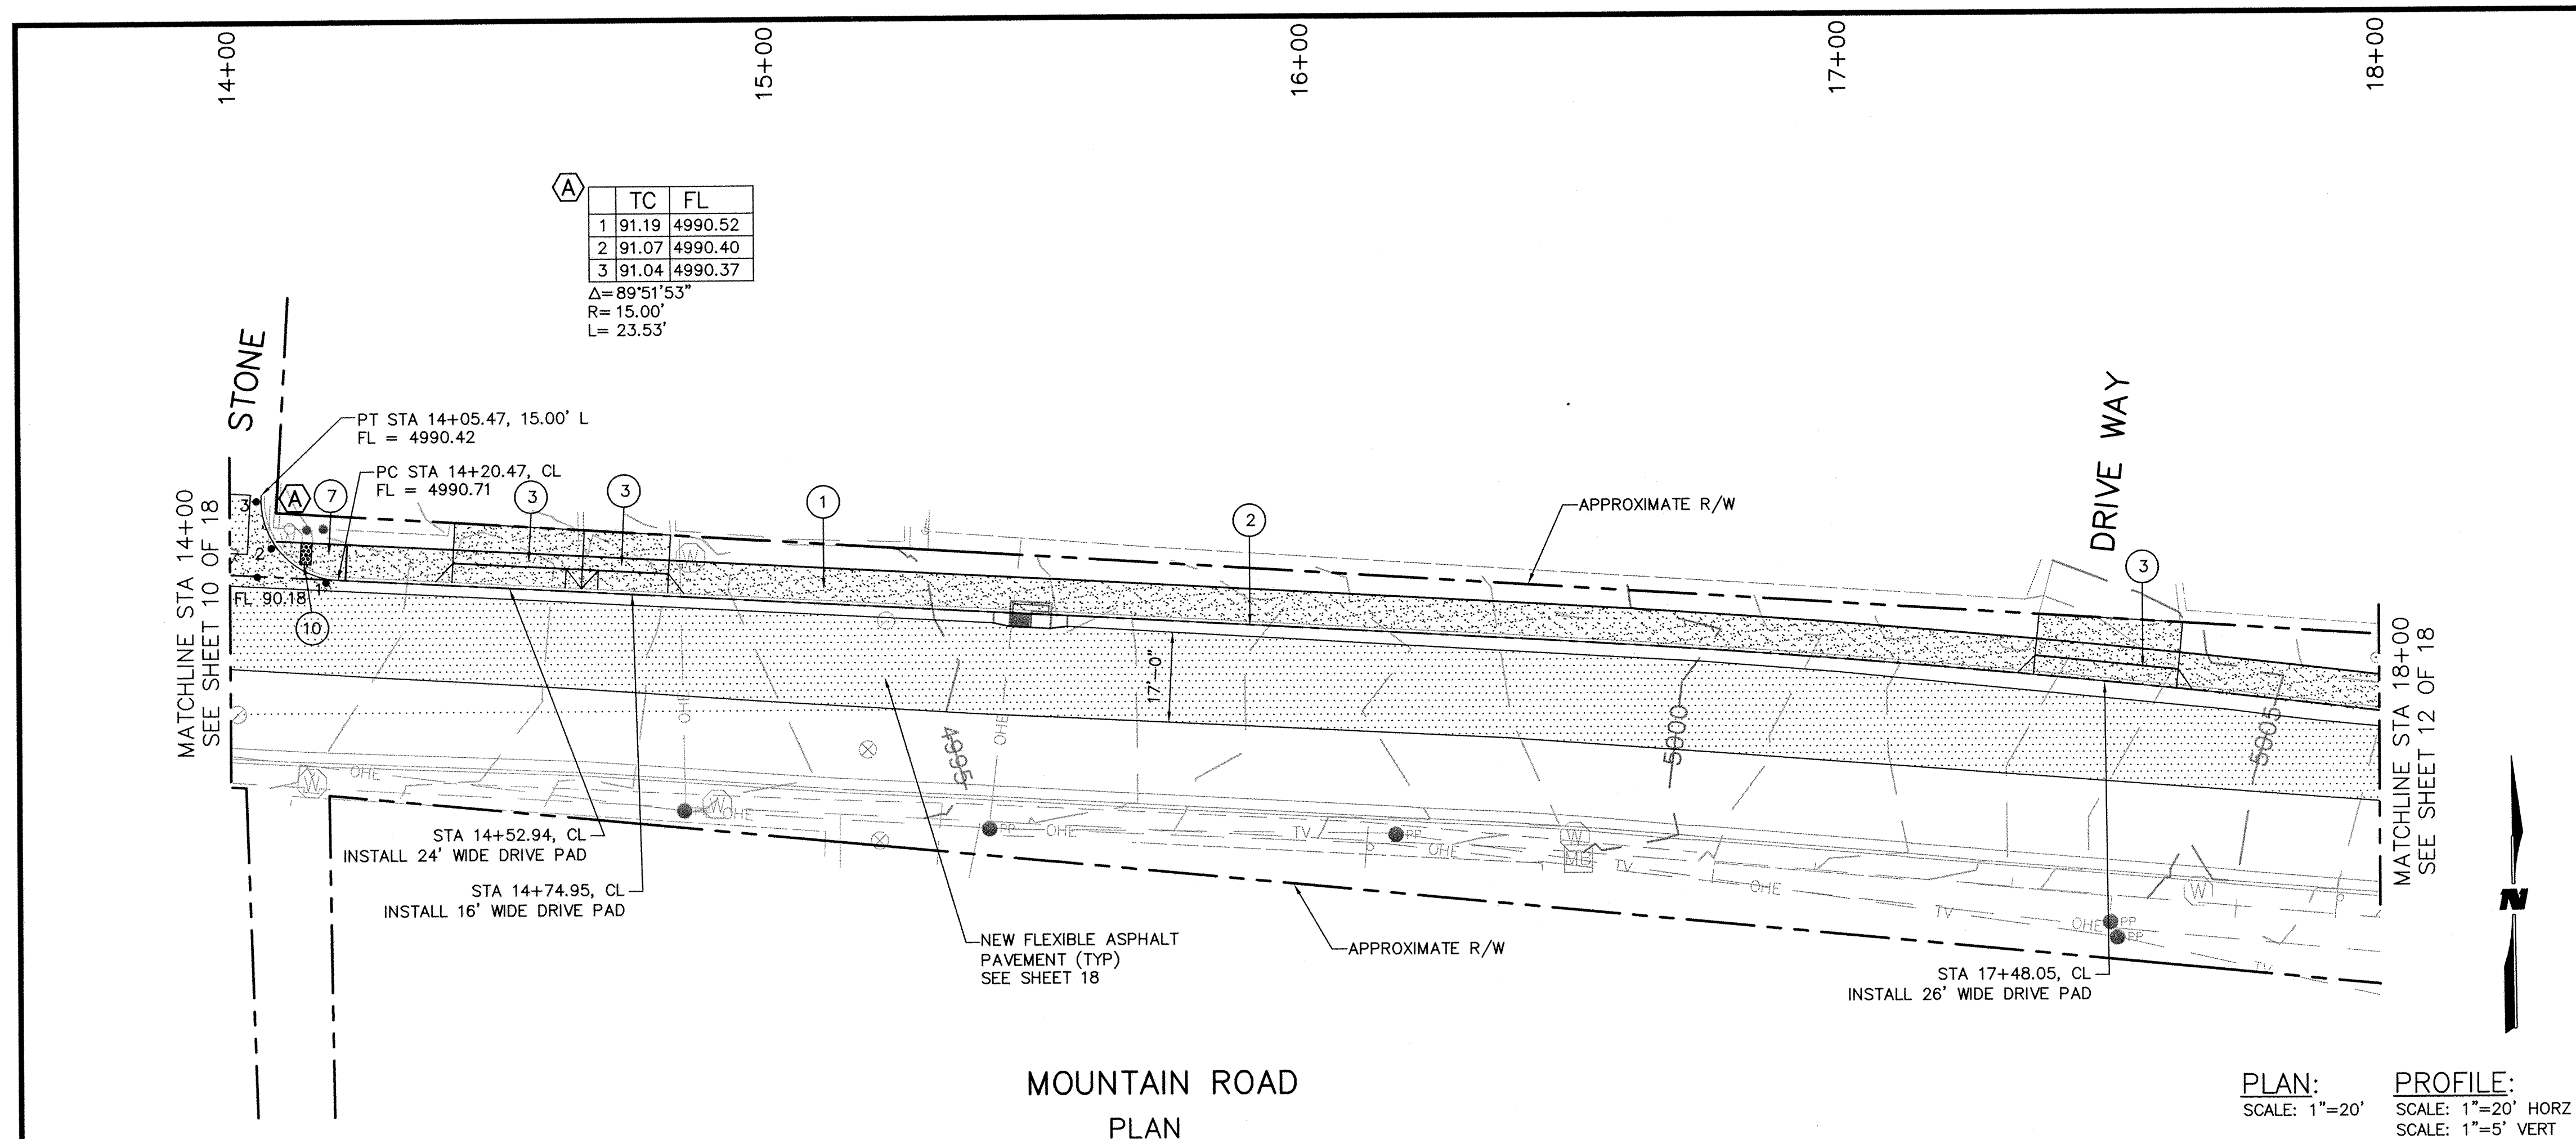

LEGEND		SHEET KEY NOTES		AS BUILT INFORMATION	
○ 1. INSTALL 6' SIDEWALK PER COA STD DWG 2430 2. INSTALL CURB AND GUTTER PER COA STD DWG 2415-A 3. INSTALL DRIVE PAD PER COA STD DWG 2425 4. INSTALL 6'-0" VALLEY GUTTER PER COA STD DWG 2420 7. UNIDIRECTIONAL WHEELCHAIR RAMP PER COA STD DWG 2426 10. DETECTABLE WARNING SURFACE SEE SHEET 18		LEGEND --- INDEX CONTOUR --- INTERMEDIATE CONTOUR WATER METER UTILITY, TV PEDESTAL UTILITY, SANITARY MANHOLE UTILITY, STORM DRAINAGE MANHOLE UTILITY, WATER VALVE VAULT POWER POLE LIGHT POLE TELEPHONE PEDESTAL ELECTRICAL, TRANSFORMER UTILITY, TELEPHONE MANHOLE UTILITY, TELEPHONE VAULT PROPOSED 48" SD PROPOSED MH		CONTRACTOR SHULS BEGS DATE 11/10 WORK STAGED BY SHULS BEGS DATE 11/10 APPROVED BY COA DATE 11/10 FIELD ACCEPTANCE BY COA DATE 11/10 VERIFICATION BY COA DATE 11/10 CORRECTED BY WLI DATE 11/10 MICRO-FILM INFORMATION RECORDED BY _____ DATE _____ NO. _____	
LEGEND --- INDEX CONTOUR --- INTERMEDIATE CONTOUR WATER METER UTILITY, TV PEDESTAL UTILITY, SANITARY MANHOLE UTILITY, STORM DRAINAGE MANHOLE UTILITY, WATER VALVE VAULT POWER POLE LIGHT POLE TELEPHONE PEDESTAL ELECTRICAL, TRANSFORMER UTILITY, TELEPHONE MANHOLE UTILITY, TELEPHONE VAULT PROPOSED 48" SD PROPOSED MH		LEGEND --- INDEX CONTOUR --- INTERMEDIATE CONTOUR WATER METER UTILITY, TV PEDESTAL UTILITY, SANITARY MANHOLE UTILITY, STORM DRAINAGE MANHOLE UTILITY, WATER VALVE VAULT POWER POLE LIGHT POLE TELEPHONE PEDESTAL ELECTRICAL, TRANSFORMER UTILITY, TELEPHONE MANHOLE UTILITY, TELEPHONE VAULT PROPOSED 48" SD PROPOSED MH		CONTRACTOR SHULS BEGS DATE 11/10 WORK STAGED BY SHULS BEGS DATE 11/10 APPROVED BY COA DATE 11/10 FIELD ACCEPTANCE BY COA DATE 11/10 VERIFICATION BY COA DATE 11/10 CORRECTED BY WLI DATE 11/10 MICRO-FILM INFORMATION RECORDED BY _____ DATE _____ NO. _____	
LEGEND --- INDEX CONTOUR --- INTERMEDIATE CONTOUR WATER METER UTILITY, TV PEDESTAL UTILITY, SANITARY MANHOLE UTILITY, STORM DRAINAGE MANHOLE UTILITY, WATER VALVE VAULT POWER POLE LIGHT POLE TELEPHONE PEDESTAL ELECTRICAL, TRANSFORMER UTILITY, TELEPHONE MANHOLE UTILITY, TELEPHONE VAULT PROPOSED 48" SD PROPOSED MH		LEGEND --- INDEX CONTOUR --- INTERMEDIATE CONTOUR WATER METER UTILITY, TV PEDESTAL UTILITY, SANITARY MANHOLE UTILITY, STORM DRAINAGE MANHOLE UTILITY, WATER VALVE VAULT POWER POLE LIGHT POLE TELEPHONE PEDESTAL ELECTRICAL, TRANSFORMER UTILITY, TELEPHONE MANHOLE UTILITY, TELEPHONE VAULT PROPOSED 48" SD PROPOSED MH		CONTRACTOR SHULS BEGS DATE 11/10 WORK STAGED BY SHULS BEGS DATE 11/10 APPROVED BY COA DATE 11/10 FIELD ACCEPTANCE BY COA DATE 11/10 VERIFICATION BY COA DATE 11/1	

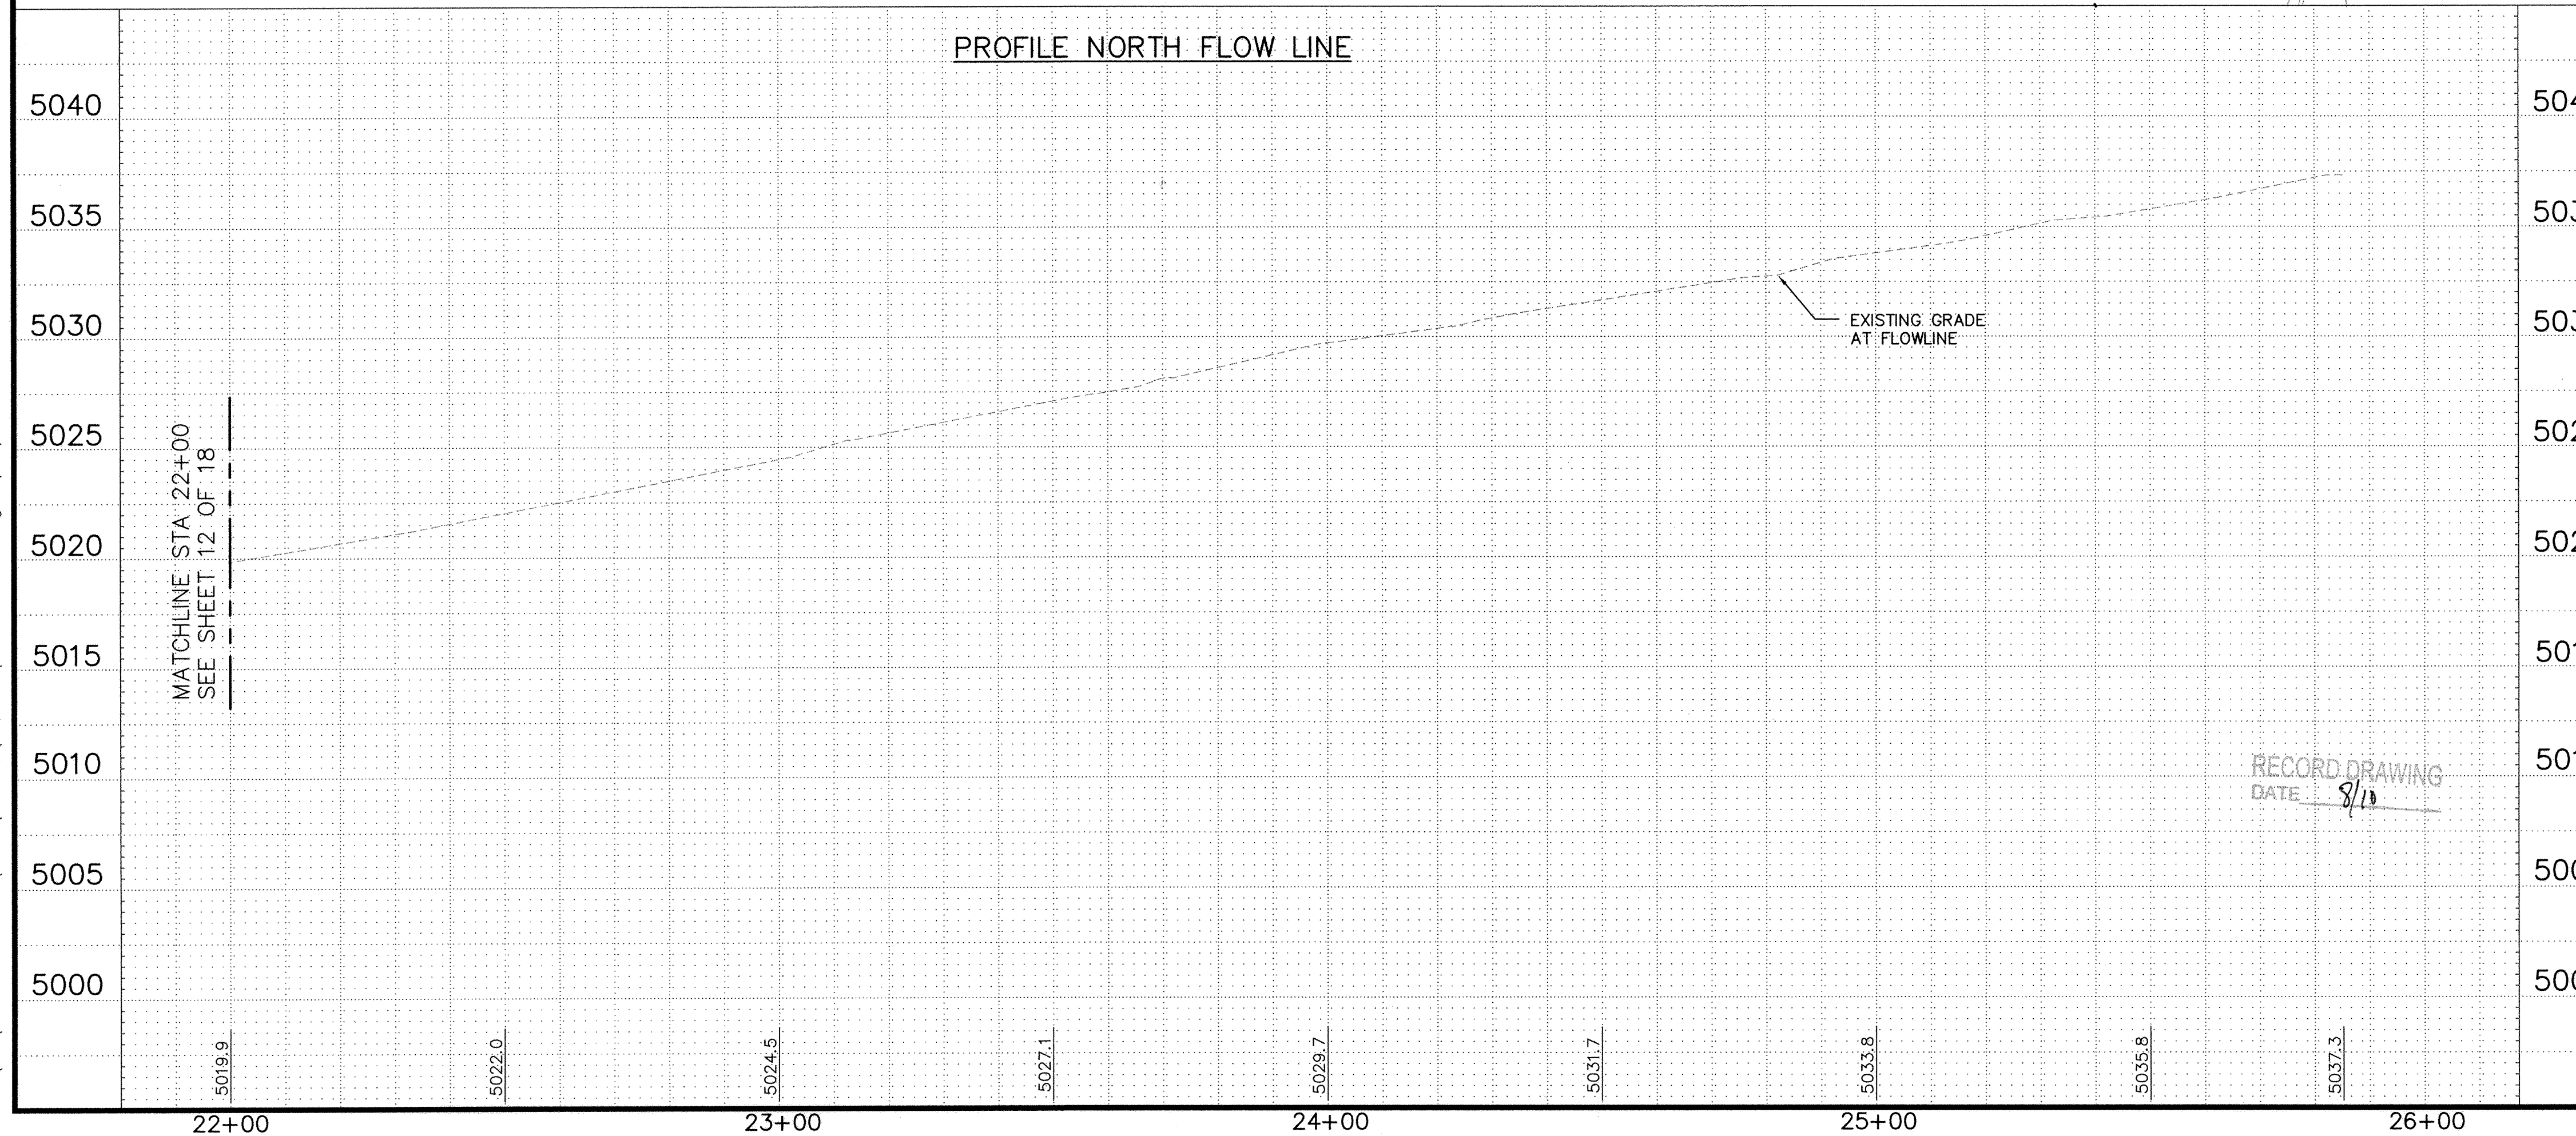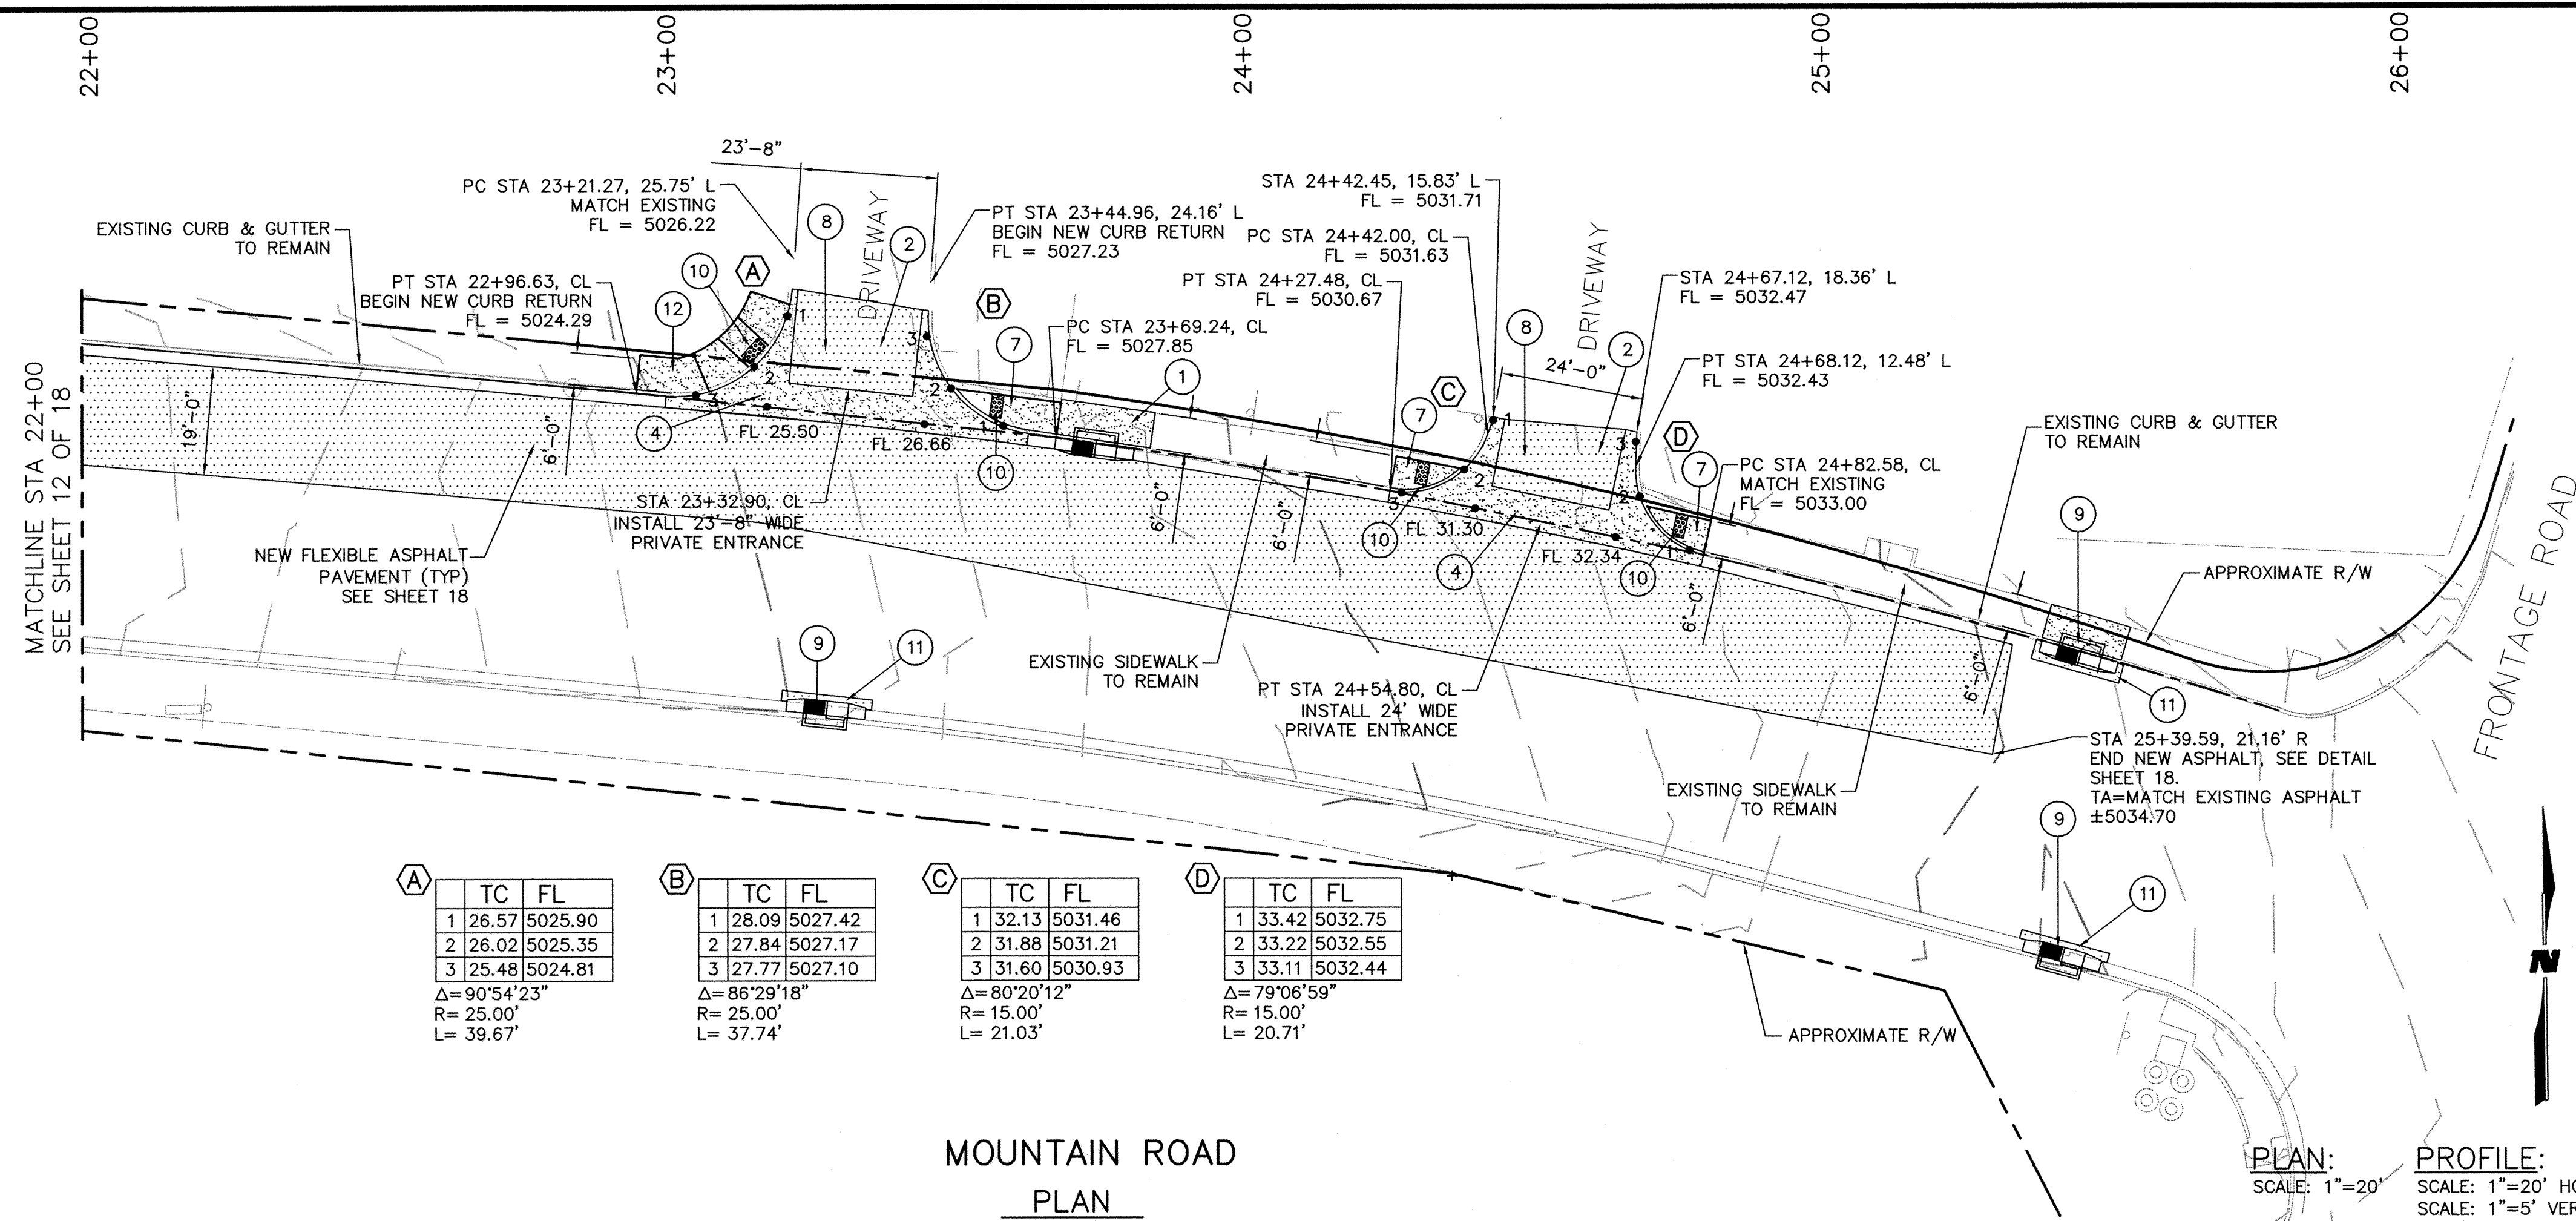


- # SHEET KEY NOTES
- 1) INSTALL 6" SIDEWALK PER COA STD DWG 2430.
 - 2) INSTALL RESIDENTIAL PAVEMENT SECTION,
SEE DETAIL SHEET 18.
 - 4) INSTALL 6"-0" VALLEY GUTTER PER COA
STD DWG 2420
 - 7) UNIDIRECTIONAL WHEELCHAIR RAMP
PER COA STD DWG 2426
 - 8) INSTALL PRIVATE ENTRANCE
PER COA STD DWG 2426
 - 9) REMOVE AND REPLACE SIDEWALK AND
CURB AND GUTTER AT NEW INLETS
 - 10) DETECTABLE WARNING SURFACE SEE SHEET 18
 - 11) SAWCUT NEAT LINE, REMOVE AND REPLACE
ASPHALT PER COA SECTION 343.
 - 12) WHEELCHAIR RAMP PER COA STD DWG 2441
CASE I.

- | | |
|--|---------------------------------|
| --- | INDEX CONTOUR |
| --- | INTERMEDIATE CONTOUR |
|  | WATER METER |
|  | UTILITY, TV PEDESTAL |
|  | UTILITY, SANITARY MANHOLE |
|  | UTILITY, STORM DRAINAGE MANHOLE |
|  | UTILITY, WATER VALVE VAULT |
|  PP | POWER POLE |
|  | LIGHT POLE |
|  | TELEPHONE PEDESTAL |
|  | ELECTRICAL, TRANSFORMER |
|  | UTILITY, TELEPHONE MANHOLE |
|  | UTILITY, TELEPHONE VAULT |
| == | PROPOSED 48" SD |
| == | PROPOSED MH |

QUERQUE										PAL DEVELOPMENT DIVISION										AIN IMPROVEMENTS N & PROFILE										26+00										
Last Design Update	Mo./Day/Yr.										Mo./Day/Yr.																													
No.	Sheet										Of										18																			

										ENGINEER'S SEAL		SURVEY INFORMATION		BENCH MARKS		AS BUILT INFORMATION	
												FIELD NOTES		ACS 1 3/4" ALUMINUM DISK,		SHALLS BEGS	
												BY		DATE		DATE 8/10	
												NO.				WORK	
																CONTRACTOR	
																STAMPED BY	
																DATE 8/10	
																ADJUSTMENTS	
																ACCEPTANCE BY	
																DATE 8/10	
																FIELD	
																VERIFICATION BY	
																DATE 8/10	
																CHANGES	
																CORRECTED BY	
																DATE 8/10	
																MICRO-FILM INFORMATION	
																RECORDED BY	
																DATE	
																NO.	

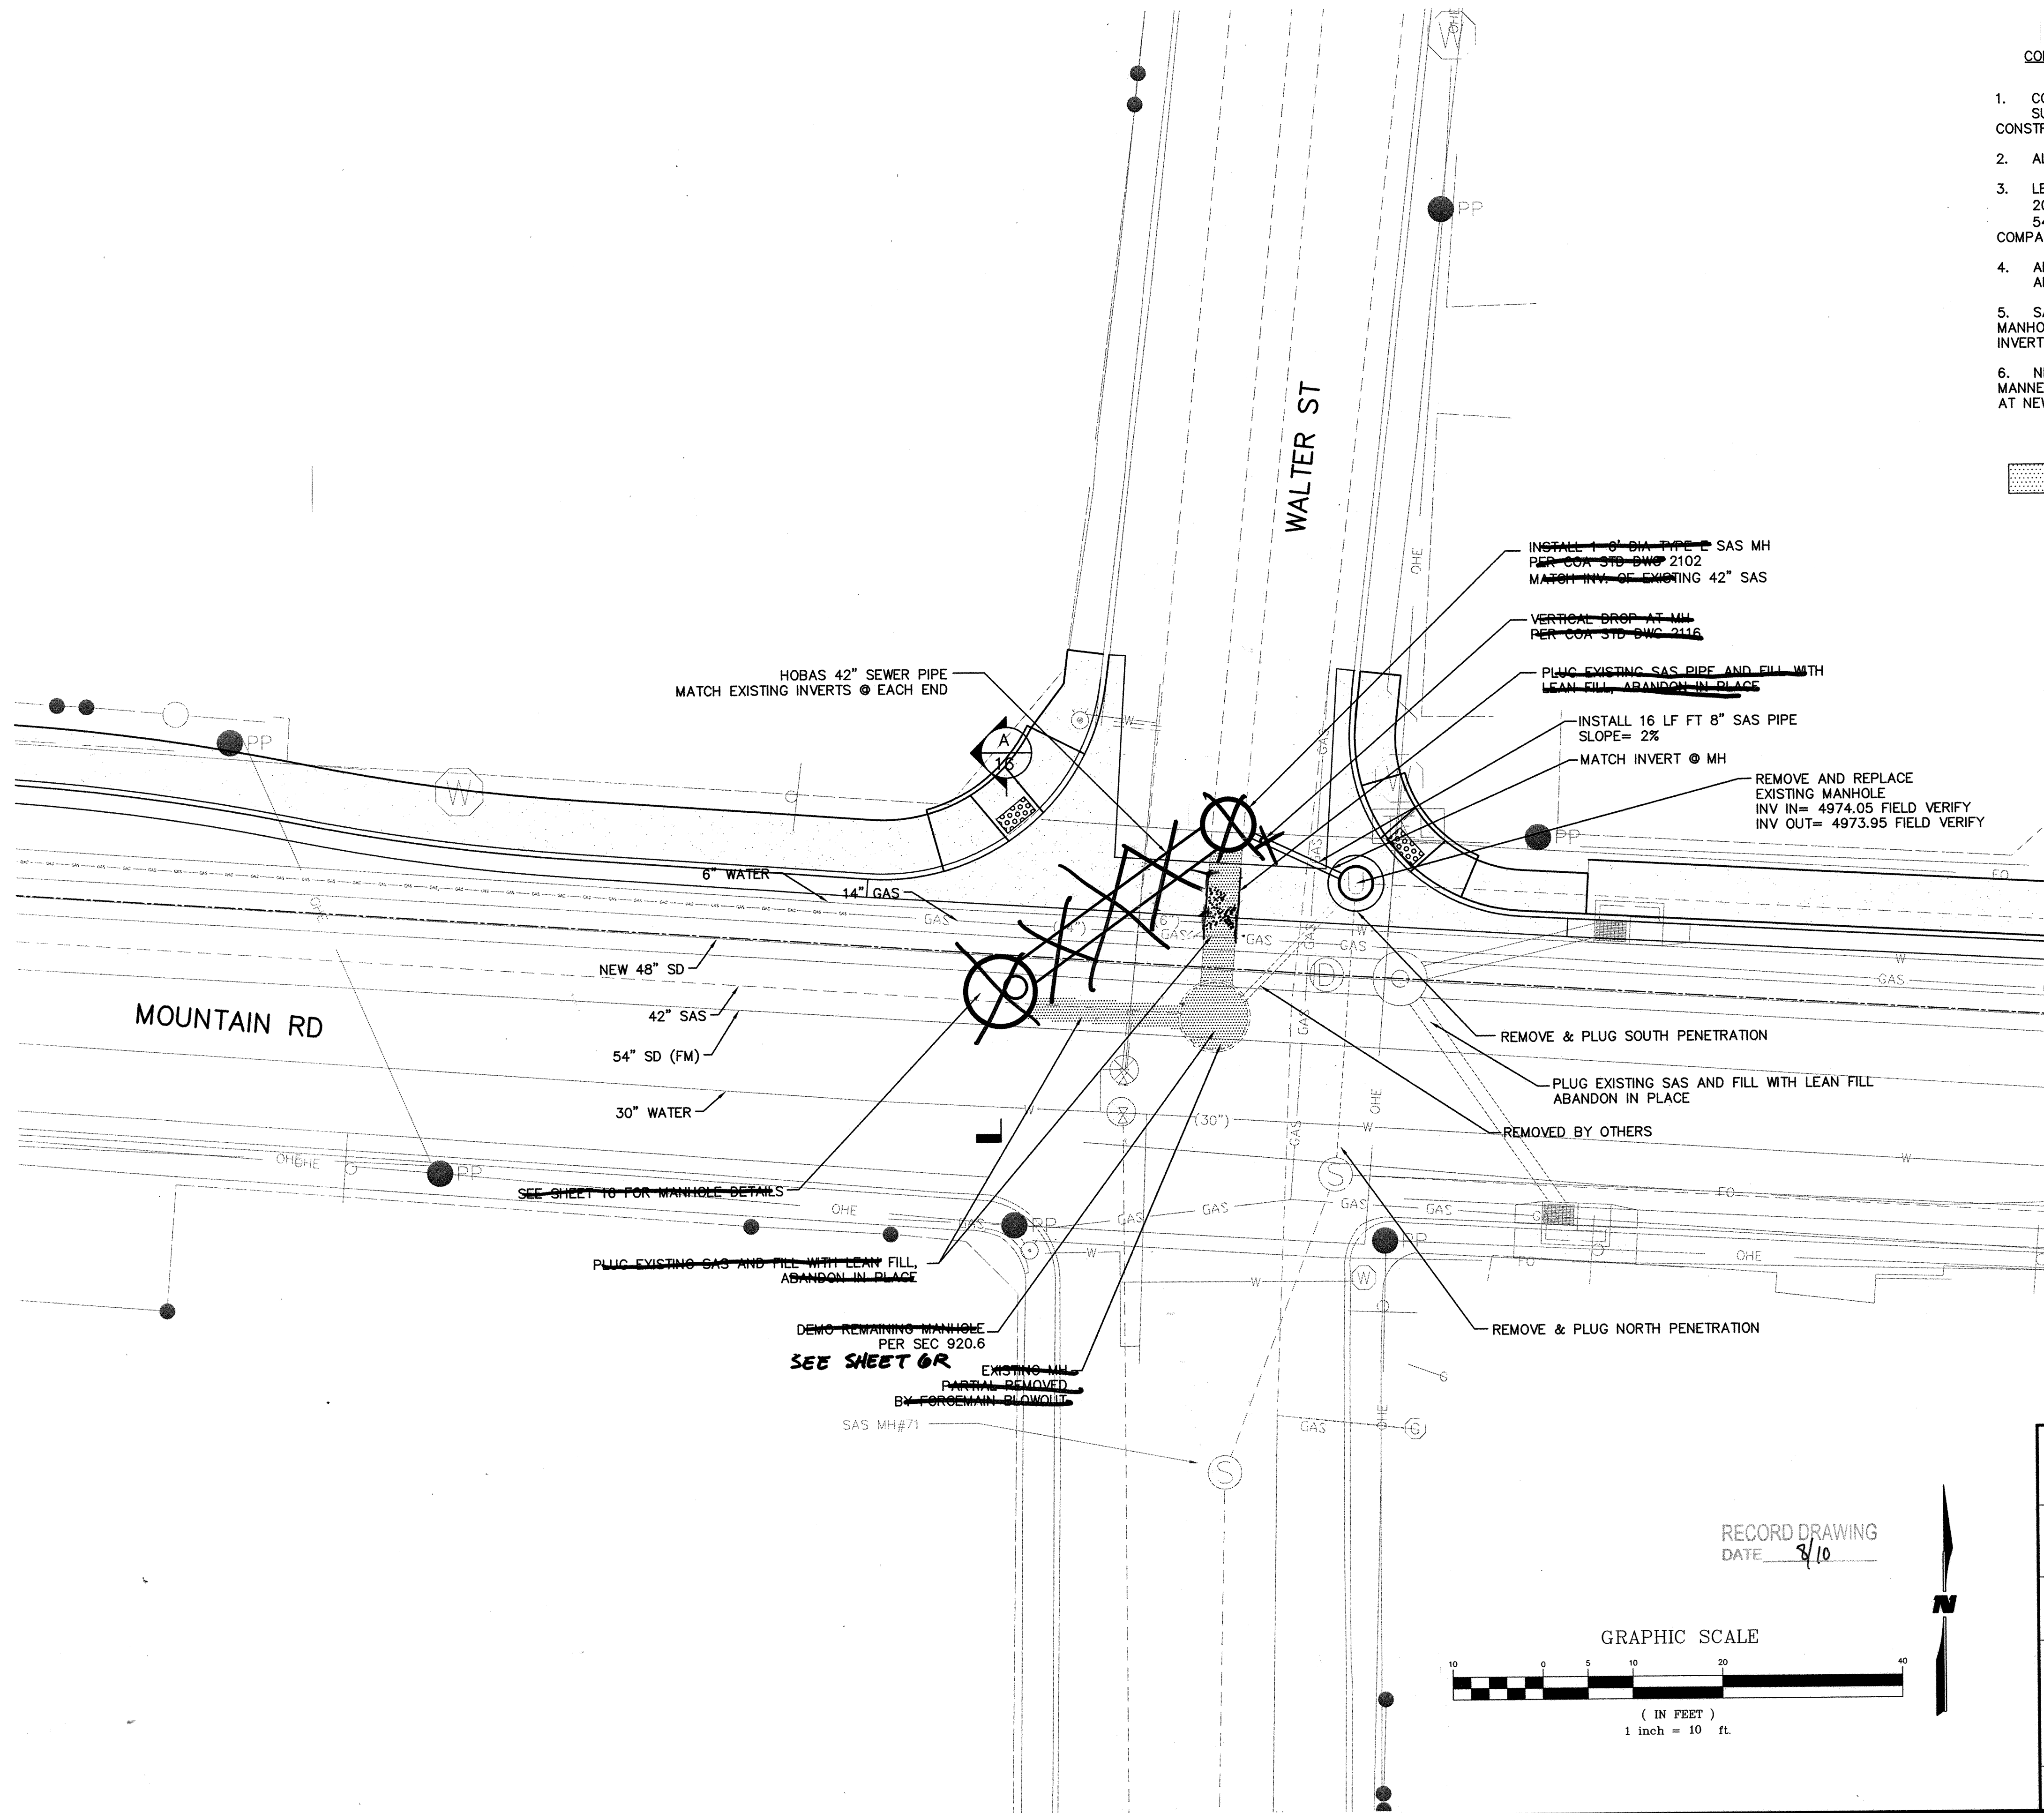

CONSTRUCTION NOTES

1. CONTRACTOR TO PROVIDE ADEQUATE SHORING OR SUPPORT OF ALL UTILITIES AS NECESSARY TO CONSTRUCT NEW FACILITIES SHOWN
2. ALL BACKFILL SHALL BE COMPACTED TO 95%
3. LEAN FILL MEETING COA STANDARD SPECIFICATION 207 SHALL BE USED FOR THE LAST 2' UNDER THE 54" FORCE MAIN AND IN ALL AREAS WHERE COMPACTION EQUIPMENT CAN NOT BE USED
4. ABANDONED SAS SHALL BE FILLED WITH LEAN FILL AND PLUGGED AS APPROVED BY FIELD ENGINEER
5. SAS PIPE SHALL BE REMOVED INSIDE NEW MANHOLES AS NECESSARY TO FORM AND POUR NEW INVERTS
6. NEW SAS PIPE SHALL BE PLACED IN SUCH A MANNER TO MATCH EXISTING INVERTS AND ALIGNMENTS AT NEW MANHOLES

LEAN FILL

AS BUILT INFORMATION		BENCH MARKS		SURVEY INFORMATION		ENGINEER'S SEAL	
CONTRACTOR	DATE	STAMPED "ACS BM, 11-115"	DATE	NO.	BY		REMARKS REVISIONS DESIGN
WORK BY	DATE	EXPOSED ON TOP OF THE	DATE				
INSPECTOR'S	DATE	CONCRETE CURB RETURN, ESE	DATE				
ACCEPTANCE BY	DATE	QUADRANT OF LOMAS BLVD AND	DATE				
MICRO-FILM INFORMATION		WOODWARD PL, NE				DESIGNED BY: TJA	
RECORDED BY		ELEV=5021.86 (NGVD29)				DRAWN BY: JIF	
NO.						CHECKED BY: MJJ	
						DATE: JUN 2007	
						DATE: JUN 2007	
						DATE: JUN 2007	

4900 LANG AVENUE NE
ALBUQUERQUE, NEW MEXICO 87109
(505) 348-4000
FAX (505) 348-4072

CITY OF ALBUQUERQUE
DEPARTMENT OF MUNICIPAL DEVELOPMENT
ENGINEERING DIVISION

TITLE: **MOUNTAIN RD. STORM DRAIN IMPROVEMENTS**
SAS RELOCATION SITE PLAN

Design Review Committee	City Engineer Approval
DESIGN REVIEW COMMITTEE	CITY ENGINEER


City Project No.	7963.93	Zone Map No.	J-15	Sheet	14	Of	18
------------------	---------	--------------	------	-------	----	----	----

M:\JDS\09-600-022-00\CADD\SHEETS\05_PNP\96022_PNP05.dwg 9/29/2009 10:42:53 AM MDT

11+00

12+00

13+00

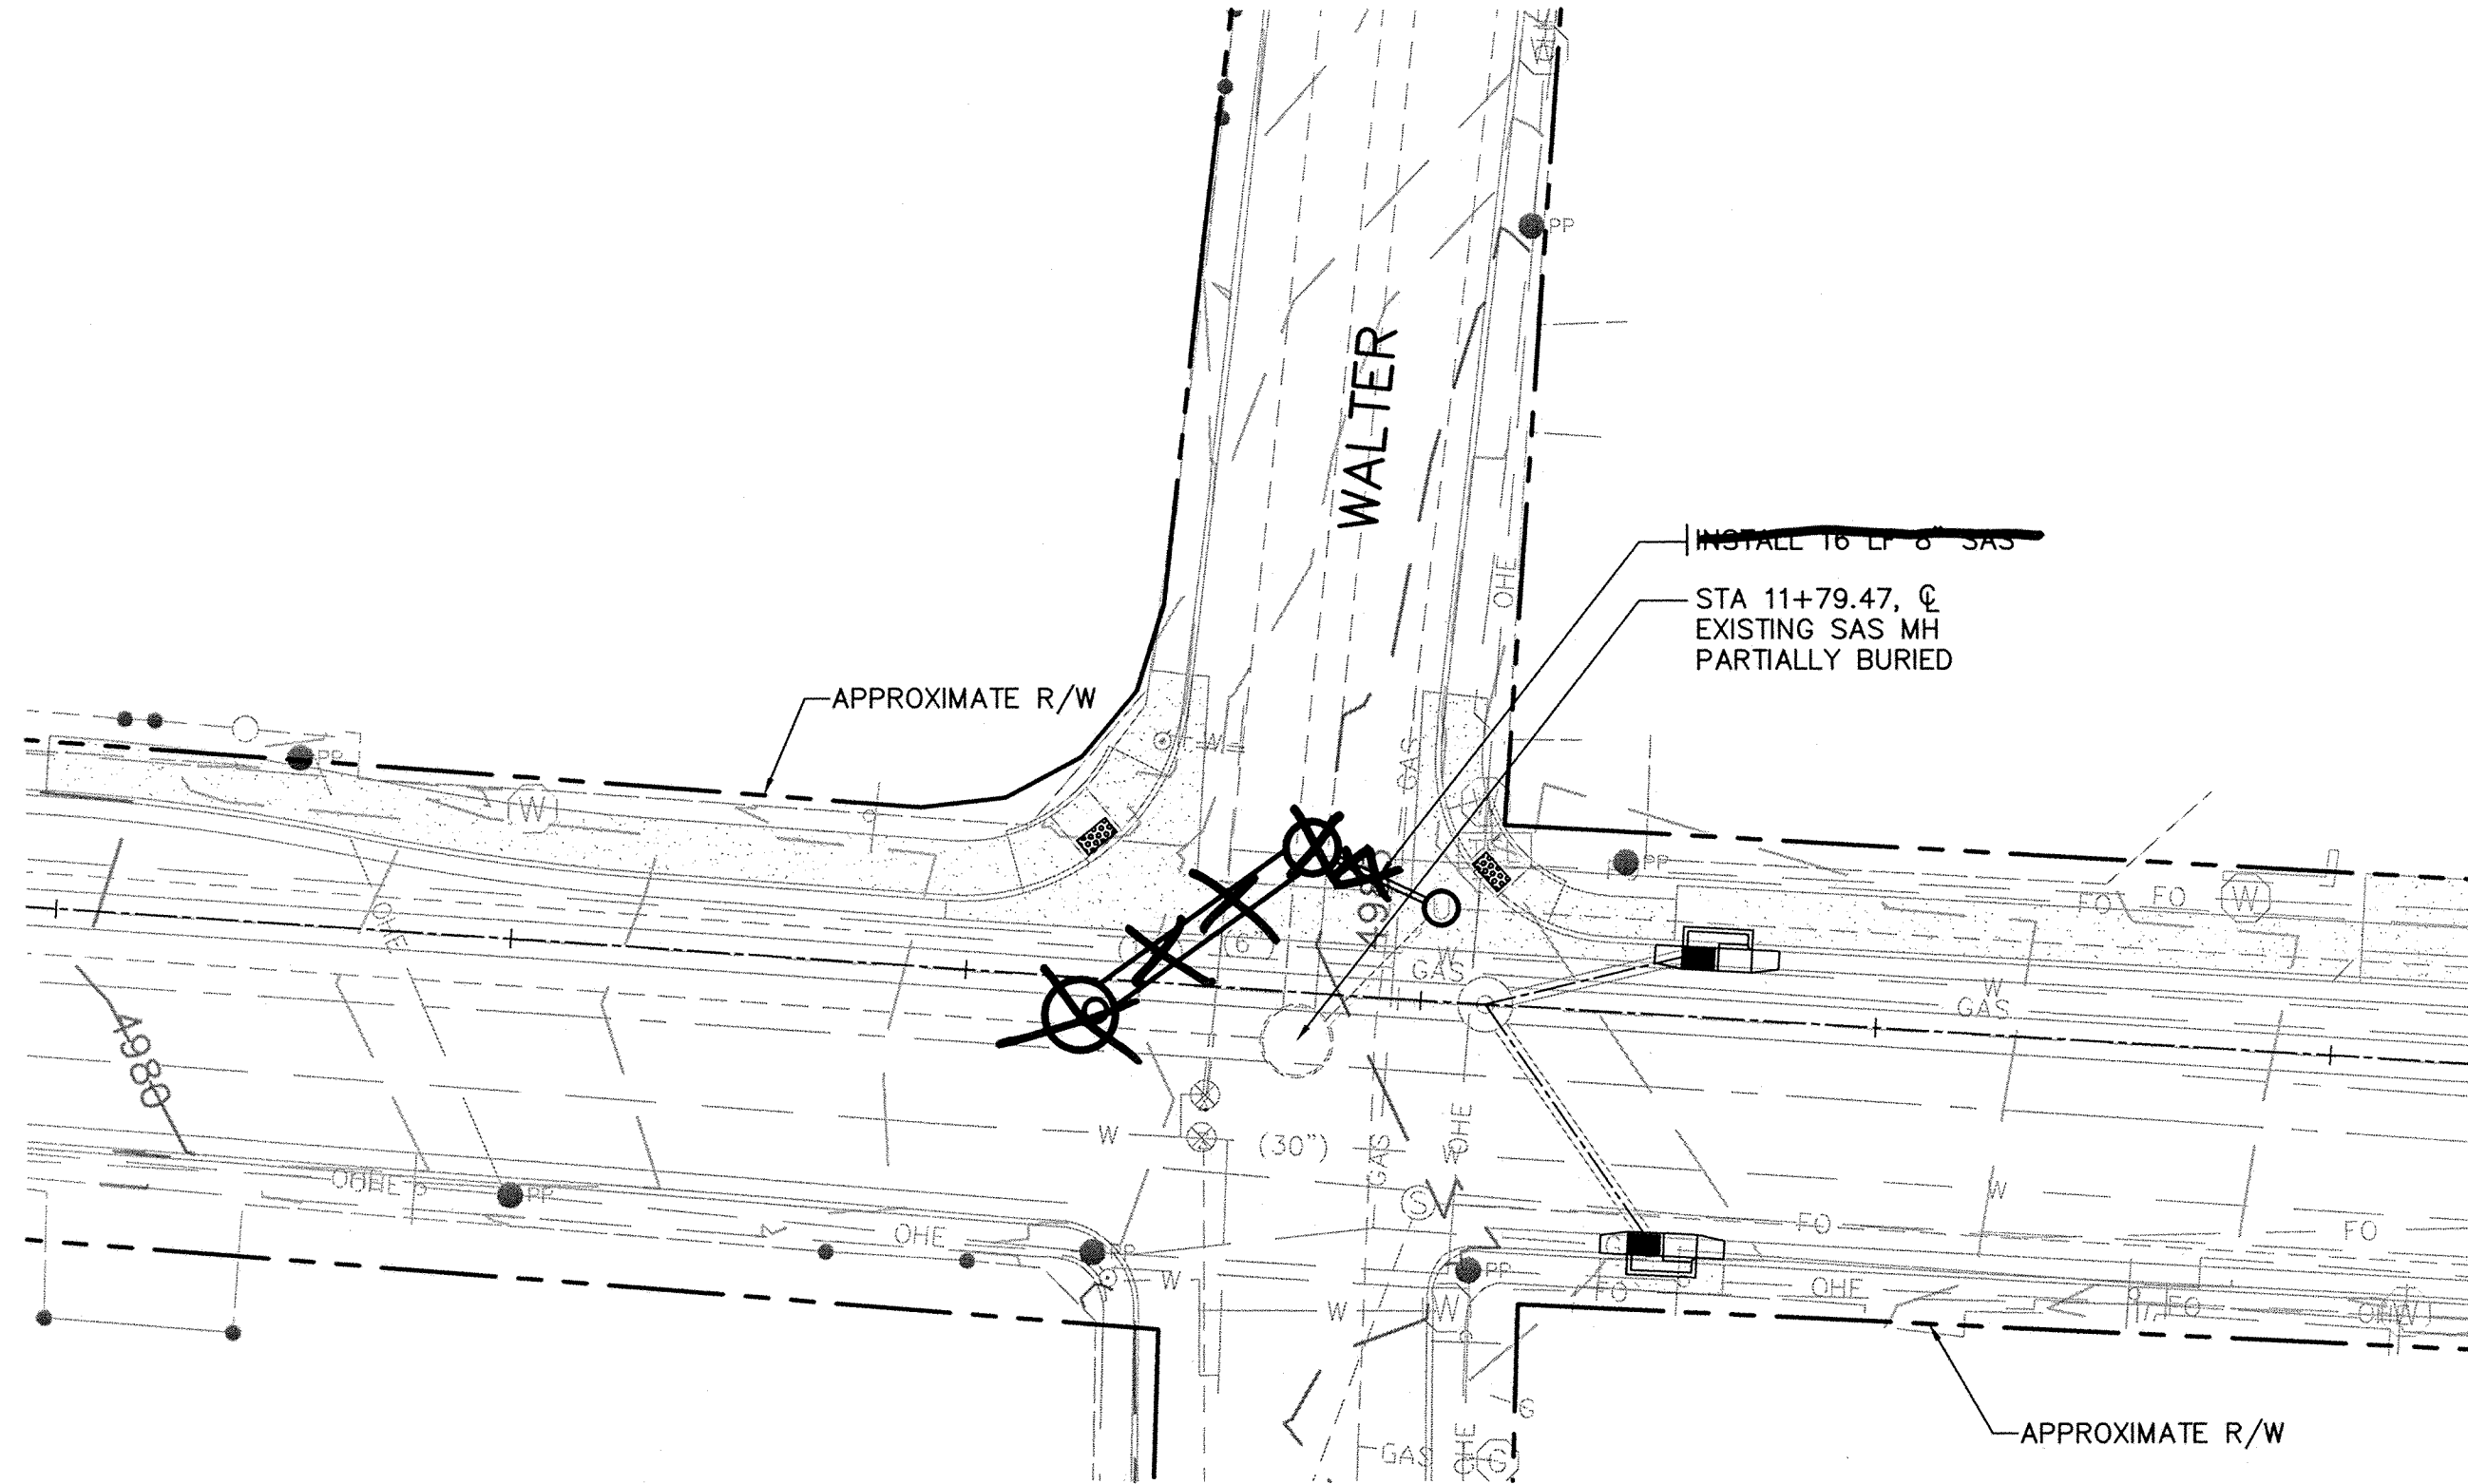


MOUNTAIN ROAD
PLAN

PLAN:
SCALE: 1"=20'

PROFILE:
SCALE: 1"=20' HORIZ
SCALE: 1"=5' VERT

PROFILE

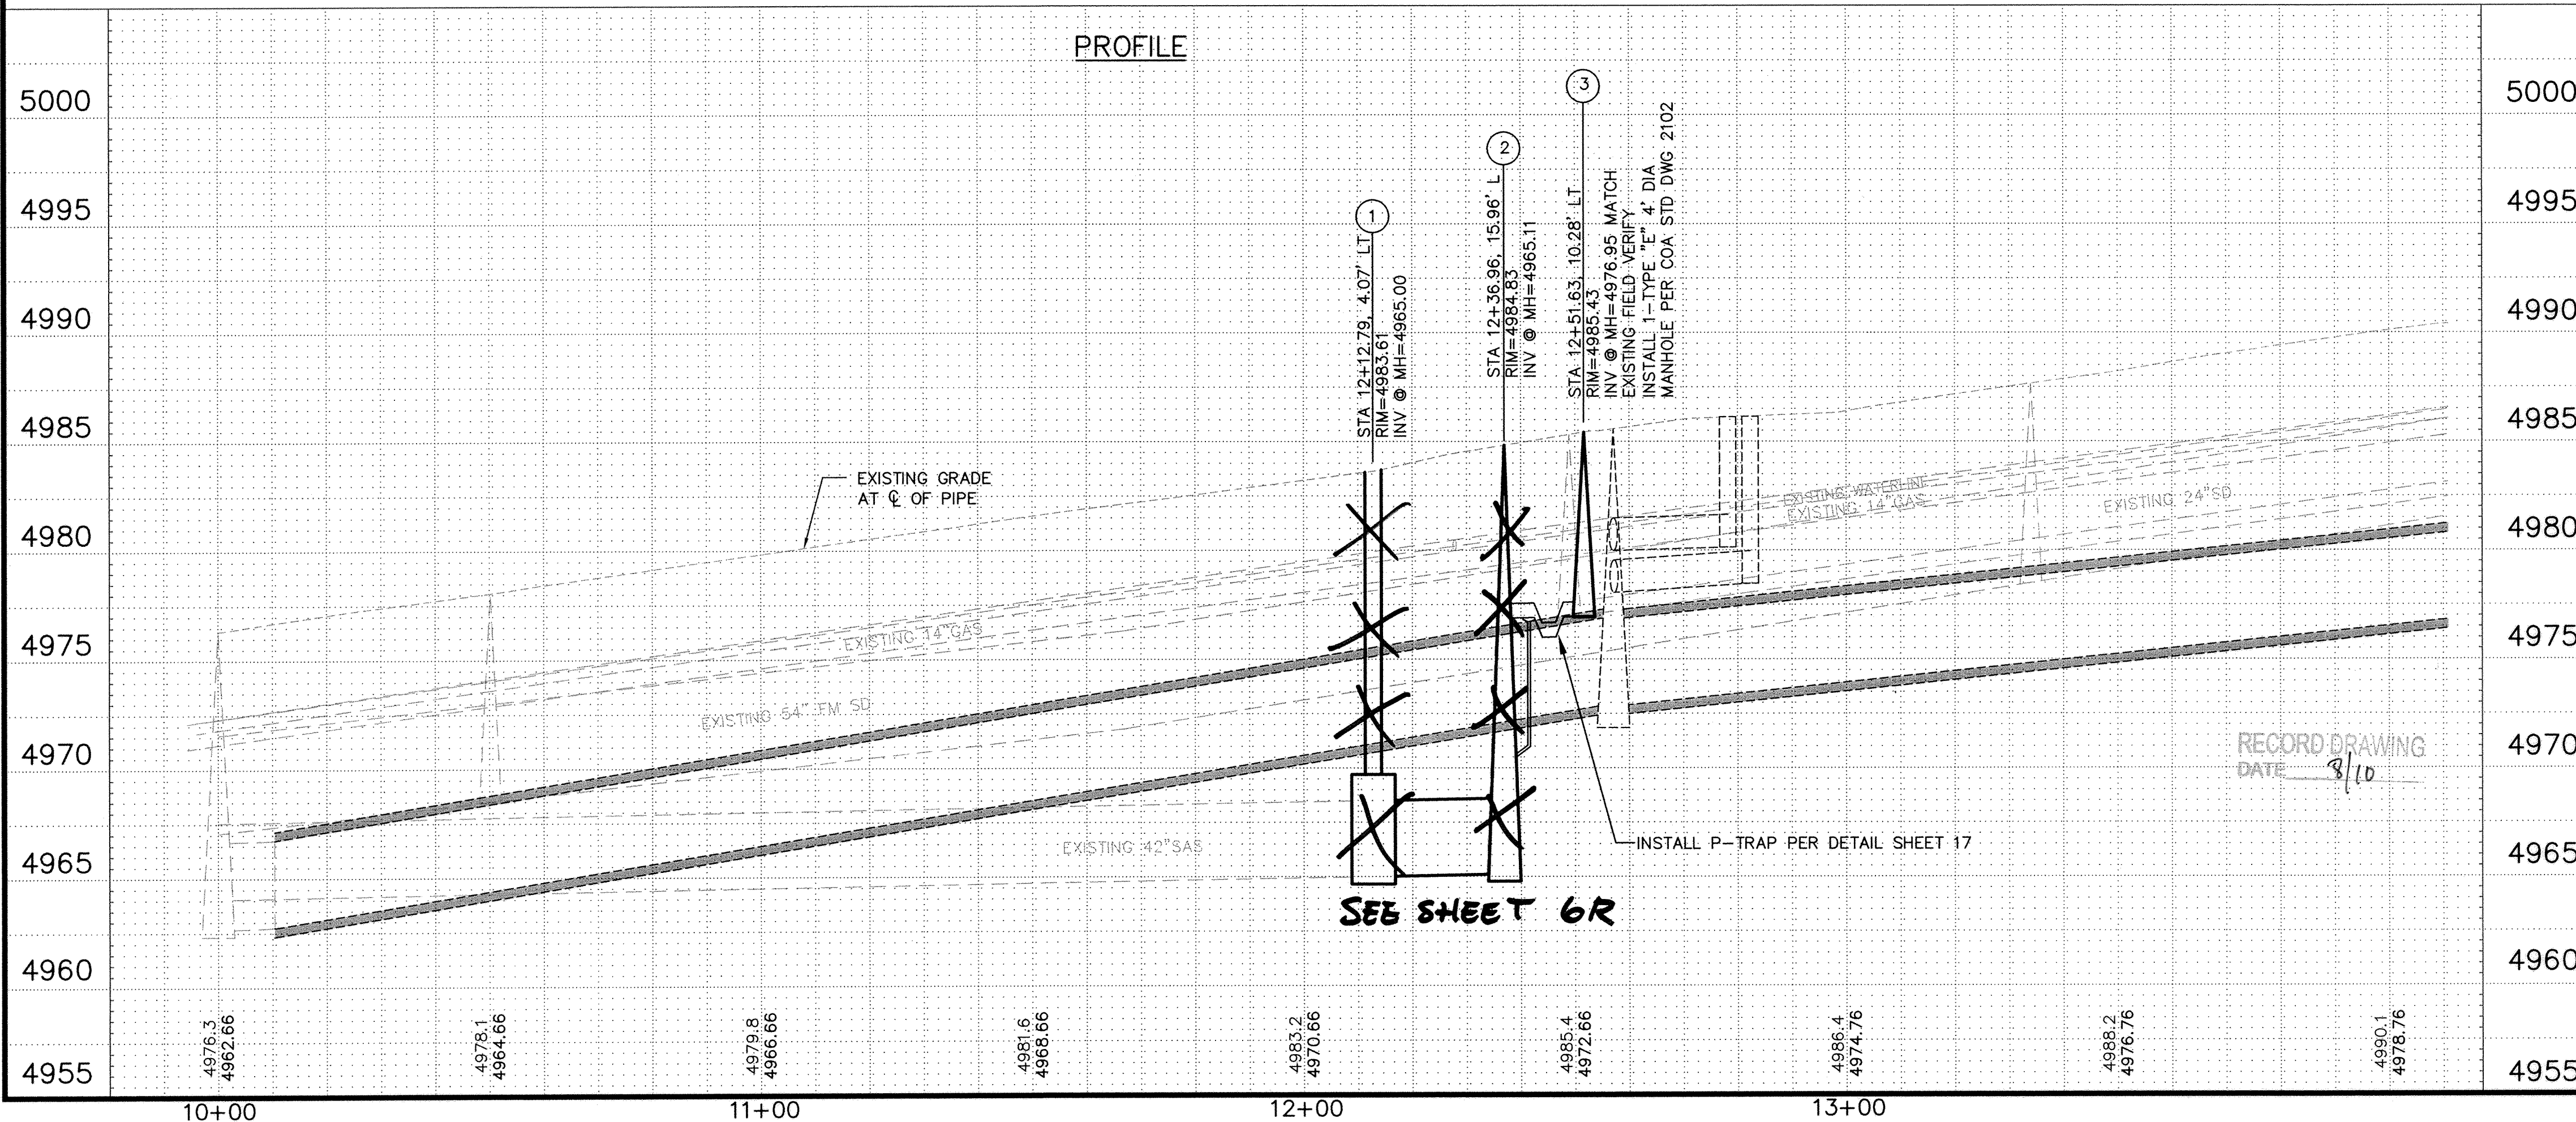

SEE SHEET 6R

RECORD DRAWING
DATE 8/10

LEGEND

○ SHEET KEY NOTES

1. INSTALL 1-8" DIA TYPE "E" SAS MH PER DETAIL SHEET 16
2. INSTALL 1-6" DIA TYPE "E" SAS MH PER COA STD DWG 2102
INSTALL VERTICAL DROP AT MH
PER COA STD DWG 2116
3. REMOVE AND REPLACE EXISTING SAS MH
"J15-507" INSTALL 1-TYPE E 4' MANHOLE
PER COA STD DWG 2102

LEGEND

- INDEX CONTOUR
- INTERMEDIATE CONTOUR
- ⊗ WATER VALVE
- ⊙ WATER METER
- TV UTILITY, TV PEDESTAL
- S UTILITY, SANITARY MANHOLE
- D UTILITY, STORM DRAINAGE MANHOLE
- W UTILITY, WATER VALVE VAULT
- PP POWER POLE
- ☀ LIGHT POLE
- TEL TELEPHONE PEDESTAL
- T ELECTRICAL, TRANSFORMER
- ⊙ UTILITY, TELEPHONE MANHOLE
- ⊙ UTILITY, TELEPHONE VAULT
- PROPOSED 48" SD
- PROPOSED MH


WILSON & COMPANY

4900 LANG AVENUE NE
ALBUQUERQUE, NEW MEXICO 87109
P (505) 348-4000
F (505) 348-4072



CITY OF ALBUQUERQUE
DEPARTMENT OF MUNICIPAL DEVELOPMENT
ENGINEERING DIVISION

TITLE: MOUNTAIN RD. STORM DRAIN IMPROVEMENTS
MOUNTAIN RD/WALTER ST SEWER RELOCATION PLAN & PROFILE
STA 10+00 TO STA 13+67.68

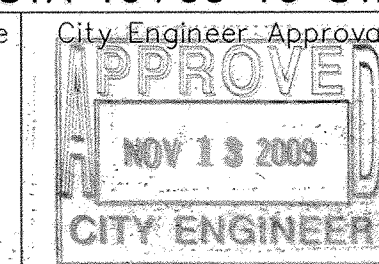


City Project No. 7963.93

Zone Map No. J-15

Sheet 15 of 18

AS BUILT INFORMATION				BENCH MARKS				SURVEY INFORMATION				ENGINEER'S SEAL			
CONTRACTOR	DATE	WORK	DATE	ACS 1 1/2" ALUMINUM DISK,	STAMPED "ACS BM, 11-J15"	DATE	NO.	BY	DATE	NO.	BY				
SHWLS BROS	8/10	STAKED BY	8/10	EPOXYED ON TOP OF THE	CONCRETE CURB RETURN, ESE	DATE									
INSPECTOR'S	DATE	FIELD	DATE	QUADRANT OF LOMAS BLVD AND	WOODWARD PL, NE	DATE						REVISIONS			
SHEV-TEK	8/10	VERIFICATION BY	8/10	ELEV=5021.86 (NGVD29)		DATE									
COA	8/10	CORRECTED BY	8/10			DESIGNED BY: TJA	DATE: JUN 2007					DESIGN			
COA	8/10	RECORDED BY	8/10			DRAWN BY: JIF	DATE: JUN 2007								
WCL	8/10					CHECKED BY: MJJ	DATE: JUN 2007								
MICRO-FILM INFORMATION															

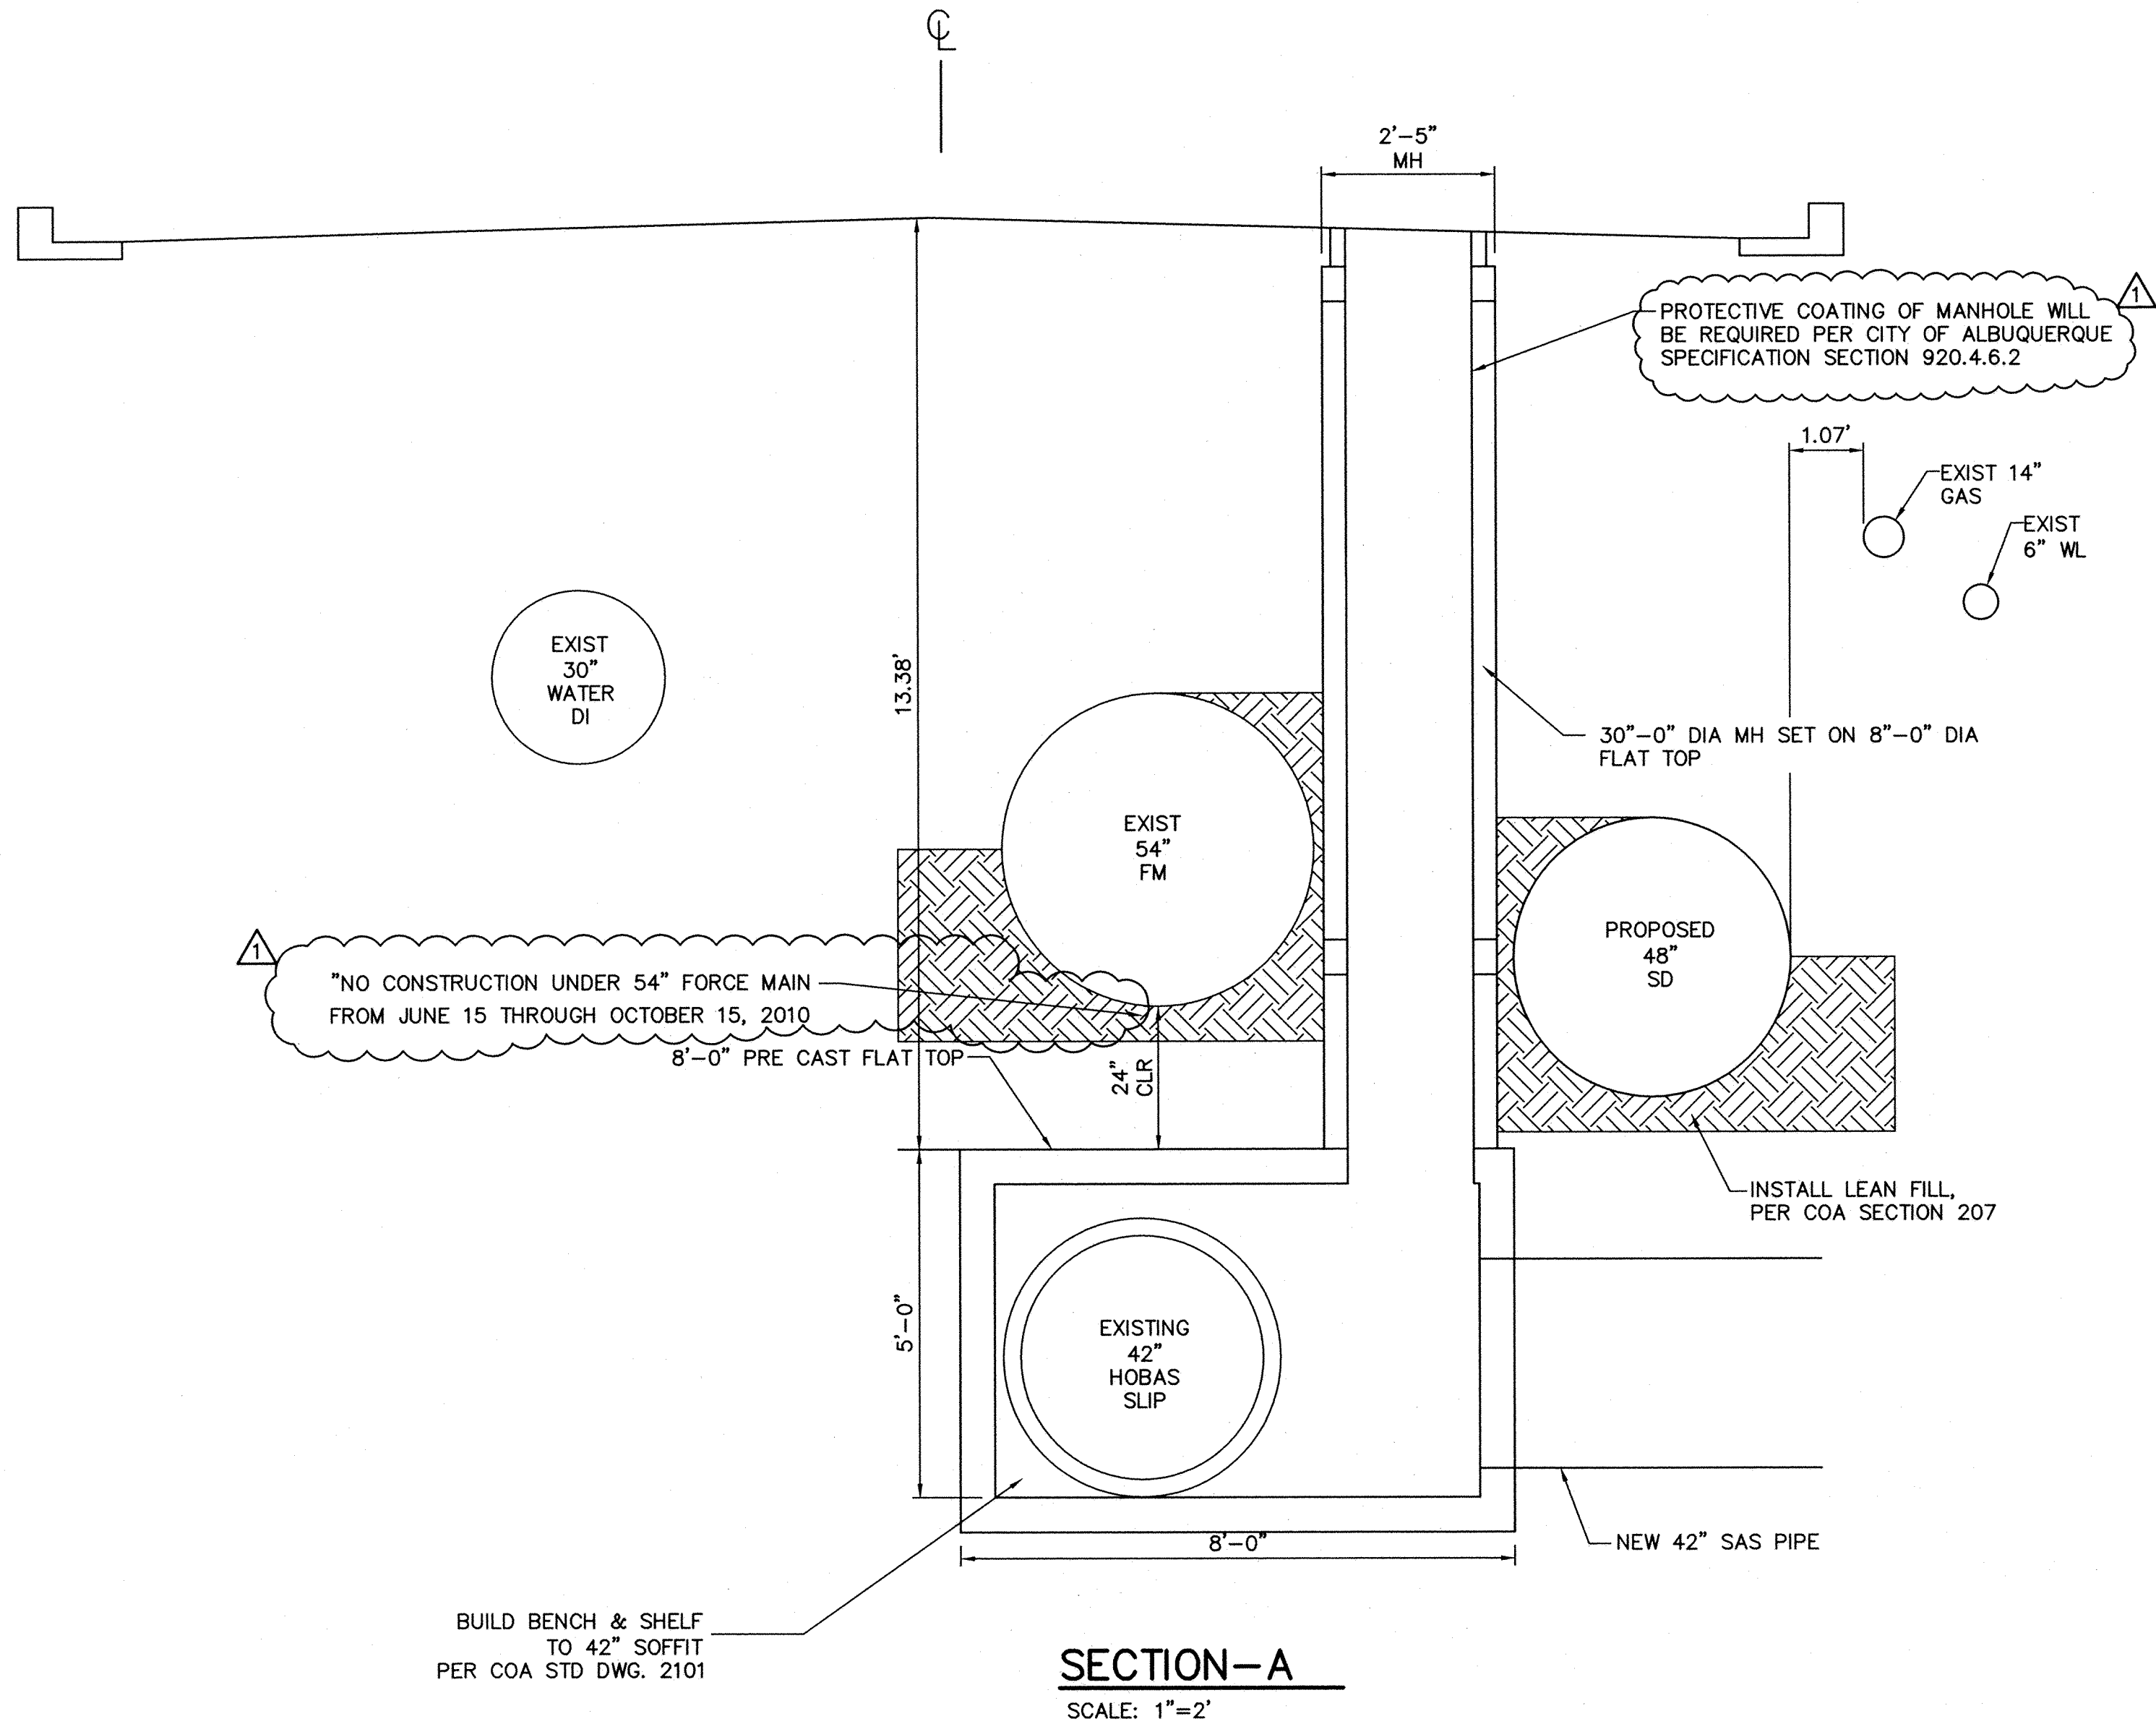


SECTION-A
SCALE: 1"=2'


RECORD DRAWING
DATE 8/10

WILSON & COMPANY 4900 LANG AVENUE NE ALBUQUERQUE, NEW MEXICO 87109 (505) 348-4000 FAX (505) 348-4072		CITY OF ALBUQUERQUE DEPARTMENT OF MUNICIPAL DEVELOPMENT ENGINEERING DIVISION TITLE: MOUNTAIN RD. STORM DRAIN IMPROVEMENTS SAS RELOCATION MANHOLE DETAILS	
Design Review Committee APPROVED DEC 04 2009 DESIGN REVIEW COMMITTEE	City Engineer Approval APPROVED DEC 04 2009 CITY ENGINEER	Last Design Update Mo./Day/Yr. _____ _____ _____	Mo./Day/Yr. _____ _____ _____
City Project No. 7963.93	Zone Map No. J-15	Sheet 16	Of 18

REVISIONS		ENGINEER'S SEAL		SURVEY INFORMATION		BENCH MARKS		AS BUILT INFORMATION	
NO.	DATE	DESIGNED BY	CHECKED BY	NO.	BY	NO.	DATE	CONTRACTOR	DATE
1	8/10	TJA	JIF	1	JIF	1	8/10	SHLS BROS.	8/10
2		JIF		2		2	8/10	WORK BY	8/10
3				3		3	8/10	INSPECTOR'S	8/10
4				4		4	8/10	ACCEPTANCE BY	8/10
5				5		5	8/10	CONCRETE CURB RETURN, ESE	8/10
6				6		6	8/10	VERIFICATION BY	8/10
7				7		7	8/10	QUADRANT OF LOMAS BLVD AND	8/10
8				8		8	8/10	WOODWARD PL, NE	8/10
9				9		9	8/10	ELEV=5021.86 (NGVD29)	8/10
10				10		10	8/10	MICRO-FILM INFORMATION	8/10
11				11		11	8/10	RECORDED BY	8/10
12				12		12	8/10	NO.	8/10

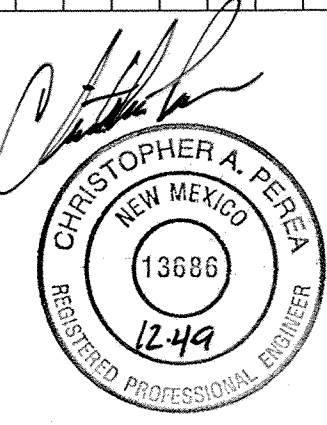

M:\DS\09-600-022-00\CADD\SHEETS\05_PNP\96022_stripping01.dwg 9/29/2009 2:47:46 PM MDT

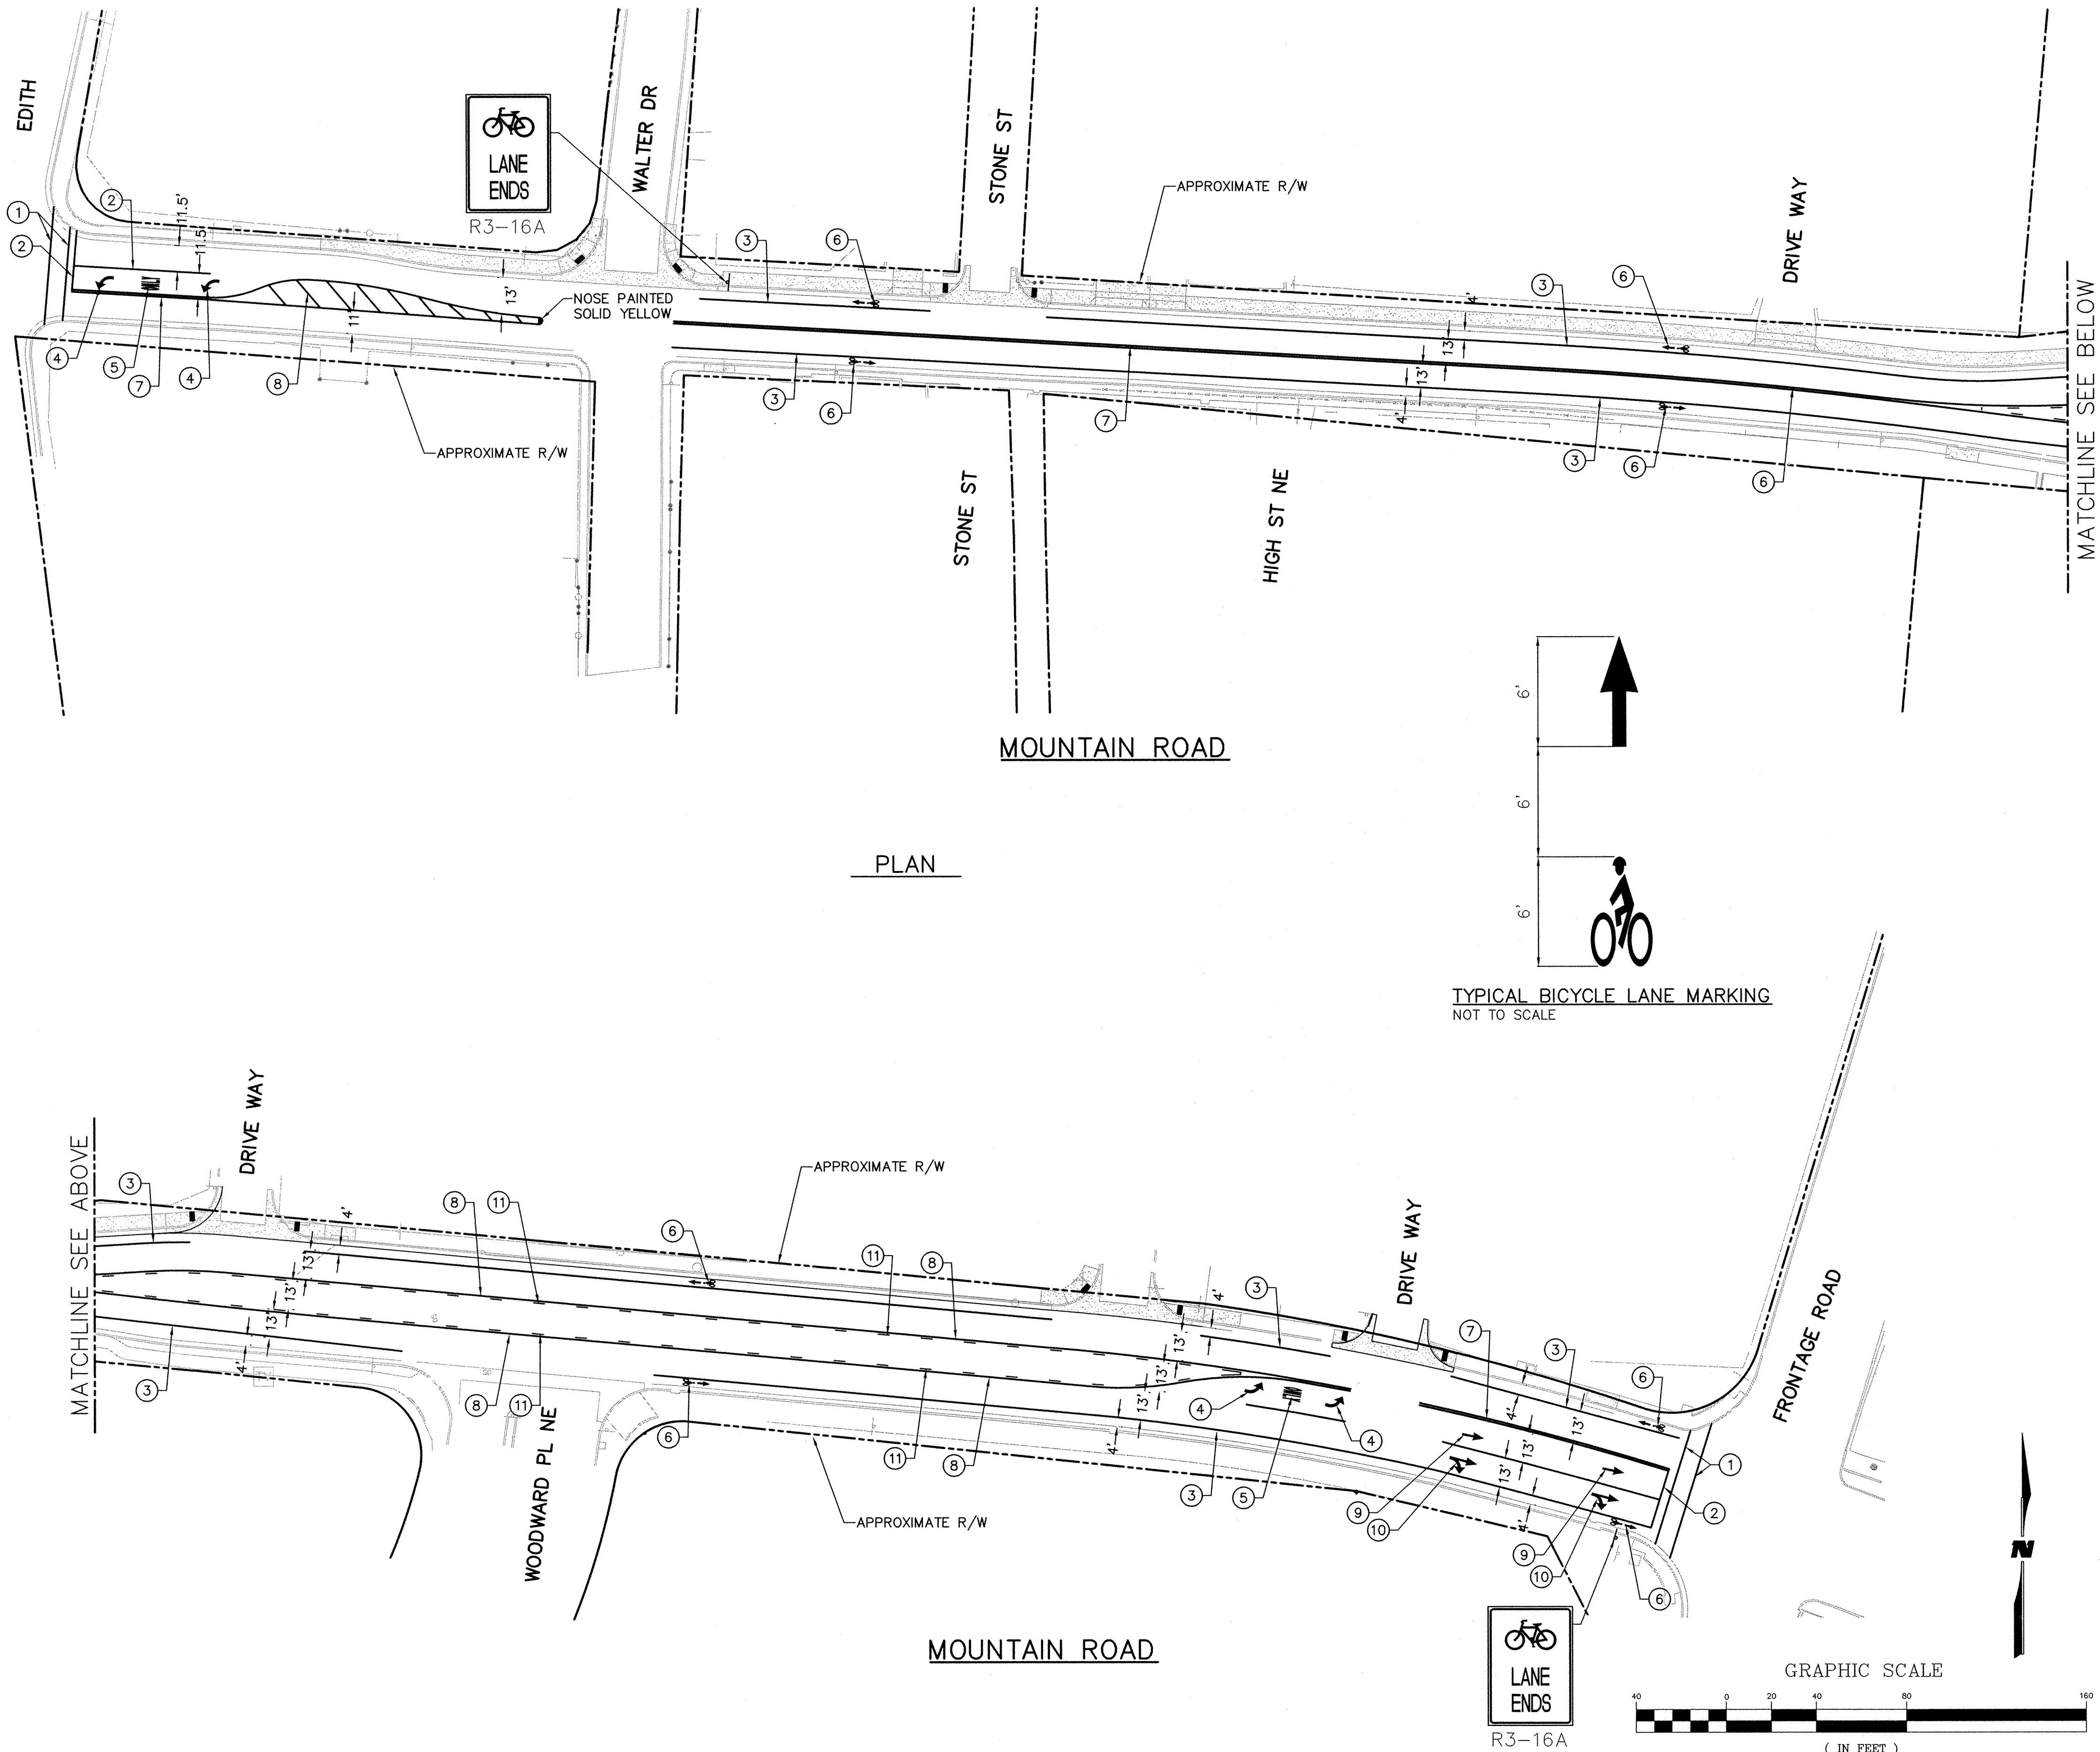

GENERAL NOTES

1

SHEET KEY NOTES

- 12" SOLID WHITE REFLECTORIZED CROSSWALK STRIPING
- 12" SOLID WHITE REFLECTORIZED STOP BAR MARKING
- 4" SOLID WHITE REFLECTORIZED STRIPING
- SOLID WHITE REFLECTORIZED LEFT ARROW MARKING
- SOLID WHITE REFLECTORIZED WORD 'ONLY' MARKING
- SOLID WHITE REFLECTORIZED BICYCLE MARKING SEE DETAIL THIS SHEET
- 4" SOLID DOUBLE YELLOW REFLECTORIZED STRIPING
- 4" SOLID YELLOW REFLECTORIZED STRIPING
- SOLID WHITE REFLECTORIZED THRU ARROW MARKING
- SOLID WHITE REFLECTORIZED THRU/RIGHT ARROW MARKING
- 4" DASHED YELLOW REFLECTORIZED STRIPING

CURVE TABLE		
CURVE	LENGTH	RADIUS
C1	22.83	50.00
C2	22.13	50.00
C3	52.58	236.50
C4	51.99	263.50
C5	4.61	1.47
C6	46.52	361.50
C7	34.49	250.50
C8	17.28	5.50
C9	17.28	5.50
C10	13.05	50.00
C11	36.72	150.00
C12	28.76	150.50
C13	10.85	50.00

WILSON & COMPANY

4900 LANG AVENUE NE
ALBUQUERQUE, NEW MEXICO
87109
P (505) 348-4000
F (505) 348-4072



CITY OF ALBUQUERQUE
DEPARTMENT OF MUNICIPAL DEVELOPMENT
ENGINEERING DIVISION

TITLE: MOUNTAIN RD. STORM DRAIN IMPROVEMENTS STRIPING PLAN

Design Review Committee
APPROVED
NOV 13 2009
DESIGN REVIEW COMMITTEE

City Engineer Approval
APPROVED
NOV 13 2009
CITY ENGINEER

Last Design Update

City Project No. 7963.93

Zone Map No. J-15

Sheet 17 Of 18

AS-BUILT INFORMATION		BENCH MARKS		SURVEY INFORMATION		ENGINEER'S SEAL	
CONTRACTOR	DATE	ACS 1 3/4" ALUMINUM DISK	DATE	FIELD NOTES	NO.		
WORK	DATE	STAMPED "ACS BM, 11-J15"	DATE	BY	DATE		
INSPECTED BY	DATE	EPOXIED ON TOP OF THE	DATE	NO.	DATE	REMARKS	BY
FIELD	DATE	CONCRETE CURB RETURN, ESE	DATE		DATE	DESIGN	
VERIFICATION BY	DATE	QUADRANT OF LOMAS BLVD AND	DATE		DATE	DESIGNED BY: TJA	DATE: JUN 2007
CORRECTED BY	DATE	WOODWARD PL, NE	DATE		DATE	DRAWN BY: JIF	DATE: JUN 2007
MICRO-FILM INFORMATION	DATE	ELEV=5021.86 (NGVD29)	DATE		DATE	CHECKED BY: MJJ	DATE: JUN 2007



SUBGRADE SOIL WITH $R < 50$ SHOULD BE REMOVED TO DEPTH OF 24" AND REPLACED WITH SOIL EXHIBITING $R \geq 50$.



SUBGRADE SOIL WITH $R < 50$ SHOULD BE REMOVED TO DEPTH OF 24" AND REPLACED WITH SOIL EXHIBITING $R \geq 50$.



BB - BASE TO BASE SPACING
0.65" MIN



DETECTABLE WARNING SURFACES SHALL EXTEND 24" MIN IN THE DIRECTION OF TRAVEL AND FULL WIDTH OF THE CURB RAMP, LANDING, OR TRANSITION. DOMES SHALL BE ALIGNED ON A SQUARE GRID IN THE PREDOMINANT DIRECTION OF THE CROSSWALK TO PERMIT WHEELS TO ROLL BETWEEN DOMES.



NOTES:

1. DOMES PER ADA GUIDE LINES.
2. PROVIDE/SUBMIT SPECS TO CONSTRUCTION ENGINEER FOR EVALUATION PRIOR TO CONSTRUCTION/INSTALLATION.

NT

RECORD DRAWING
DATE 8/10

ADDENDUM #1