LEGEND . **MATERIALS** CONCRETE LINES SUBDIVISION BOUNDARY PROPERTY LINE (PLAN) PROPERTY LINE (SECTION) CENTERLINE EASEMENT LINE MATCH LINE SECTION CUT LINE **EARTHWORK** CONTOUR LINE SPOT ELEVATION PROJECT / PHASE BOUNDARY FLOWLINE DIRECTION OF FLOW MISCELLANEOUS UTILITIES GAS LINE UNDERGROUND TELEPHONE UNDERGROUND ELECTRICAL STORM DRAIN MANHOLE STORM DRAIN INLET SANITARY SEWER SANITARY SEWER LINE SANITARY SEWER MANHOLE SAS SERVICE CONNECTIONS SAS CAP OR PLUG ENCASEMENT WATER WATER LINE WATER SERVICE CONNECTIONS GATE VALVE FIRE HYDRANT BUTTERFLY VALVE REDUCER DDDDDDDDD WATER PRESSURE ZONE BOUNDARY WATER FITTINGS CAPS AND PLUGS _______ **MISCELLANEOUS** CHAINLINK FENCE FIELD FENCE COMMON YARD WALL RETAINING WALL POWER OR TELEPHONE POLE ∇


CONSTRUCTION PLANS for

NATIONAL MUSEUM OF NUCLEAR SCIENCE AND HISTORY EUBANK BLVD SE PUBLIC WATER LINE EXTENSION

ALBUQUERQUE, NEW MEXICO AUGUST, 2007

DRAWINGS

SHEET DESCRIPTION COVER SHEET, VICINITY MAP, GENERAL NOTES, LEGEND AND INDEX OF DRAWINGS SITE PLAN, WATER VALVE SHUTOFF PLAN PUBLIC WATER LINE EXTENSION PLAN AND PROFILE

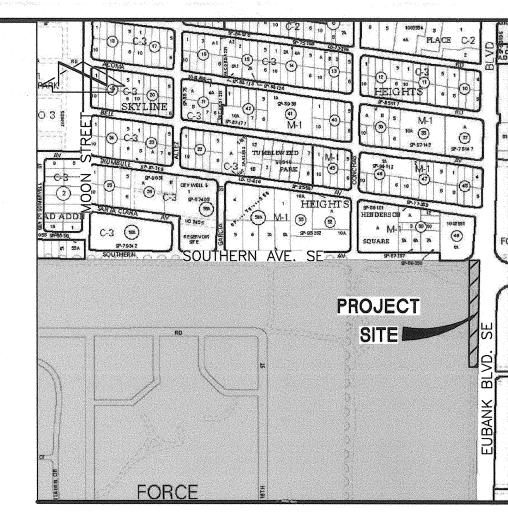

<u>L-20</u>

1. ALL WORK DETAILED ON THESE PLANS TO BE PERFORMED UNDER CONTRACT SHALL, EXCEPT AS OTHERWISE STATED OR PROVIDED FOR HEREON, BE CONSTRUCTED IN ACCORDANCE WITH THE CITY OF ALBUQUERQUE STANDARD SPECIFICATIONS-PUBLIC WORKS CONSTRUCTION-1986 - UPDATE NO. 7, INCLUDING AMENDMENT #1.

2. TWO (2) WORKING DAYS PRIOR TO ANY EXCAVATION, CONTRACTOR MUST CONTACT NEW MEXICO ONE CALL SYSTEM 260-1990, (ALBUQUERQUE AREA) 1-800-321-ALERT (2537) (STATEWIDE) FOR LOCATION OF EXISTING UTILITIES.

3. IF ANY UTILITY LINES, PIPELINES, OR UNDERGROUND UTILITY LINES ARE SHOWN ON THESE DRAWINGS, 1 SHOWN IN AN APPROXIMATE MANNER ONLY, AND SUCH LINES MAY EXIST WHERE NONE ARE SHOWN. EXISTING LINES ARE SHOWN, THE LOCATION IS BASED UPON INFORMATION PROVIDED BY THE OWNER OF SAID UNDERGROUND UTILITY LINES. IN PLANNING AND CONDUCTING EXCAVATION, THE CONTRACTOR SHALL COMPLY WITH STATE STATUTES, MUNICIPAL AND LOCAL ORDINANCES, RULES AND REGULATIONS, IF ANY, PERTAINING TO THE

4. SHOULD A CONFLICT EXIST BETWEEN THESE PLANS AND ACTUAL FIELD CONDITIONS, THE CONTRACTOR SHALL PROMPTLY

5. THE CONTRACTOR SHALL MAINTAIN ACCESS TO ADJACENT PROPERTIES DURING CONSTRUCTION.

7. ALL UTILITIES AND UTILITY SERVICE LINES SHALL BE INSTALLED PRIOR TO PAVING

8. BACKFILL COMPACTION SHALL BE ACCORDING TO SPECIFIED STREET USE.

9. TACK COAT REQUIREMENTS SHALL BE DETERMINED DURING CONSTRUCTION BY THE ENGINEER.

RETURN IS CONSTRUCTED. 11. IF CURB IS DEPRESSED FOR A DRIVEPAD OR A HANDICAP RAMP, THE DRIVEPAD OR RAMP SHALL BE CONSTRUCTED

PRIOR TO ACCEPTANCE OF THE CURB AND GUTTER.

12. ALL STORM DRAINAGE FACILITIES SHALL BE COMPLETED PRIOR TO FINAL ACCEPTANCE.

13. CONTRACTOR SHALL COORDINATE WITH THE ABCWUA WATER SYSTEM DIVISION FOR THE EXECUTION OF THE VALVE SHUT OFF PLAN, NOT LESS THAN SEVEN (7) WORKING DAYS IN ADVANCE OF ANY WORK THAT MAY AFFECT THE EXISTING PUBLIC WATER UTILITIES. ONLY ABCWUÀ WATER SYSTEM DIVISION PERSONNEL SHALL OPERATE EXISTING VALVES. REFER TO SECTION 18 OF THE SPECIFICATIONS. THE ABCWUA WATER SYSTEM DIVISION PHONE NUMBER IS 857-8200

14. CONTRACTOR SHALL NOTIFY THE CITY SURVEYOR NOT LESS THAN SEVEN (7) DAYS PRIOR TO STARTING WORK IN ORDER THAT THE CITY SURVEYOR MAY TAKE NECESSARY MEASURES TO INSURE THE PRESERVATION OF SURVEY MONUMENTS. CONTRACTOR SHALL NOT DISTURB PERMANENT SURVEY MONUMENTS WITHOUT THE CONSENT OF THE CITY SURVEYOR AND SHALL NOTIFY THE CITY SURVEYOR AND BEAR THE EXPENSE OF REPLACING ANY THAT MAY BE DISTURBED WITHOUT PERMISSION. REPLACEMENT SHALL BE DONE ONLY BY THE CITY SURVEYOR. WHEN A CHANGE IS MADE IN THE FINISHED ELEVATION OF THE PAVEMENT OF ANY ROADWAY IN WHICH A PERMANENT SURVEY MONUMENT IS LOCATED, CONTRACTOR SHALL, AT HIS OWN EXPENSE, ADJUST THE MONUMENT COVER TO THE NEW GRADE UNLESS OTHERWISE SPECIFIED. REFER TO SECTION 4.4 OF THE SPECIFICATIONS.

15. FIVE (5) WORKING DAYS PRIOR TO BEGINNING CONSTRUCTION THE CONTRACTOR SHALL SUBMIT TO THE CONSTRUCTION CO-ORDINATION DIVISION A DETAILED CONSTRUCTION SCHEDULE. TWO (2) WORKING DAYS PRIOR TO CONSTRUCTION THE CONTRACTOR SHALL OBTAIN A BARRICADING PERMIT FROM THE CONSTRUCTION CO-ORDINATION DIVISION. CONTRACTOR SHALL NOTIFY BARRICADE ENGINEER (924-3400) PRIOR TO OCCUPYING AN INTERSECTION. CONTRACTOR MUST REFER TO SECTION 19 OF THE STANDARD SPECIFICATION FOR TRAFFIC CONTROL.

16. PRIVATE STREETS REQUIRE STREET NAME SIGNS, STOP SIGNS, AND ANY NECESSARY STRIPING

(DEVELOPER'S RESPONSIBILITY).

17. PERMANENT PAVEMENT STRIPING WILL BE PLACED BY THE CONTRACTOR. THE ROAD SHALL NOT BE OPENED TO THE TRAFFIC UNTIL IT IS STRIPED. ALL STRIPING, PAVEMENT MARKINGS INCLUDING CROSSWALKS, ARROWS AND LINE MARKINGS ARE TO BE CONSTRUCTED OF HOT PLASTIC OR COLD PLASTIC IN ACCORDANCE WITH THE MANUAL OF UNIFORM TRAFFIC PROVED AS RECORD DIRECTION ESSONOMINATED AS RECORD DIRECTION ESSONOMINATED

18. CAUTION: THESE DRAWINGS DO NOT INCLUDE NECESSARY COMPONENTS FOR CONSTRUCTION SAFETY WHICH SHALL REMAIN THE RESPONSIBILITY OF THE CONTRACTOR. ALL EXCAVATION, TRENCHING AND SHORING ACTIVITIES MUST BE CARRIED-OUT IN ACCORDANCE WITH OSHA 29 CFR 1926, SUBPART P-EXCAVATIONS. 19. ANY WORK OCCURRING WITHIN AN ARTERIAL ROADWAY REQUIRES TWENTY-FOUR HOUR CONSTRUCTION.

20. CONTRACTOR WILL BE RESPONSIBLE FOR PROVIDING AND MAINTAINING ALL CONSTRUCTION SIGNING UNTIL PROJECT HAS BEEN ACCEPTED BY THE CITY. 21. CONTRACTOR SHALL MAINTAIN A GRAFFITI-FREE WORK SITE. CONTRACTOR SHALL PROMPTLY REMOVE ANY AND ALL

GRAFFITI FROM EQUIPMENT, WHETHER PERMANENT OR TEMPORARY

22. WHEN APPLICABLE, CONTRACTOR SHALL SECURE, ON BEHALF OF THE OWNER AND OPERATORS, "TOPSOIL DISTURBANCE PERMIT" FROM THE CITY AND/OR FILE A NOTICE OF INTENT (N.O.I.) WITH THE EPA PRIOR TO BEGINNING CONSTRUCTION.

MESA Consulting Group 2006.081.5 6010-B MIDWAY PARK BLVD. NE . ALBUQUERQUE, NEW MEXICO 87109 PHONE: 505.345.4250 • FAX: 505.345.4254 • www.highmesacg.com REV. SHEETS CITY ENGINEER USER DEPARTMENT DATE USER DEPARTMENT APPROVALS ENGINEER DATE | * * * * * * * * * * * * * * ENGINEERS STAMP & SIGNATURE DRC Chairman 10/9/07 APPROVED FOR CONSTRUCTION Transportation Water/Wastewater William J. March Hydrology

DMD 2007-1 ON CALL

Const. Mngmt. Const. Coord.

City Engineer

APPROVED AS RECORD DRAWINGS

CITY CONSTRUCTION ENGINEER

606182

City Project No.

