

CITY OF ALBUQUERQUE
NEW MEXICO



CONSTRUCTION PLANS
FOR
BICYCLE BOULEVARD
COA PROJECT NO. 7986.91

PHASE I: Silver Ave from San Mateo to Cedar Street
PHASE II: Silver Ave from 14th St to Second St
PHASE III: Silver Ave from Cedar Street to Second Street


RECORD DRAWINGS

INDEX OF SHEETS


1	COVER SHEET
2	GENERAL NOTES
3	SUMMARY OF QUANTITIES
4-11	SIGNING AND STRIPING PLANS
2 11a, 11b	COAL AVE STRIPING PLANS
12-18	SIGNING AND STRIPING PLANS
19-20	SIGN FACE DETAILS
2 21	PAVEMENT MARKING DETAILS, PAVEMENT MARKING AND PERMANENT SIGNING NOTES
22	SILVER-GIRARD INTERSECTION IMPROVEMENT PLAN
22a	AS CONSTRUCTED WAYFINDING SIGNS (1 OF 2)
22b	AS CONSTRUCTED WAYFINDING SIGNS (2 OF 2)

RECORD DRAWING
Drawing revised to reflect the
best information available. Do
not use without field verification.

2	SHEETS ADDED TO REFLECT AS-BUILT CONDITIONS	3-10	BRS
1	SHEETS REVISED TO REFLECT AS-BUILT CONDITIONS	3-10	BRS
NO.	DESCRIPTION	DATE	BY
REVISIONS (OR CHANGE NOTICES)			

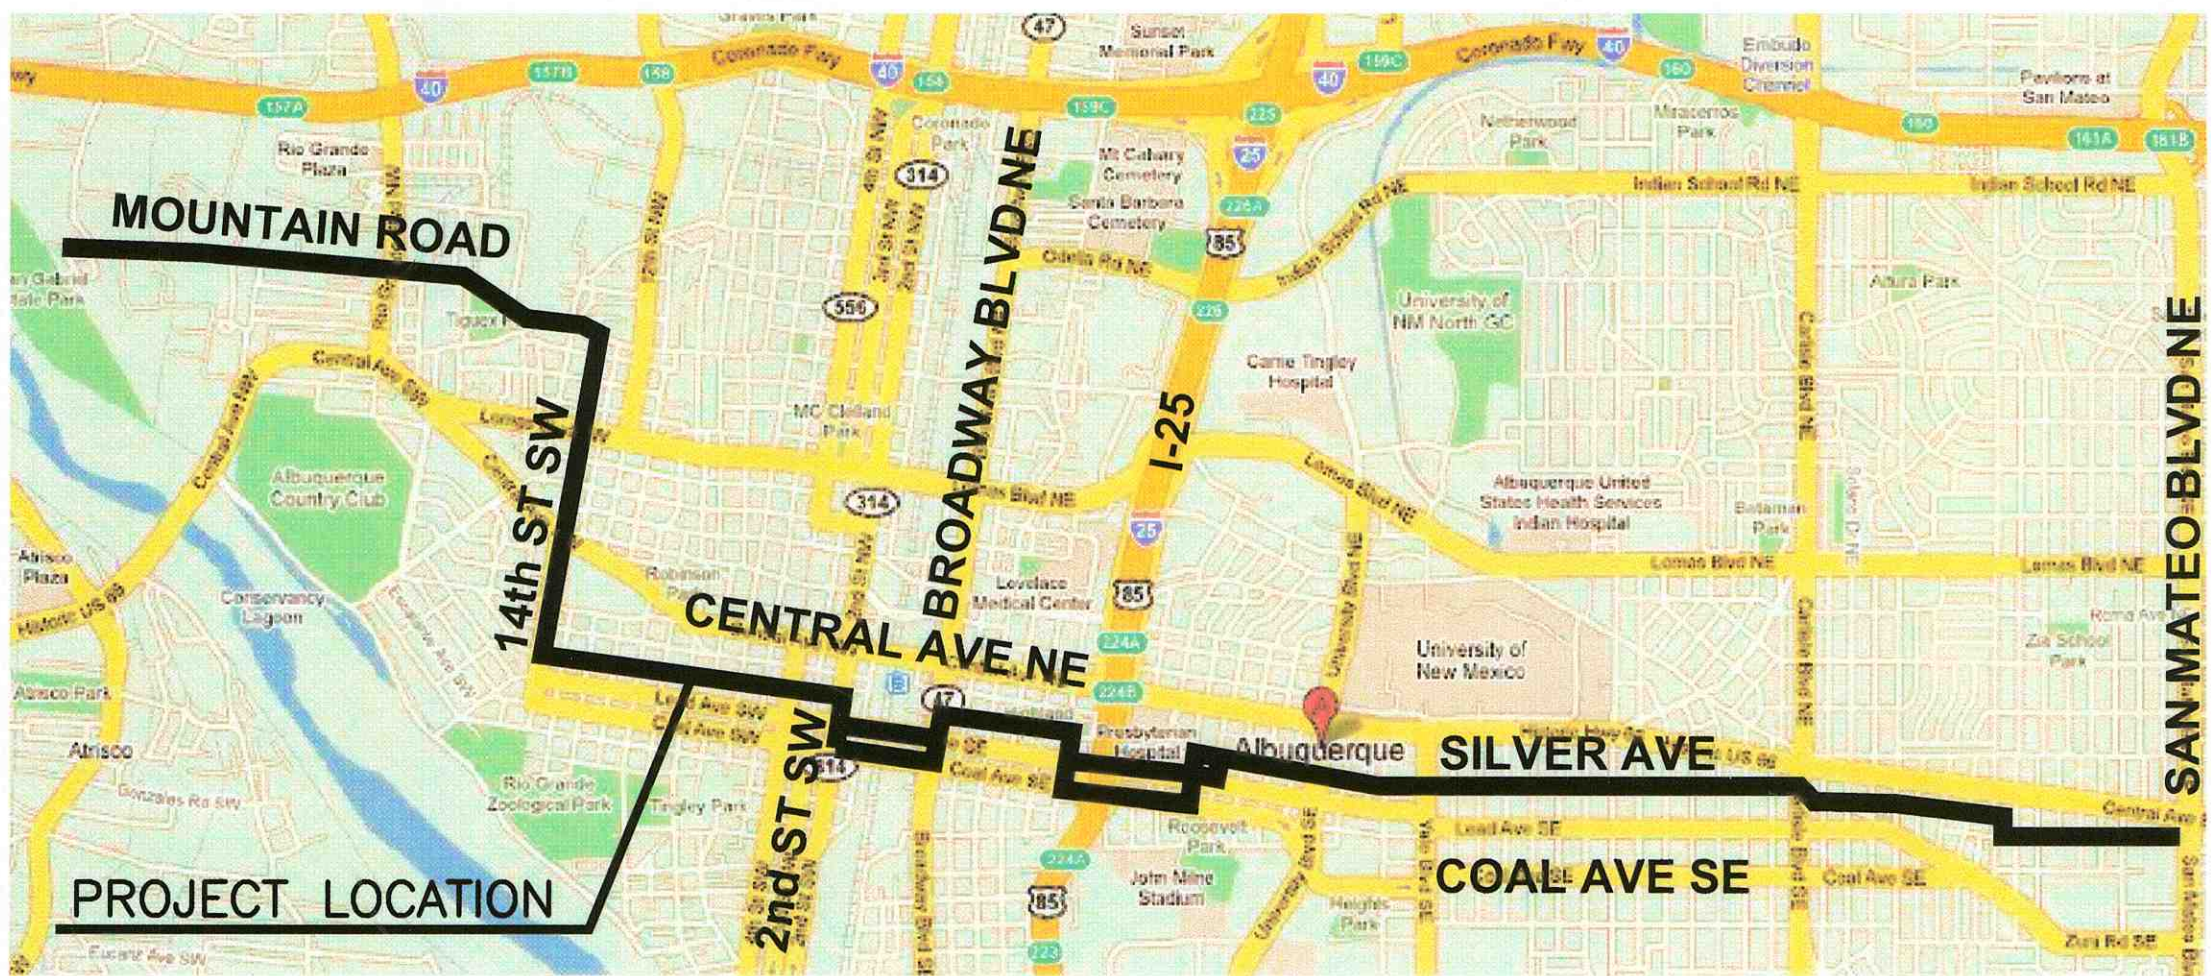

VICINITY MAP
NTS
ZONE ATLAS MAPS
J-12 TO J-14

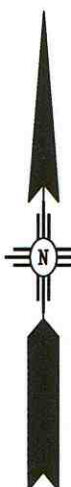

Gannett Fleming West, Inc.
2155 Louisiana NE, Suite 7000 Albuquerque, New Mexico 87110
Office: (505) 265-8468 Facsimile: (505) 881-2513

REV.	SHEETS	CITY ENGINEER	DATE	USER DEPARTMENT	DATE	USER DEPARTMENT	DATE
ENGINEERS STAMP & SIGNATURE	APPROVALS	ENGINEER	DATE	*****			
	DRC Chairman			APPROVED FOR CONSTRUCTION			
	Transportation						
	Water/Wastewater						
	Hydrology						
	Parks						
Constr. Mngmt.				City Engineer		Date	
Constr. Coord.							
City Project No.				Sheet 1 Of 22			
7986.91							

SUMMARY OF QUANTITIES
Last Saved: 04/15/2010 11:38 AM - Status: Printed Date: 04/15/2010 - Sheets: 0001 of 01
Bicycle Blvd Construction - 04-15-2010 11:38 AM - Status: Printed Date: 04/15/2010 - Sheets: 0001 of 01

SUMMARY OF QUANTITIES

COA ITEM NO.	DESCRIPTION	UNIT	ESTIMATE QUANTITY	FINAL QUANTITY
Roadway				
6.010	Construction Project Sign, per Contract Special Provisions, cip	EA	2	0
19.010	Construction Traffic Control & Barricading, compl.	LS	LS	LS
621.001	Mobilization (5% Maximum of Base Bid)	LS	LS	LS
621.002	Demobilization (2% Maximum of Base Bid)	LS	LS	LS
343.999	Temporary Curb Extension, Complete	EA	4	4
441.005	Reflectorized Plastic Pavement Word, Ahead, cip.	LF	30	20
441.021	Reflectorized Plastic Pavement Word, Stop, cip.	EA	30	20
441.998	Bicycle Boulevard Reflectorized Preformed Plastic Pavement Markings, cip.	EA	71	82
450.001	Aluminum Panel Sign, cip	SF	1620	1354
450.010	Square Tube Steel Post and Base Posts for Aluminum Pannel Sign, cip.	EA	137	3298 (LF)
450.101	Sign, Post, & Base Post, remove and Slavage. Compl.	EA	37	125
450.998	Stop Sign Remove and Salvage, sign only	EA	40	0
450.999	Street Name Sign Remove and Salvage, sign only	EA	174	174

RECORD DRAWING
Drawing revised to reflect the best information available. Do not use without field verification.



2155 Louisiana NE, Suite 7000 Albuquerque, New Mexico 87110
Office: (505) 265-8468 Facsimiles: (505) 881-2513



CITY OF ALBUQUERQUE
DEPARTMENT OF MUNICIPAL DEVELOPMENT

TITLE: BICYCLE BOULEVARD - MOUNTAIN ROAD, 14TH STREET, SILVER BLVD
SUMMARY OF QUANTITIES

Design Review Committee

City Engineer Approval

Least Design Update

City Project No.
7986-91

Zone Map No.
K-15 TO 17

Sheet
3 OF 22

Mo./Day/Yr.

Mo./Day/Yr.

DESIGNED BY: MPG

DRAWN BY: BRS

CHECKED BY: CG

DATE: MAY 2008

DATE: MAY 2008

DATE: MAY 2008

ENGINEER'S SEAL
11-7-2008
MATTHEW P. GOSLISH
16906
LICENSED PROFESSIONAL ENGINEER
NEW MEXICO

NO. DATE
REVISIONS
DESIGN

REMARKS
BY


SURVEY INFORMATION
FIELD NOTES
NO. BY DATE

AS BUILT INFORMATION
CONTRACTOR TLL DATE 6-09
WORK BY N/A DATE 6-09
INSPECTOR'S ACCEPTANCE BY COA DATE 8-09
DRAWINGS VERIFICATION BY COA DATE 8-09
CHECKED BY GFW DATE 3-10
MICRO-FILM INFORMATION
RECORDED BY DATE
NO.

Mountain Rd - BOP to Lulac Ave
Last Speed Limit Sign Removed Date: 11-25-08
Last Speed Limit Sign Removed Date: 11-25-08
Last Speed Limit Sign Removed Date: 11-25-08


KEYED NOTES:

- (A) BICYCLE BOULEVARD PAVEMENT MARKING
- (B) BICYCLE BOULEVARD SIGN (SP-3)
- (C) BICYCLE BOULEVARD STREET NAME SIGN
- (D) SPEED LIMIT SIGN
- (E) BICYCLE BOULEVARD PLAQUE (SP-4)
- (F) WAYFINDING SIGN
- (G) REMOVE CONFLICTING SIGN

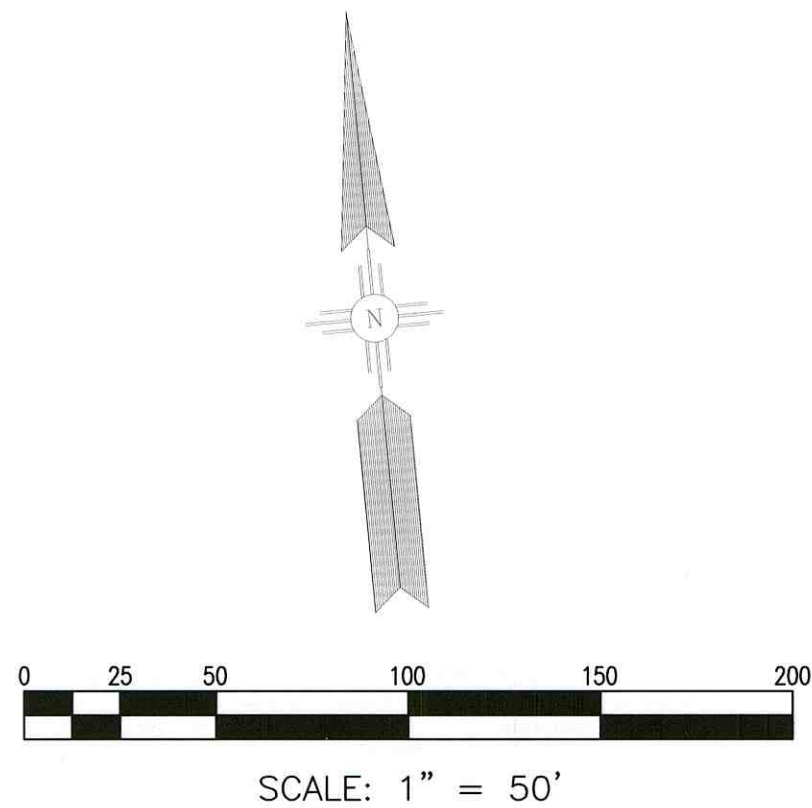

MATCH LINE
SEE ABOVE

MATCH LINE
SEE SHEET 5

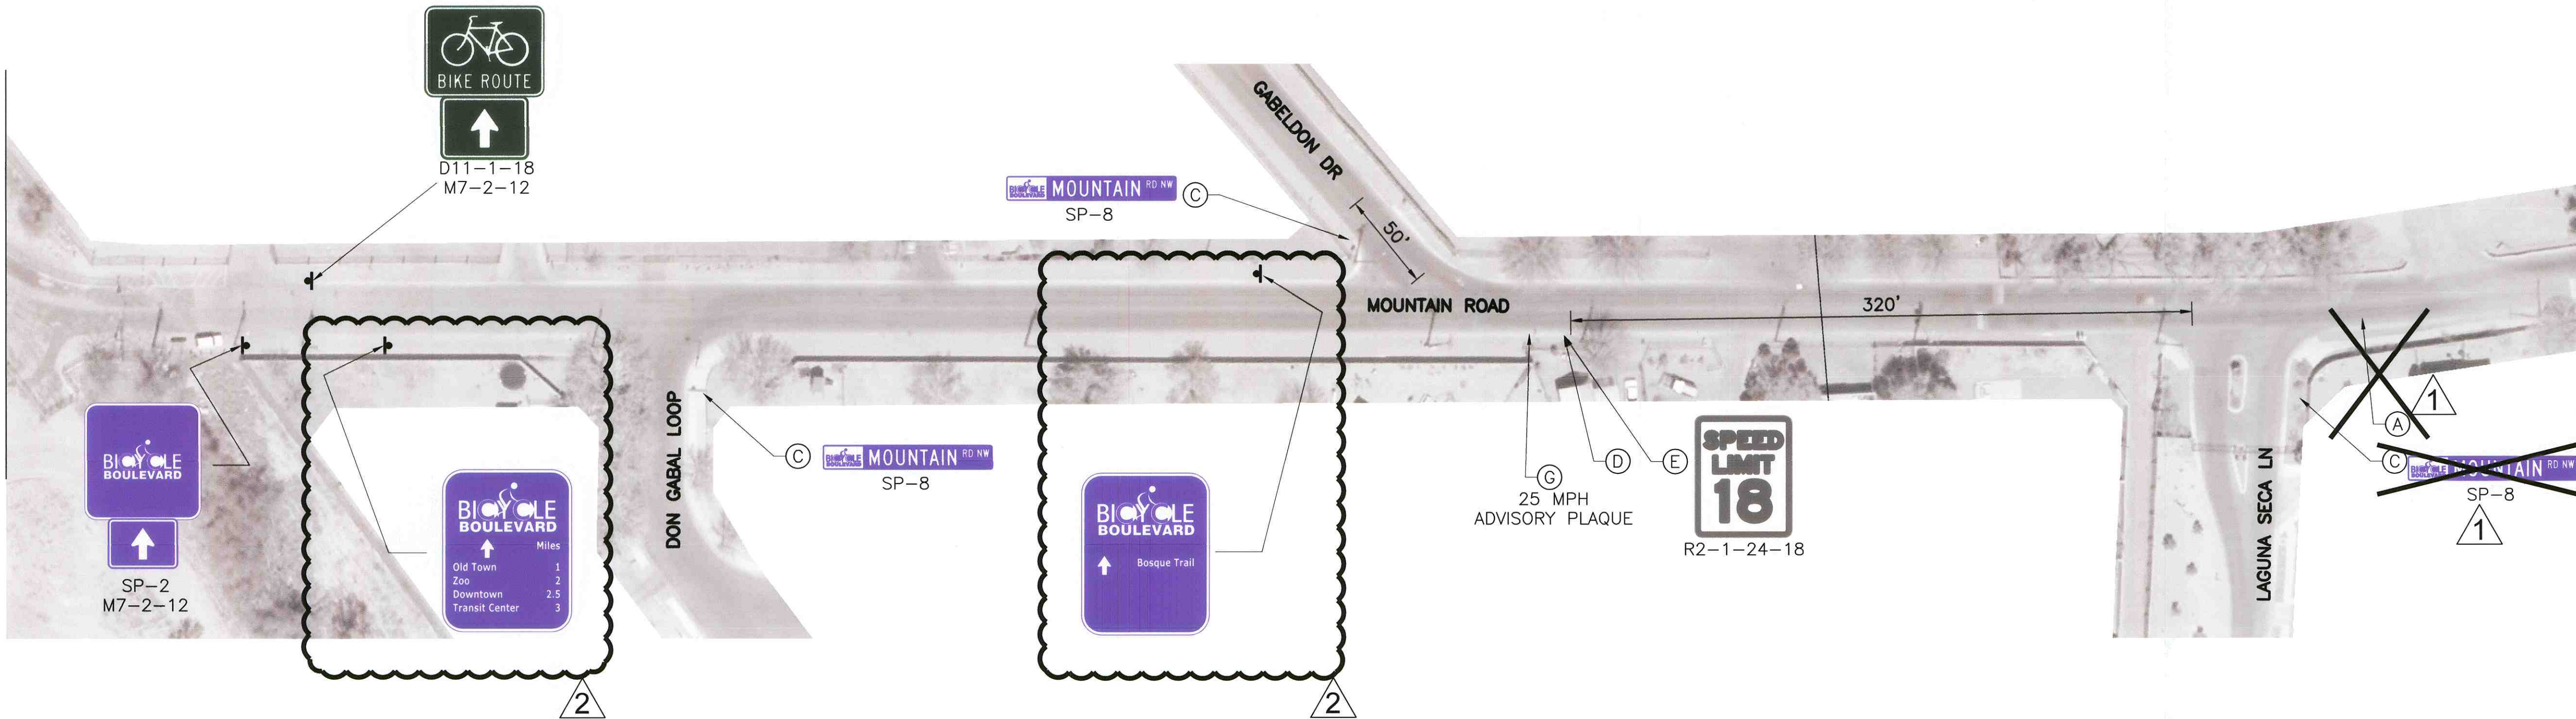

MATCH LINE
SEE BELOW

Gannett Fleming West, Inc.
2155 Louisiana NE, Suite 7000 Albuquerque, New Mexico 87110
Office: (505) 265-8468 Facsimile: (505) 881-2513



CITY OF ALBUQUERQUE
DEPARTMENT OF MUNICIPAL DEVELOPMENT

TITLE: BICYCLE BOULEVARD - MOUNTAIN ROAD, 14TH STREET, SILVER BLVD
BICYCLE BOULEVARD - SIGNING AND STRIPING PLANS

Design Review Committee	City Engineer Approval	Last Design Update	Mo./Day/Yr.	Mo./Day/Yr.

City Project No. 7986-91 Zone Map No. J-12,13,14 K-13,14,15 Sheet 4 OF 22

RECORD DRAWING
Drawing revised to reflect the best information available. Do not use without field verification.

SURVEY INFORMATION		BENCH MARKS		AS BUILT INFORMATION	
NO.	BY	DATE	NO.	CONTRACTOR	DATE
				WORK	DATE
				INSPECTED BY	DATE
				ACCEPTANCE BY	DATE
				REVISION BY	DATE
				DRAWINGS	DATE
				CORRECTED BY	DATE
				RECORDED BY	DATE
				NO.	

MATCH LINE
SEE SHEET 10

LEAD AVE

2ND ST

1ST ST

COAL AVE

BIKE ROUTE
D11-1-24
M7-1-12

1

BIKE ROUTE
D11-1-24
M7-1-12



R3-17-30

(A) BICYCLE BOULEVARD PAVEMENT MARKING

(B) BICYCLE BOULEVARD SIGN (SP-3)


(C) BICYCLE BOULEVARD STREET NAME SIGN

(D) SPEED LIMIT SIGN

(E) BICYCLE BOULEVARD PLAQUE (SP-4)

(F) WAYFINDING SIGN

(G) REMOVE CONFLICTING SIGN

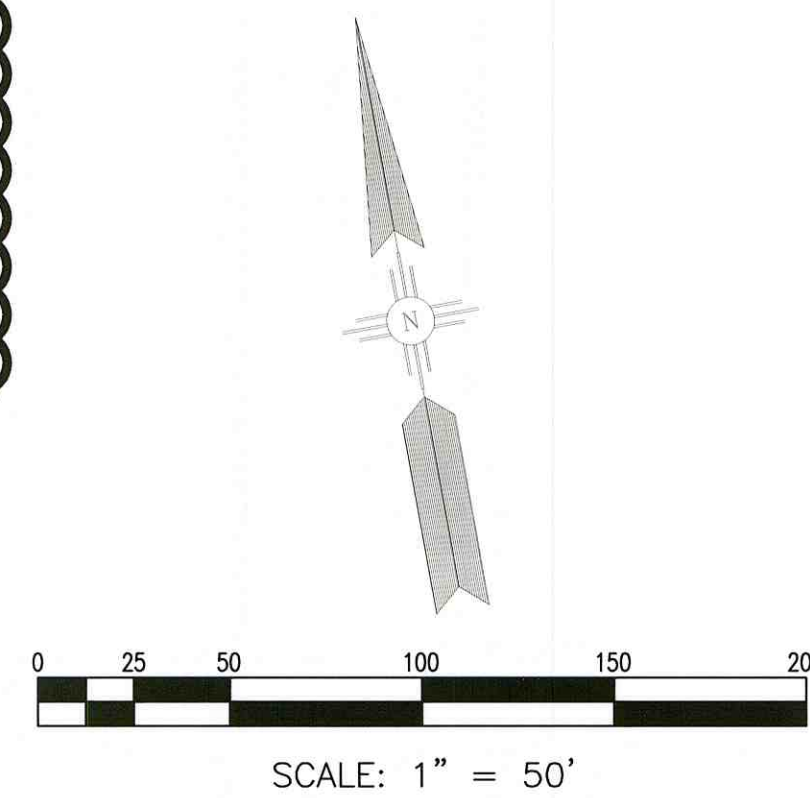

 Gannett Fleming West, Inc.
2155 Louisiana NE, Suite 7000 Albuquerque, New Mexico 87110
Office: (505) 265-8468 Facsimile: (505) 881-2513

CITY OF ALBUQUERQUE
DEPARTMENT OF MUNICIPAL DEVELOPMENT

10	Design Review Committee	City Engineer Approval	Last Design Update	Mo./Day/Yr.	Mo./Day/Yr.

City Project No.	Zone Map No. J-12,13,14 K-13,14,15	Sheet 11 OF 22
------------------	--	-------------------


RECORD DRAWING
Drawing revised to reflect the
best information available. Do
not use without field verification.

[illegible]



NOTE:
REMOVAL OF PAVEMENT MARKINGS SHALL BE BY WATER BLASTING METHODS, ONLY.

- ① REMOVE EXISTING PAVEMENT MARKING
- ② REFLECTORIZED PLASTIC MARKING 4" SOLID WHITE STRIPE
- ③ REFLECTORIZED PLASTIC MARKING 4" DASHED WHITE LANE STRIPE, 10' LONG WITH 30' SKIP
- ④ REFLECTORIZED PLASTIC MARKING 6" SOLID WHITE STRIPE
- ⑤ REFLECTORIZED PLASTIC MARKING 4" SOLID YELLOW STRIPE
- ⑥ REFLECTORIZED PLASTIC MARKING LEFT TURN AND THRU ARROW
- ⑦ REFLECTORIZED PLASTIC MARKING THRU ARROW
- ⑧ REFLECTORIZED PLASTIC MARKING RIGHT TURN ARROW
- ⑨ REFLECTORIZED PLASTIC MARKING WORD "ONLY"
- ⑩ REFLECTORIZED PLASTIC MARKING BIKE SYMBOL AND ARROW (BIKEWAY)
- ⑪ REFLECTORIZED PLASTIC MARKING 6" SHORT DASHED WHITE STRIPE, 2' LONG WITH 6' SKIP
- ⑫ REFLECTORIZED PLASTIC MARKINGS 12" SOLID WHITE CROSSWALK STRIPE
- ⑬ REFLECTORIZED PLASTIC MARKING 24" SOLID WHITE STRIPE

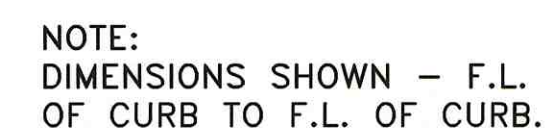

	Gannett Fleming West, Inc.				
	2155 Louisiana NE, Suite 7000 Office: (505) 265-8468	Albuquerque, New Mexico 87110 Facsimile: (505) 881-2513			
			1	3-	
				NO. DA.	
				DESIGNED BY:	CHECKED BY:
				DRAWN BY:	

CITY OF ALBUQUERQUE

DEPARTMENT OF MUNICIPAL DEVELOPMENT

TITLE: BICYCLE BOULEVARD - MOUNTAIN ROAD, 14TH STREET, SILVER BLVD


COAL AVE. STRIPING MODIFICATION PLAN

Design Review Committee	City Engineer Approval	Last Design Update	Mo./Day/Yr.	Mo./Day/Yr.

City Project No.
7986-91
Zone Map No.
J-12,13,14
K-13,14,15
Sheet
11a OF **22**

Coal Ave. Striping Modification Plan Sheet 11b
K:\PROJECTS\44860\Bike Boulevard\2000 CONSTRUCTION\As-Built\Sheet 11a - Coal Striping 2nd To Broadway.dwg
User: jmc
Date: 5/17/2018 9:55:40 AM
Printed Date: 5/17/2018 9:55:40 AM


MATCH LINE
SEE SHEET 11a

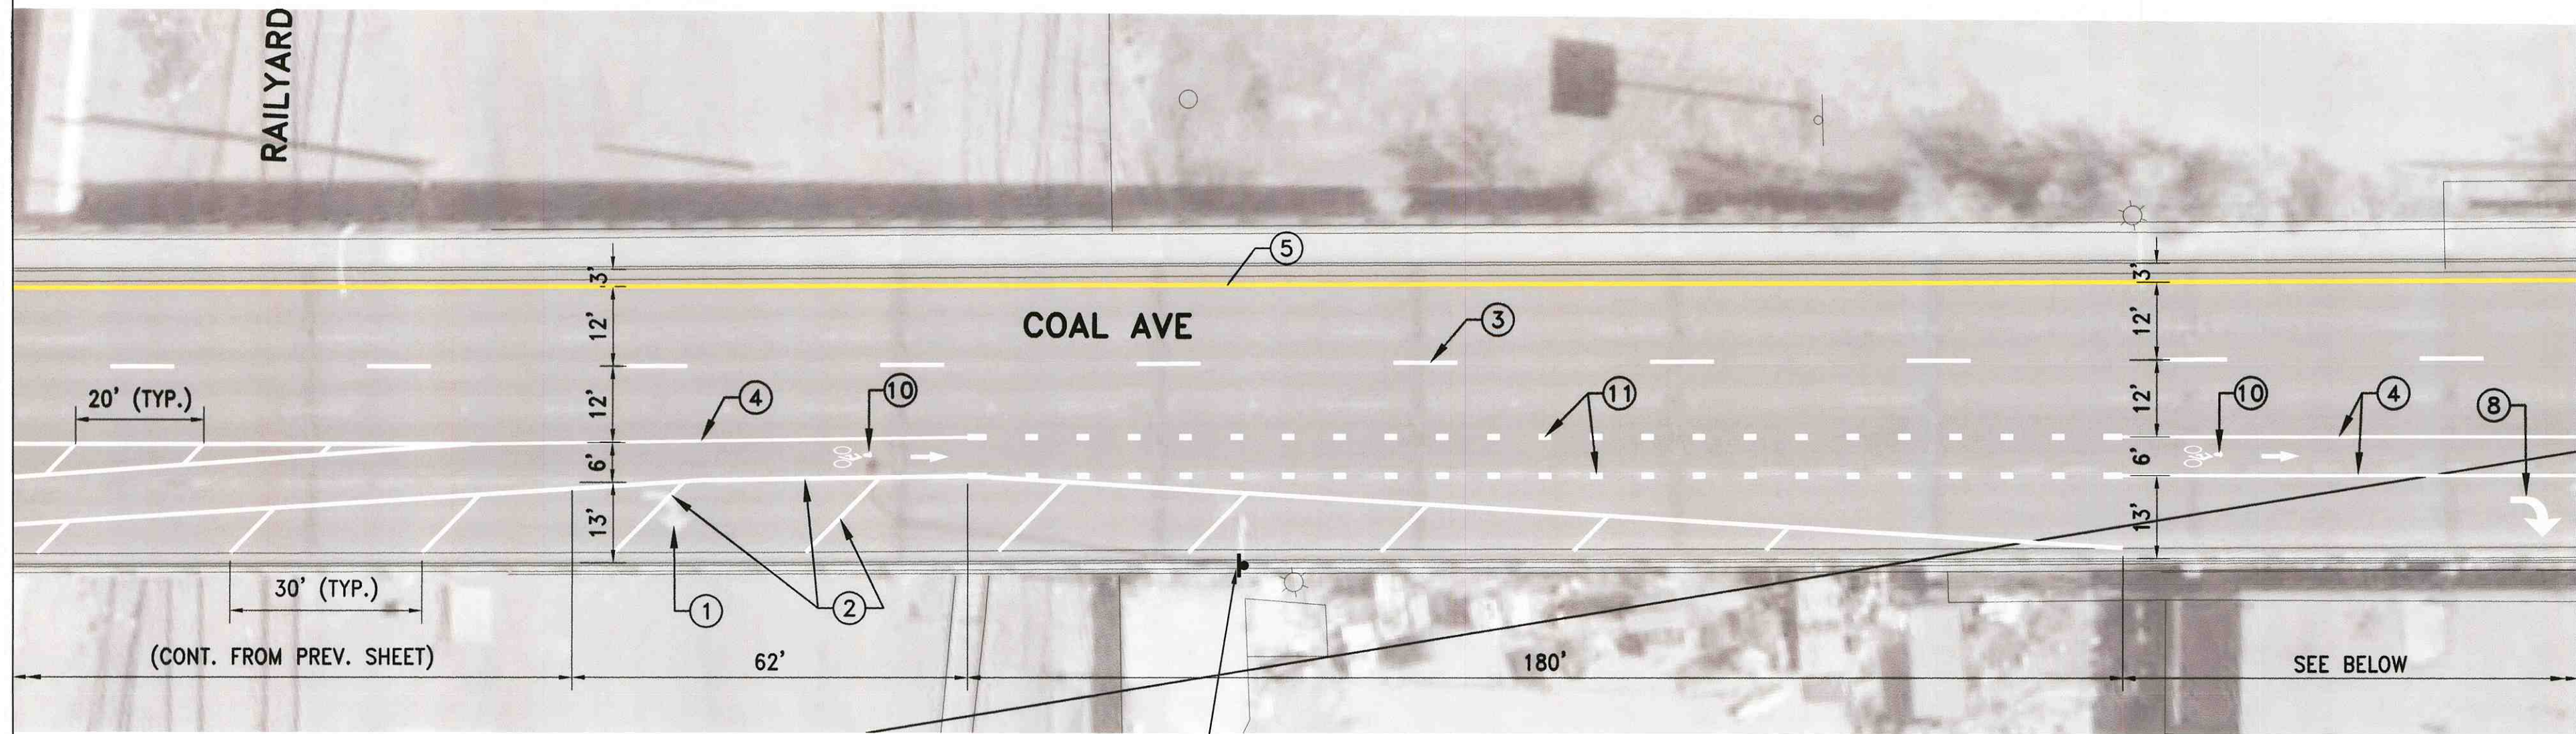

BEGIN
RIGHT TURN LANE
YIELD TO BIKES

R4-4-36
B/W


MATCH LINE
SEE ABOVE

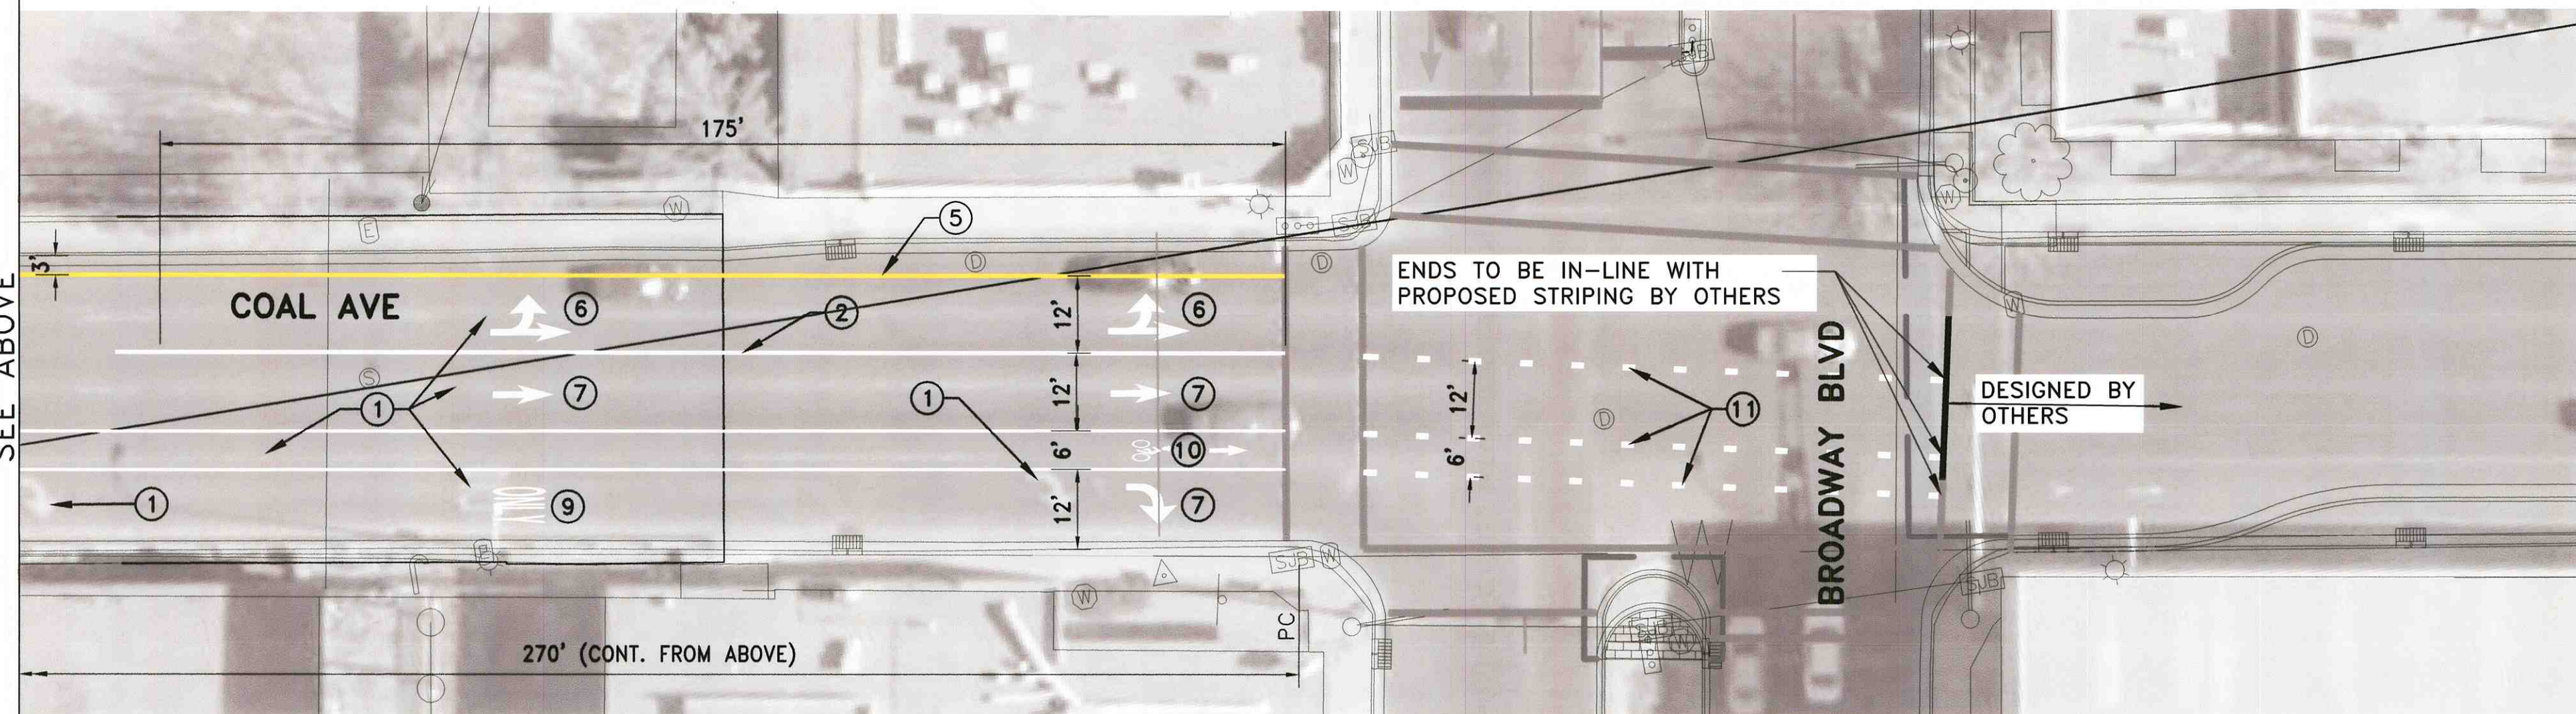

STRIPING LEGEND


- ① REMOVE EXISTING PAVEMENT MARKING
- ② REFLECTORIZED PLASTIC MARKING 4" SOLID WHITE STRIPE
- ③ REFLECTORIZED PLASTIC MARKING 4" DASHED WHITE LANE STRIPE, 10' LONG WITH 30' SKIP
- ④ REFLECTORIZED PLASTIC MARKING 6" SOLID WHITE STRIPE
- ⑤ REFLECTORIZED PLASTIC MARKING 4" SOLID YELLOW STRIPE
- ⑥ REFLECTORIZED PLASTIC MARKING LEFT TURN AND THRU ARROW
- ⑦ REFLECTORIZED PLASTIC MARKING THRU ARROW
- ⑧ REFLECTORIZED PLASTIC MARKING RIGHT TURN ARROW
- ⑨ REFLECTORIZED PLASTIC MARKING WORD "ONLY"
- ⑩ REFLECTORIZED PLASTIC MARKING BIKE SYMBOL AND ARROW (BIKEWAY)
- ⑪ REFLECTORIZED PLASTIC MARKING 6" SHORT DASHED WHITE STRIPE, 2' LONG WITH 6' SKIP
- ⑫ REFLECTORIZED PLASTIC MARKINGS 12" SOLID WHITE CROSSWALK STRIPE
- ⑬ REFLECTORIZED PLASTIC MARKING 24" SOLID WHITE STRIPE

NOTE:
DIMENSIONS SHOWN - F.L.
OF CURB TO F.L. OF CURB.

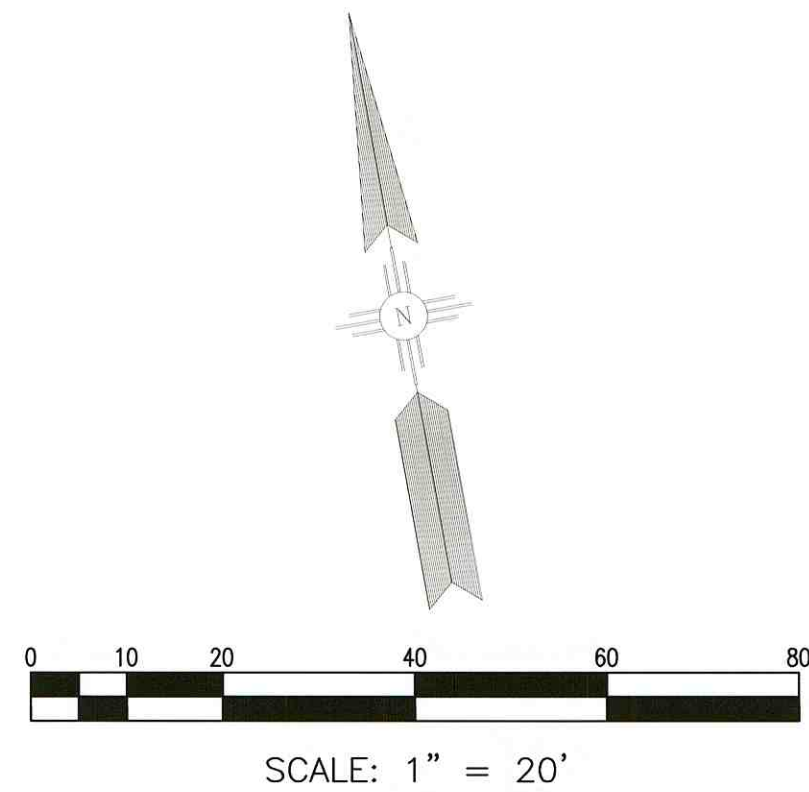

BIKE LANE SYMBOL & ARROW COMBINATION

PAY ITEM 441.032
STRIPING LEGEND ①
REFLECTORIZED PLASTIC MARKING
N.T.S.

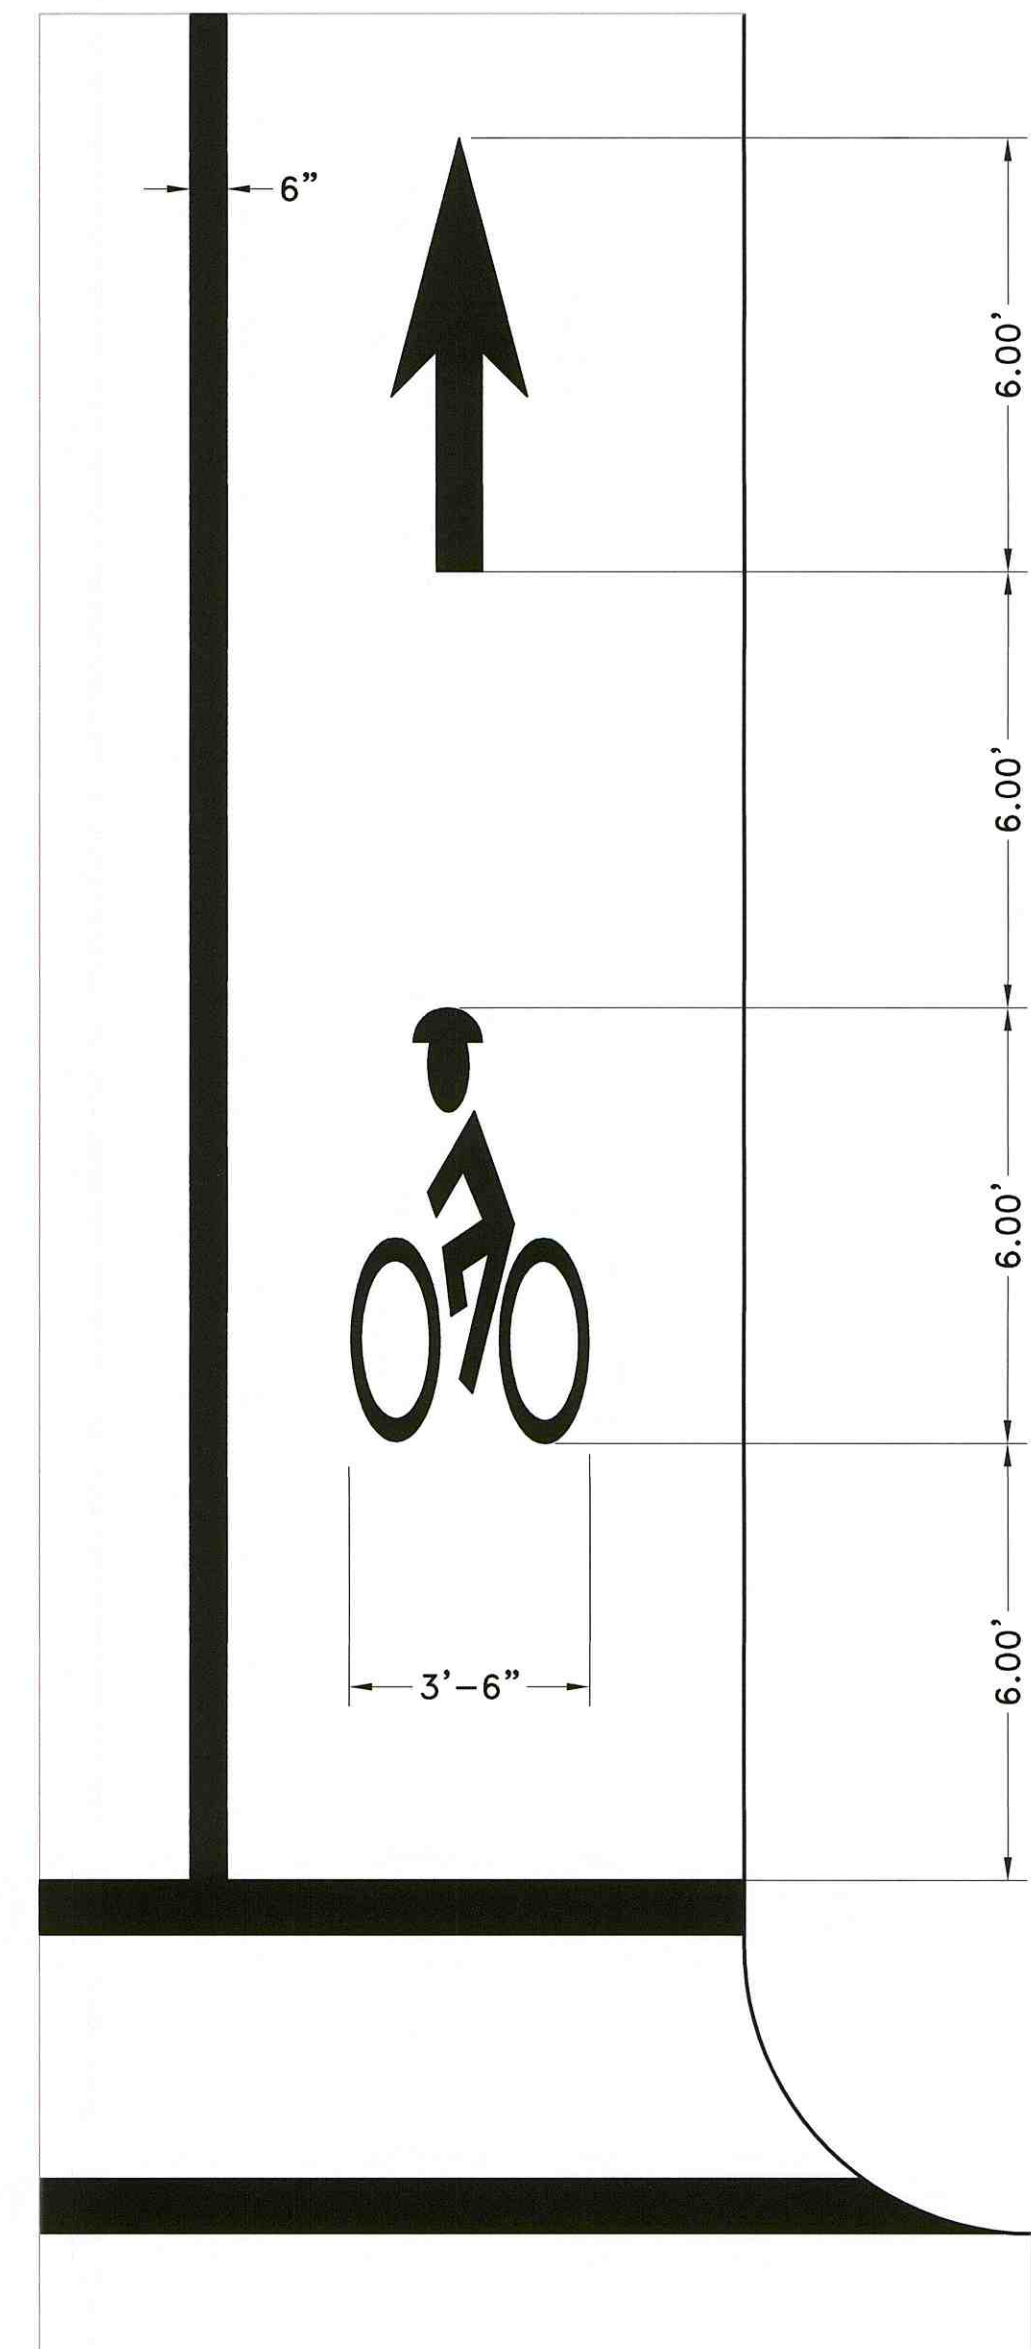

Gannett Fleming West, Inc.
2155 Louisiana NE, Suite 7000 Albuquerque, New Mexico 87110
Office: (505) 265-8468 Facsimile: (505) 881-2513



CITY OF ALBUQUERQUE
DEPARTMENT OF MUNICIPAL DEVELOPMENT

TITLE: BICYCLE BOULEVARD - MOUNTAIN ROAD, 14TH STREET, SILVER BLVD

COAL AVE. STRIPING MODIFICATION PLAN

Design Review Committee

City Engineer Approval

Last Design Update

Mo./Day/Yr.

Mo./Day/Yr.

City Project No.

7986-91

Zone Map No.
J-12,13,14
K-13,14,15

Sheet

11b OF **22**




SURVEY INFORMATION		BENCH MARKS		AS BUILT INFORMATION	
NO.	BY	DATE	NO.	CONTRACTOR	DATE
				INSPECTOR'S	DATE
				FIELD	DATE
				VERIFICATION BY	DATE
				CORRECTED BY	DATE
ENGINEER'S SEAL		MICRO-FILM INFORMATION		RECORDED BY	DATE
				NO.	DATE

05-08-2018
MATTHEW P. GRUPO
NEW MEXICO
18806
PROFESSIONAL ENGINEER

NO.	DATE	REMARKS	BY
1	3-10	SHEET ADDED TO SHOW COAL STRIPING	BR
DESIGN			
DESIGNED BY:	MPG	DATE: FEB 2008	
DRAWN BY:	MJM	DATE: FEB 2008	
CHECKED BY:	-	DATE:	

KEYED NOTES:

- (A) BICYCLE BOULEVARD PAVEMENT MARKING
- (B) BICYCLE BOULEVARD SIGN (SP-3)
- (C) BICYCLE BOULEVARD STREET NAME SIGN
- (D) SPEED LIMIT SIGN
- (E) BICYCLE BOULEVARD PLAQUE (SP-4)
- (F) WAYFINDING SIGN
- (G) REMOVE CONFLICTING SIGN
- (H) STOP AHEAD PAVEMENT MARKING, STOP AHEAD SIGN W3-1-36 TO BE PLACED 150 FEET IN ADVANCE OF STOP BAR
- (J) STOP SIGN REPLACE WITH R1-1-36

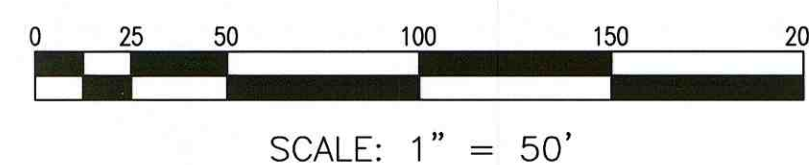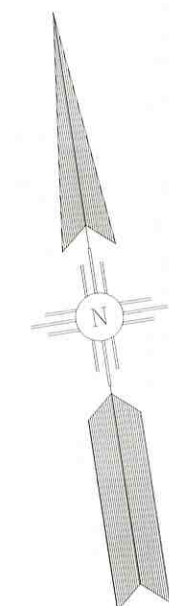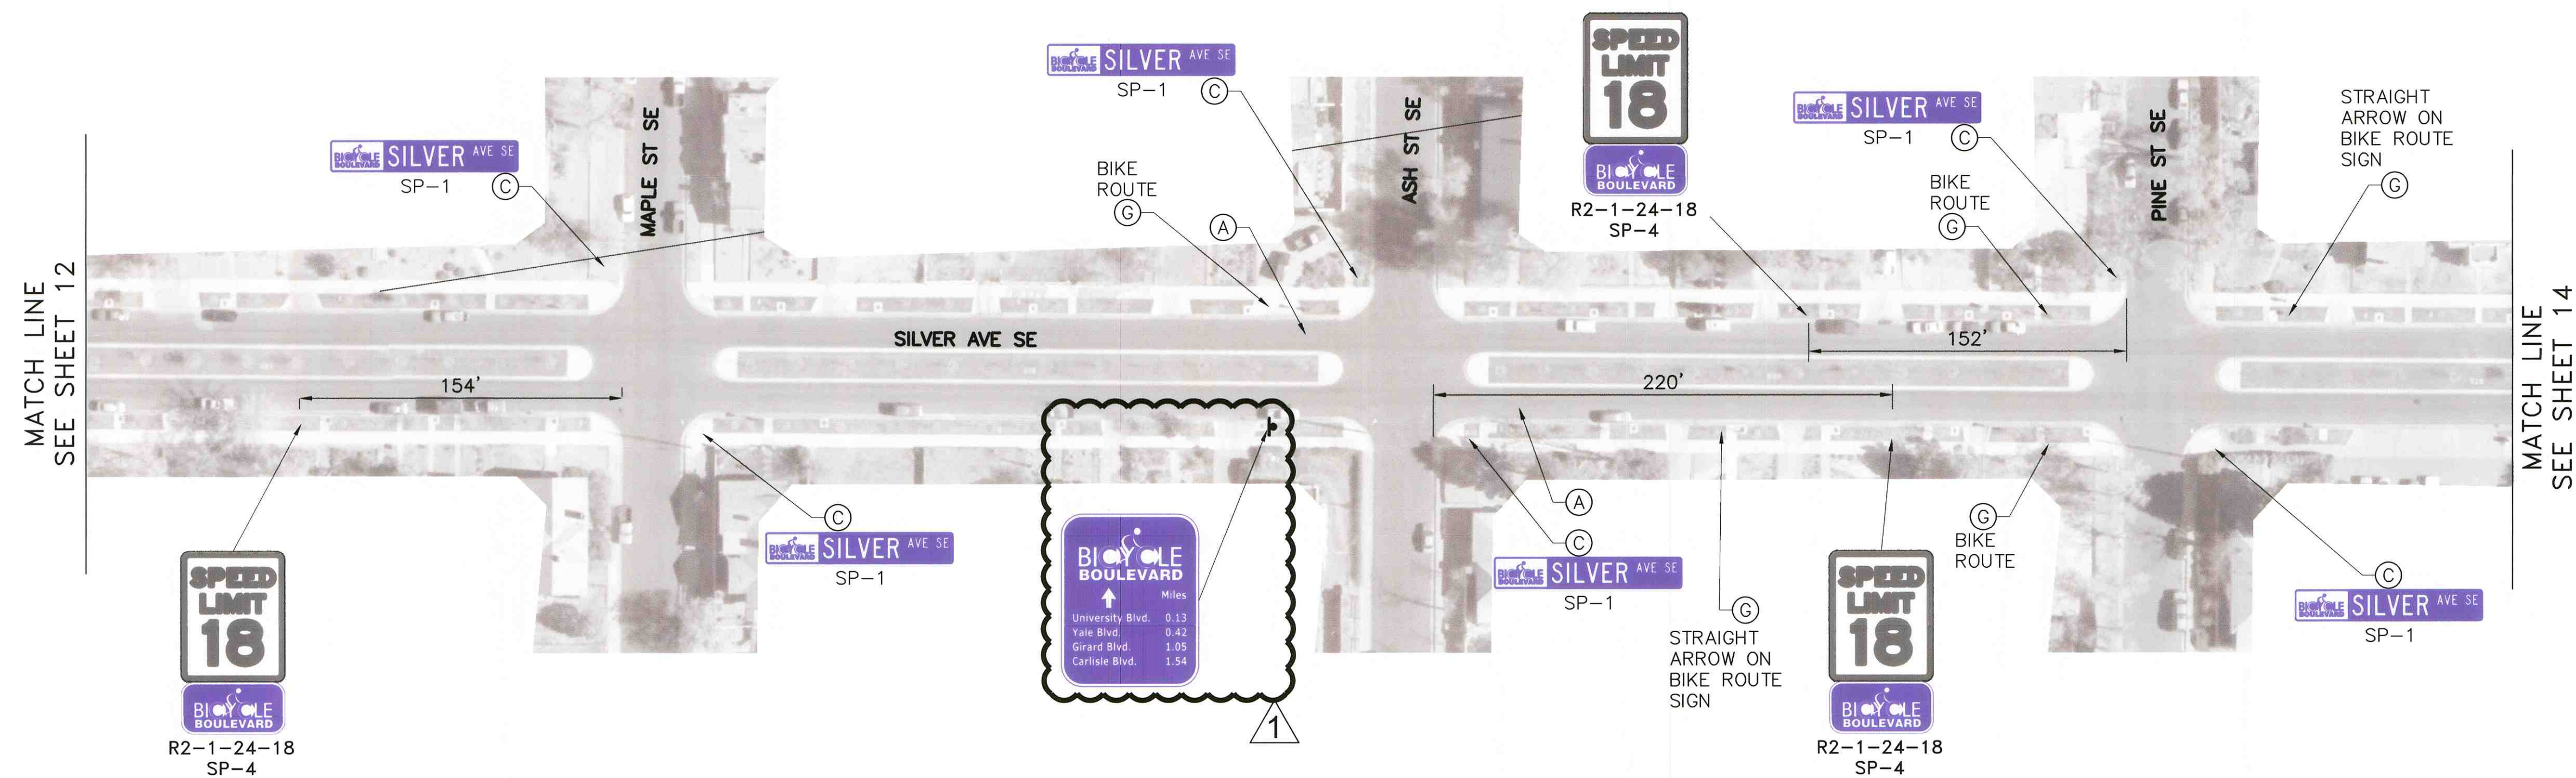

RECORD DRAWING
Drawing revised to reflect the
best information available. Do
not use without field verification.

PHASE I



 **Gannett Fleming West, Inc.**
2155 Louisiana NE, Suite 7000 Albuquerque, New Mexico 87110
Office: (505) 265-8468 Facsimile: (505) 881-2513

CITY OF ALBUQUERQUE
DEPARTMENT OF MUNICIPAL DEVELOPMENT

TITLE: BICYCLE BOULEVARD - MOUNTAIN ROAD, 14TH STREET, SILVER BLVD

BICYCLE BOULEVARD – SIGNING AND STRIPING PLANS

Design Review Committee

City Engineer Approval

Last Design Update

Mo./Day/Yr.

Mo./Day/Yr.


City Project No.



7986-91

Zone Map No.	K-15 TO 17
--------------	------------

Sheet 13 OF 22

[illegible]

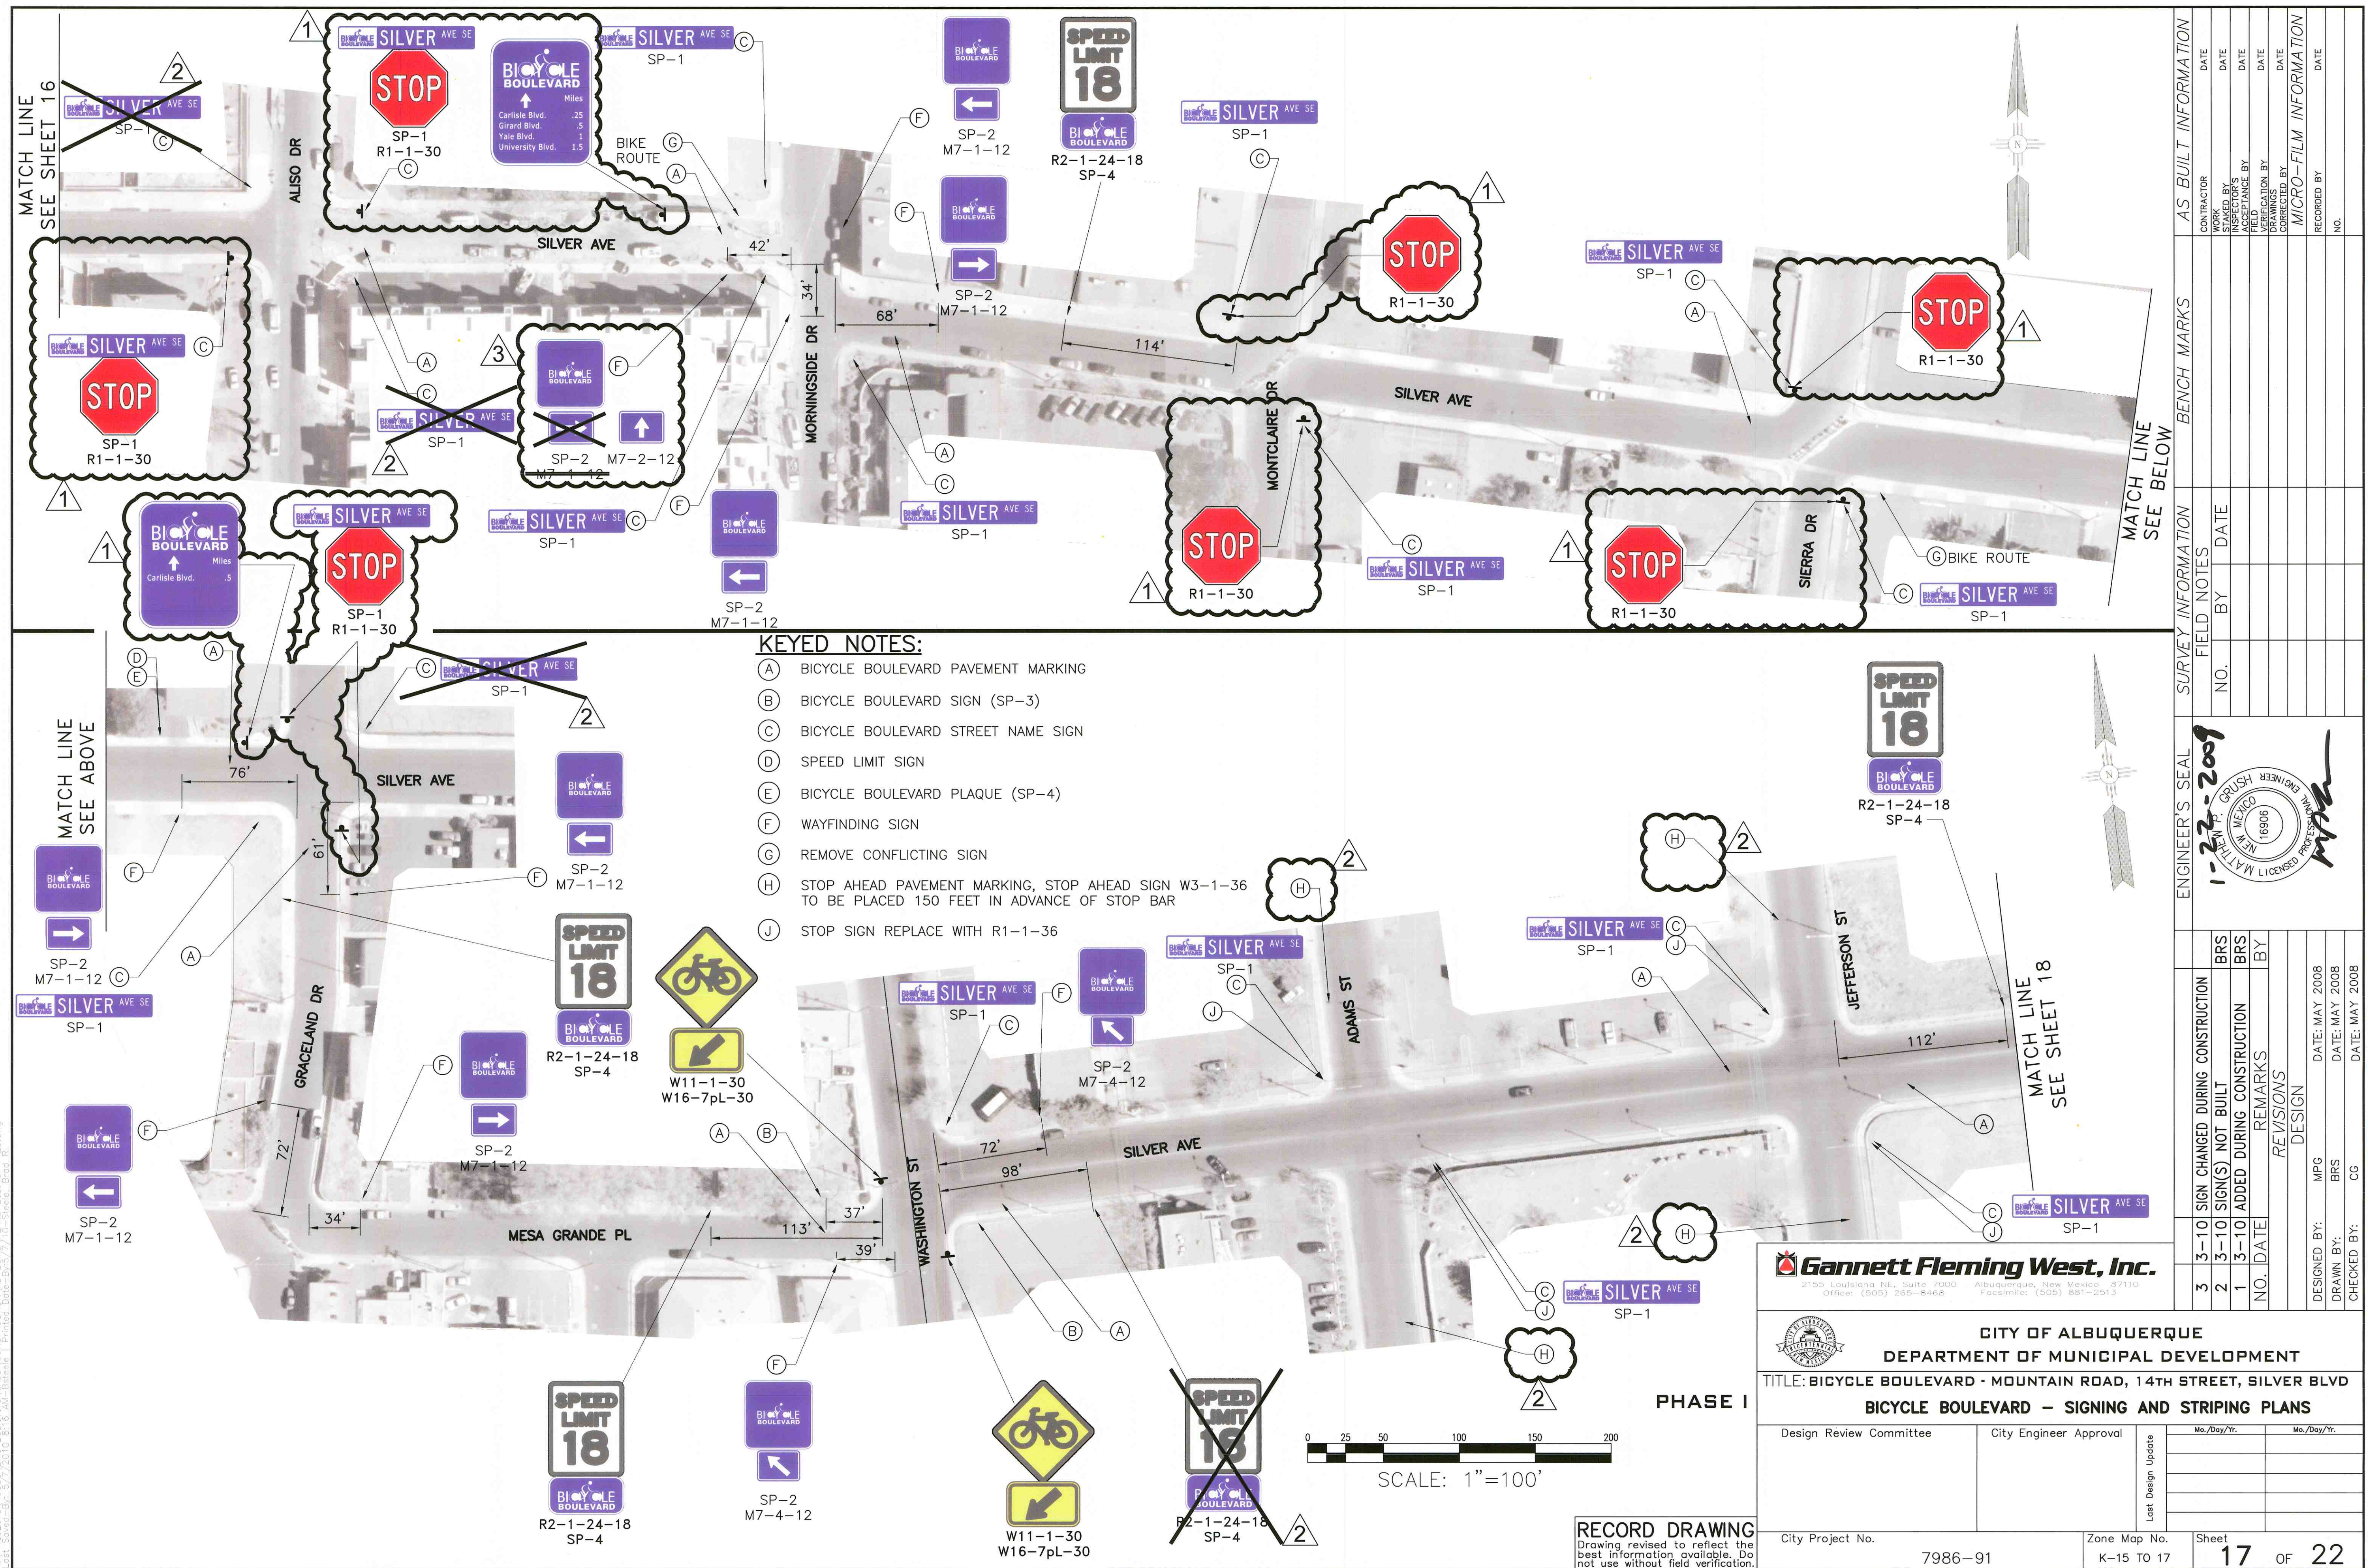

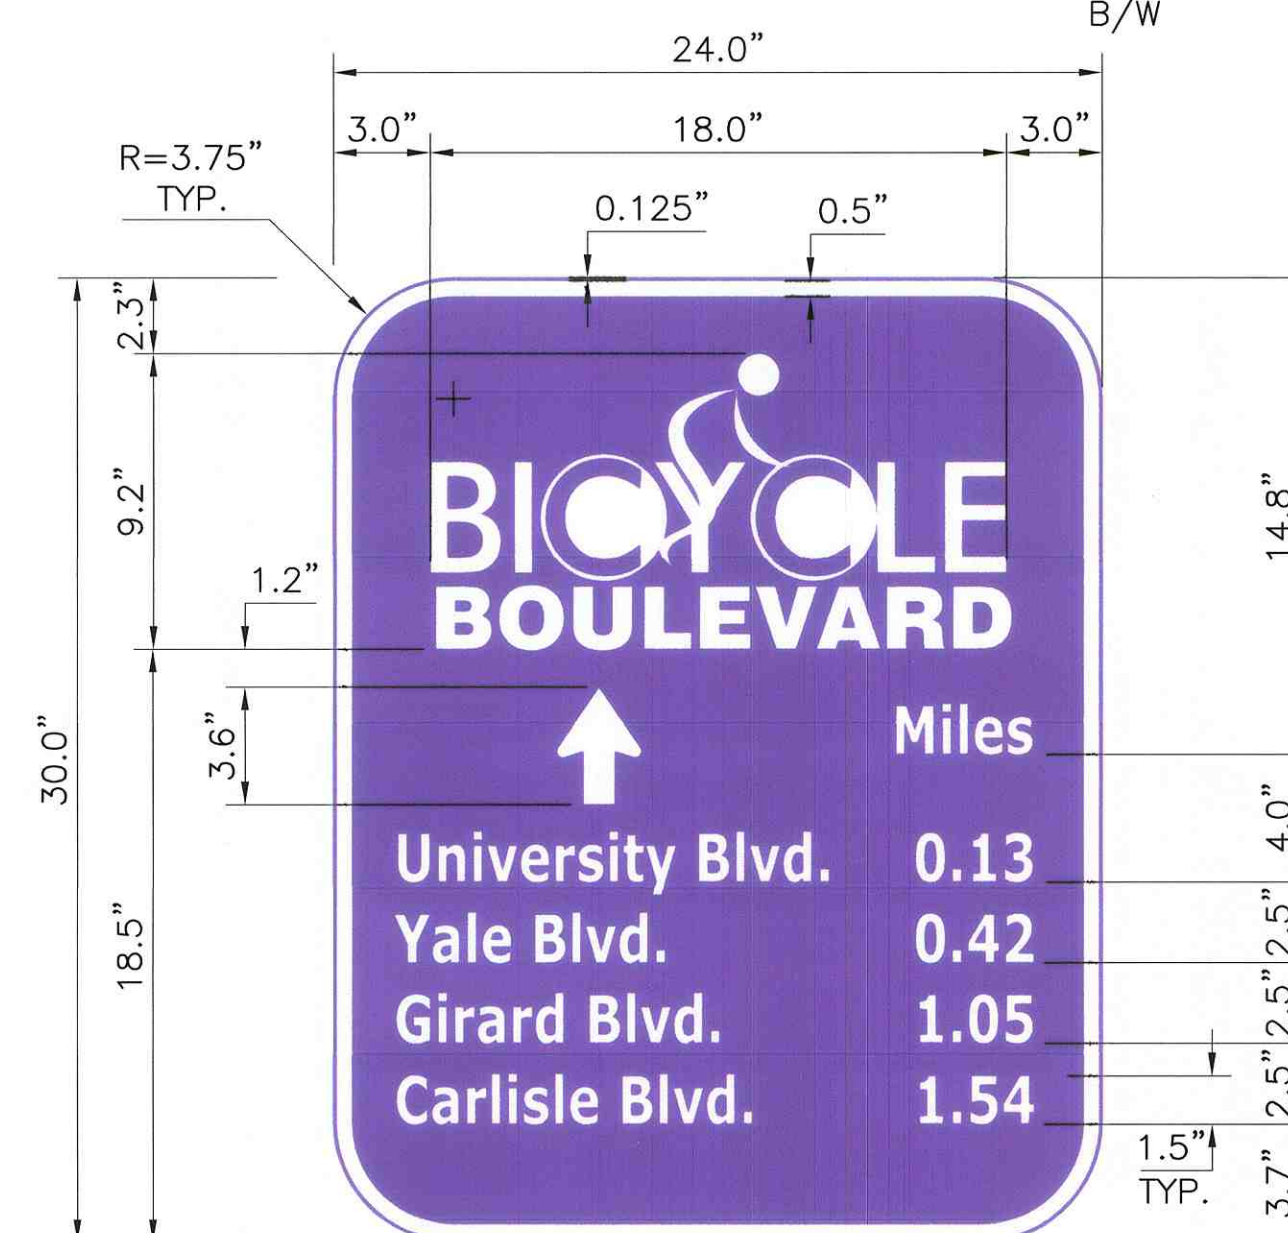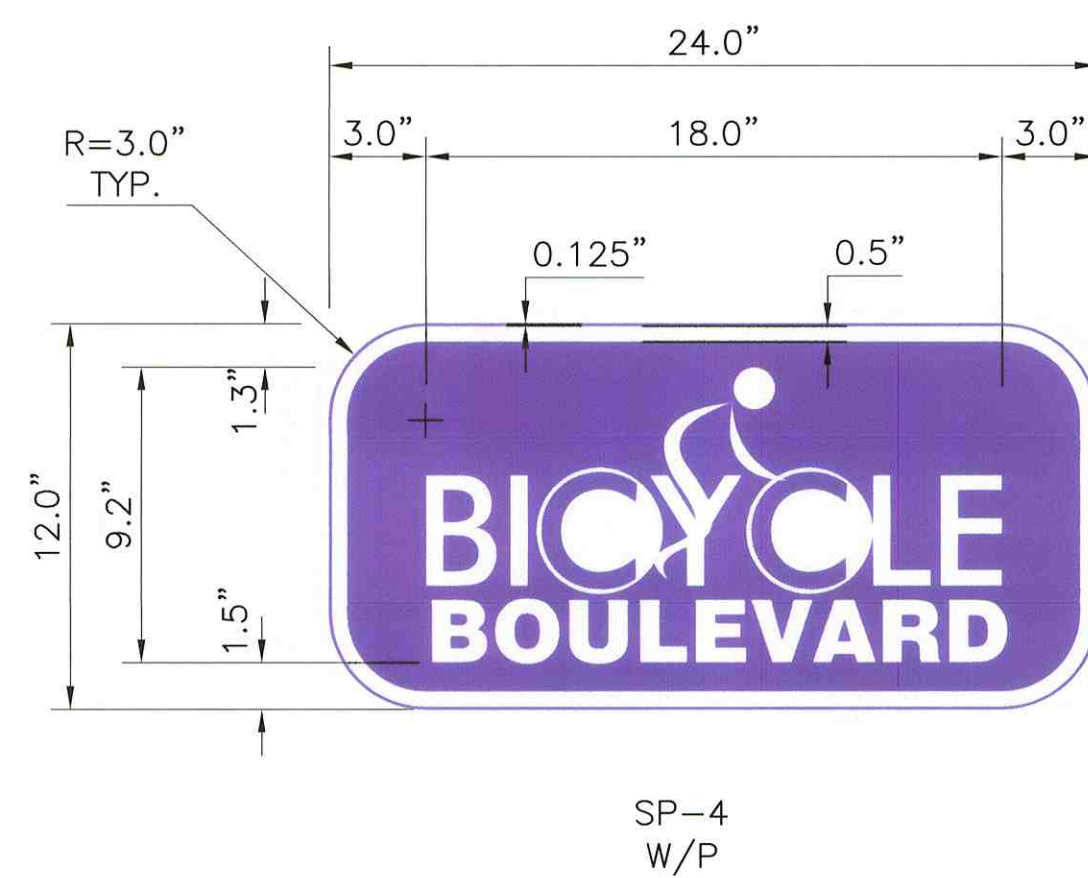

						ENGINEER'S SEAL		SURVEY INFORMATION		BENCH MARKS		AS BUILT INFORMATION	
						11-7-2008		FIELD NOTES					
								NO. BY DATE				CONTRACTOR	
												WORK	
												STARTED BY	
												INSPECTED BY	
												CHANGE BY	
												FIELD	
												VERIFICATION BY	
												DATE	
												DATE	
												MICRO-FILM INFORMATION	
												RECORDED BY	
												NO.	
DESIGNED BY: MPG		DATE: MAY 2008											
DRAWN BY: BRS		DATE: MAY 2008											

 **Gannett Fleming West, Inc.**
2155 Louisiana NE, Suite 7000 Albuquerque, New Mexico 87110
Office: (505) 265-8468 Facsimile: (505) 881-2513



CITY OF ALBUQUERQUE
DEPARTMENT OF MUNICIPAL DEVELOPMENT

TITLE: BICYCLE BOULEVARD : MOUNTAIN ROAD, 14TH STREET, SILVER BLVD

SIGN FACE DETAILS

Design Review Committee	City Engineer Approval	Last Design Update	Mo./Day/Yr.	Mo./Day/Yr.










City Project No.

Zone Map No.	K-15 TO 17
--------------	------------

Sheet 19 OF 22

RECORD DRAWING

Sign Face Details 20 of 22
K:\Projects\2008\080501\Bicycle Boulevard\Bicycle Boulevard.dwg
K:\Projects\2008\080501\Bicycle Boulevard\Bicycle Boulevard.dwg

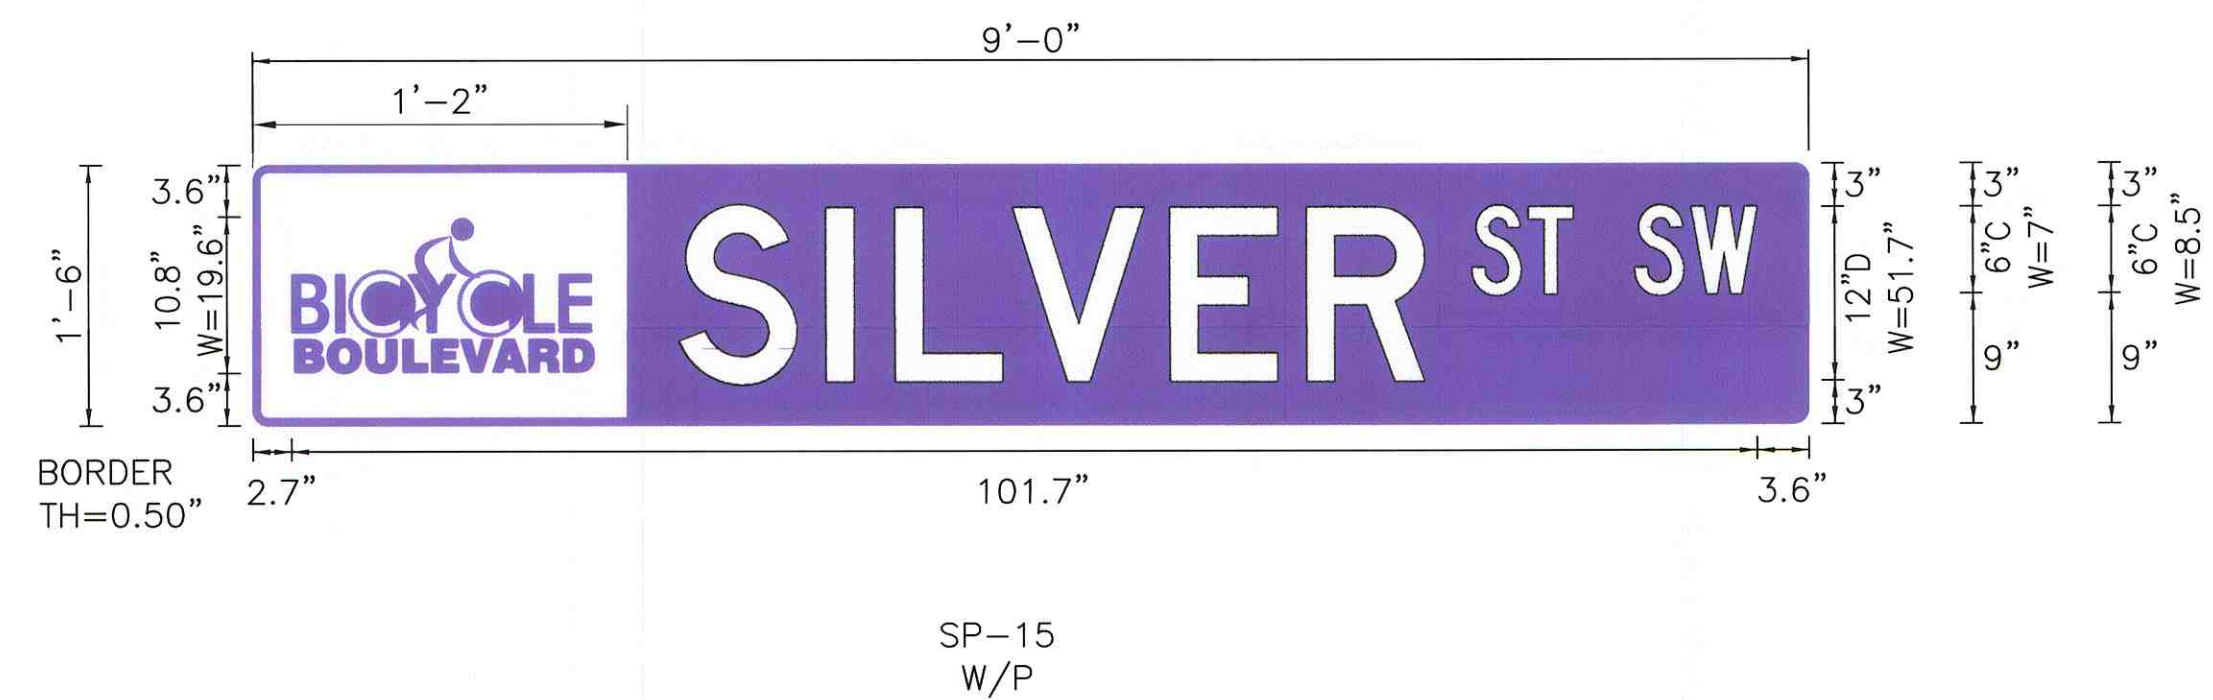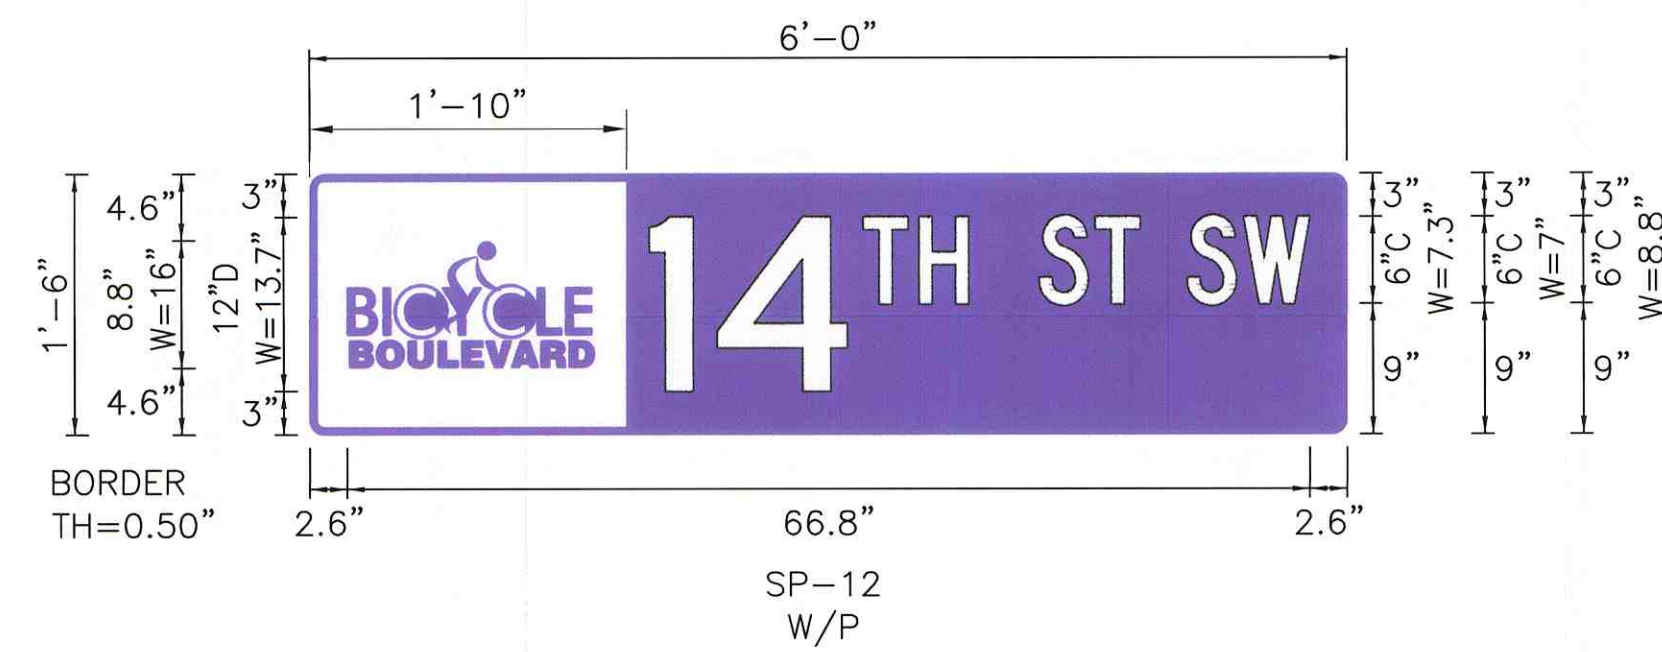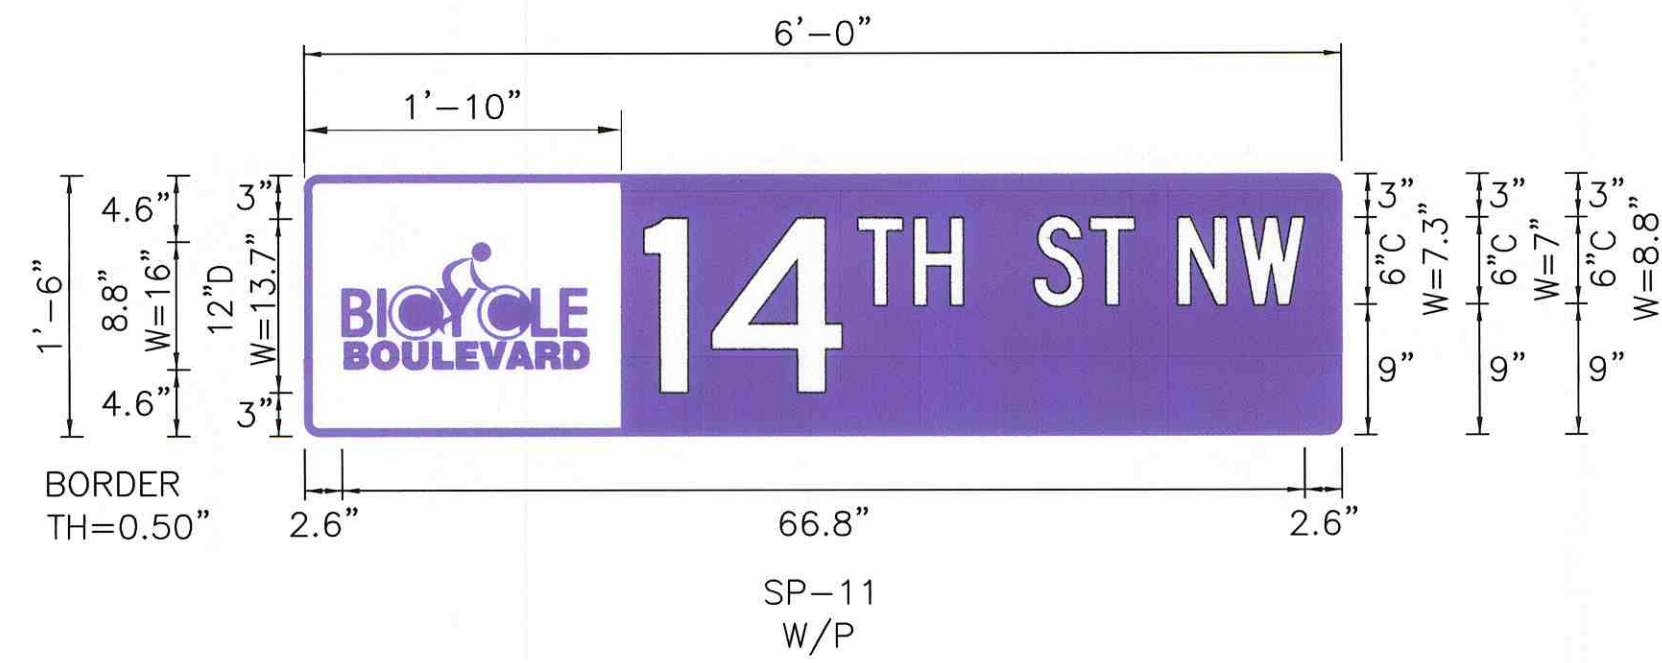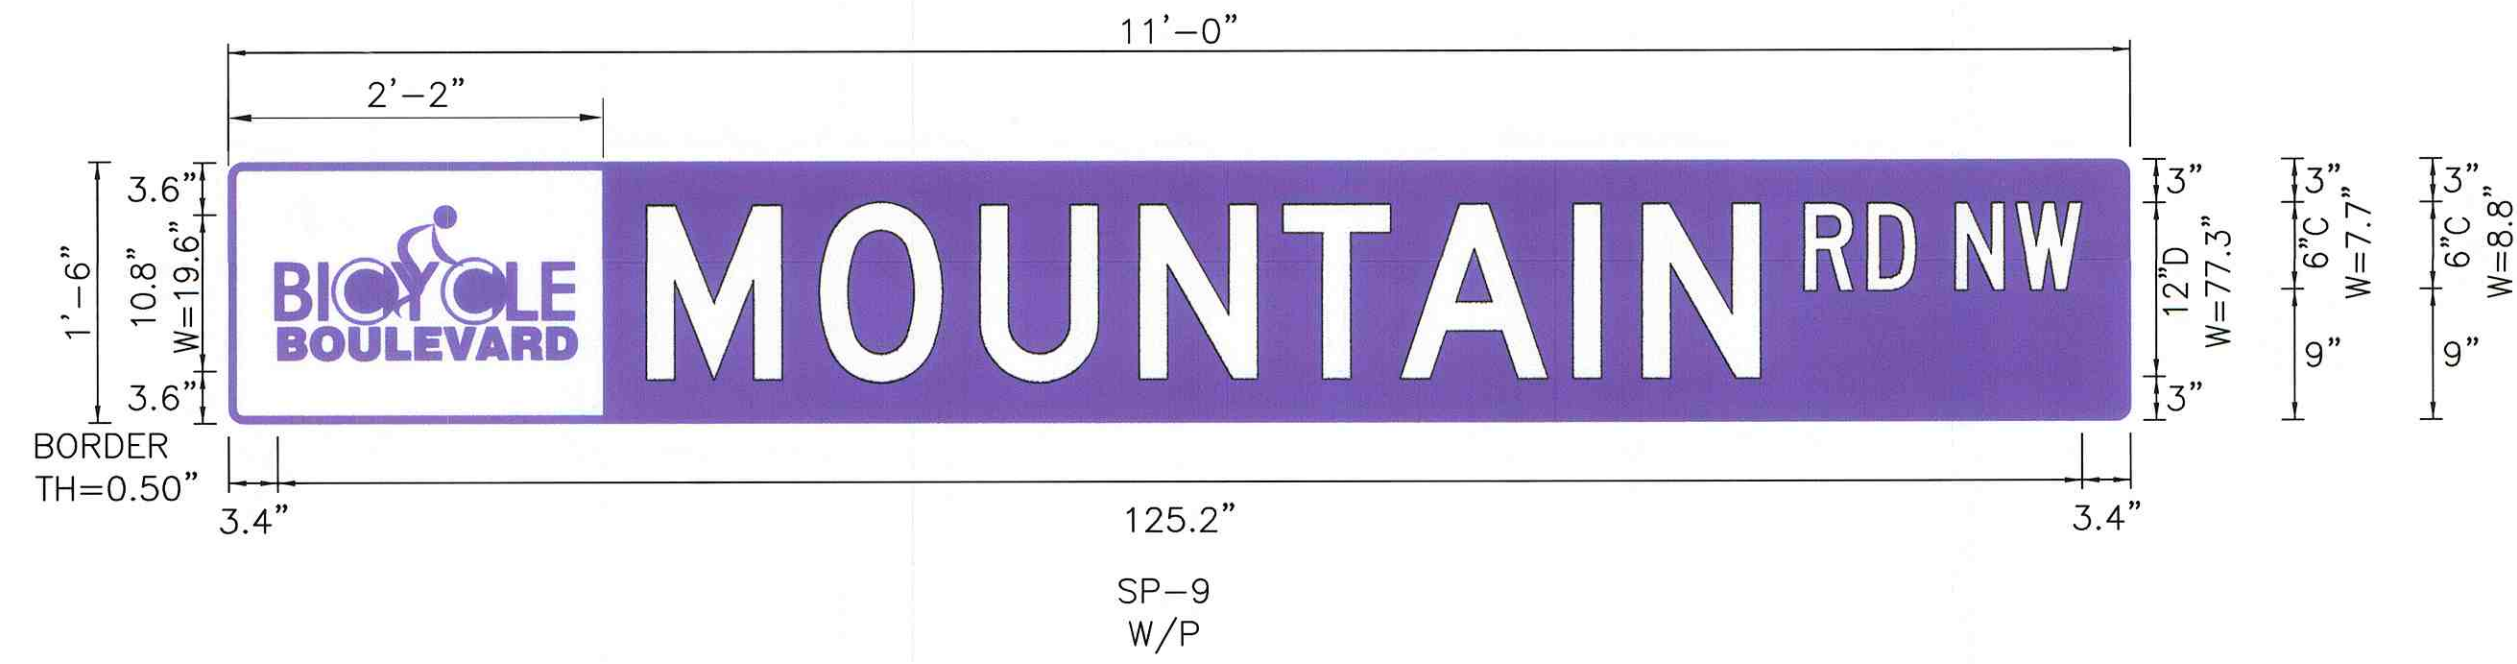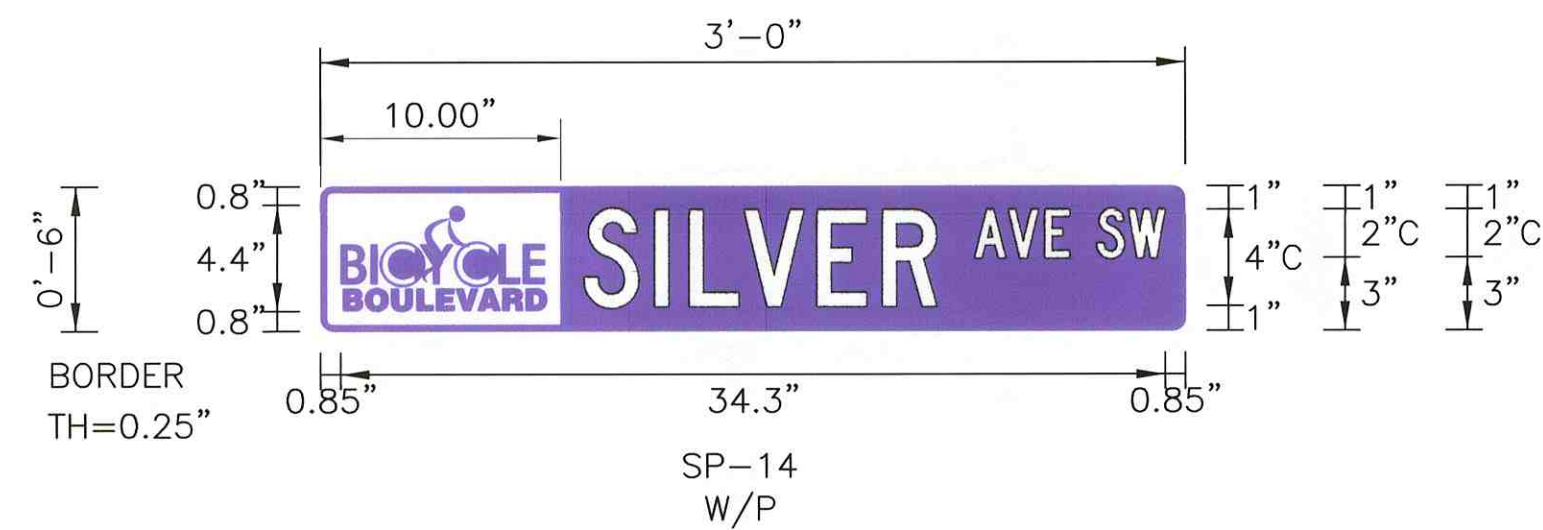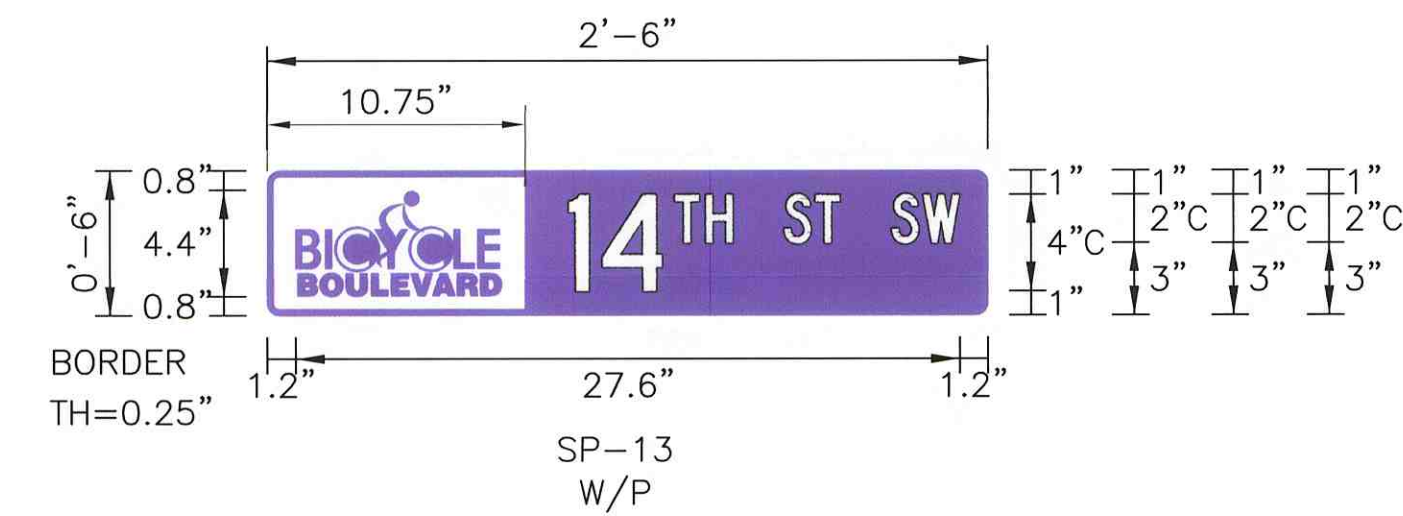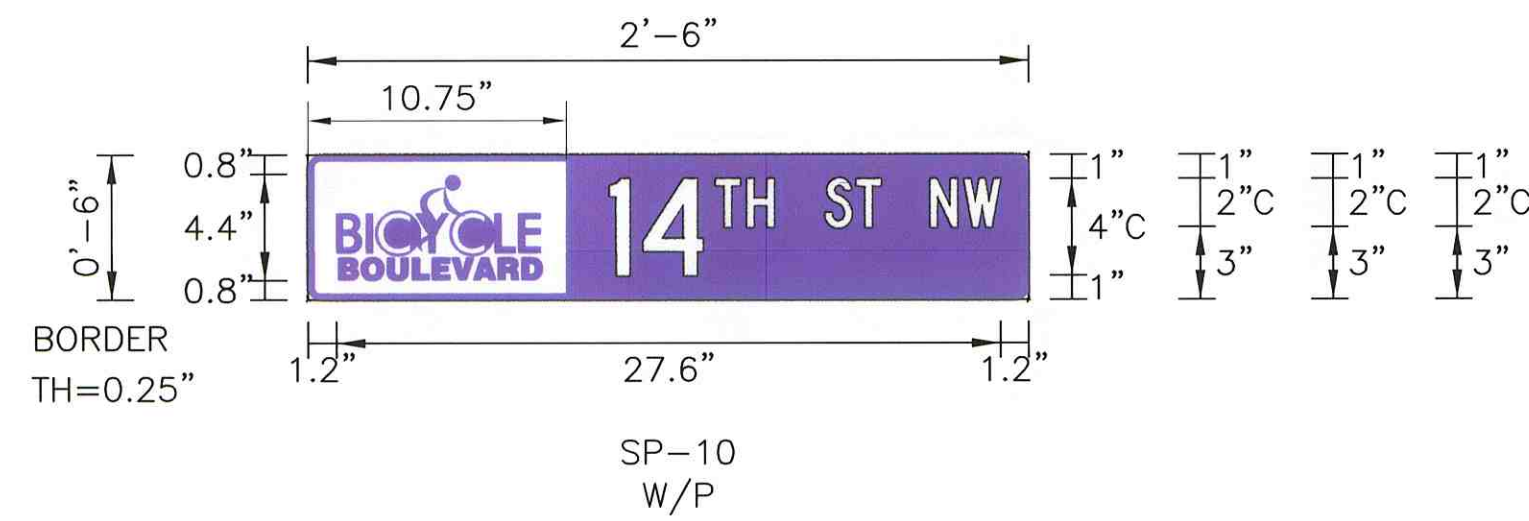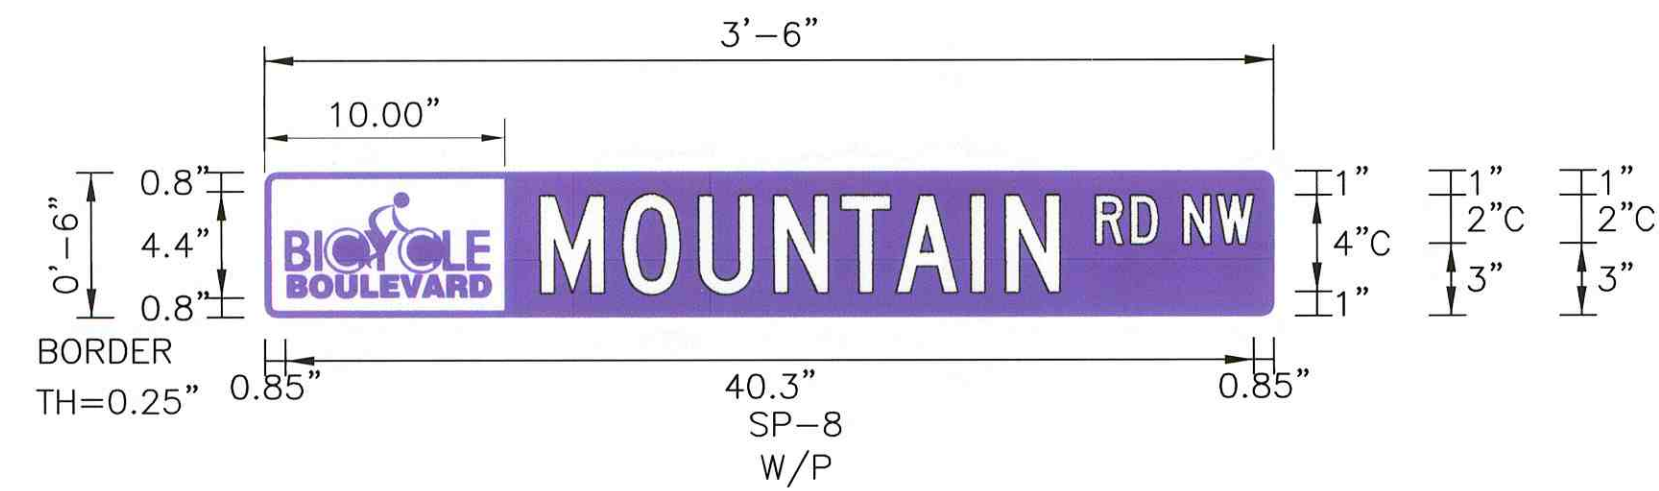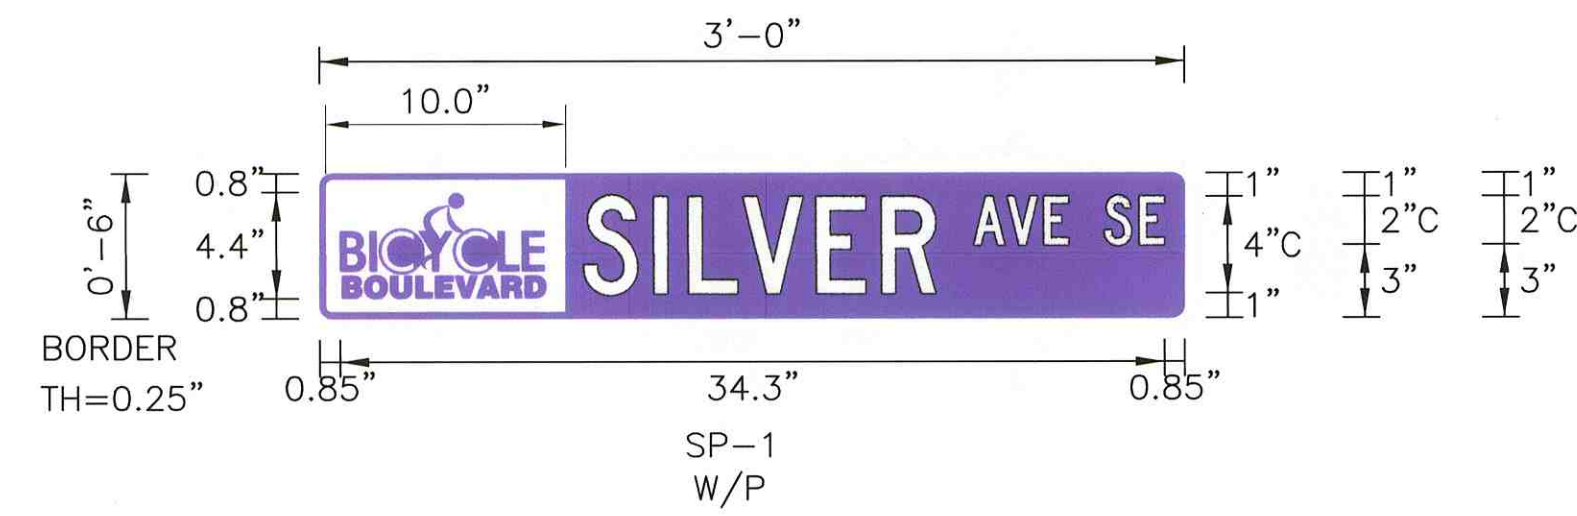

N.T.S.
Gannett Fleming West, Inc.
2155 Louisiana NE, Suite 7000 Albuquerque, New Mexico 87110
Office: (505) 265-8468 Facsimile: (505) 881-2513



CITY OF ALBUQUERQUE
DEPARTMENT OF MUNICIPAL DEVELOPMENT

TITLE: BICYCLE BOULEVARD - MOUNTAIN ROAD, 14TH STREET, SILVER BLVD

SIGN FACE DETAILS

Design Review Committee	City Engineer Approval	Mo./Day/Yr.	Mo./Day/Yr.


RECORD DRAWING
Drawing revised to reflect the best information available. Do not use without field verification.

City Project No. 7986-91 Zone Map No. K-15 TO 17 Sheet 20 OF 22


						ENGINEER'S SEAL		SURVEY INFORMATION		BENCH MARKS		AS BUILT INFORMATION	
						11-7-2008		FIELD NOTES					
								NO.		BY		DATE	

Technical drawing of a 'STOP AHEAD' sign. The sign is rectangular with a height of 10' and a width of 6'. The word 'STOP' is positioned at the bottom in a large, bold, sans-serif font, with a height of 8'. The word 'AHEAD' is positioned above 'STOP' in a smaller, bold, sans-serif font, with a height of 8'. The drawing includes dimension lines and arrows indicating the overall size and the height of the text.

BICYCLE BOULEVARD PAVEMENT MARKING
WHITE RETROREFLECTIVE

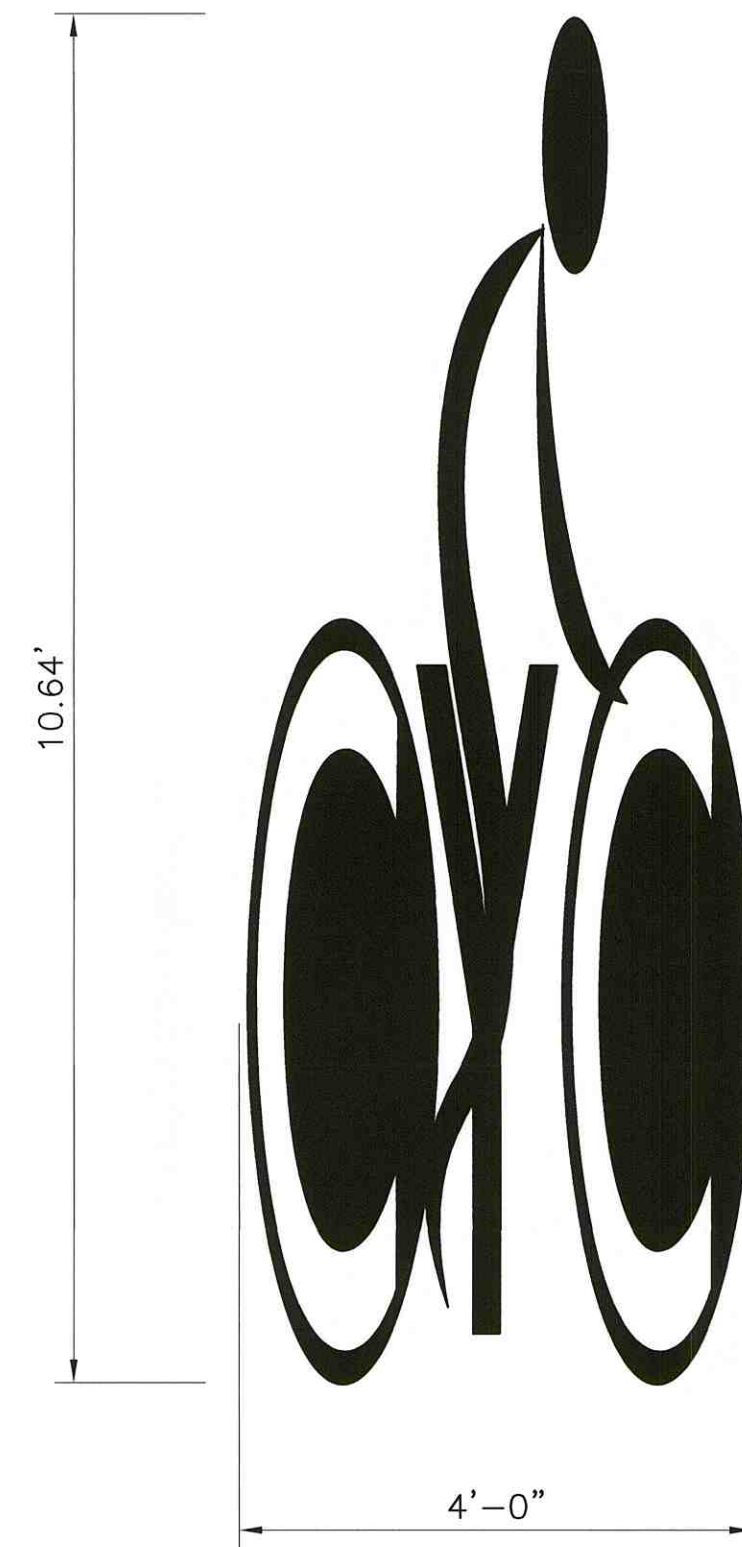

TYPICAL BICYCLE BOULEVARD PAVEMENT MARKING PLACEMENT DETAIL

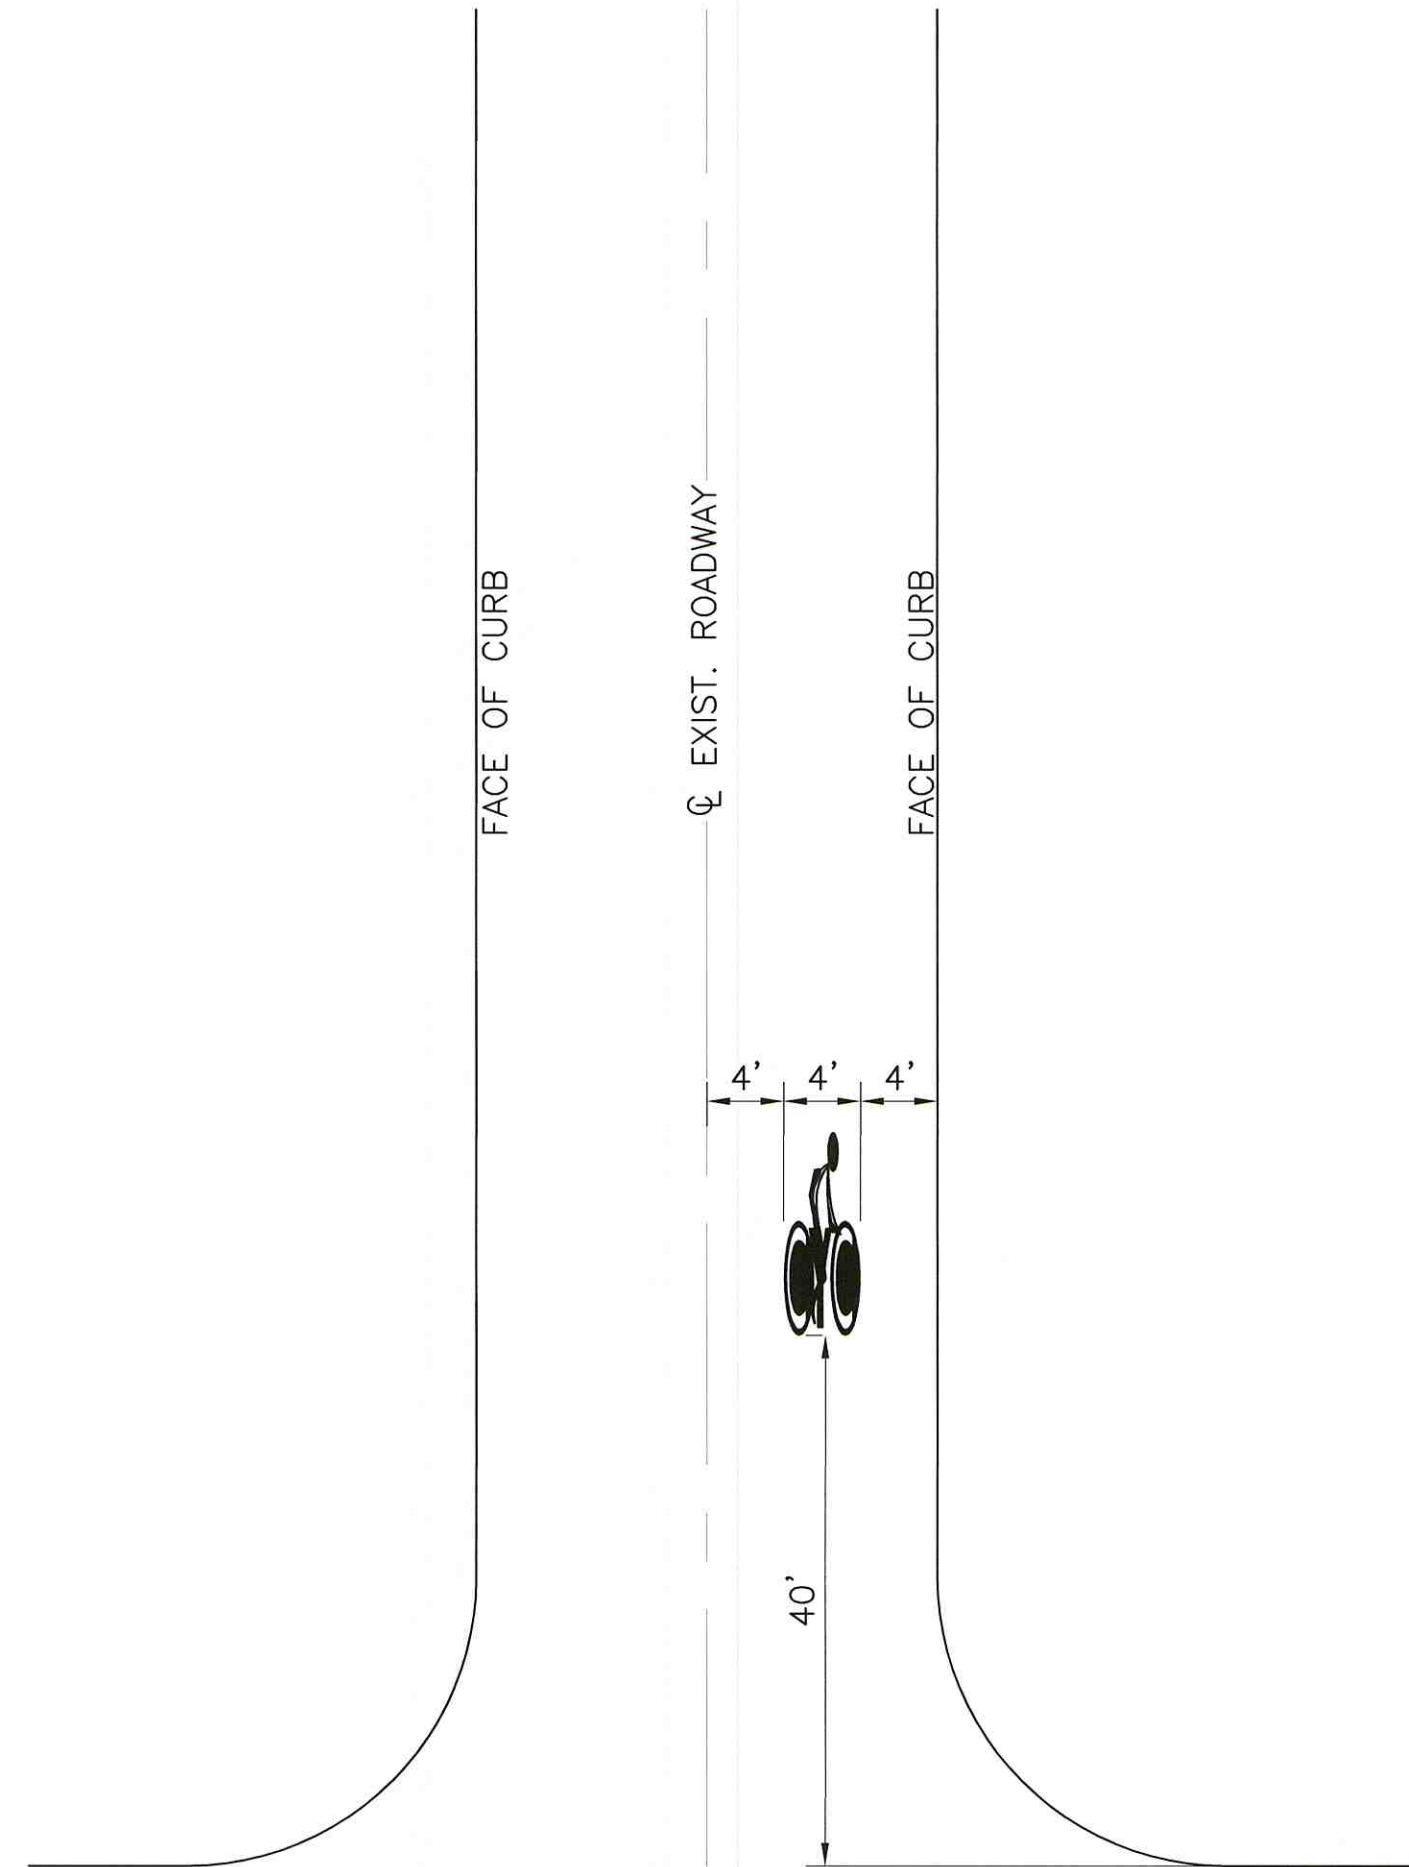

1. ALL STANDARD SIGN FACE DETAILS AND COLORS SHALL BE ACCORDING TO THE LATEST MUTCD AND STANDARD HIGHWAY SIGNS 2004 EDITION..
2. NEW POST MOUNTED SIGNS SHALL BE MOUNTED ON A SINGLE 12 GAUGE POST, AS MANUFACTURED BY TESPAR, OR APPROVED EQUAL. POSTS SHALL BE SQUARE WITH DIMENSIONS AS FOLLOWS:

2 1/4"x2 1/4"
3. CONTRACTOR SHALL INSTALL A CORRESPONDINGLY SIZED 30-INCH LONG BASE POST WITH AN 18-INCH LONG BASE POST SLEEVE. SIGN POSTS SHOULD BE INSERTED 6-INCHES INTO THE BASE POST OR PER MANUFACTURER'S RECOMMENDATIONS.
4. THE CONTRACTOR IS RESPONSIBLE FOR IDENTIFYING LOCATIONS WHERE NEW SIGNS WILL BE PLACED. AT THESE LOCATIONS, THE CONTRACTOR SHALL PLACE THE BASE POST AND SLEEVE ADJACENT TO EXISTING SIDEWALKS. THE CONTRACTOR WILL BE RESPONSIBLE FOR REPLACING ANY SIDEWALK DAMAGED BY SIGN POST INSTALLATION. ALL SIDEWALK REPLACEMENT SHALL BE CONSIDERED INCIDENTAL AND NO ADDITIONAL PAYMENT MADE THEREFOR.
5. ALL NEW SIGNS SHALL, AT A MINIMUM, USE SUPER ENGINEERING GRADE REFLECTIVE SHEETING WITH GRAFFITI RESISTANT INKS OR COATING AS APPROVED BY THE TRAFFIC ENGINEER.
6. ALL EXISTING SIGNS NOT SHOWN SHALL REMAIN INTACT.
7. ALL PAVEMENT MARKING SYMBOLS, LEGENDS, STRIPES AND MARKINGS SHALL BE RETROREFLECTORIZED PREFORMED PLASTIC AS PER COA STD SPEC. SECTION 441. HOT PLASTIC RETROREFLECTIVE PAVEMENT MARKING REQUIRES APPROVAL BY THE TRAFFIC OPERATION DIVISION PRIOR TO USAGE.
8. THE COLOR PURPLE FOR THE SIGN FACES IS DESCRIBED IN 23 CFR, PART 655, SUBPART F, APPENDIX SHOWN BELOW.

Color	Chromaticity Coordinates							
	1		2		3		4	
	x	y	x	y	y	x	x	y
White	0.303	0.300	0.368	0.366	0.340	0.393	0.274	0.329
Red	0.648	0.351	0.735	0.265	0.629	0.281	0.565	0.346
Orange	0.558	0.352	0.636	0.364	0.570	0.429	0.506	0.404
Brown	0.430	0.340	0.430	0.390	0.518	0.434	0.570	0.382
Yellow	0.498	0.412	0.557	0.442	0.479	0.520	0.438	0.472
Green	0.026	0.999	0.166	0.364	0.286	0.446	0.207	0.771
Blue	0.078	0.171	0.150	0.220	0.210	0.160	0.137	0.038
Light Blue	0.180	0.260	0.240	0.300	0.270	0.260	0.230	0.200
Purple	0.300	0.064	0.320	0.200	0.550	0.300	0.600	0.202



N.T.S.										NO. DATE		DESIGNED BY:		DRAWN BY:		CHECKED BY:																										
 Gannett Fleming West, Inc. 2155 Louisiana NE, Suite 7000 Office: (505) 265-8468		Albuquerque, New Mexico 87110 Facsimile: (505) 881-2513																																								
 CITY OF ALBUQUERQUE DEPARTMENT OF MUNICIPAL DEVELOPMENT TITLE: BICYCLE BOULEVARD - MOUNTAIN ROAD, 14TH STREET, SILVER BLVD PAVEMENT MARKING AND PERMANENT SIGNING NOTES <table border="1" style="width: 100%;"> <tr> <td style="width: 33%;">Design Review Committee</td> <td style="width: 33%;">City Engineer Approval</td> <td style="width: 10%;">Last Design Update</td> <td style="width: 15%;">Mo./Day/Yr.</td> <td style="width: 10%;">Mo./Day/Yr.</td> </tr> <tr><td> </td><td> </td><td> </td><td> </td><td> </td></tr> <tr><td> </td><td> </td><td> </td><td> </td><td> </td></tr> <tr><td> </td><td> </td><td> </td><td> </td><td> </td></tr> <tr><td> </td><td> </td><td> </td><td> </td><td> </td></tr> </table>																		Design Review Committee	City Engineer Approval	Last Design Update	Mo./Day/Yr.	Mo./Day/Yr.																				
Design Review Committee	City Engineer Approval	Last Design Update	Mo./Day/Yr.	Mo./Day/Yr.																																						
City Project No.				Zone Map No.				Sheet																																		
7986-91				K-15 To 17				21 OF 22																																		

RECORD DRAWING
Drawing revised to reflect the best information available. Do not use without field verification.

Silver and Girard
K:\PROJECTS\49900\Bike Boulevards\ROAD CONSTRUCTION\As-Built\49900_11-25a.MXD
11/25/2008 11:25:00 AM
11/25/2008 11:25:00 AM



* MOUNT SO THAT BOTTOM OF SIGN IS 2' ABOVE PAVEMENT TO MINIMIZE SIGHT LINE OBSTRUCTION

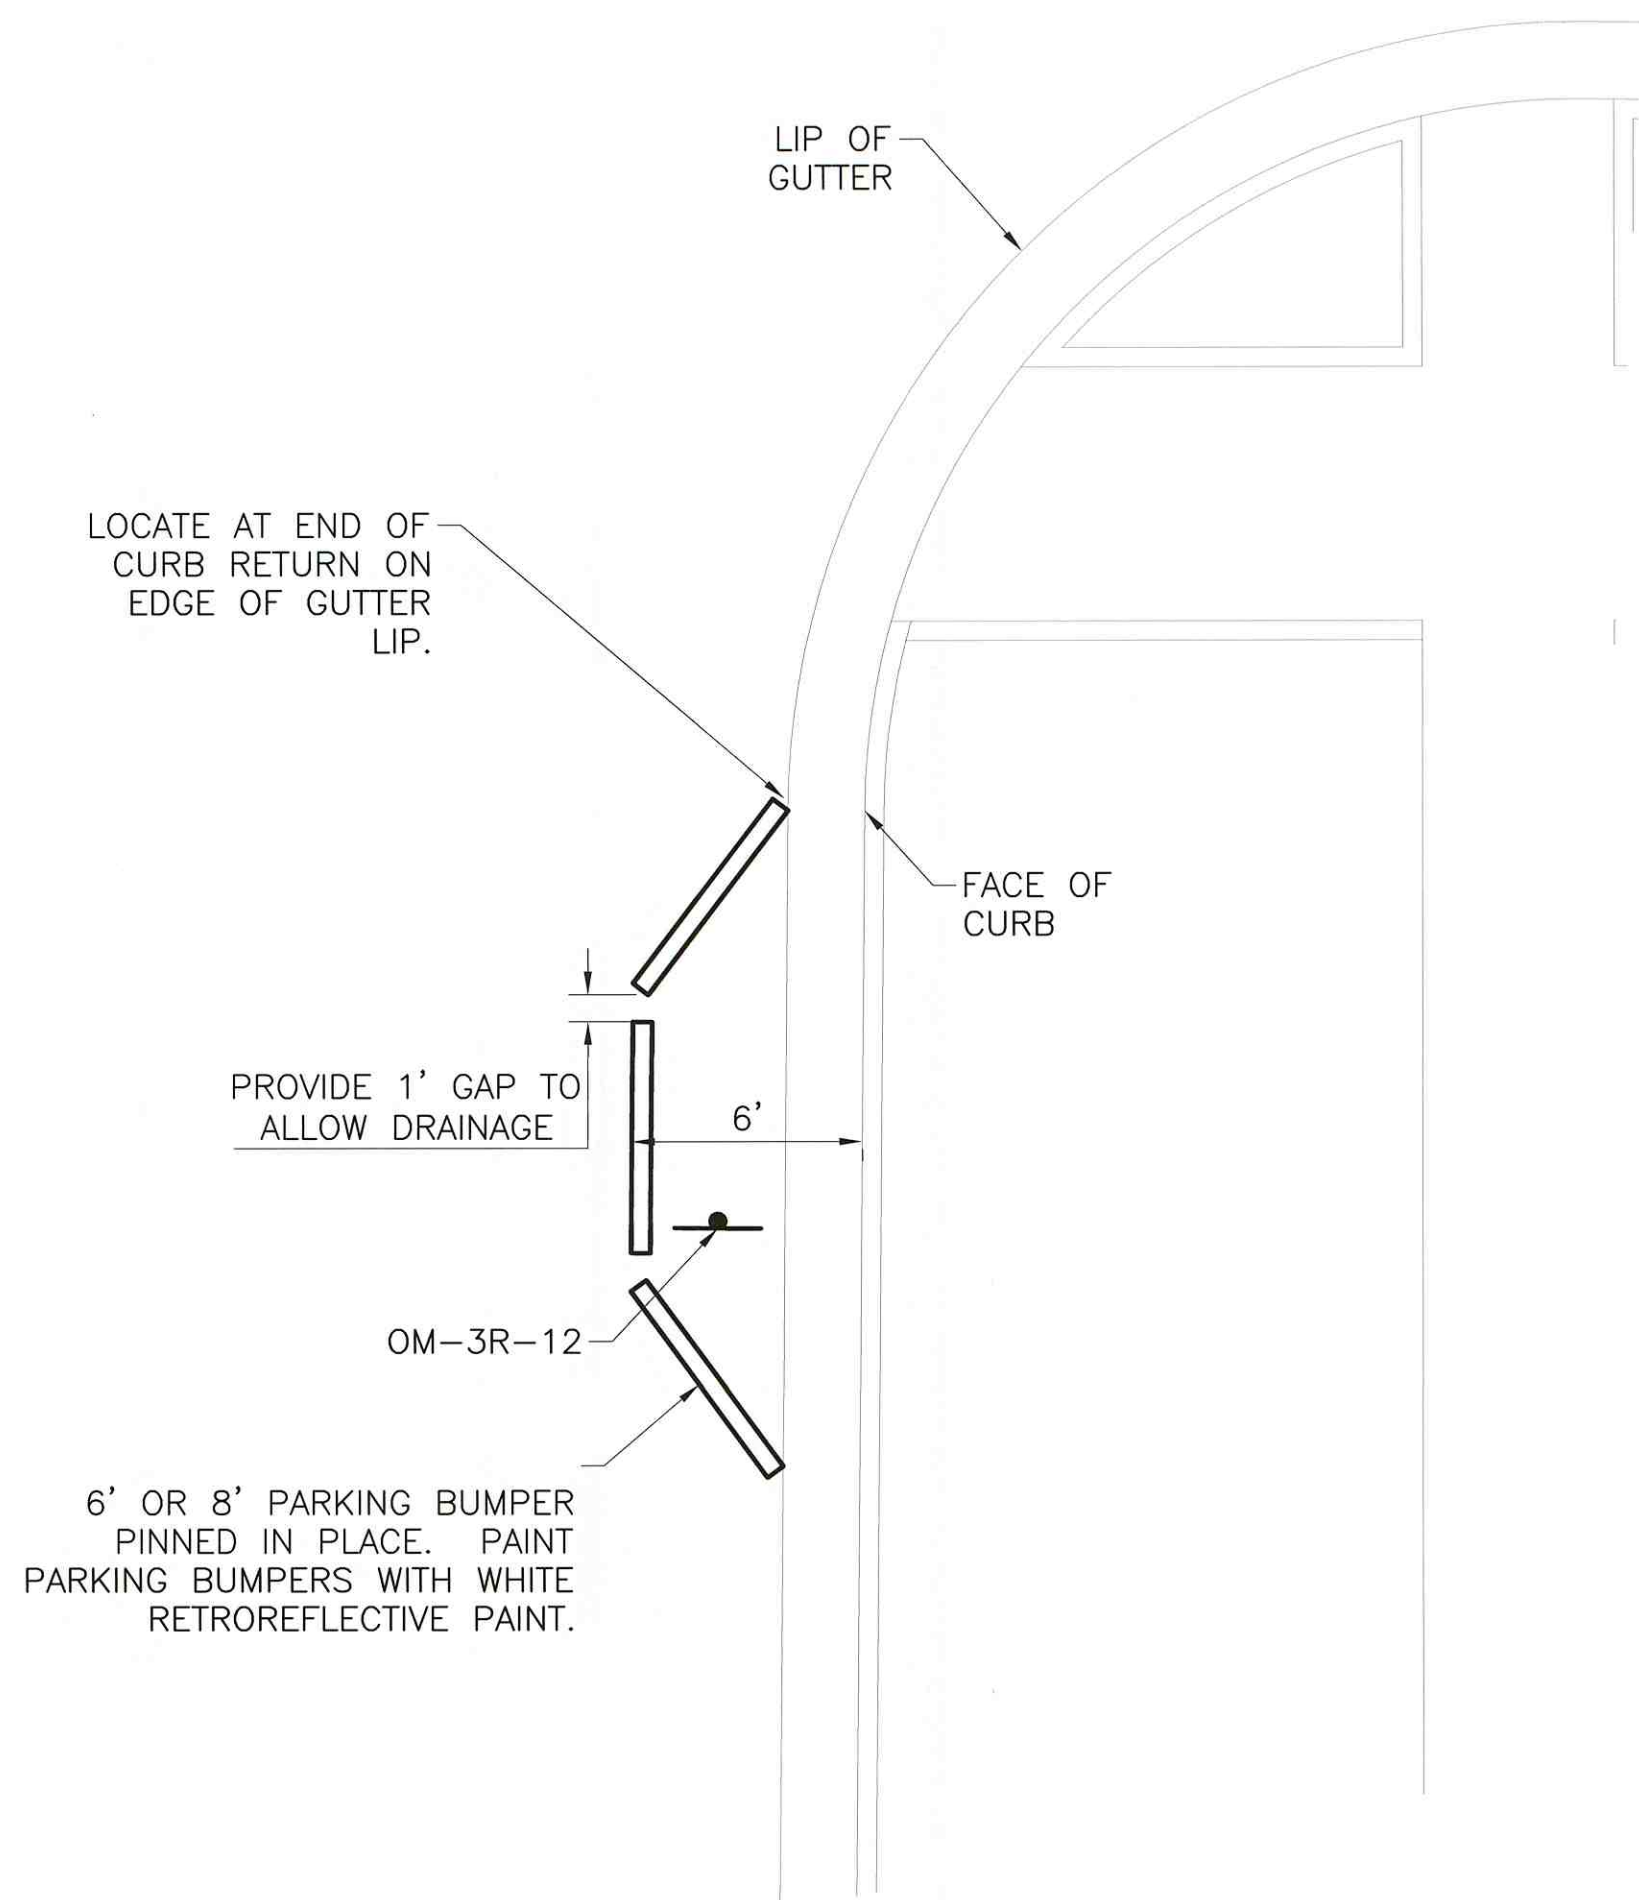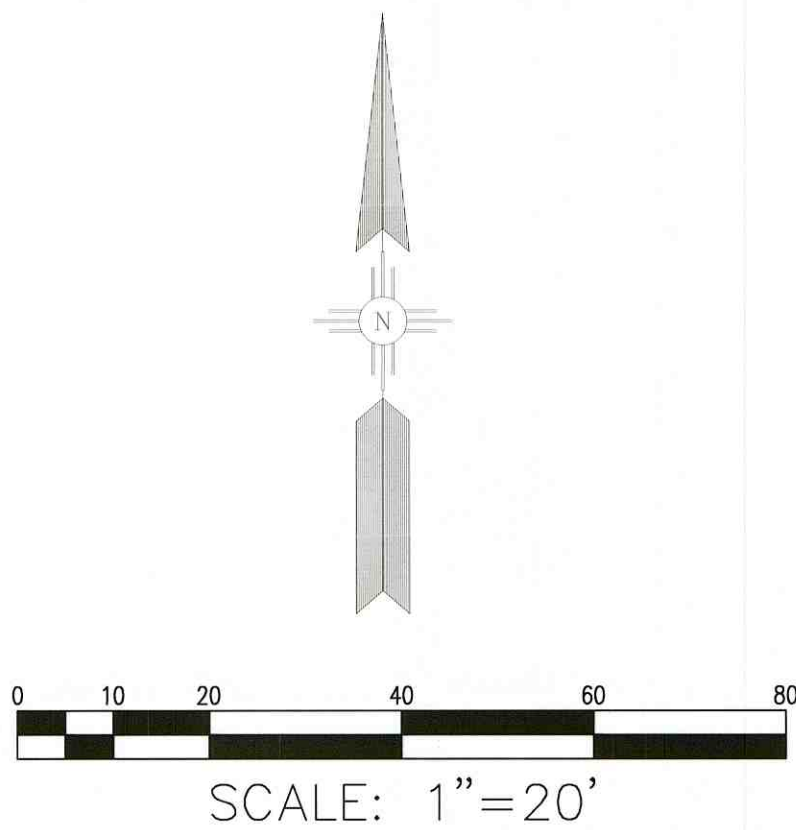

TYPICAL TEMPORARY CURB EXTENSION
SCALE: 1"=5'

Gannett Fleming West, Inc.
2155 Louisiana NE, Suite 7000 Albuquerque, New Mexico 87110
Office: (505) 265-8468 Facsimile: (505) 881-2513



CITY OF ALBUQUERQUE
DEPARTMENT OF MUNICIPAL DEVELOPMENT

TITLE: BICYCLE BOULEVARD - MOUNTAIN ROAD, 14TH STREET, SILVER BLVD
SILVER-GIRARD INTERSECTION IMPROVEMENT PLAN

Design Review Committee

City Engineer Approval

Last Design Update

Mo./Day/Yr.

Mo./Day/Yr.

City Project No.

7986-91

Zone Map No.
K-15 TO 17

Sheet


22 OF 22

RECORD DRAWING
Drawing revised to reflect the best information available. Do not use without field verification.

SURVEY INFORMATION		BENCH MARKS		AS BUILT INFORMATION	
NO.	BY	DATE	CONTRACTOR	WORK	DATE
				STANDARD BY	DATE
				FIELD ACCEPTANCE BY	DATE
				DESIGNATION BY	DATE
				DRAWINGS	DATE
				CORRECTED BY	DATE
				MICRO-FILM INFORMATION	DATE
				RECORDED BY	DATE
				NO.	DATE

ENGINEER'S SEAL
11/23/2008
M. A. FLEMING
157310
1998
PROFESSIONAL ENGINEER












NO.	DATE	REMARKS	BY
		DESIGN	
		REVISIONS	
		DESIGN	
		DESIGNED BY: MPG	DATE: MAY 2008
		DRAWN BY: BRS	DATE: MAY 2008
		CHECKED BY: CG	DATE: MAY 2008

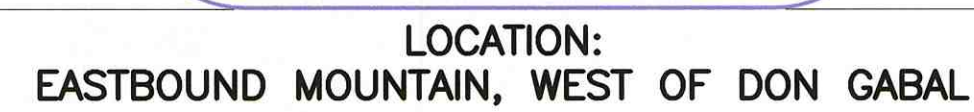

City Project No.	7986-91	Zone Map No. J-12,13,14 K-13,14,15	Sheet 22a OF 22
------------------	---------	--	--------------------

[illegible]

RECORD DRAWING
Drawing revised to reflect the
best information available. Do
not use without field verification.

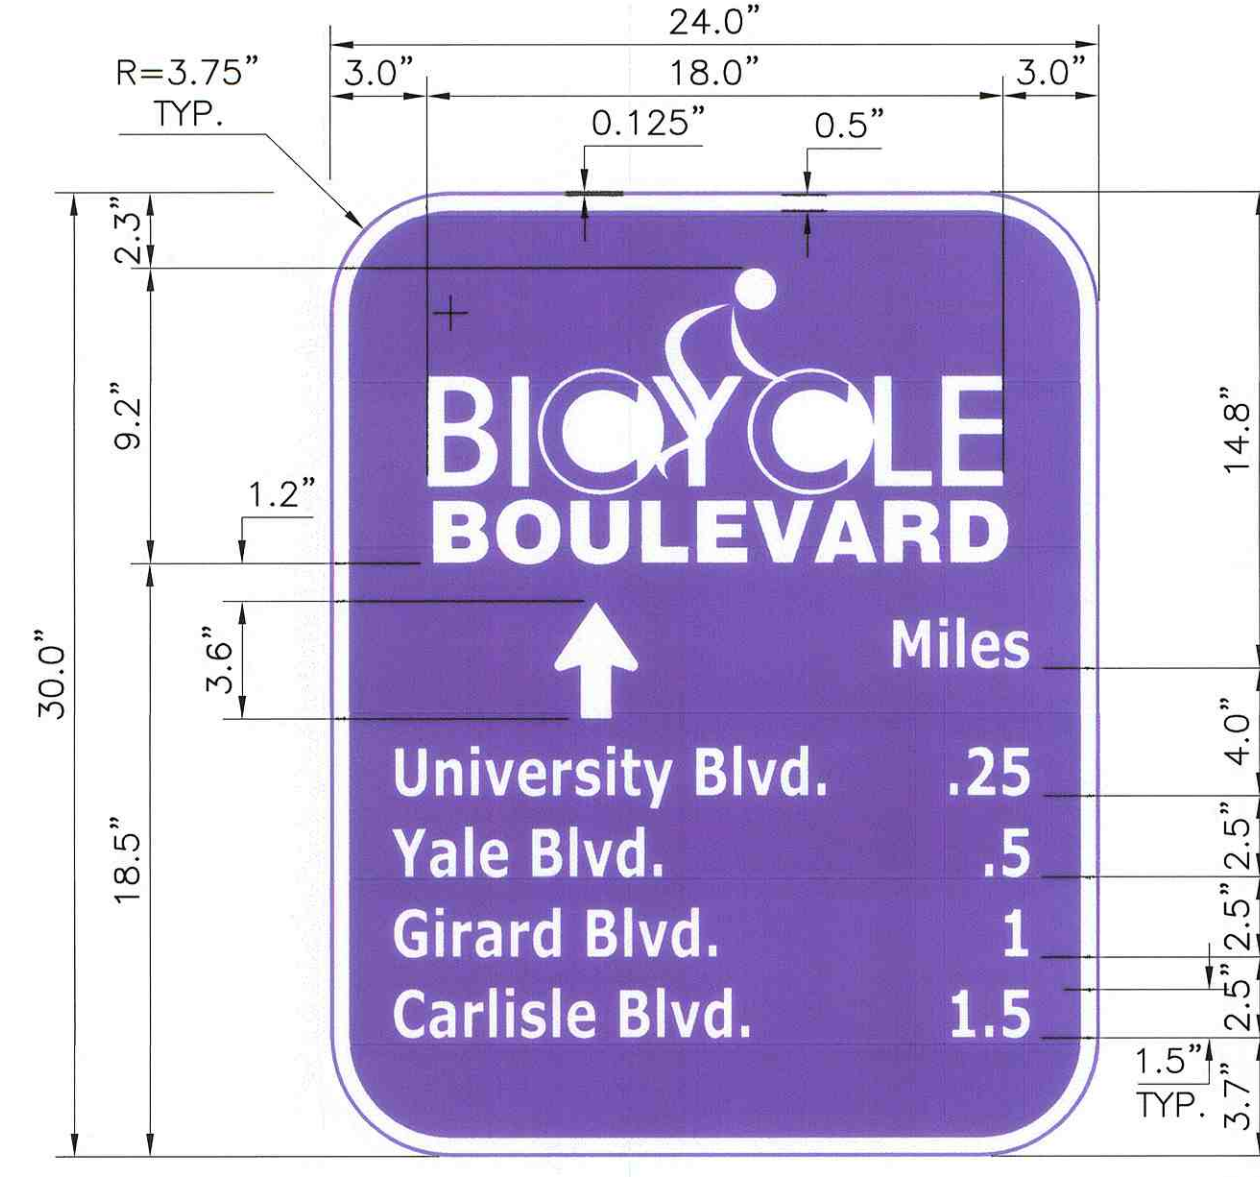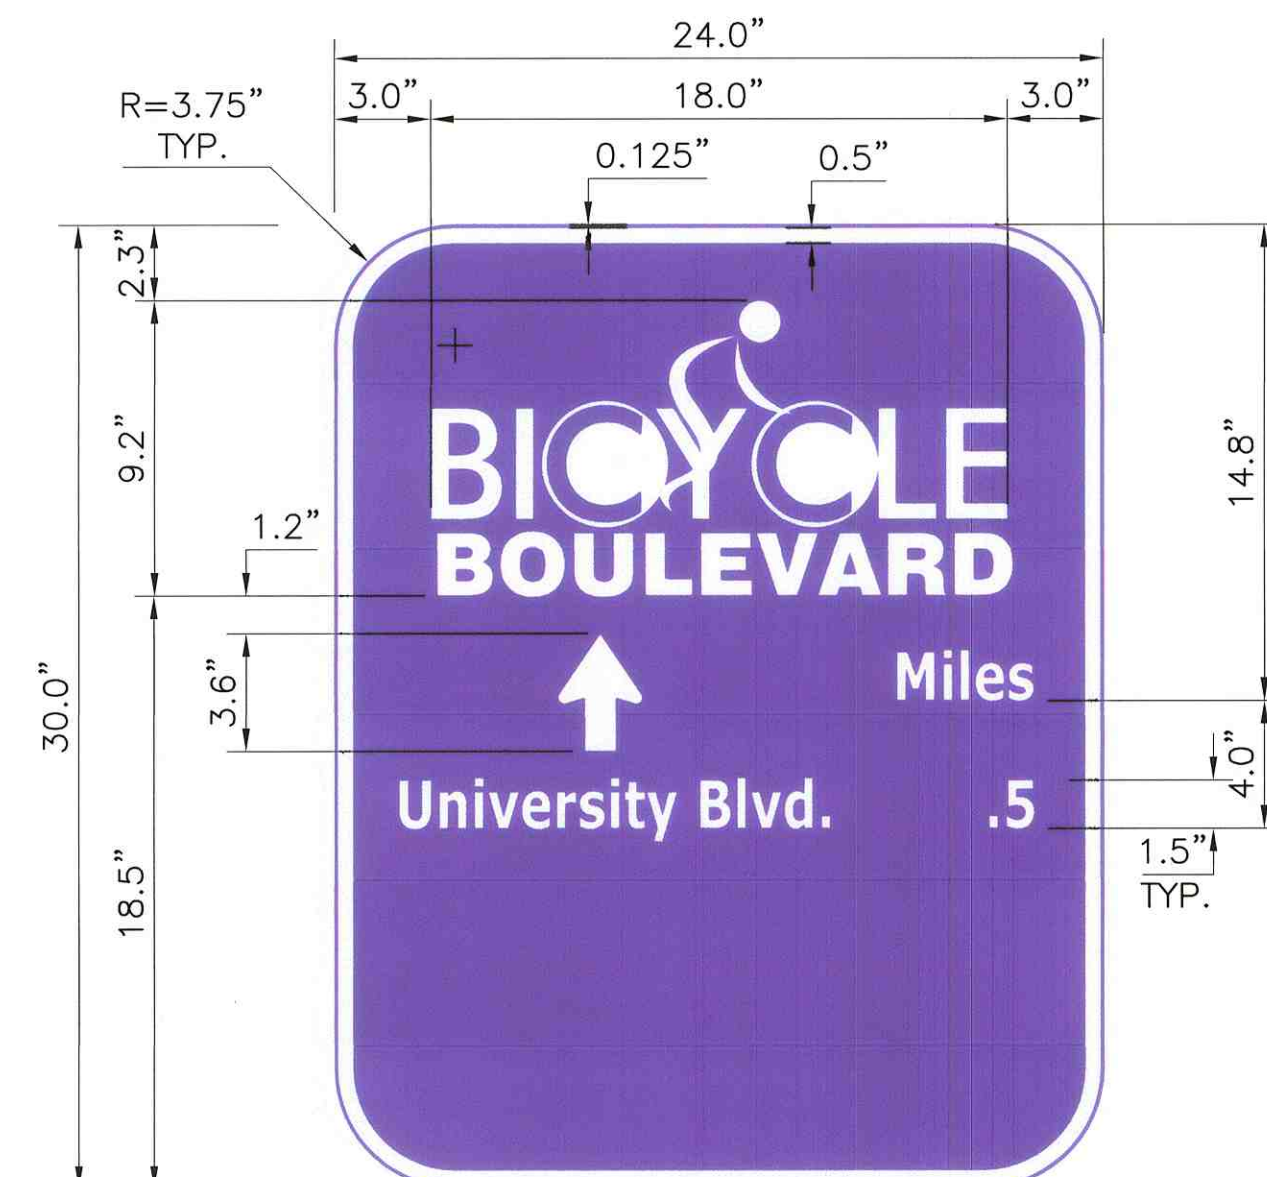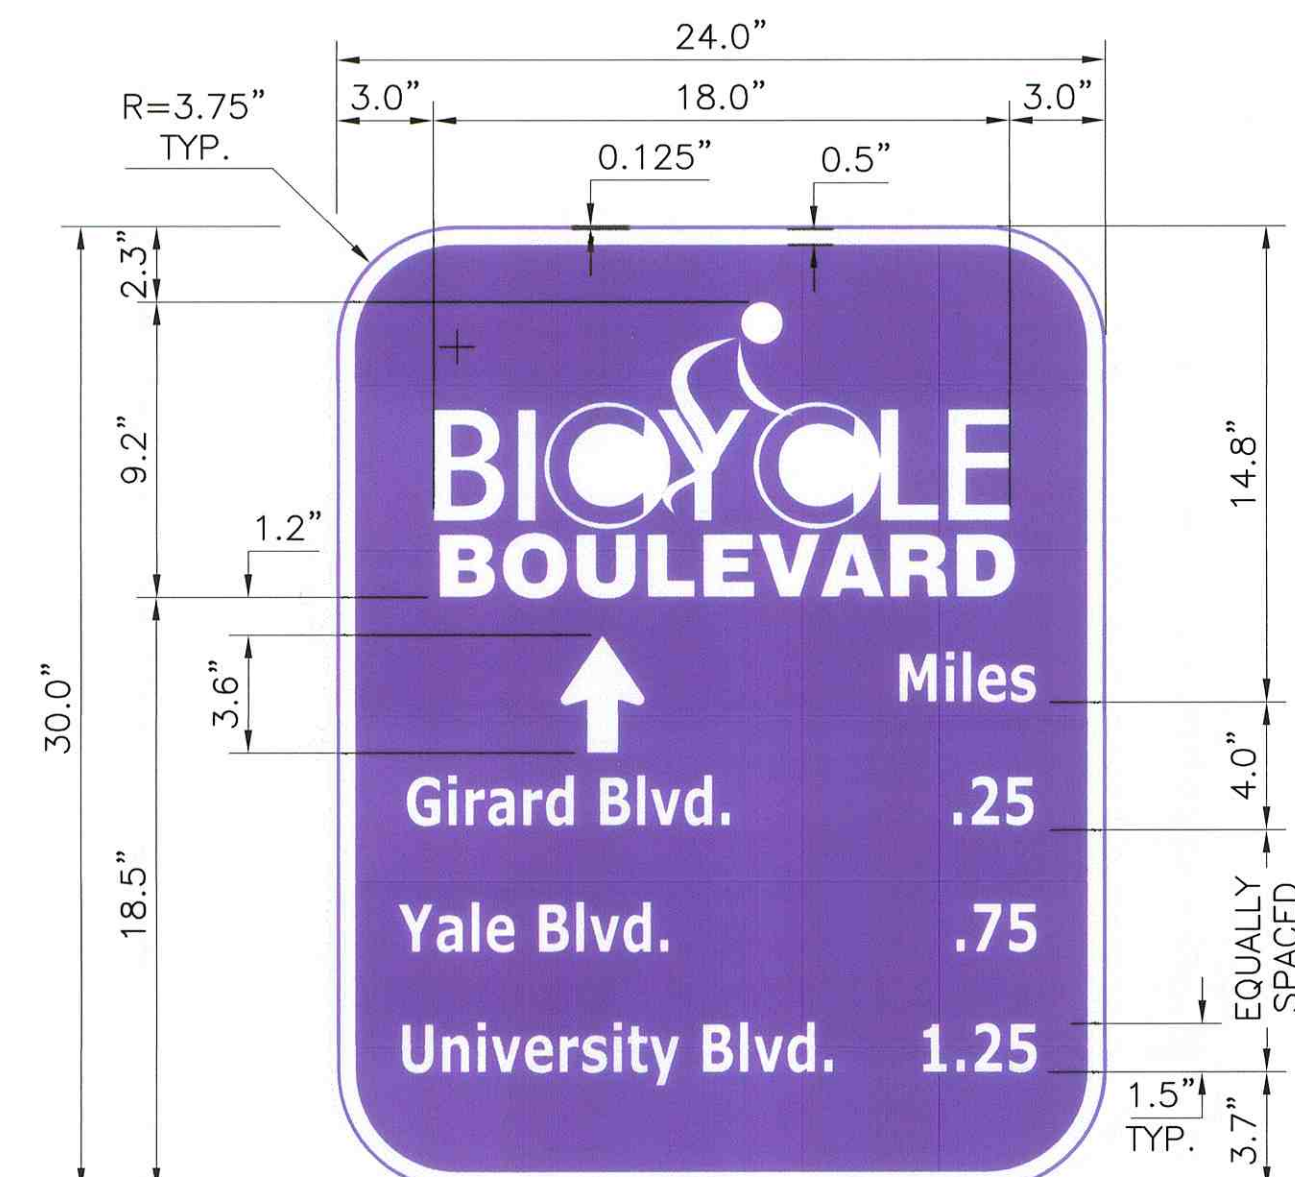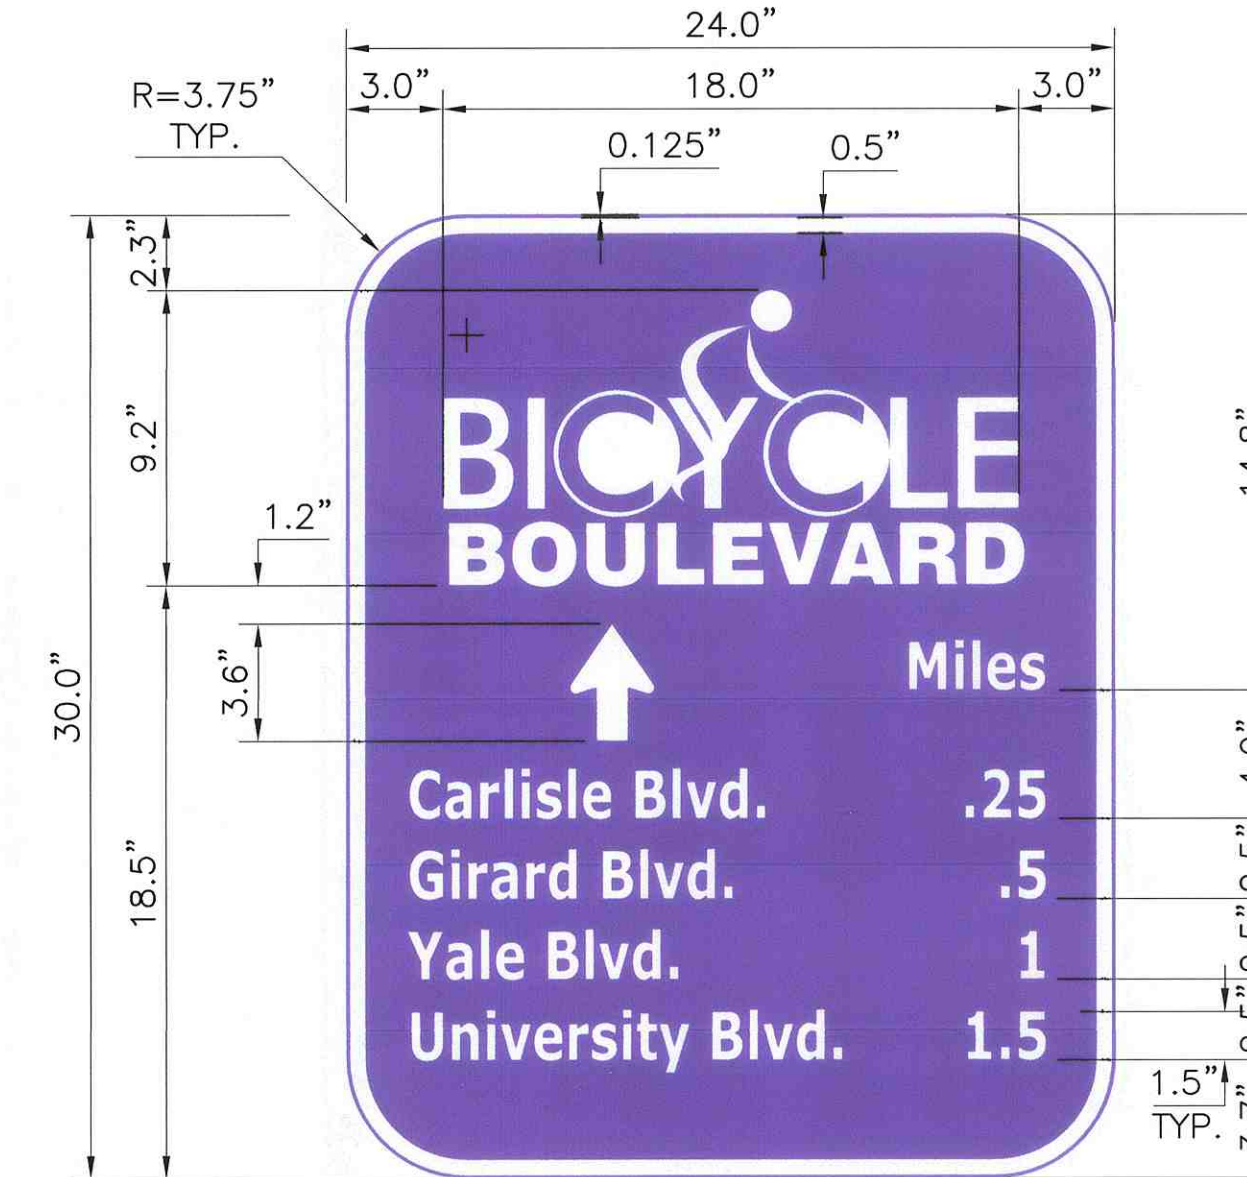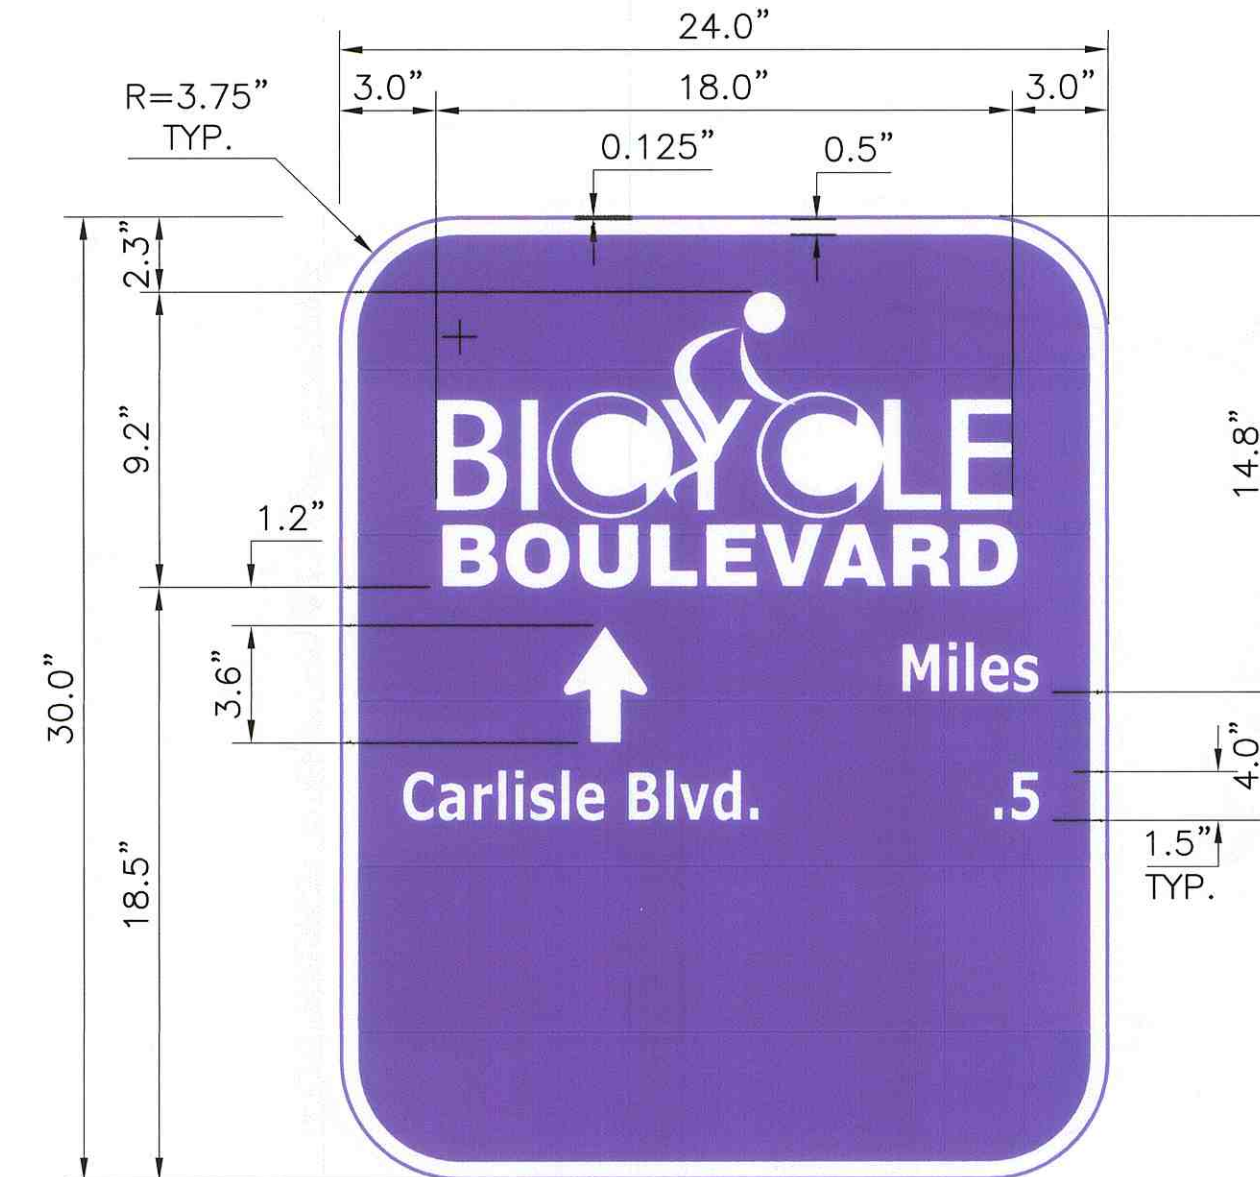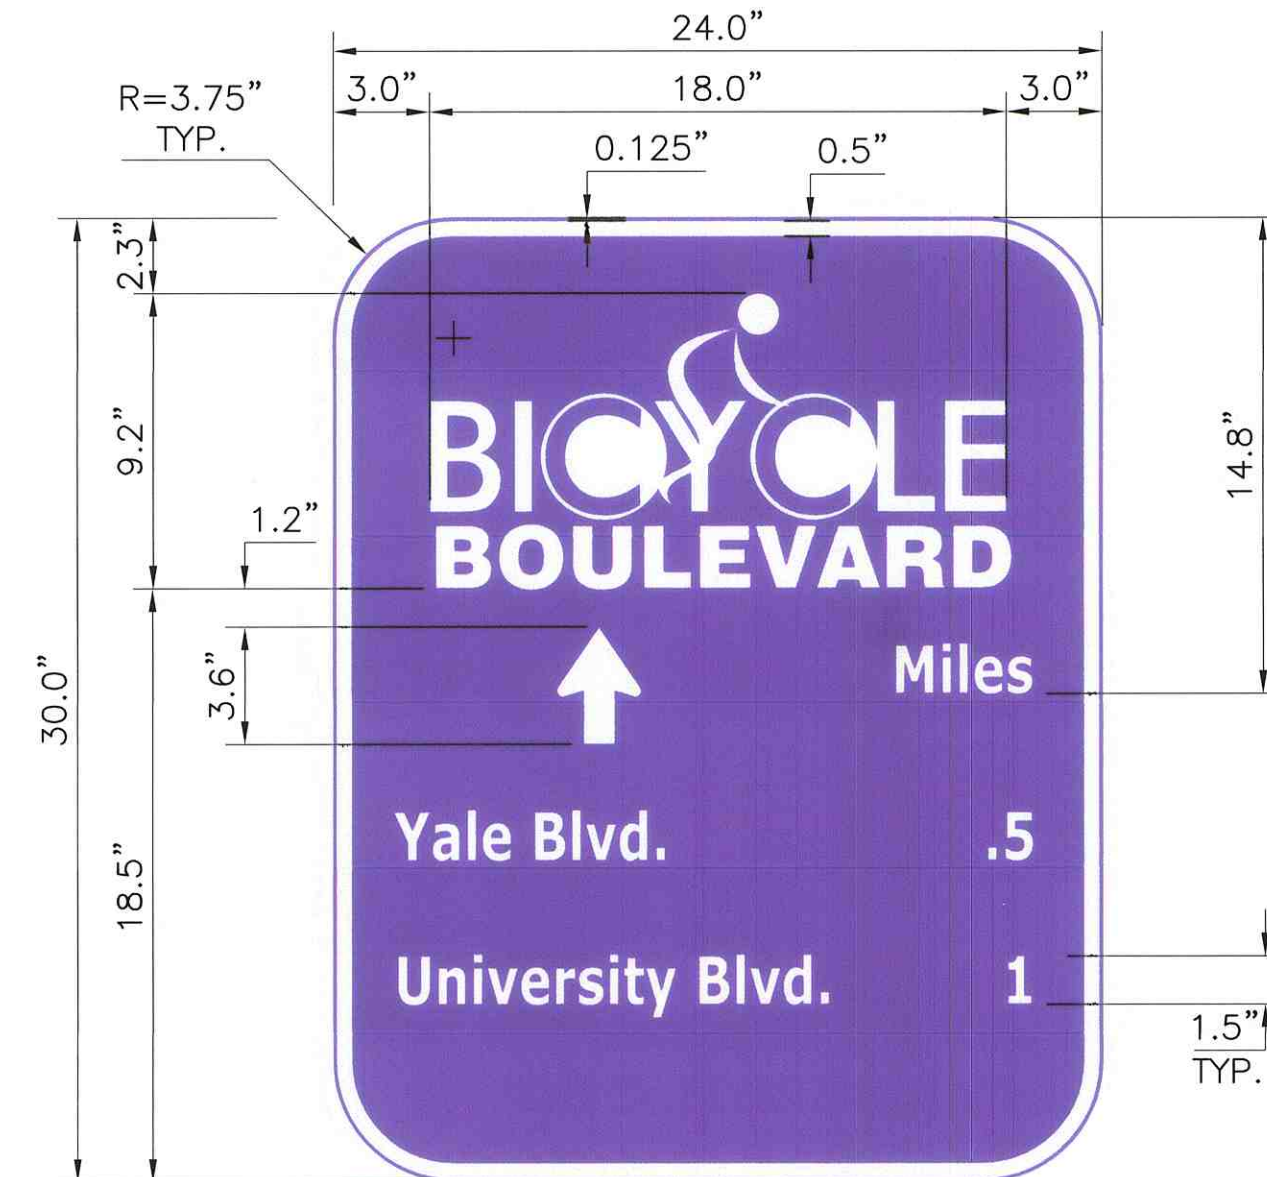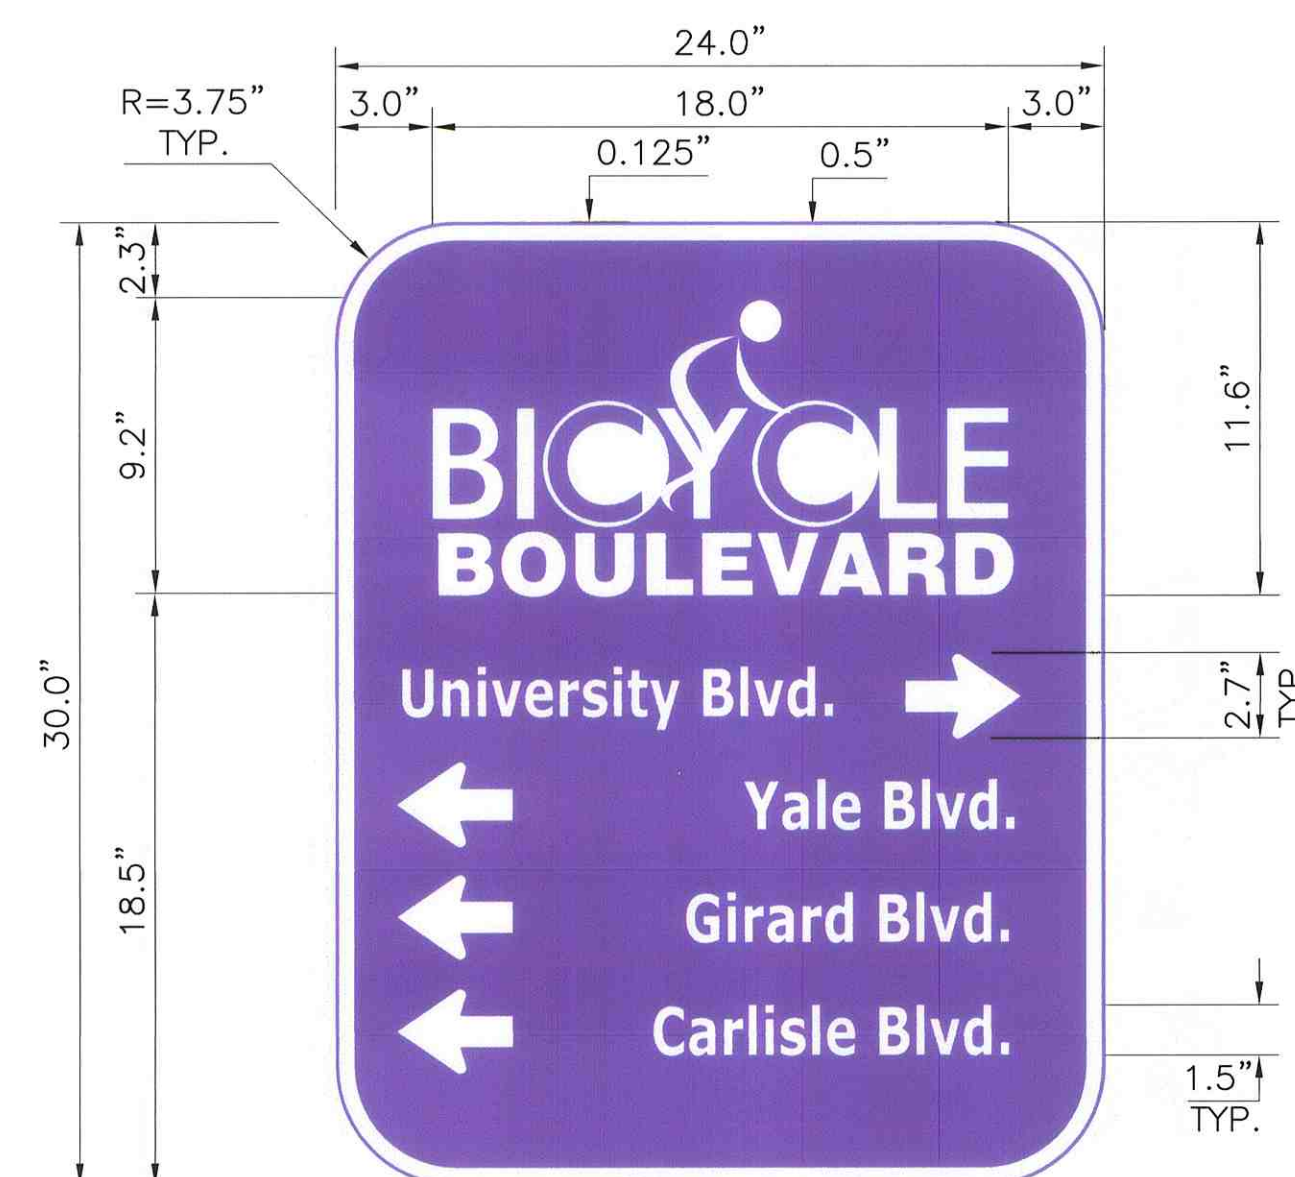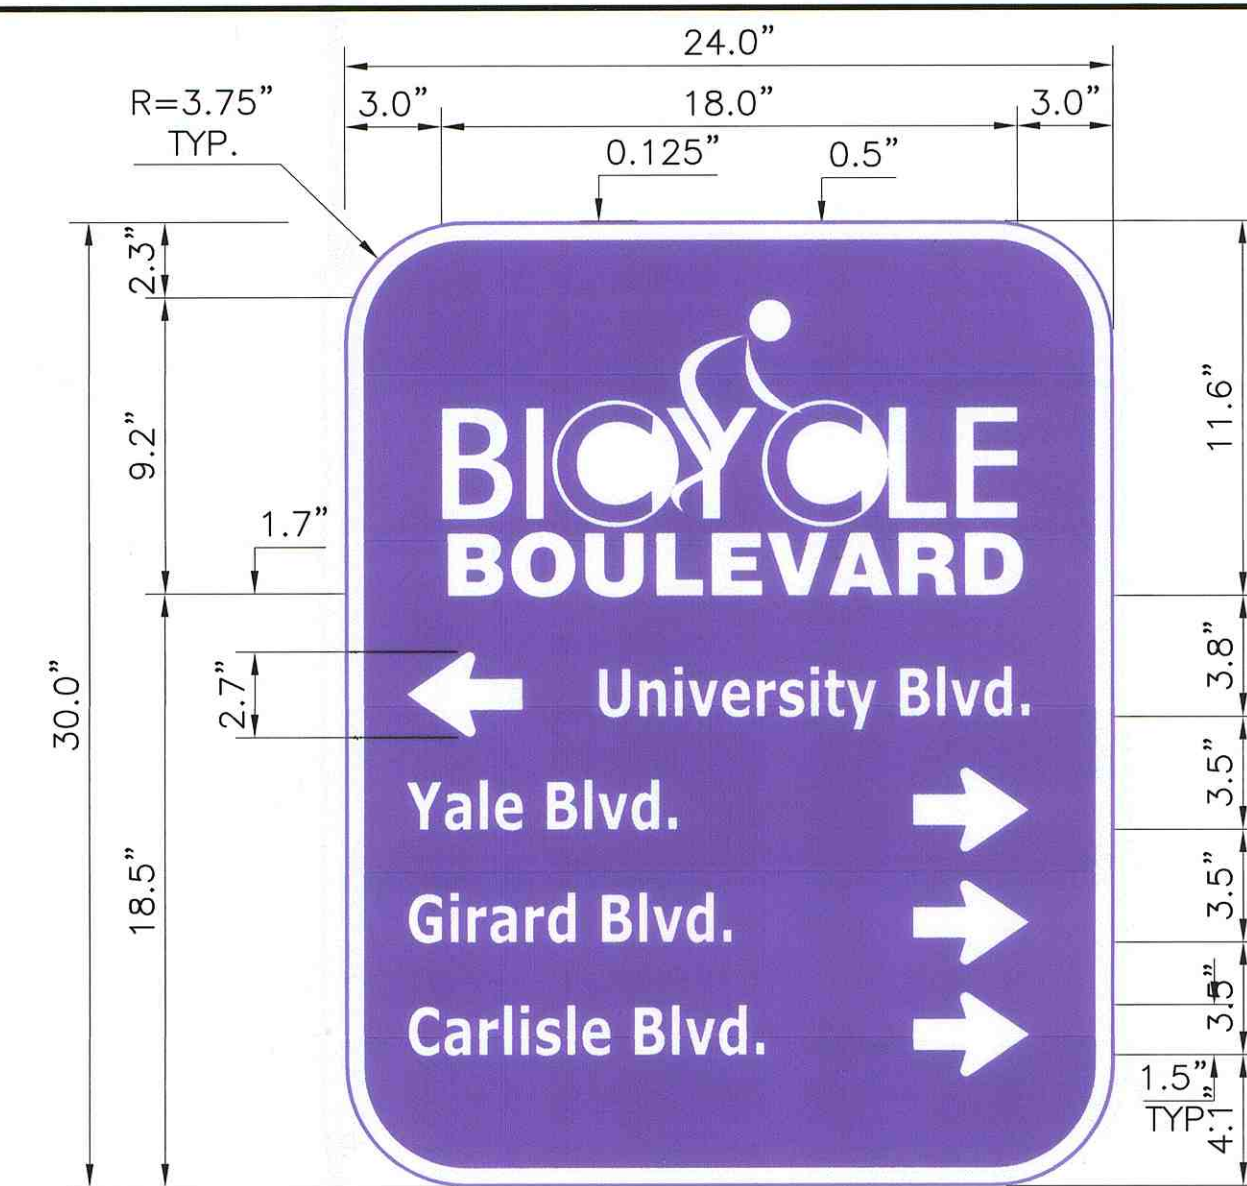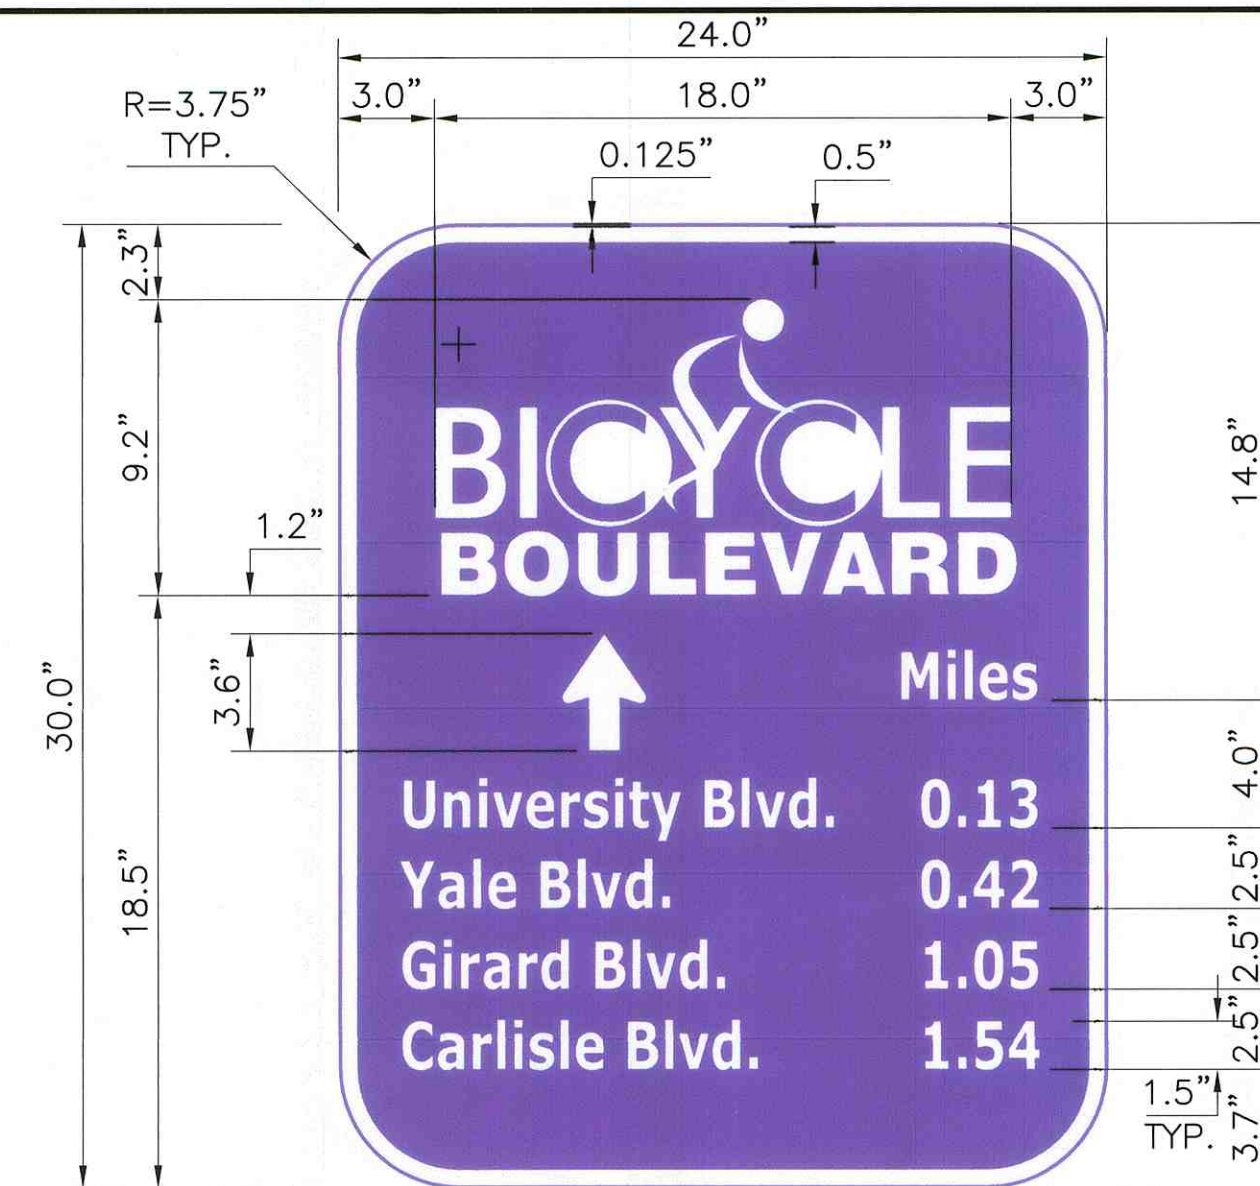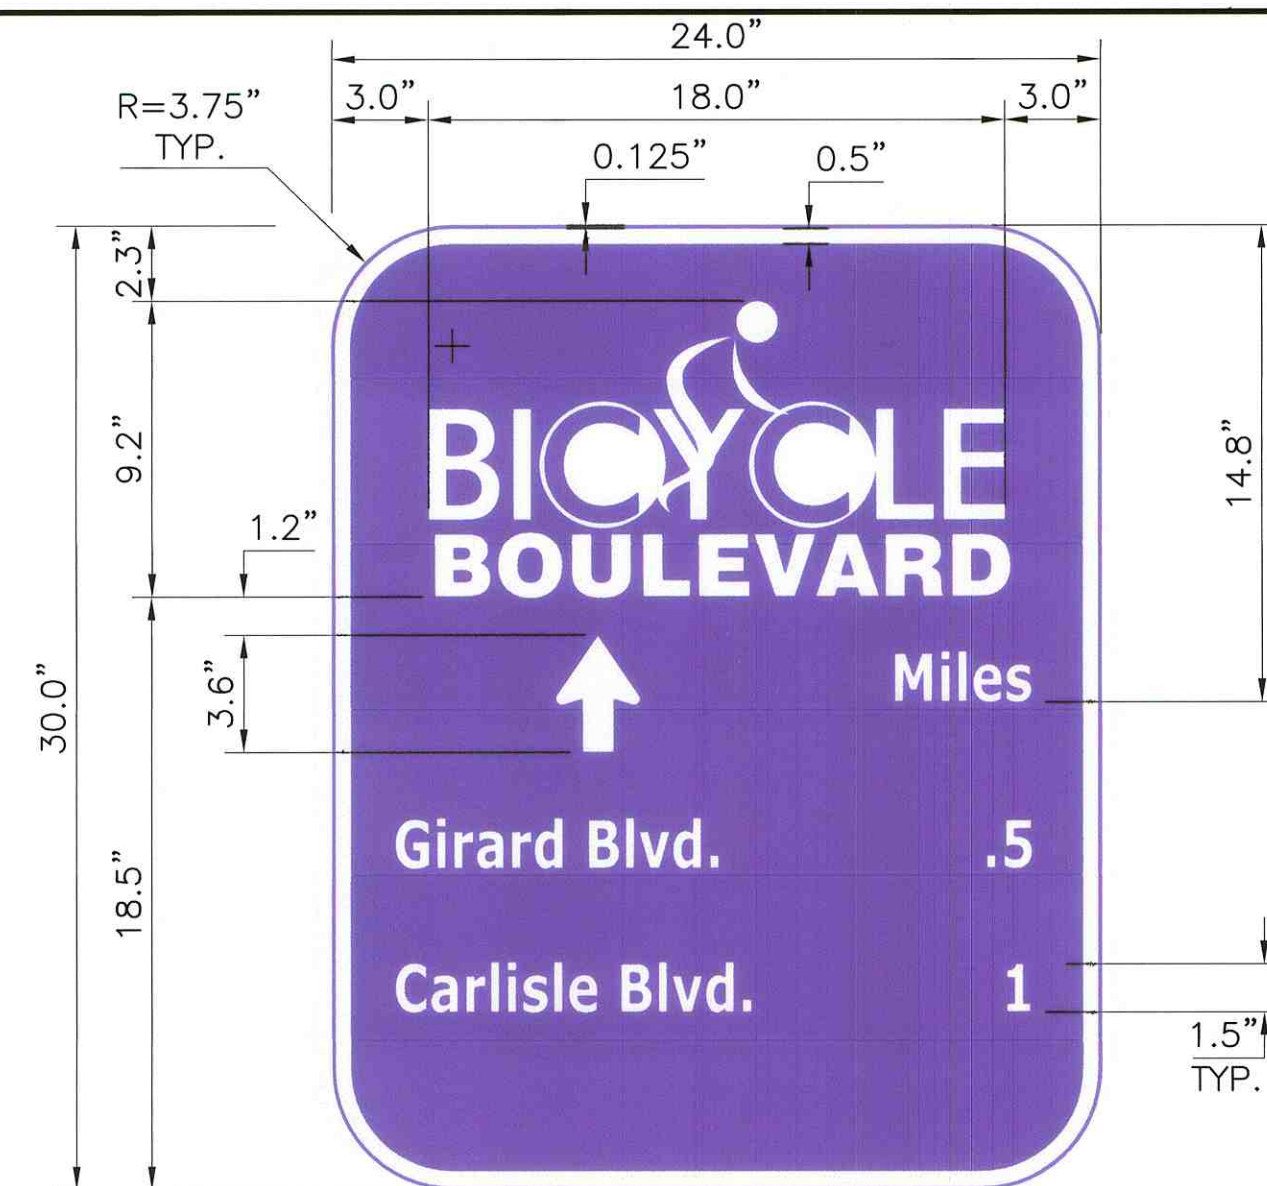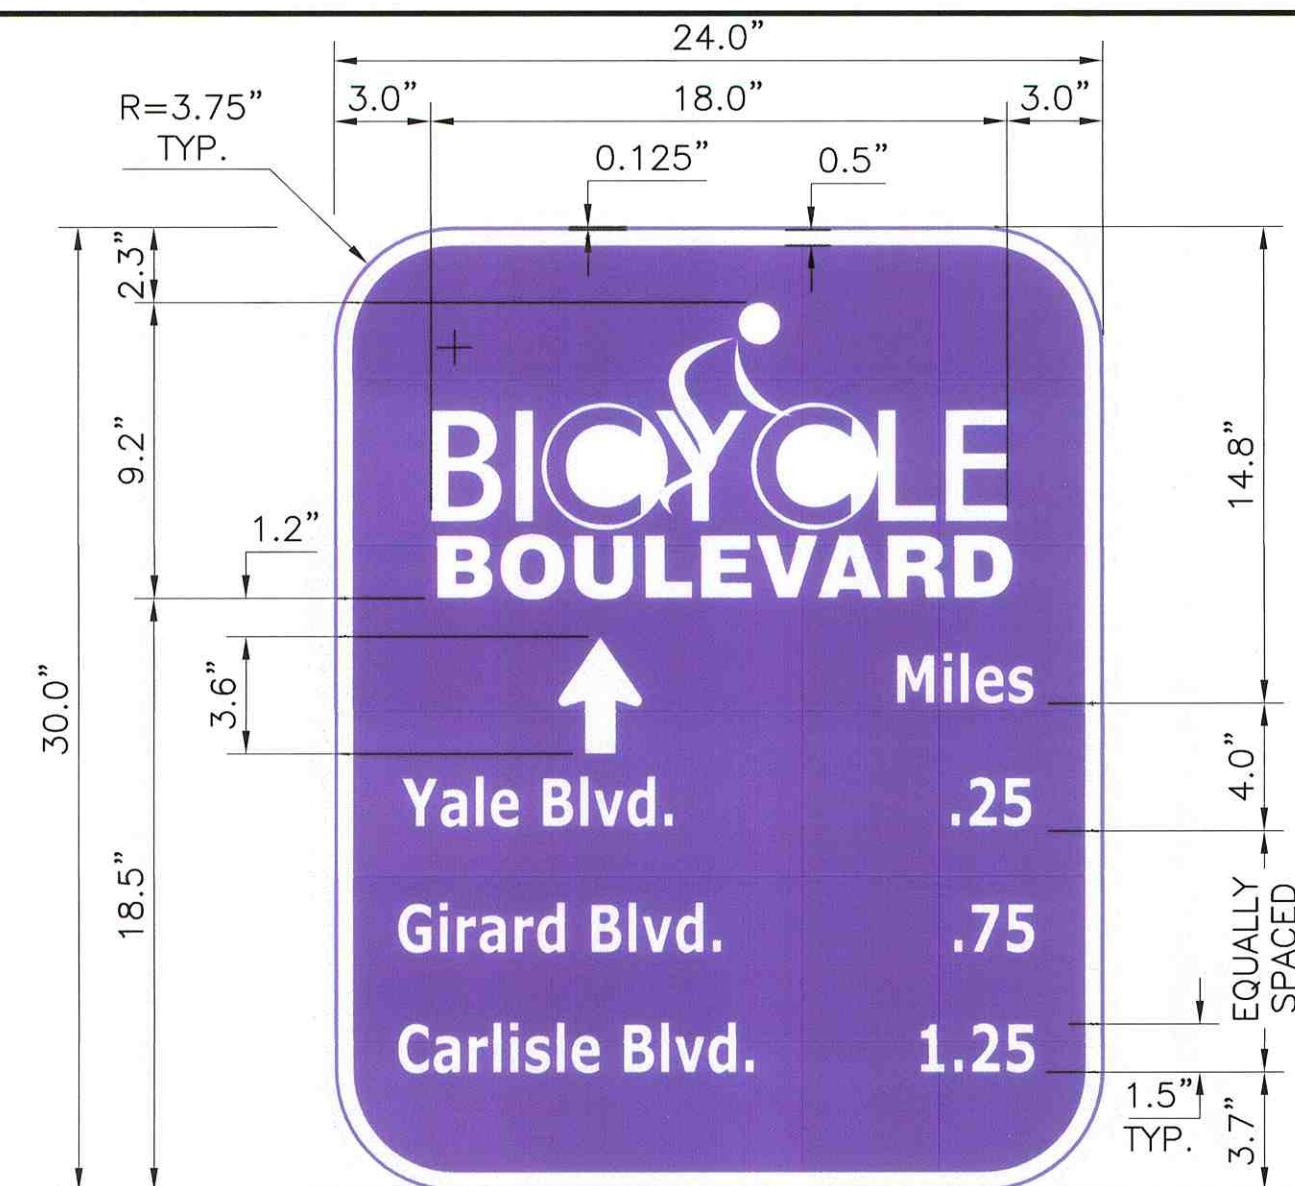

SIGN DETAILS NOT TO SCALE



CITY OF ALBUQUERQUE
DEPARTMENT OF MUNICIPAL DEVELOPMENT

TITLE: BICYCLE BOULEVARD - MOUNTAIN ROAD, 14TH STREET, SILVER BLVD
AS-CONSTRUCTED WAYFINDING AND DIRECTIONAL SIGNS

CG the Do not	Design Review Committee	City Engineer Approval	Last Design Update	Mo./Day/Yr.	Mo./Day/Yr.
	City Project No.	7986-91	Zone Map No. J=12,13,14 K=13,14,15	Sheet 22b OF 22	