

ABBREVIATIONS

A	=	AIR LINE
AD	=	AREA DRAIN
AIP	=	ABANDONED IN PLACE
BLDG	=	BUILDING
BM	=	BENCHMARK
CATV	=	CABLE TELEVISION LINE
CIP	=	CAST IRON PIPE
CMP	=	CORRUGATED METAL PIPE
CMPA	=	CORRUGATED METAL PIPE ARCH
CO	=	CLEANOUT
COA	=	CITY OF ALBUQUERQUE
CONC	=	CONCRETE
CL	=	CENTERLINE
DIA	=	DIAMETER
DIP	=	DUCTILE IRON PIPE
DTL	=	DETAIL
DWG	=	DRAWING
EG	=	EXISTING GRADE
ELEC.	=	ELECTRIC
EL	=	ELEVATION
EX	=	EXISTING
FF	=	FINISHED FLOOR ELEVATION
FG	=	FINISHED GRADE
FH	=	FIRE HYDRANT
FL	=	FLOW LINE
G	=	GAS PIPE
GM	=	GAS METER
GV	=	GATE VALVE
HP	=	HIGH POINT
INV	=	INVERT ELEVATION
LF	=	LINEAL FEET
LP	=	LIGHT POLE
L/S	=	LANDSCAPING
MH	=	MANHOLE
NG	=	NATURAL GROUND
OE	=	OVERHEAD ELECTRIC LINE
OT	=	OVERHEAD TELEPHONE LINE
PB	=	ELECTRICAL PULL BOX
PCC	=	PORTLAND CEMENT CONCRETE
PP	=	POWER POLE
PROP	=	PROPOSED
PVC	=	POLYVINYL CHLORIDE PIPE
RCP	=	REINFORCED CONCRETE PIPE
ROW	=	RIGHT-OF-WAY
S	=	SLOPE
SAS	=	SANITARY SEWER
SD	=	STORM DRAIN
STA	=	STATION
STD	=	STANDARD
SW	=	SIDEWALK
T	=	TELEPHONE
TA	=	TOP OF ASPHALT PAVEMENT
TAC	=	TOP OF ASPHALT CURB
TC	=	TOP OF CONCRETE SLAB (PAVEMENT)
TCC	=	TOP OF CONCRETE CURB
TS	=	TOP OF SIDEWALK
TW	=	TOP OF WALL
TYP	=	TYPICAL
UE	=	UNDERGROUND ELECTRIC
UT	=	UNDERGROUND TELEPHONE
W	=	WATER
WM	=	WATER METER
WV	=	WATER VALVE

SURVEYOR'S CERTIFICATION

I, BRIAN J. MARTINEZ, A DULY QUALIFIED, REGISTERED, PROFESSIONAL LAND SURVEYOR UNDER THE LAWS OF THE STATE OF NEW MEXICO, DO HEREBY CERTIFY THAT THE 'AS-BUILT' INFORMATION SHOWN ON THESE DRAWINGS WAS OBTAINED FROM FIELD CONSTRUCTION AND 'AS-BUILT' INFORMATION SHOWN ON THESE DRAWINGS WAS ADDED BY ME OR UNDER MY SUPERVISION, AND THAT THIS 'AS-BUILT' INFORMATION IS TRUE AND CORRECT TO THE BEST OF MY KNOWLEDGE AND BELIEF. CARTESIAN SURVEYS, INC. IN NOT RESPONSIBLE FOR ANY OF THE DESIGN CONCEPTS, CALCULATIONS, ENGINEERING, OR INTENT OF THE RECORD DRAWINGS.

B. J. Martinez 3/9/21



APPROVED RECORD DRAWINGS	
City Inspector	Arlene Sandoval
Contractor	Sundance Mechanical
Construction Engineer	Jim Roeder
Date	4/29/2021

CITY OF ALBUQUERQUE, NEW MEXICO

HORIZON VILLAGE SUBDIVISION

PAVING, SANITARY SEWER AND WATERLINE IMPROVEMENTS

INDEX TO DRAWINGS

SHEET No.	DESCRIPTION	SHEET No.	DESCRIPTION
1	COVER SHEET AND INDEX TO DRAWINGS	11	GENERAL UTILITY NOTES, SHUTOFF PLAN AND SHEET MAP
2-3	PRELIMINARY PLAT	12	HORIZON WAY STA. 11+20 - 16+00 UTILITY PLAN
4-5	GRADING AND DRAINAGE PLAN	13	HORIZON WAY UTILITY PLAN
5	OVERALL PAVING PLAN	14	ALOFT PLACE / AWAY PLACE UTILITY PLAN
6	HORIZON WAY PAVING PLAN AND PROFILE	15	HORIZON WAY STA. 16+00 - 18+00 UTILITY PLAN
7	HORIZON WAY / AEROSTAT PLACE PAVING PLAN AND PROFILE		
8	ALOFT PLACE / AWAY PLACE PAVING PLAN AND PROFILE		
9-10	PAVING DETAILS		

LEGEND

	NEW CURB AND GUTTER & SIDEWALK		EX SAS MANHOLE		PROPOSED SANITARY SEWER LINE
	EX CURB AND GUTTER & SIDEWALK		PROP SAS MANHOLE		EX SANITARY SEWER LINE
	PROP FIRE HYDRANT		PROP WATER METER		PROPOSED WATER LINE
	PROP WATER VALVE		PROPOSED SANITARY SEWER SERVICE		EX WATER LINE
	PROPERTY LINE		RECORD BEARING AND DISTANCES		MEASURED BEARING AND DISTANCES

UTILITY COMPANY CONTACTS

ALBUQUERQUE BERNALILLO COUNTY
WATER UTILITY AUTHORITY
DAVID GUTIERREZ, PE
Piazo Del Sol
PO Box 568
Albuquerque NM, 87103
(505) 289-3307

PNM
Dan Aragon, Lead Land
Permitting Specialist
PNM, Land Services
2401 Aztec Rd NE, Albuquerque,
NM 87107
505-241-4437


NEW MEXICO GAS CO.
Antoinette Dominguez
P.O. Box 97500
Albuquerque, New Mexico 87199
(505) 241-7759 / 401-7542

QWEST COMMUNICATIONS
Don Davalos
400 Tijeras Ave. NW, Suite 520
Albuquerque, New Mexico 87102
(505) 245-8967

AT&T
N.N.
111 Third ST., NW
Albuquerque, New Mexico 87103
(505) 842-2806

COMCAST CABLE
Robert Martinez
4611 Montbel Pl. NE
Albuquerque, NM 87107
(505) 761-6221
Robert.Martinez@cable.comcast.com

RECORD DRAWINGS

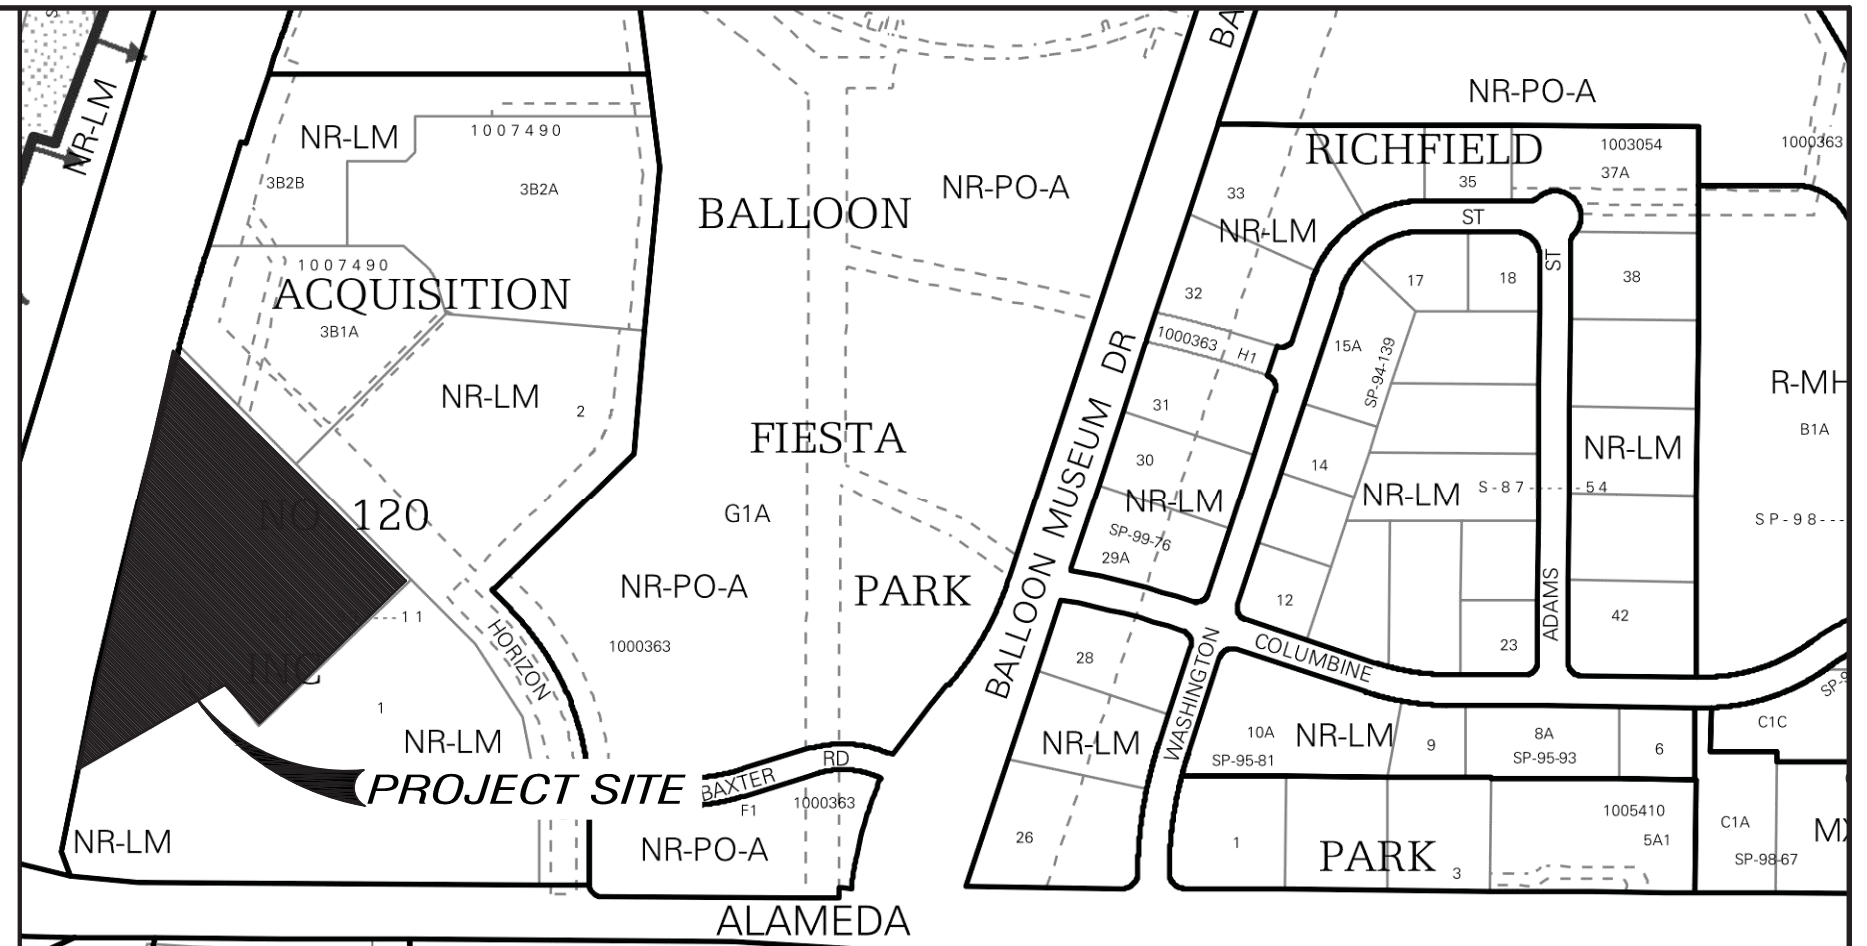

VICINITY MAP ZONE ATLAS: C-17
SCALE: NONE

GENERAL NOTES

NOTICE TO CONTRACTORS

- ALL WORK DETAILED ON THESE PLANS, EXCEPT AS OTHERWISE STATED OR PROVIDED HEREON, SHALL BE CONSTRUCTED IN ACCORDANCE WITH CITY OF ALBUQUERQUE STANDARD SPECIFICATIONS FOR PUBLIC WORKS CONSTRUCTION, 1986 EDITION THROUGH UPDATE #9, AND WILL BE REFERRED TO HEREIN AS "STANDARD SPECIFICATIONS".
- ALL CONSTRUCTION WITHIN CITY RIGHT-OF-WAY OR EASEMENTS MUST BE DONE FROM APPROVED WORK ORDER DOCUMENTS ISSUED BY THE CITY.
- ALL WORK ON THIS PROJECT SHALL BE PERFORMED IN ACCORDANCE WITH APPLICABLE FEDERAL, STATE, AND LOCAL LAWS, ORDINANCES, RULES, AND REGULATIONS CONCERNING CONSTRUCTION SAFETY AND HEALTH.
- CONTRACTOR SHALL ASSUME THE SOLE AND COMPLETE RESPONSIBILITY FOR THE JOB SITE CONDITIONS DURING THE COURSE OF CONSTRUCTION OF THIS PROJECT, INCLUDING SAFETY OF ALL PERSONS AND PROPERTY. THIS REQUIREMENT SHALL APPLY CONTINUOUSLY AND NOT BE LIMITED TO NORMAL WORKING HOURS. CONTRACTOR SHALL DEFEND, INDEMNIFY, AND HOLD HARMLESS THE OWNER AND ENGINEER FROM ANY AND ALL LIABILITY REAL OR ALLEGED, IN CONNECTION WITH THE PERFORMANCE OF WORK ON THIS PROJECT, EXCEPT LIABILITY ARISING FROM THE SOLE NEGLIGENCE OF THE OWNER OR ENGINEER.
- ALL EXCAVATION, TRENCHING, AND SHORING ACTIVITIES MUST BE ACCOMPLISHED IN ACCORDANCE WITH OSHA 29CFR 1926.650 SUBPART P.
- AN EXCAVATION/CONSTRUCTION PERMIT WILL BE REQUIRED BEFORE BEGINNING ANY WORK WITHIN CITY RIGHT-OF-WAY.
- CONTRACTOR SHALL NOTIFY THE CONSTRUCTION ENGINEER (OR PROJECT MANAGER) NOT LESS THAN SEVEN (7) DAYS PRIOR TO STARTING WORK IN ORDER THAT THE CITY SURVEYOR MAY TAKE NECESSARY MEASURES TO INSURE THE PRESERVATION OF SURVEY MONUMENTS. CONTRACTOR SHALL NOT DISTURB PERMANENT SURVEY MONUMENTS WITHOUT THE CONSENT OF THE CITY SURVEYOR AND SHALL NOTIFY THE CITY SURVEYOR AND BEAR THE EXPENSE OF REPLACING ANY THAT MAY BE DISTURBED WITHOUT PERMISSION. ONLY THE CITY SURVEYOR SHALL REPLACE SURVEY MONUMENTS. WHEN A CHANGE IS MADE IN THE FINISHED ELEVATIONS OF THE PAVEMENT OF ANY ROADWAY IN WHICH A PERMANENT SURVEY MONUMENT IS LOCATED, CONTRACTOR SHALL, AT HIS OWN EXPENSE, ADJUST THE MONUMENT COVER TO THE NEW GRADE UNLESS OTHERWISE SPECIFIED. REFER TO STANDARD SPECIFICATIONS SECTION 4.4
- TWO (2) WORKING DAYS PRIOR TO ANY EXCAVATION, CONTRACTOR MUST CONTACT NEW MEXICO ONE CALL SYSTEM (811) / (505-260-1990) FOR LOCATION OF EXISTING UTILITIES.
- CONTRACTOR SHALL ASSIST THE ENGINEER/INSPECTOR IN THE RECORDING OF DATA ON ALL UTILITY LINES AND ACCESSORIES AS REQUIRED BY THE CITY OF ALBUQUERQUE FOR THE PREPARATION OF AS-BUILT DRAWINGS. CONTRACTOR SHALL NOT COVER UTILITY LINES AND ACCESSORIES UNTIL ALL DATA HAS BEEN RECORDED.
- CONTRACTOR SHALL ASSUME FINANCIAL RESPONSIBILITY FOR ANY DAMAGE TO EXISTING PAVEMENT, PAVEMENT MARKINGS, SIGNAGE, CURB AND GUTTER, HANDICAP RAMPS, AND SIDEWALK DURING CONSTRUCTION APART FROM THOSE SECTIONS INDICATED FOR REMOVAL ON THE PLANS, AND SHALL REPAIR OR REPLACE, PER THE STANDARD SPECIFICATIONS, ANY SUCH DAMAGE.
- CONTRACTOR SHALL MAINTAIN A GRAFFITI-FREE WORK SITE. CONTRACTOR SHALL PROMPTLY REMOVE ANY AND ALL GRAFFITI FROM EQUIPMENT, WHETHER PERMANENT OR TEMPORARY.
- CONTRACTOR SHALL BE RESPONSIBLE TO PROVIDE AND MAINTAIN ALL CONSTRUCTION SIGNING UNTIL THE PROJECT HAS BEEN ACCEPTED BY THE CITY AND OTHER JURISDICTIONAL AUTHORITIES WHERE APPLICABLE.
- PRIOR TO CONSTRUCTION, THE CONTRACTOR SHALL EXCAVATE AND VERIFY THE HORIZONTAL AND VERTICAL LOCATIONS OF ALL OBSTRUCTIONS AND EXISTING PAVEMENT. SHOULD A CONFLICT EXIST, THE CONTRACTOR SHALL NOTIFY THE ENGINEER OR SURVEYOR SO THAT THE CONFLICT CAN BE RESOLVED WITH A MINIMUM OF DELAY.
- THE CONTRACTOR SHALL PROVIDE AND MAINTAIN ALL CONSTRUCTION SIGNAGE UNTIL THE PROJECT HAS BEEN ACCEPTED BY THE CITY.
- THE CONTRACTOR SHALL COORDINATE WITH THE WATER AUTHORITY SEVEN (7) DAYS IN ADVANCE OF PERFORMING WORK THAT WILL AFFECT THE PUBLIC WATER OR SANITARY SEWER INFRASTRUCTURE. WORK REQUIRING SHUTOFF OF FACILITIES DESIGNATED AS MASTER PLAN FACILITIES MUST BE COORDINATED WITH THE WATER AUTHORITY 14 DAYS IN ADVANCE OF PERFORMING SUCH WORK. ONLY WATER AUTHORITY CREWS ARE AUTHORIZED TO OPERATE PUBLIC VALVES. SHUTOFF REQUESTS MUST BE MADE ONLINE AT http://abowua.org/WATER_SHUT_OFF_AND_TURN_ON_PROCEEDURES.ASPX
- CONTRACTOR SHALL SECURE A 'TOPSOIL DISTURBANCE PERMIT' PRIOR TO BEGINNING CONSTRUCTION.
- THE CONTRACTOR SHALL BE RESPONSIBLE FOR REPAIR, OR REMOVAL AND REPLACEMENT, OF ANY PAVEMENT, PAVEMENT MARKINGS, CURB AND GUTTER, DRIVEPADS, SIDEWALK, WHEELCHAIR RAMP, SIGNAGE OR ANY OTHER EXISTING IMPROVEMENTS DAMAGED BY THE CONTRACTOR'S OPERATIONS.

THE FOLLOWING NOTES ALSO APPLY WHEN CHECKED

- ☒ ALL UTILITIES AND UTILITY SERVICE LINES SHALL BE INSTALLED PRIOR TO PAVING.
- ☒ BACKFILL COMPACTION SHALL BE ACCORDING TO SPECIFIED STREET USE.
- ☐ TACK COAT REQUIREMENTS SHALL BE DETERMINED BY THE ENGINEER.
- ☒ SIDEWALK AND WHEELCHAIR RAMPS WITHIN THE CURB RETURNS SHALL BE CONSTRUCTED WHEREVER A NEW CURB RETURN IS CONSTRUCTED.
- ☐ IF CURB IS DEPRESSED FOR A DRIVEPAD, THE DRIVEPAD SHALL BE CONSTRUCTED PRIOR TO ACCEPTANCE OF CURB AND GUTTER.
- ☐ ALL STORM DRAINAGE FACILITIES SHALL BE COMPLETED PRIOR TO FINAL ACCEPTANCE.



D.R.B. No. 001842

REV.	SHEETS	CITY ENGINEER	DATE	USER DEPARTMENT	DATE	USER DEPARTMENT	DATE
ENGINEERS STAMP & SIGNATURE		APPROVALS	ENGINEER	DATE	*****		
		DRC CHAIRMAN		7/21/2020	APPROVED FOR CONSTRUCTION		
		TRANSPORTATION		7/20/2020			
		WATER/WASTEWATER		7/20/2020			
		HYDROLOGY		07/21/20			
		AMAFCA					
		CONSTR. MGMT.			CITY ENGINEER DATE		
		CONSTR. COORD.					
CITY PROJECT NO.					SHEET OF		
799782					1 15		

<i>CURVE</i>	<i>LENGTH</i>	<i>RADIUS</i>	<i>TANGENT</i>	<i>CHORD</i>	<i>CHORD BEARING</i>	<i>DELTA</i>
C21	27.80	19.85	16.73	25.58	N35° 58' 16"E	80°14'22"
C22	26.52	55.85	13.51	26.27	S89° 47' 06"E	27°12'00"
C23	31.39	20.00	19.98	28.27	N32° 20' 22"W	89°55'45"
C24	31.42	20.00	20.00	28.28	N57° 41' 45"E	90°00'00"
C25	31.42	20.00	20.00	28.28	N32° 18' 15"W	90°00'00"
C26	31.42	20.00	20.00	28.28	N57° 41' 45"E	90°00'00"
C27	31.42	20.00	20.00	28.28	N32° 18' 15"W	90°00'00"
C28	12.44	15.00	6.60	10.28	N36° 27' 35"E	47°31'39"
C29	11.11	14.98	5.83	10.86	N81° 26' 04"E	42°29'49"
C30	15.12	25.00	7.80	14.89	S4° 37' 58"E	34°39'27"
C31	30.24	50.00	15.60	29.79	S4° 37' 58"E	34°39'27"
C32	88.44	100.96	47.28	85.64	S20° 33' 18"W	50°11'26"
C33	18.46	11304.16	9.23	18.46	S15° 19' 42"W	0°05'37"
C34	18.46	61.39	9.30	18.39	S10° 54' 46"E	17°13'58"
C35	16.86	11304.16	8.43	16.86	S11° 58' 07"W	0°05'08"
C36	18.46	11304.16	9.23	18.46	S15° 19' 42"W	0°05'37"
C37	34.56	11304.16	17.28	34.56	S11° 50' 18"W	0°10'31"
C38	70.02	11304.16	35.01	70.02	S11° 34' 24"W	0°21'18"
C39	10.85	61.39	5.44	10.84	S24° 35' 40"E	10°07'51"

[illegible]

A. "Private Access Easement", "Parking Easement" and "Drainage Easement", Over HOA Tract 4-A-1, for the benefit of Lots One Thru Thirty. Granted by this Plat. Maintenance Responsibilities will be Provided Per "Reciprocal Easement" and "Operating Agreement"

Filed _____, 20____

B. Tract 4-A-1 (Horizon Way, Aerosta place, Aloft Place and Away Place) is Granted to the A.B.C.W.U.A. as a Public Sanitary Sewer and Waterline Easement by this Plat.

A Private Blanket Access Easement is hereby granted by this plat over Tract 4-A with the exception of those areas covered by future buildings and non-storm water drainage improvements within said tract for the benefit of A.M.A.F.C.A. and Tract 4-B. Maintenance of said easement to be the responsibility of the owner(s) of said Tract 4-A. For the Benefit of A.M.A.F.C.A. Said Easement to be vacated when future development occurs.

Filed 07-02-2019, Bk. 2019C, Pg. 66


25' Sanitary Sewer Easement
Filed November 25, 1992,
92-28, Page 3166, Docu-
ment No. 0211

TRACT 3B-1-1-A
LANDS OF
IHS ACQUISITION NO. 120 INC.
Filed 6-10-2011, Bk. 2011C, Pg. 59

Albuquerque Control Survey Monument "NDC-7-1A"
New Mexico State Plane Coordinates, Central
Zone (NAD 83) as published:
N = 1,524,419.502 US Survey feet
E = 1,534,929.428 US Survey feet
Ground to grid factor = 0.999674775
Delta Alpha = -00°12'12.47"
TIE = N10°00'50"E, 736.25

PROHIBITION ON PRIVATE RESTRICTIONS ON THE INSTALLATION OF SOLAR COLLECTORS

"No property within the area of this plat shall at any time be subject to a deed restriction, covenant, or binding agreement prohibiting solar collectors from being installed on buildings or erected on the lots or parcels within the area of proposed plat. The foregoing requirement shall be a condition to approval of this plat."

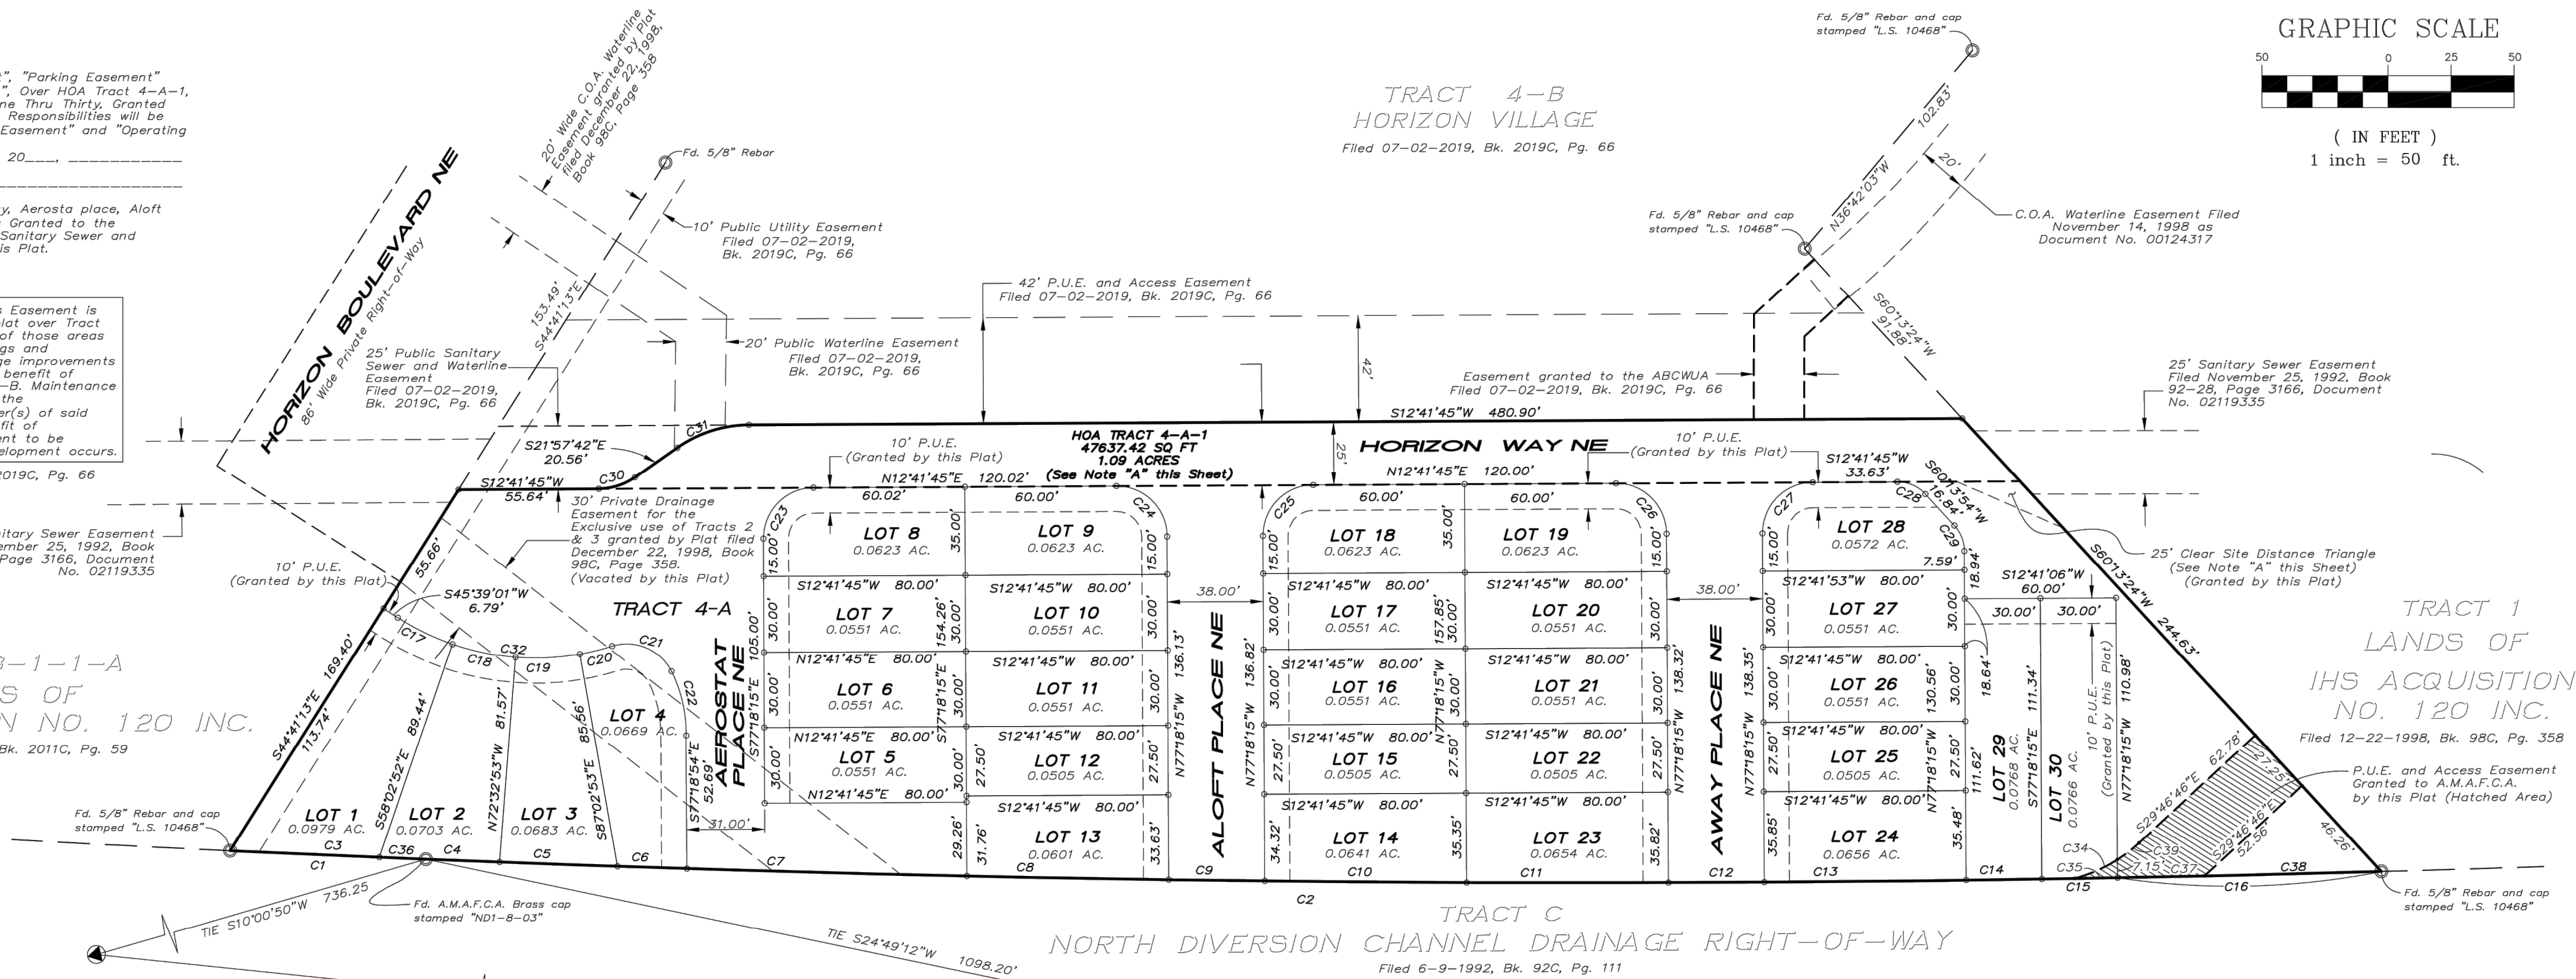

SHEET 3 OF 3

SURV* *TEK

Consulting Surveyors Phone: 505-897-3366
9384 Valley View Drive, N.W. Albuquerque, New Mexico 87114 Fax: 505-897-3377



THE HENSLEY ENGINEERING GROUP
(505) 410-1622

HORIZON VILLAGE SUBDIVISION

DESIGN REVIEW COMMITTEE	CITY ENGINEER APPROVAL	LAST DESIGN UPDATE	Mo./DAY/YR.	Mo./DAY/YR.
For Information Only				
CITY PROJECT No. 799782	ZONE MAP NO. C-17	SHEET 2 OF 15		

FOR INFORMATION ONLY

GRADING INFORMATION

LOCATION & DESCRIPTION

THE PROJECT SITE IS IN ITS NATURAL STATE WITH MEDIUM TO HEAVY NATIVE VEGETATION. THE SITE SLOPES FROM EAST TO WEST IN A SOUTHERLY DIRECTION. THE SITE IS BOUND BY HORIZON BOULEVARD ON THE NORTH AND EAST, ALAMEDA BOULEVARD ON THE SOUTH AND THE NORTH DIVERSION CHANNEL ON THE WEST.

SITE ACCESS IS PROVIDED THROUGH THE PRIVATE DRIVE OF HORIZON BLVD. THE GRADING PLAN WAS CREATED IN ACCORDANCE WITH THE APPROVED DRAINAGE REPORT "DRAINAGE PLAN FOR: HORIZON HEALTHCARE CORPORATION ALAMEDA BLVD. ALBUQUERQUE, NEW MEXICO". DATED JUNE 4, 1996, WHICH CONCURS WITH THE UNRESTRICTED DIRECT DISCHARGE INTO THE NORTH DIVERSION CHANNEL RIGHT OF WAY.

PHASE I IS THE SITE OF A RESIDENTIAL SUBDIVISION AND SHALL ACCOMMODATE 30 TOWNHOUSES IN 13 BUILDINGS.

PHASE II IS THE DEVELOPMENT OF TRACT 4B AND SHALL ACCOMMODATE OFFICE BUILDINGS TOTALING APPROXIMATELY 30,000 SQUARE FOOT AND PARKING LOT.

EXISTING CONDITION

THE ENTIRE SITE AND ALL BASINS SHOWN ON SP3.2, CURRENTLY DRAIN INTO THE NORTH DIVERSION CHANNEL THROUGH A CONCRETE CHANNEL LOCATED WEST OF THE SITE. BASIN B CURRENTLY DRAINS INTO BASIC C-3 THROUGH A 36" CULVERT PIPE.

DEVELOPED CONDITION

THE GRADING OF THE SITE WILL CLOSELY MATCH THE EXISTING ELEVATIONS OF THE SITE. DEVELOPMENT OF PHASE I INCLUDES THE ACCOMMODATION OF OFF SITE FLOWS FROM PHASE II. THE FLOWS WILL BE ACCEPTED AT THE POINTS SHOWN THROUGH CURB OPENINGS AND SURFACE FLOWS. THE FLOWS ARE THEN ROUTED VIA THE SURFACE STREETS TO THE PRESCRIBED POINTS OF DISCHARGE TO THE NORTH DIVERSION CHANNEL. AS SHOWN ON THE FINAL CONDITIONS DRAINAGE PLAN, PHASE I HAS ALLOWED FOR UNRESTRICTED THE DEVELOPED FLOWS FROM PHASE II.

REQUIRED WATER QUALITY VOLUME

OWNERS ASSOCIATION SHALL BE RESPONSIBLE FOR MAINTAINING WATER QUALITY FEATURES TO MAINTAIN RUNOFF RETENTION INDICATED. THE TOTAL VOLUME SHALL BE EQUAL TO:

IMPERVIOUS AREA * (0.44-0.10)/12 IN CUBIC FEET.
IMPERVIOUS AREA = 3.39 AC. * 85% = 125,518 SQ.FT

REQUIRED VOLUME = 125,518 * (0.44-0.10)/12 = 3,556 CU.FT.
VOLUME PROVIDED = 3,492 + 302 + 471 = 4,265 CU.FT.

GENERAL SHEET NOTES


1. THE CONCEPT DETAILED ON THESE PLANS SHALL, EXCEPT AS OTHERWISE STATED OR PROVIDED HEREIN, BE CONSTRUCTED IN ACCORDANCE WITH THE CITY OF ALBUQUERQUE STANDARD SPECIFICATIONS FOR PUBLIC WORKS CONSTRUCTION, 1986 EDITION, UPDATE NO 8.
2. THE EROSION PROTECTION SPECIFIED ON THIS PLAN IS THE MINIMUM RECOMMENDED. THE OWNER IS ENCOURAGED TO INCORPORATE EROSION RESISTANT LANDSCAPING ON AREAS WHERE EROSION MAY OCCUR SUCH AS SLOPES AND SWALES. THE OWNER IS RESPONSIBLE FOR THE INSTALLATION AND MAINTENANCE OF ALL EROSION CONTROL FEATURES NECESSARY TO PRESERVE THE DESIGN INTENT OF THE GRADING PLAN.
3. THE DRAINAGE INFRASTRUCTURE SHOWN ON THIS PLAN IS THE RESPONSIBILITY OF THE PROPERTY OWNER.

SHEET KEYED NOTES


1	4" DISCHARGE CULVERT - OPEN TOP BOX SHAPE
2	ROLL-TYPE CURB & GUTTER, PER COA STD. DTL. 2415A
3	STANDARD CURB & GUTTER, PER COA STD. DTL. 2415A
4	ESTATE CURB RUNDOWN, PER COA STD. DTL. 2415A
5	6" SPILL TYPE CURB
6	CONCRETE SWALE TO AMAFCA CHANNEL
7	3' CURB OPENING
8	24' TRACT 4B ENTRANCE
9	EXISTING CURB, INLET AND PIPE TO BE REMOVED

LEGEND

- GRADE BREAK
- 5000 EXISTING CONTOUR
- 5000 EXISTING CONTOUR
- EASEMENT
- RETAINING WALL
- RIP RAP
- EL=11.28 PROPOSED ELEVATION
- 66.33 EXISTING ELEVATION
- 12.11 TOP OF CURB
- 11.61 BOTTOM OF CURB
- TW 11.28 PROPOSED GROUND ELEVATION AT WALL

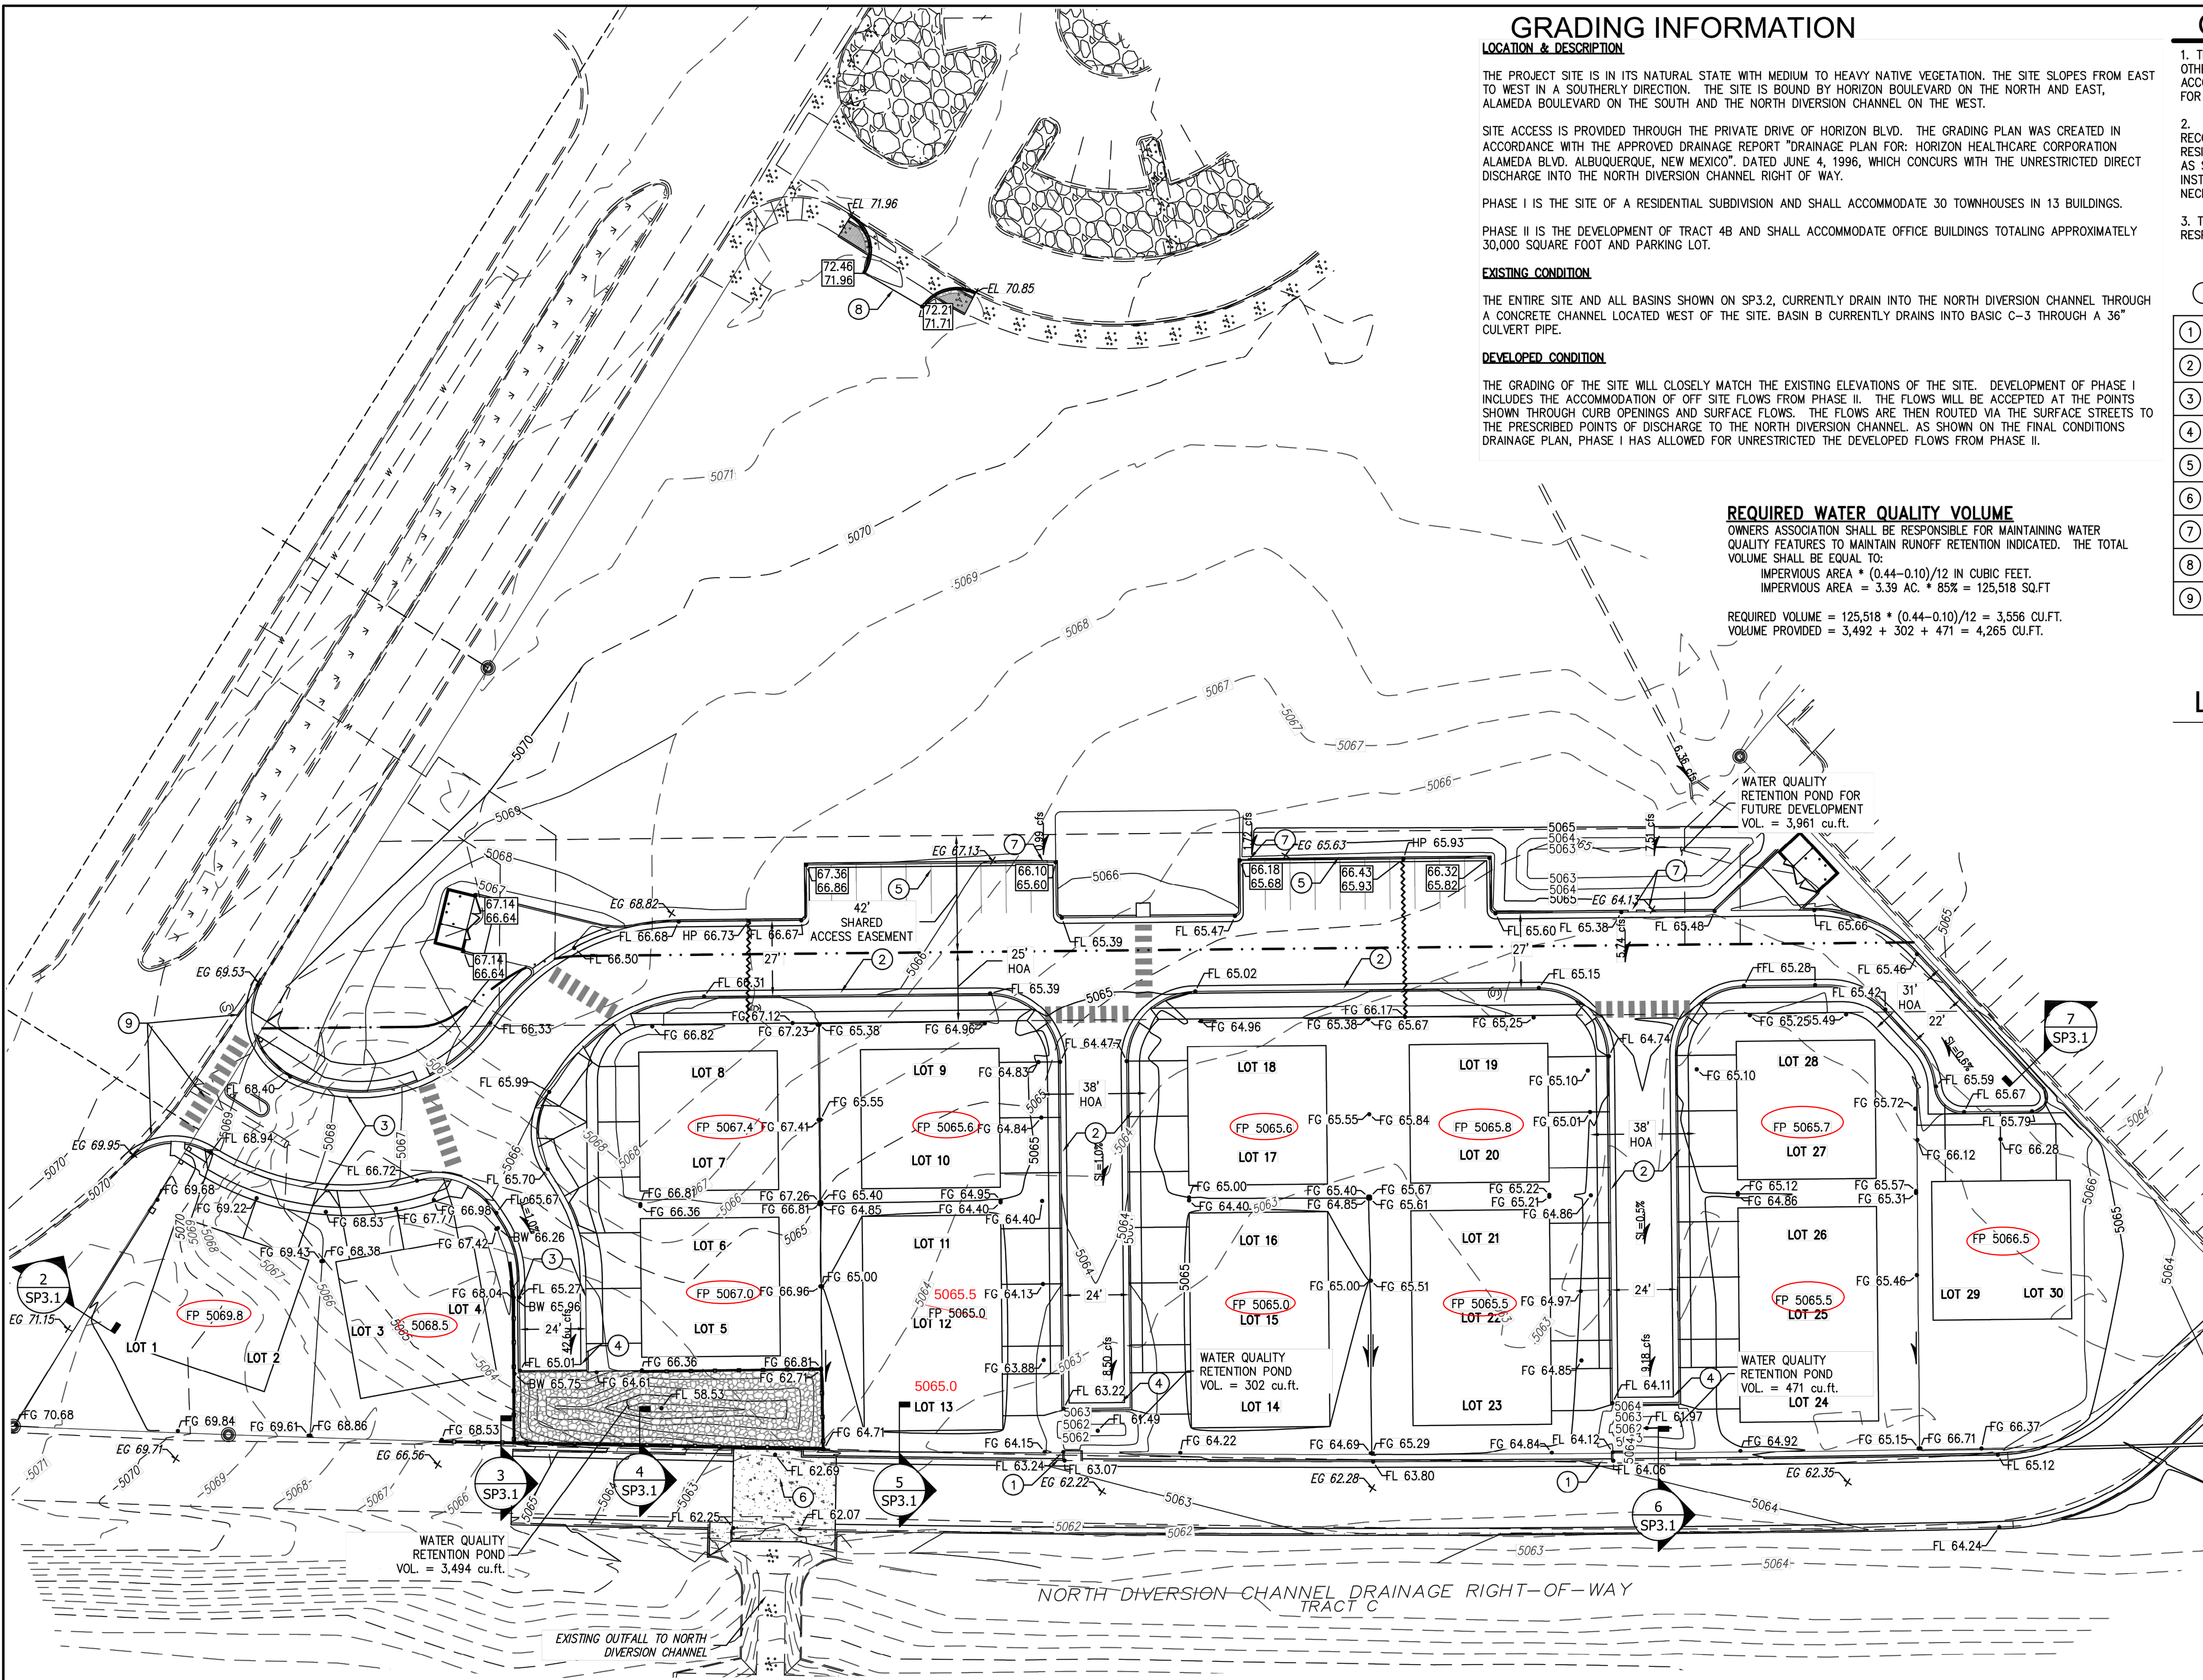

FOR INFORMATION ONLY

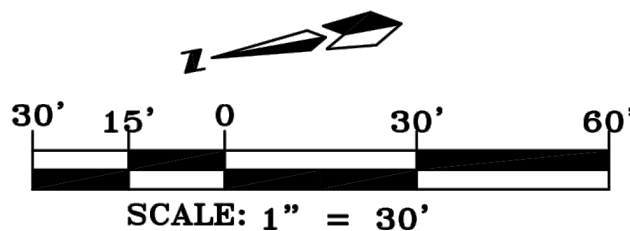

THE
group

THE HENSLEY ENGINEERING GROUP
(505) 410-1622

HORIZON ALDEA SUBDIVISION


A REPLAT OF TRACT 4 LANDS OF ITS ACQUISITION NO 120
GRADING PLAN

DESIGN REVIEW COMMITTEE	CITY ENGINEER APPROVAL	Mo./DAY/YR.	Mo./DAY/YR.
-------------------------	------------------------	-------------	-------------

For Information Only


CITY PROJECT No.	ZONE MAP No.	SHEET	OF
	C-17	1	2

AS BUILT INFORMATION		BENCH MARKS		SURVEY INFORMATION		ENGINEER'S SEAL		REVISIONS	
CONTRACTOR	DATE	NO.	DATE	NO.	DATE	NO.	DATE	NO.	DATE
WORKED BY	DATE	NO.	DATE	NO.	DATE	NO.	DATE	NO.	DATE
INSPECTOR'S	DATE	NO.	DATE	NO.	DATE	NO.	DATE	NO.	DATE
FIELD DISTANCE BY	DATE	NO.	DATE	NO.	DATE	NO.	DATE	NO.	DATE
VERIFICATION BY	DATE	NO.	DATE	NO.	DATE	NO.	DATE	NO.	DATE
CORRECTED BY	DATE	NO.	DATE	NO.	DATE	NO.	DATE	NO.	DATE
MICRO-FILM INFORMATION		RECORDS		DESIGN		DESIGNED BY		CHECKED BY	
						REH		REH	
						DATE 1/31/19		DATE 4/7/19	
						DATE 4/12/19			

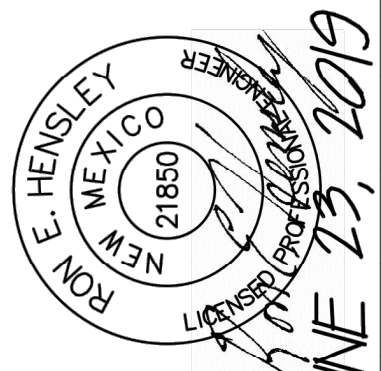


GENERAL SHEET NOTES


1. THE CONCEPT DETAILED ON THESE PLANS SHALL, EXCEPT AS OTHERWISE STATED OR PROVIDED HEREIN, BE CONSTRUCTED IN ACCORDANCE WITH THE CITY OF ALBUQUERQUE STANDARD SPECIFICATIONS FOR PUBLIC WORKS CONSTRUCTION, 1986 EDITION, UPDATE NO 8.
2. THE EROSION PROTECTION SPECIFIED ON THIS PLAN IS THE MINIMUM RECOMMENDED. THE OWNER IS ENCOURAGED TO INCORPORATE EROSION RESISTANT LANDSCAPING ON AREAS WHERE EROSION MAY OCCUR SUCH AS SLOPES AND SWALES. THE OWNER IS RESPONSIBLE FOR THE INSTALLATION AND MAINTENANCE OF ALL EROSION CONTROL FEATURES NECESSARY TO PRESERVE THE DESIGN INTENT OF THE GRADING PLAN.
3. THE DRAINAGE INFRASTRUCTURE SHOWN ON THIS PLAN IS THE RESPONSIBILITY OF THE PROPERTY OWNER.

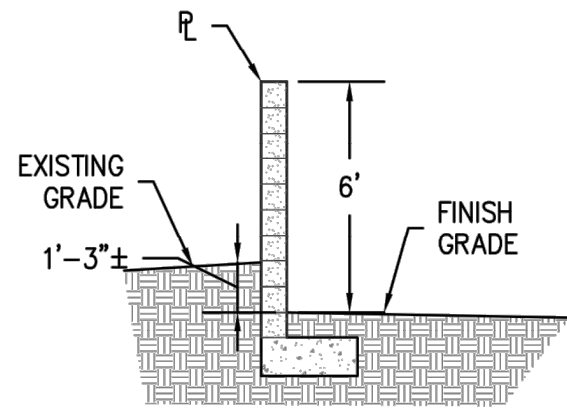


2 SECTION AT PROPERTY LINE
Scale: 1"=5'

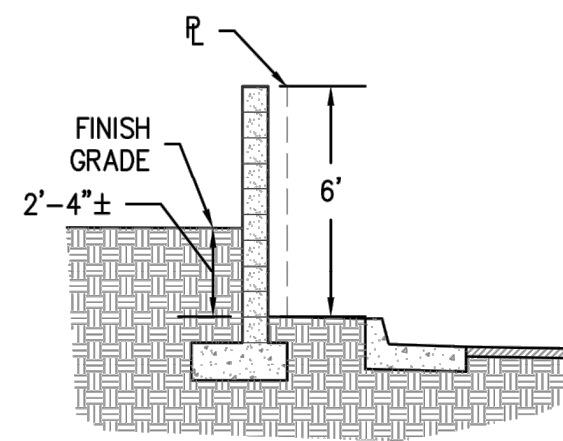


3 SECTION AT PROPERTY LINE
Scale: 1"=5'

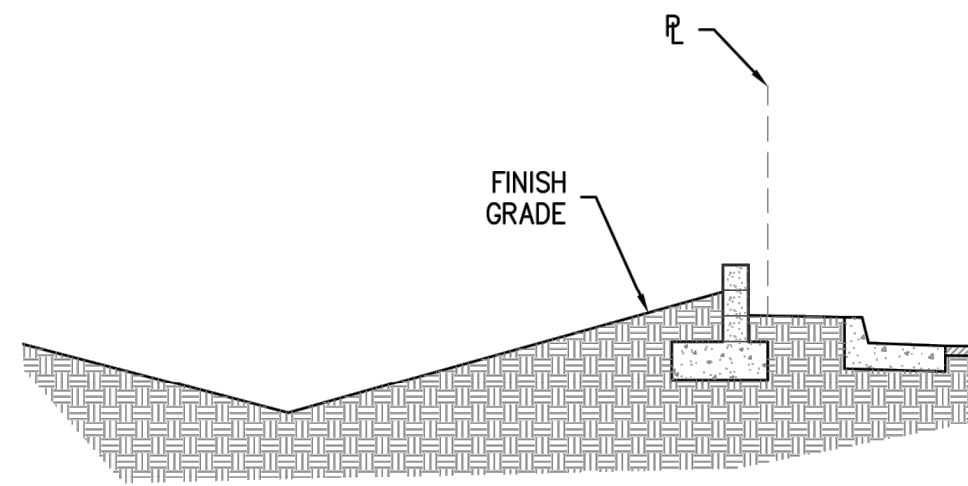


4 SECTION AT WATER QUALITY
Scale: 1"=5'

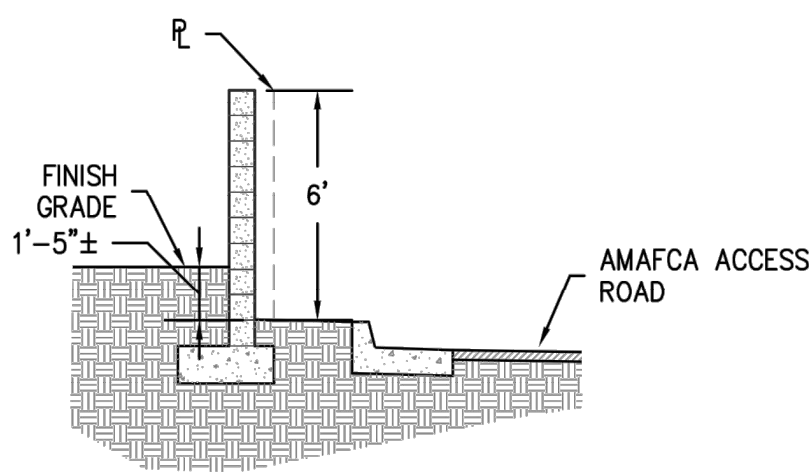


5 SECTION AT PROPERTY LINE
Scale: 1"=5'

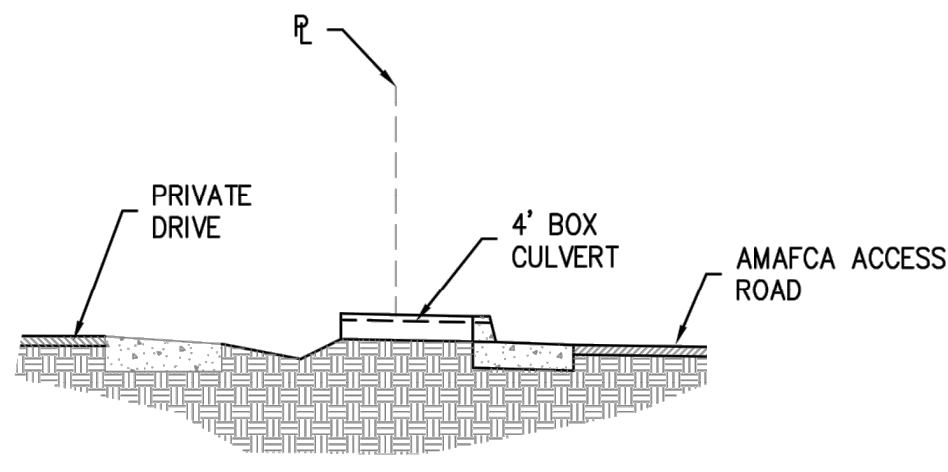


6 SECTION AT PROPERTY LINE
Scale: 1"=5'

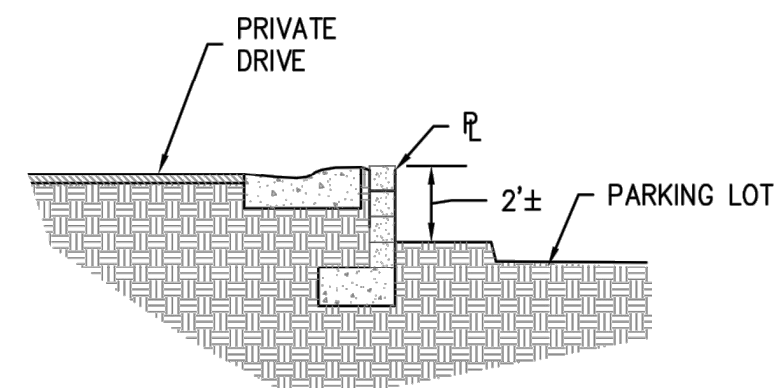

7 SECTION AT PROPERTY LINE
Scale: 1"=5'

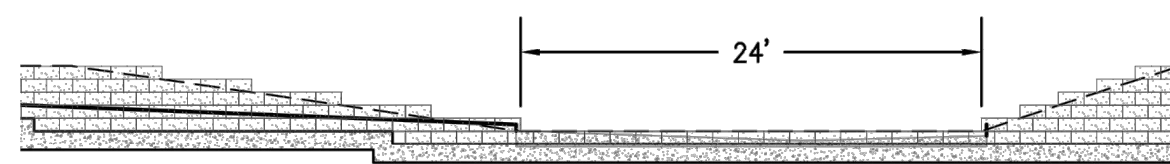


1 DRAIANGE DISCHARGE WIER
Scale: 1"=10'

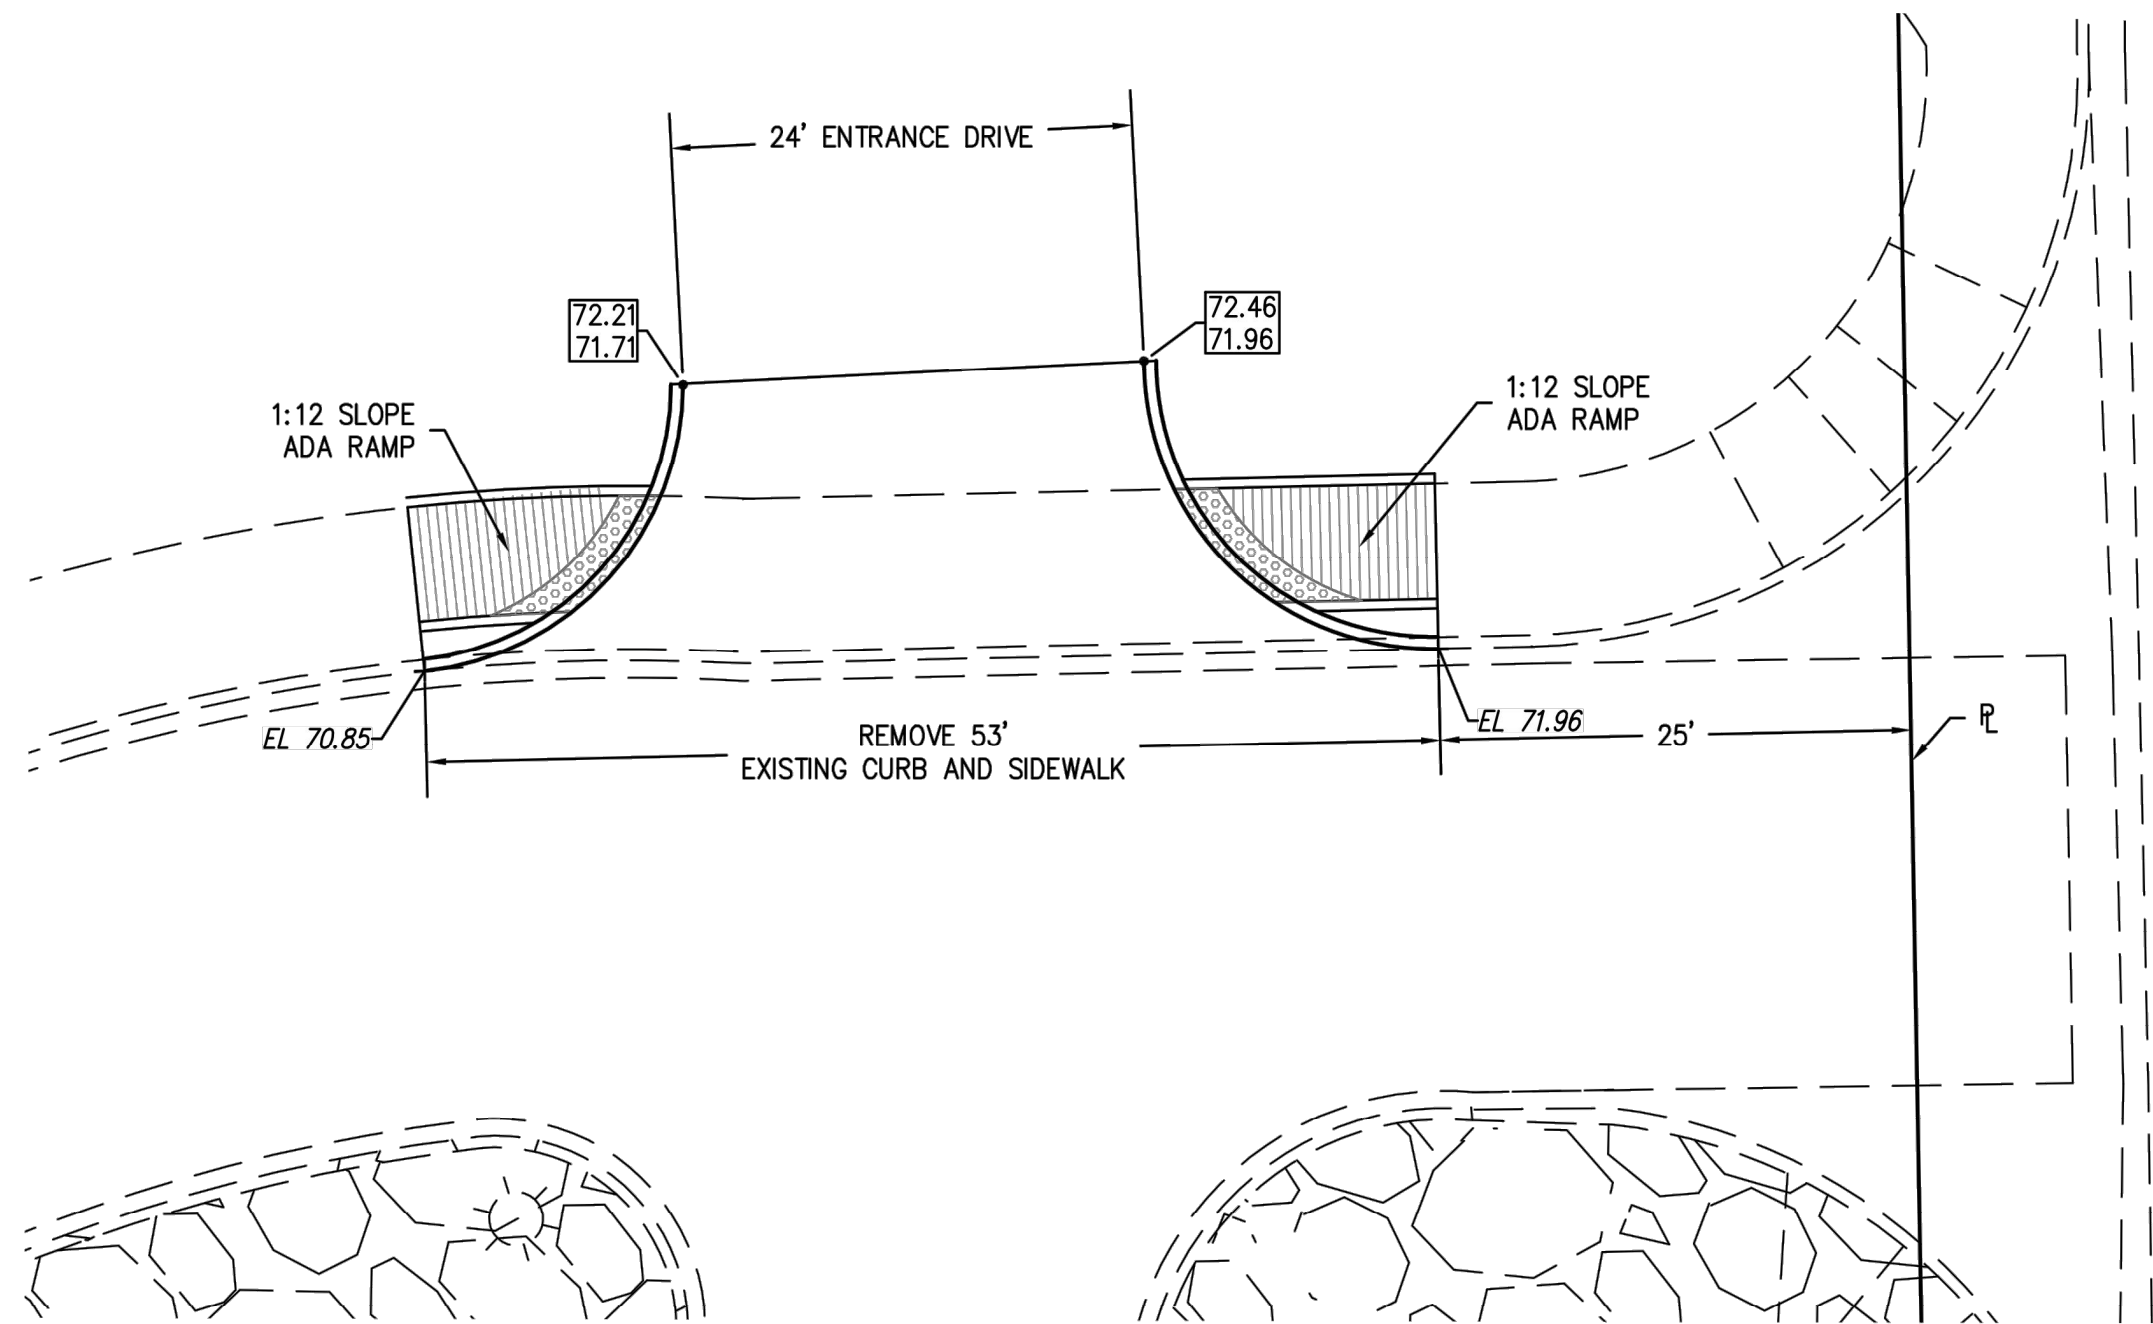

8 TRACT 4B ENTRANCE
Scale: 1"=10'

AS BUILT INFORMATION		BENCH MARKS		SURVEY INFORMATION		ENGINEER'S SEAL		REVISIONS		DESIGN	
CONTRACTOR	DATE	NO.	DATE	NO.	DATE	NO.	DATE	NO.	DATE	NO.	DATE
WORKED BY	DATE	NO.	DATE	NO.	DATE	NO.	DATE	NO.	DATE	NO.	DATE
INSPECTOR'S	DATE	NO.	DATE	NO.	DATE	NO.	DATE	NO.	DATE	NO.	DATE
FIELD STAKE BY	DATE	NO.	DATE	NO.	DATE	NO.	DATE	NO.	DATE	NO.	DATE
VERIFICATION BY	DATE	NO.	DATE	NO.	DATE	NO.	DATE	NO.	DATE	NO.	DATE
CORRECTED BY	DATE	NO.	DATE	NO.	DATE	NO.	DATE	NO.	DATE	NO.	DATE
MICRO-FILM INFORMATION		REVISIONS		DESIGN		REVISIONS		DESIGN		REVISIONS	
RECORDED BY		NO.		NO.		NO.		NO.		NO.	
DATE		DATE		DATE		DATE		DATE		DATE	

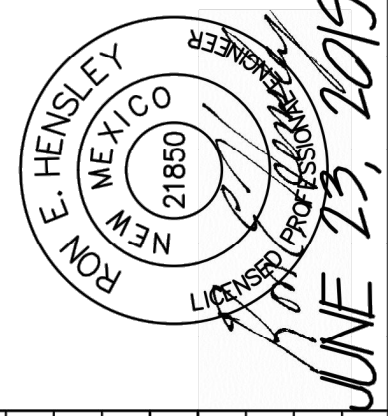



HORIZON ALDEA SUBDIVISION			
A REPLAT OF TRACT 4 LANDS OF AHS ACQUISITION NO 120			
GRADING DETAILS			
DESIGN REVIEW COMMITTEE	CITY ENGINEER APPROVAL	Mo./DAY/YR.	Mo./DAY/YR.
For Information Only			
CITY PROJECT No.	ZONE MAP NO.	SHEET	OF
	C-17	2	2

FOR INFORMATION ONLY

GENERAL NOTES
NOTICE TO CONTRACTORS


PAVING

1. REMOVAL OF EXISTING CURB & GUTTER AND SIDEWALKS SHALL BE TO THE NEAREST JOINT.
2. ANY DAMAGE TO THE EXISTING CURB & GUTTER, PAVEMENT, SIDEWALKS, STRIPING, AND SIGNAGE DURING CONSTRUCTION SHALL BE REPLACED AT THE CONTRACTOR'S EXPENSE.
3. OVERNIGHT PARKING OF CONSTRUCTION EQUIPMENT SHALL NOT OBSTRUCT DRIVEWAYS OR DESIGNATED TRAFFIC LANES. THE CONTRACTOR SHALL NOT STORE ANY EQUIPMENT OR MATERIAL WITHIN THE PUBLIC RIGHT-OF-WAY.
4. CURB AND GUTTER, SIDEWALKS, AND DRIVE PADS SHALL MATCH THE LINE AND GRADE OF ABUTTING EXISTING AREAS AS SHOWN ON THE PLANS OR AS DIRECTED BY THE PROJECT ENGINEER.
5. THE SUBGRADE PREP SHALL EXTEND ONE FOOT BEYOND THE FREE EDGE OF NEW CURB AND GUTTER AND SIDEWALK.
6. CONTRACTOR TO TEST SUBGRADE R-VALUE PRIOR TO CONSTRUCTION. IN THE EVENT THE R-VALUE IS LESS THAN 50, REMOVE 2 FEET OF SUBGRADE MATERIAL AND IMPORT MATERIAL WITH R-VALUE GREATER THAN 50 OR CONTACT THE ENGINEER IMMEDIATELY SO THE PAVEMENT SECTION CAN BE MODIFIED.
7. AT ALL PAVEMENT REMOVAL AND REPLACEMENTS, SAW-CUT EDGES SHALL BE STRAIGHT AND CLEAN, AND LONGITUDINAL JOINTS SHALL NOT BE PLACED WITHIN WHEEL PATHS. PATCHES SHALL BE REGULAR AND SQUARE OR RECTANGULAR, WITH FOUR STRAIGHT SIDES. FINISHED PAVEMENT SURFACE SHALL BE FLUSH WITH EXISTING PAVEMENT SURFACE, WITH NO SPILLOVER OF ASPHALT OR TACK COAT. CARE MUST BE TAKEN TO AVOID DAMAGING THE INTEGRITY OR APPEARANCE OF SURROUNDING PAVEMENTS; IF DAMAGED, THE ENTIRE SURFACE PATCH MUST BE EXPANDED TO COVER DAMAGES.
8. CONTRACTOR WILL ENSURE THE ASPHALT HAS A SMOOTH, UNIFORM EDGE WHEN REMOVING AND REPLACING CURB AND GUTTER. IF THE ASPHALT EDGE IS NOT SMOOTH AND UNIFORM, CONTRACTOR WILL SAW CUT AND REPLACE A ONE-FOOT STRIP OF ASPHALT ALONG THE FULL SECTION BEING REPLACED; REFER TO C.O.A. STANDARD DRAWING # 2465 WITH THE APPROPRIATE PAVING SECTION BASED ON ROADWAY CLASSIFICATION.
9. BACKFILL COMPACTION SHALL BE ACCORDING TO SPECIFIED STREET USE.
10. TACK COAT REQUIREMENTS SHALL BE DETERMINED BY THE ENGINEER.
11. UNLESS SPECIFICALLY NOTED, SIDEWALKS AND WHEELCHAIR RAMPS WITHIN THE CURB RETURNS SHALL BE CONSTRUCTED WHEREVER A NEW CURB RETURN IS CONSTRUCTED.
12. THE CONTRACTOR SHALL BE RESPONSIBLE FOR REPAIR, OR REMOVAL AND REPLACEMENT, OF ANY PAVEMENT, PAVEMENT MARKINGS, CURB AND GUTTER, DRIVEPADS, SIDEWALK, WHEELCHAIR RAMP, SIGNAGE OR ANY OTHER EXISTING IMPROVEMENTS DAMAGED BY THE CONTRACTOR'S OPERATIONS.

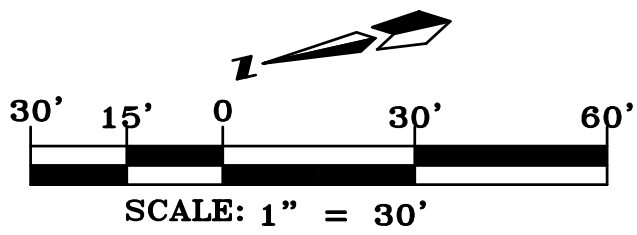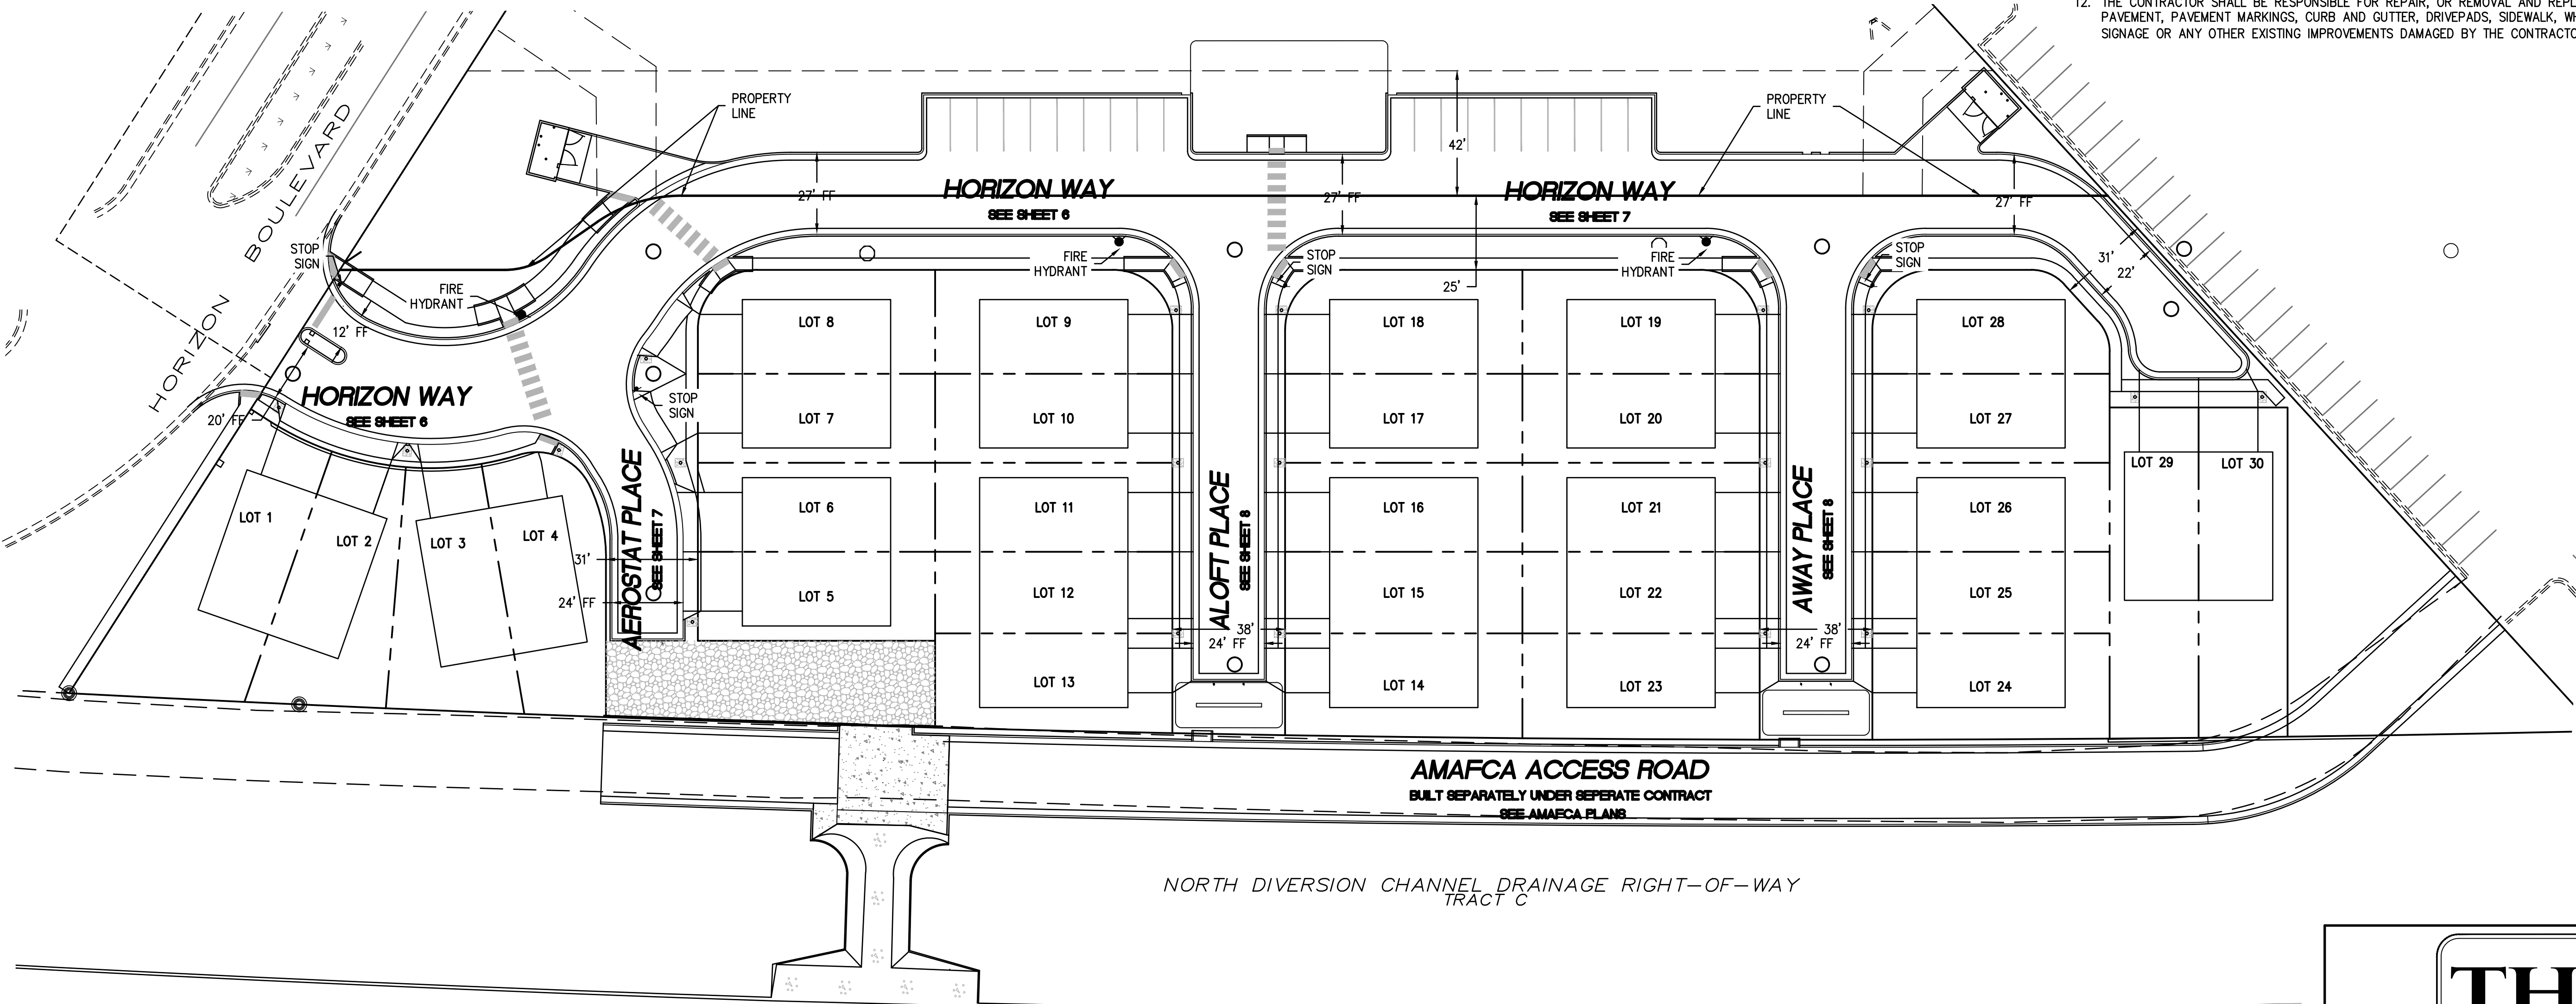


HORIZON VILLAGE SUBDIVISION GENERAL PAVING GENERAL PAVING NOTES AND SHEET MAP			
DESIGN REVIEW COMMITTEE	CITY ENGINEER APPROVAL	Mo./DAY/YR.	Mo./DAY/YR.
APPROVE July 21, 2020 DESIGN REVIEW COMMITTEE	APPROVE Aug 6, 2020 CITY ENGINEER		
CITY PROJECT No. 799782		ZONE MAP NO. C-17	SHEET 5 OF 15

AS BUILT INFORMATION			
CONTRACTOR	DATE	DATE	DATE
STAKED BY	DATE	DATE	DATE
INSPECTED BY	DATE	DATE	DATE
FIELD ENGINEER	DATE	DATE	DATE
REVISIONS	DATE	DATE	DATE
CORRECTED BY	DATE	DATE	DATE
MICRO-FILM INFORMATION			
RECORDED BY	DATE	DATE	DATE
NO.			

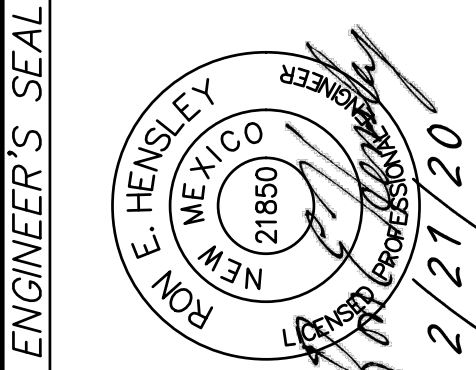



SURVEY INFORMATION			
FIELD NOTES	DATE	DATE	DATE
BY			
NO.			
ENGINEER'S SEAL			
REMARKS	BY	DATE	DATE
DESIGN		10/31/19	12/07/19
REH		02/21/20	
REH			

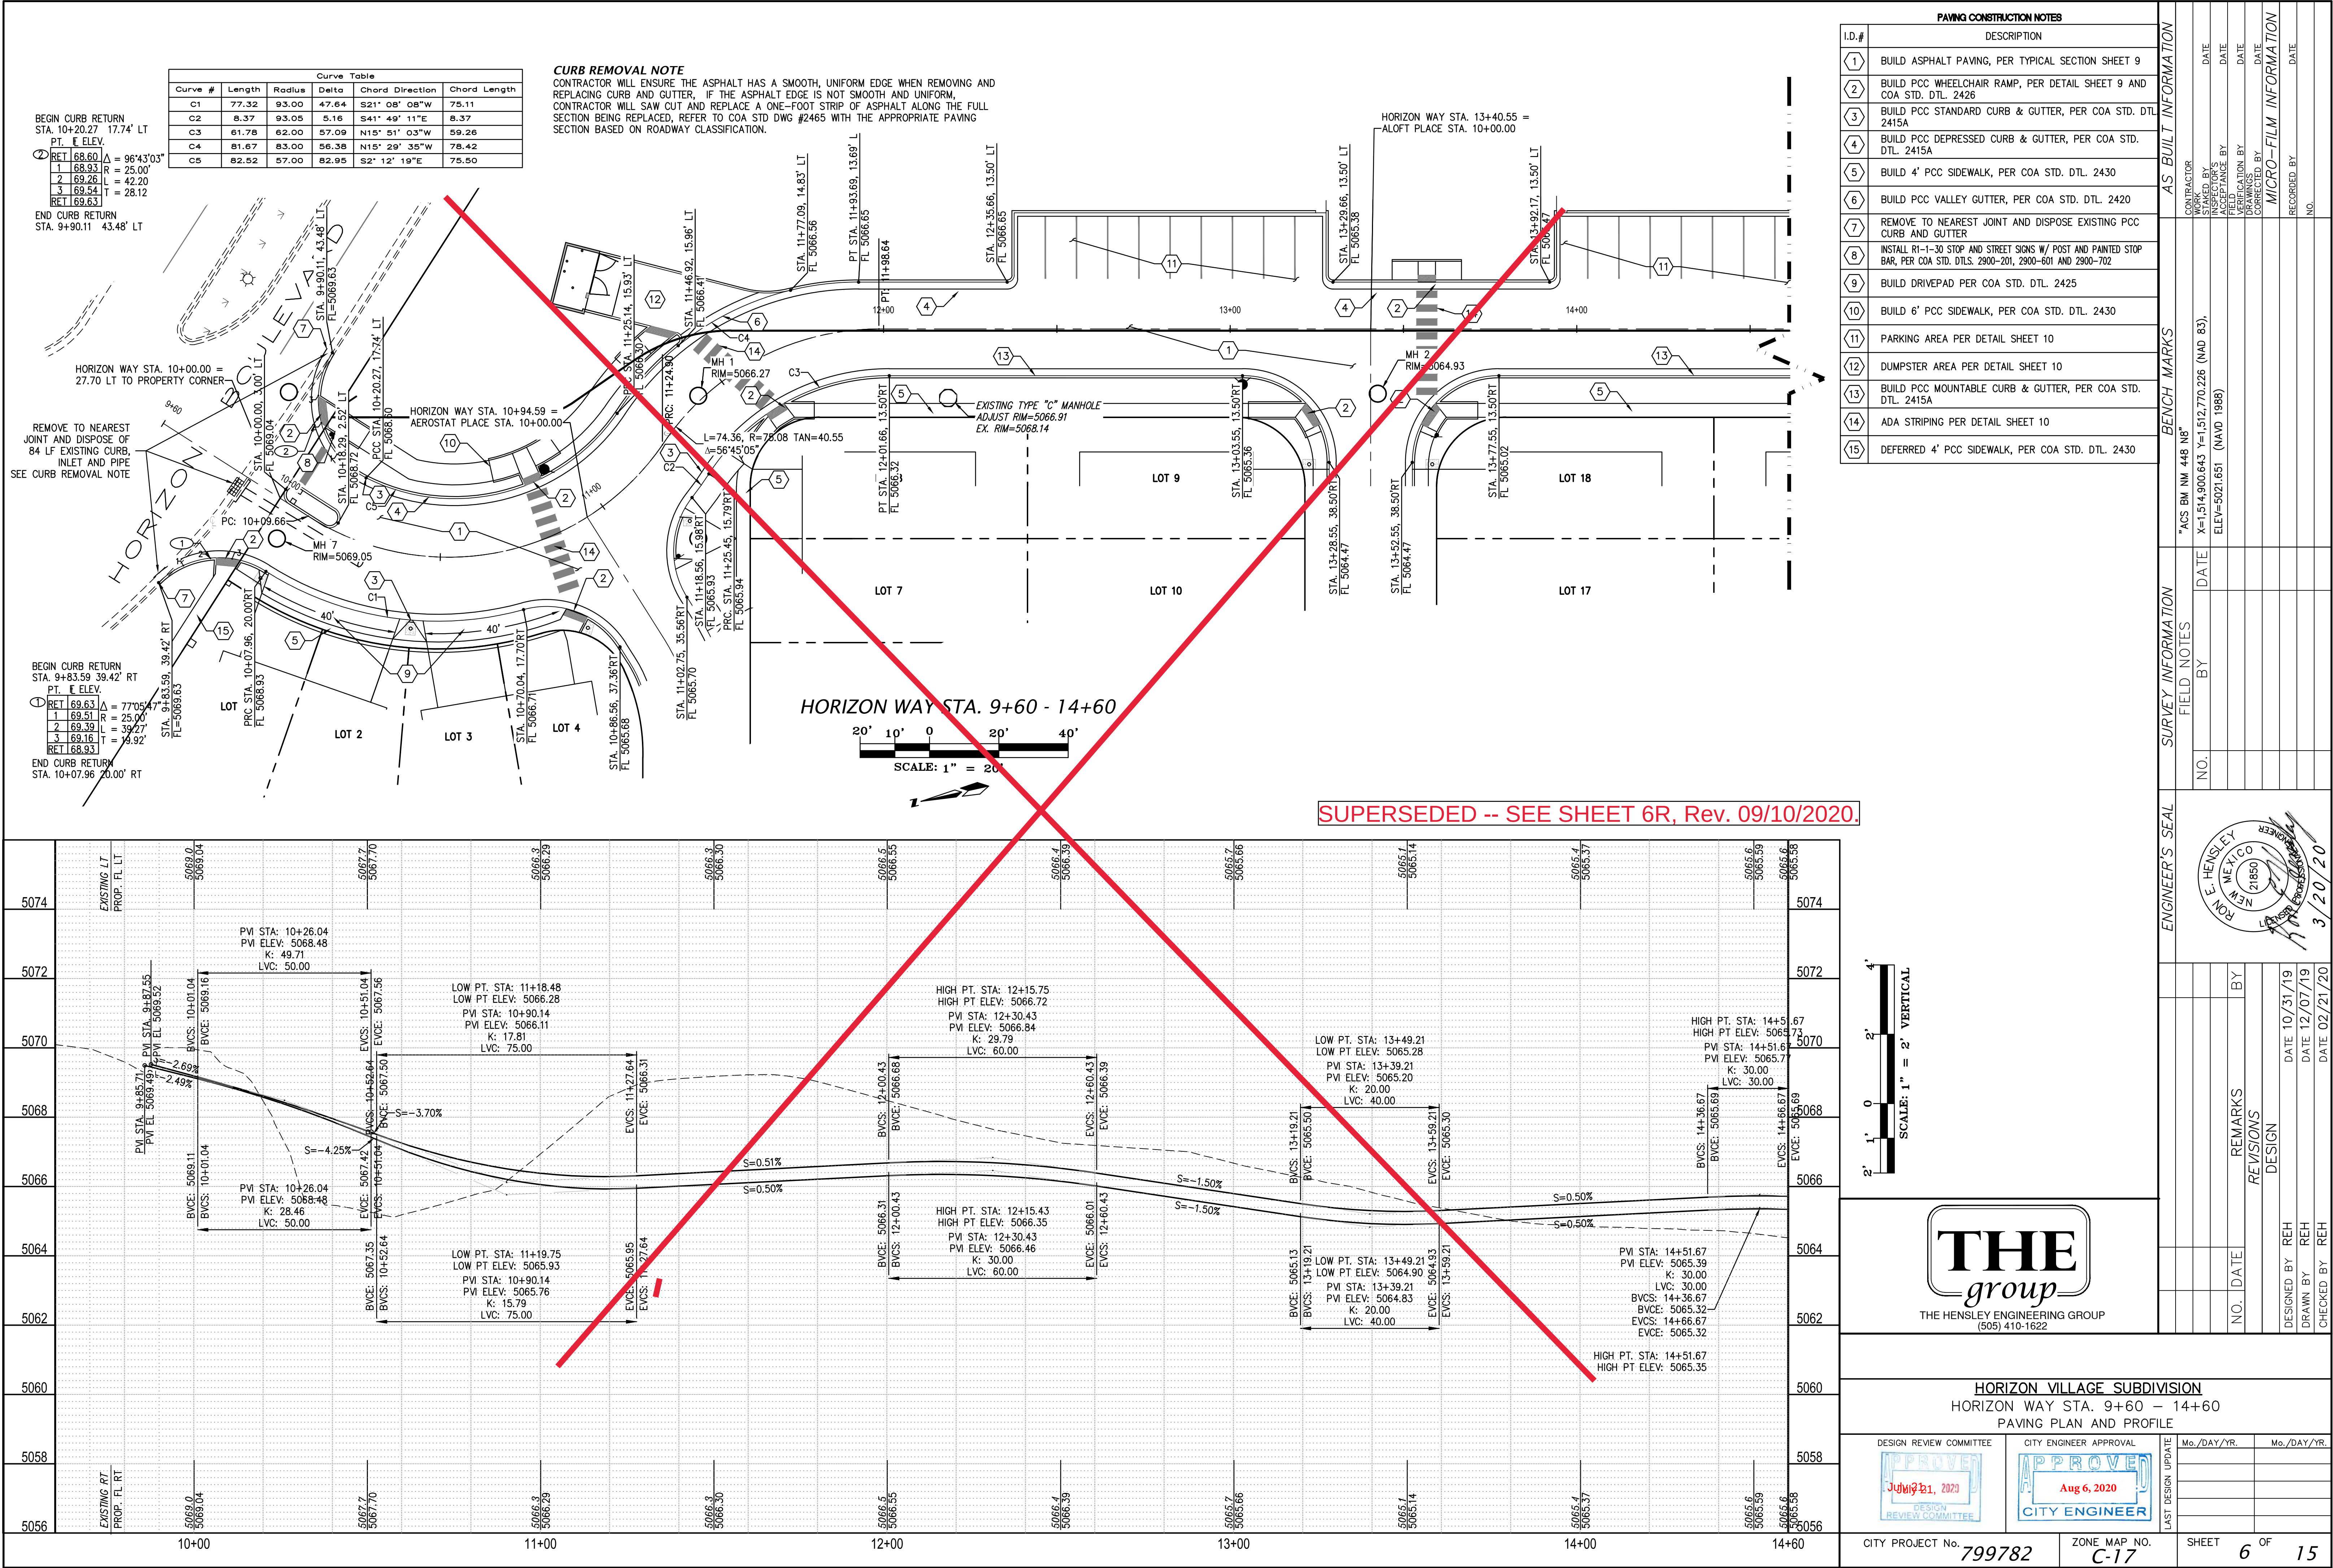

Curve Table					
Curve #	Length	Radius	Delta	Chord Direction	Chord Length
C1	77.32	93.00	47.64	S21° 08' 08"W	75.11
C2	8.37	93.05	5.16	S41° 49' 11"E	8.37
C3	61.78	62.00	57.09	N15° 51' 03"W	59.26
C4	81.67	83.00	56.38	N15° 29' 35"W	78.42
C5	82.52	57.00	82.95	S2° 12' 19"E	75.50

CURB REMOVAL NOTE


CONTRACTOR WILL ENSURE THE ASPHALT HAS A SMOOTH, UNIFORM EDGE WHEN REMOVING AND REPLACING CURB AND GUTTER, IF THE ASPHALT EDGE IS NOT SMOOTH AND UNIFORM, CONTRACTOR WILL SAW CUT AND REPLACE A ONE-FOOT STRIP OF ASPHALT ALONG THE FULL SECTION BEING REPLACED, REFER TO COA STD DWG #2465 WITH THE APPROPRIATE PAVING SECTION BASED ON ROADWAY CLASSIFICATION.

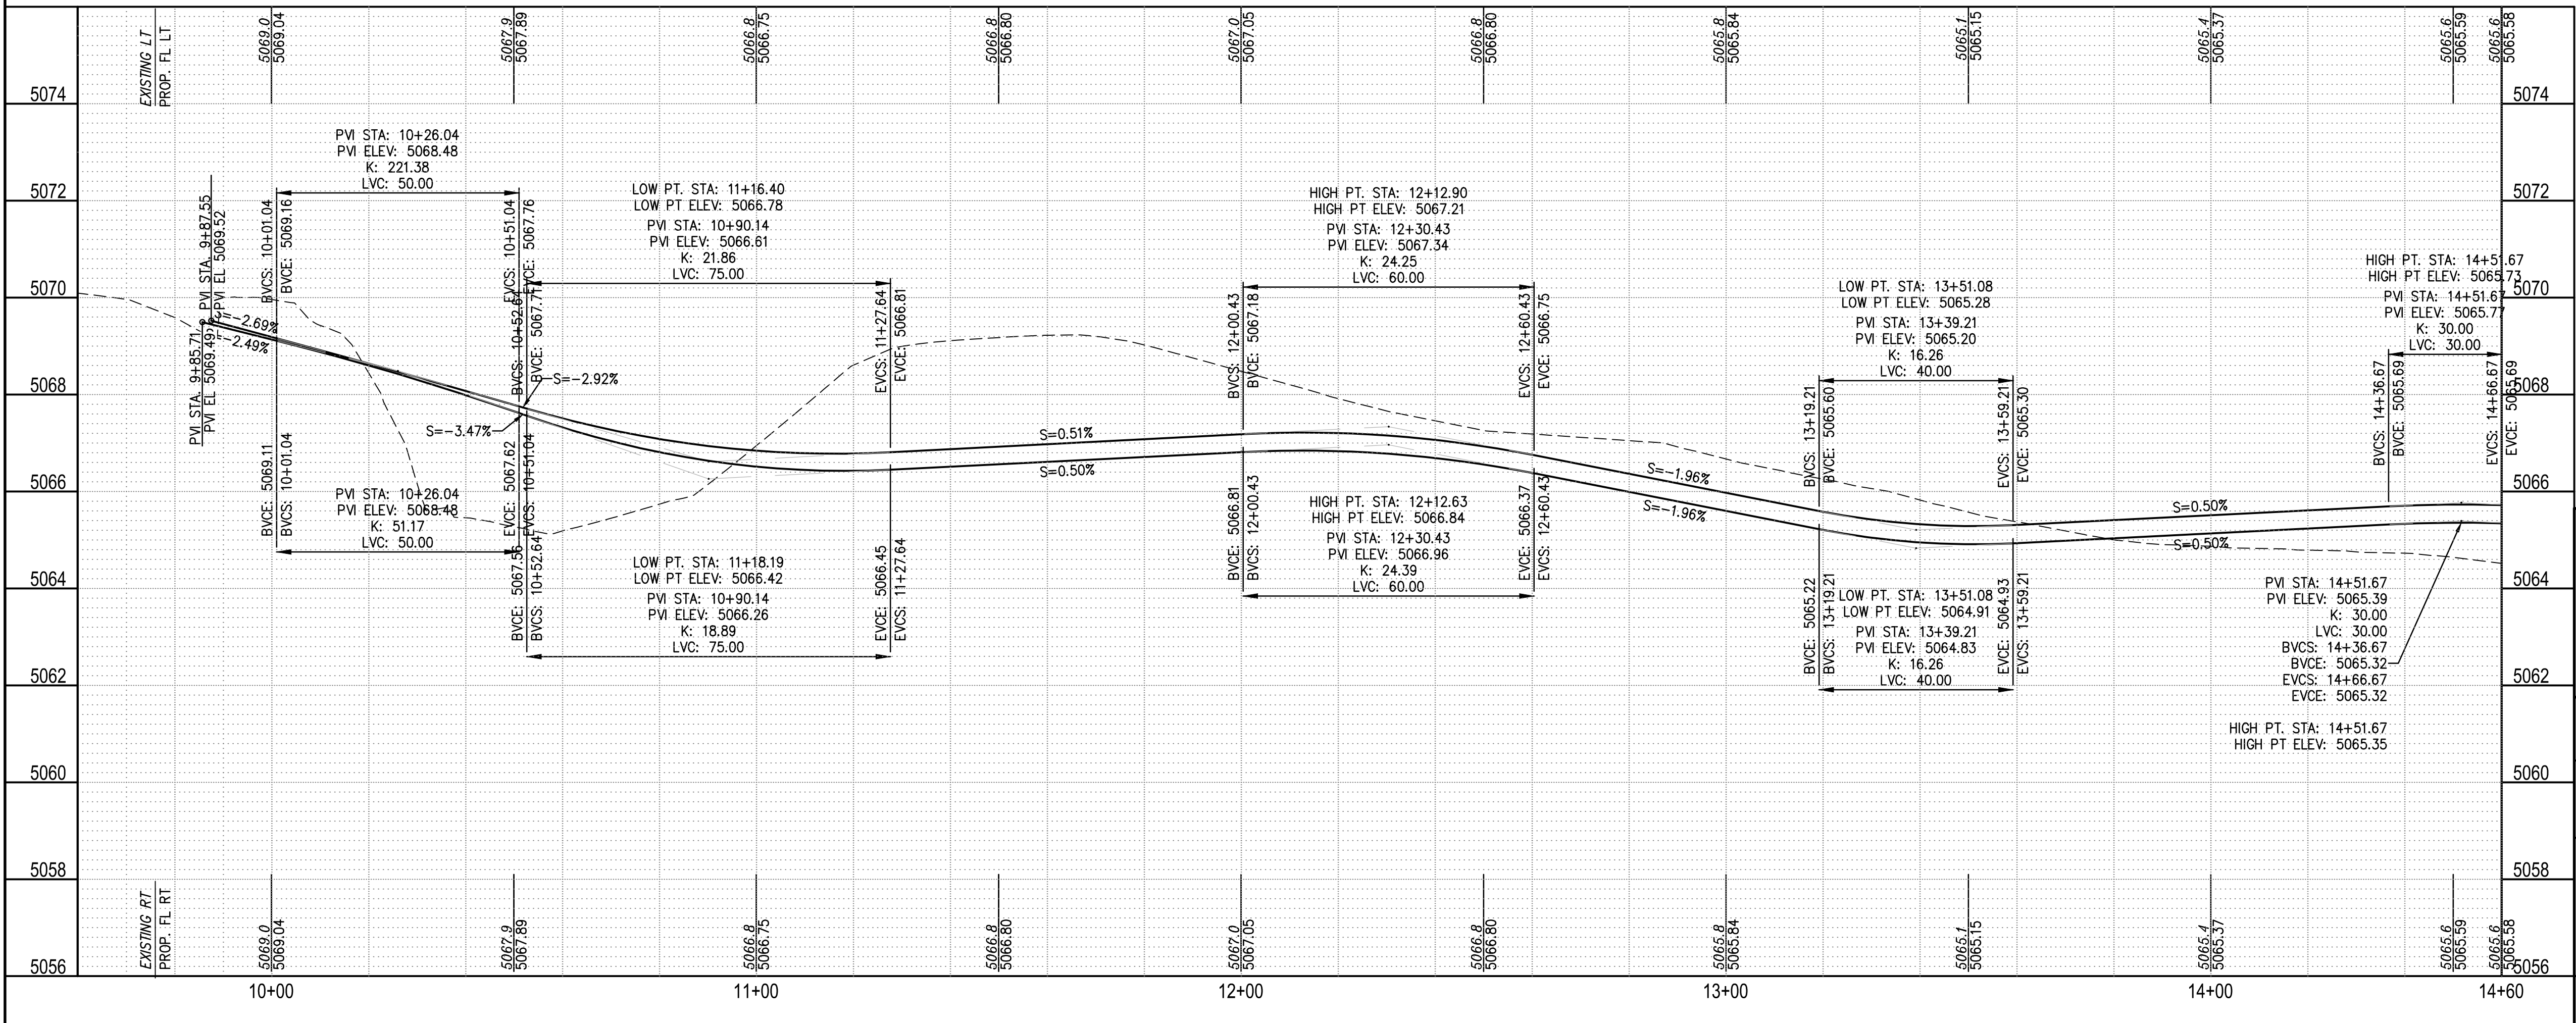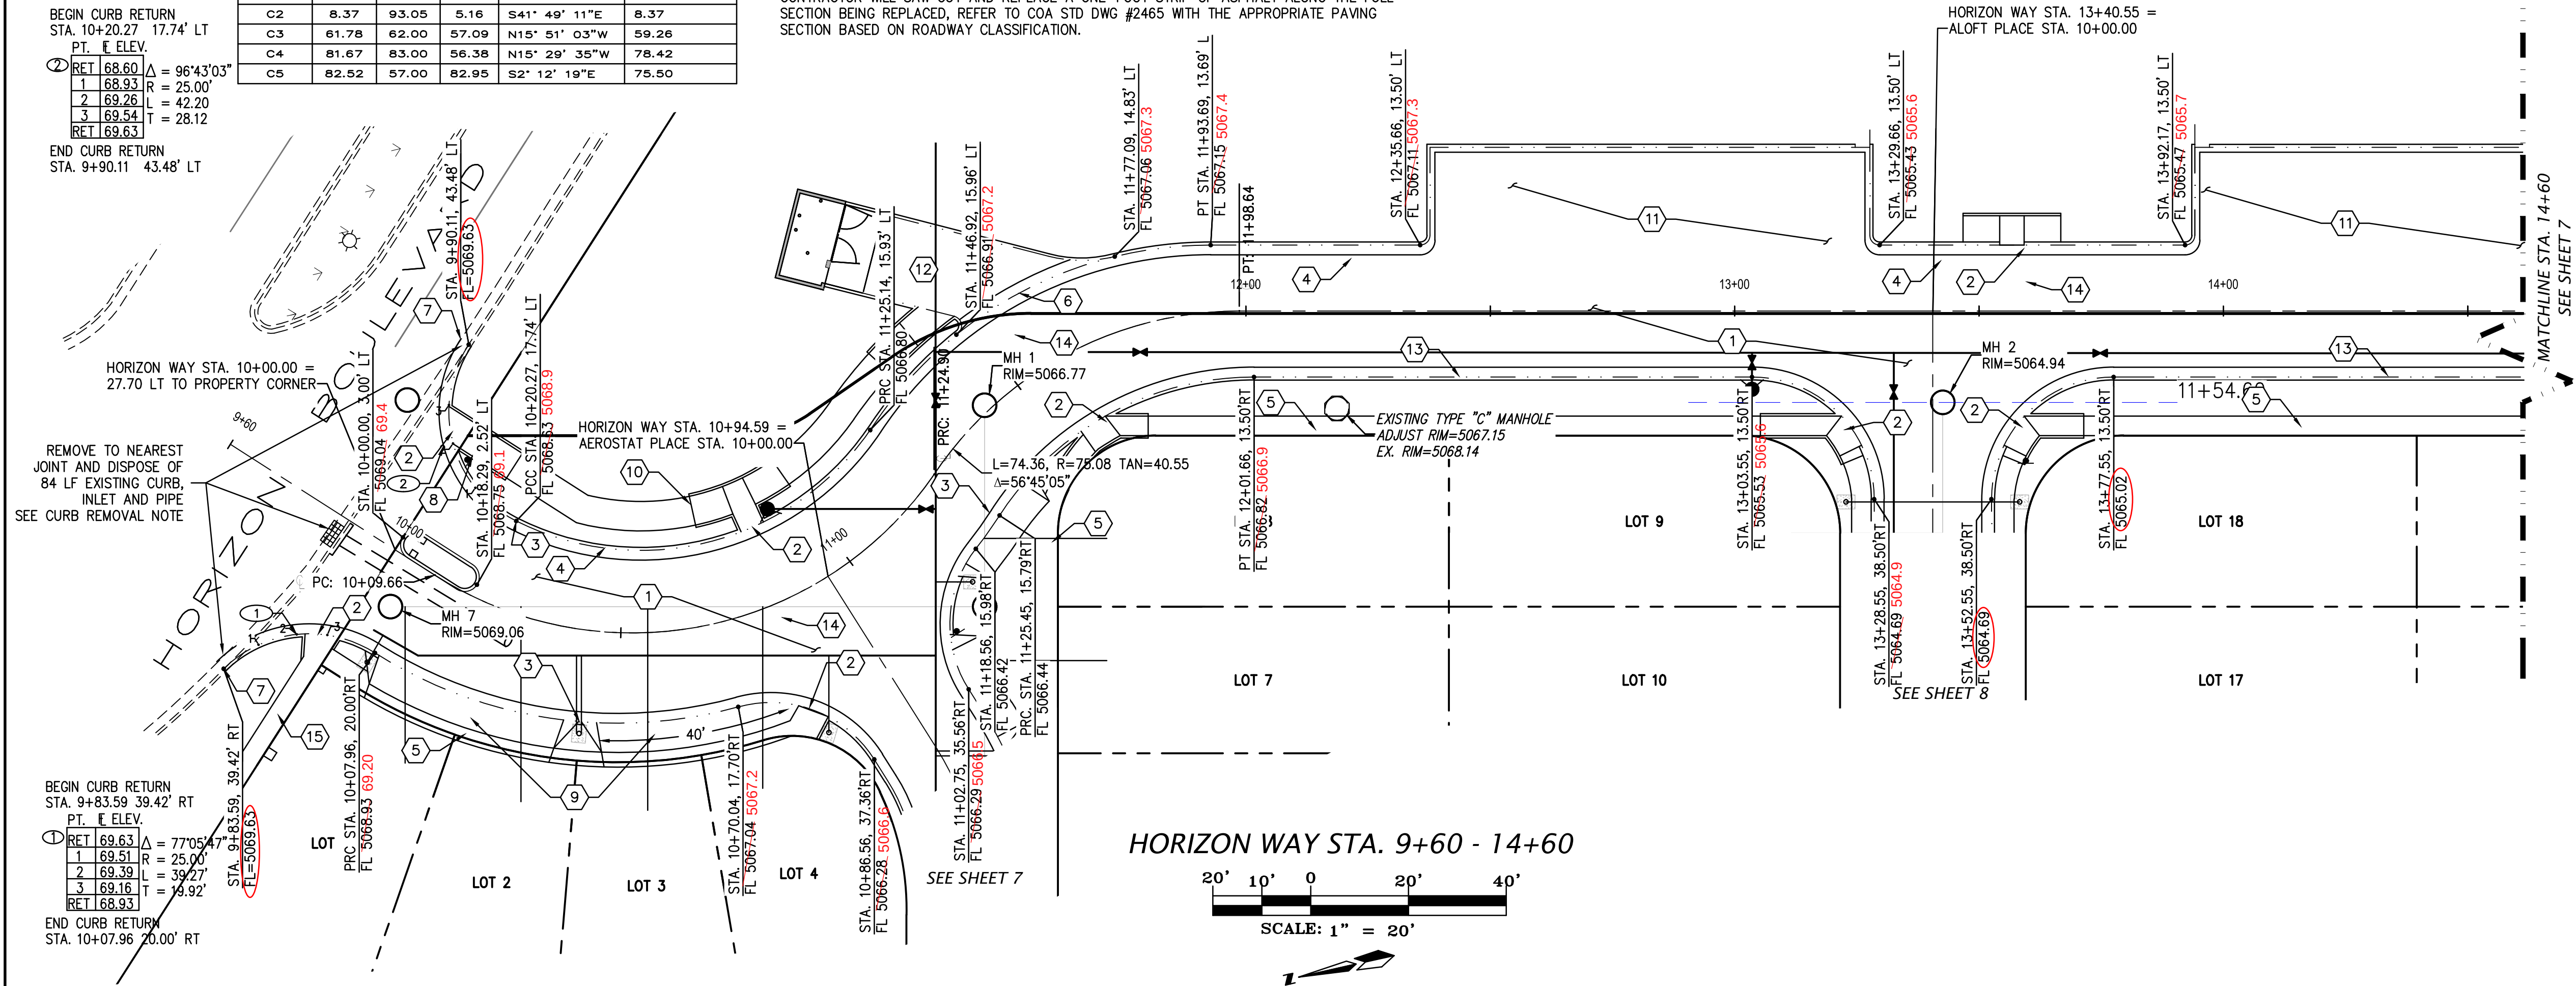


PAVING CONSTRUCTION NOTES	
I.D.#	DESCRIPTION
(1)	BUILD ASPHALT PAVING, PER TYPICAL SECTION SHEET 9
(2)	BUILD PCC WHEELCHAIR RAMP, PER DETAIL SHEET 9 AND COA STD. DTL. 2426
(3)	BUILD PCC STANDARD CURB & GUTTER, PER COA STD. DTL. 2415A
(4)	BUILD PCC DEPRESSIONED CURB & GUTTER, PER COA STD. DTL. 2415A
(5)	BUILD 4' PCC SIDEWALK, PER COA STD. DTL. 2430
(6)	BUILD PCC VALLEY GUTTER, PER COA STD. DTL. 2420
(7)	REMOVE TO NEAREST JOINT AND DISPOSE EXISTING PCC CURB AND GUTTER
(8)	INSTALL R1-1-30 STOP AND STREET SIGNS W/ POST AND PAINTED STOP BAR, PER COA STD. DTLs. 2900-201, 2900-601 AND 2900-702
(9)	BUILD DRIVEPAD PER COA STD. DTL. 2425
(10)	BUILD 6' PCC SIDEWALK, PER COA STD. DTL. 2430
(11)	PARKING AREA PER DETAIL SHEET 10
(12)	DUMPSTER AREA PER DETAIL SHEET 10
(13)	BUILD PCC MOUNTABLE CURB & GUTTER, PER COA STD. DTL. 2415A
(14)	ADA STRIPING PER DETAIL SHEET 10
(15)	DEFERRED 4' PCC SIDEWALK, PER COA STD. DTL. 2430

SURVEY INFORMATION		BENCH MARKS		AS BUILT INFORMATION	
NO.	FIELD NOTES	"ACS BM NW 448 N8"		CONTRACTOR	
BY	DATE	X=1,514,900.643 (-1,512,770.2226 (NAD 83),		WORK	
		ELEV=5021.651 (NAVD 1988)		STAKED BY	CARTESIAN SURVEYS DATE 7/20/121
				ACCEPTANCE BY	DATE
				FIELD CATION BY	CARTESIAN SURVEYS DATE 2/21
				DRAWINGS	DATE
				CORRECTED BY	DATE
				MICRO-FILM INFORMATION	
				RECORDED BY	DATE
				NO.	

[illegible]

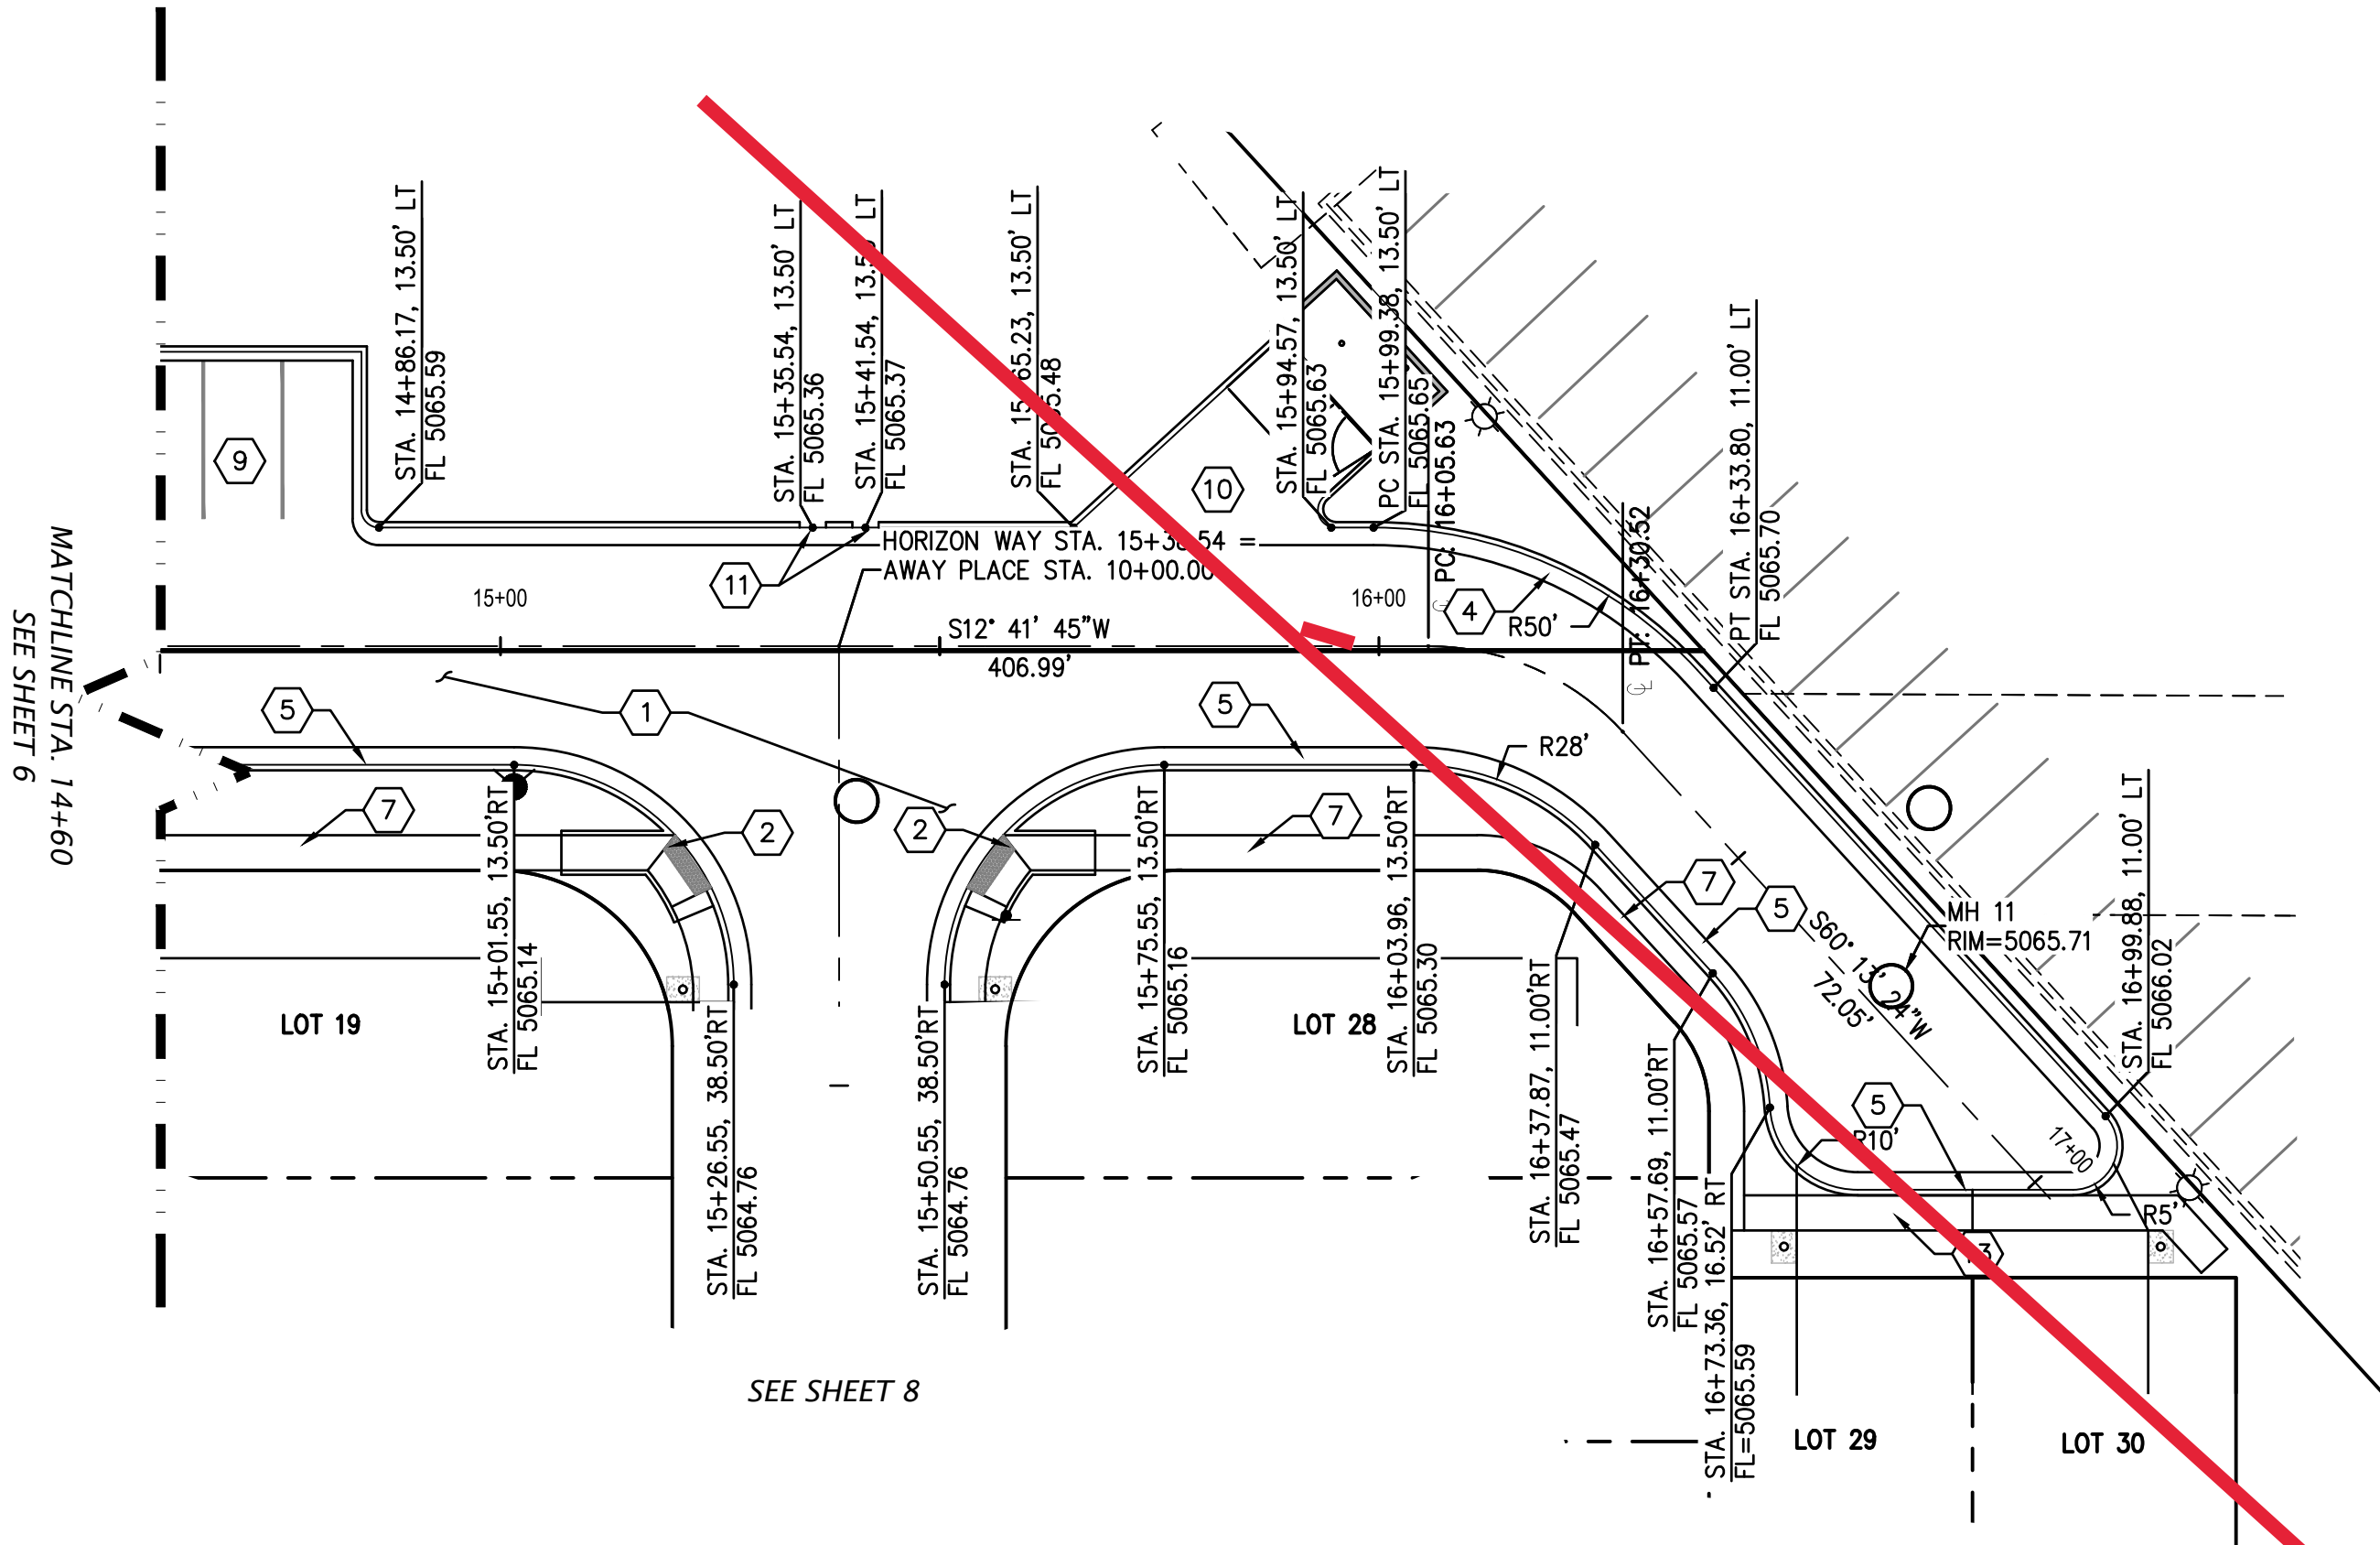


HORIZON WAY STA. 14+60 - 17+00

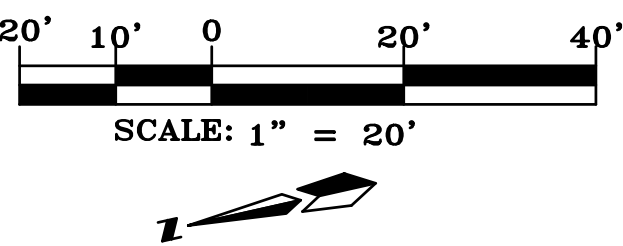




BEGIN CURB RETURN
STA. 10+34.91 12.00' LT
PT. E. ELEV.
④ RET 65.70 Δ = 7019'48"
1 65.77 R = 25.00'
2 65.83 L = 30.69
3 65.89 T = 17.61
RET 65.93
END CURB RETURN
STA. 10+11.37 28.58' LT

BEGIN CURB RETURN
STA. 10+12.80 29.74' RT
PT. E. ELEV.
④ RET 66.71 Δ = 7307'40"
1 66.43 R = 25.00'
2 66.16 L = 31.91
3 65.84 T = 18.54
RET 65.68
END CURB RETURN
STA. 10+36.72 12.00' RT

AEROSTAT PLACE

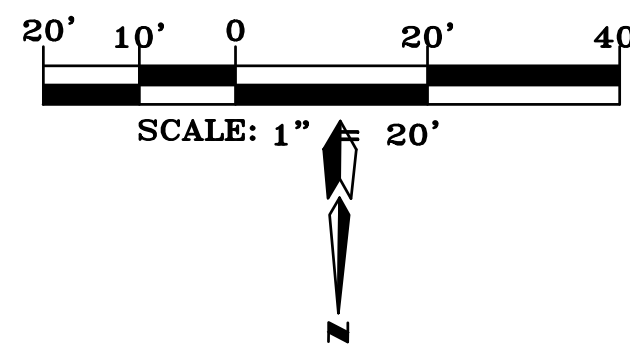


SUPERSEDED -- SEE SHEET 7R,
Rev. 9/10/2020.

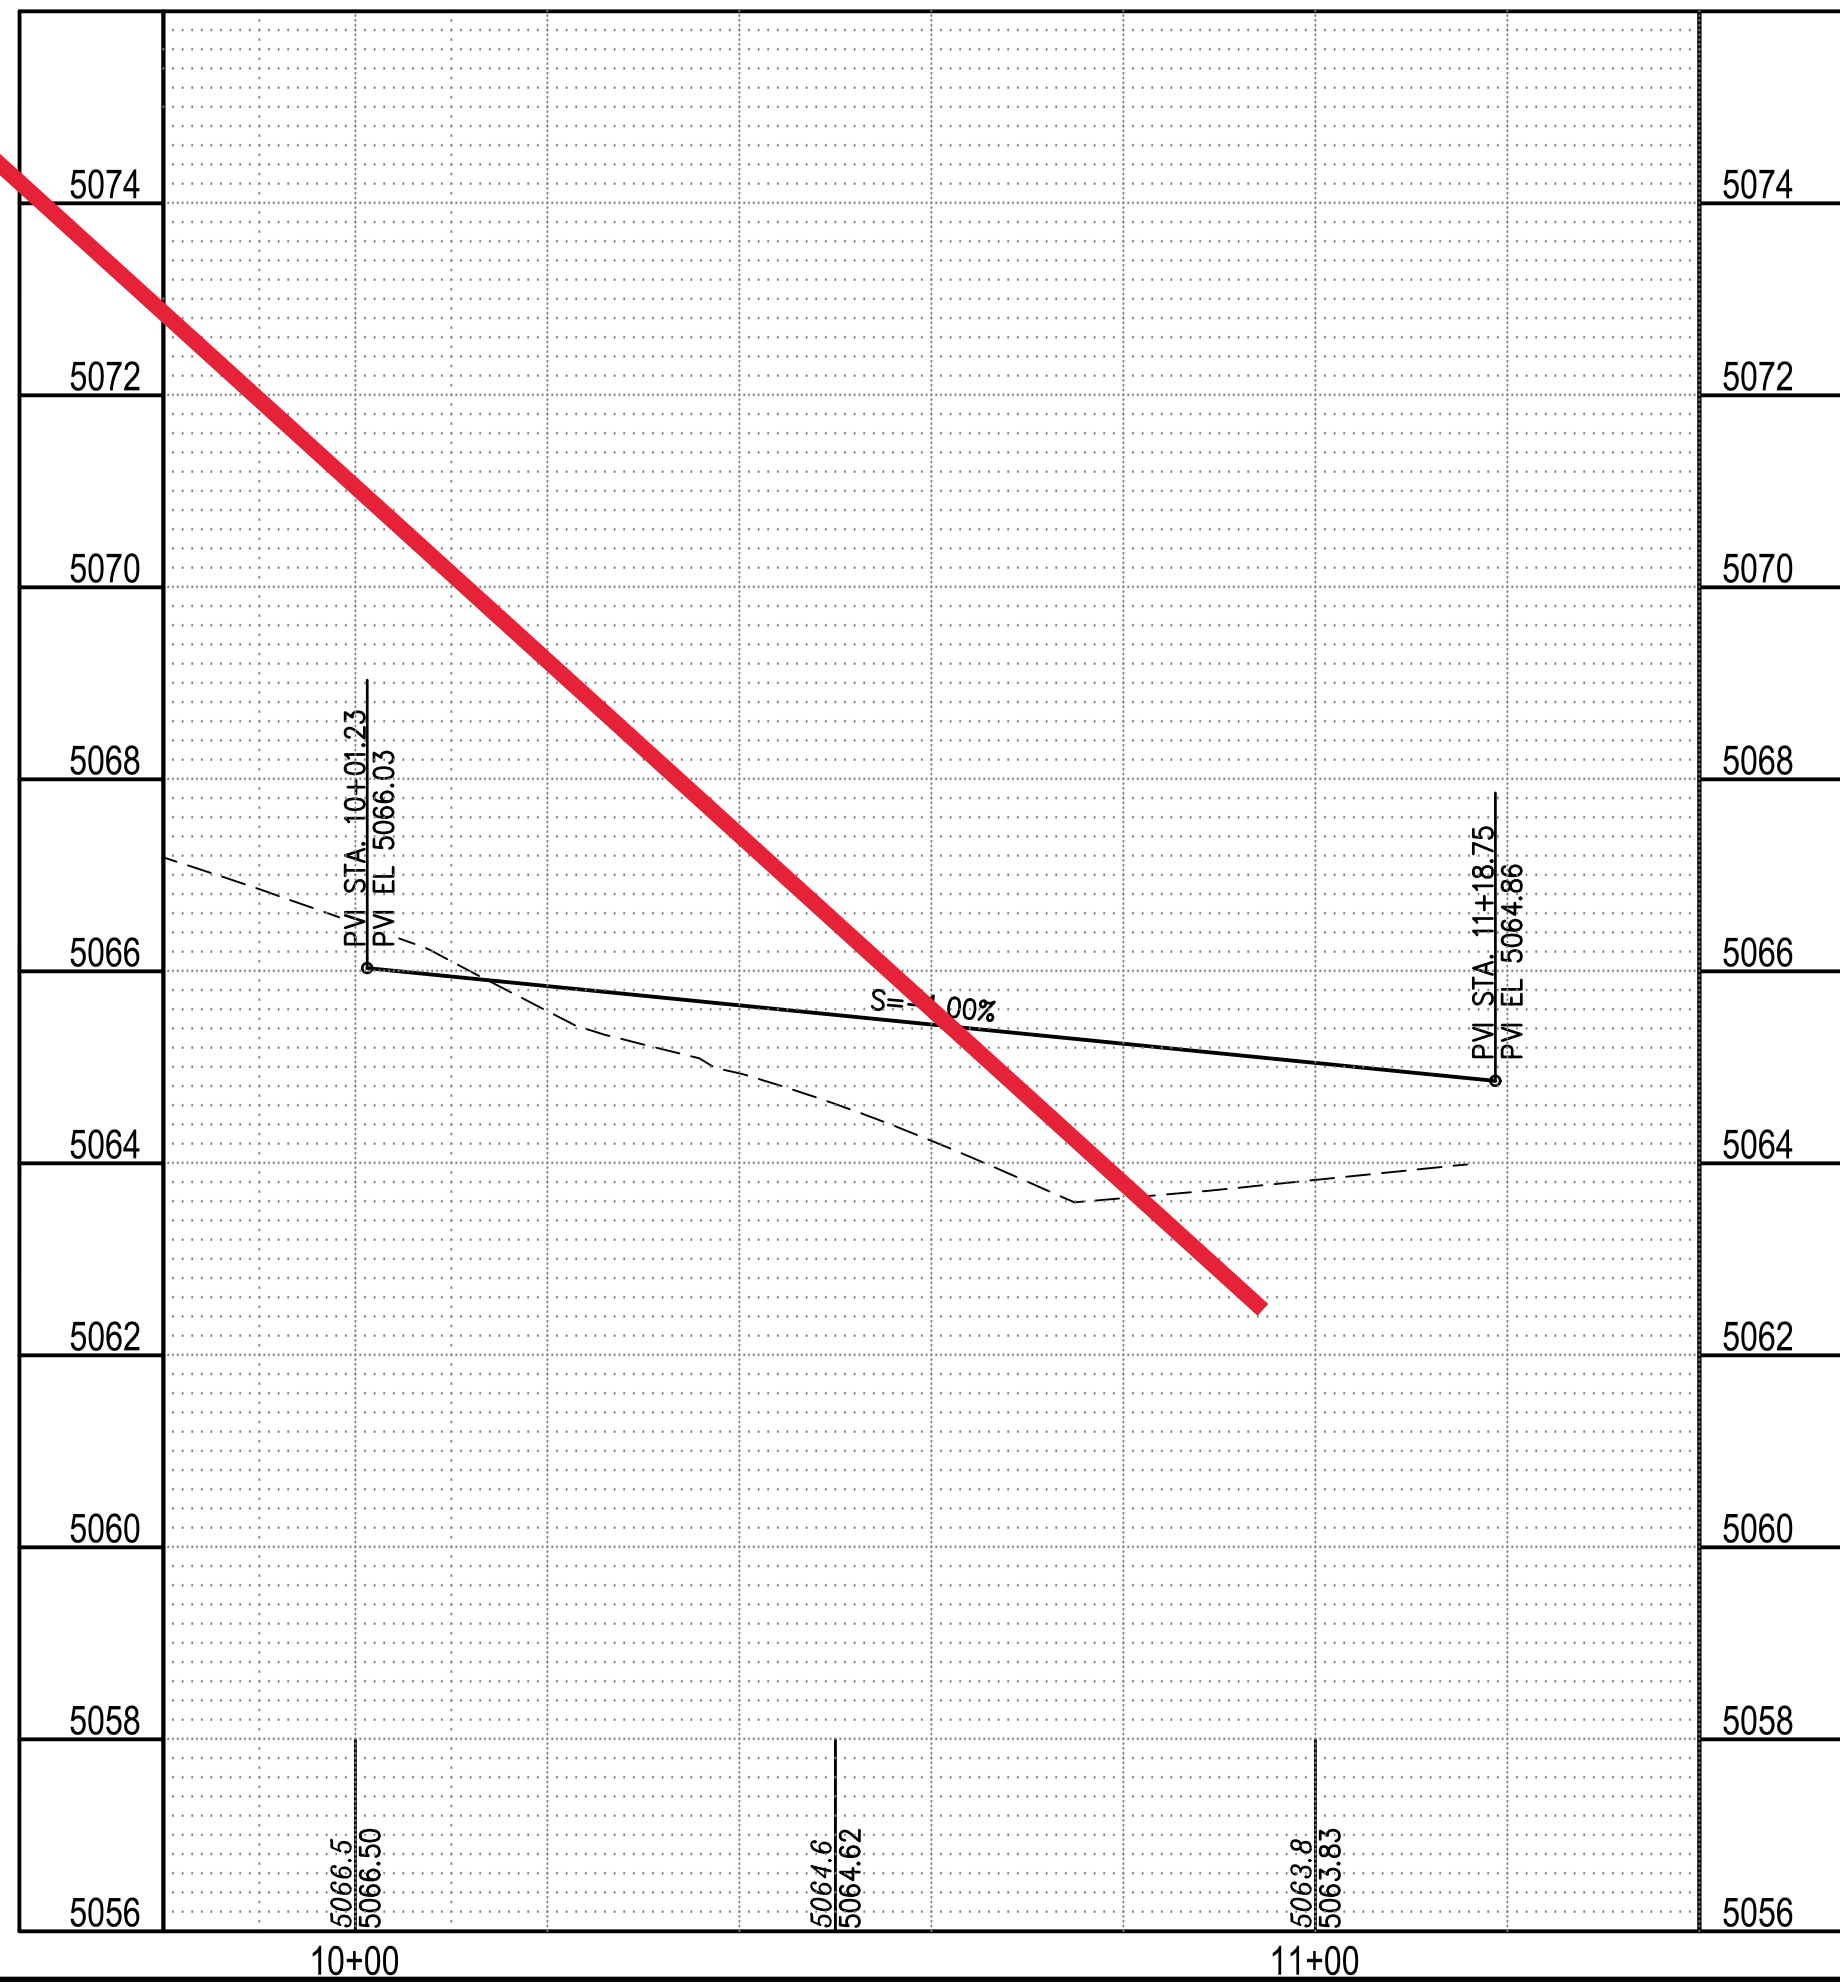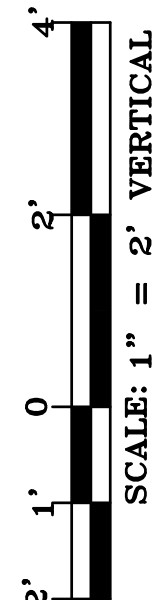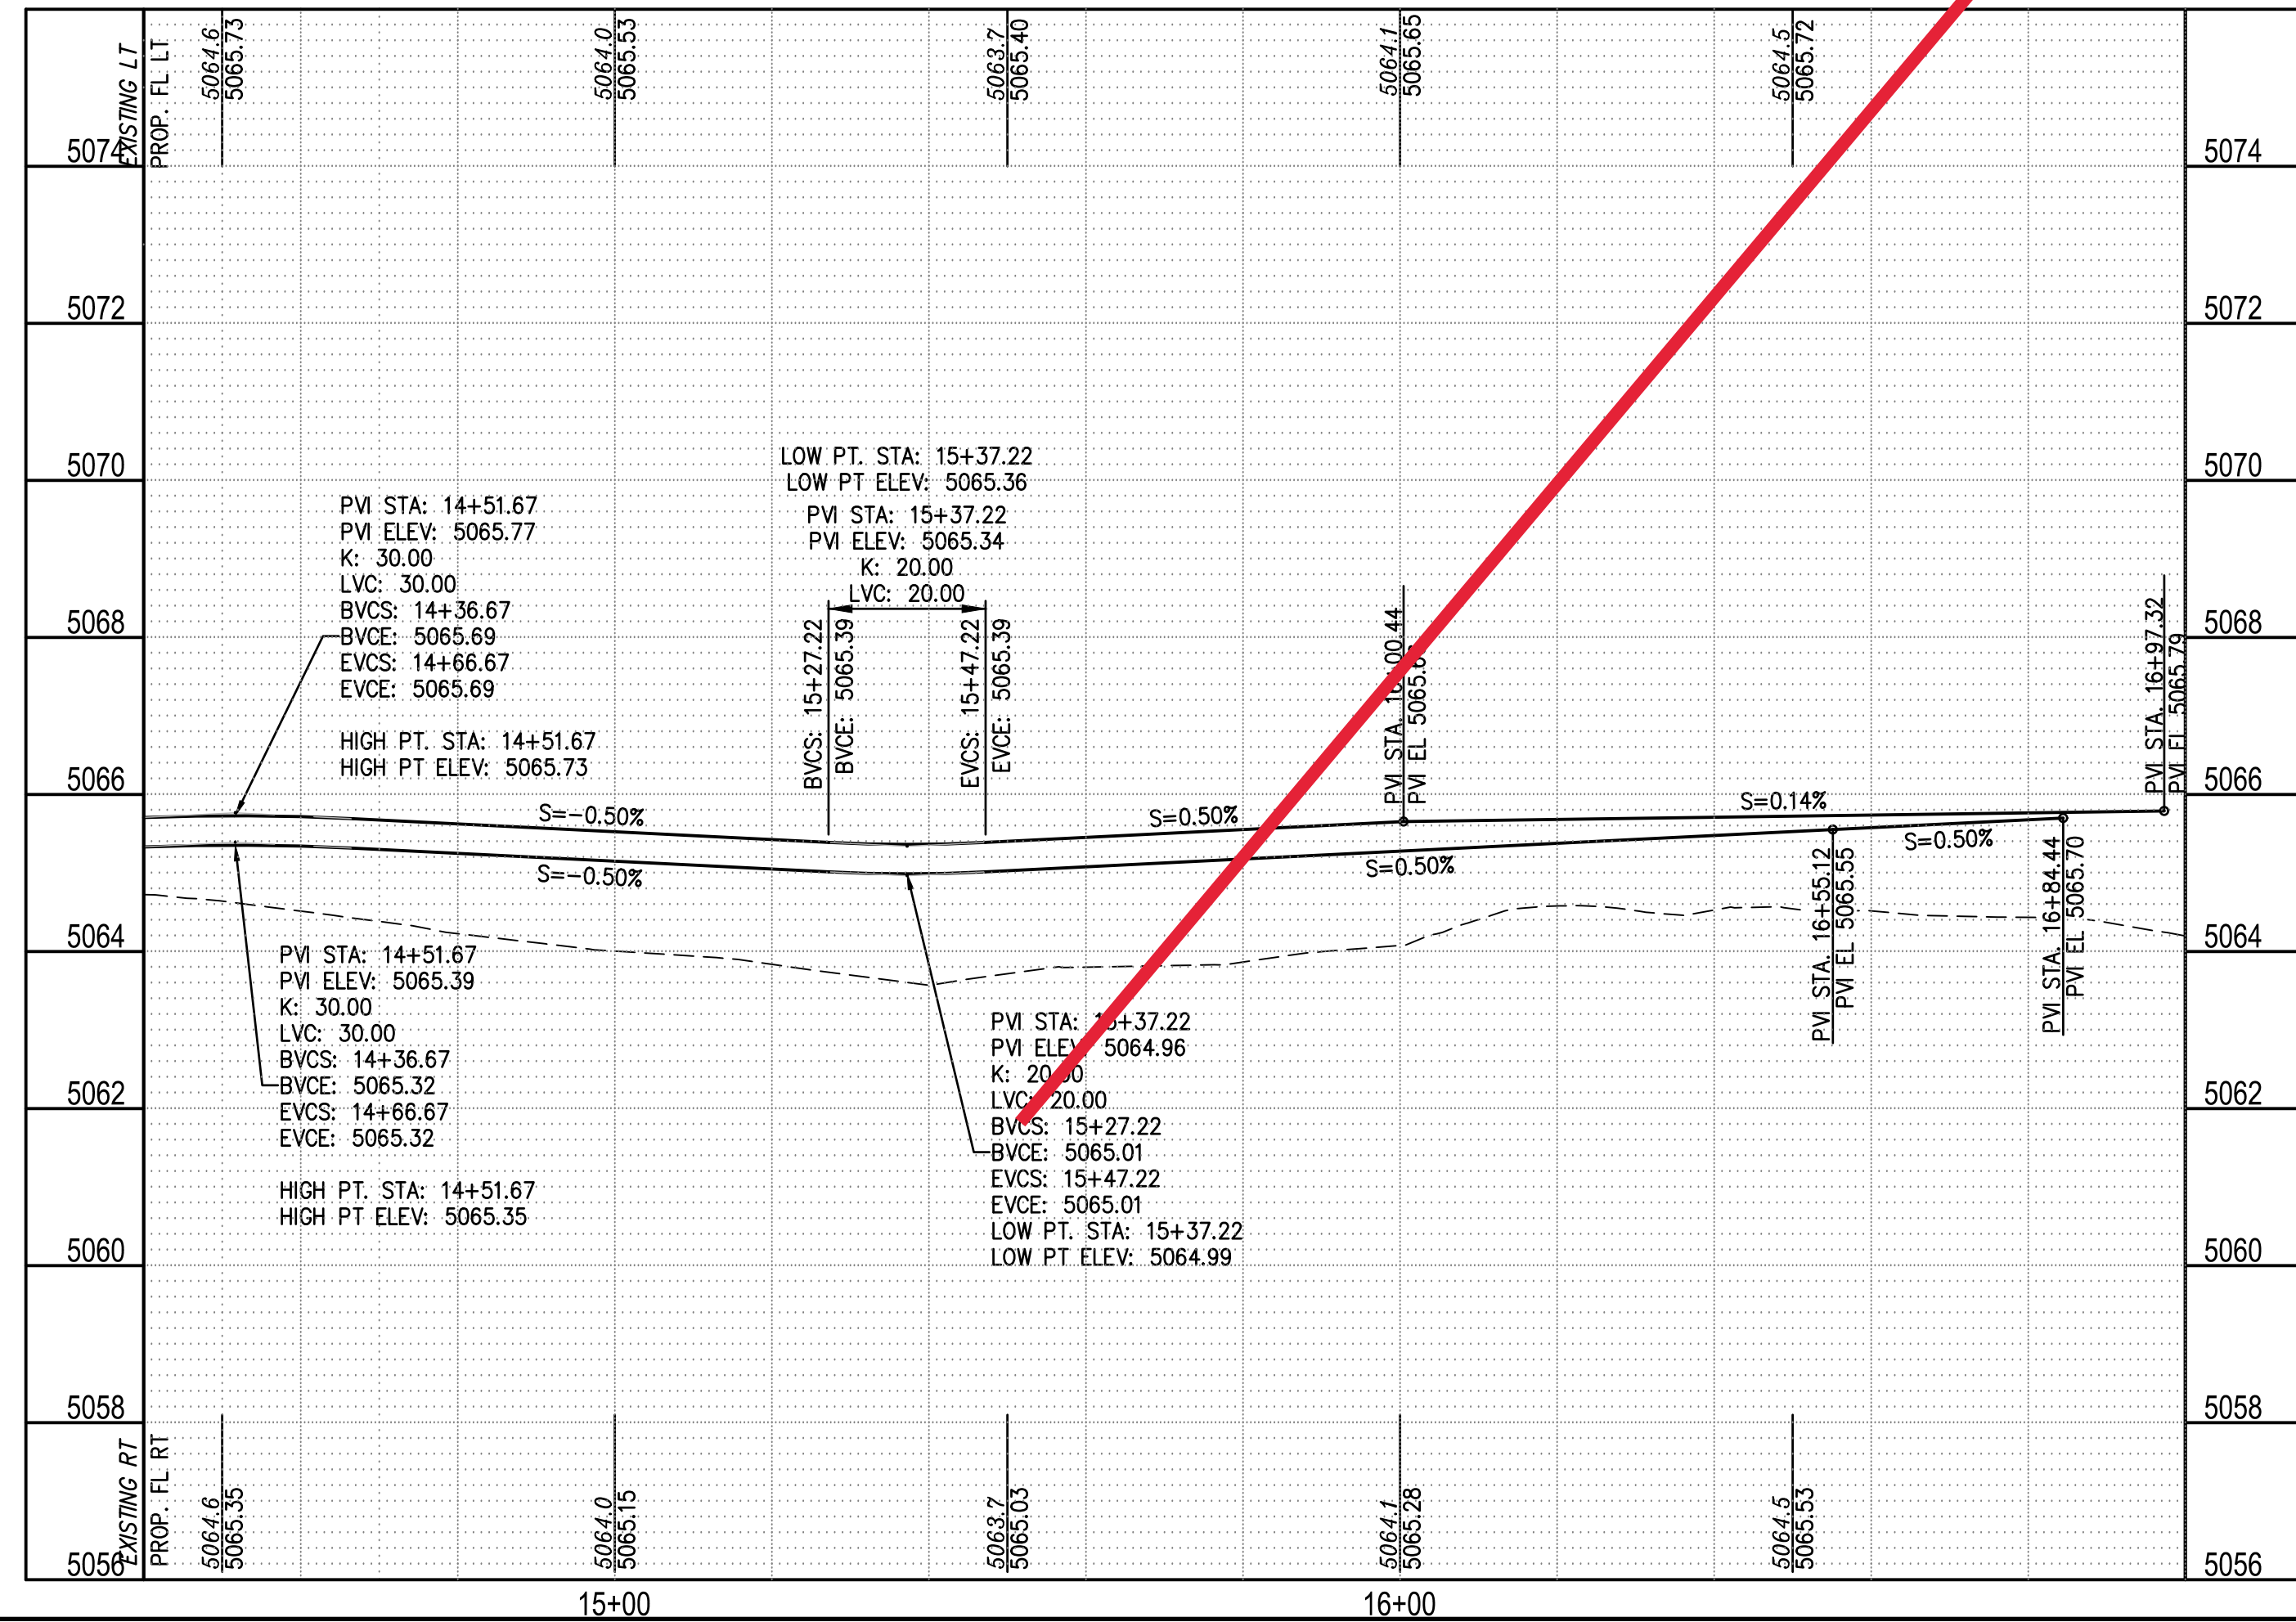

PAVING CONSTRUCTION NOTES	
I.D.#	DESCRIPTION
①	BUILD ASPHALT PAVING, PER TYPICAL SECTION SHEET 9
②	BUILD PCC WHEELCHAIR RAMP, PER DETAIL SHEET 9 AND COA STD. DTL. 2426
③	BUILD PCC STANDARD CURB & GUTTER, PER COA STD. DTL. 2415A
④	BUILD PCC DEPRESSED CURB & GUTTER, PER COA STD. DTL. 2415A
⑤	BUILD PCC MOUNTABLE ROLL-TYPE CURB & GUTTER, PER COA STD. DTL. 2415A
⑥	BUILD PCC RUNDOWN CURB, PER COA STD. DTL. 2415A
⑦	BUILD 4' PCC SIDEWALK, PER COA STD. DTL. 2430
⑧	DRIVEPAD
⑨	PARKING AREA PER DETAIL SHEET 10
⑩	DUMPSTER AREA PER DETAIL SHEET 10
⑪	3' CURB OPENINGS
⑫	INSTALL R1-1-30 STOP SIGN W/ POST, PER COA STD. DTL. 2900-201, 2900-601 AND 2900-702
⑬	DEFERRED 4' PCC SIDEWALK, PER COA STD. DTL. 2430
⑭	BOLLARD PER DETAIL SHEET 9

VISION				& AEROSTAT PLACE				FILE			
LAST DESIGN UPDATE		Mo./DAY/YR.		Mo./DAY/YR.		Mo./DAY/YR.		Mo./DAY/YR.		Mo./DAY/YR.	
SHEET				7				OF			
								15			

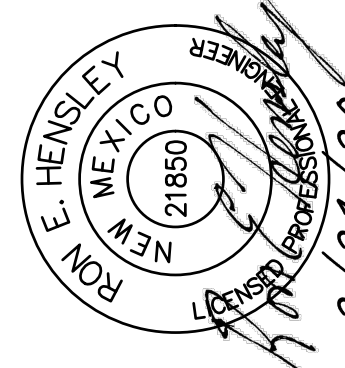ENGINEER'S SEAL		SURVEY INFORMATION		BENCH MARKS		AS BUILT INFORMATION	
		FIELD NOTES		*ACS BM NM 448 N8"		CONTRACTOR	
		NO.	BY	DATE	X=1514.900.643 Y=1512.770.226 (NAD 83),	WORKED BY	DATE
					ELEV=5021.651 (NAVD 1988)	INSPECTOR'S	DATE
						ACCEPTANCE BY	DATE
						MICRO-FILM INFORMATION	
						RECORDED BY	
						NO.	

DESIGNED BY		DATE 10/31/19	
DRAWN BY		DATE 12/07/19	
CHECKED BY		DATE 02/21/20	

REVISIONS	
NO.	DATE
REMARKS	
BY	


THE
group

THE HENSLEY ENGINEERING GROUP
(505) 410-1622



HORIZON VILLAGE SUBDIVISION
HORIZON WAY STA. 14+60 - 17+00 & AEROSTAT PLACE
PAVING PLAN AND PROFILE

DESIGN REVIEW COMMITTEE	CITY ENGINEER APPROVAL	Mo./DAY/YR.	Mo./DAY/YR.
APPROVED July 21, 2020 DESIGN REVIEW COMMITTEE	APPROVED Aug 6, 2020 CITY ENGINEER		

CITY PROJECT No. 799782	ZONE MAP NO. C-17	SHEET 7 OF 15
-------------------------	-------------------	---------------



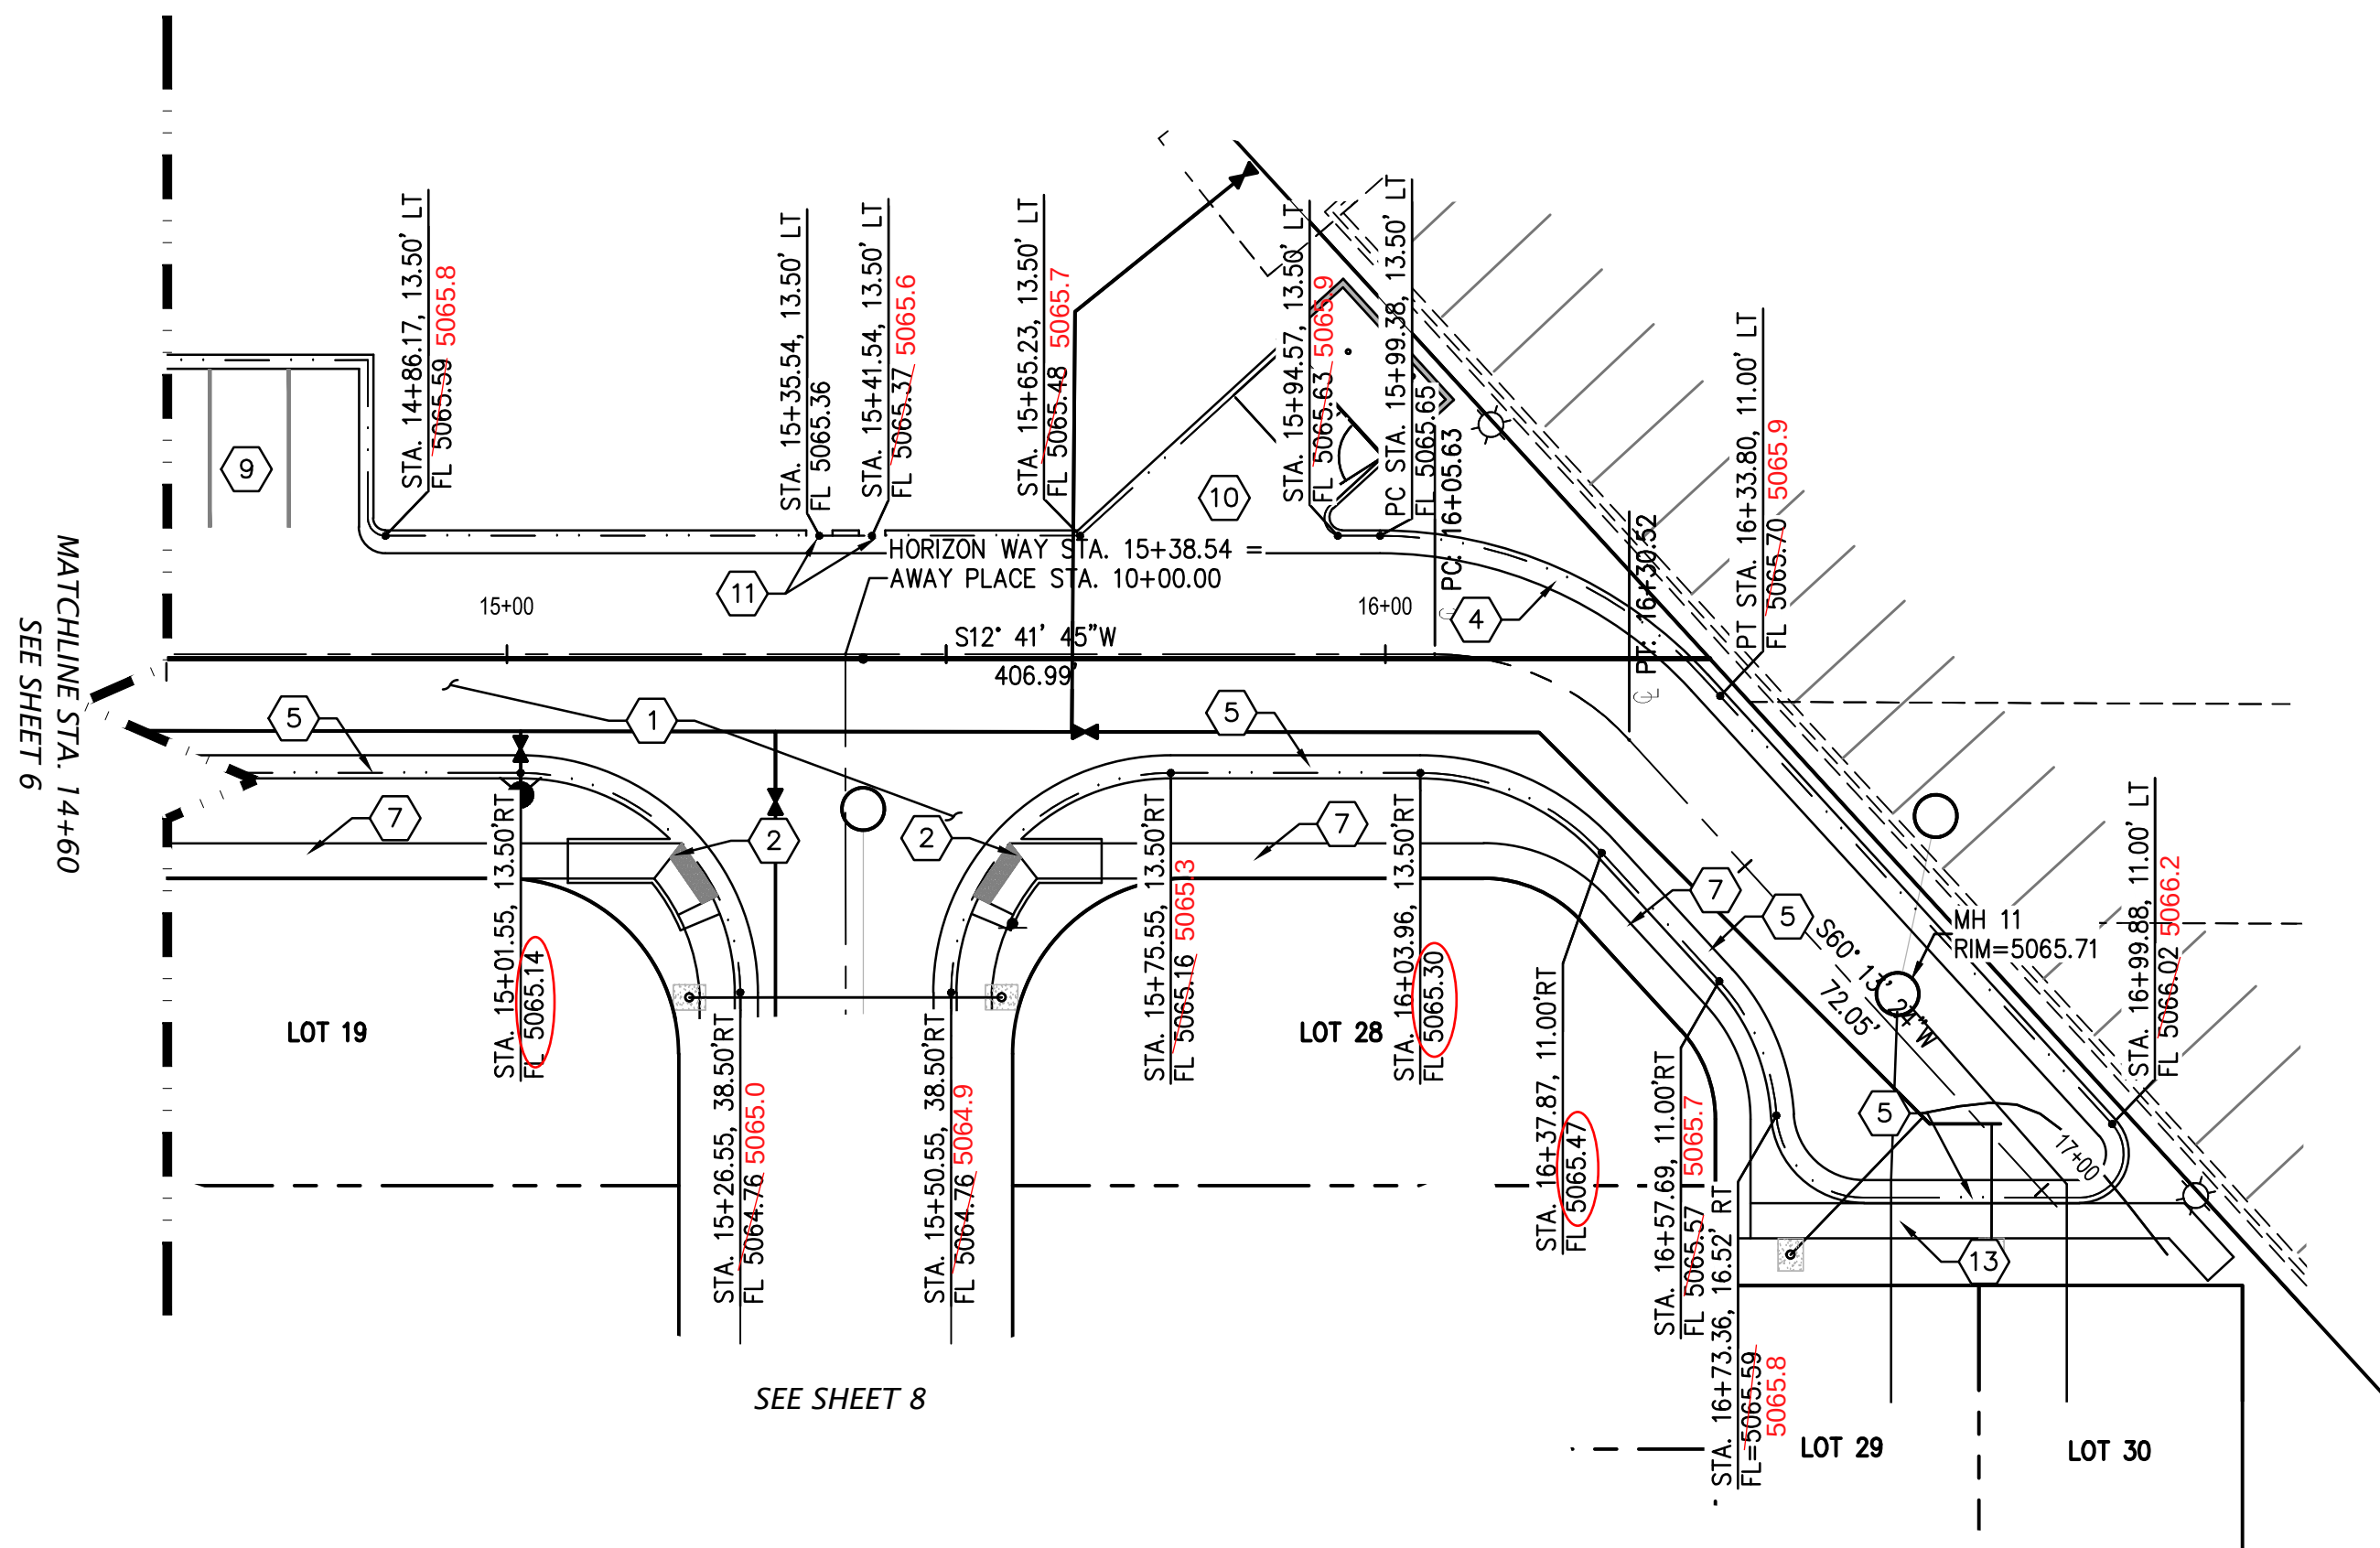



HORIZON WAY STA. 14+60 - 17+00

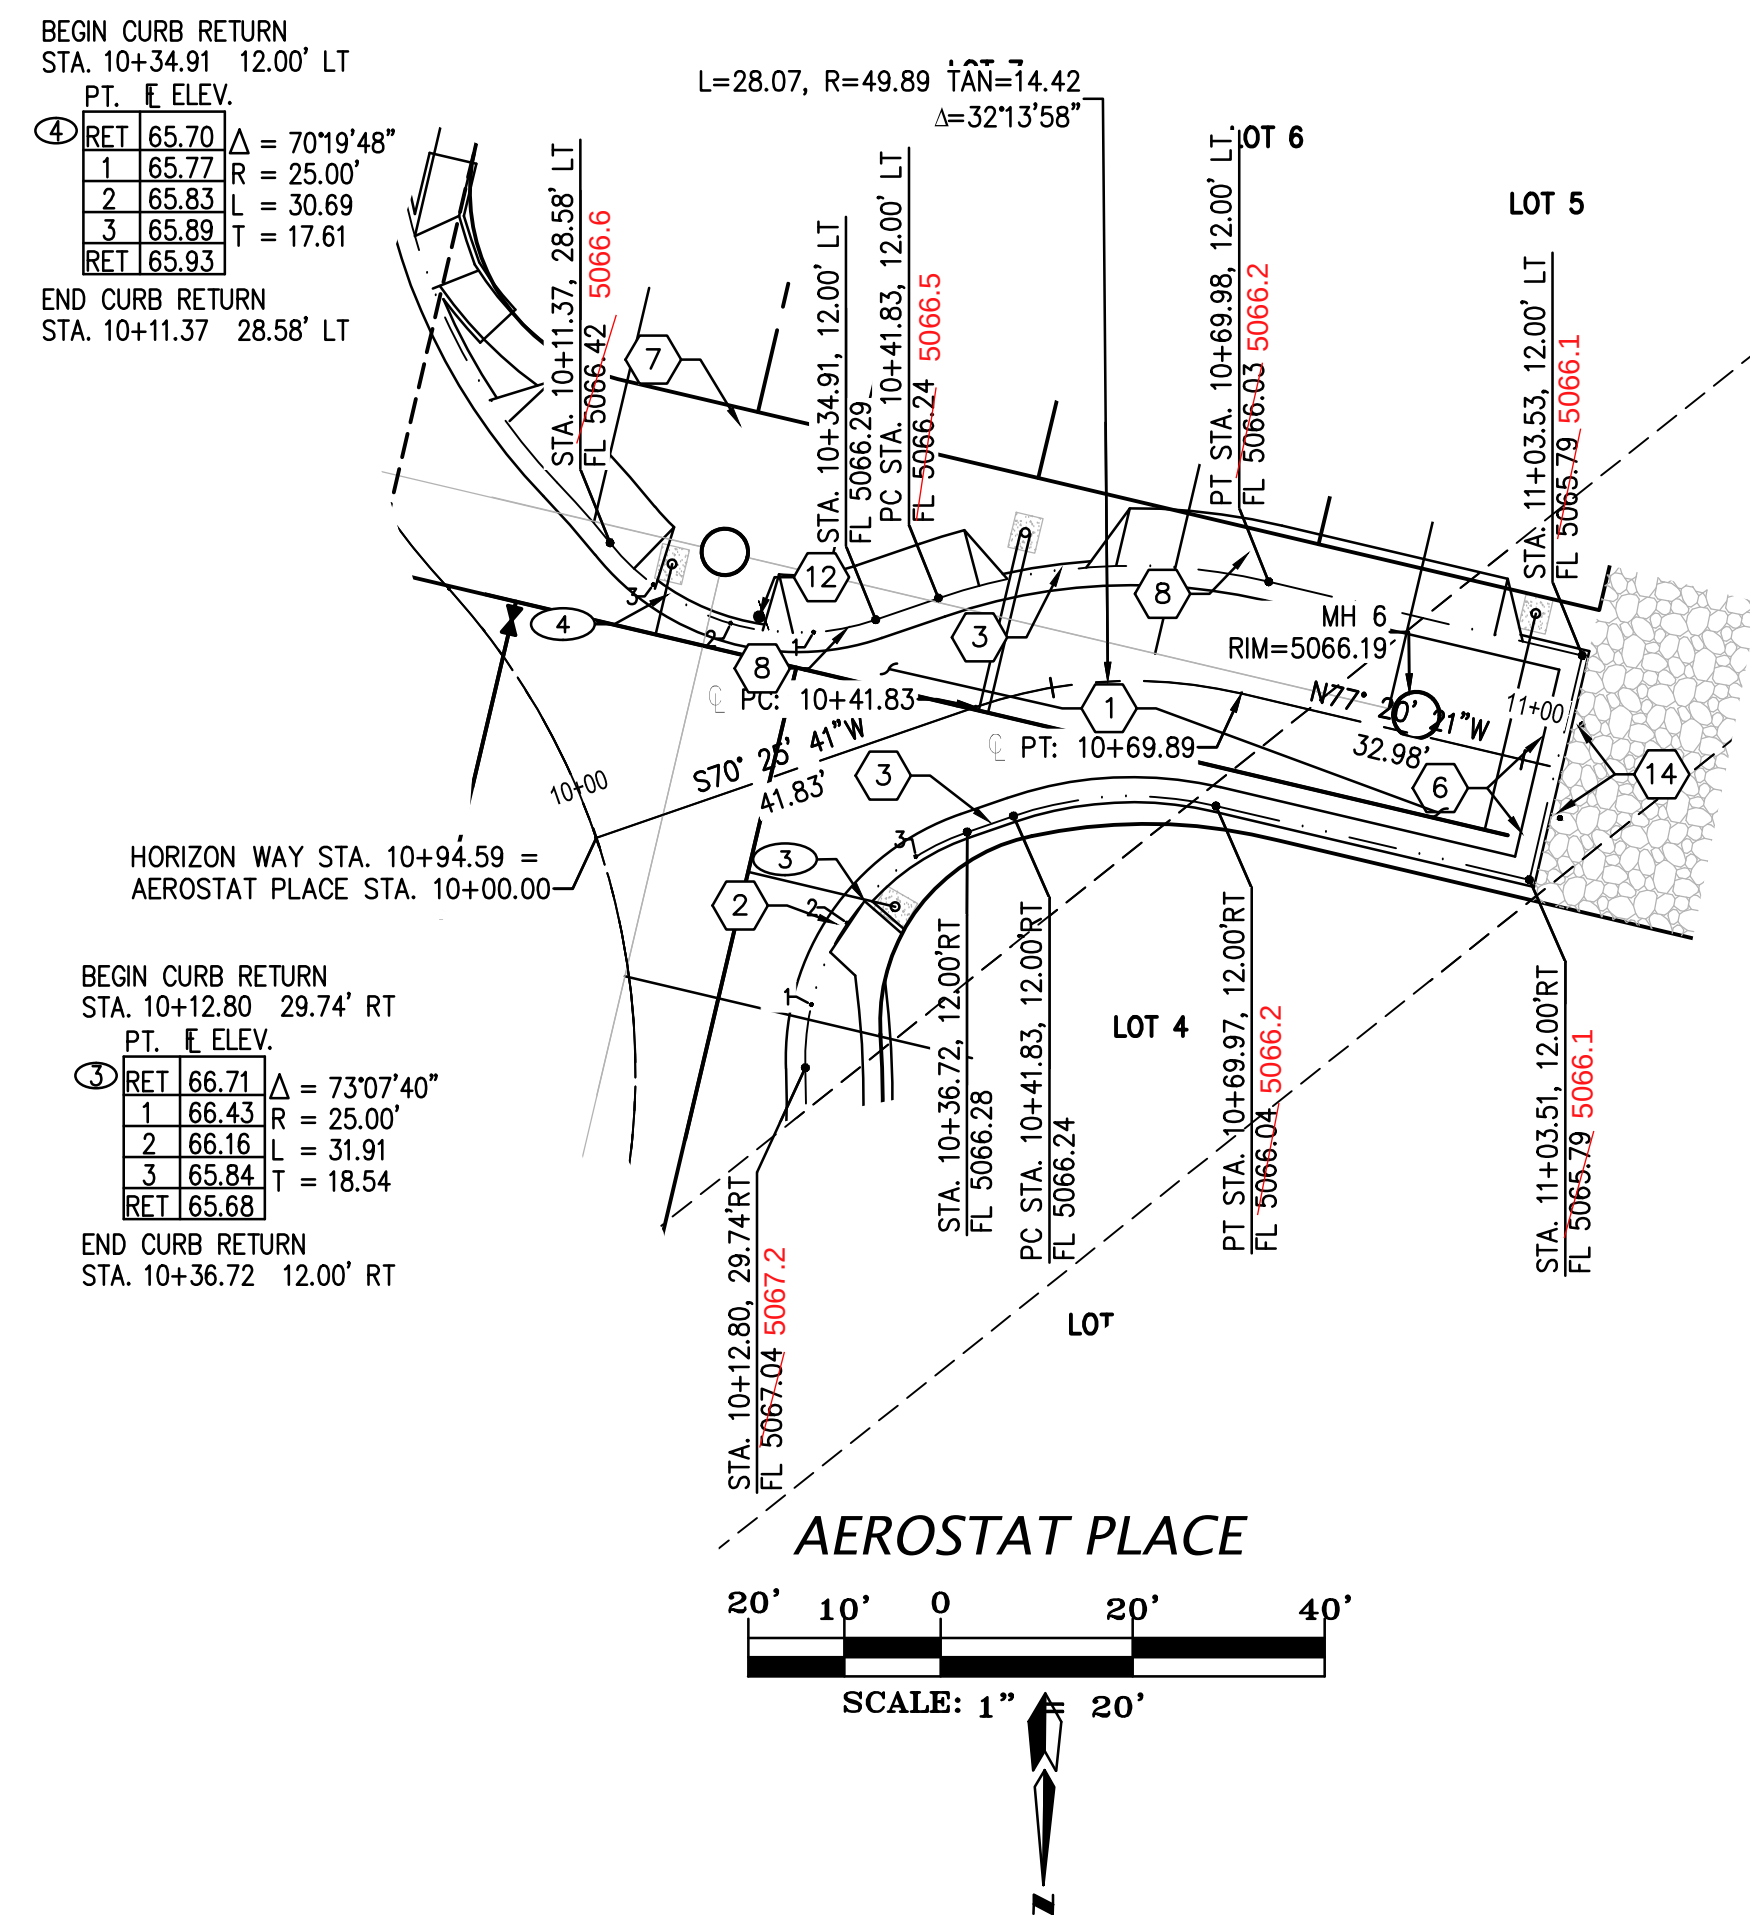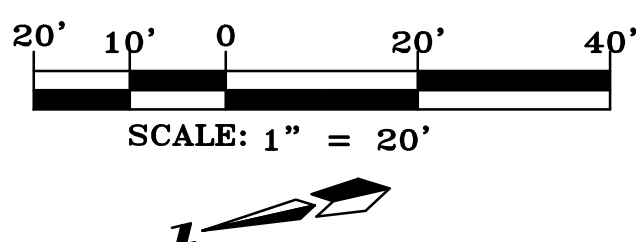

PAVING CONSTRUCTION NOTES	
I.D. #	DESCRIPTION
1	BUILD ASPHALT PAVING, PER TYPICAL SECTION SHEET 9
2	BUILD PCC WHEELCHAIR RAMP, PER DETAIL SHEET 9 AND COA STD. DTL. 2426
3	BUILD PCC STANDARD CURB & GUTTER, PER COA STD. DTL. 2415A
4	BUILD PCC DEPRESSED CURB & GUTTER, PER COA STD. DTL. 2415A
5	BUILD PCC MOUNTABLE ROLL-TYPE CURB & GUTTER, PER COA STD. DTL. 2415A
6	BUILD PCC RUNDOWN CURB, PER COA STD. DTL. 2415A
7	BUILD 4' PCC SIDEWALK, PER COA STD. DTL. 2430
8	BUILD DRIVEPAD PER COA STD. DTL. 2425
9	PARKING AREA PER DETAIL SHEET 10
10	DUMPSTER AREA PER DETAIL SHEET 10
11	3' CURB OPENINGS
12	INSTALL R1-1-30 STOP SIGN W/ POST, PER COA STD. DTLs. 2900-201, 2900-601 AND 2900-702
13	DEFERRED 4' PCC SIDEWALK, PER COA STD. DTL. 2430
14	BOLLARD PER DETAIL SHEET 9

SURVEY INFORMATION		BENCH MARKS		AS BUILT INFORMATION	
NO.	FIELD NOTES		"ACS BM NM 448 NB"	CONTRACTOR	DATE
	BY	DATE			
			X=1,514,900.643 Y=1,512,770.226 (NAD 83), ELEV=5021.651 (NAD 1986)	WORK INSPECTED BY ACCEPTANCE BY FIELD MODIFICATION BY DRAWINGS CORRECTED BY	CARTESIAN SURVEYS DATE 7/20-1/21 CARTESIAN SURVEYS DATE 2/21 MICRO-FILM INFORMATION
				RECORDED BY	DATE
				NO.	

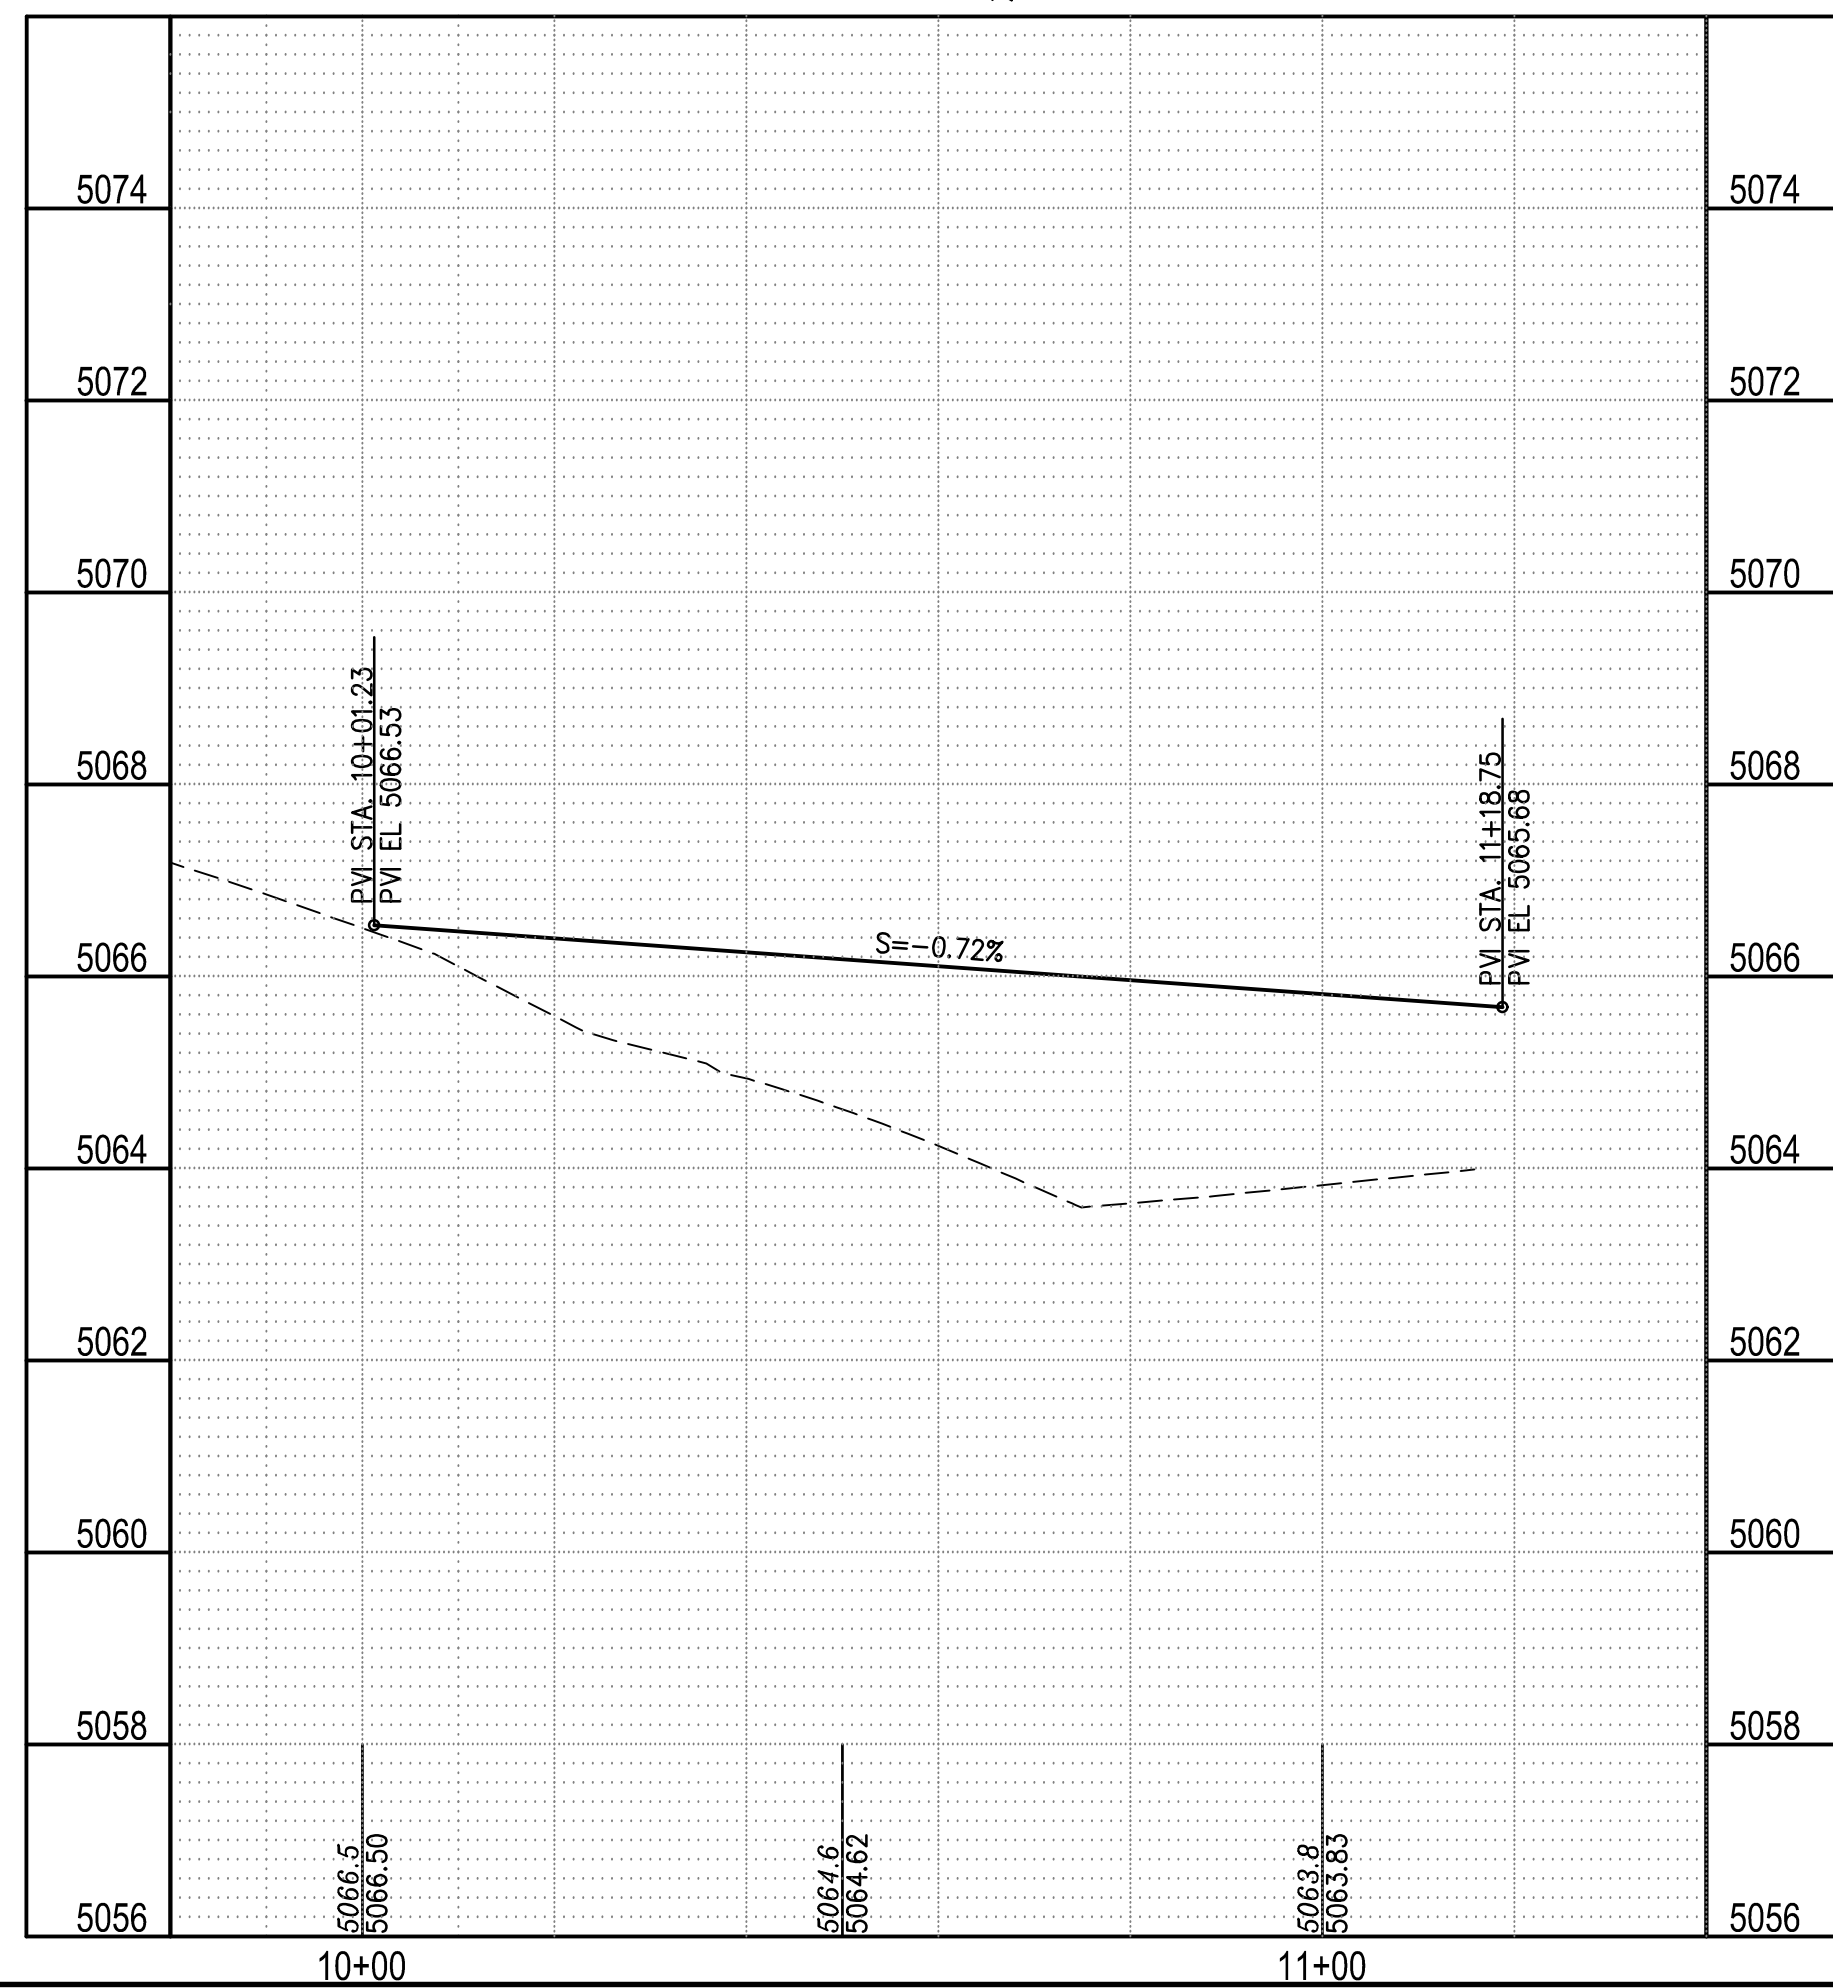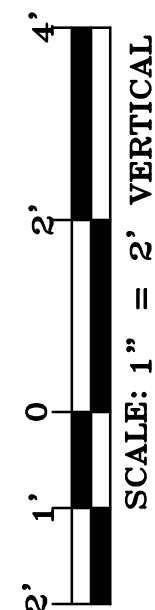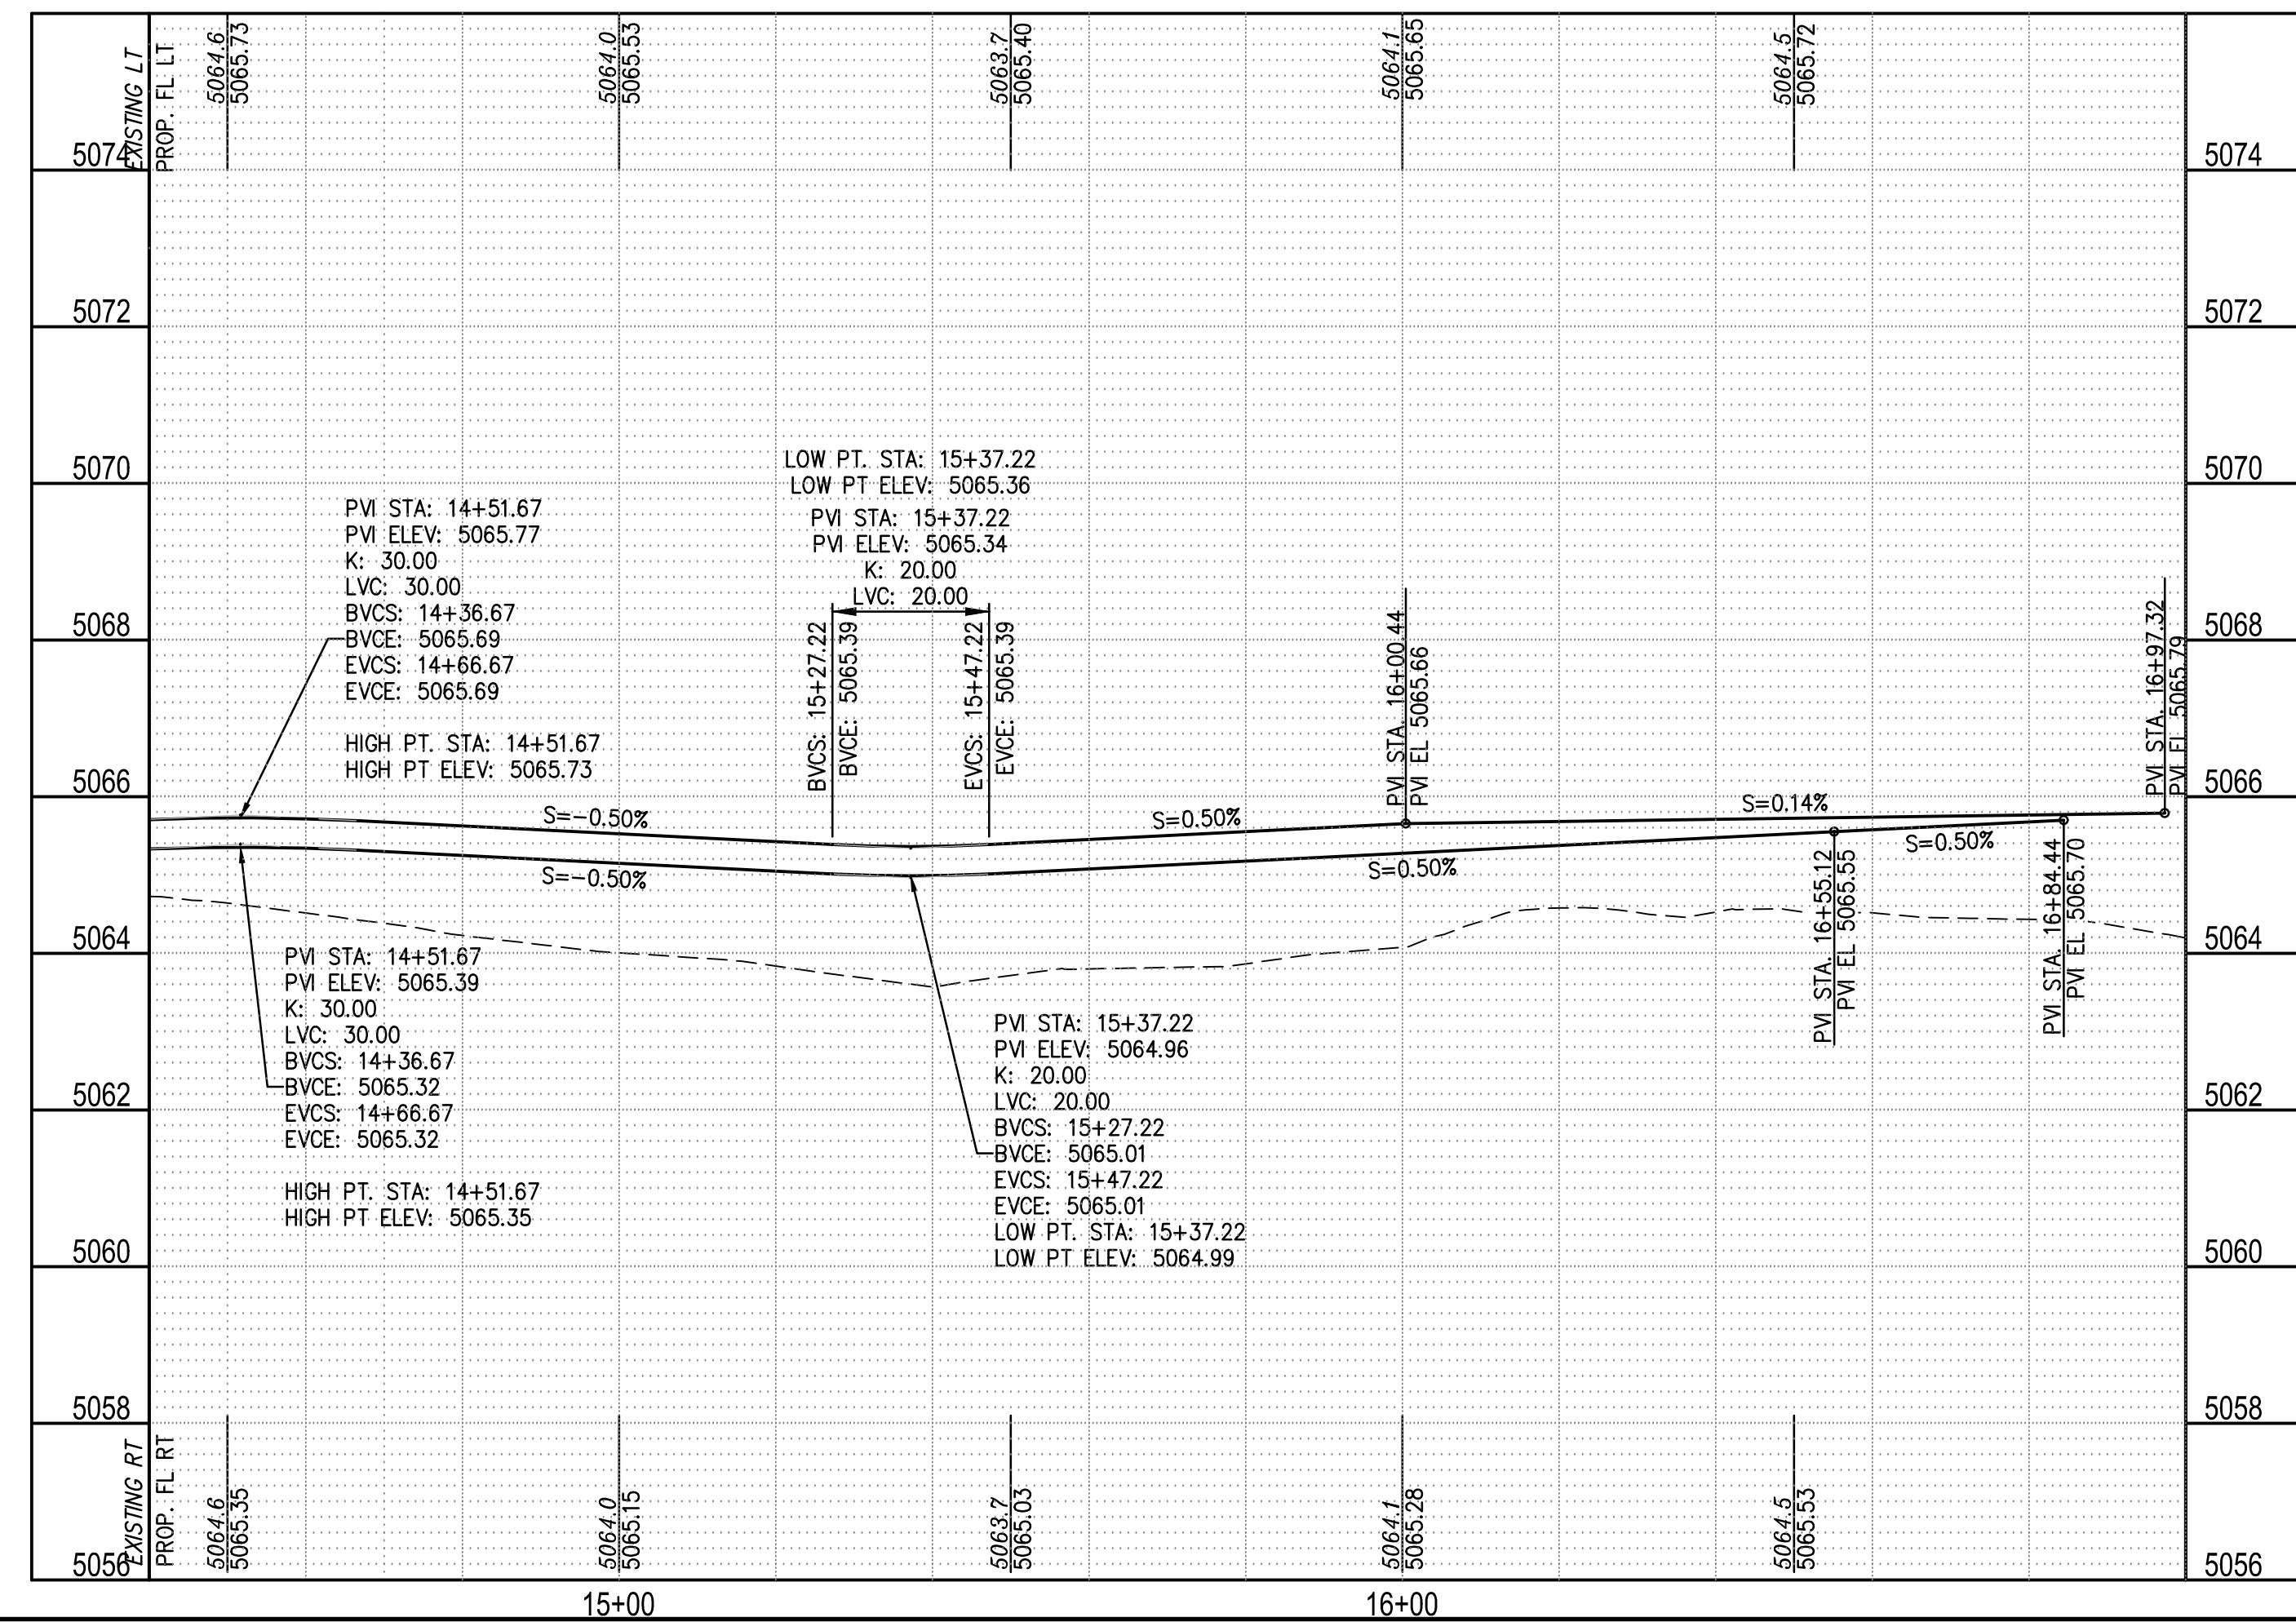

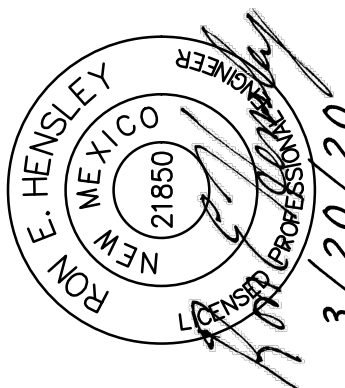 THE <i>group</i> THE HENSLEY ENGINEERING GROUP (505) 410-1622						ENGINEER'S SEAL			
		SEWER DEPTH REVISION							
1		8/25/20							
		NO.	DATE	REMARKS	BY				
		REVSIONS							
		DESIGN							
		DESIGNED BY	REH	DATE	10/31/19				
		DRAWN BY	REH	DATE	12/07/19				
		CHECKED BY	REH	DATE	02/21/20				


HORIZON VILLAGE SUBDIVISION HORIZON WAY STA. 14+60 – 17+00 & AEROSTAT PLACE PAVING PLAN AND PROFILE													
DESIGN REVIEW COMMITTEE 		CITY ENGINEER APPROVAL 		LAST DESIGN UPDATE <table border="1"> <thead> <tr> <th>Mo./DAY/YR.</th> <th>Mo./DAY/YR.</th> </tr> </thead> <tbody> <tr><td> </td><td> </td></tr> <tr><td> </td><td> </td></tr> <tr><td> </td><td> </td></tr> </tbody> </table>		Mo./DAY/YR.	Mo./DAY/YR.						
Mo./DAY/YR.	Mo./DAY/YR.												
CITY PROJECT No. 799782		ZONE MAP NO. C-17		SHEET 7 OF 15									

BEGIN CURB RETURN
STA. 10+44.37 13.00' LT
PT. E ELEV.
RET 64.47 Δ = 90°00'00"
1 64.62 R = 25.00'
2 64.77 L = 39.27'
3 64.93 T = 25.00'
RET 65.02
END CURB RETURN
STA. 10+19.38 38.00' LT


BEGIN CURB RETURN
STA. 10+19.38 38.00' RT
PT. E ELEV.
RET 65.36 Δ = 90°00'00"
1 65.15 R = 25.00'
2 64.94 L = 39.27'
3 64.64 T = 25.00'
RET 64.47
END CURB RETURN
STA. 10+41.25 14.00' RT

BEGIN CURB RETURN
STA. 10+38.50 12.00' LT
PT. E ELEV.
RET 64.76 Δ = 90°00'00"
1 64.86 R = 15.00'
2 64.96 L = 23.56'
3 65.09 T = 15.00'
RET 65.16
END CURB RETURN
STA. 10+13.50 37.00' LT


BEGIN CURB RETURN
STA. 10+13.50 37.00' RT
PT. E ELEV.
RET 65.14 Δ = 90°00'00"
1 65.05 R = 15.00'
2 64.95 L = 23.56'
3 64.83 T = 15.00'
RET 64.76
END CURB RETURN
STA. 10+38.50 12.00' RT

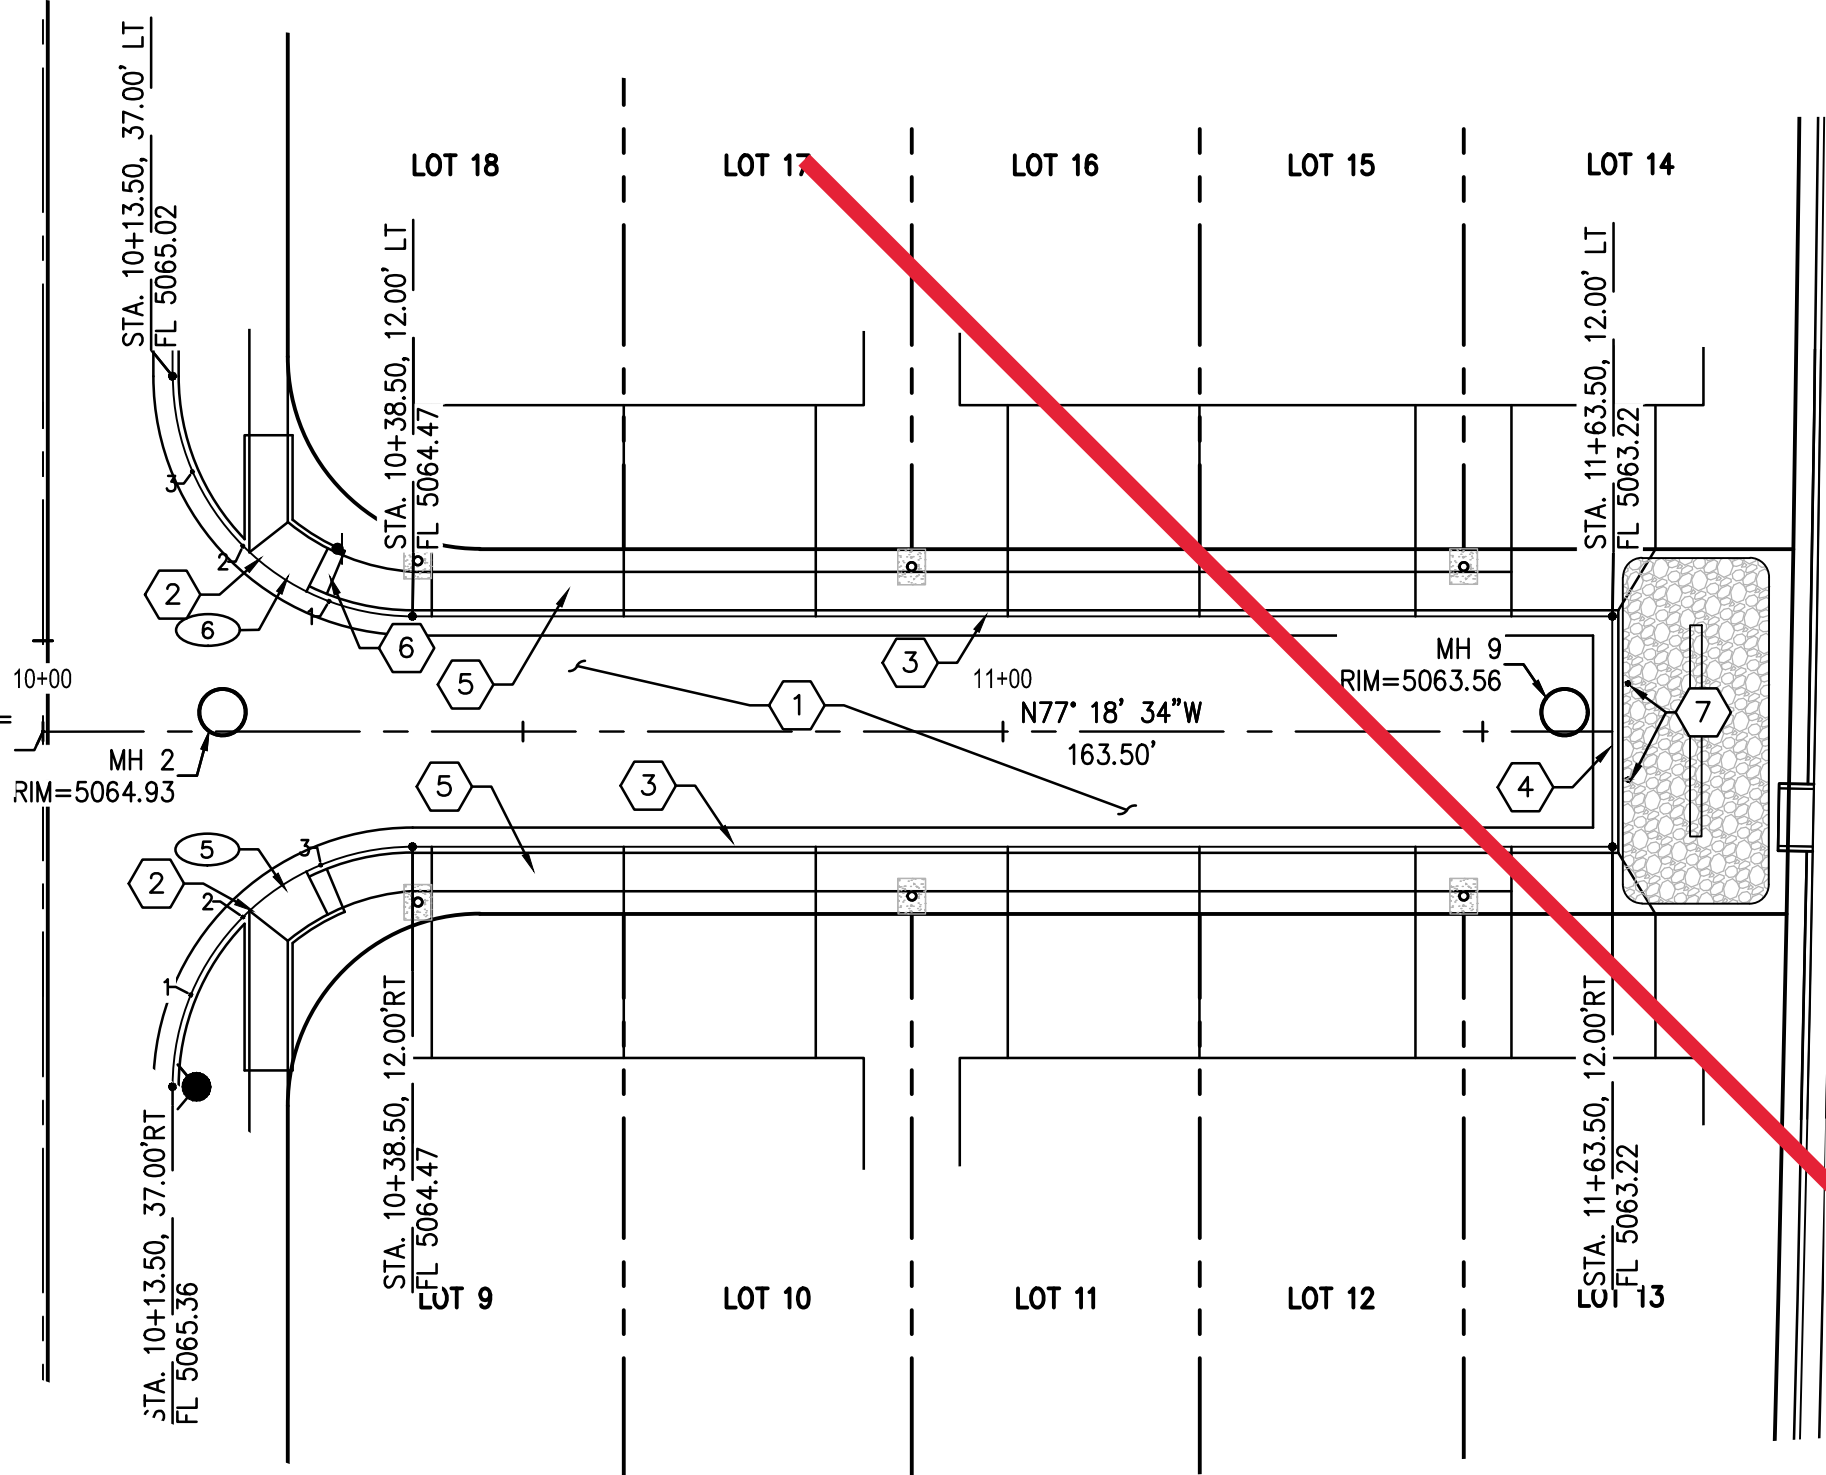





ALOFT PLACE

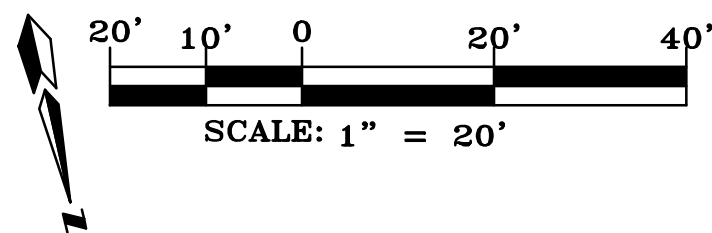

HORIZON WAY STA. 15+38.55 =
AWAY PLACE STA. 10+00.00

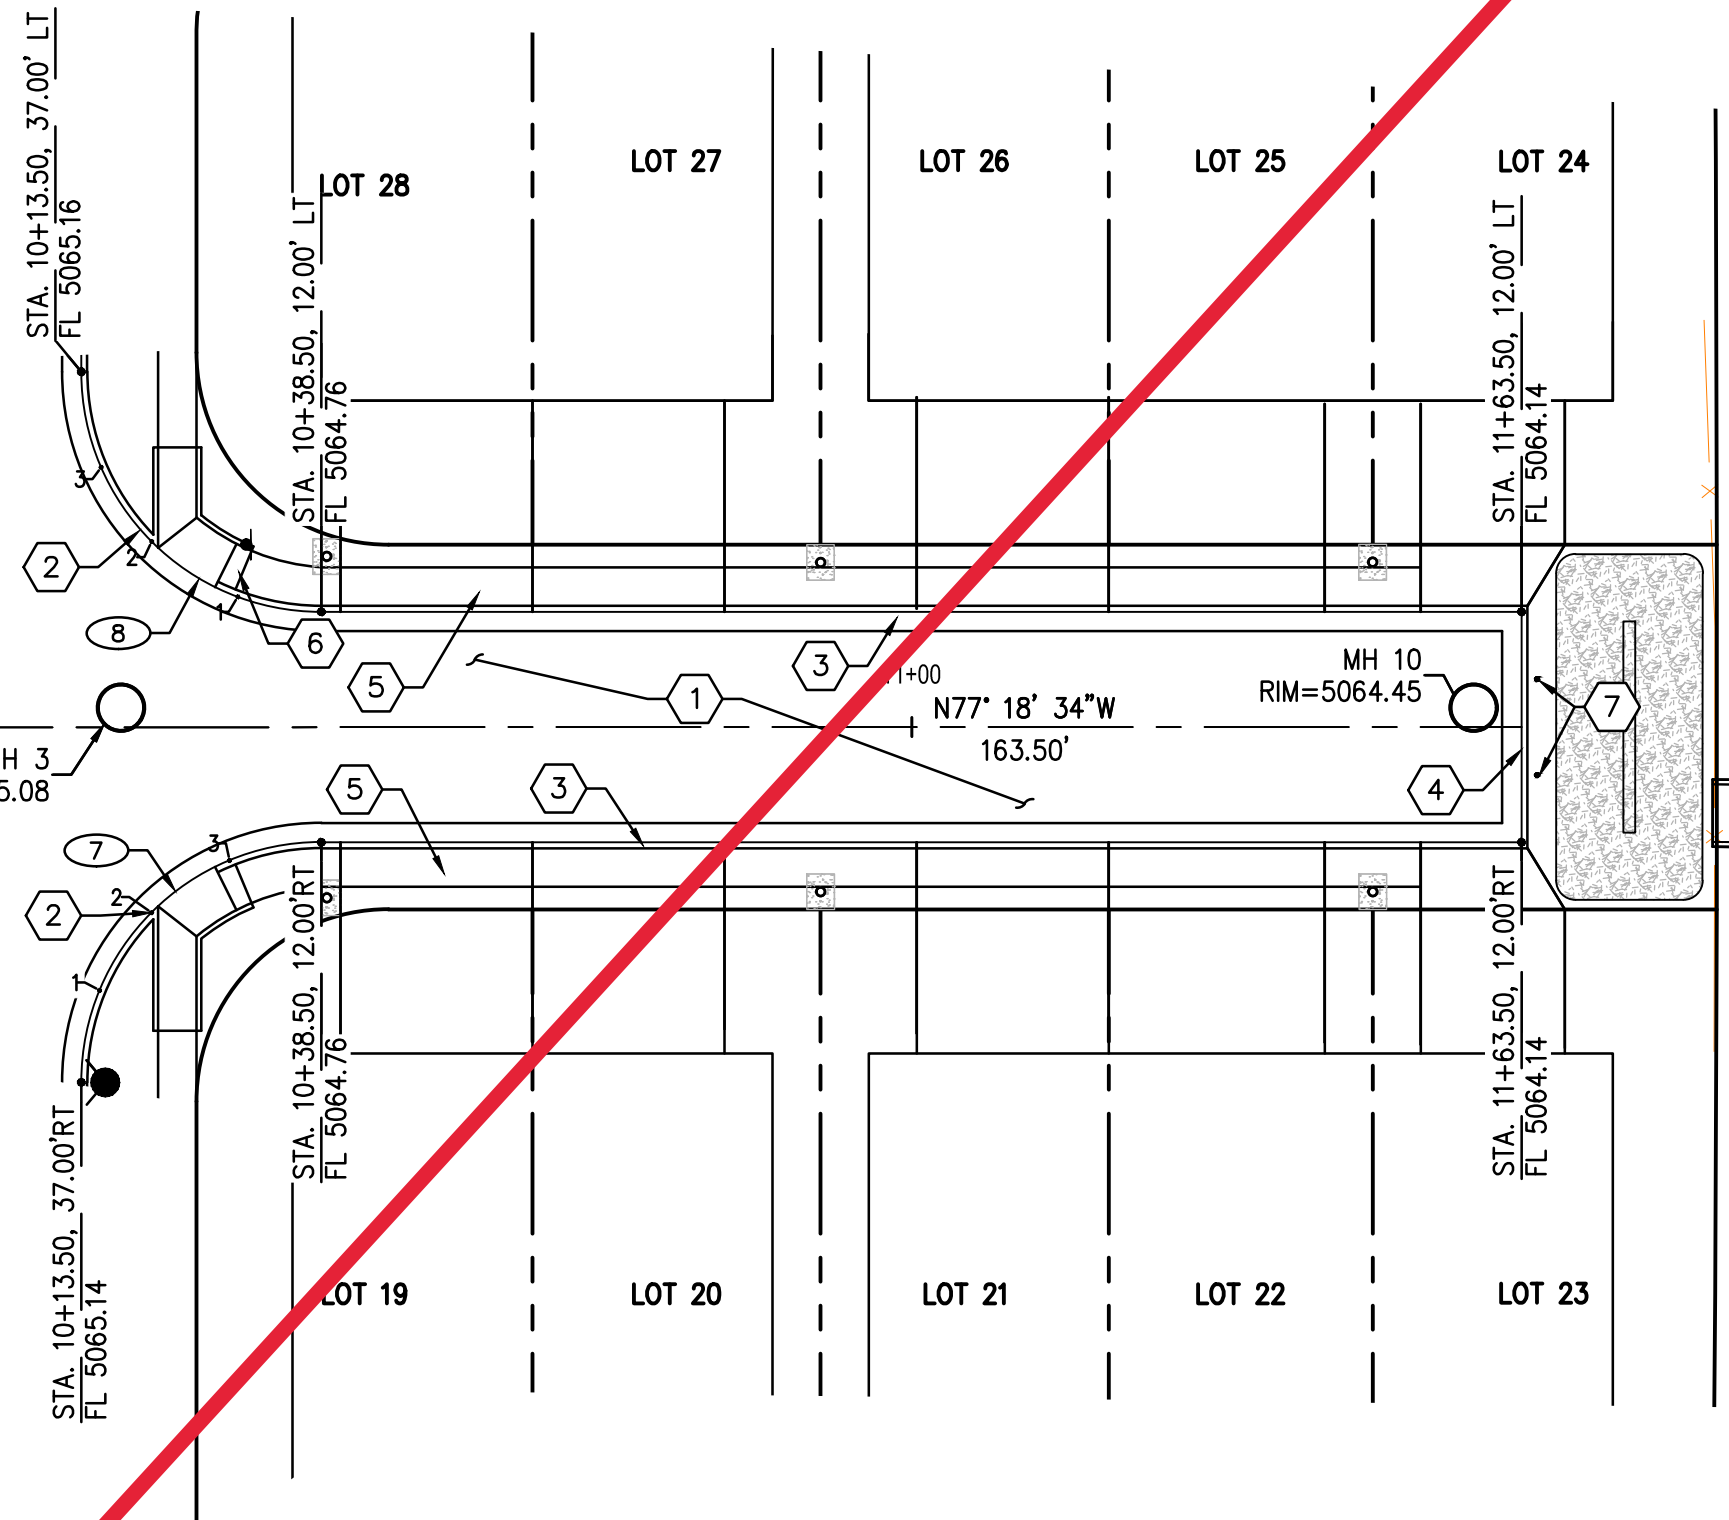


SUPERSEDED -- SEE SHEET 8R, Rev. 9/10/2020.

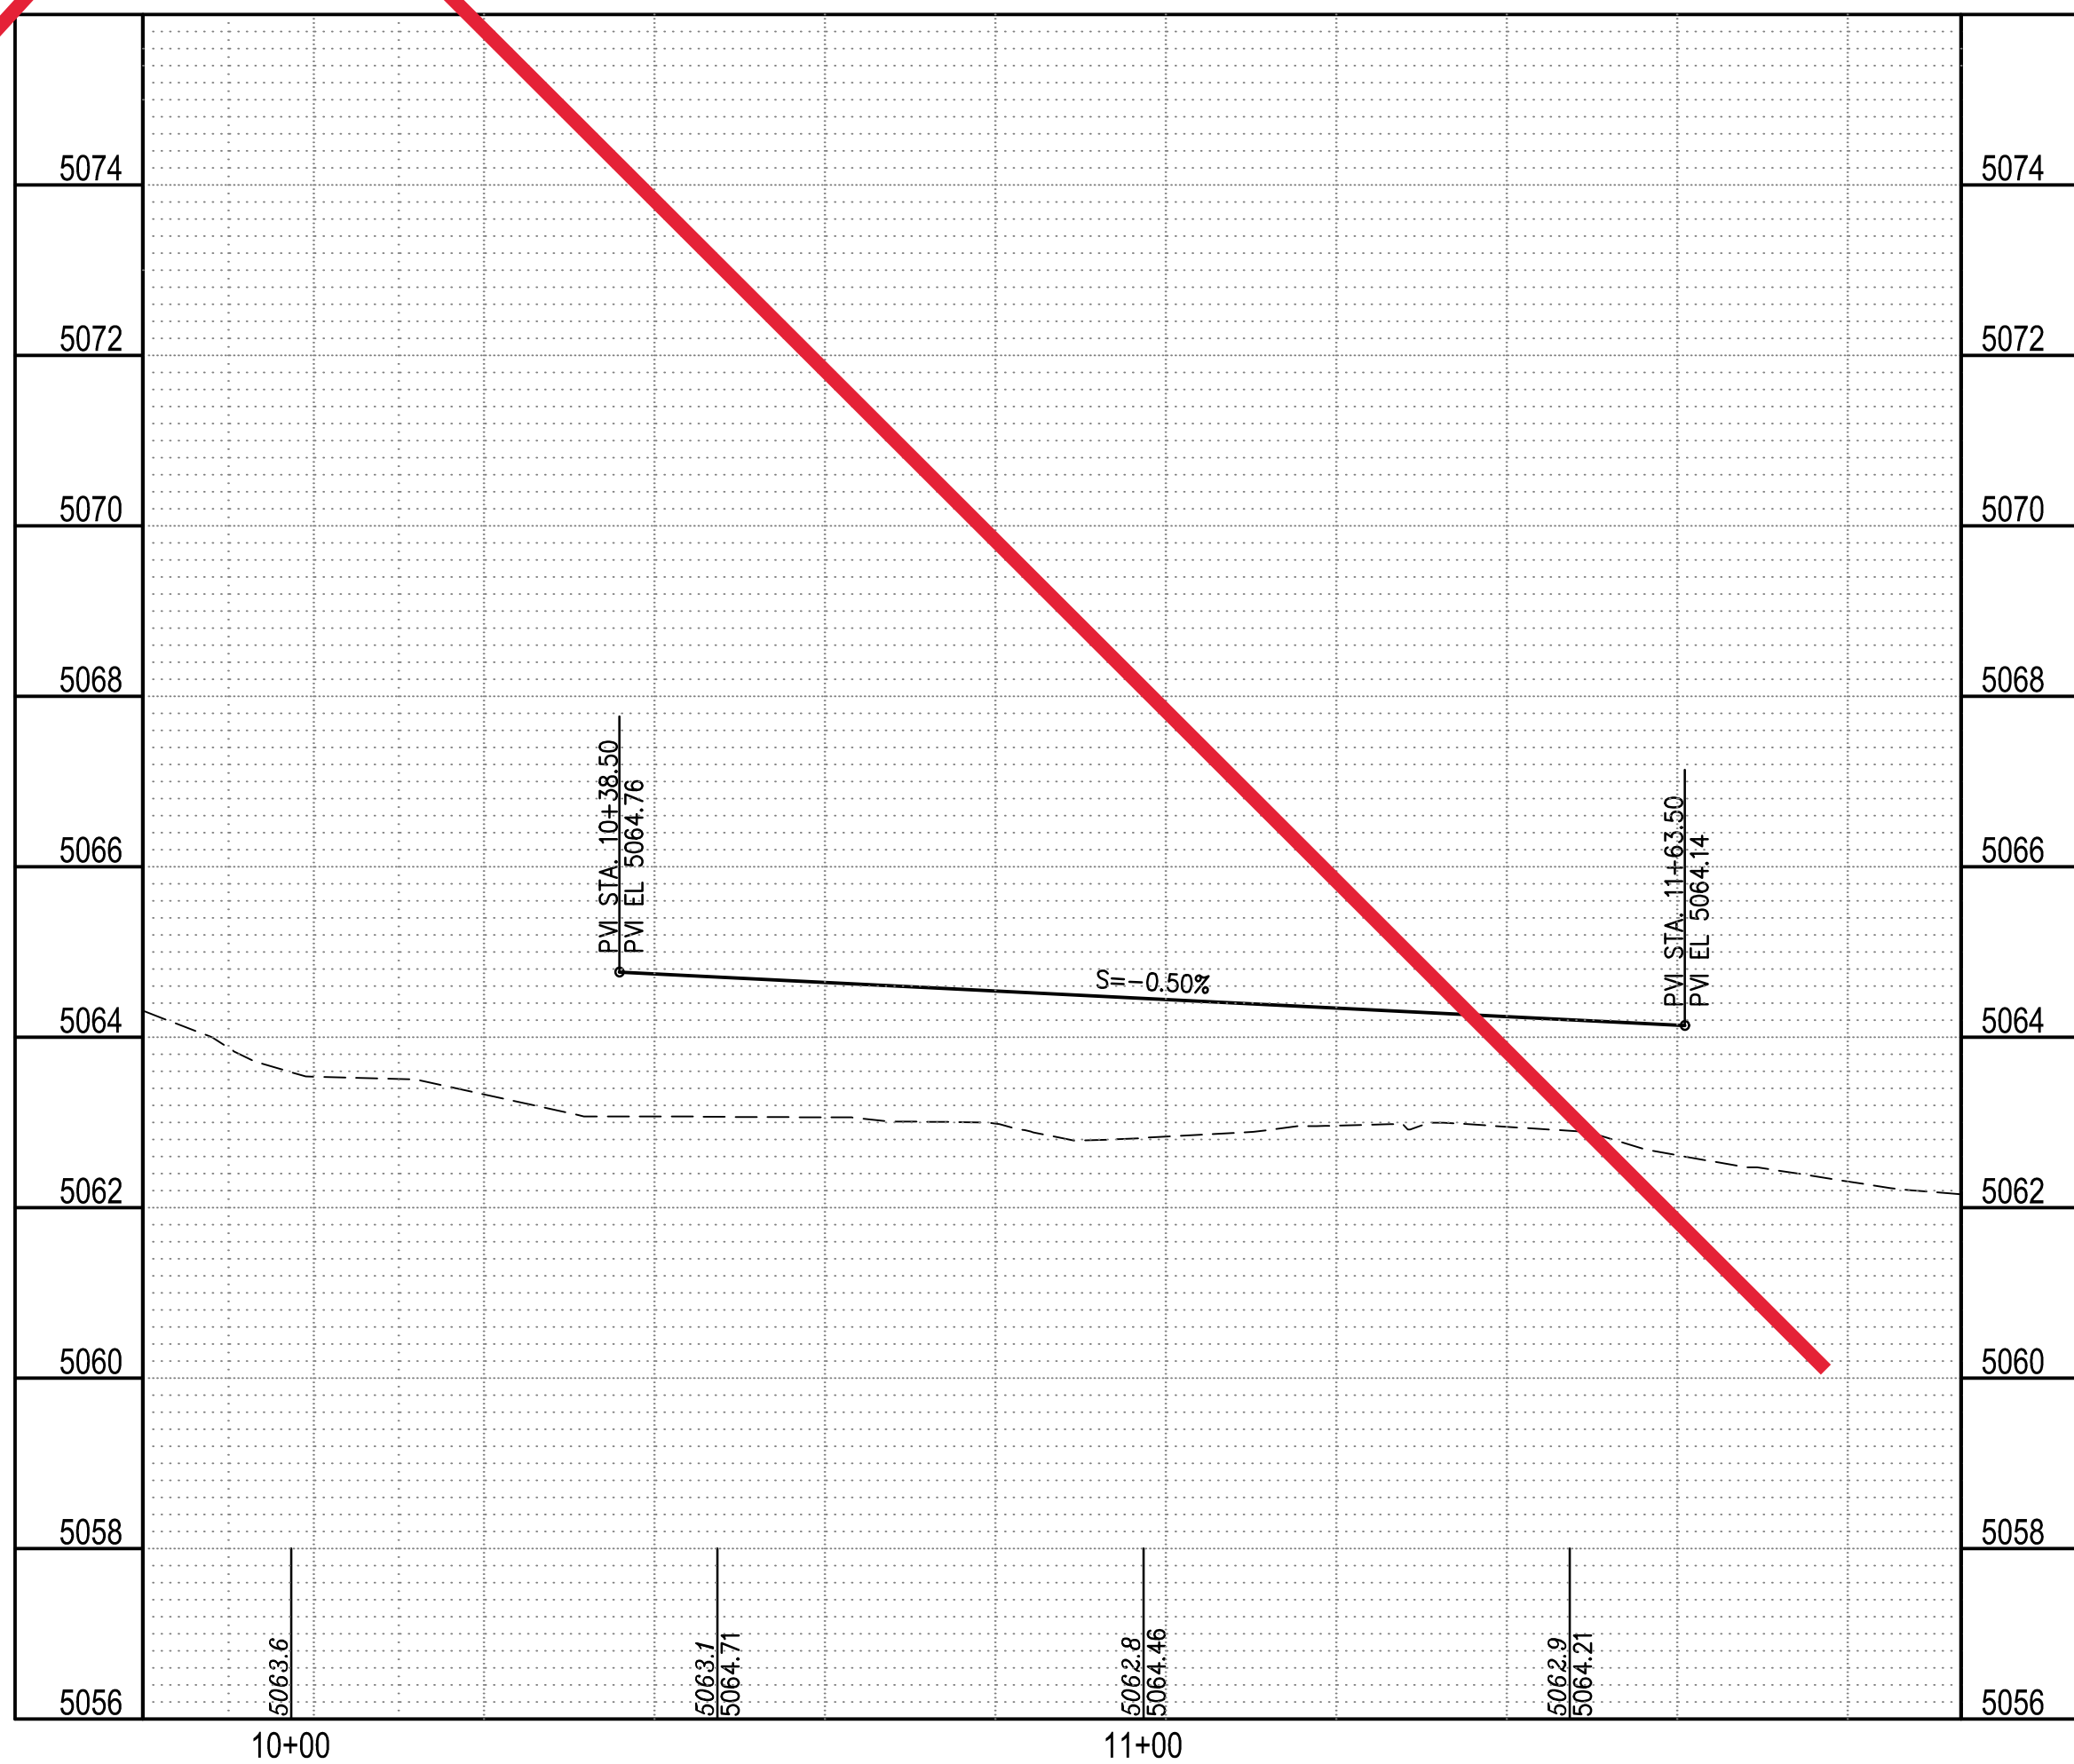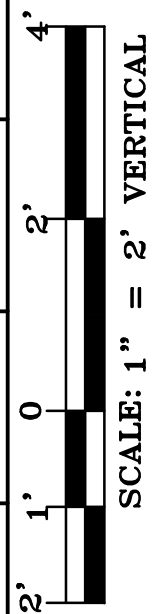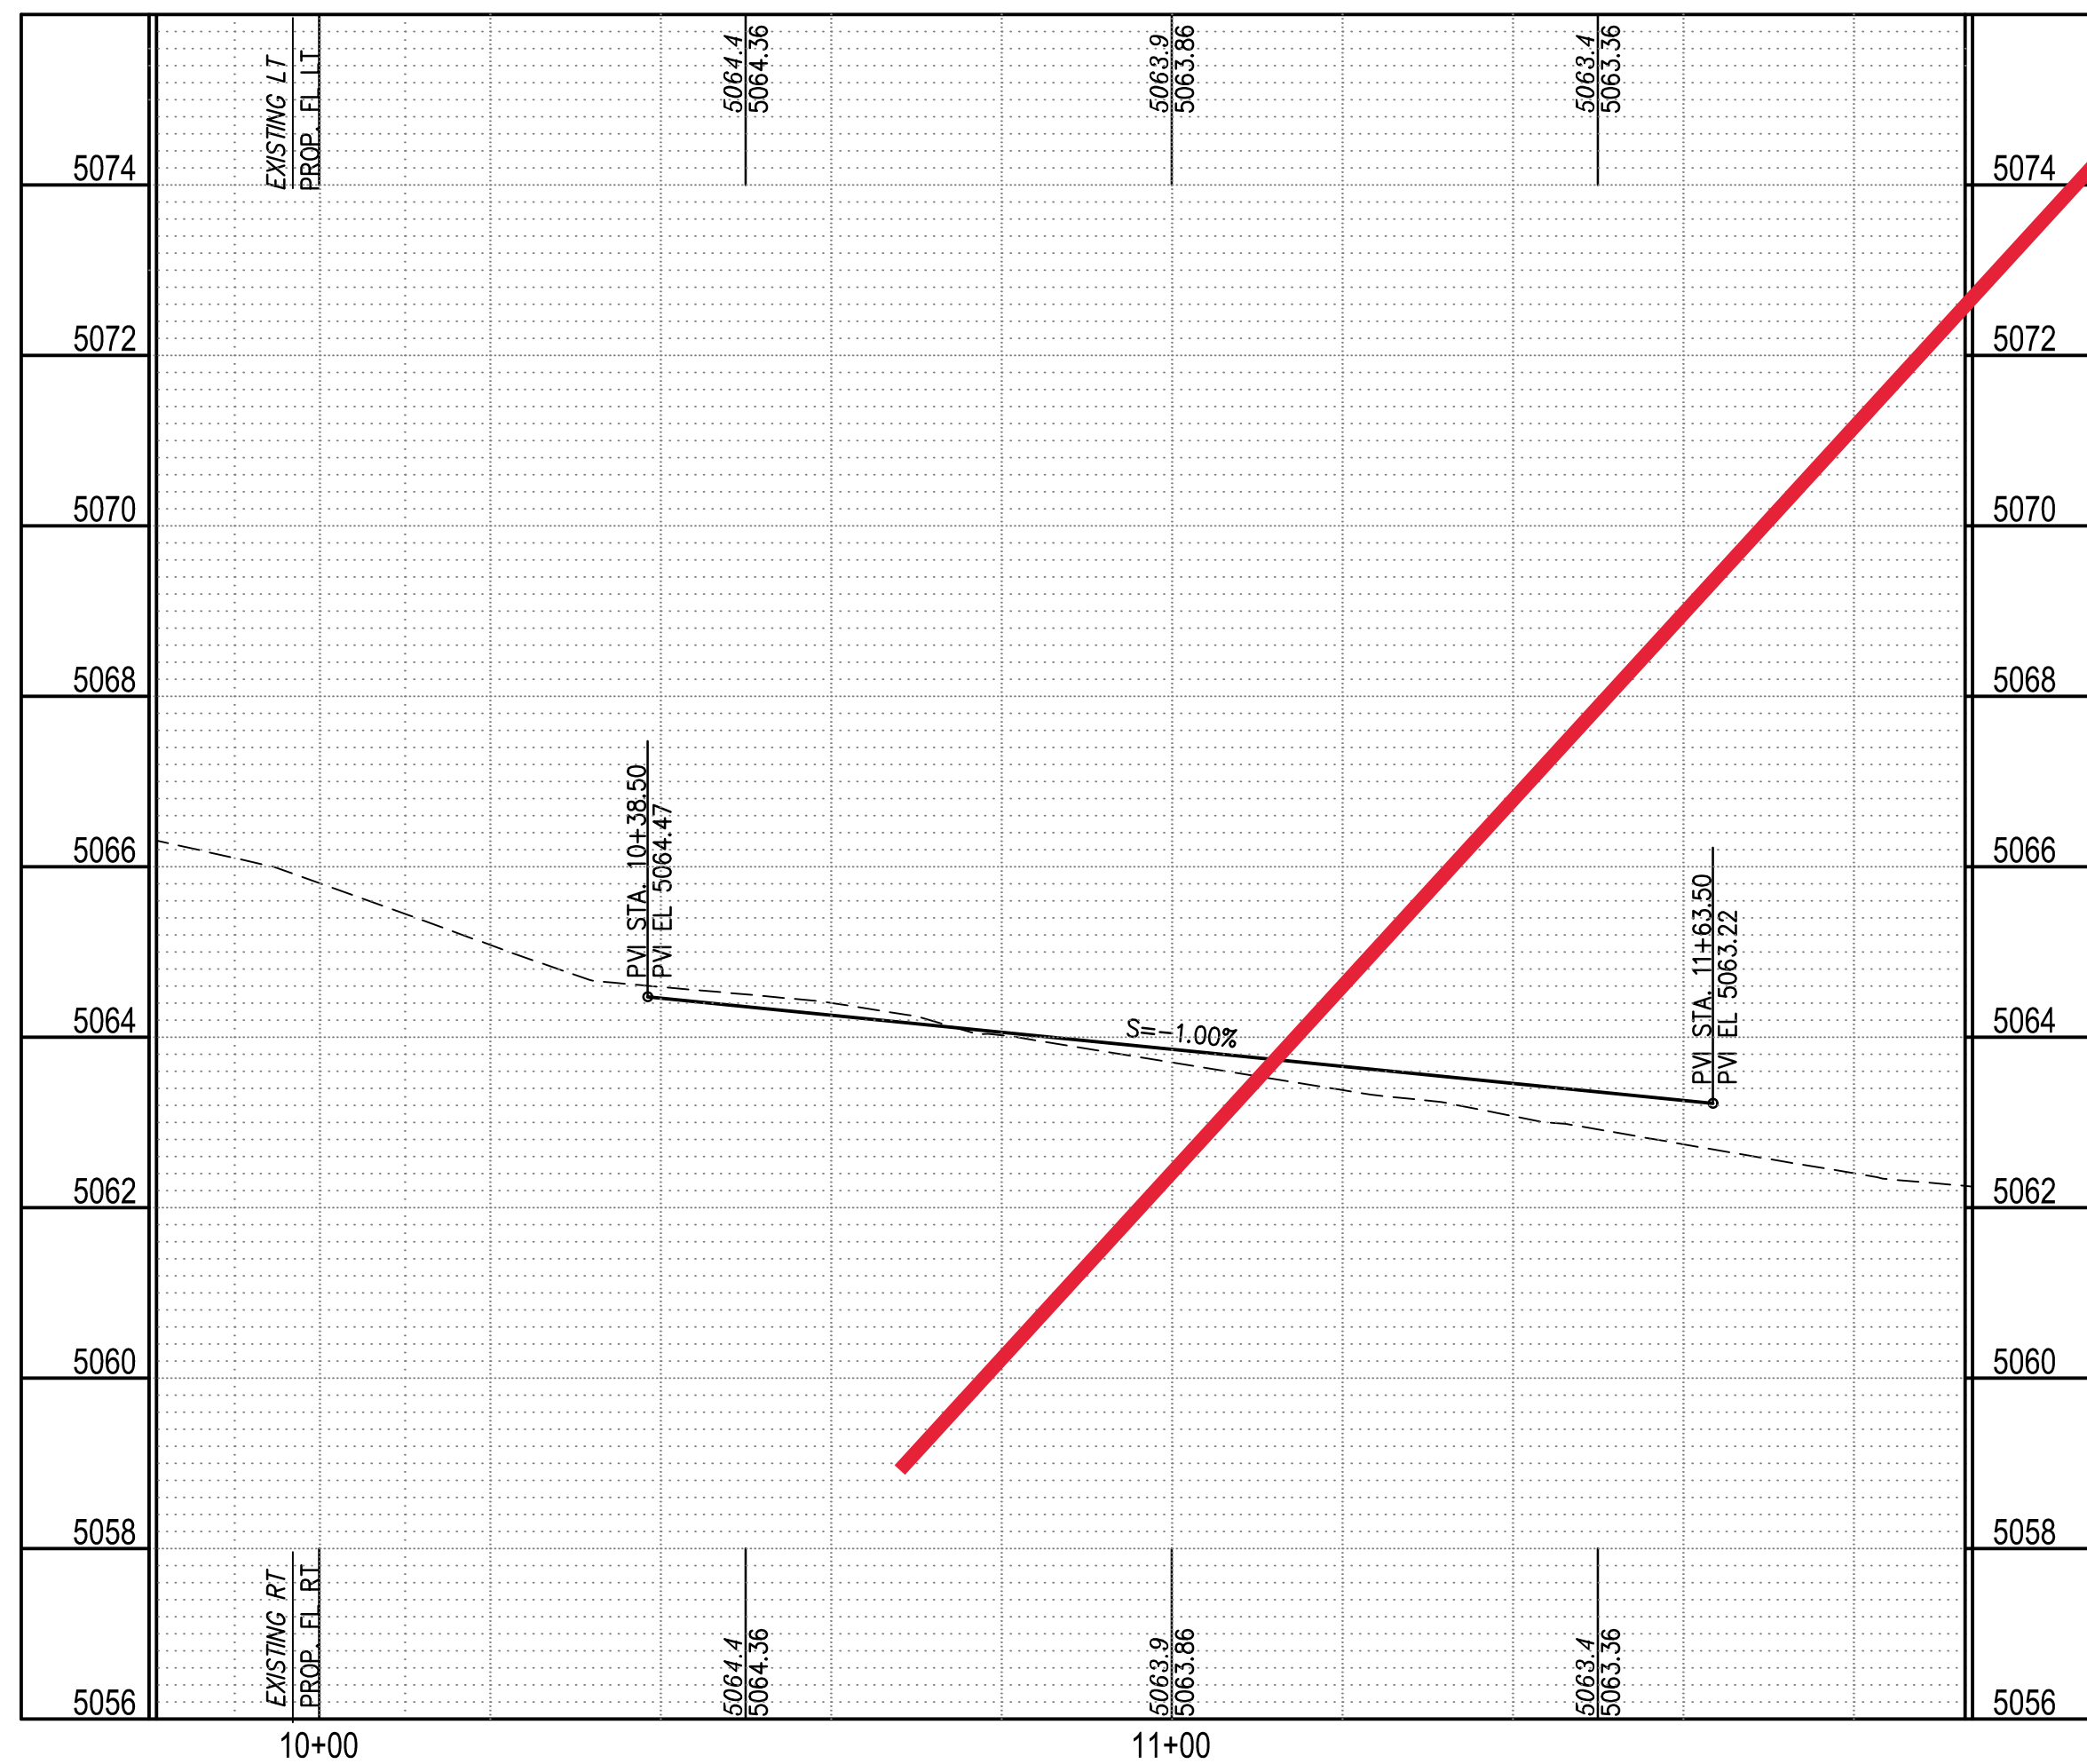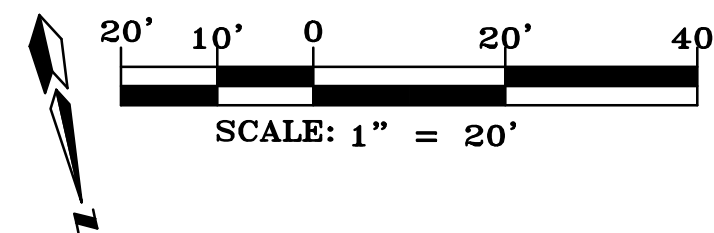

PAVING CONSTRUCTION NOTES	
I.D.#	DESCRIPTION
1	BUILD ASPHALT PAVING, PER TYPICAL SECTION SHEET 9
2	BUILD PCC WHEELCHAIR RAMP, PER DETAIL SHEET 9 AND COA STD. DTL. 2426
3	BUILD PCC MOUNTABLE ROLL-TYPE CURB & GUTTER, PER COA STD. DTL. 2415A
4	BUILD PCC RUNDOWN CURB, PER COA STD. DTL. 2415A
5	DEFERRED 4" PCC SIDEWALK, PER COA STD. DTL. 2430
6	INSTALL R1-1-30 STOP SIGN W/ POST, PER COA STD. DTL. 2900-201, 2900-601 AND 2900-702
7	BOLLARD PER DETAIL SHEET 9

AS BUILT INFORMATION		BENCH MARKS	
CONTRACTOR	DATE	*ACS BM NM 448 N8"	
INSPECTOR'S	DATE	X=1514.900.643 Y=1512.770.226 (NAD 83).	
FIELD	DATE	ELEV=5021.651 (NAVD 1988)	
VERIFICATION BY	DATE		
CORRECTED BY	DATE		
MICRO-FILM INFORMATION			
RECORDED BY	DATE		
NO.			

SURVEY INFORMATION	
FIELD NOTES	DATE
BY	
NO.	

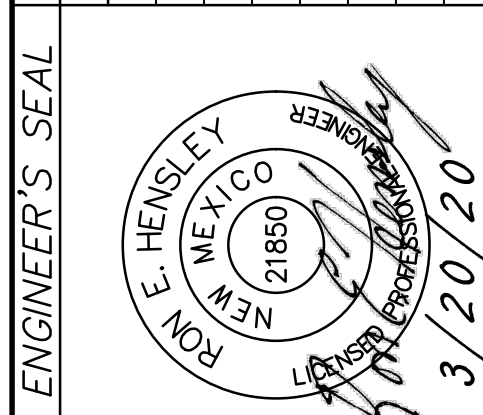

ENGINEER'S SEAL		REMARKS	
		NO. DATE	BY
		DESIGNED BY	REH
		DRAWN BY	REH
		CHECKED BY	REH
		DATE 10/31/19	
		DATE 12/07/19	
		DATE 02/21/20	









HORIZON VILLAGE SUBDIVISION
ALOFT PLACE & AWAY PLACE
PAVING PLAN AND PROFILE



CITY PROJECT No. 799782

ZONE MAP NO. C-17

SHEET 8 OF 15

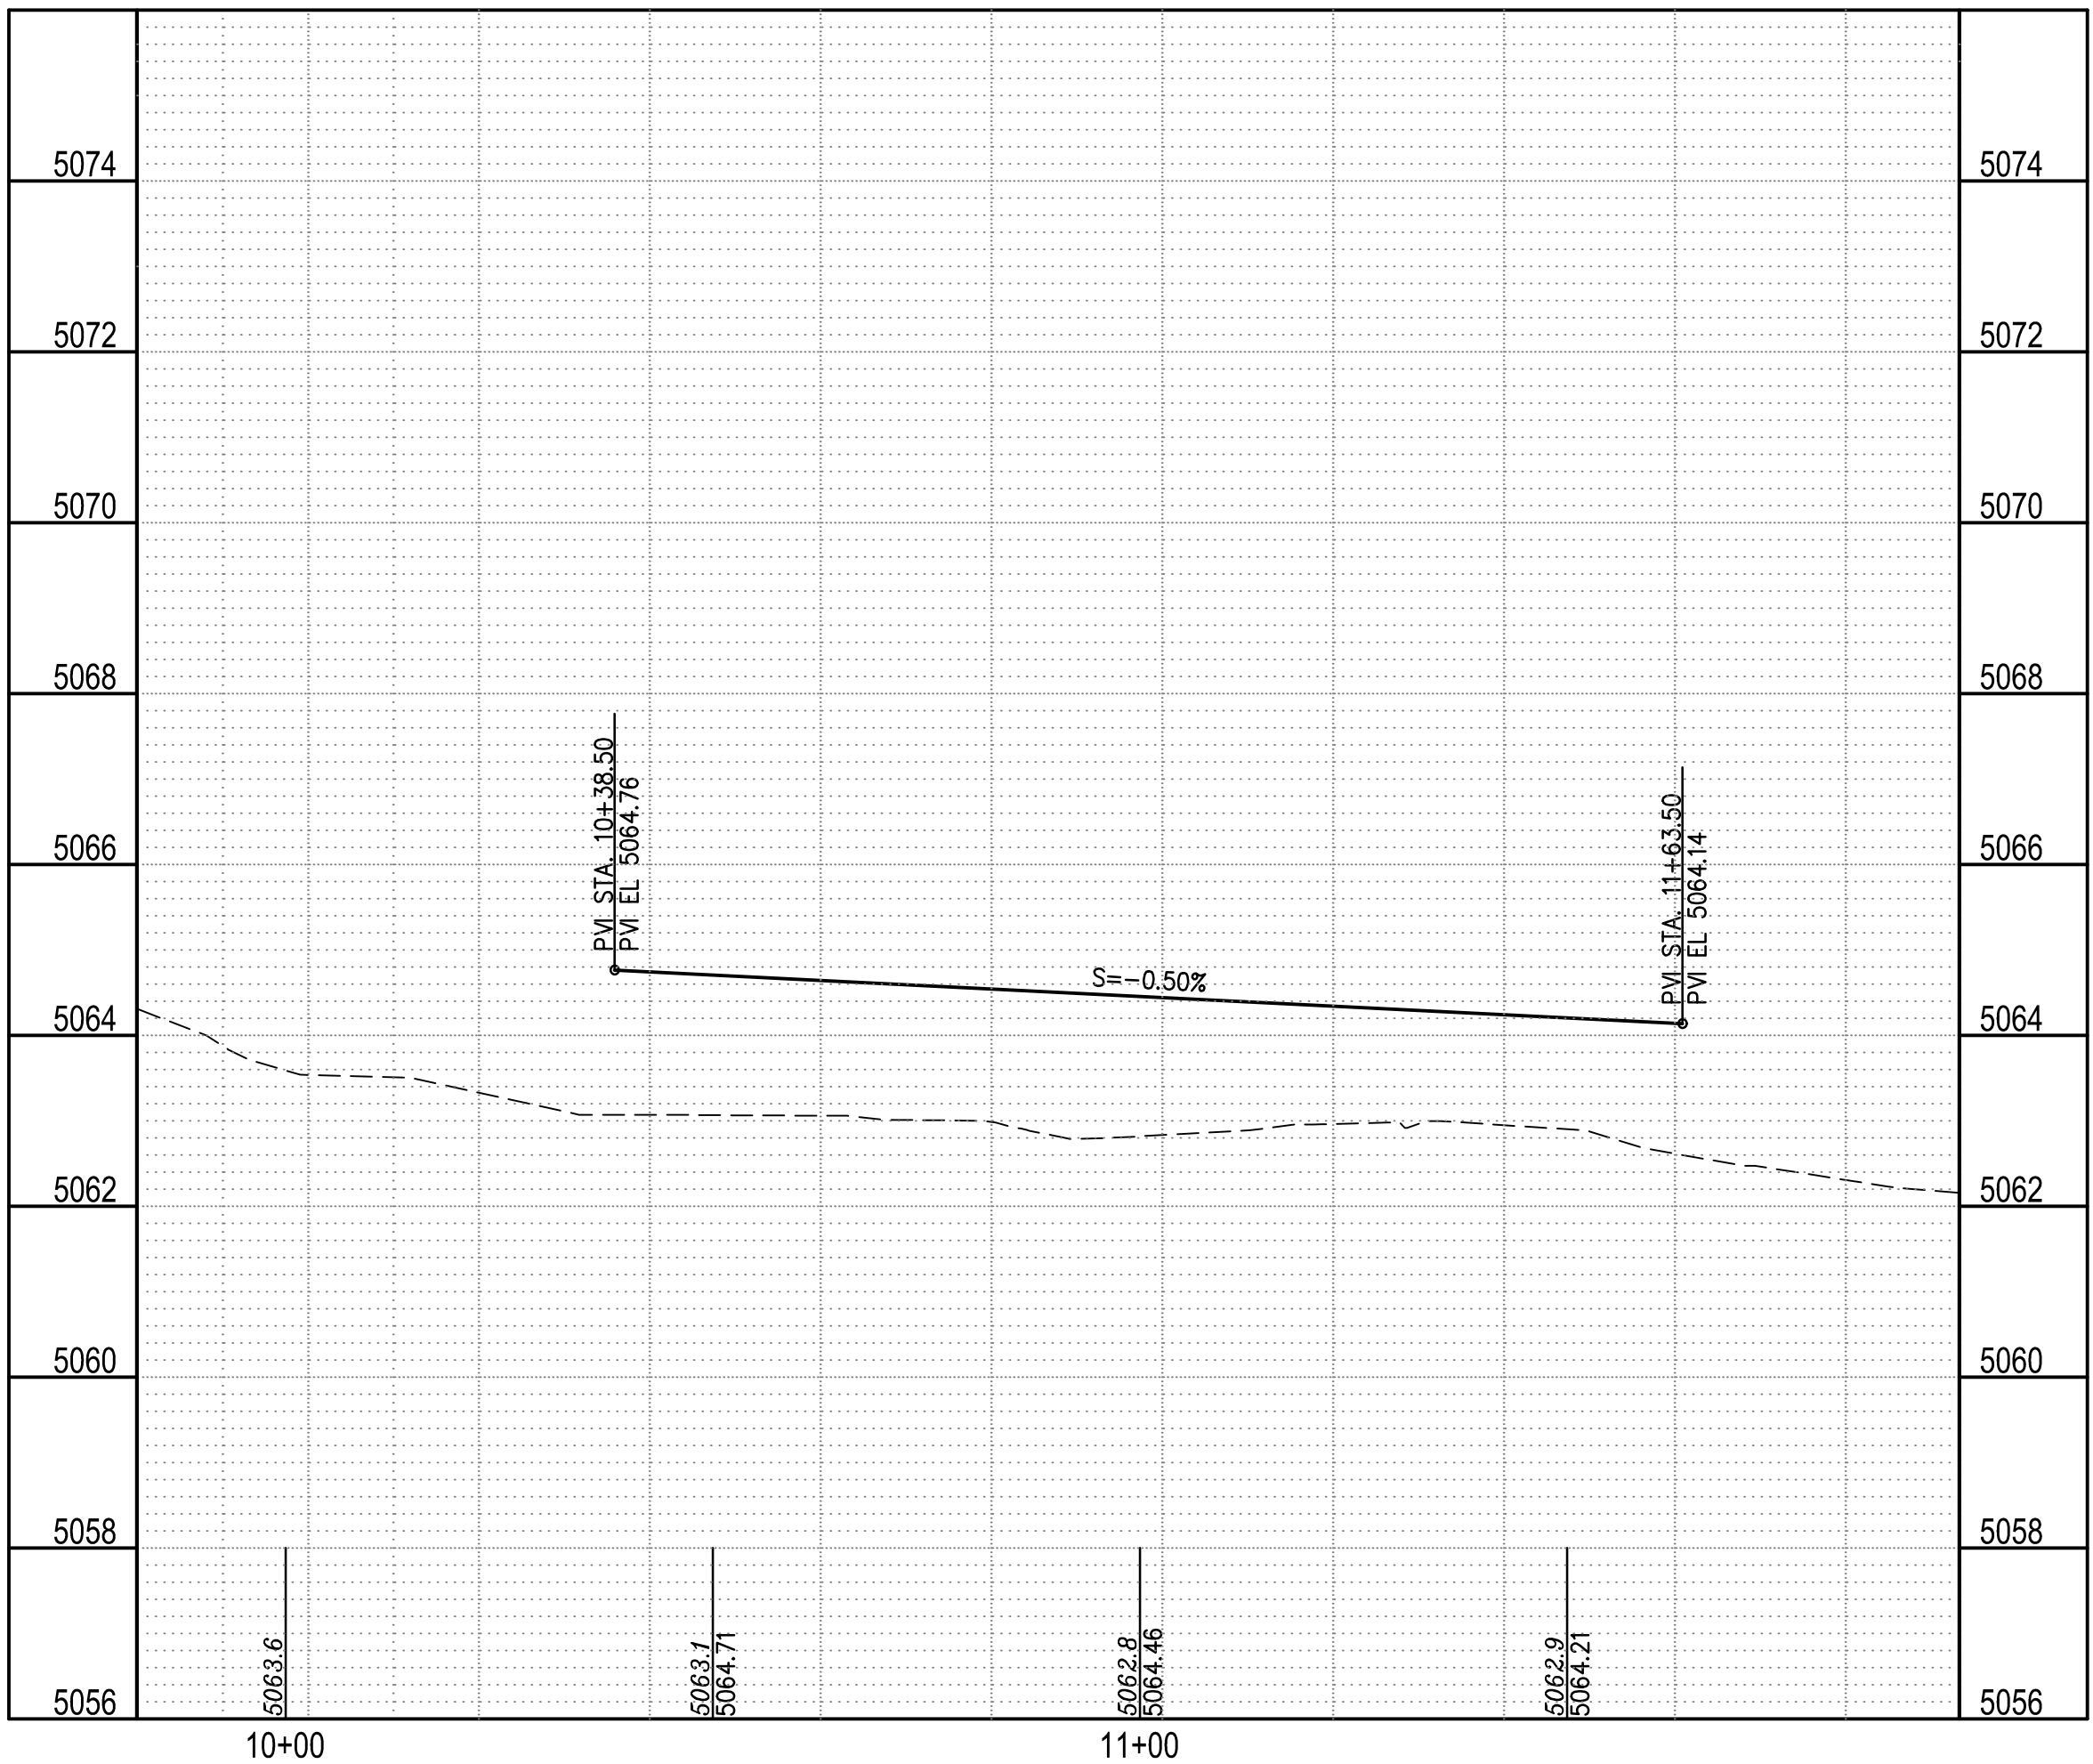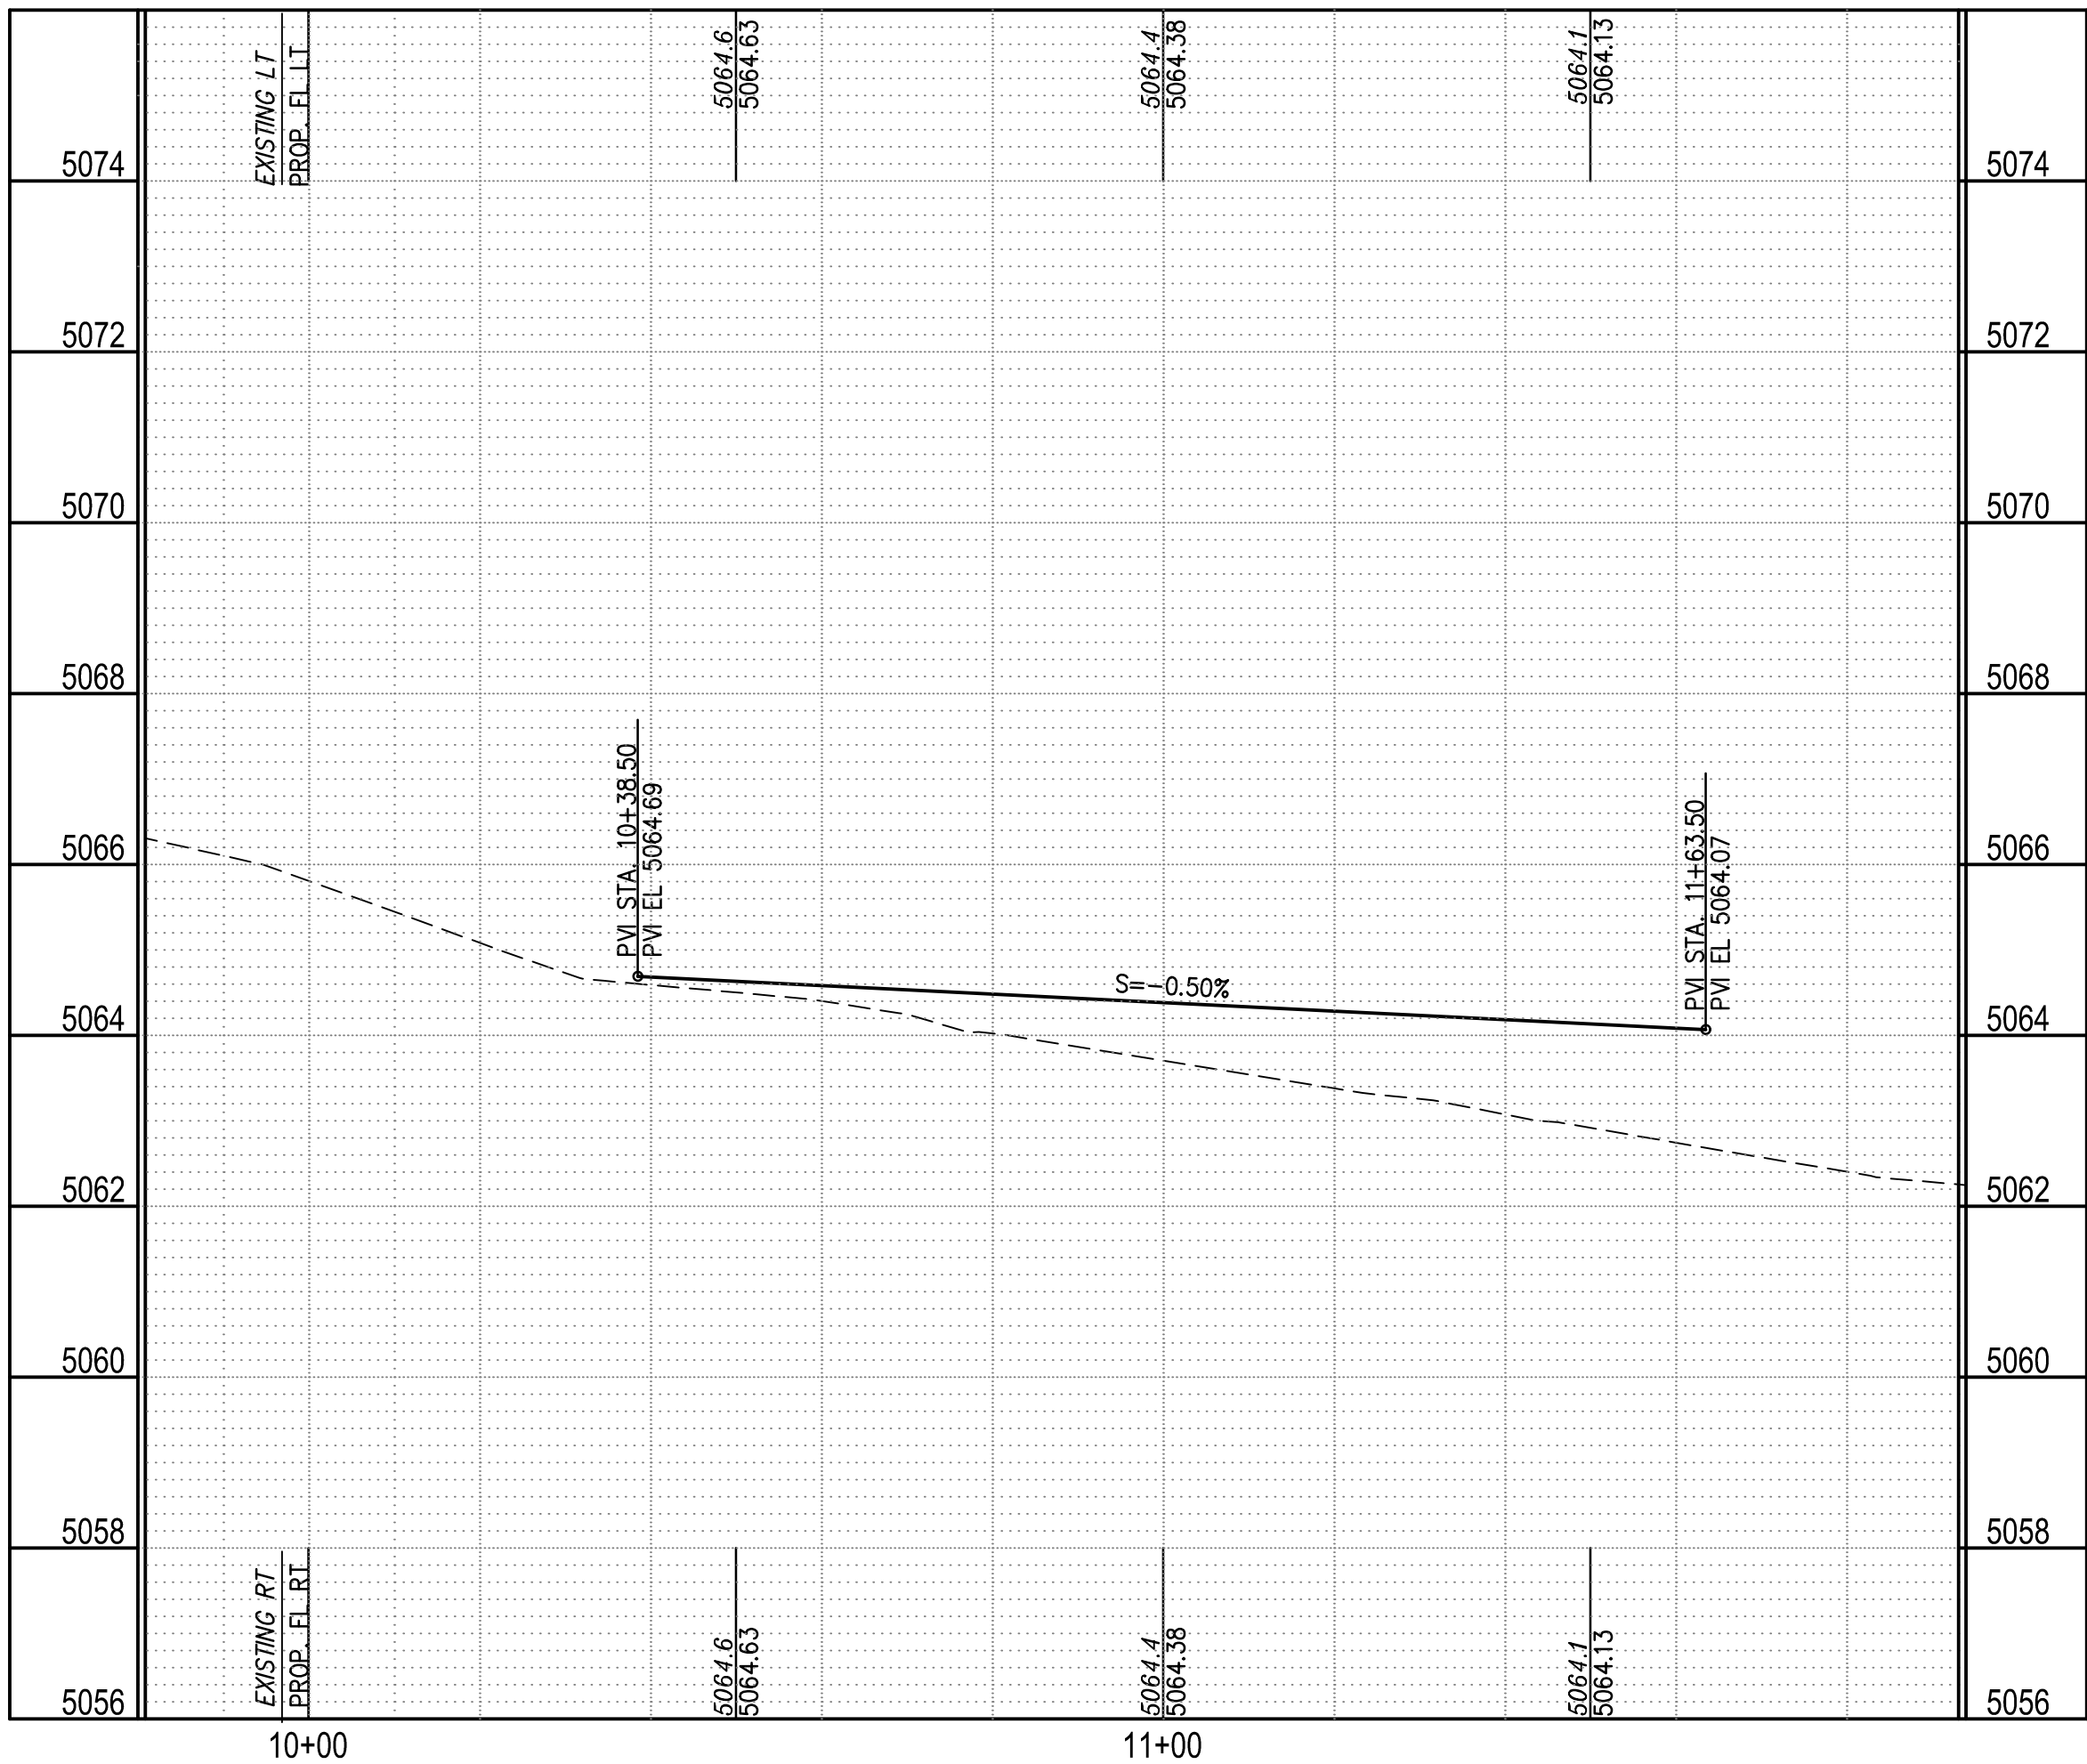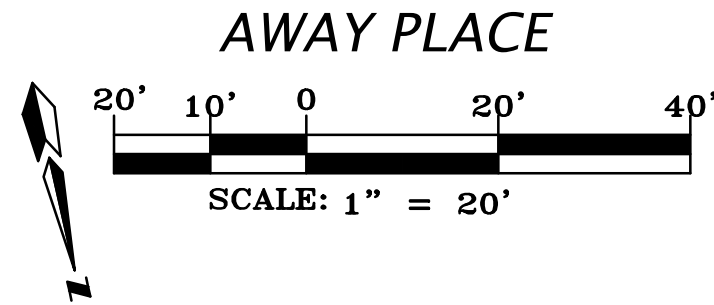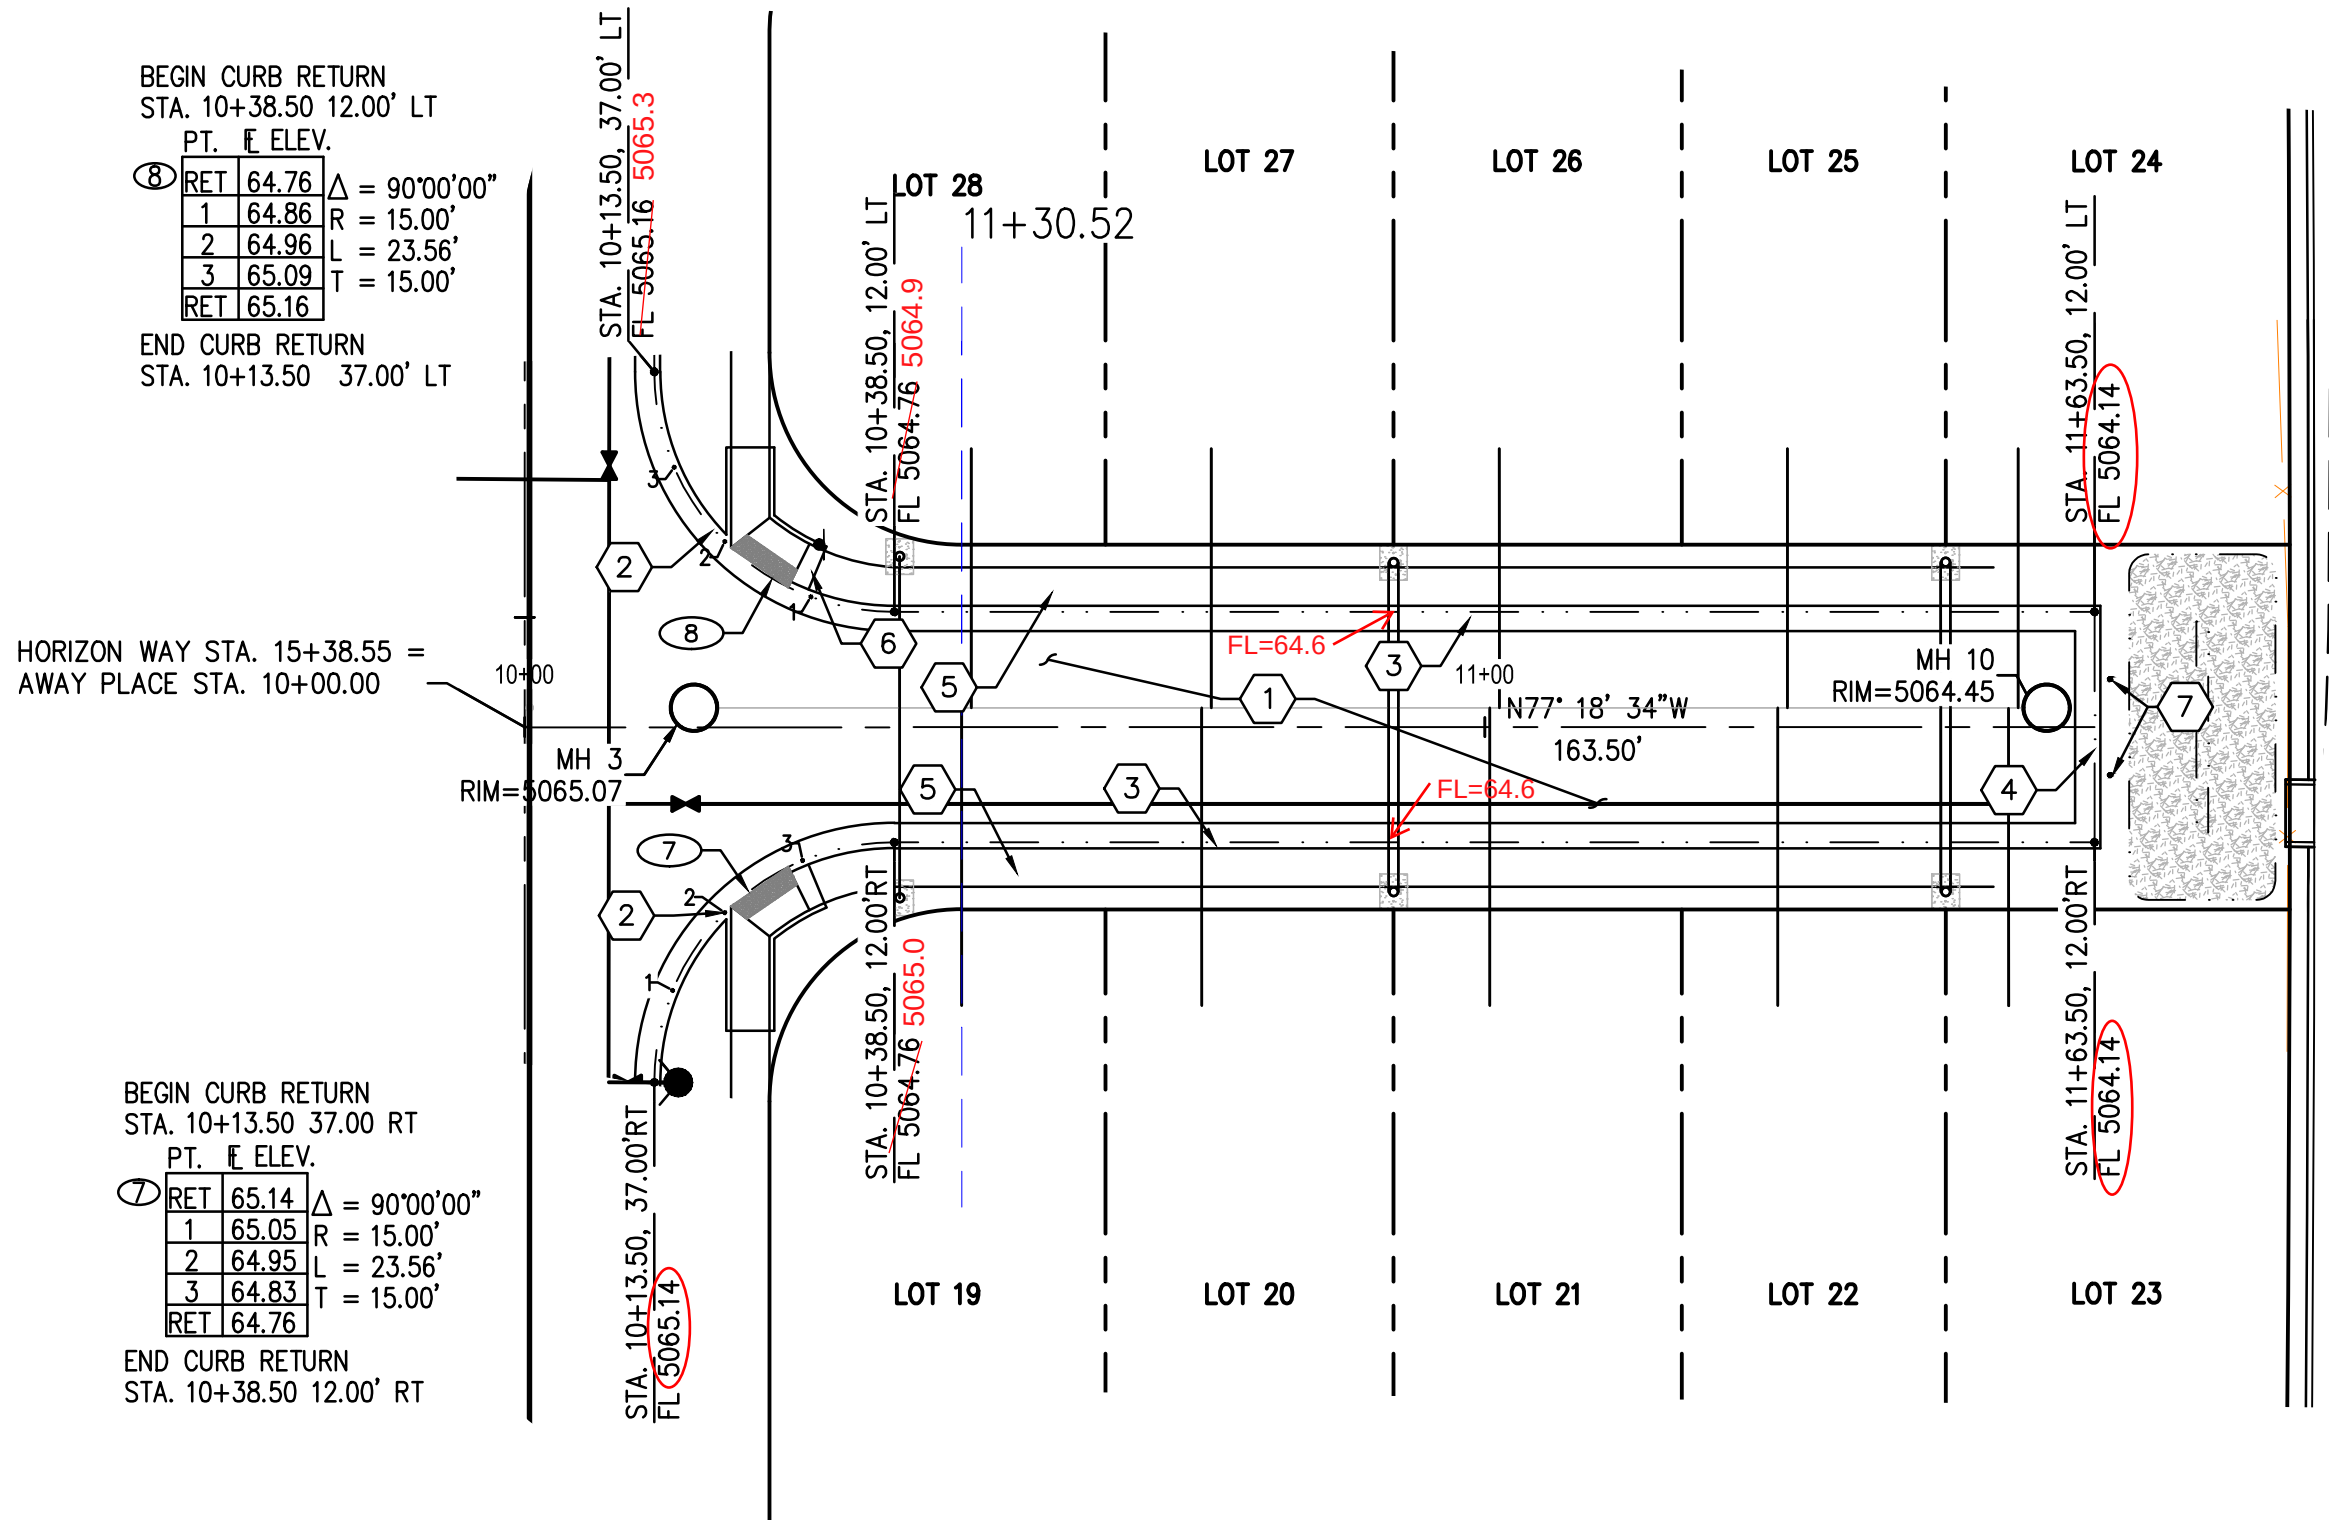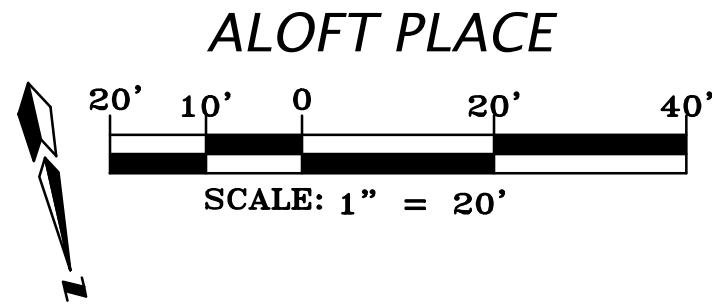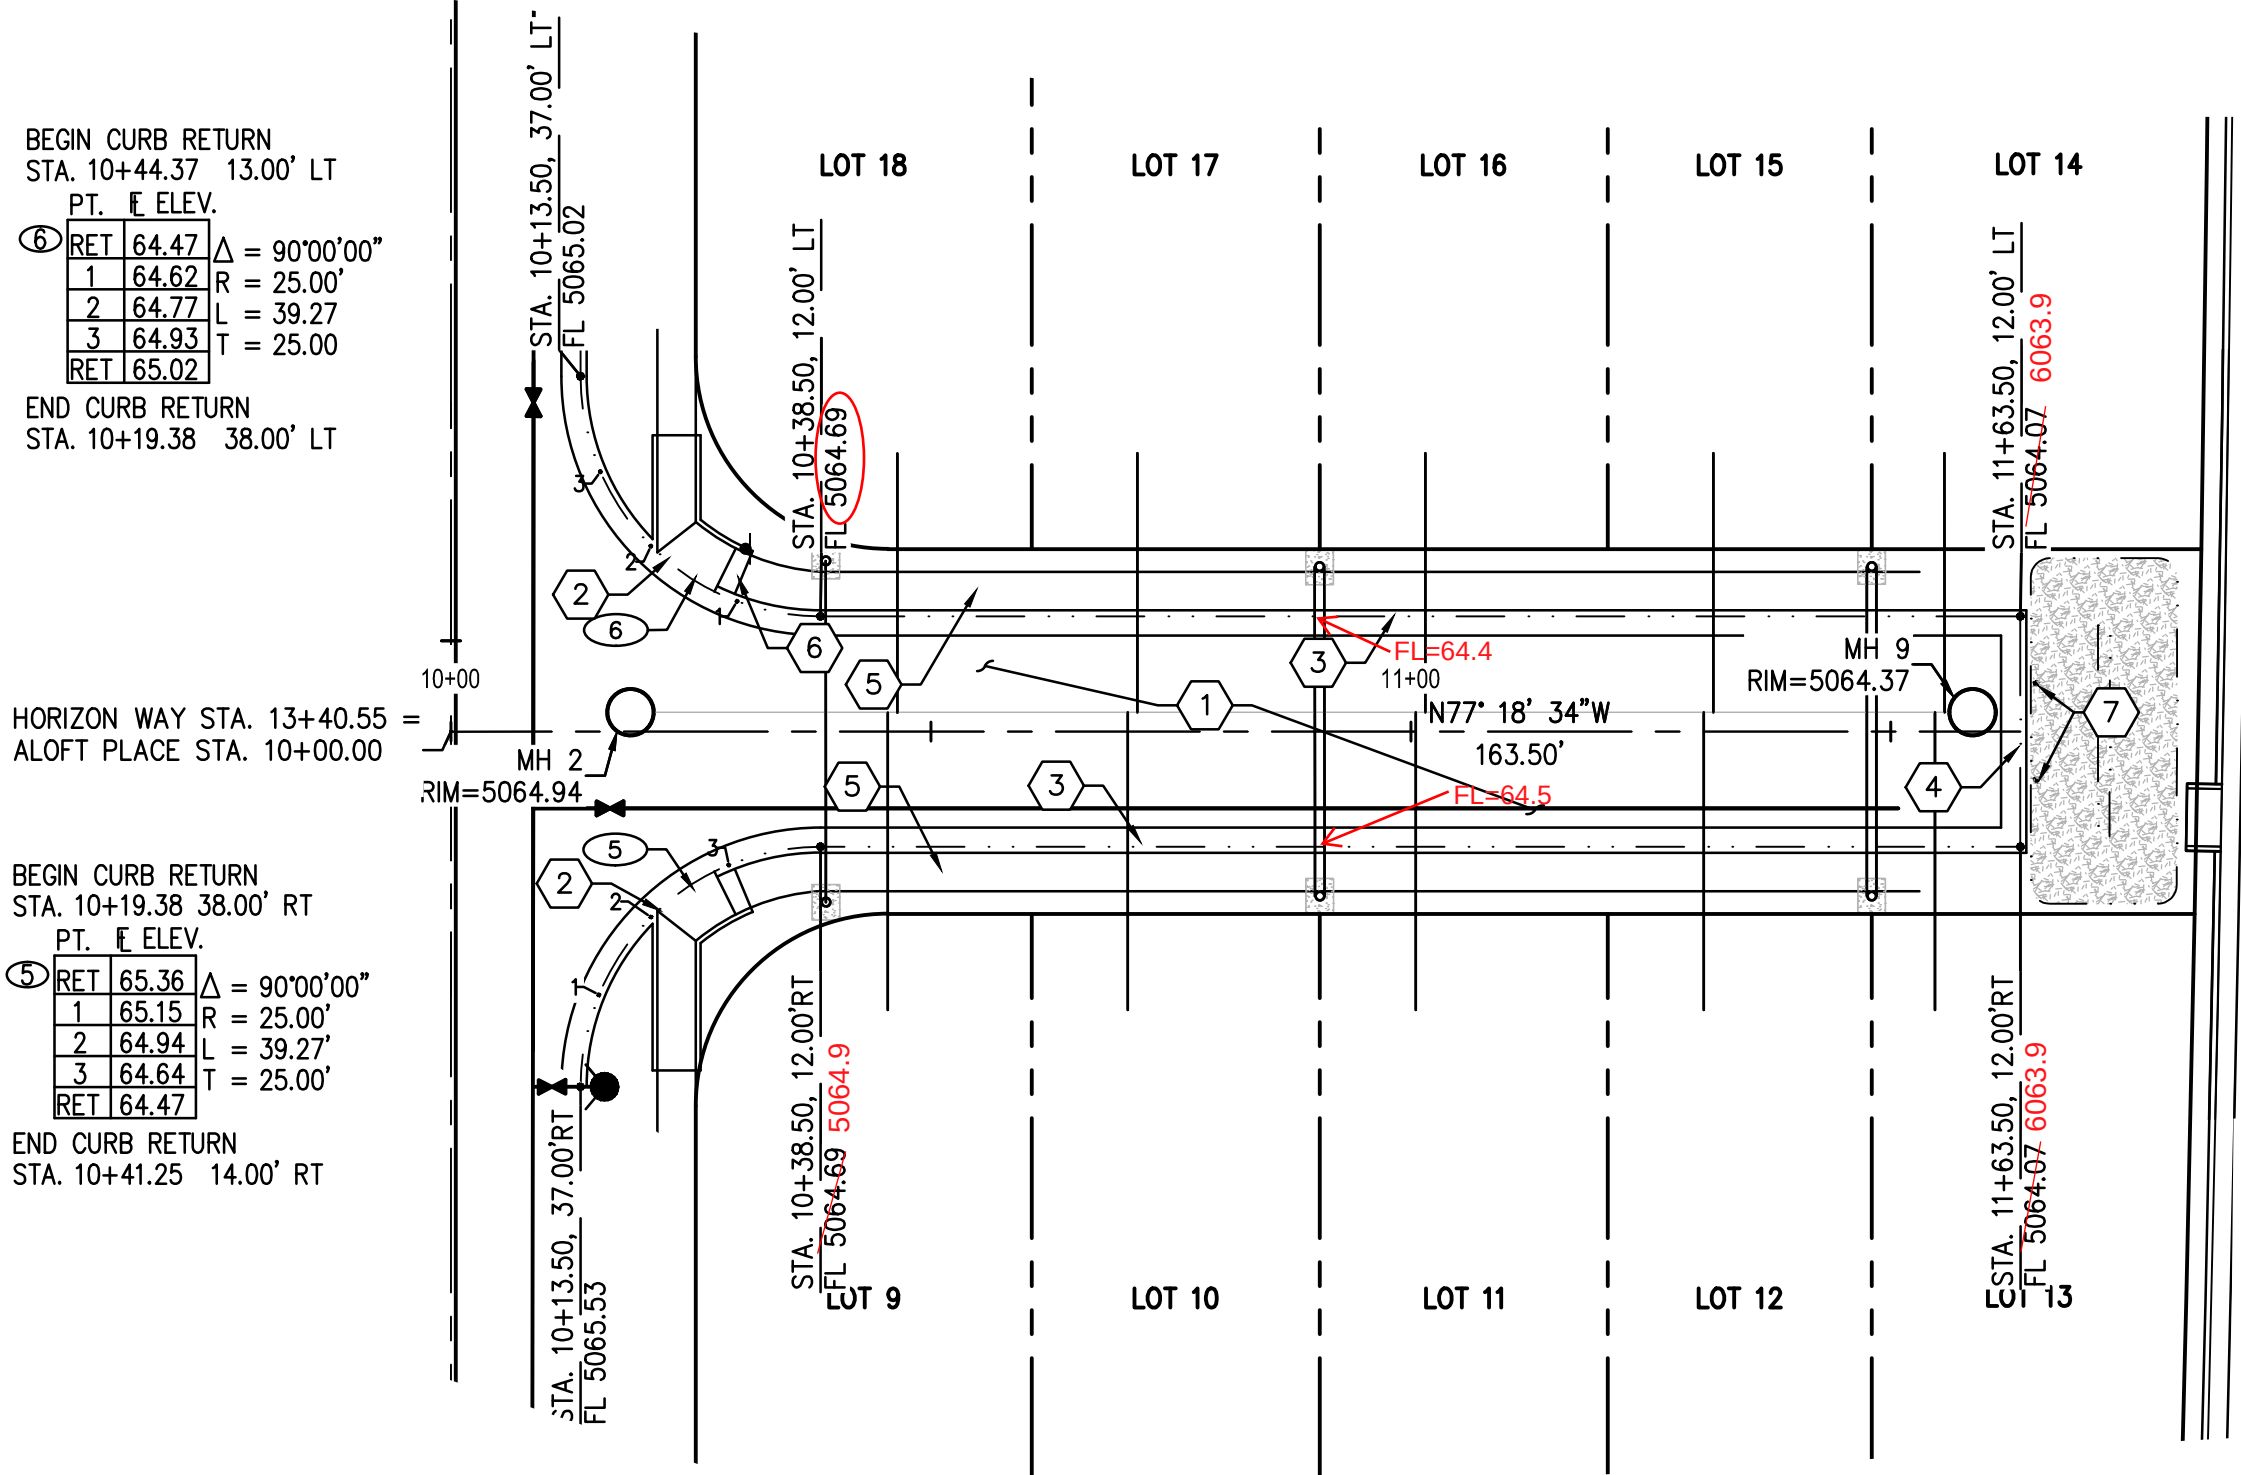


PAVING CONSTRUCTION NOTES	
I.D.#	DESCRIPTION
1	BUILD ASPHALT PAVING, PER TYPICAL SECTION SHEET 9
2	BUILD PCC WHEELCHAIR RAMP, PER DETAIL SHEET 9 AND COA STD. DTL. 2426
3	BUILD PCC MOUNTABLE ROLL-TYPE CURB & GUTTER, PER COA STD. DTL. 2415A
4	BUILD PCC RUNDOWN CURB, PER COA STD. DTL. 2415A
5	DEFERRED 4' PCC SIDEWALK, PER COA STD. DTL. 2430
6	INSTALL R1-1-30 STOP SIGN W/ POST, PER COA STD. DTL. 2900-201, 2900-601 AND 2900-702
7	BOLLARD PER DETAIL SHEET 9

AS BUILT INFORMATION	
CONTRACTOR	DATE
INSPECTOR'S	DATE
STAKED BY	DATE
FIELD VERIFICATION BY	DATE
CORRECTED BY	DATE
MICRO-FILM INFORMATION	
RECORDED BY	DATE
NO.	

BENCH MARKS	
"ACS BM NM 448 N8"	
X=1,514,900.643 Y=1,512,770.226 (NAD 83)	
ELEV=5021.651 (NAVD 1988)	

SURVEY INFORMATION	
FIELD NOTES	DATE
BY	
NO.	

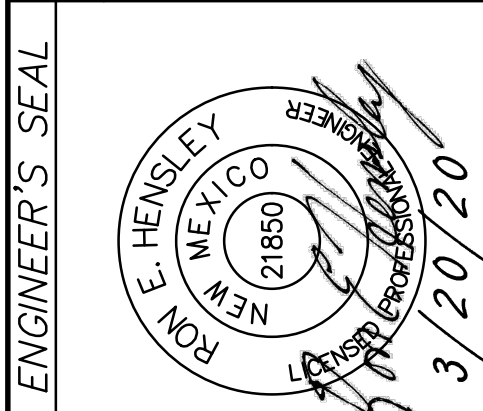

SEWER DEPTH REVISION	
1	8/25/20

REVISIONS	
NO.	DATE
DESIGNED BY	REH
DRAWN BY	REH
CHECKED BY	REH
DATE	10/31/19
DATE	12/07/19
DATE	02/21/20

THE HENSLEY ENGINEERING GROUP
(505) 410-1622

HORIZON VILLAGE SUBDIVISION
ALOFT PLACE & AWAY PLACE
PAVING PLAN AND PROFILE


DESIGN REVIEW COMMITTEE
APPROVED
Sept. 10, 2020
DESIGN REVIEW COMMITTEE

CITY ENGINEER APPROVAL
APPROVED
Sept. 10, 2020
CITY ENGINEER


CITY PROJECT No. 799782

ZONE MAP NO. C-17


SHEET 8 OF 15

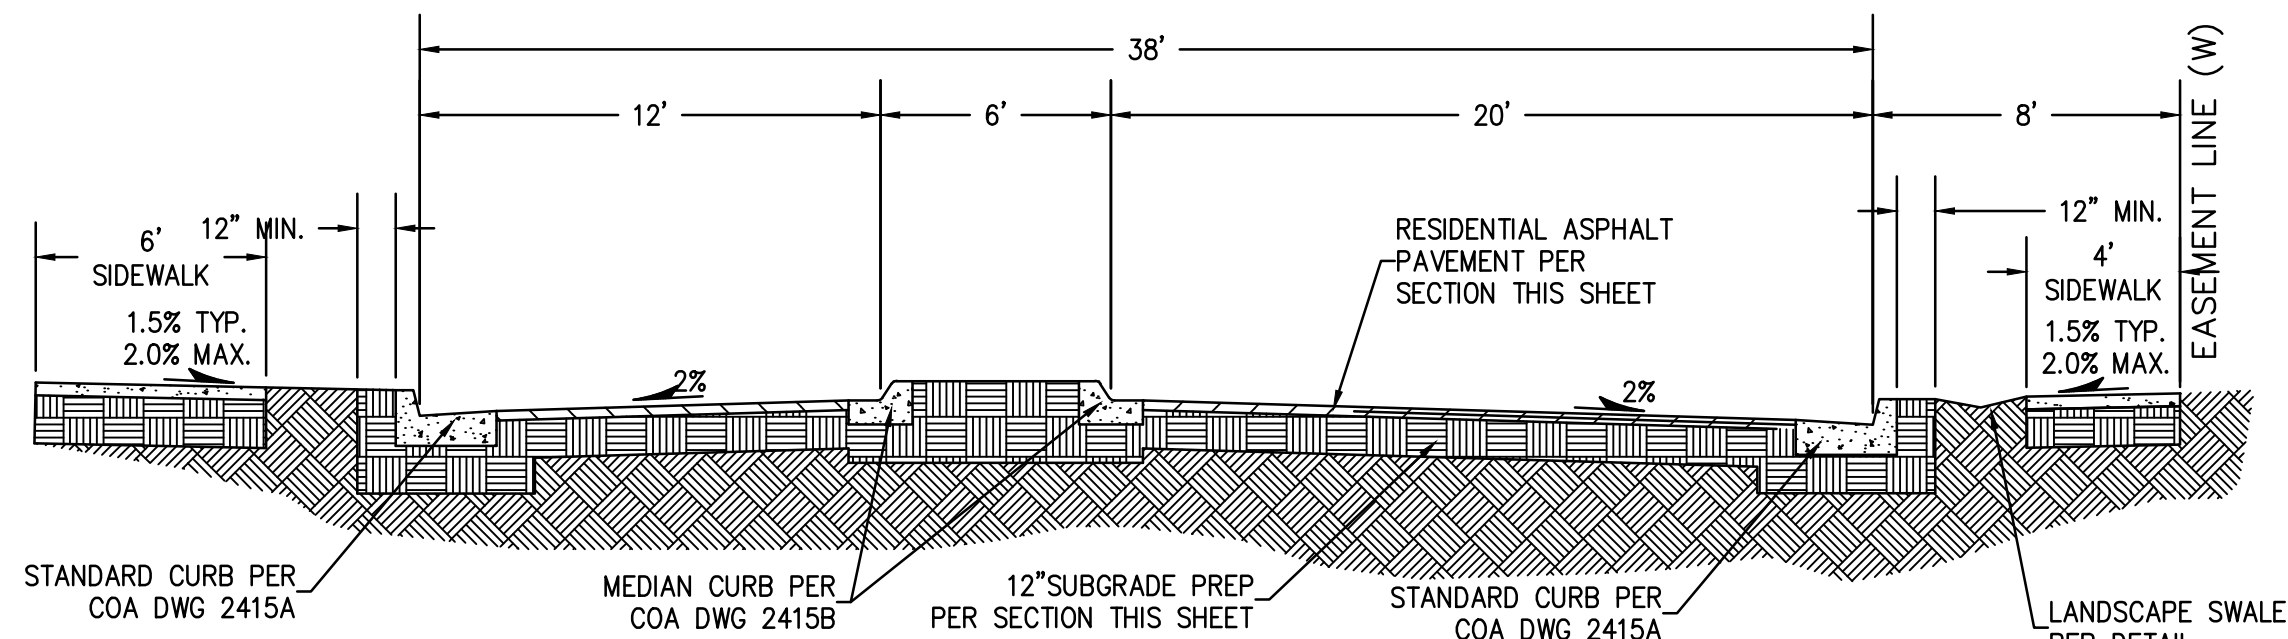

HORIZON WAY ENTRY STREET SECTION

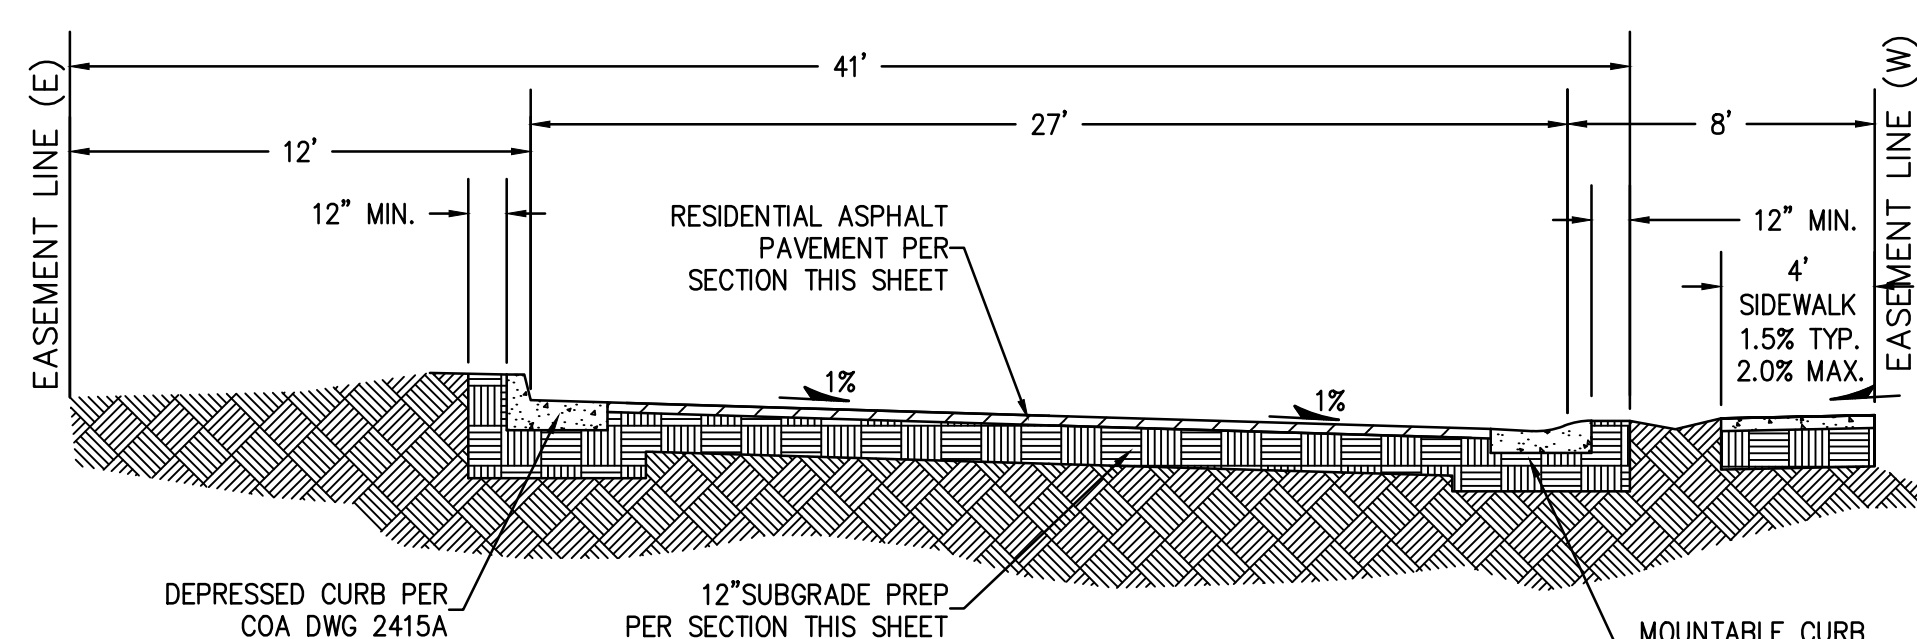


HORIZON WAY STREET SECTION

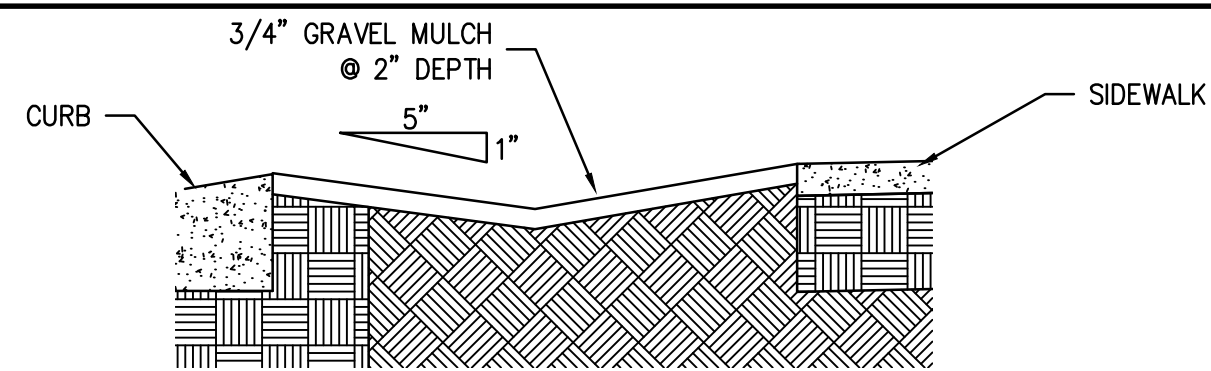


TYPICAL LANDSCAPE SWALE


- Swale to have side slope of 5:1 (H:V).
- For wide landscape buffers, greater than 10 feet, the maximum depth is 10 inches.
- Landscape buffers 2 feet and less are excluded.
- Final grade of dirt to be 1 to 2 inches below top of curb and top of sidewalk grade.
- Surface between back of curb and sidewalk to be covered with gravel mulch (minimum 3/4"), cobbles or rip-rap. Do not fill entire swale.
- A check dam will be required for swales on steeper longitudinal slopes and longer sections. The engineer will determine the location.
- Landscape fabric is recommended, but not required, between the dirt and the stone. If landscape fabric is to be used it is to be permeable.
- Detail is to be built for all new construction. In the case where the sidewalk is existing and the landscape buffer is improved with landscaping and/or some form of erosion protection, this requirement does not apply.

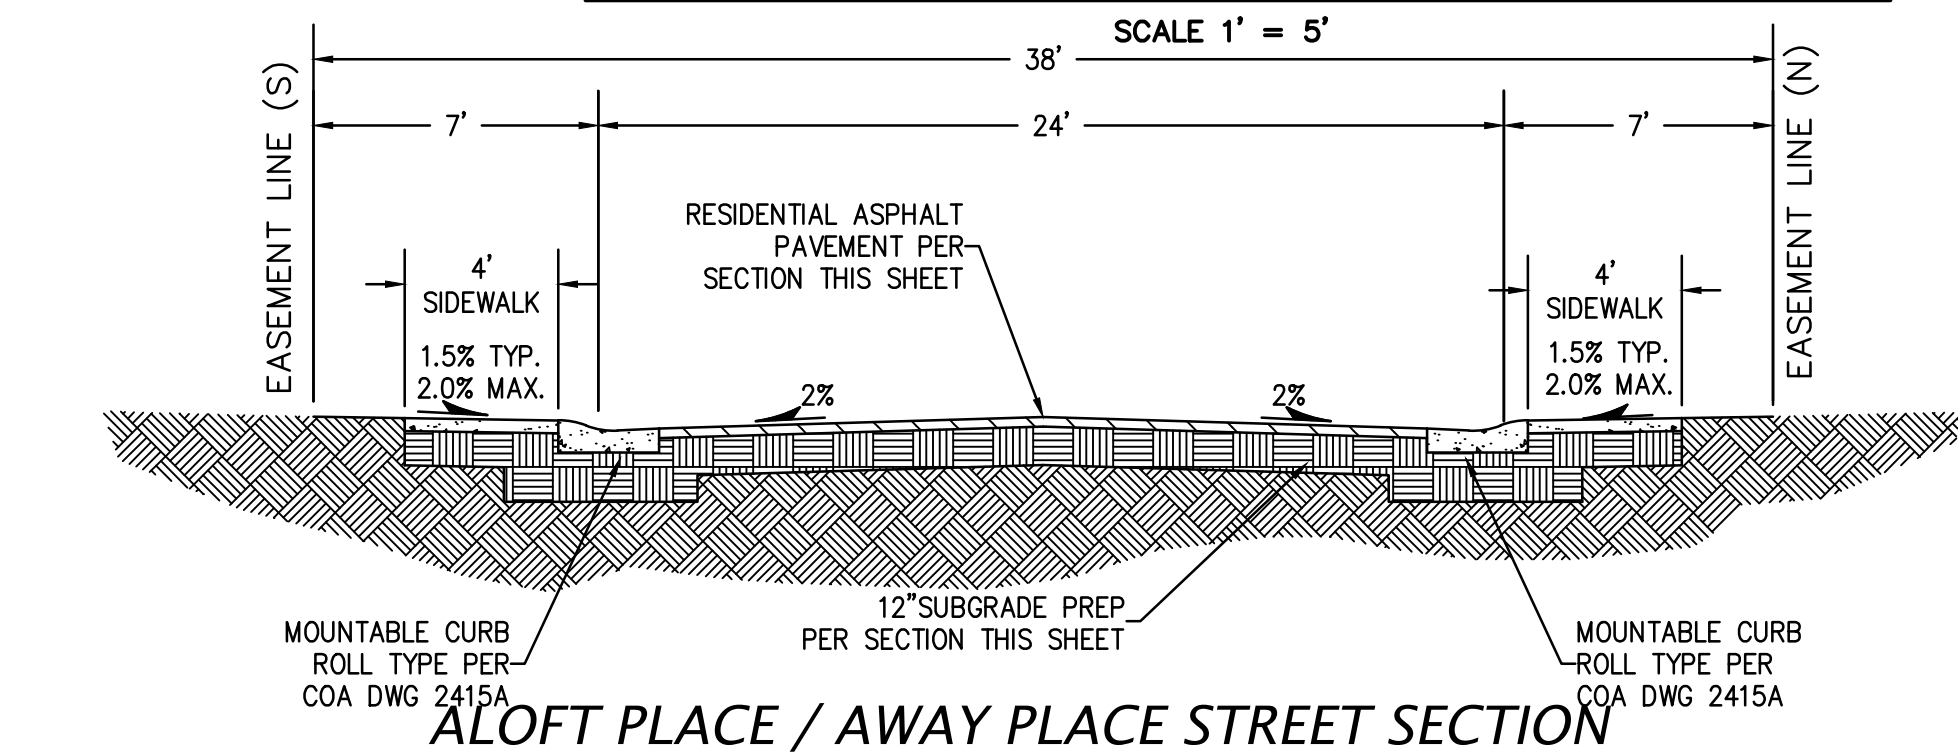


ALOFT PLACE / AWAY PLACE STREET SECTION

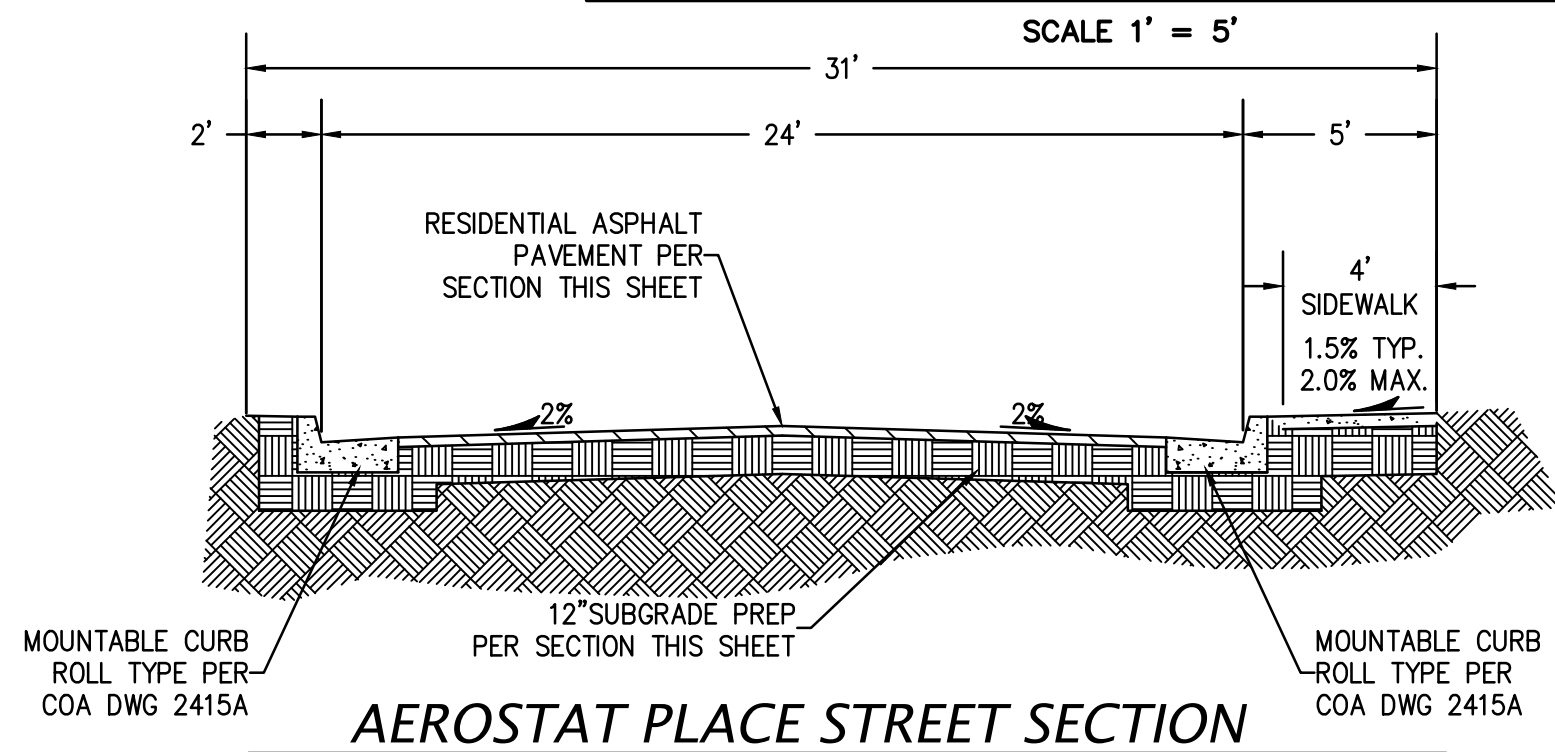


AEROSTAT PLACE STREET SECTION

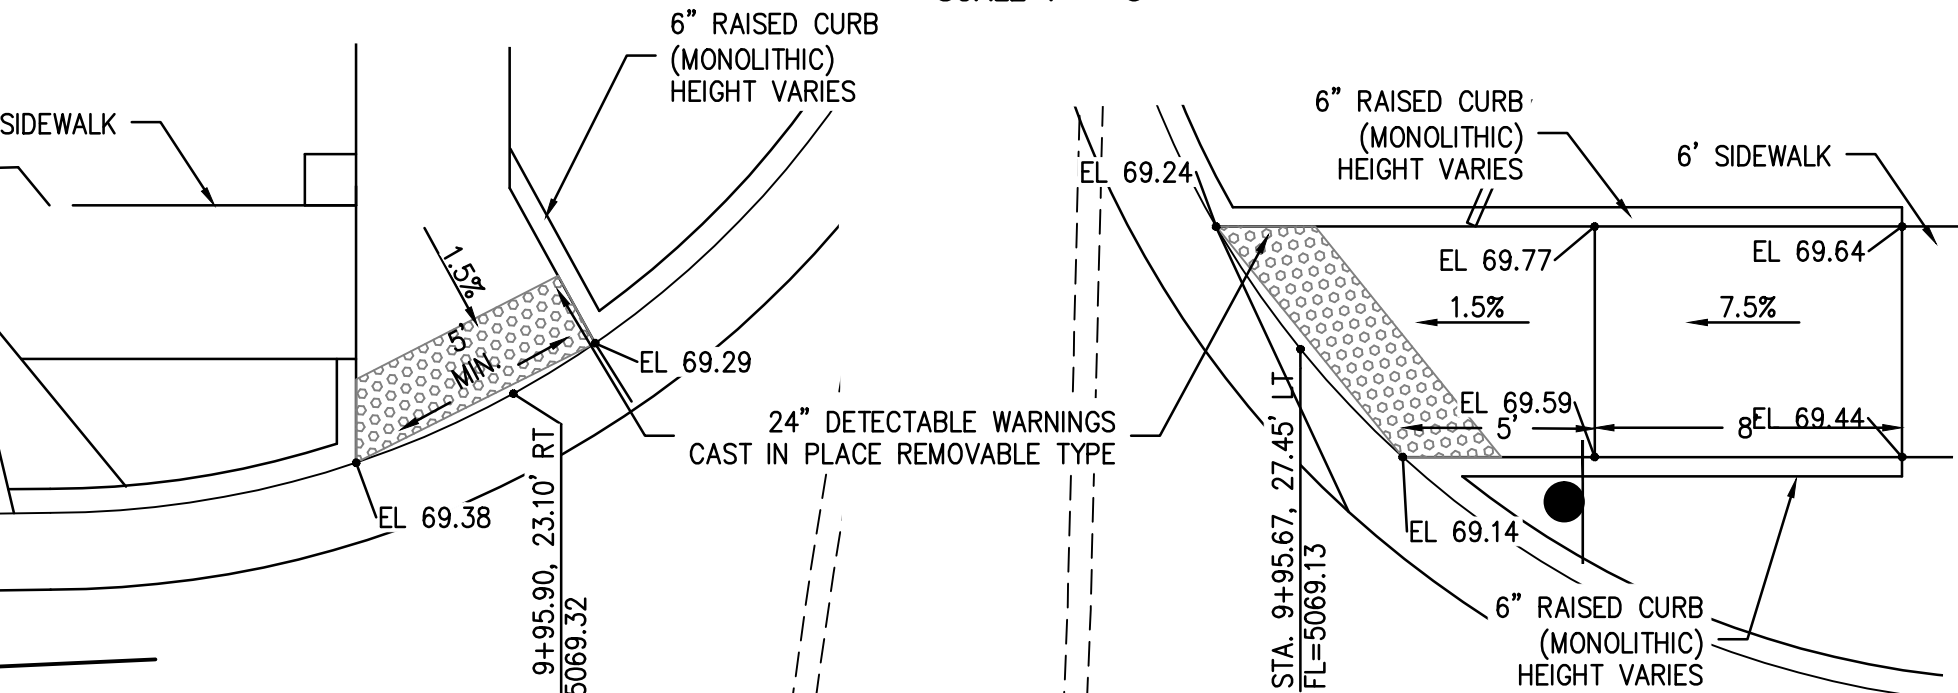


1 ADA RAMP DETAIL

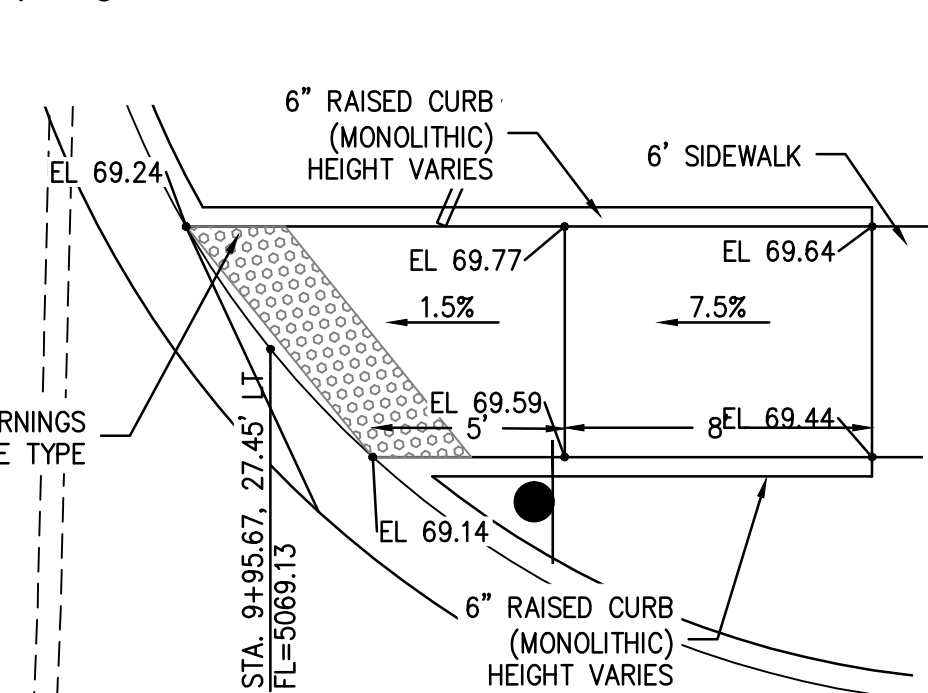


2 ADA RAMP DETAIL

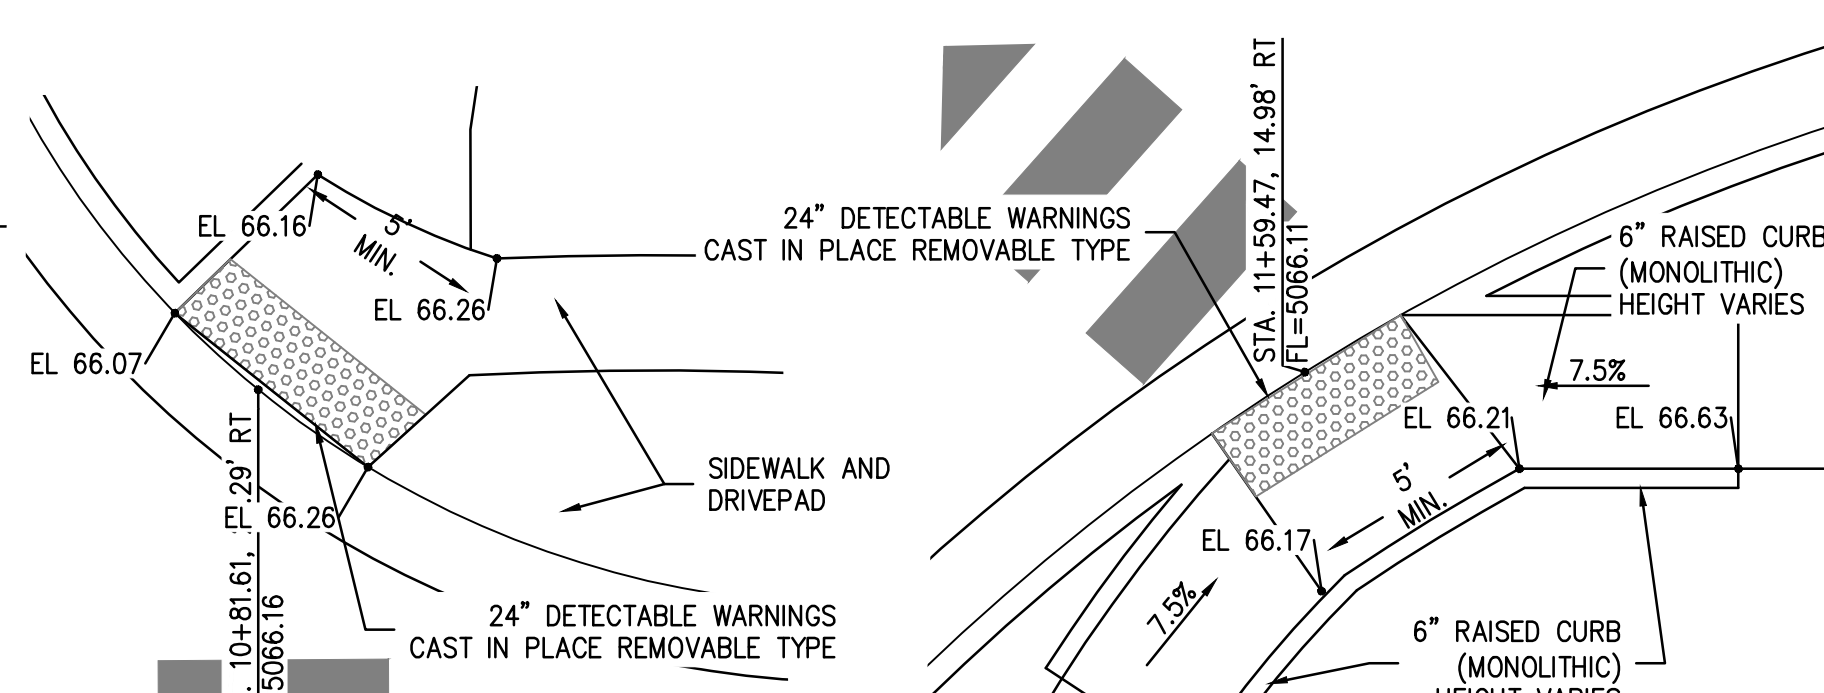


3 ADA RAMP DETAIL

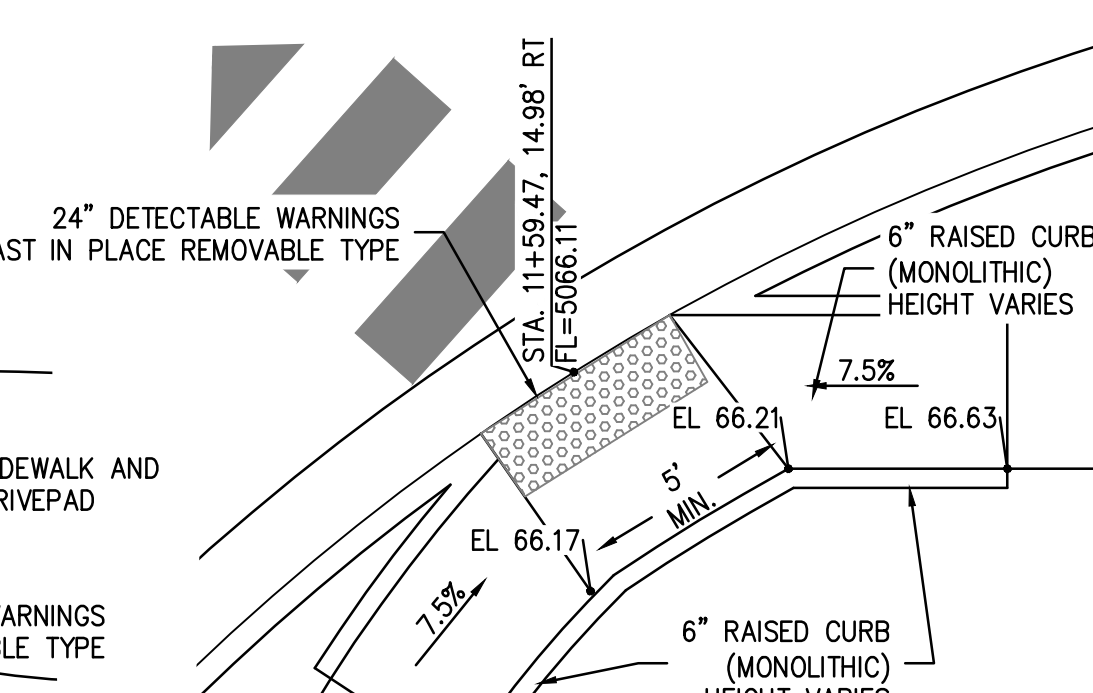


4 ADA RAMP DETAIL

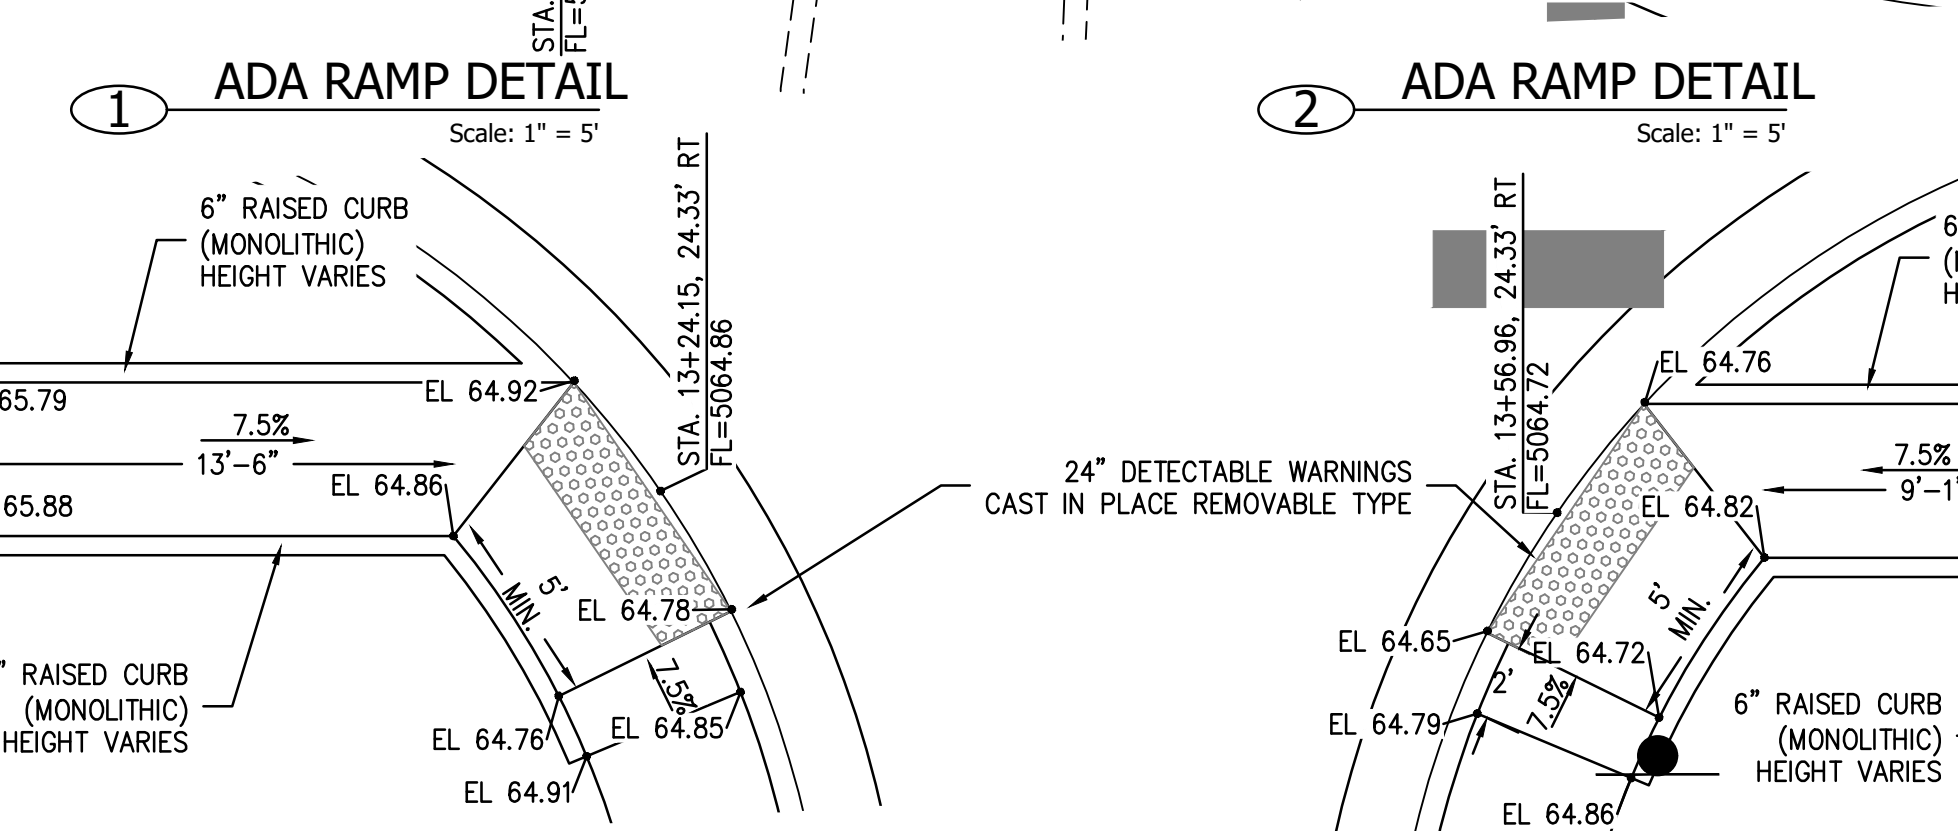


5 ADA RAMP DETAIL

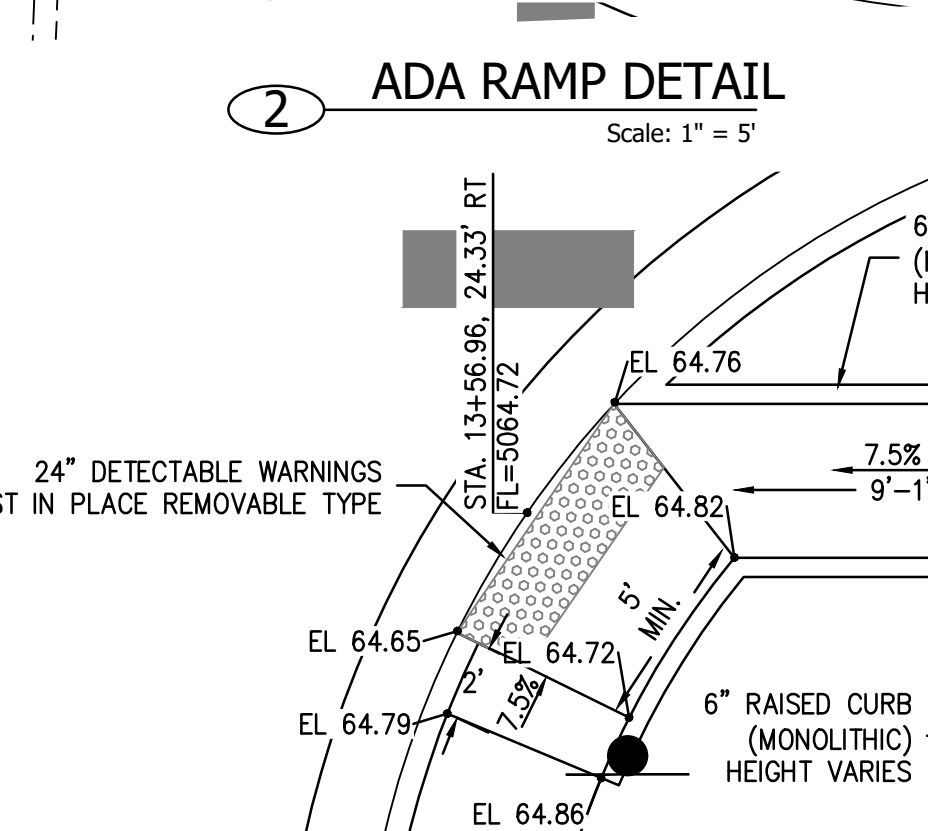


6 ADA RAMP DETAIL

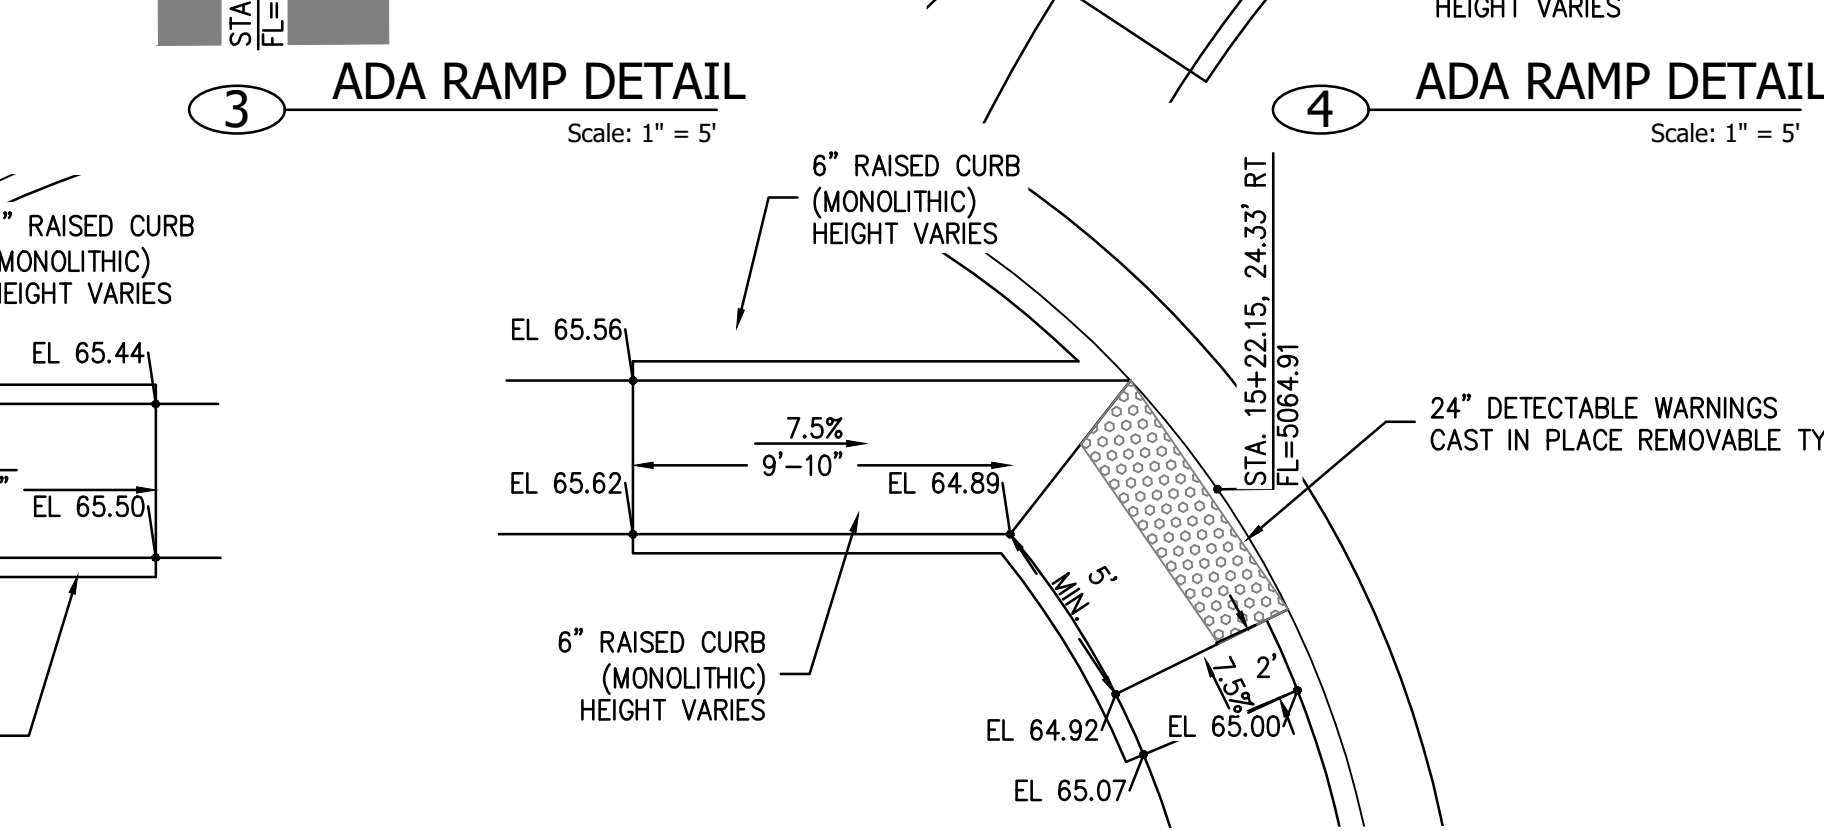


7 ADA RAMP DETAIL

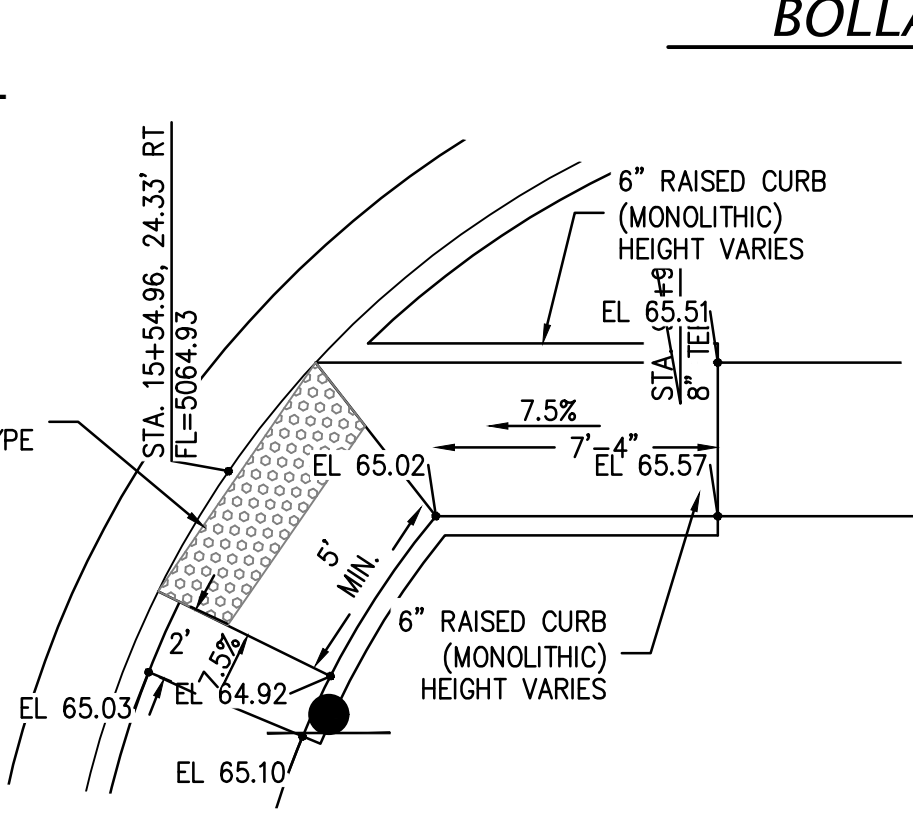


8 ADA RAMP DETAIL

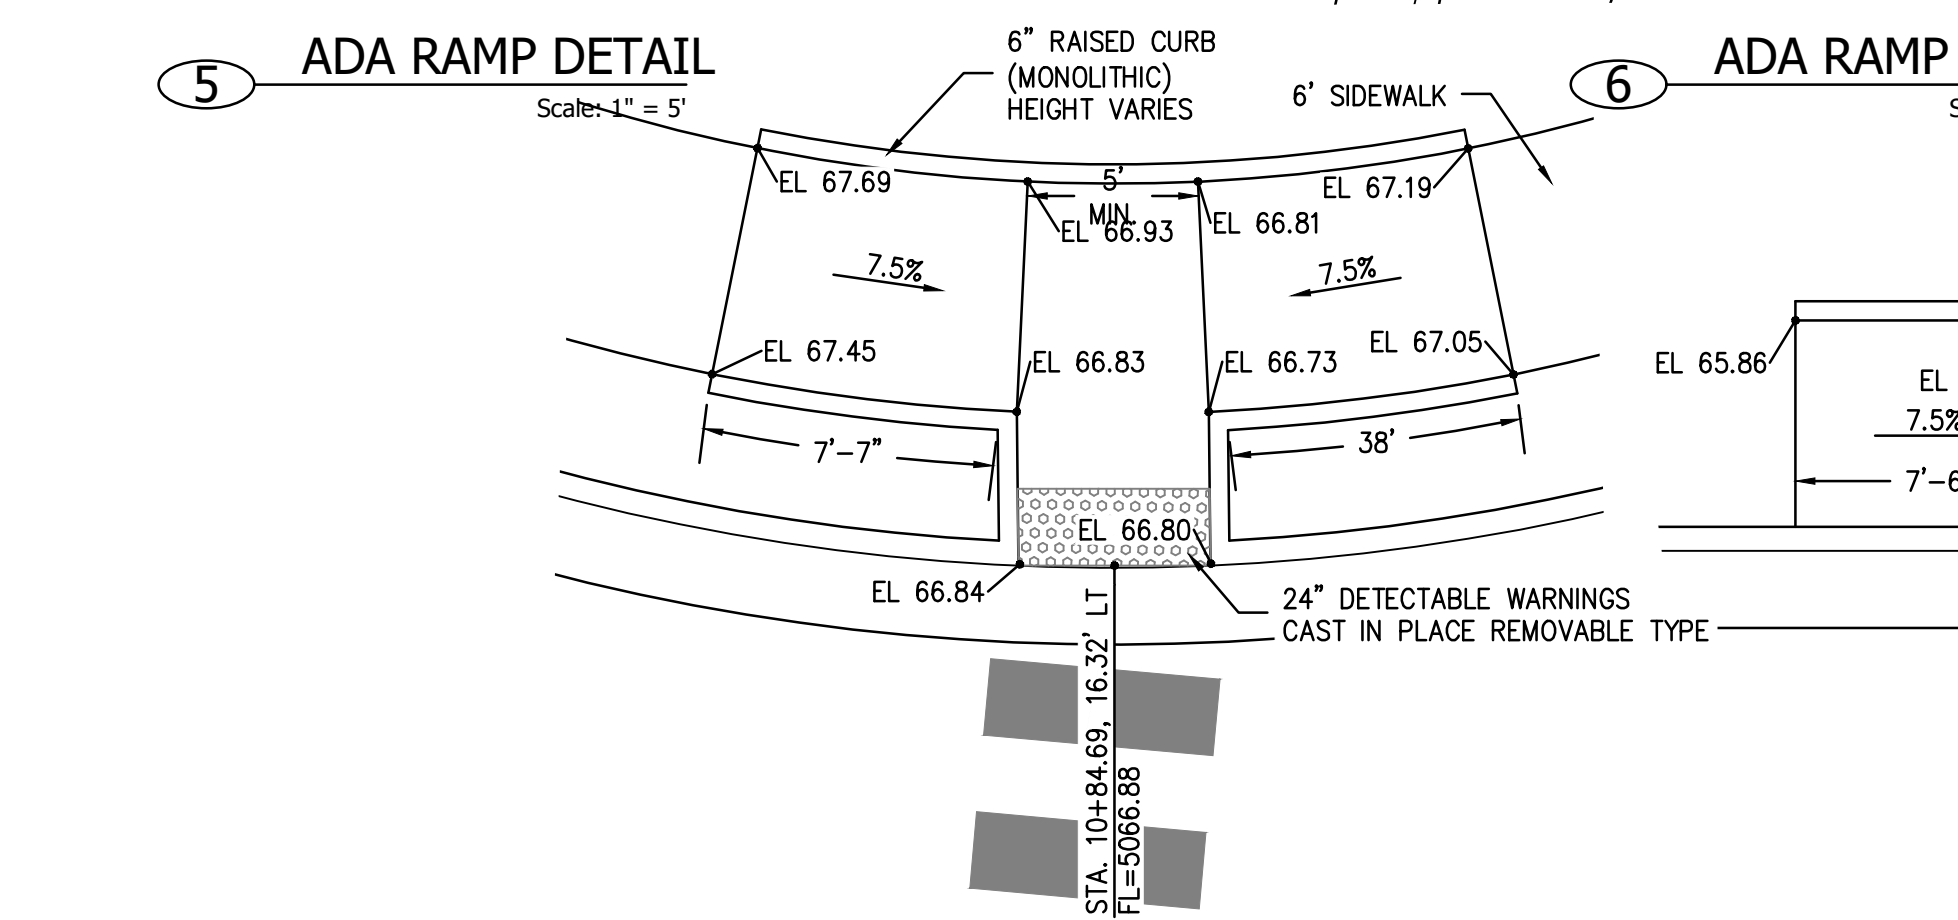


9 ADA RAMP DETAIL

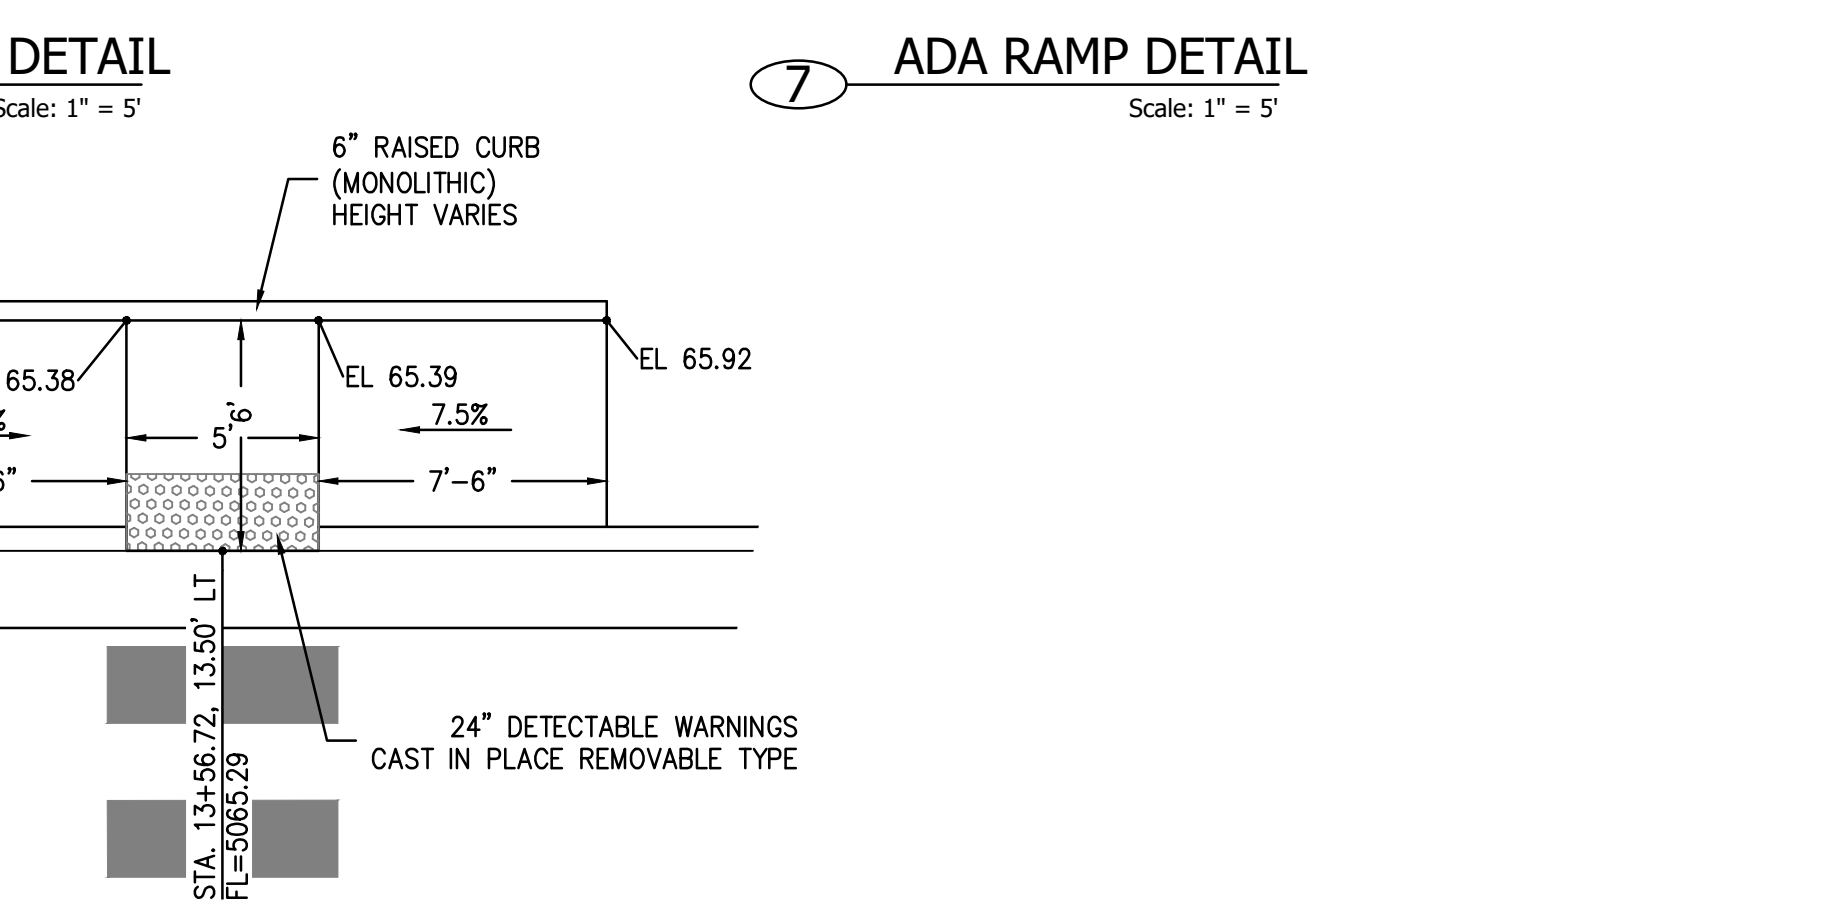











































































































































10 ADA RAMP DETAIL



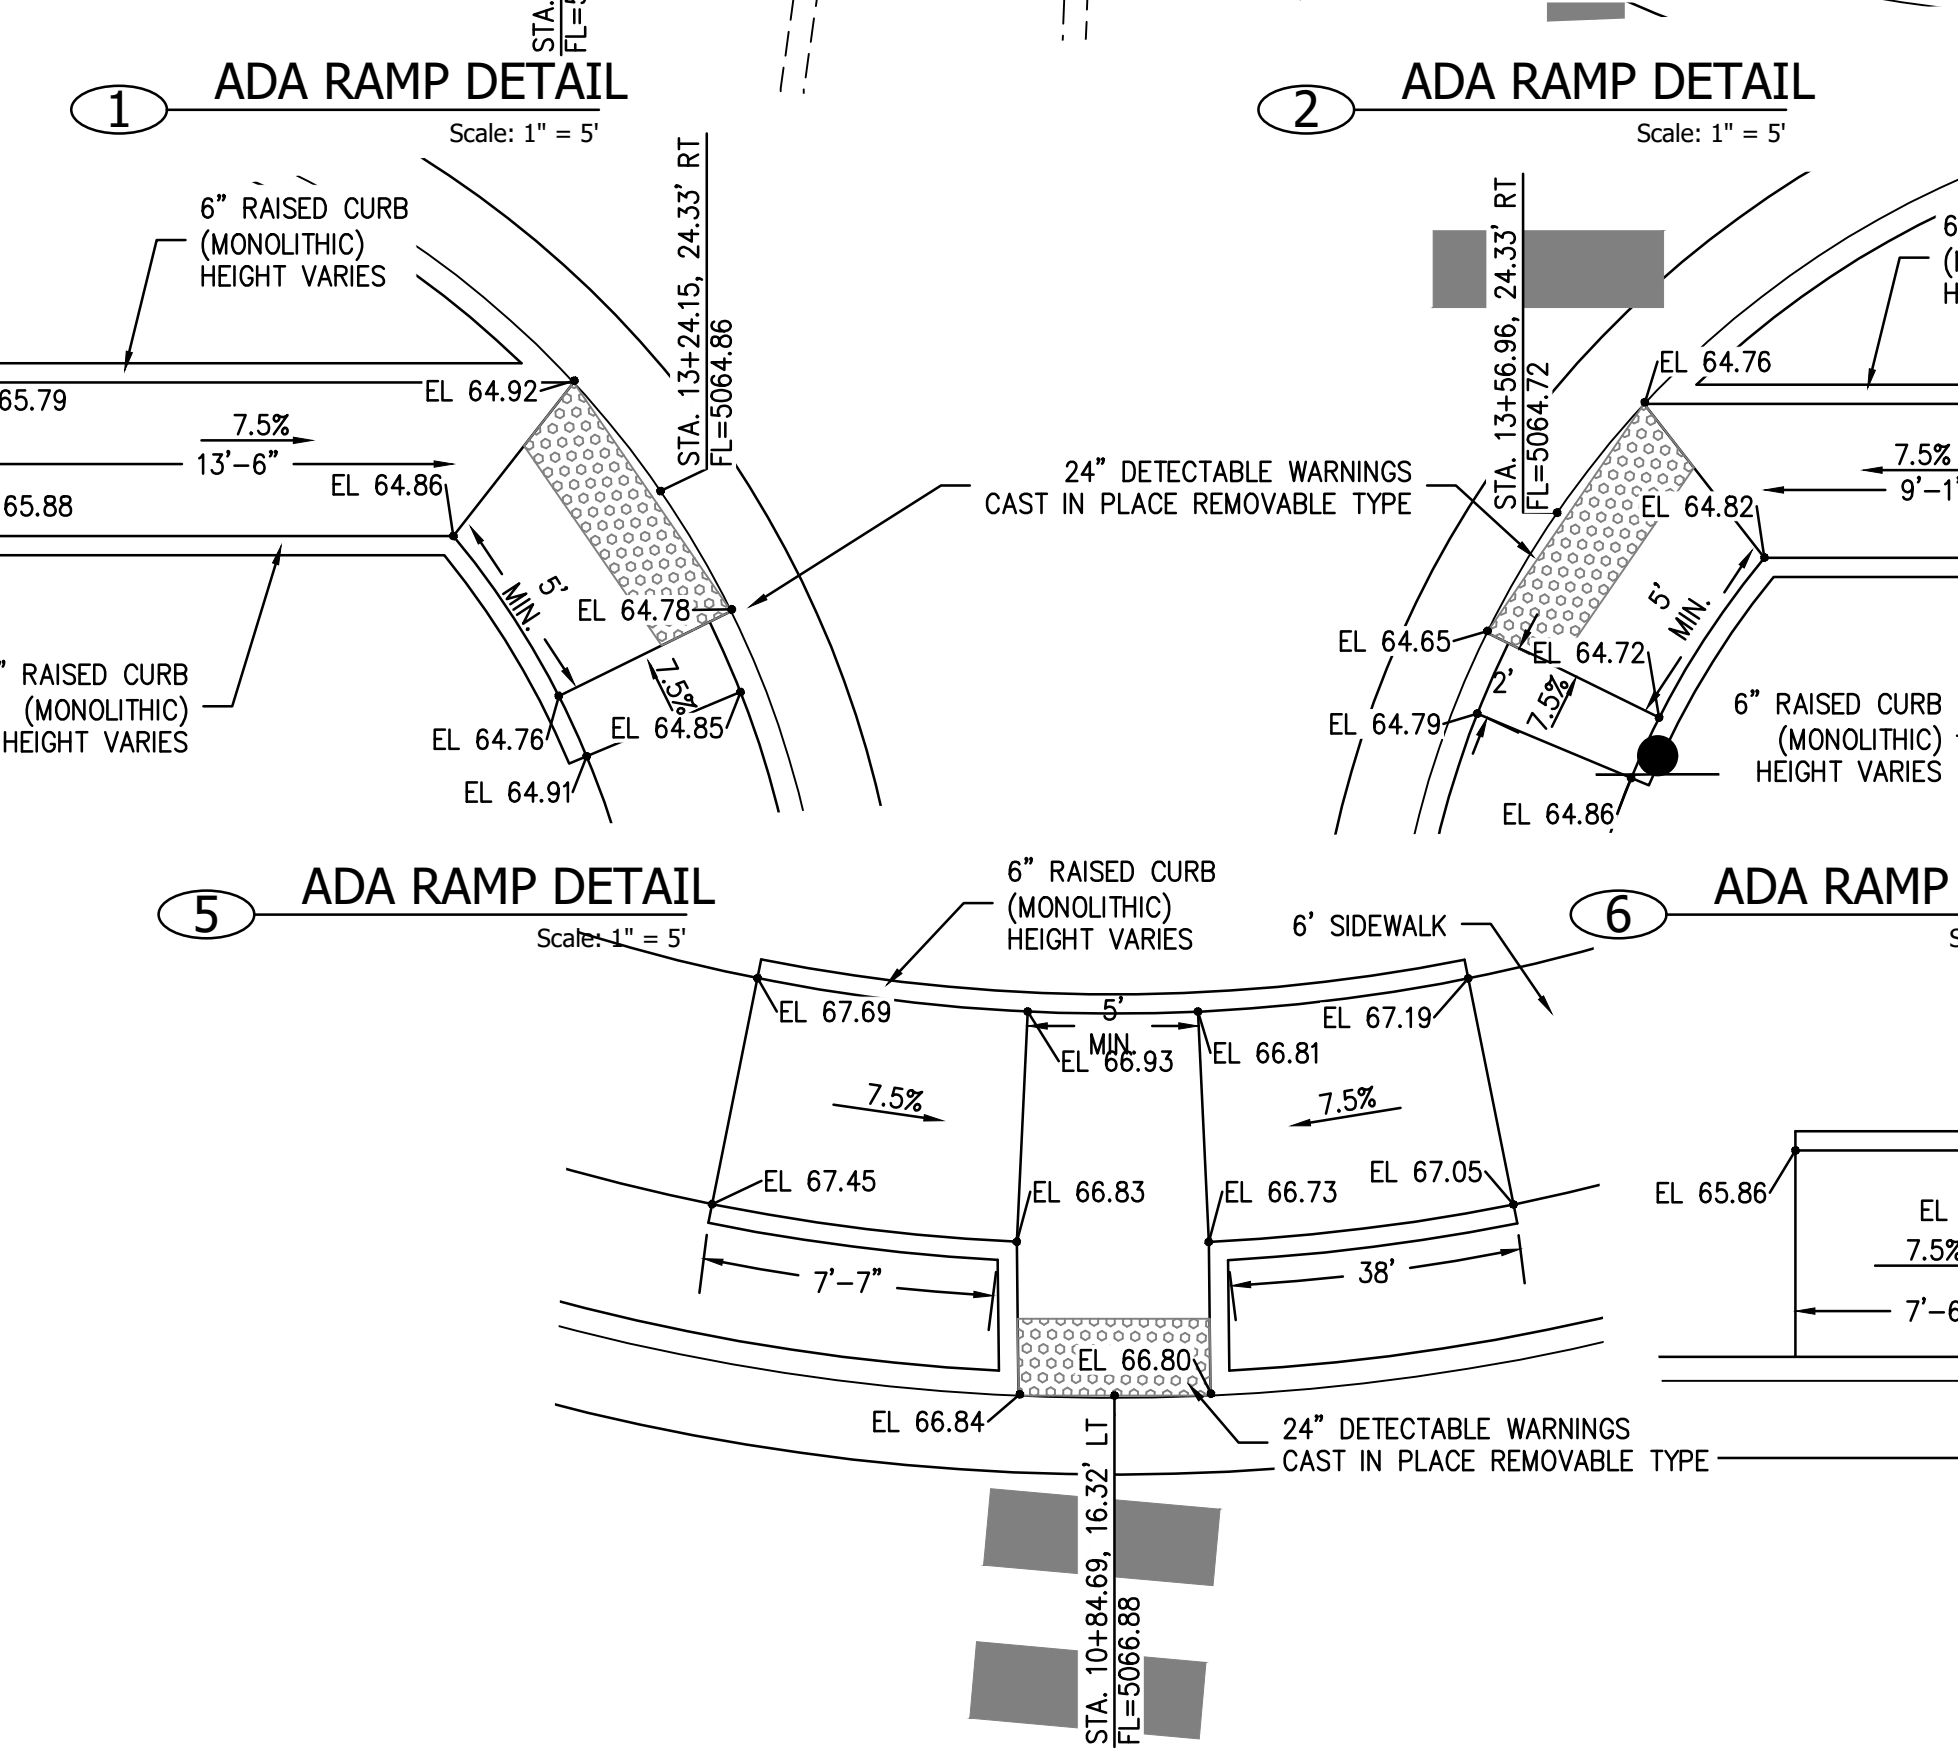


BOLLARD DETAIL

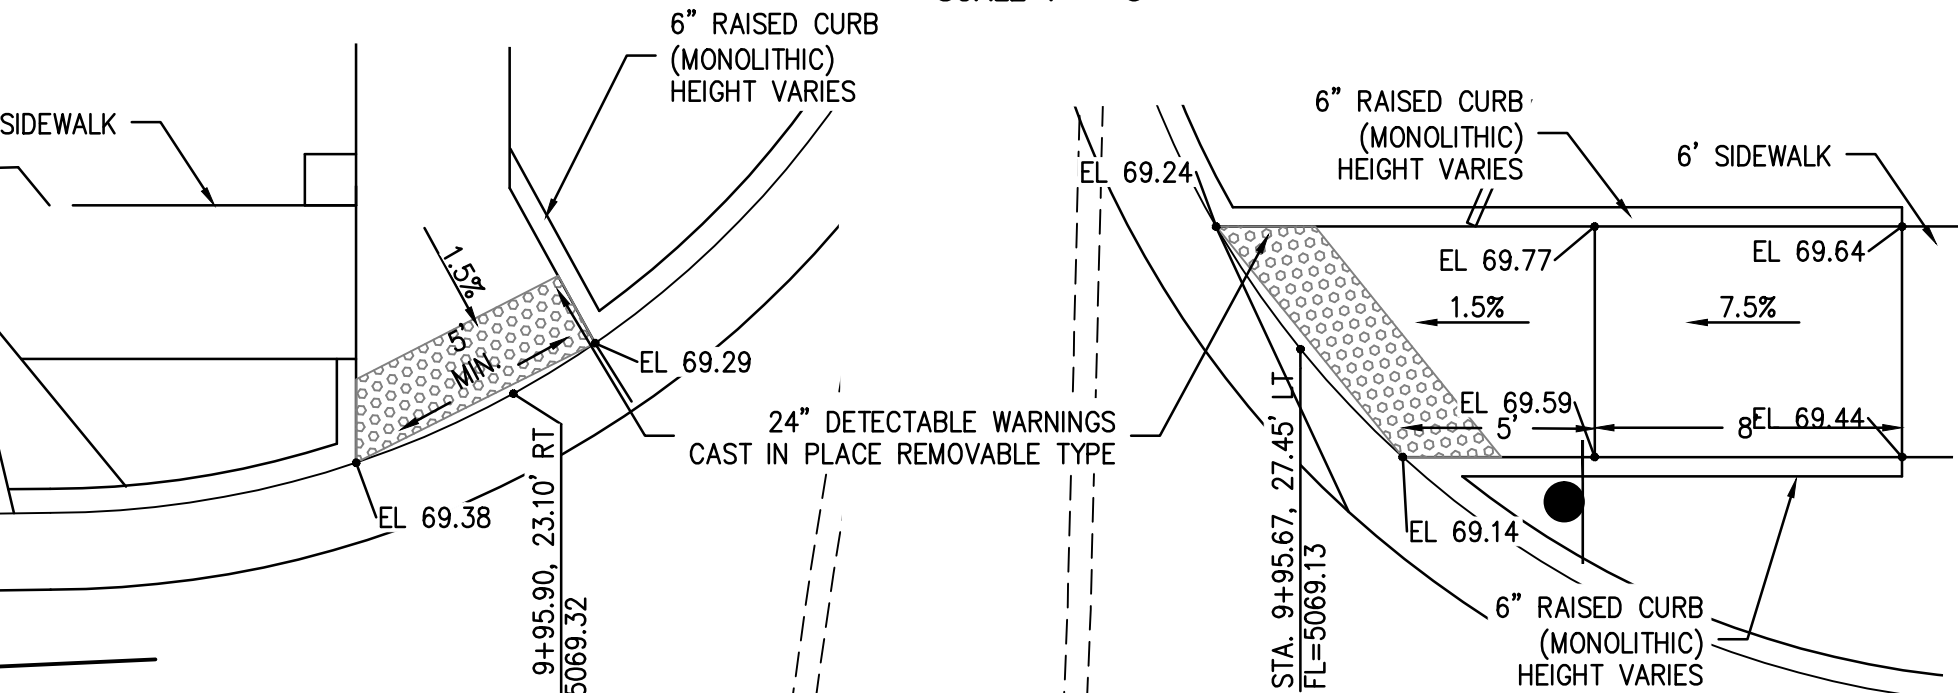

TYPICAL PAVEMENT SECTION

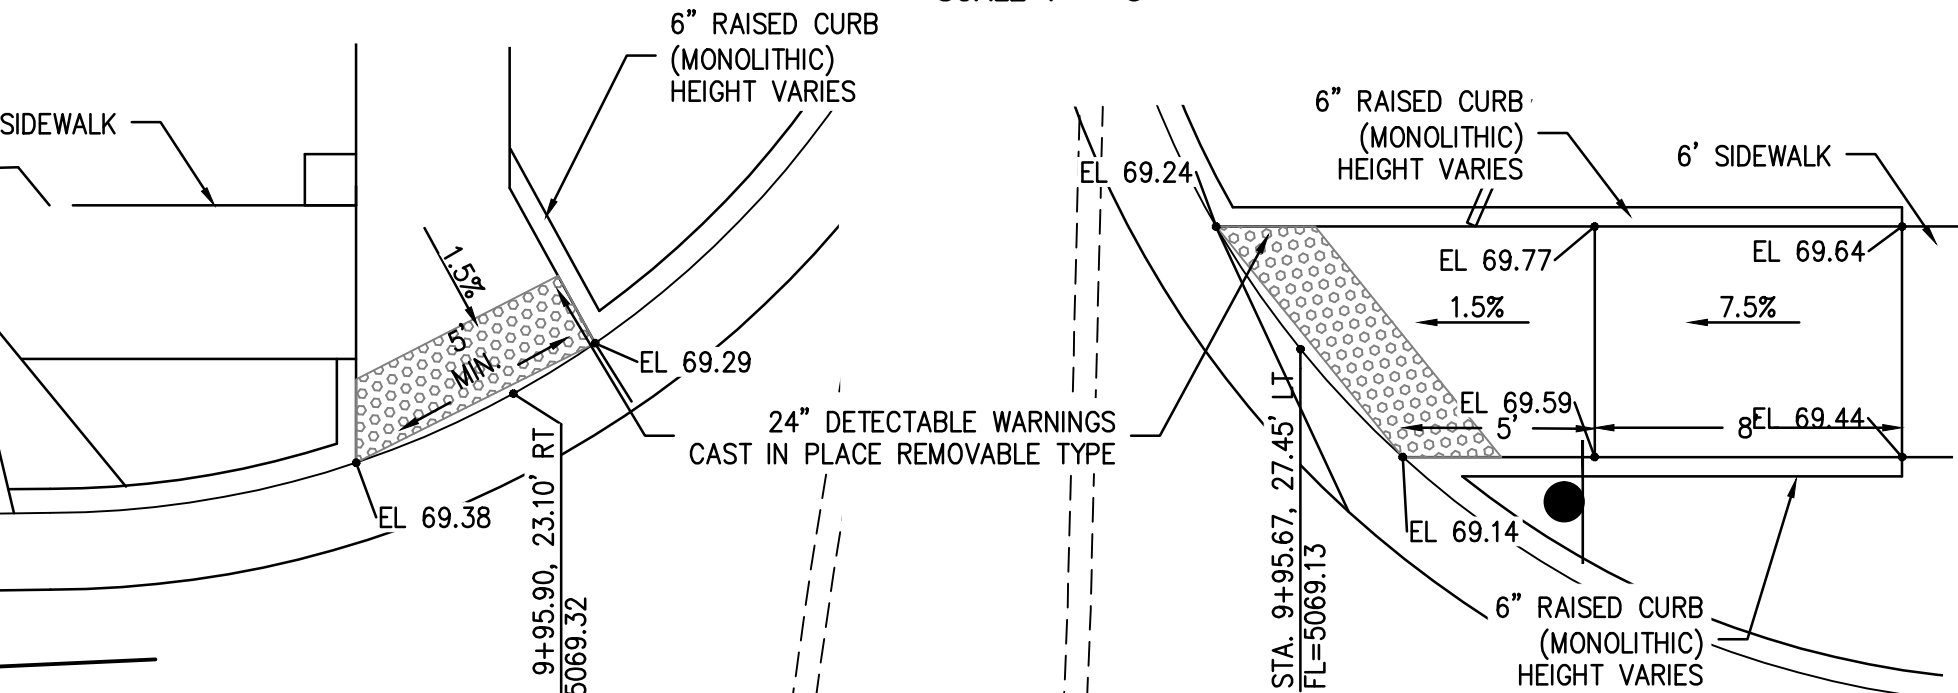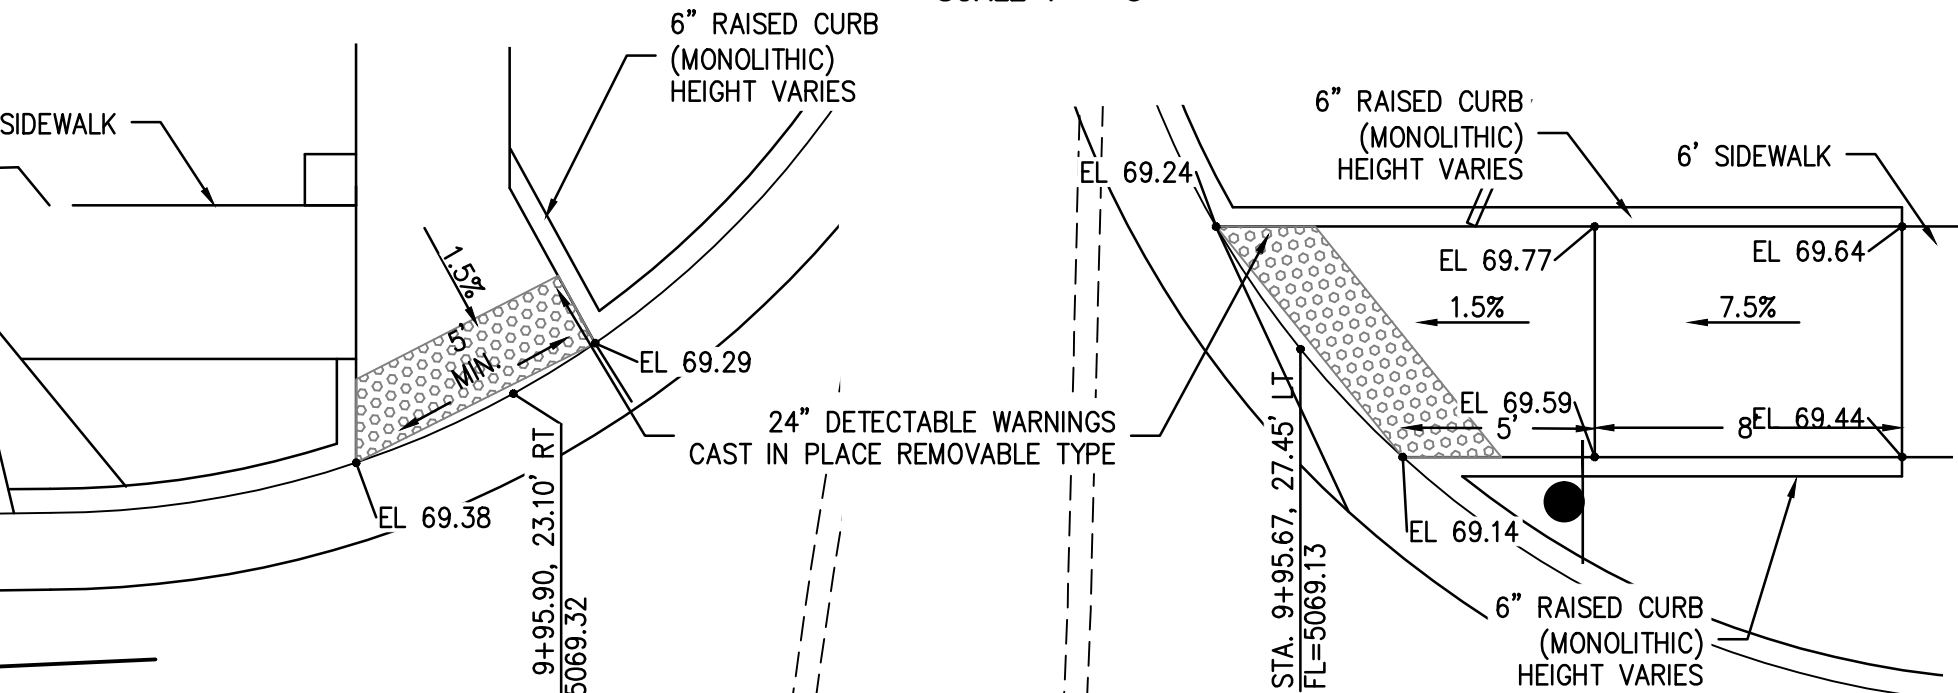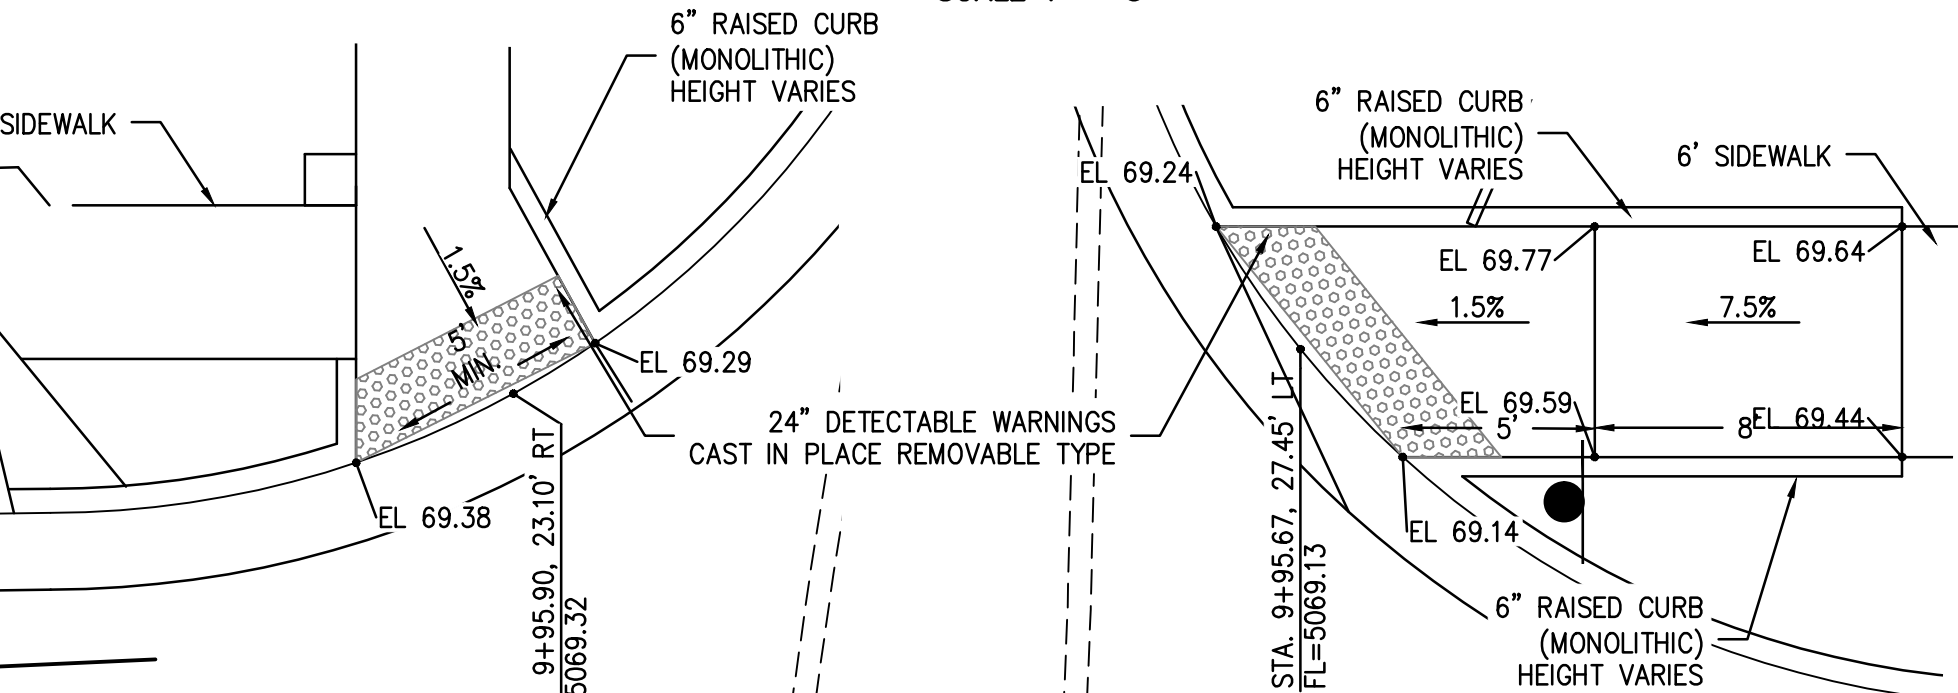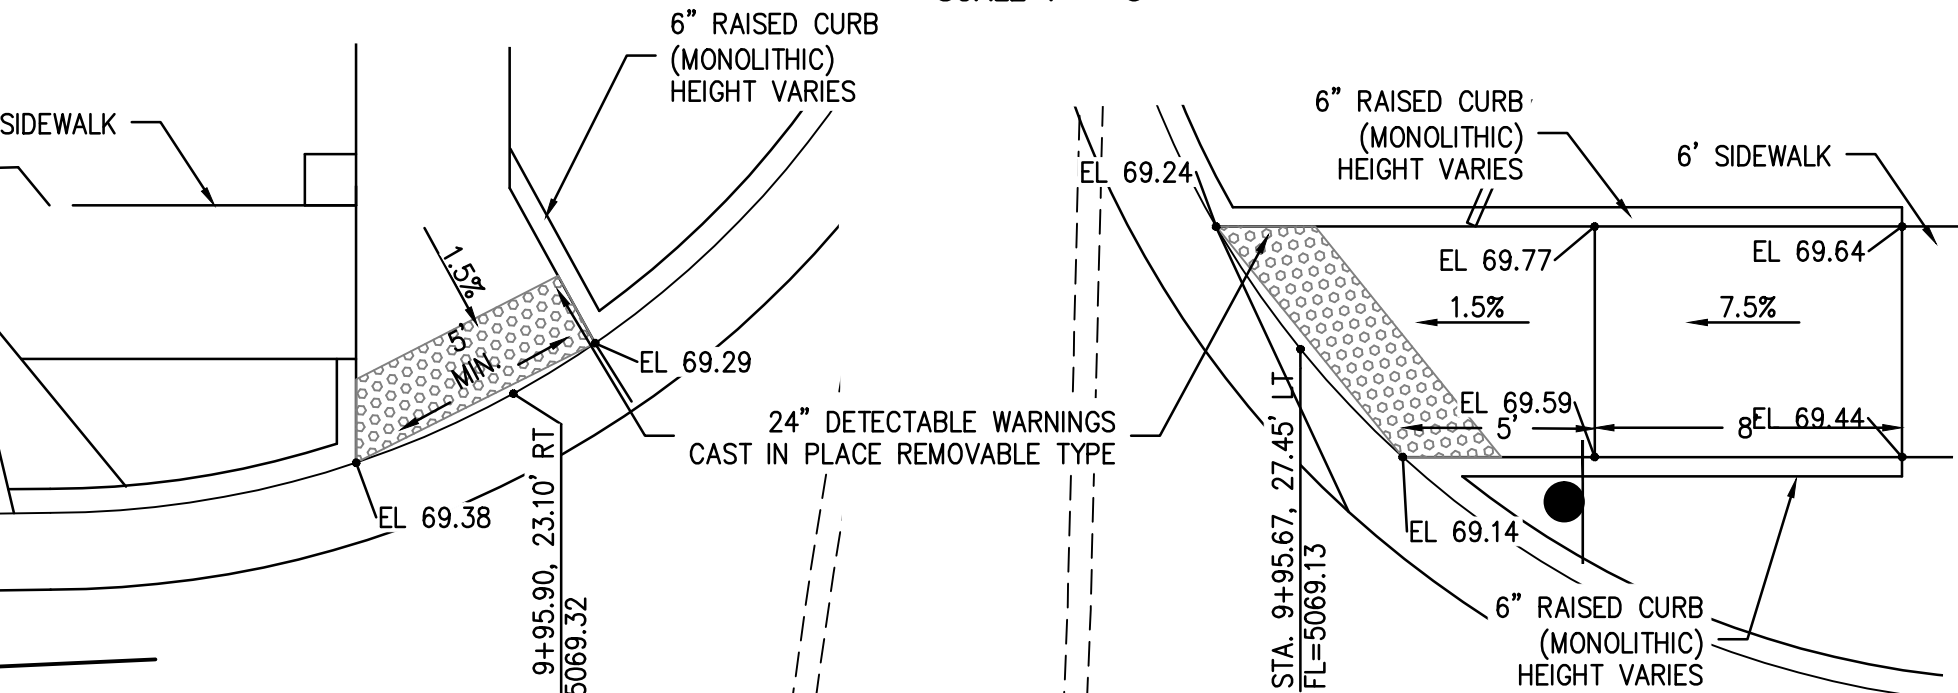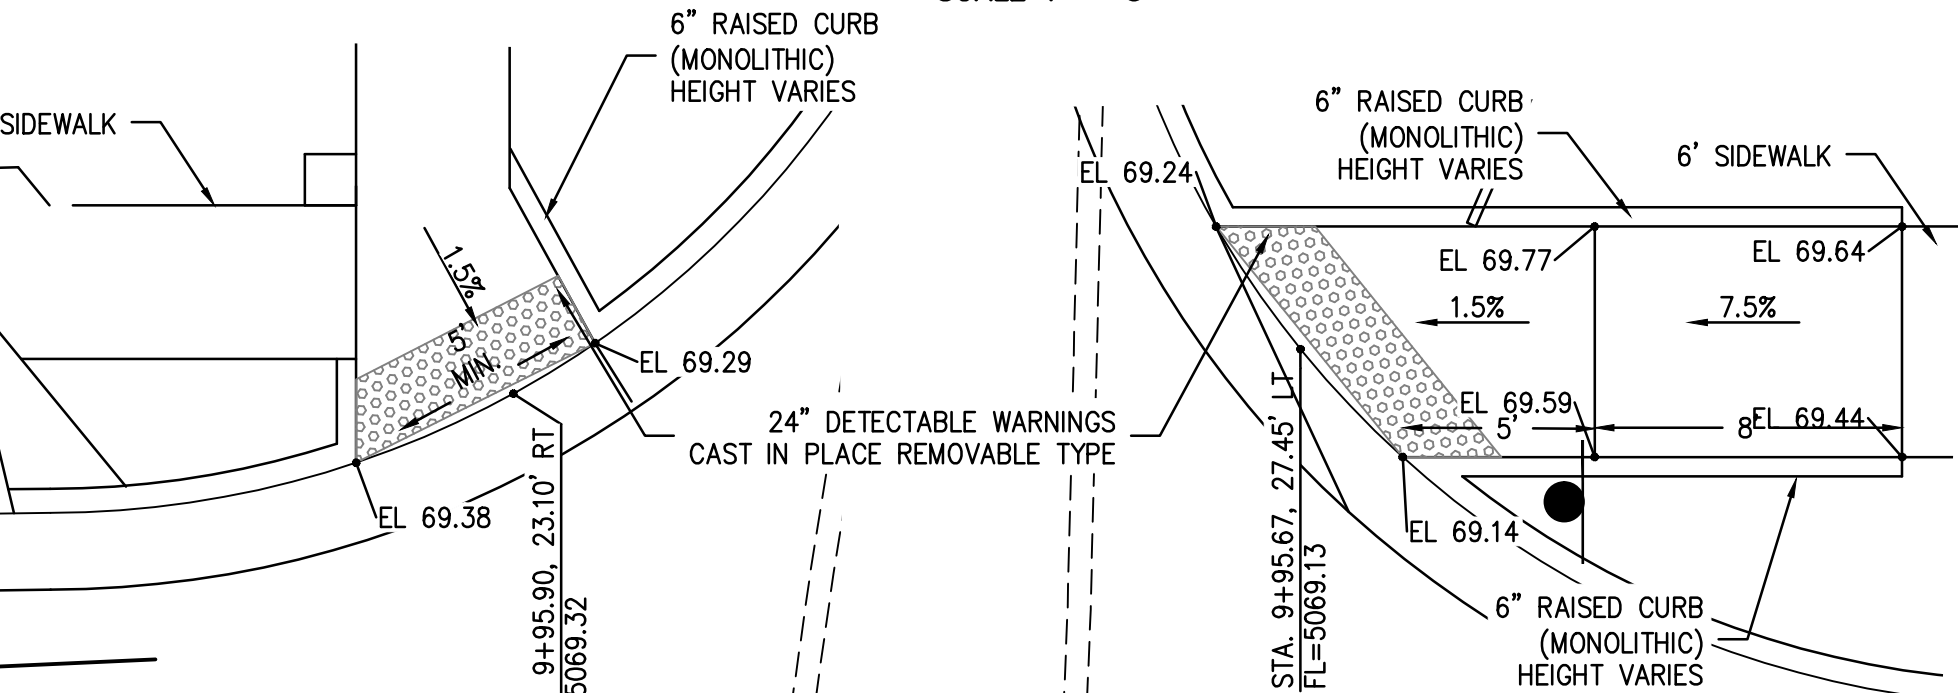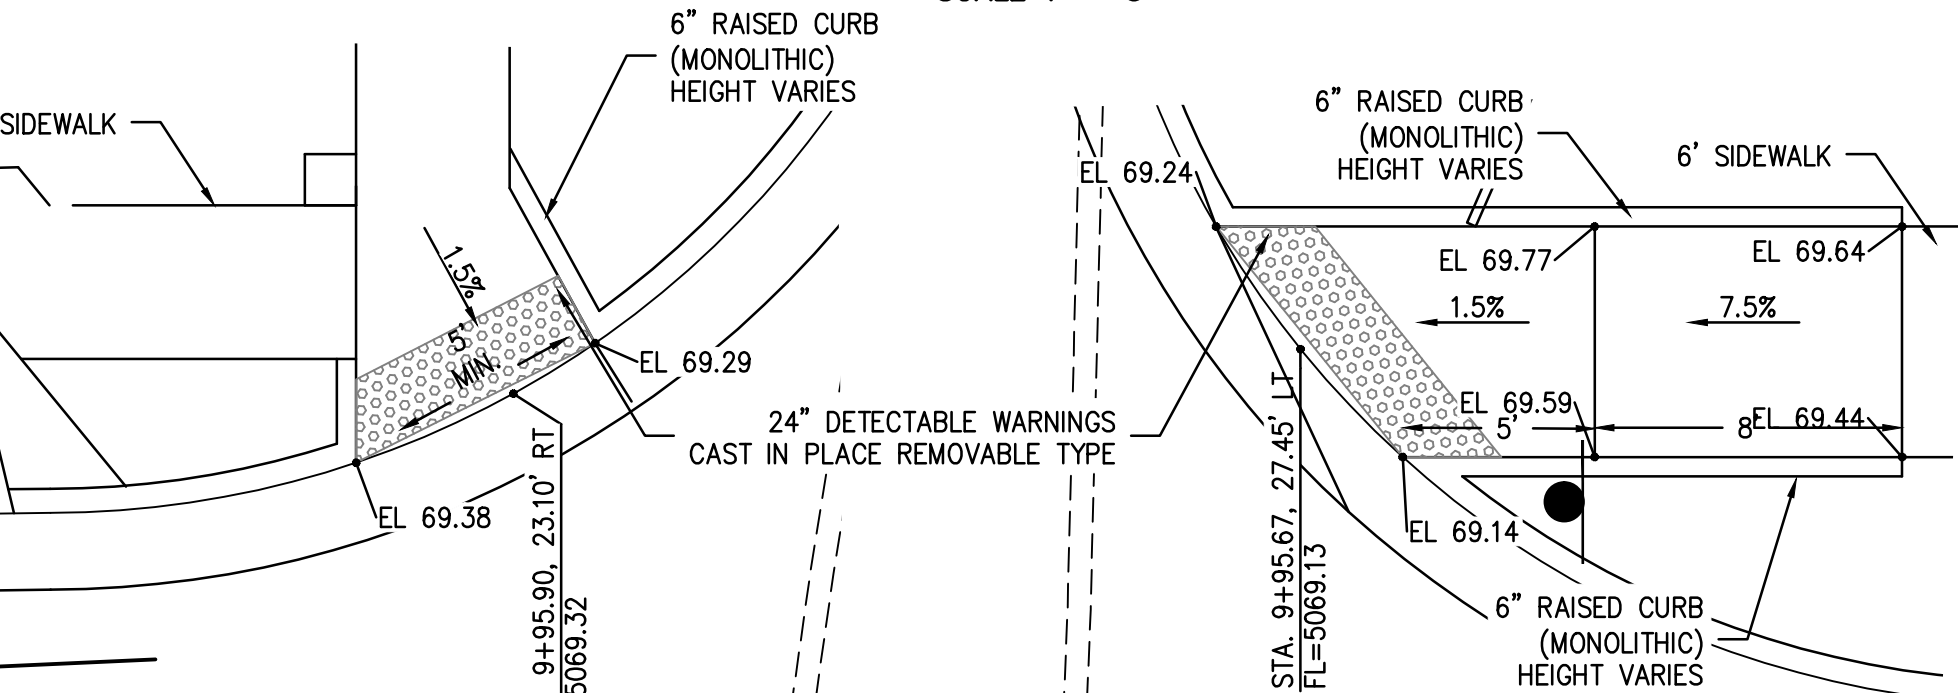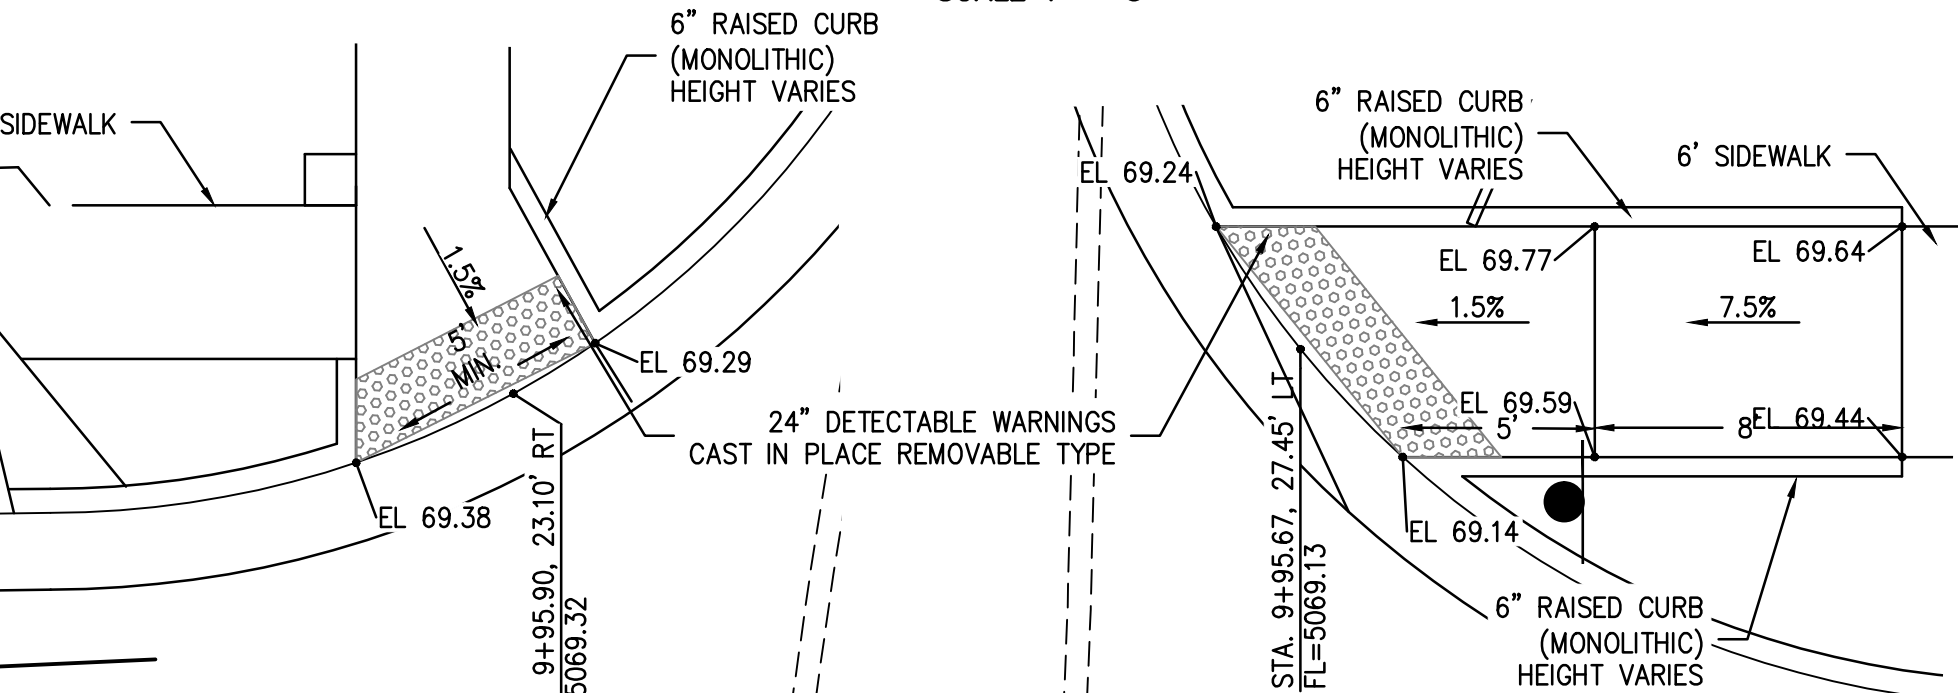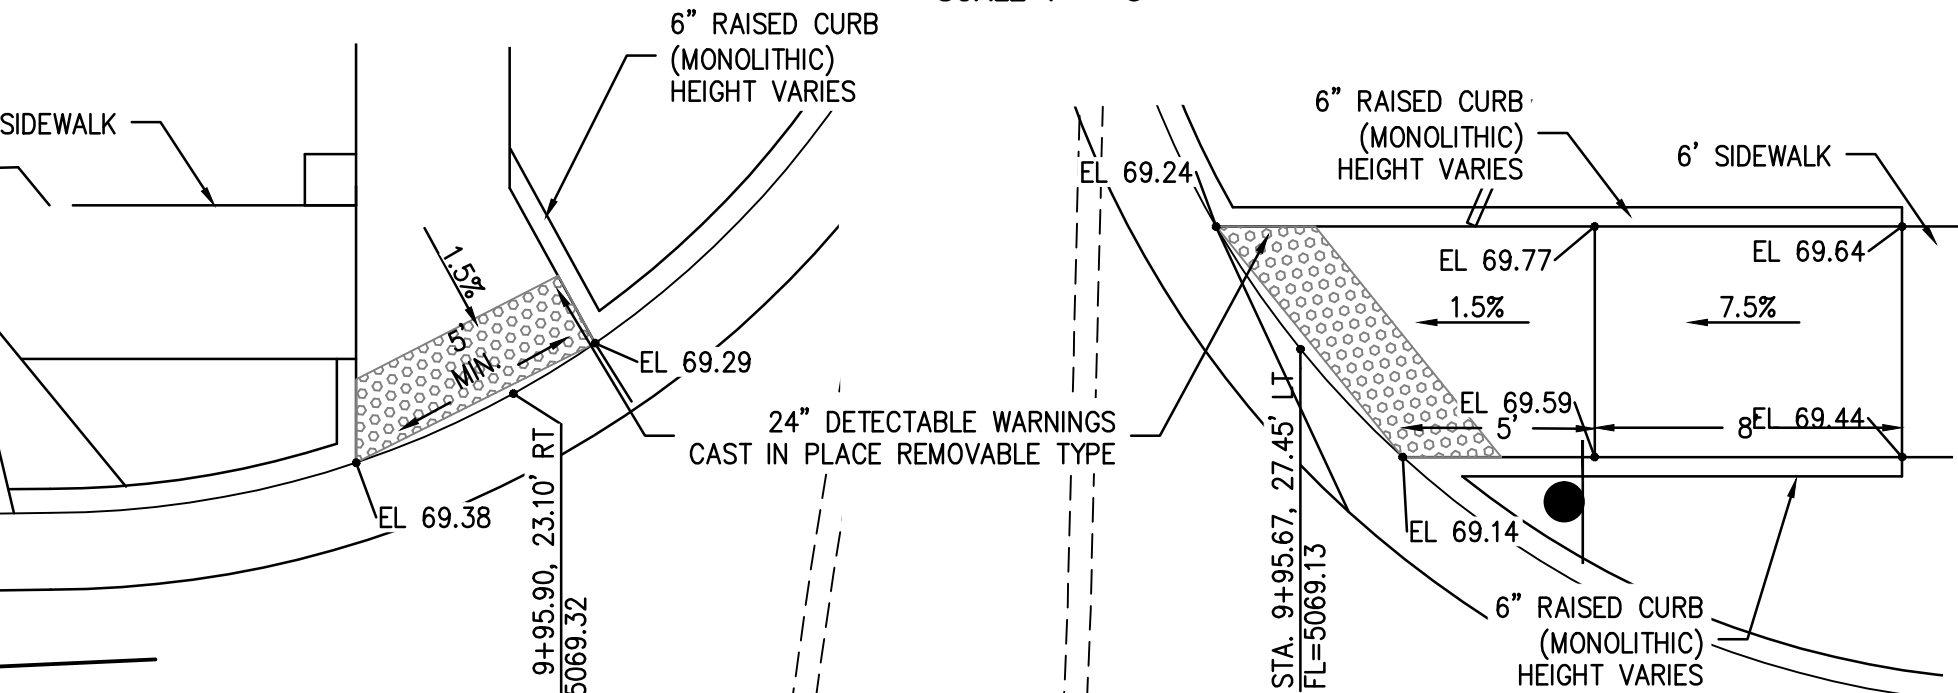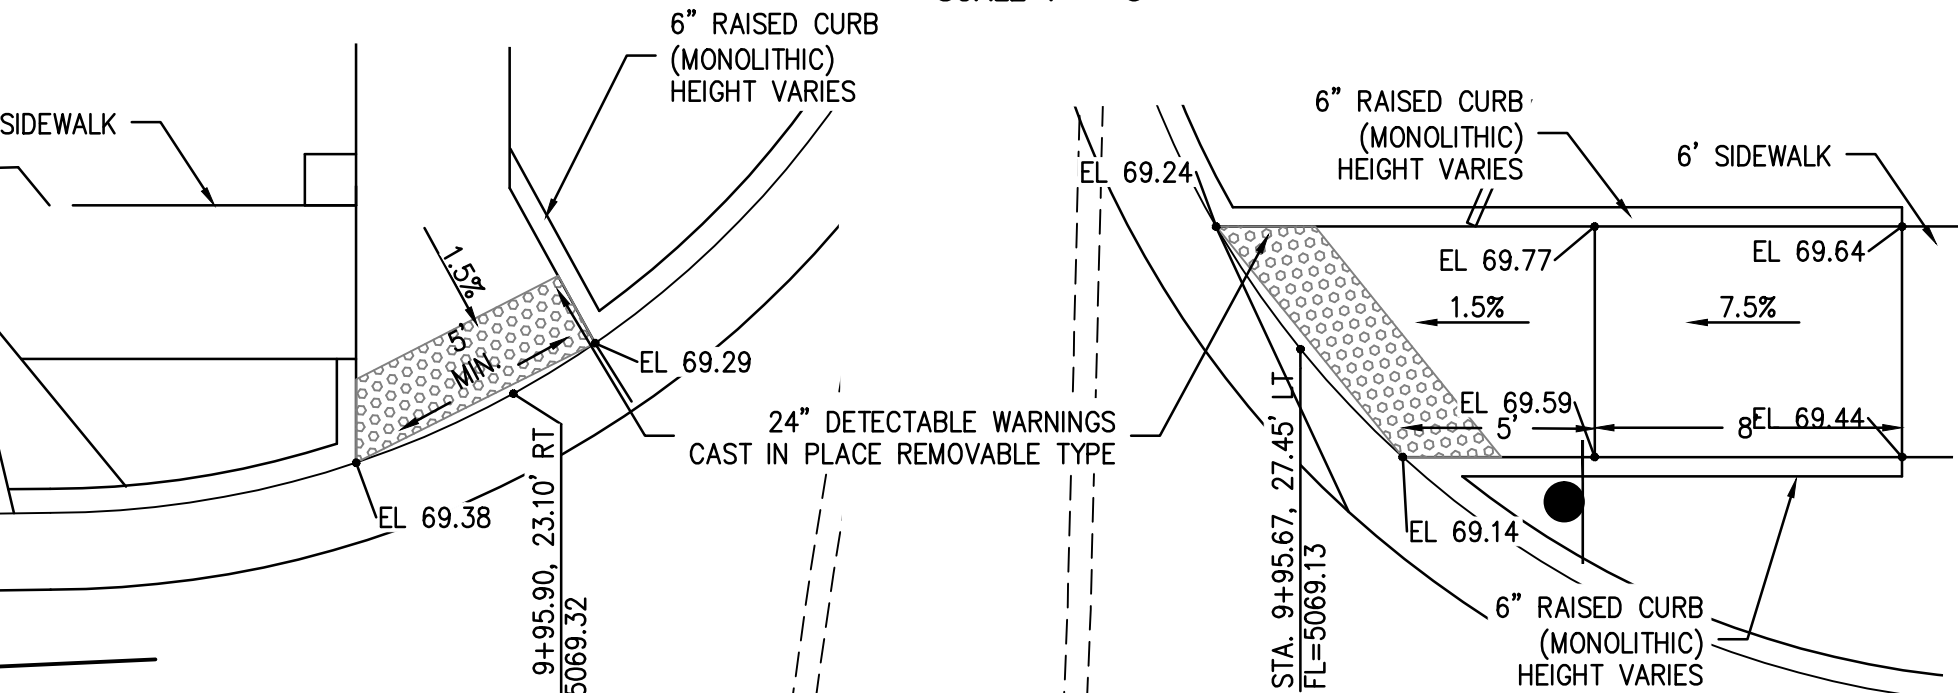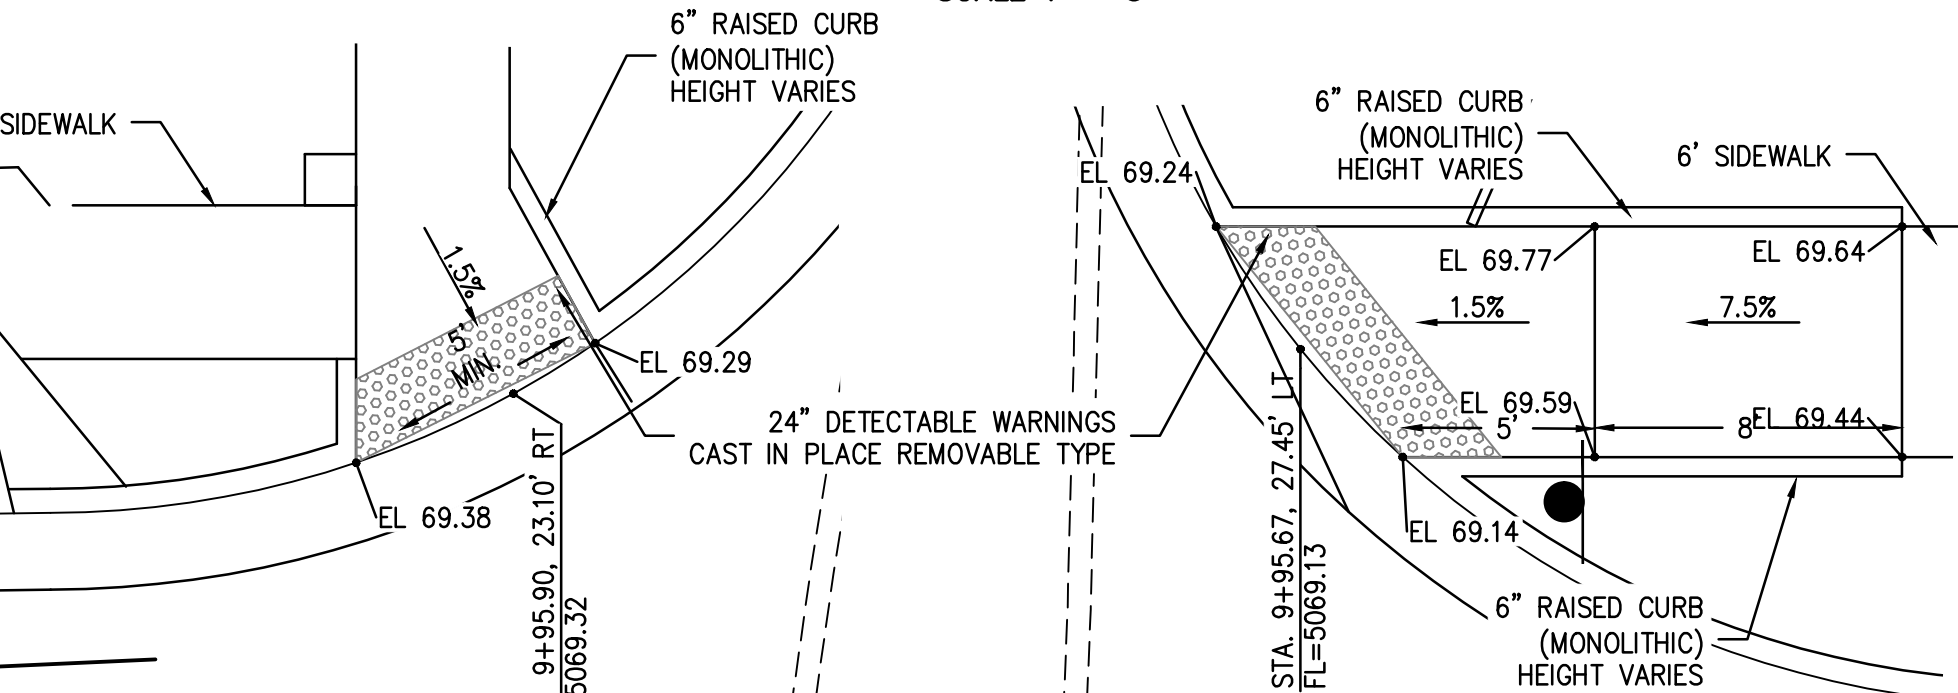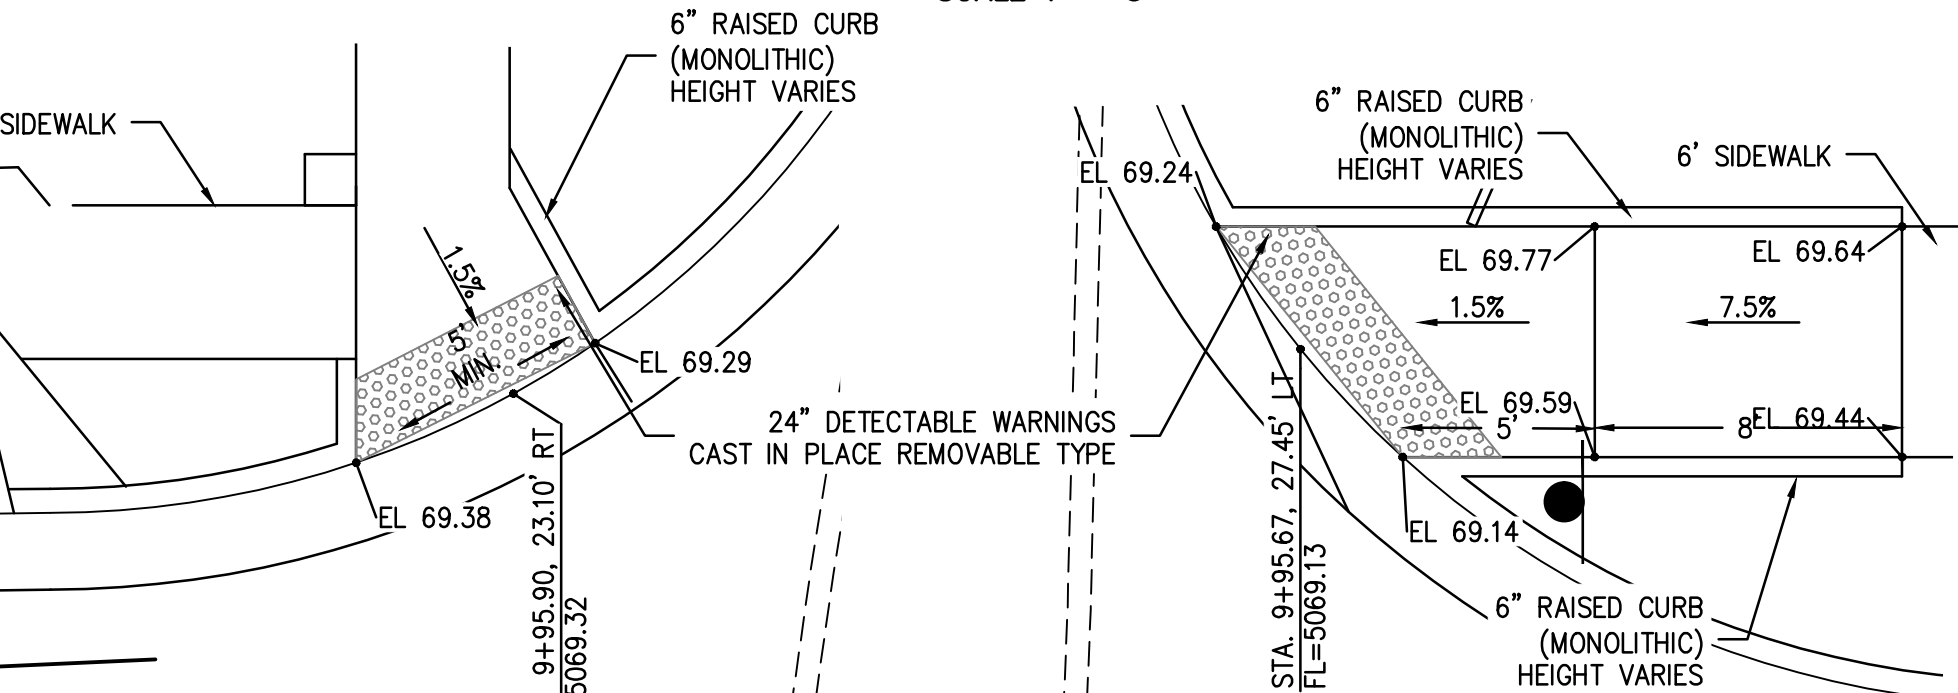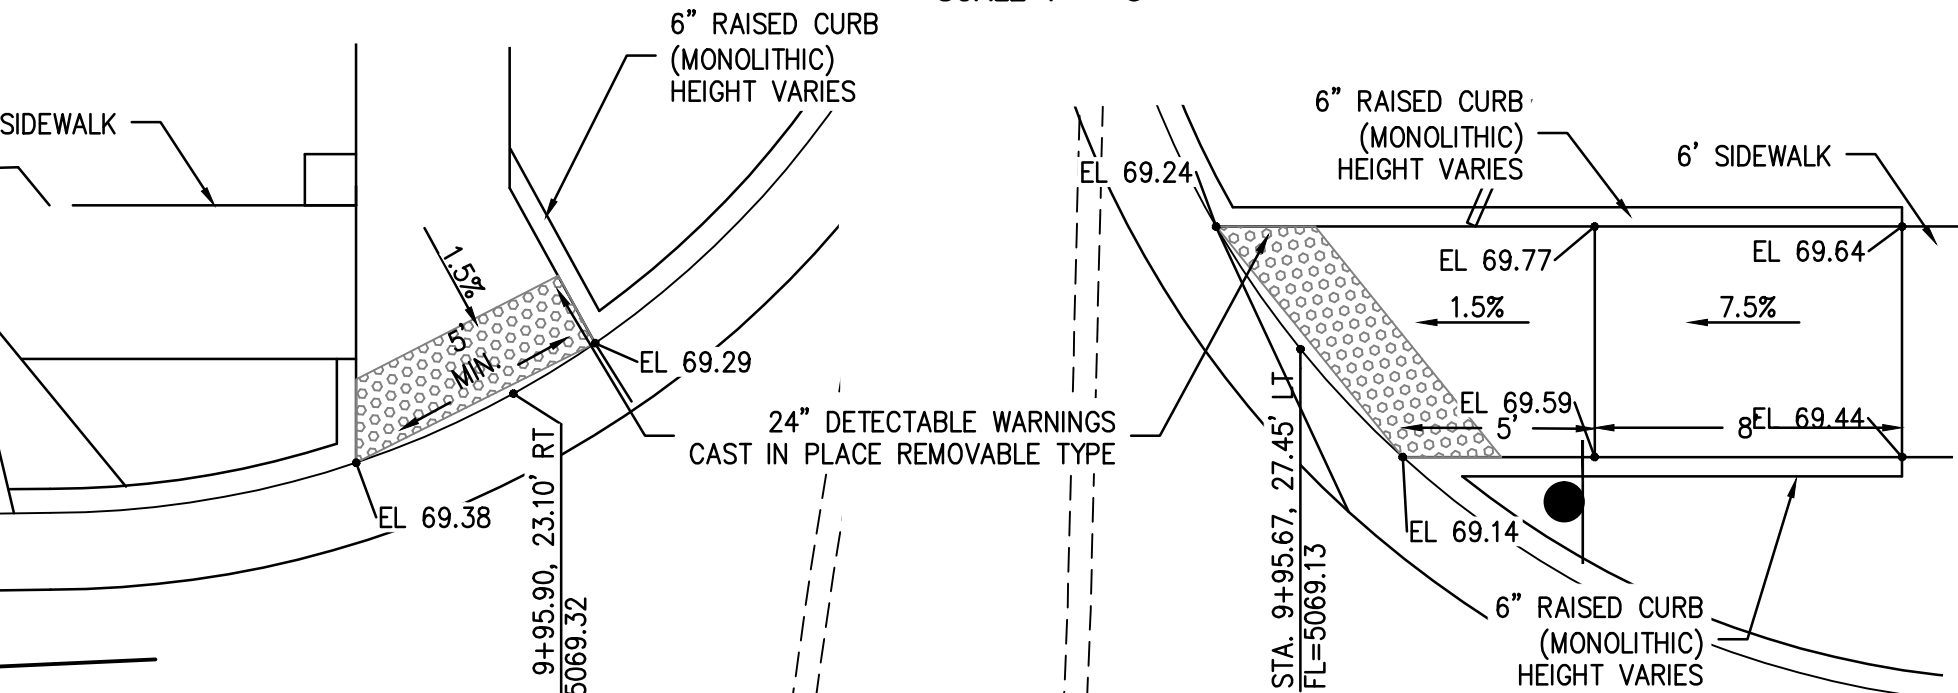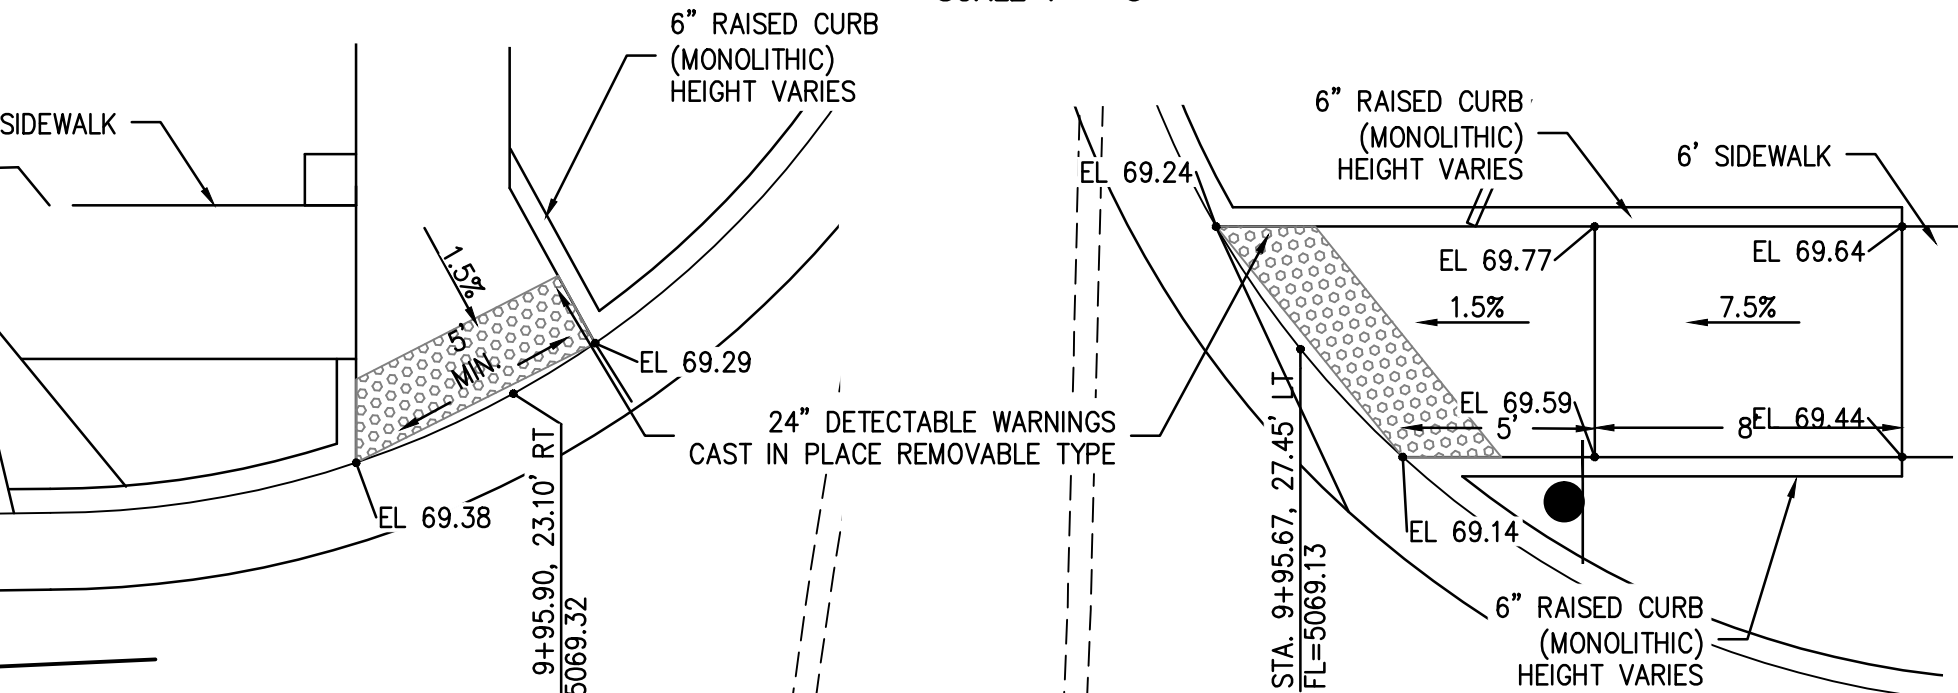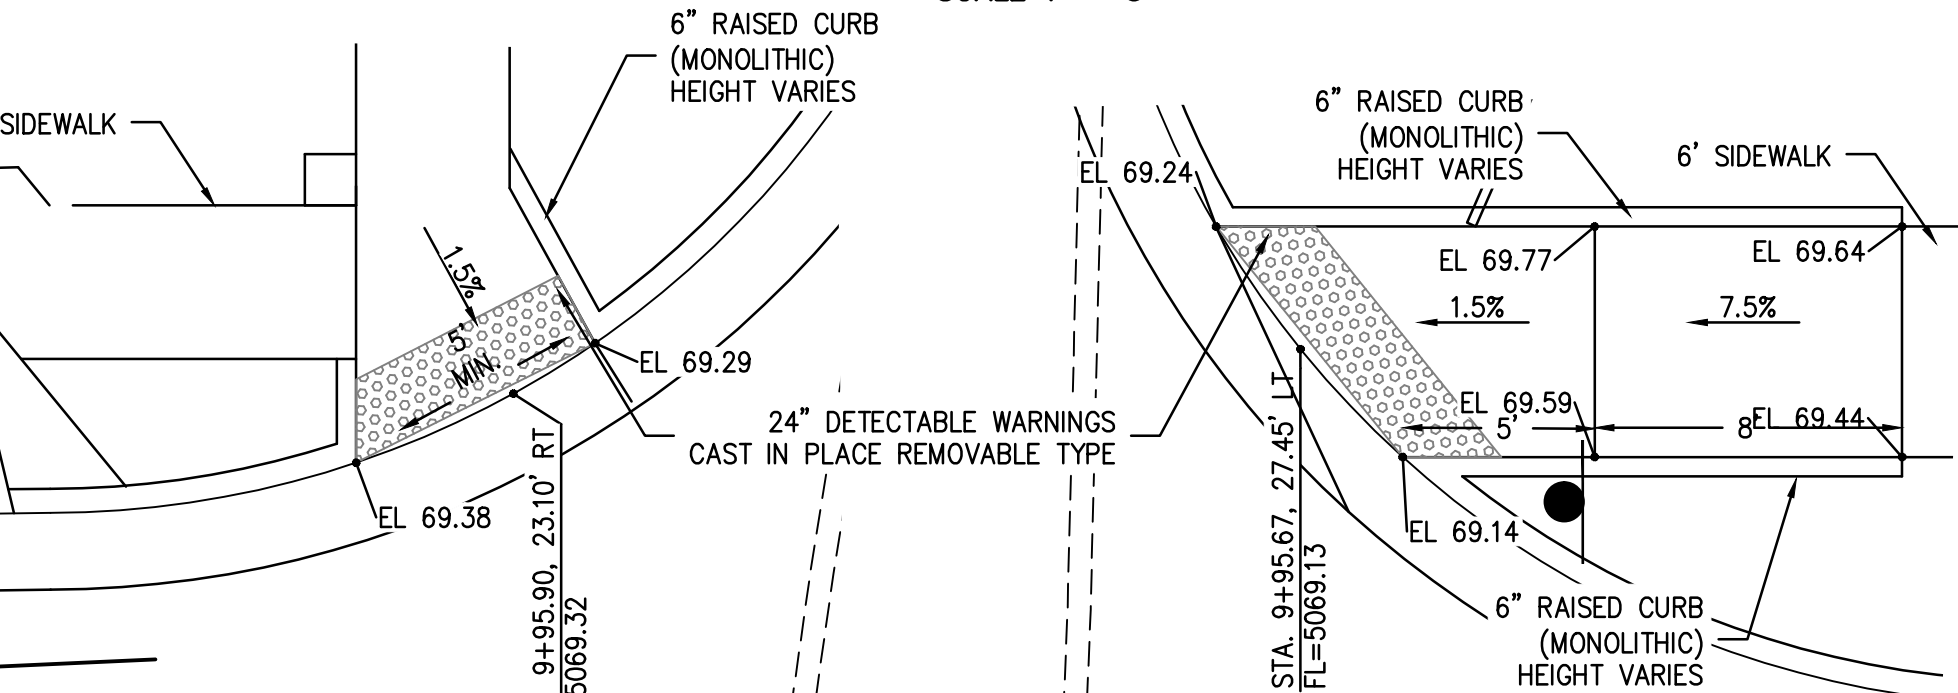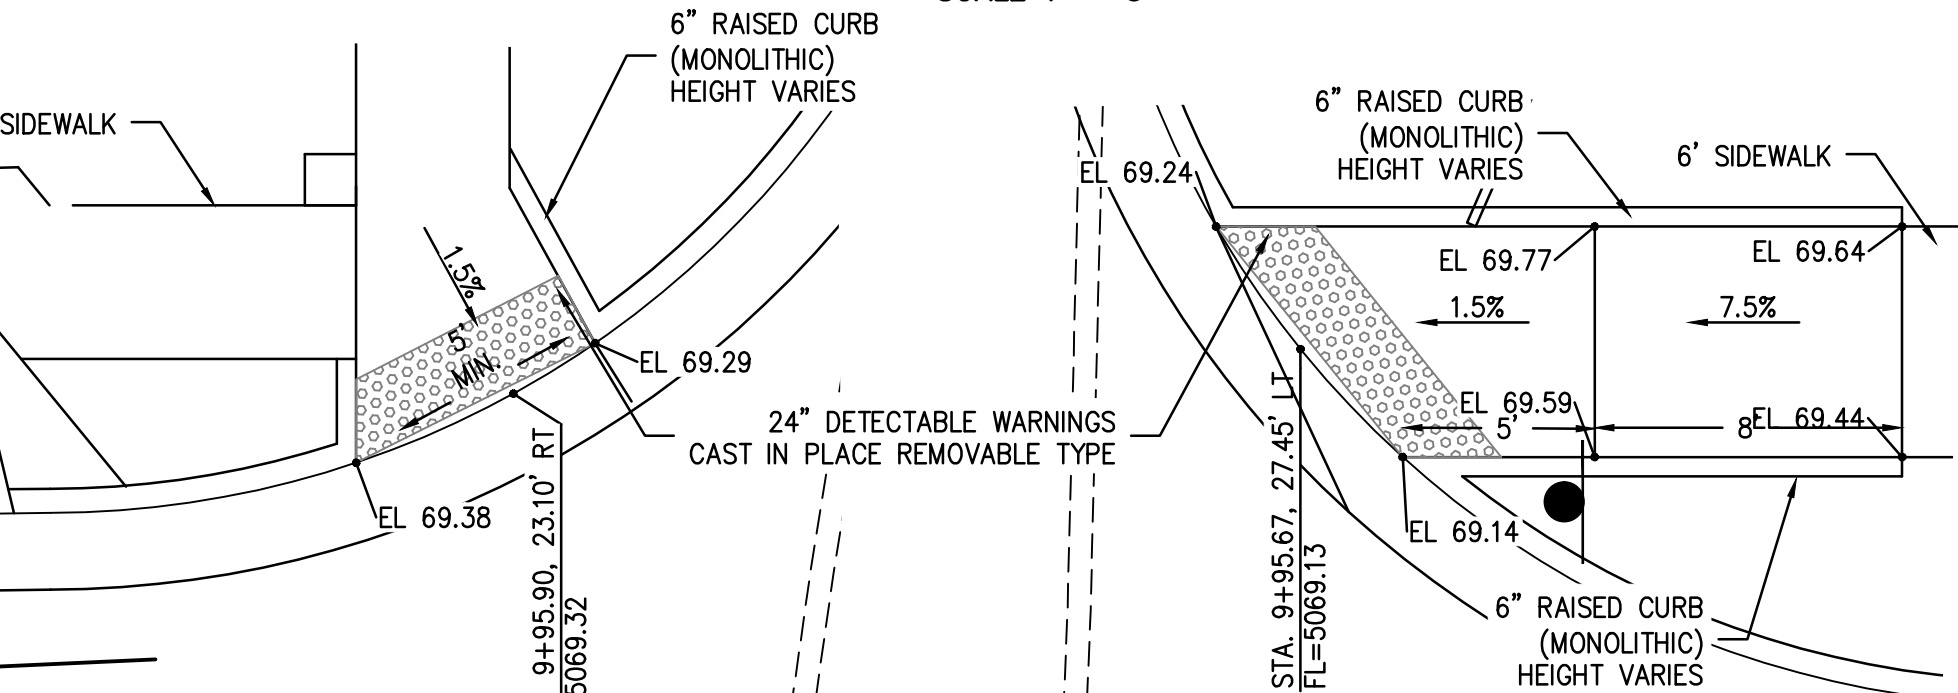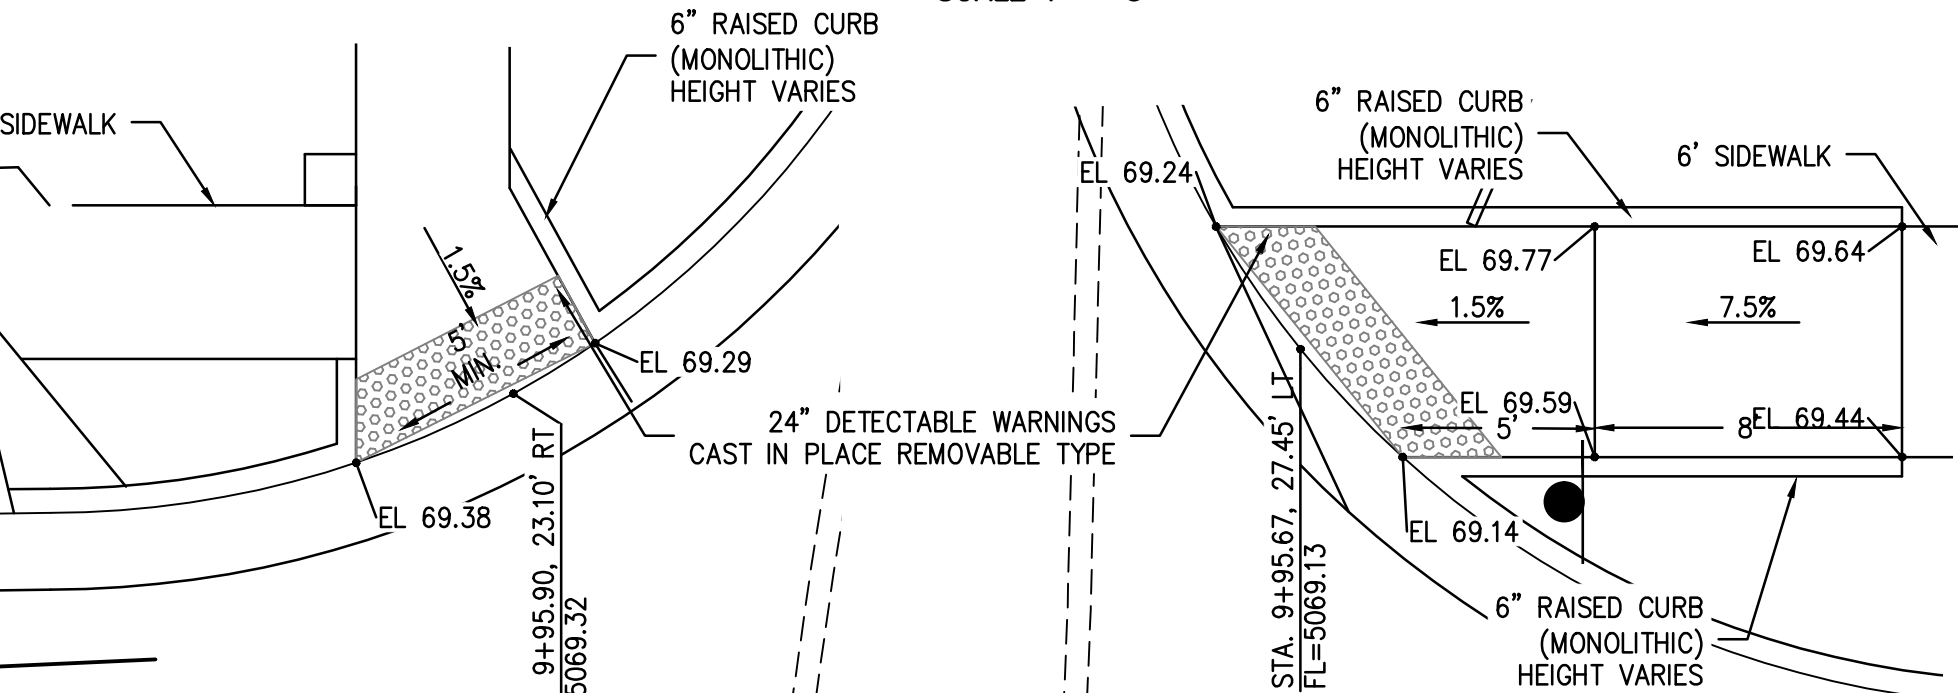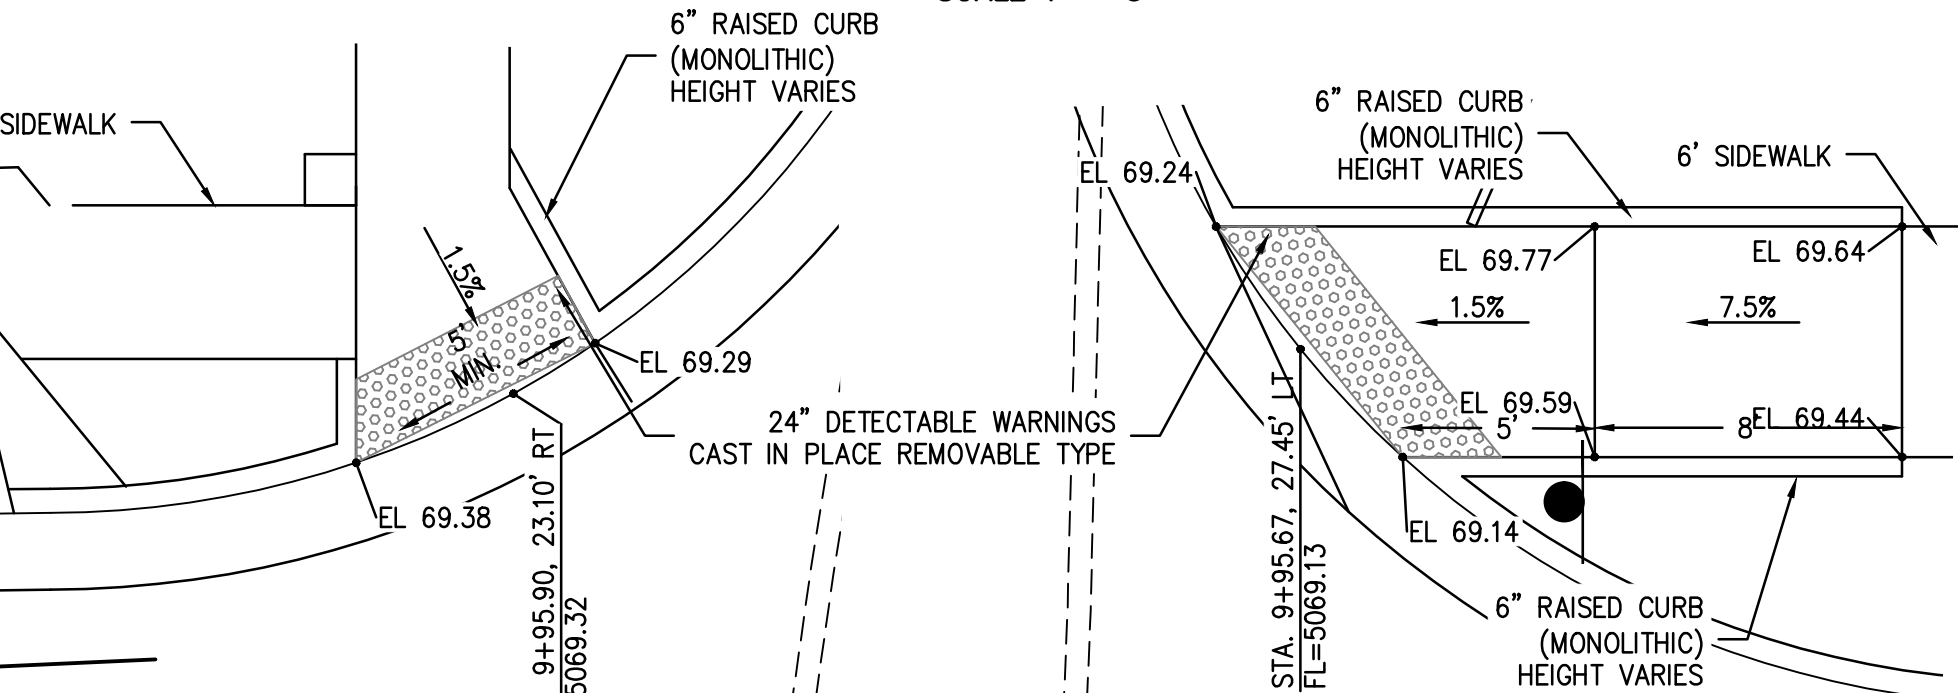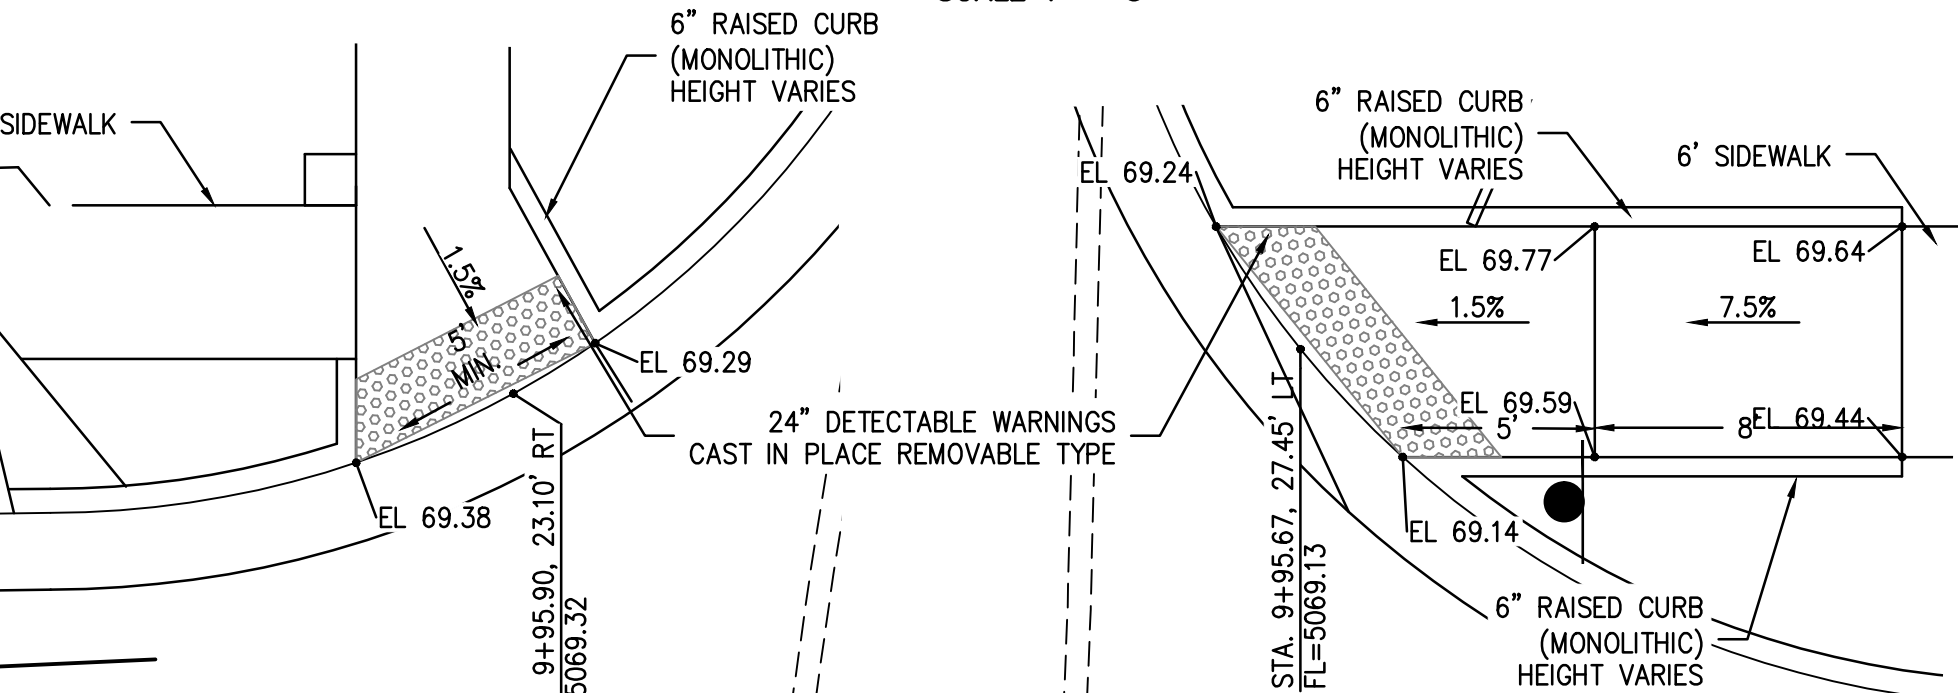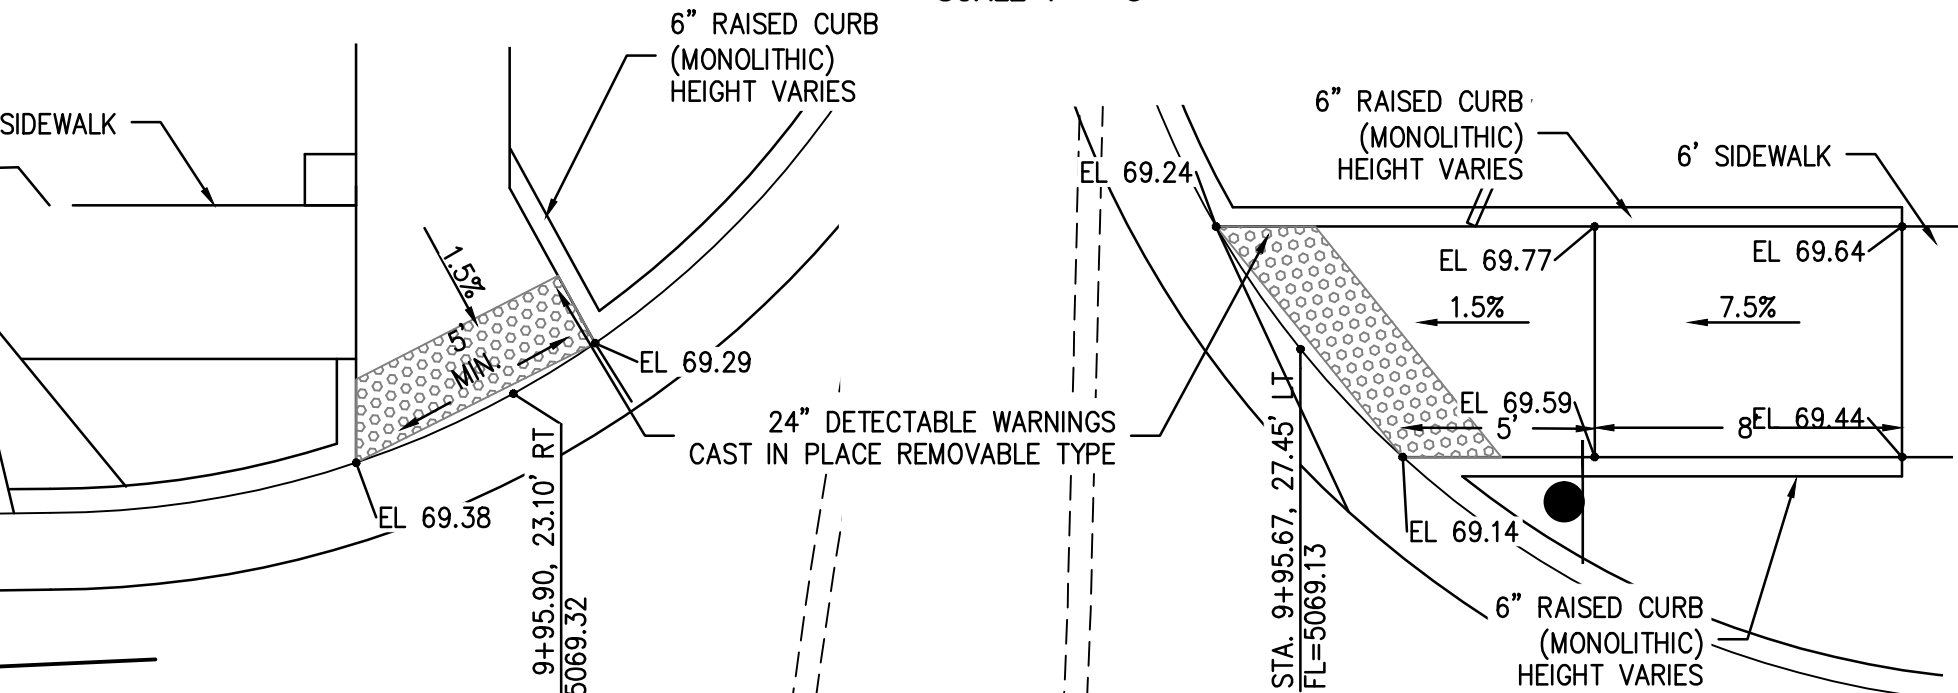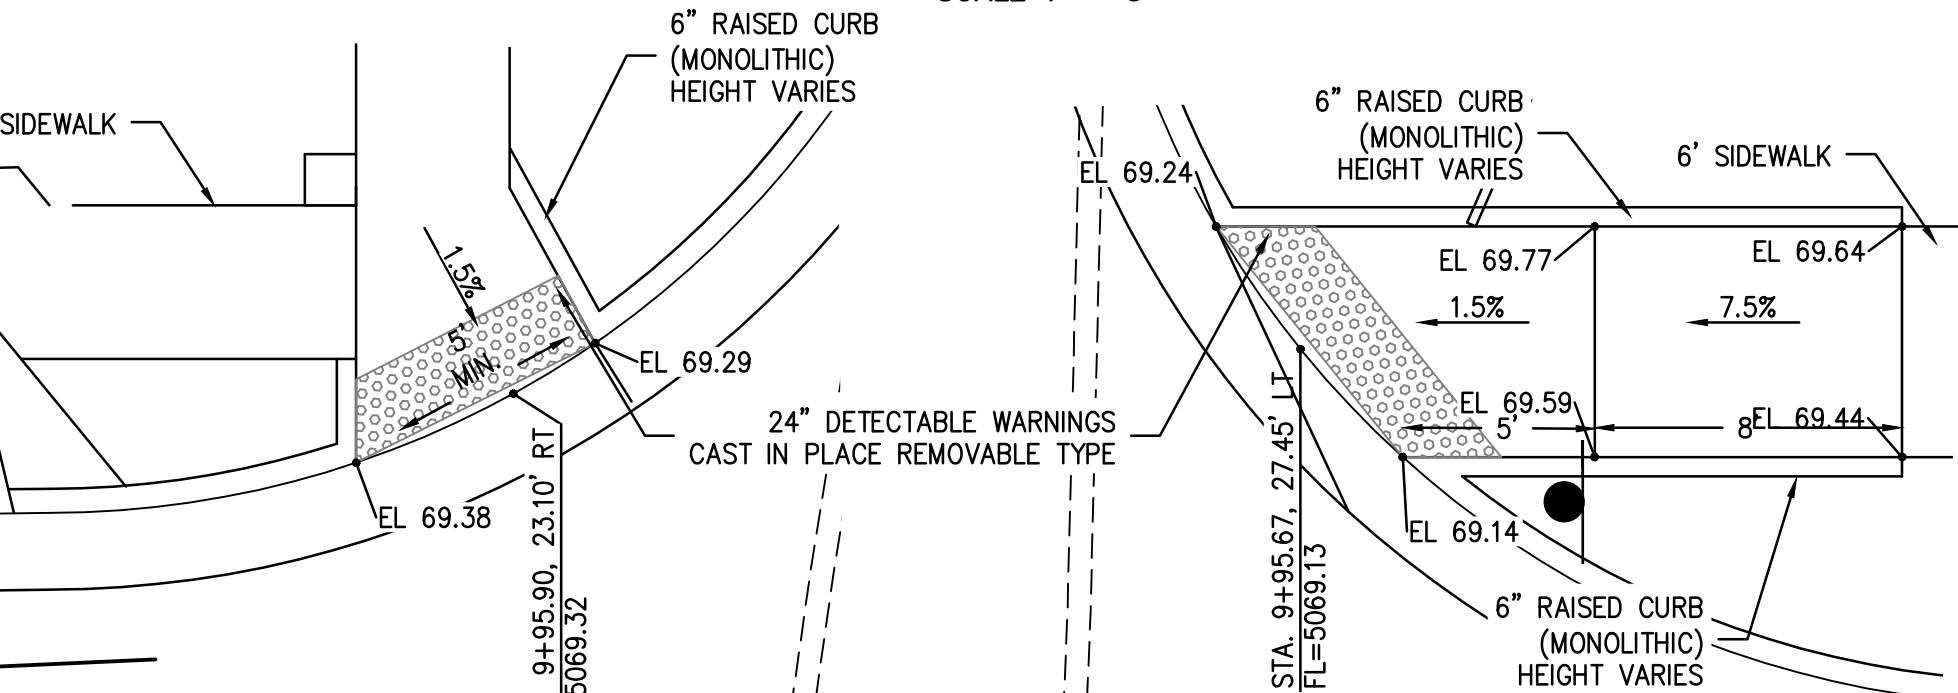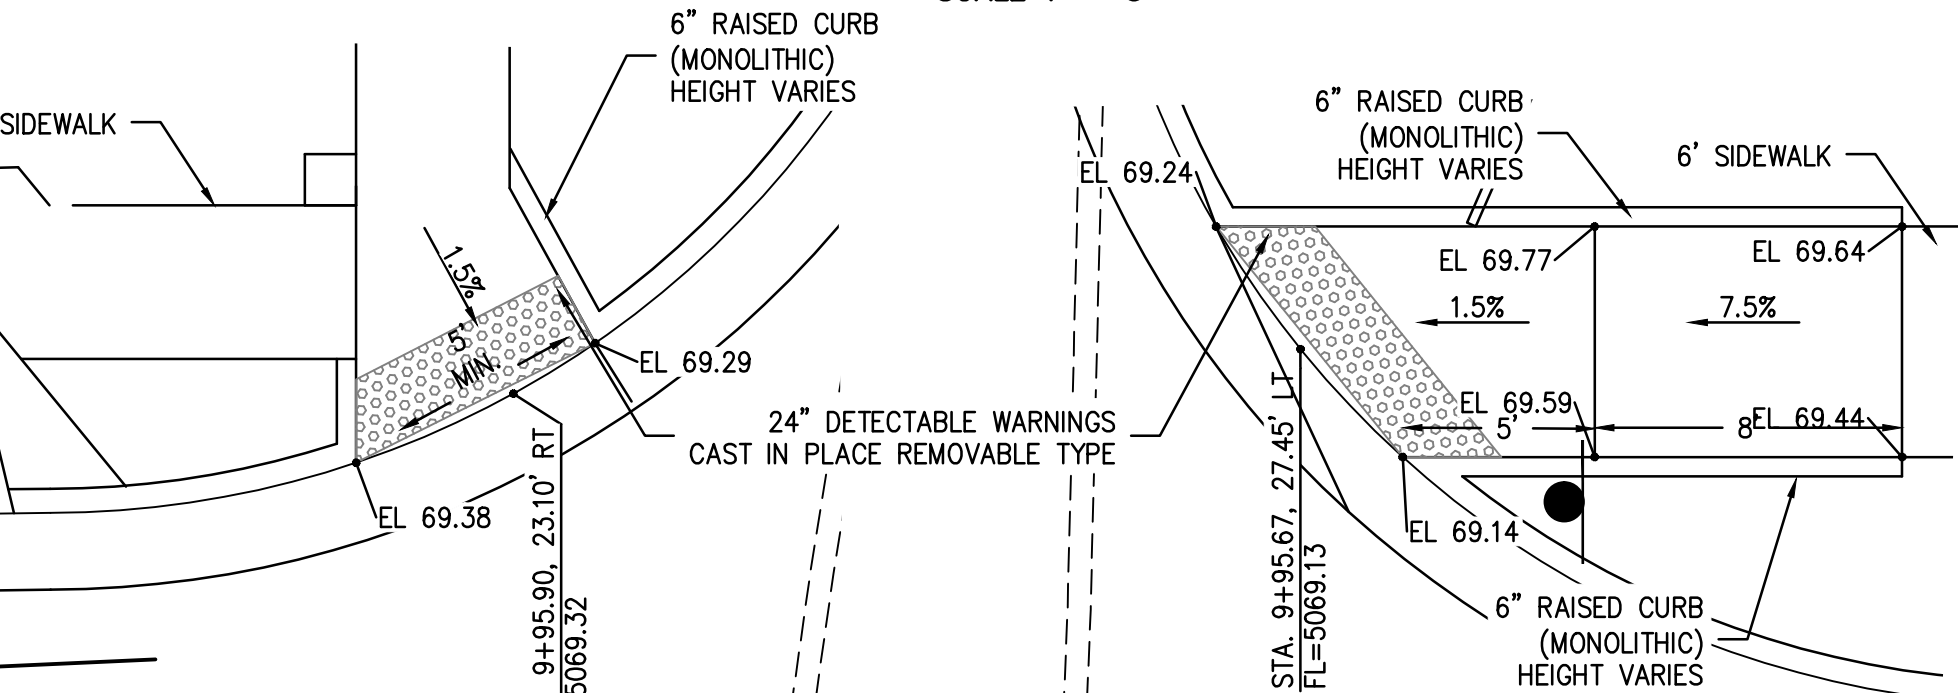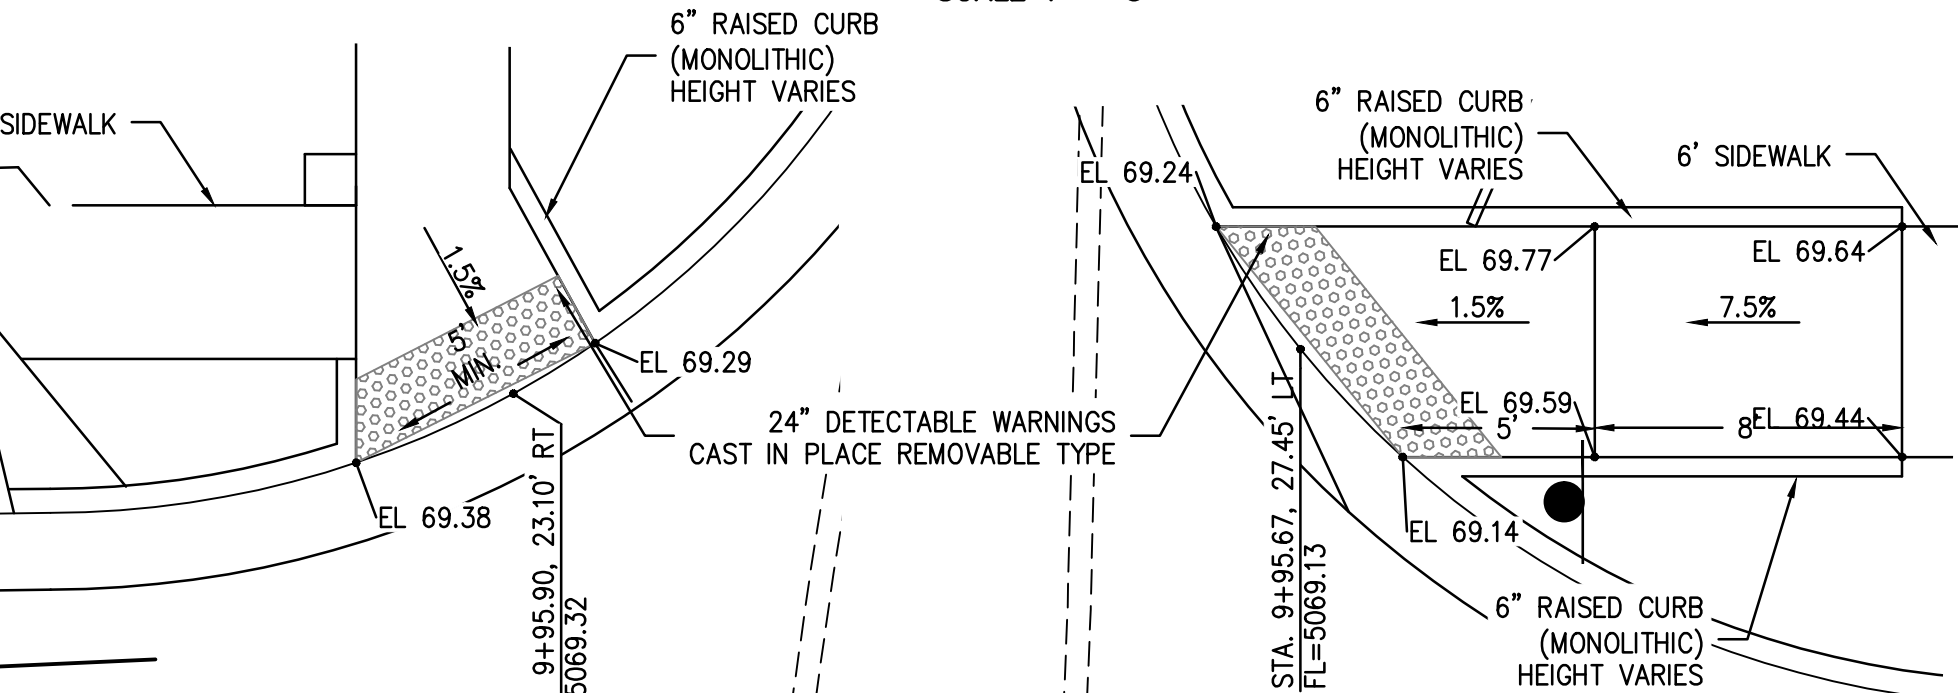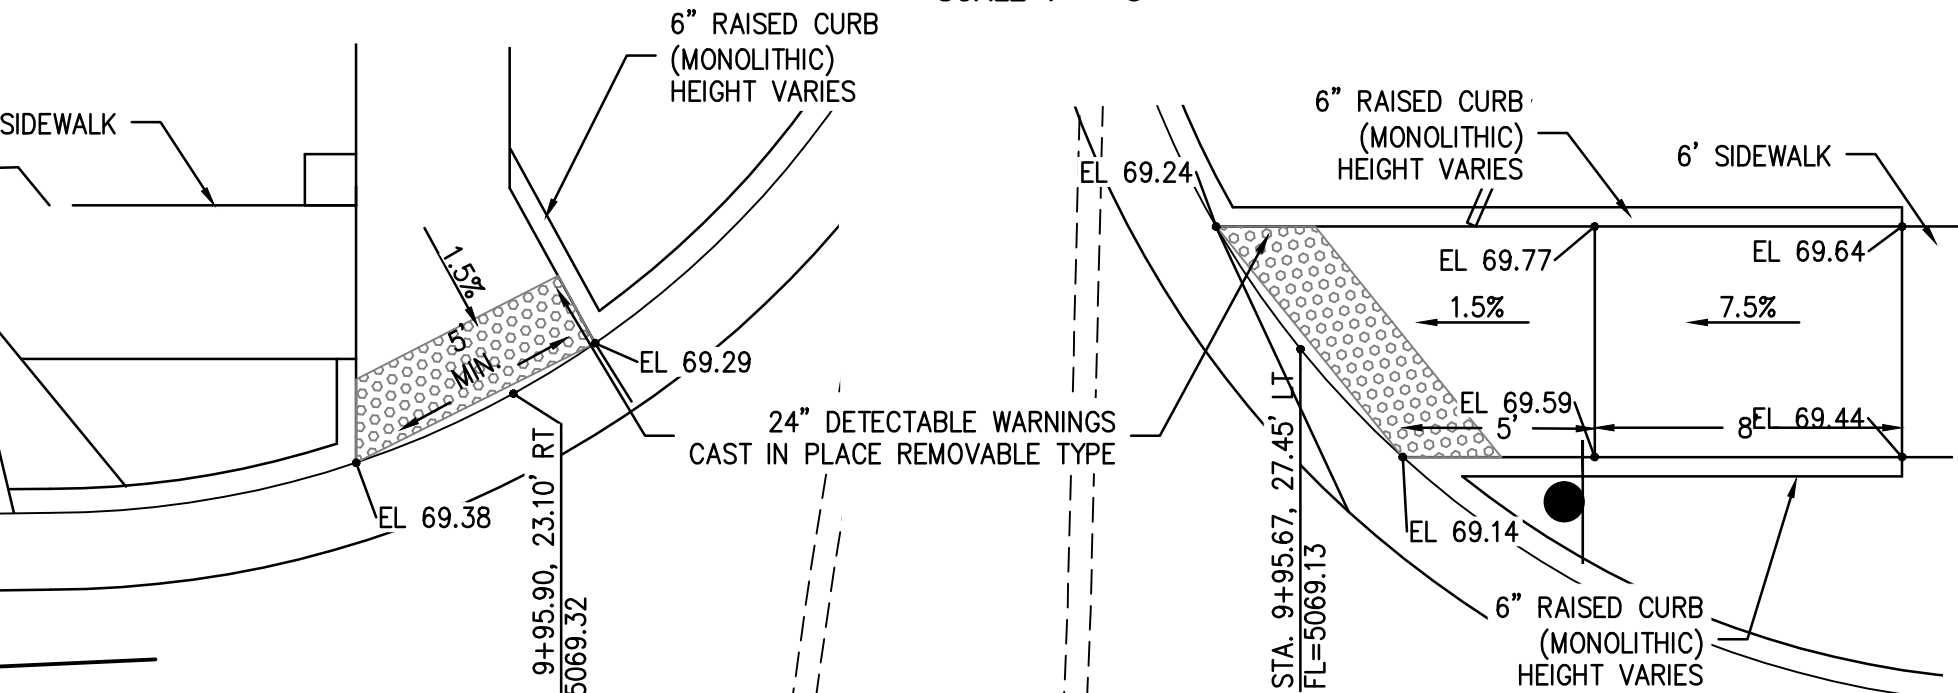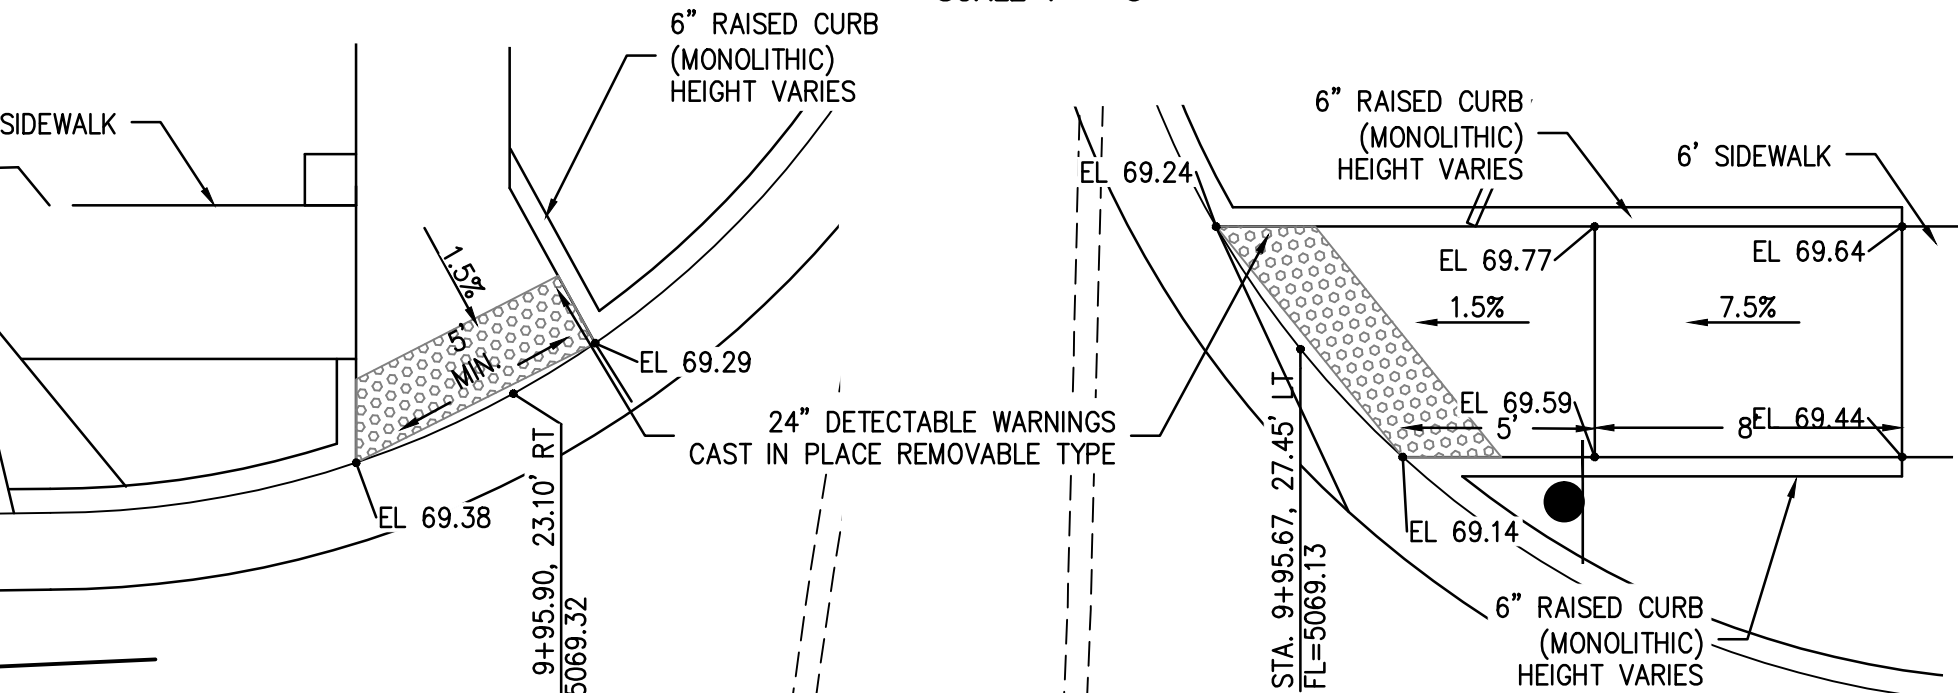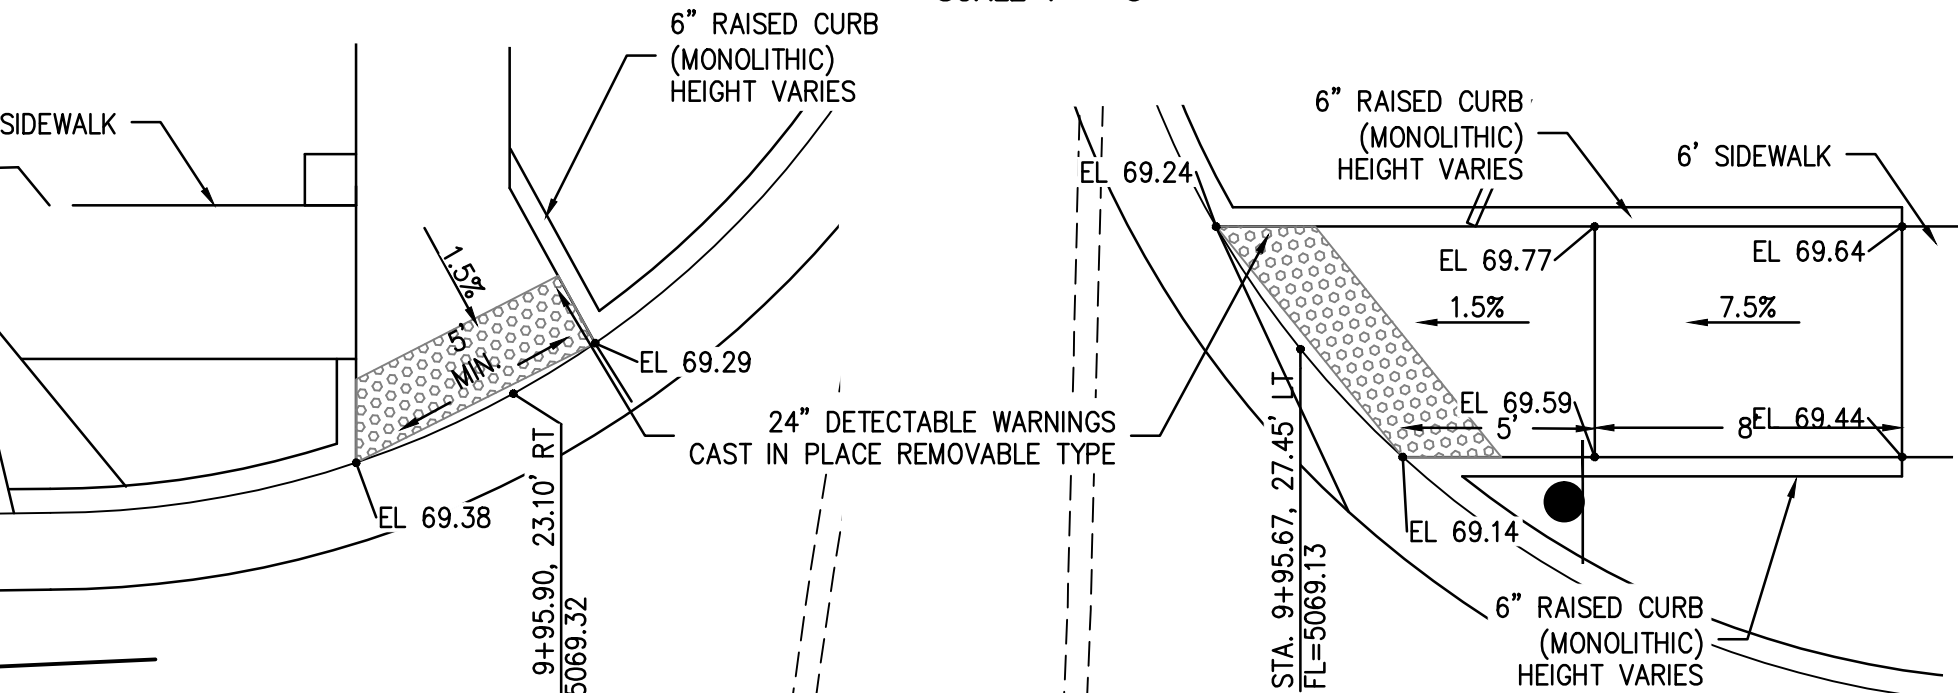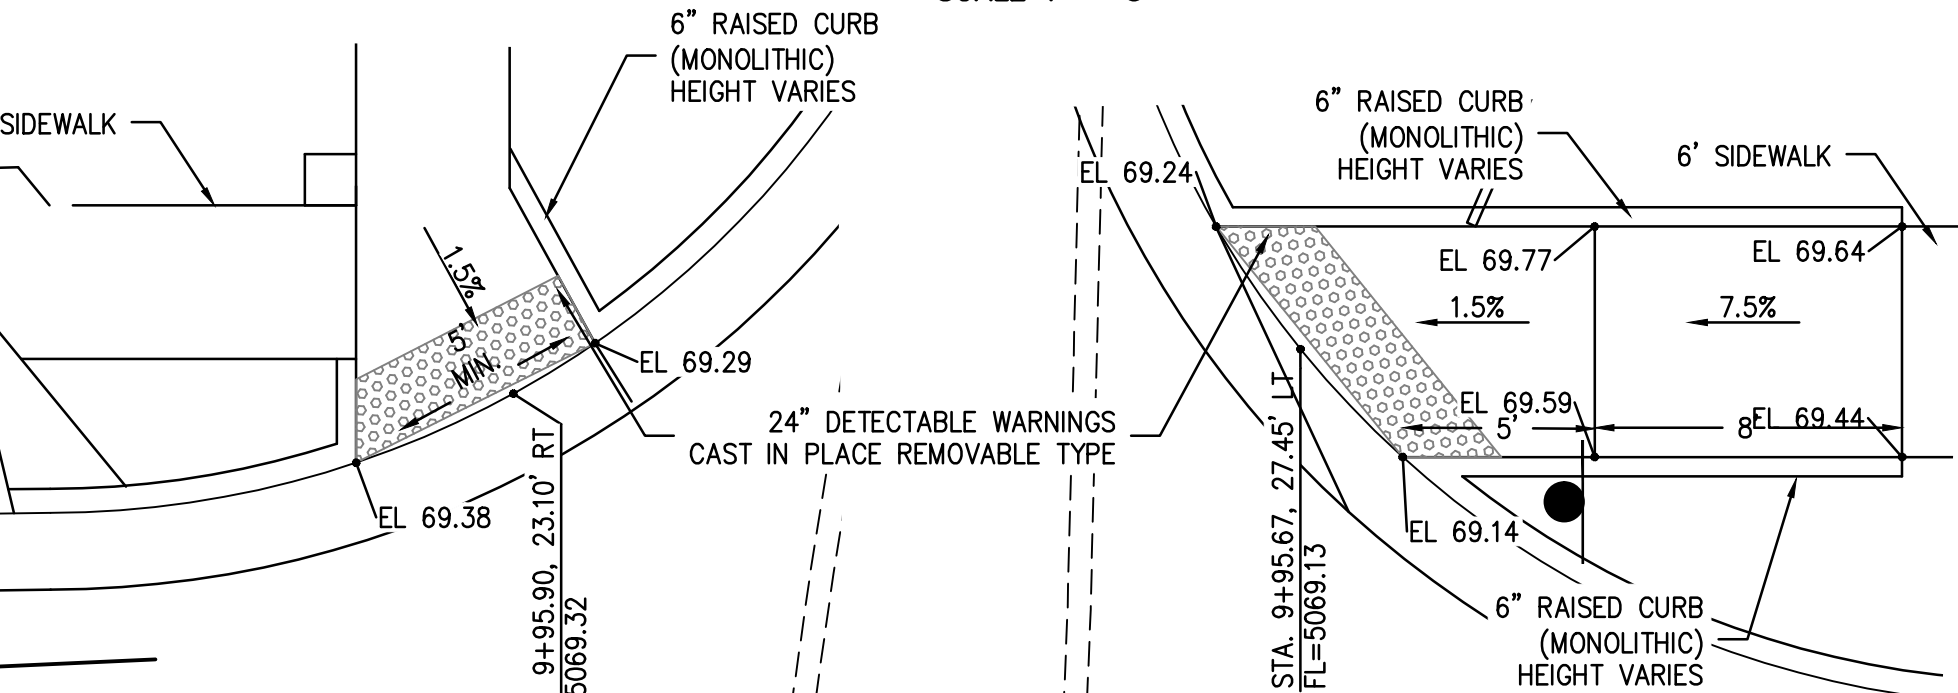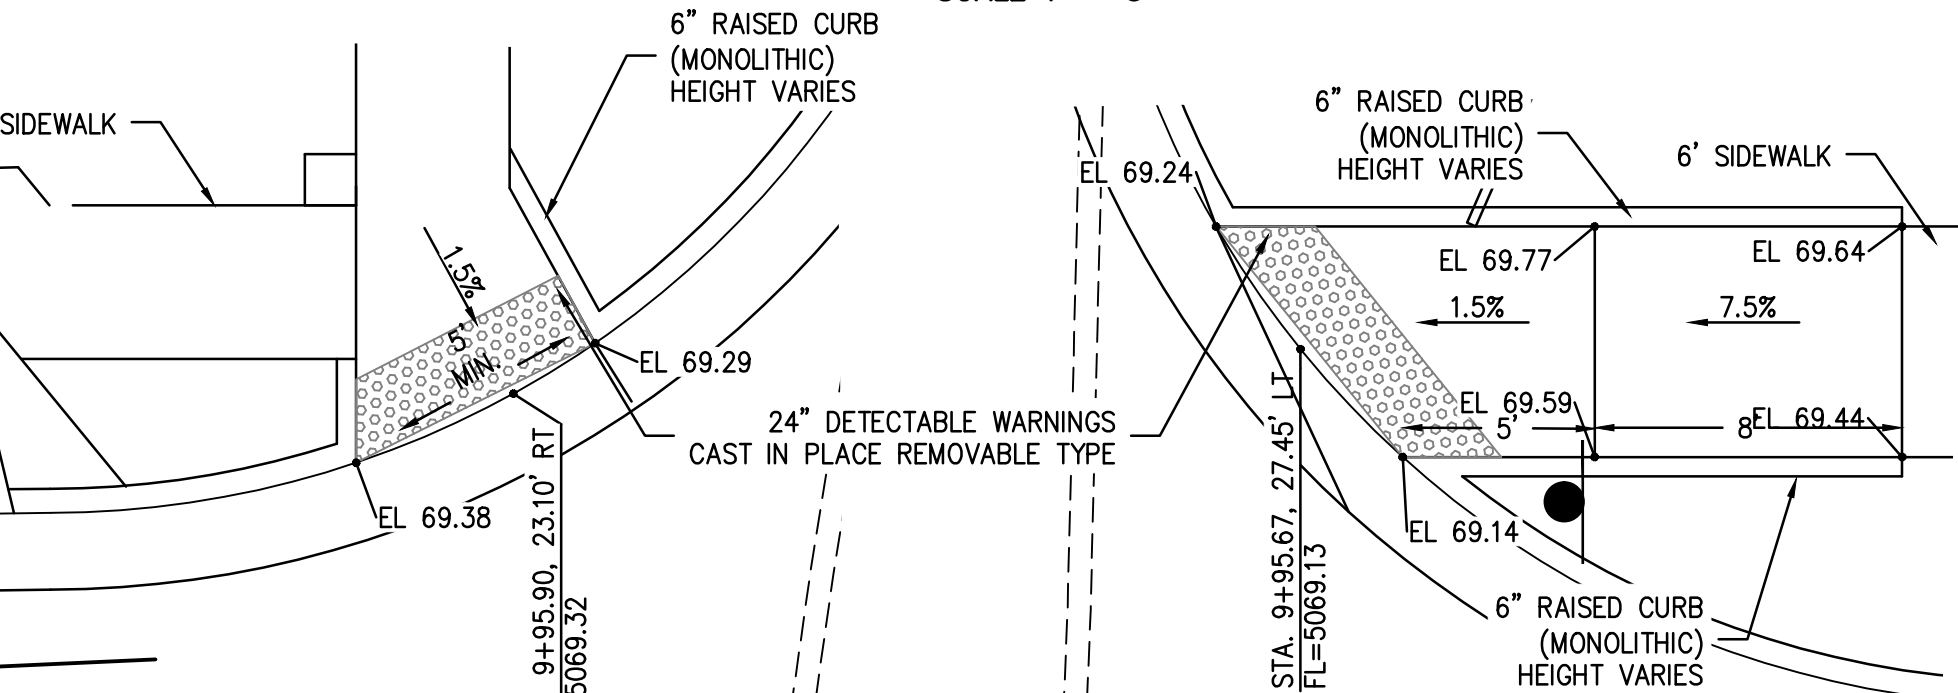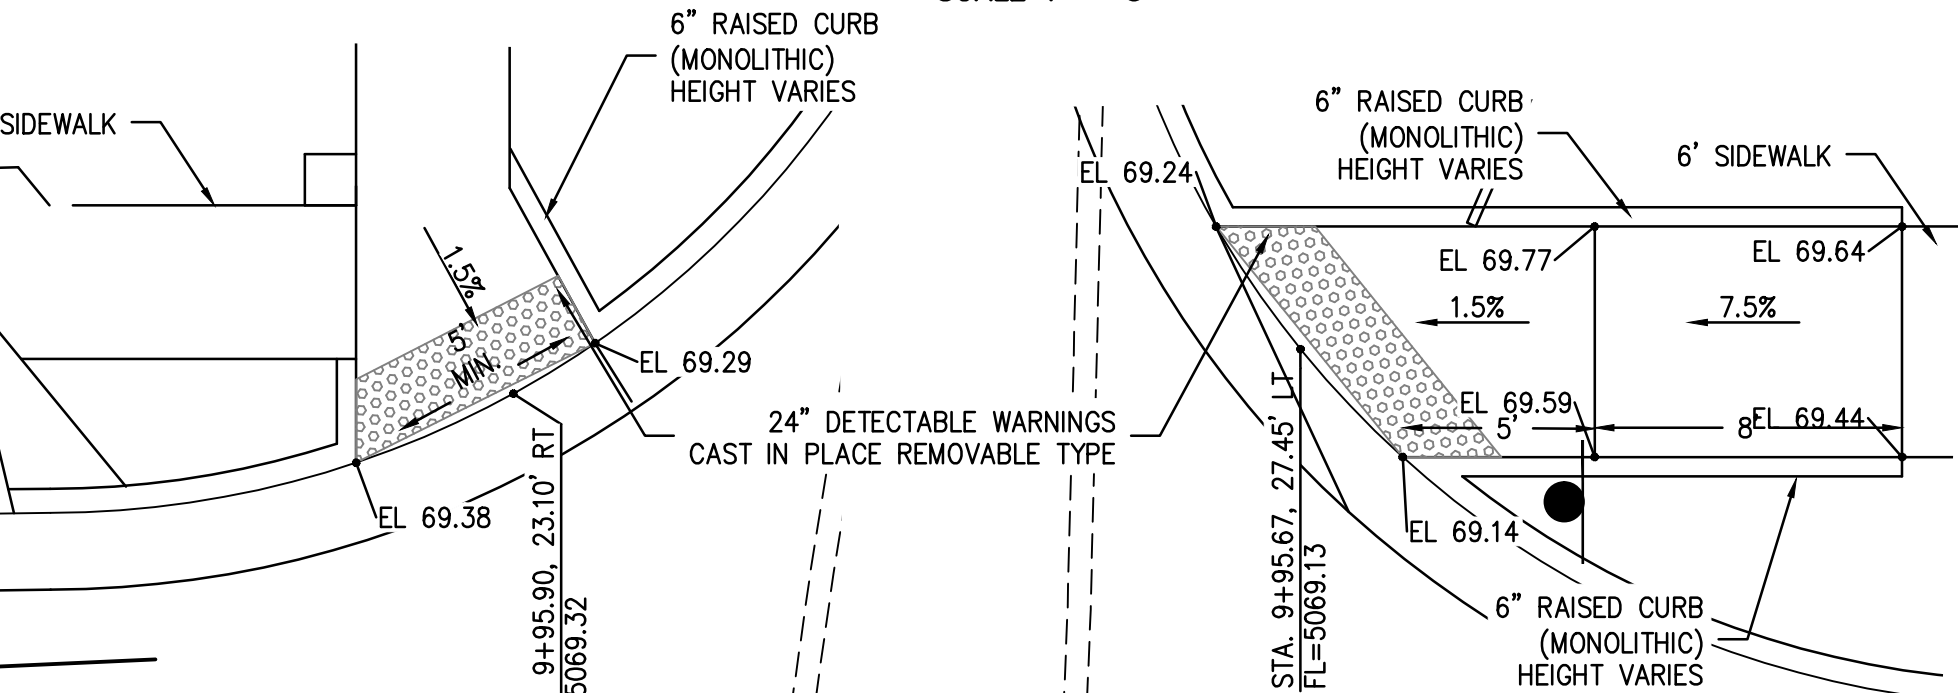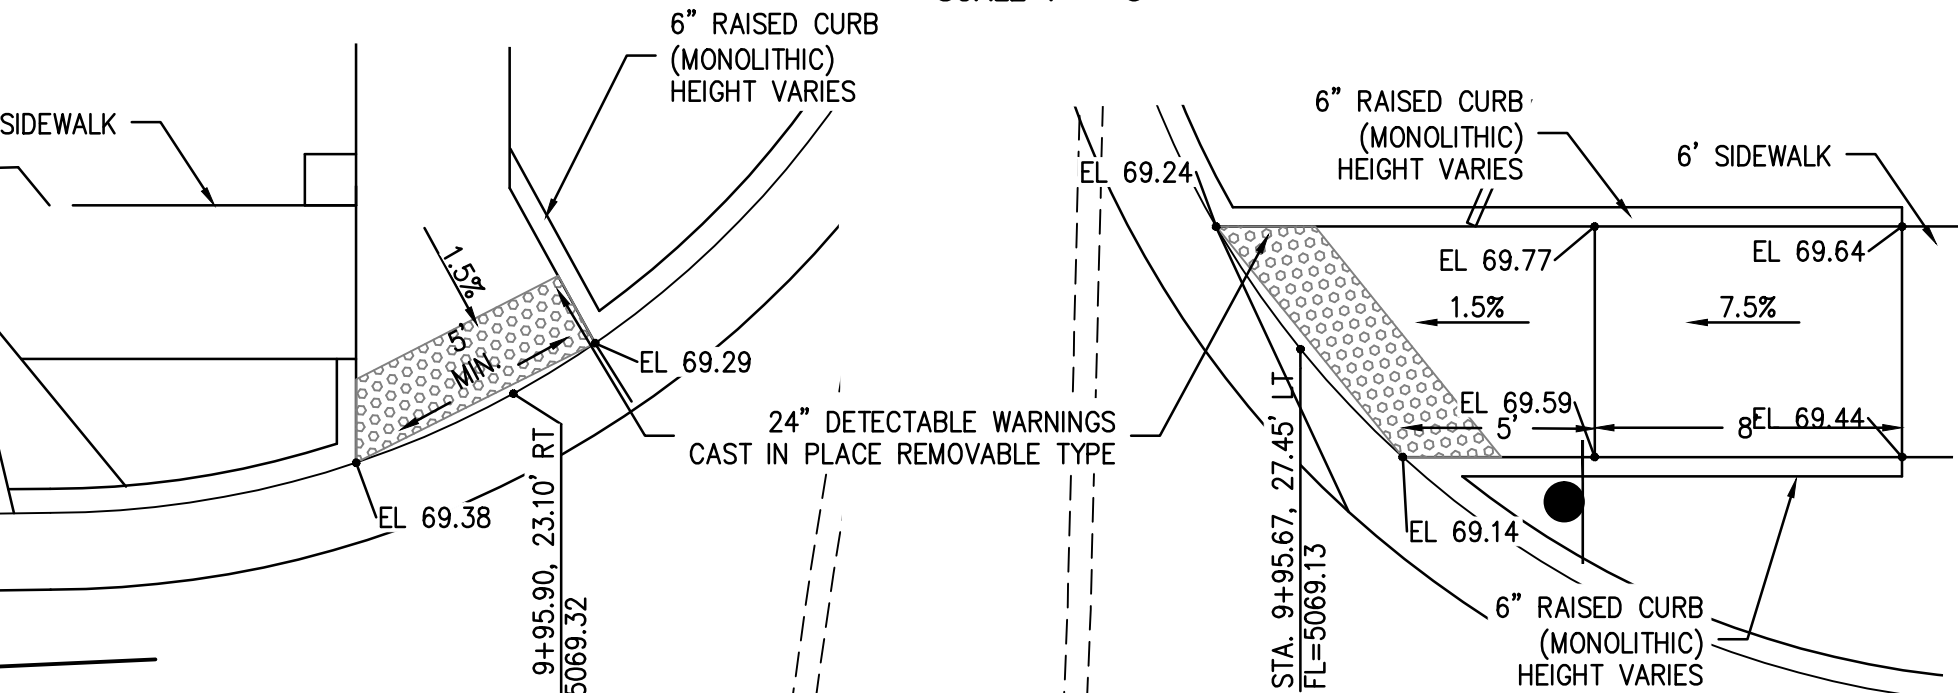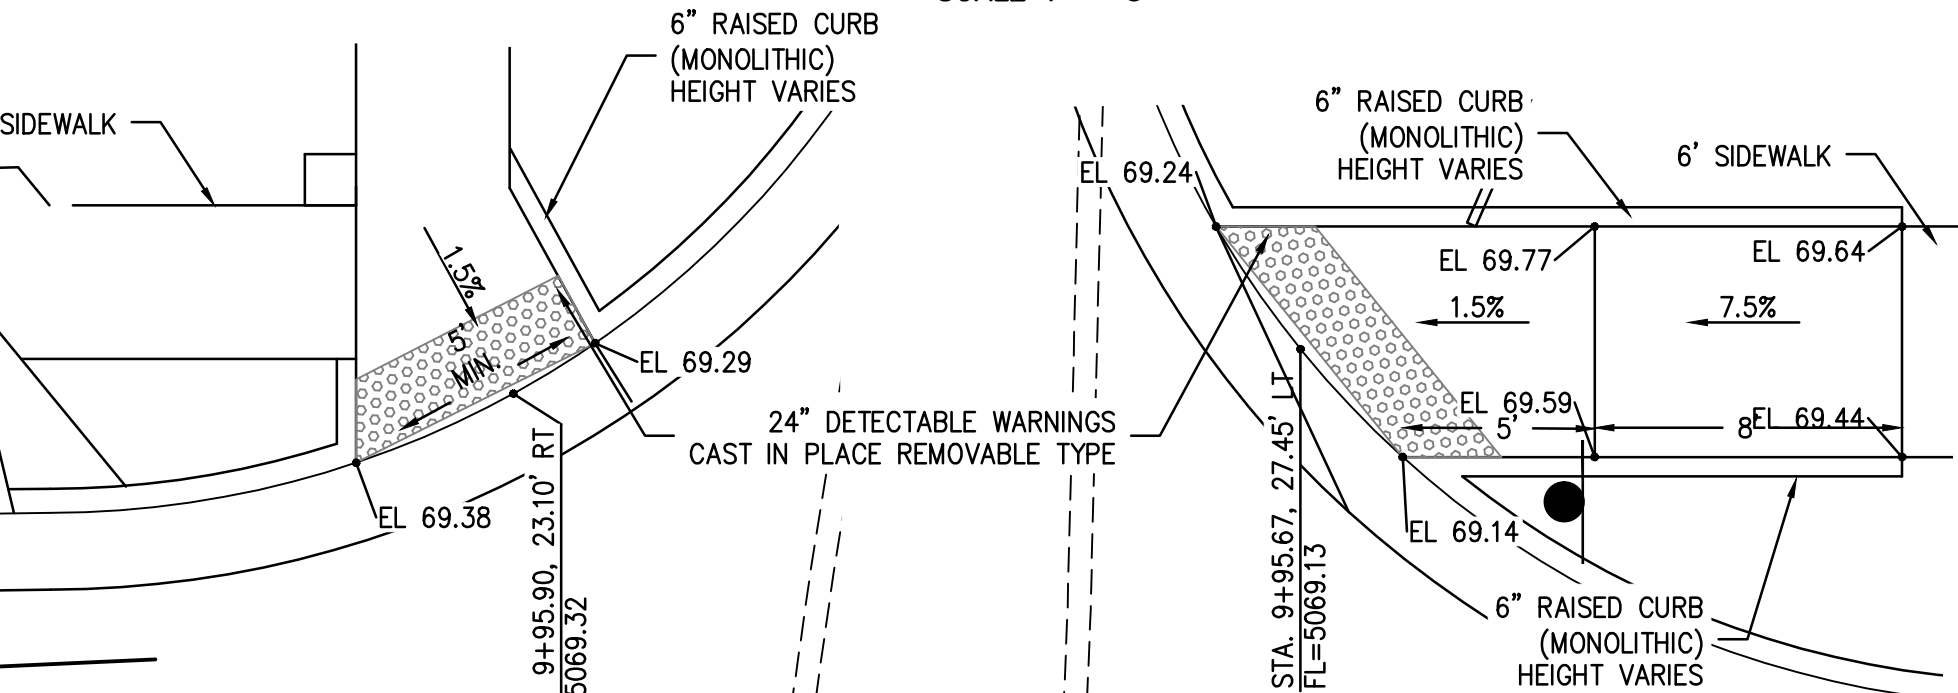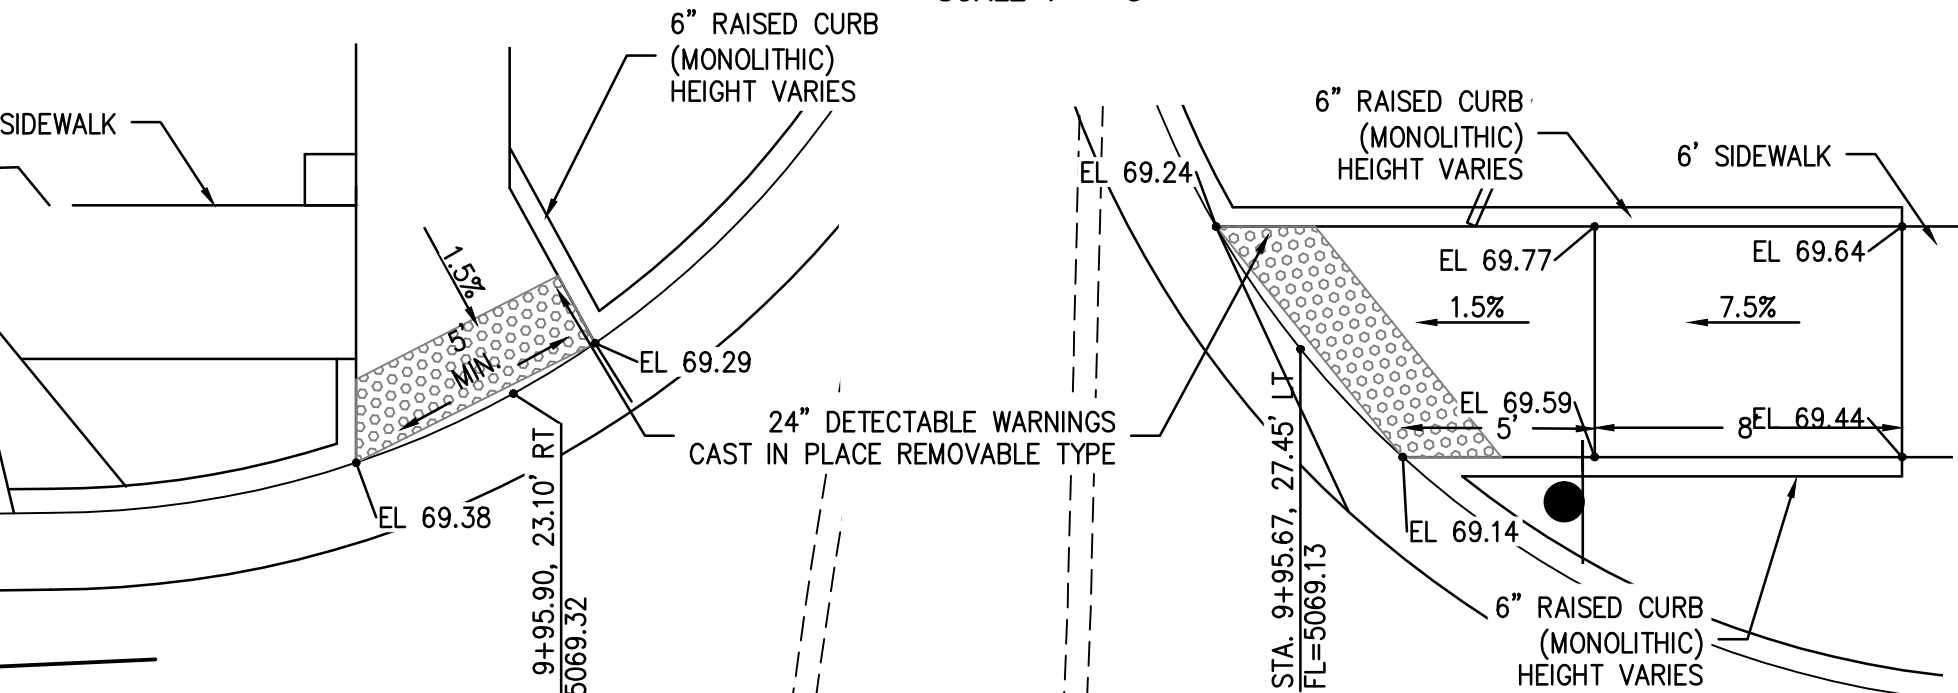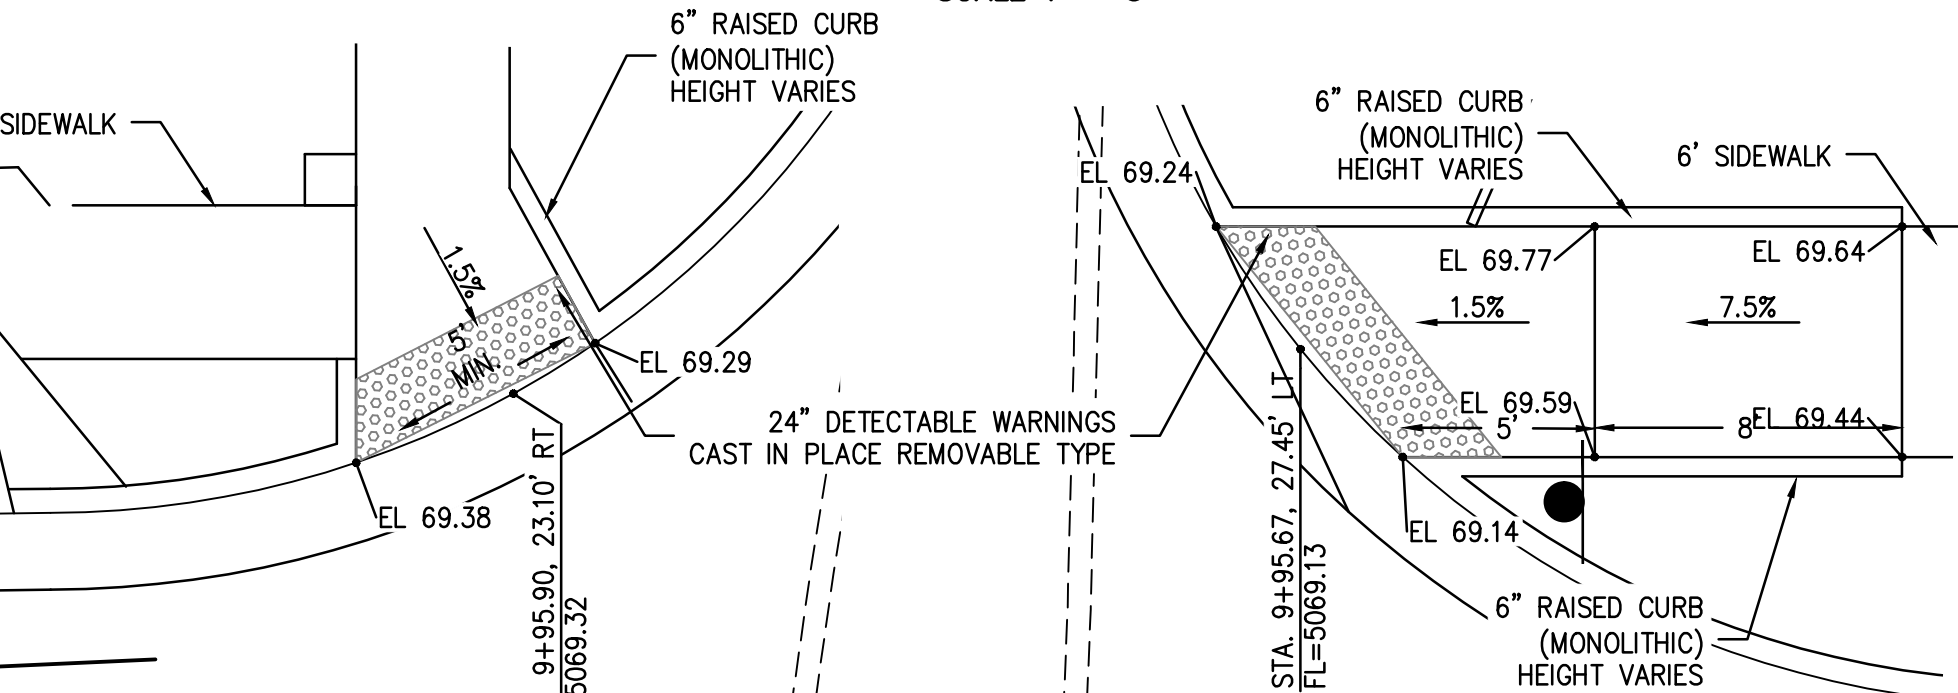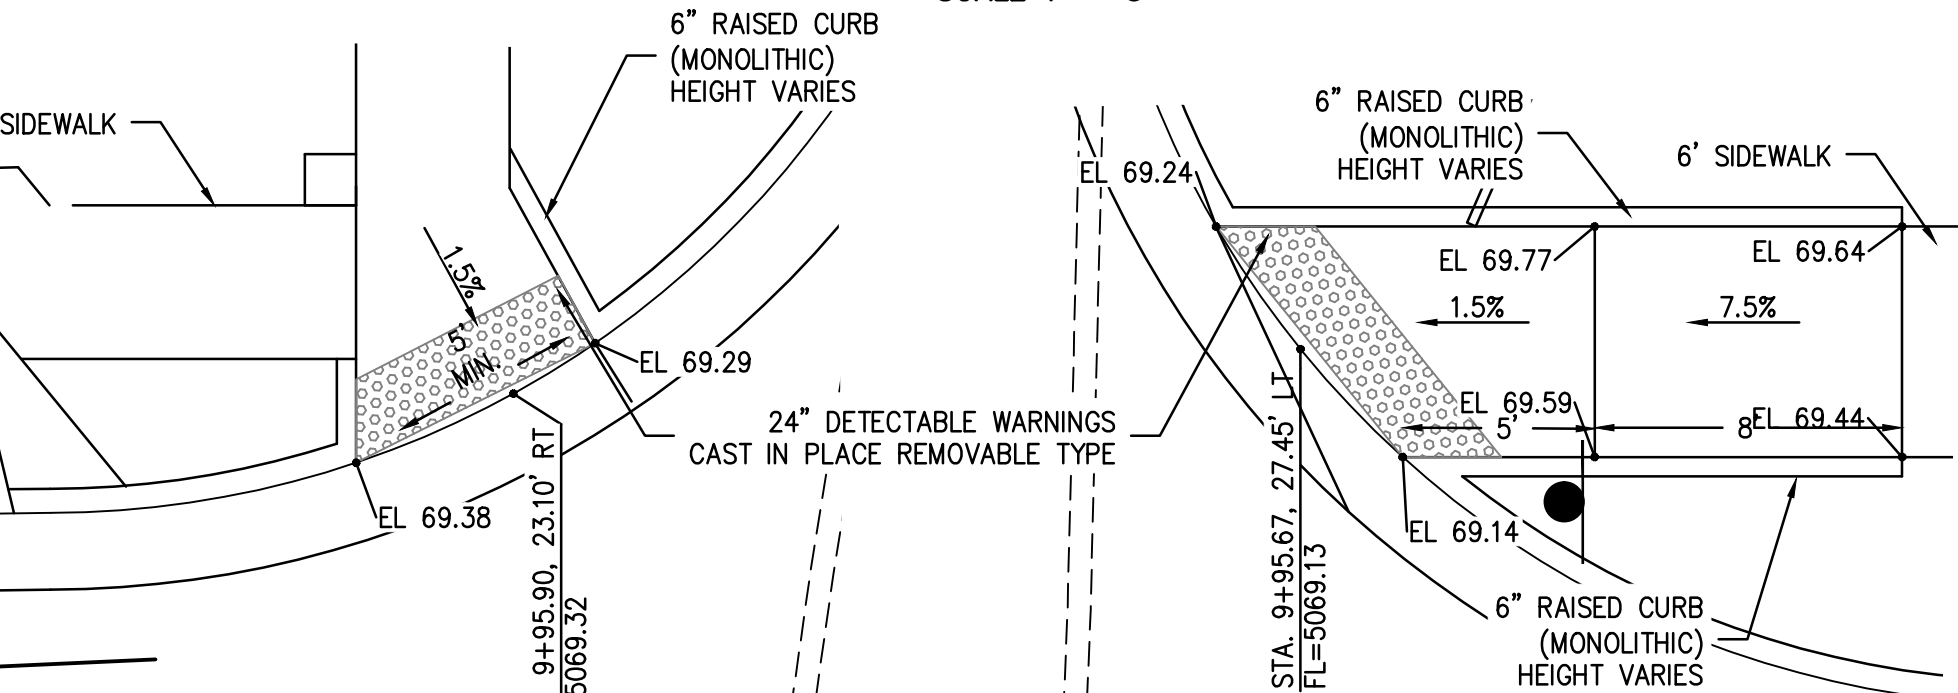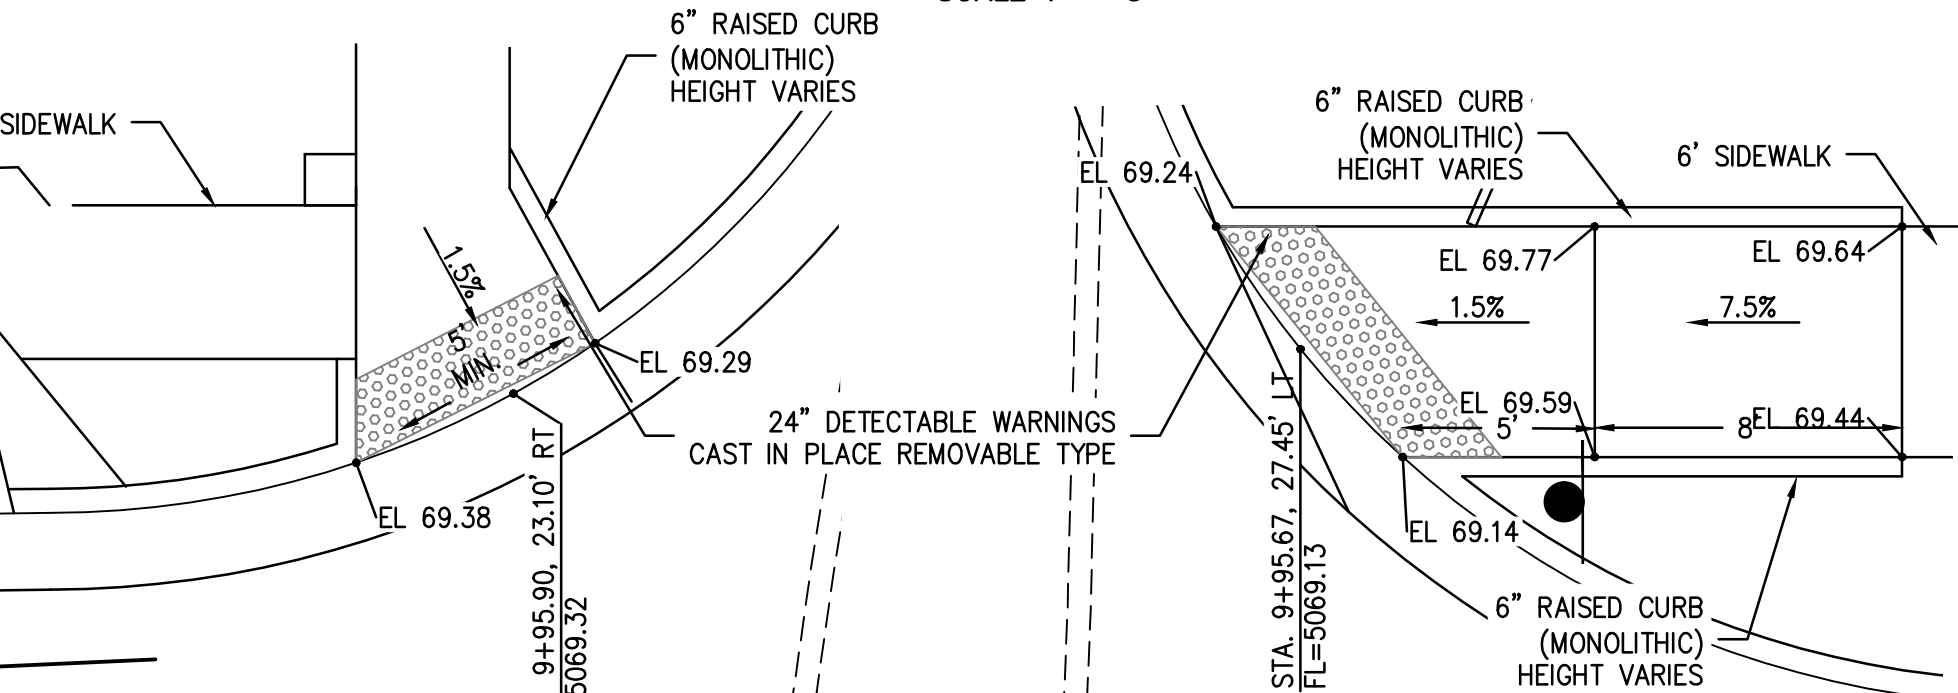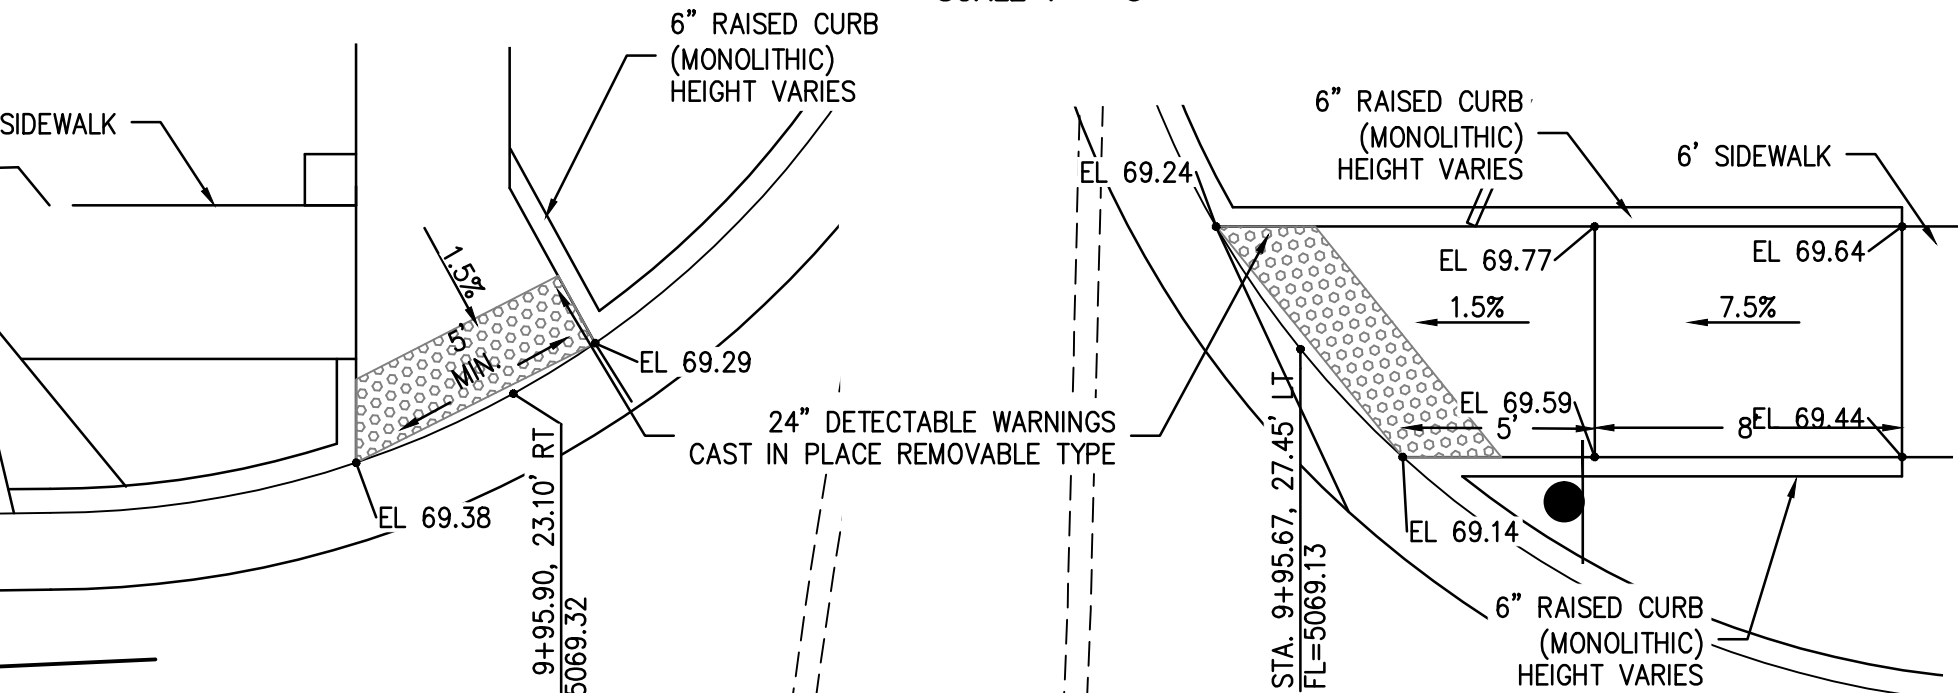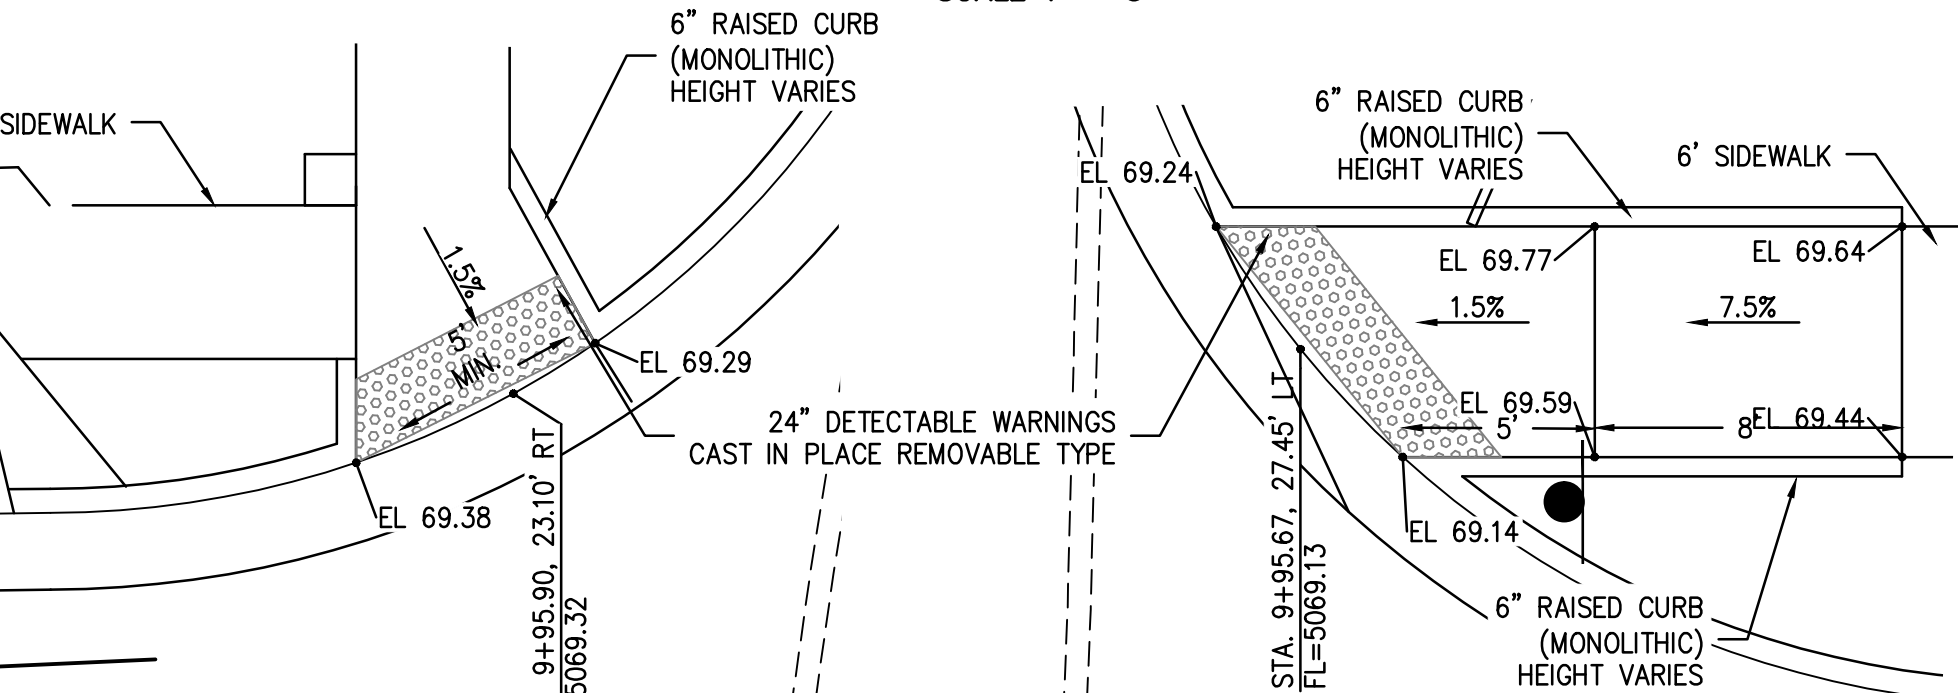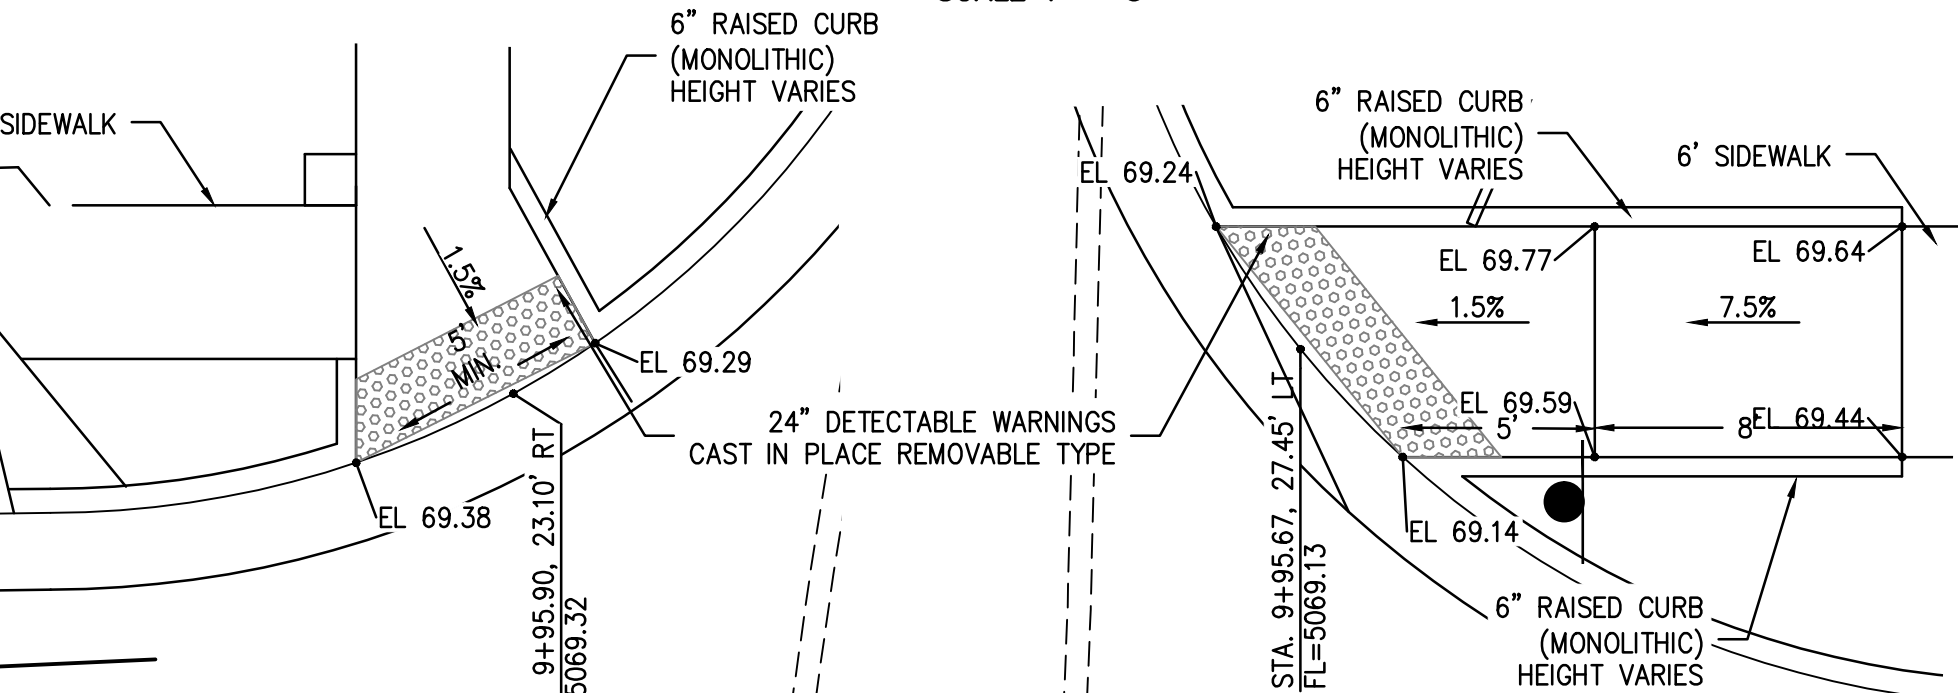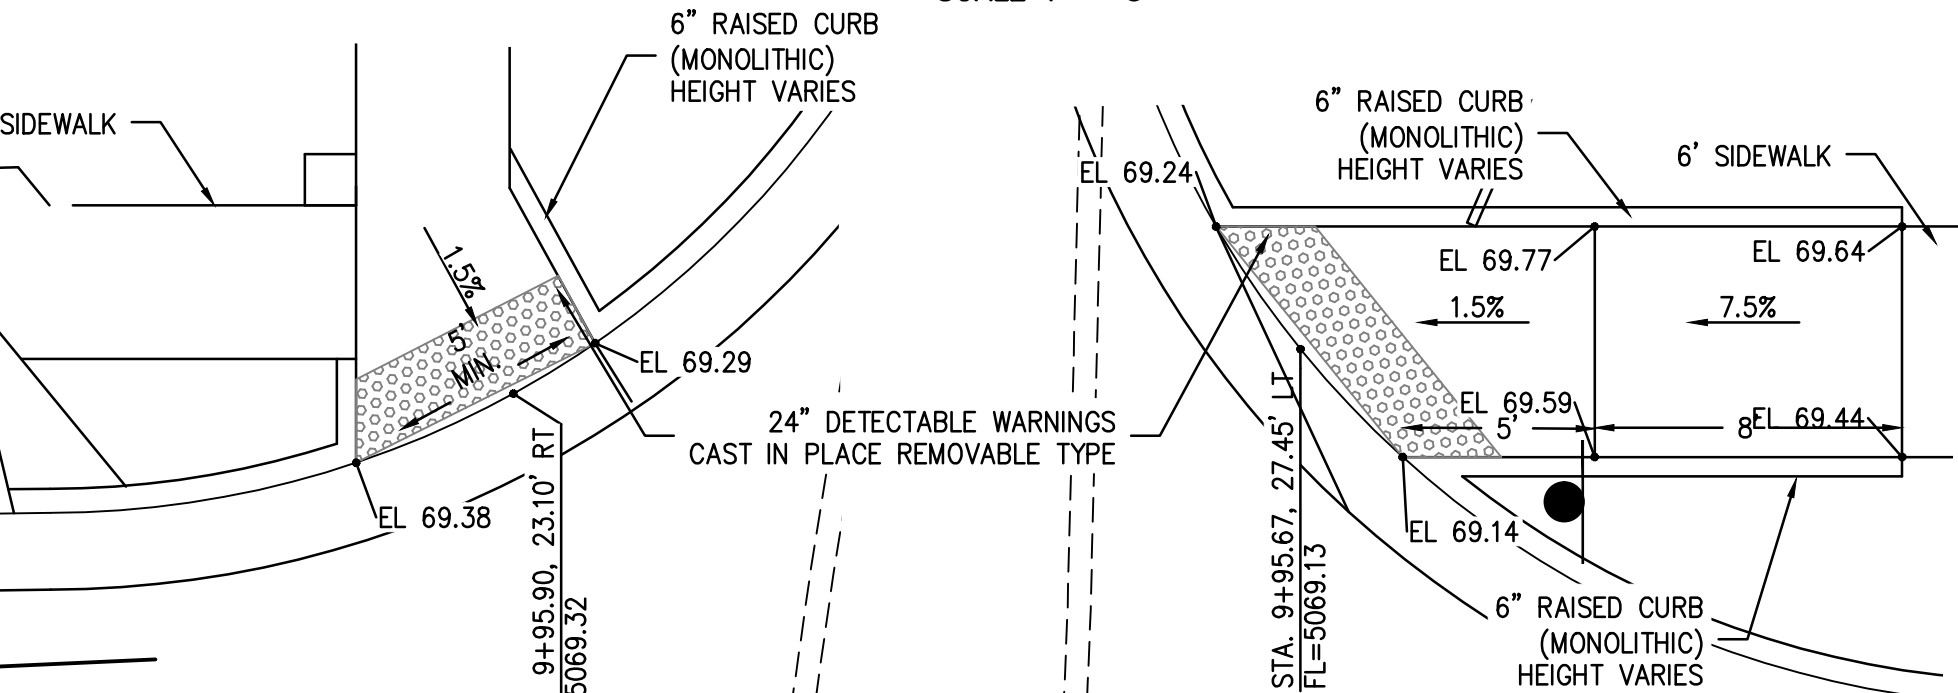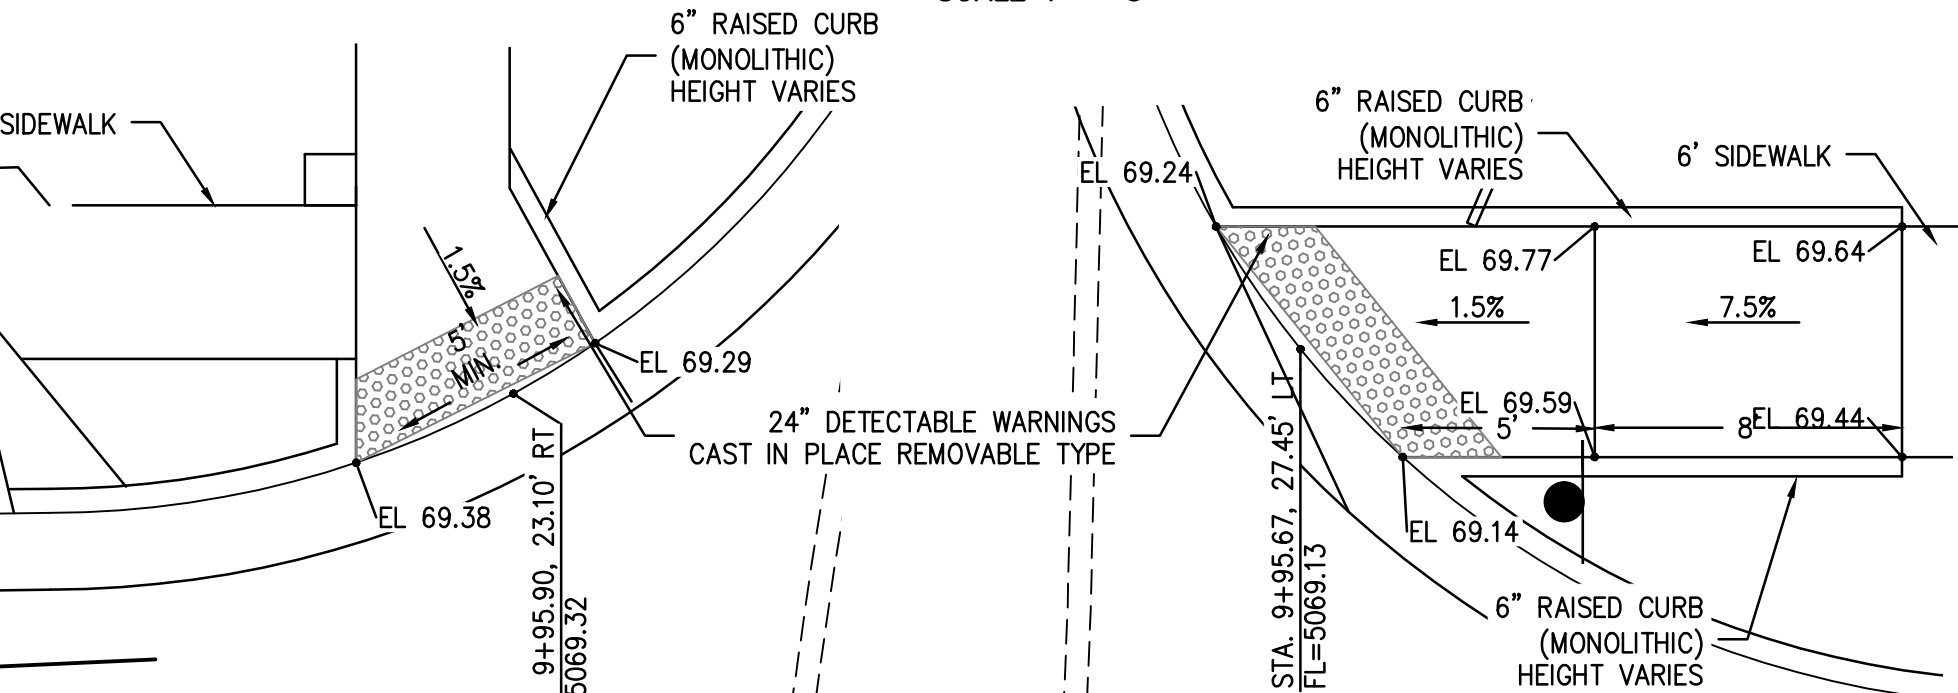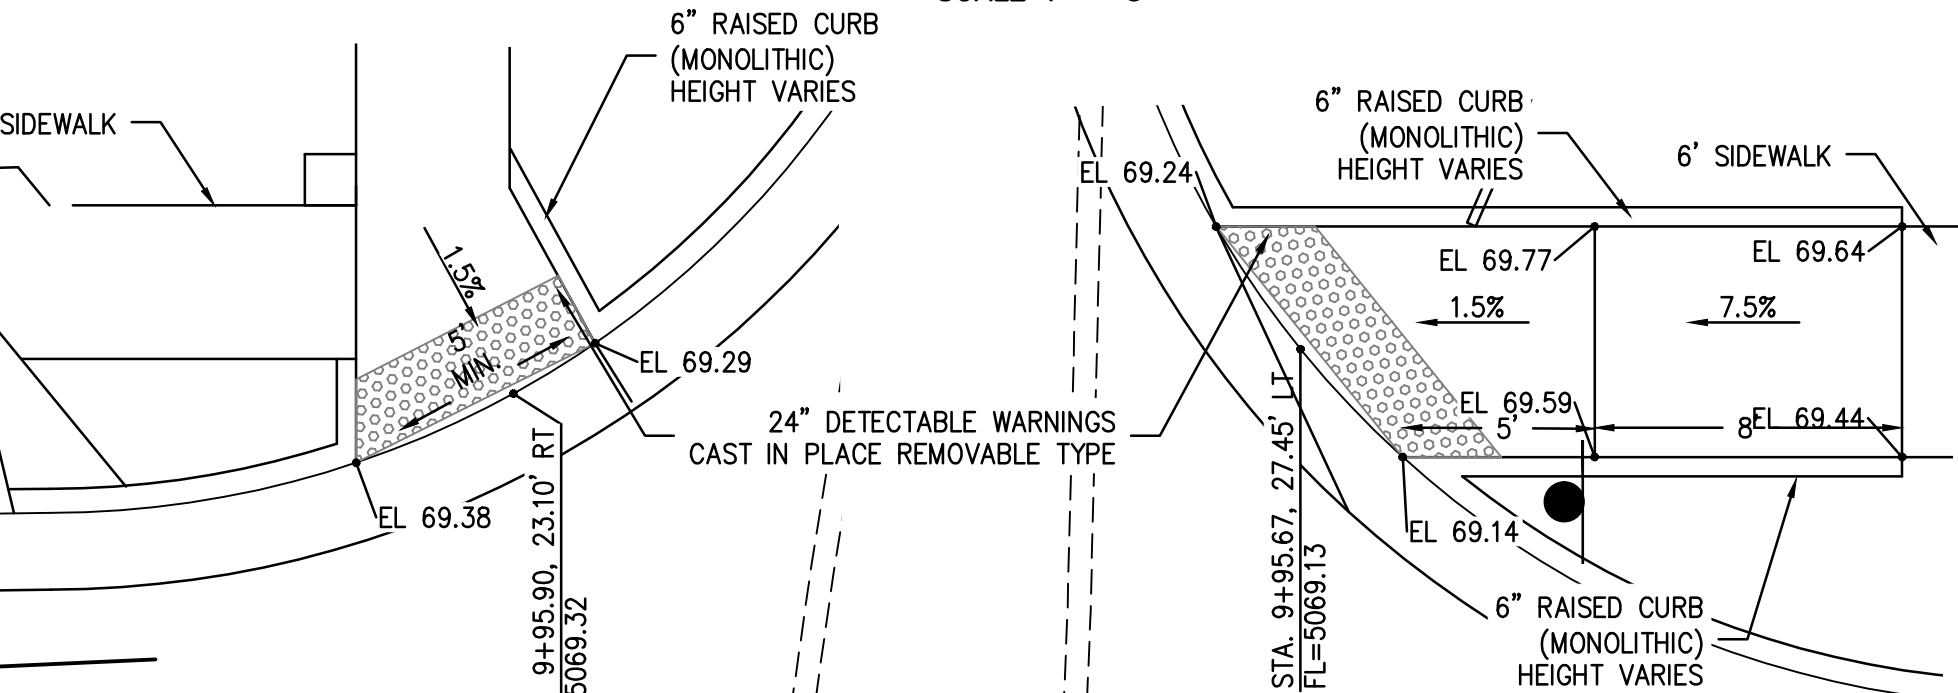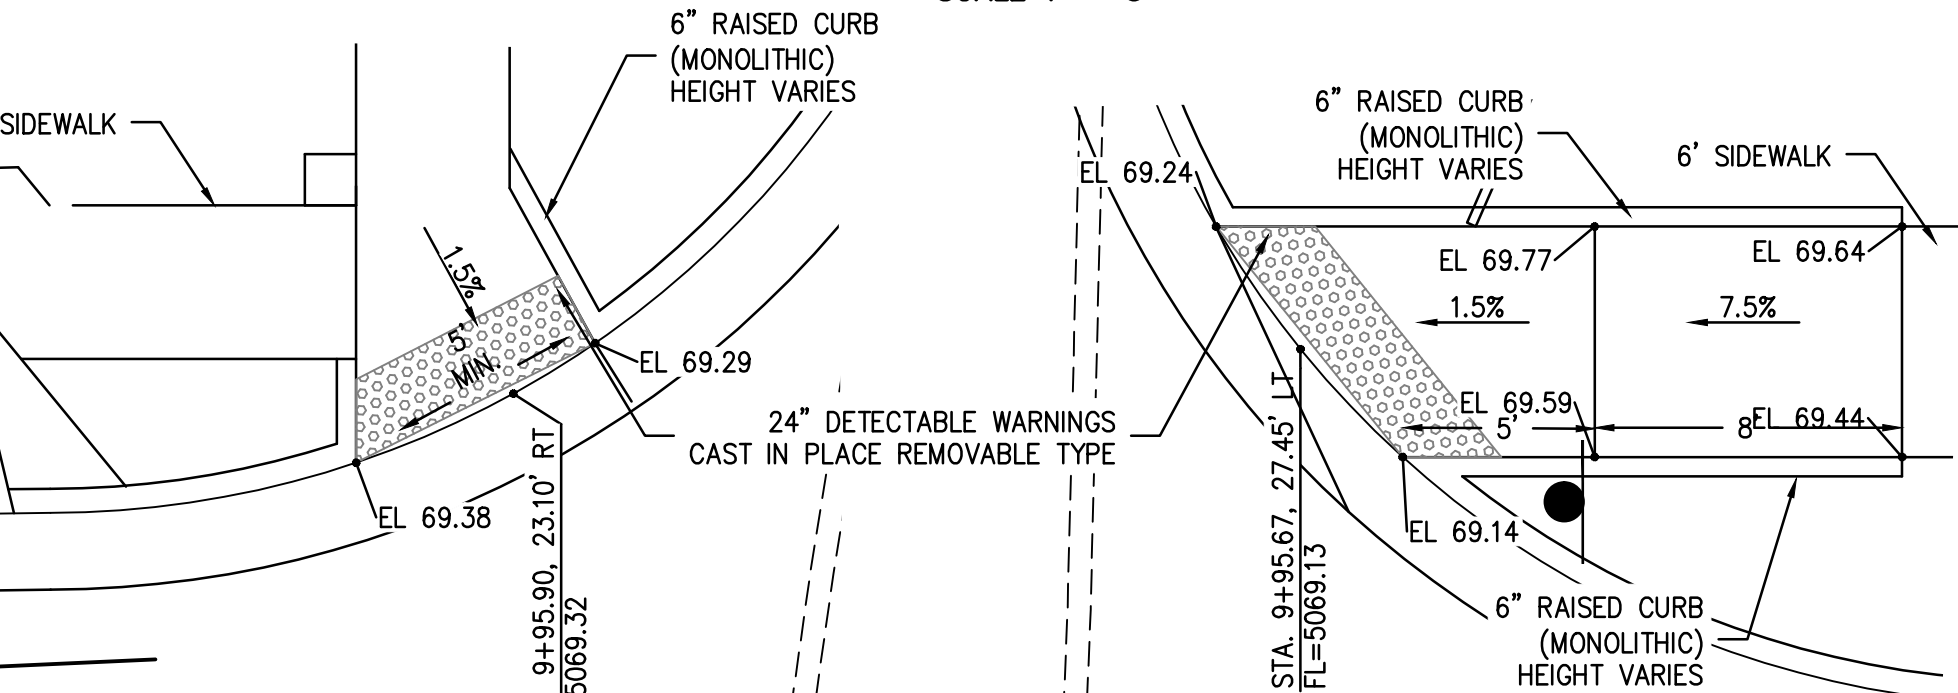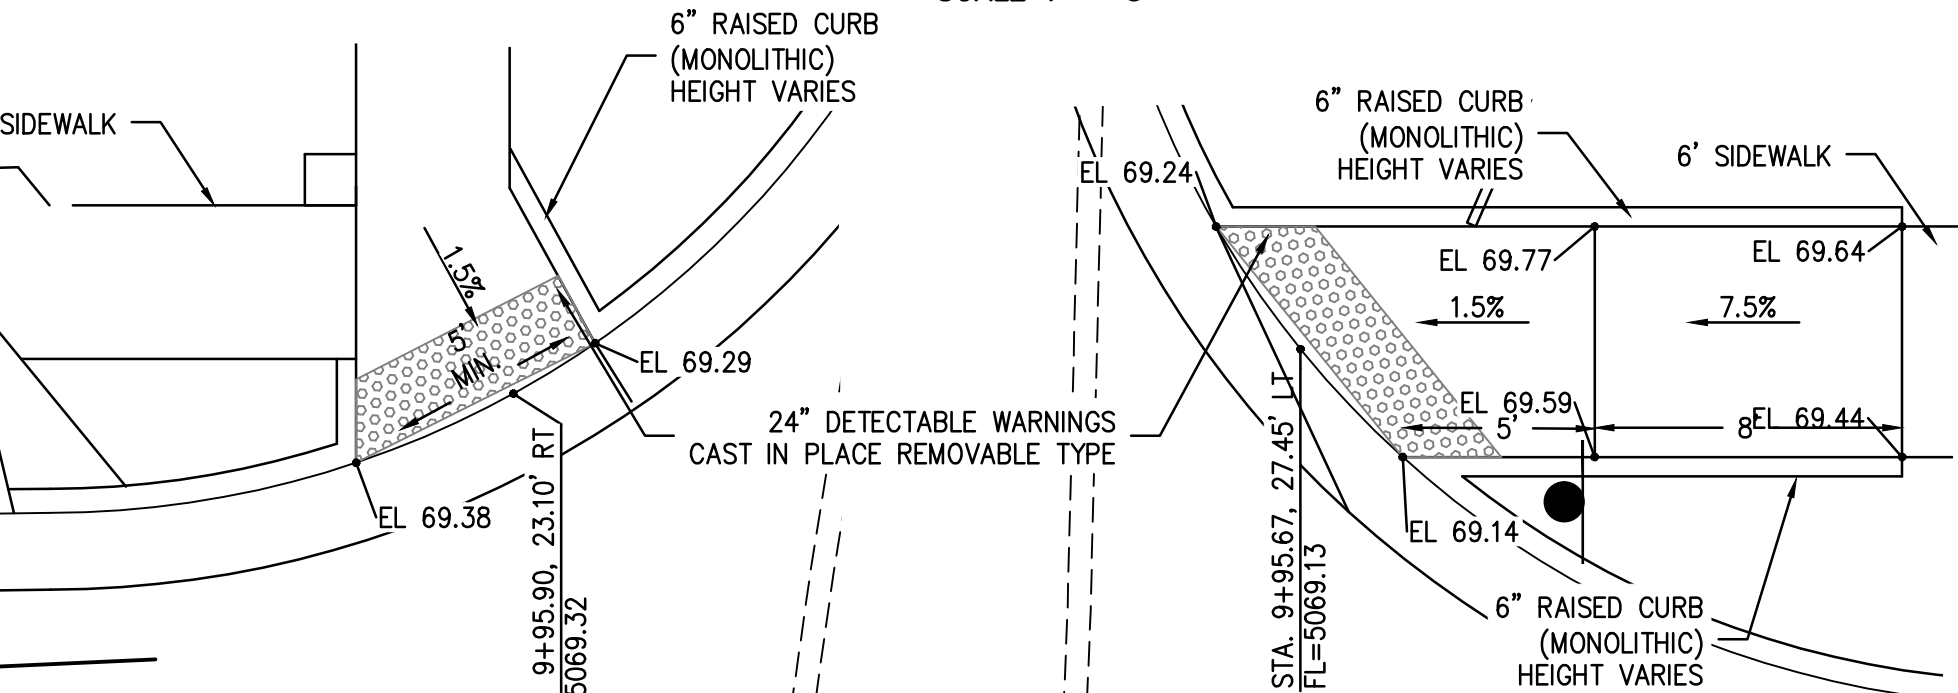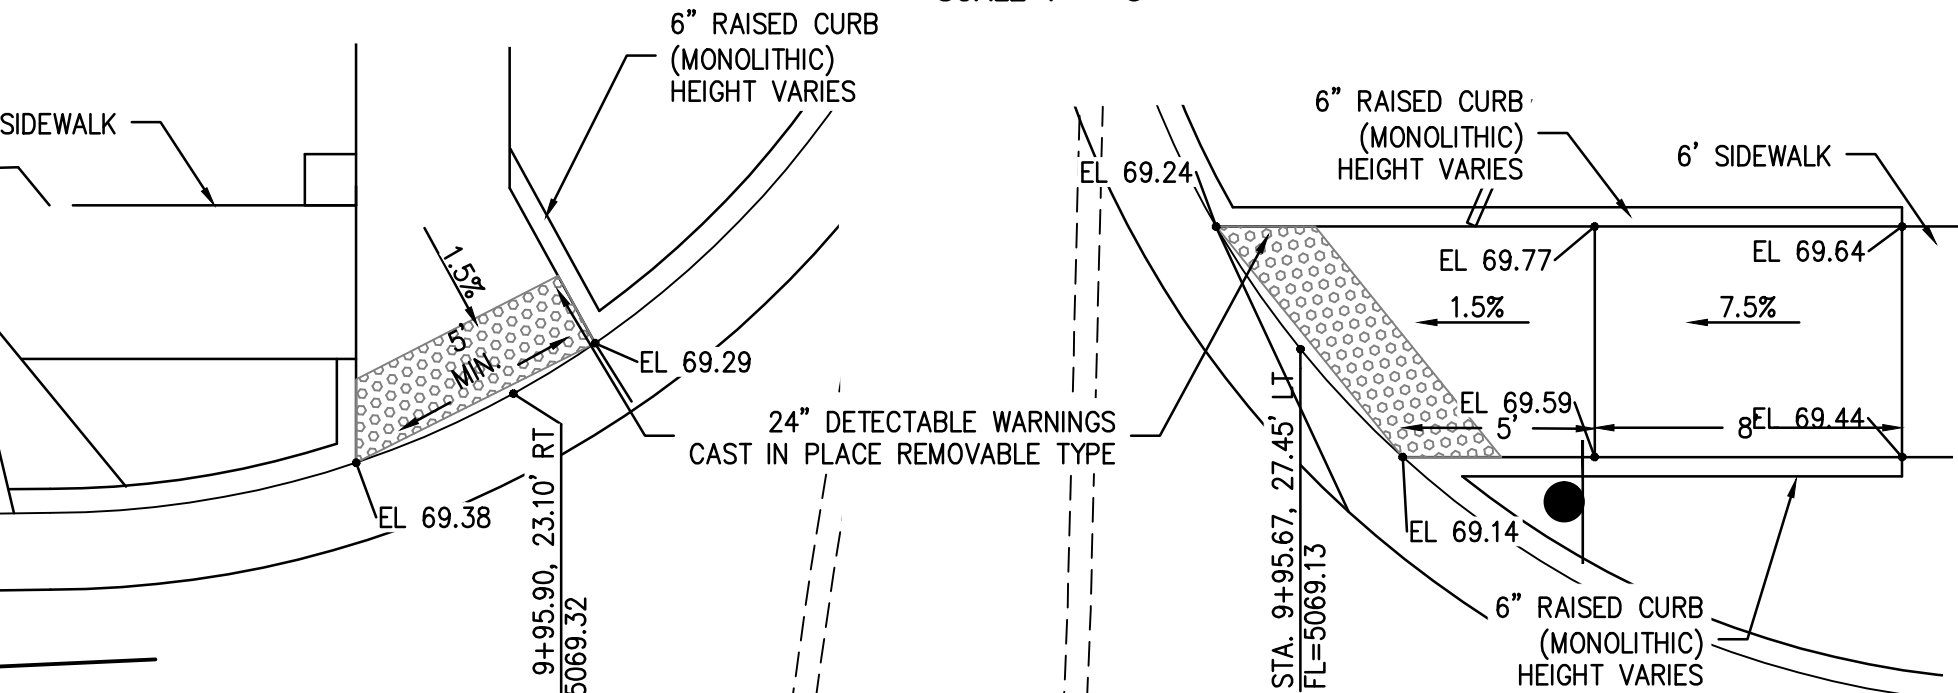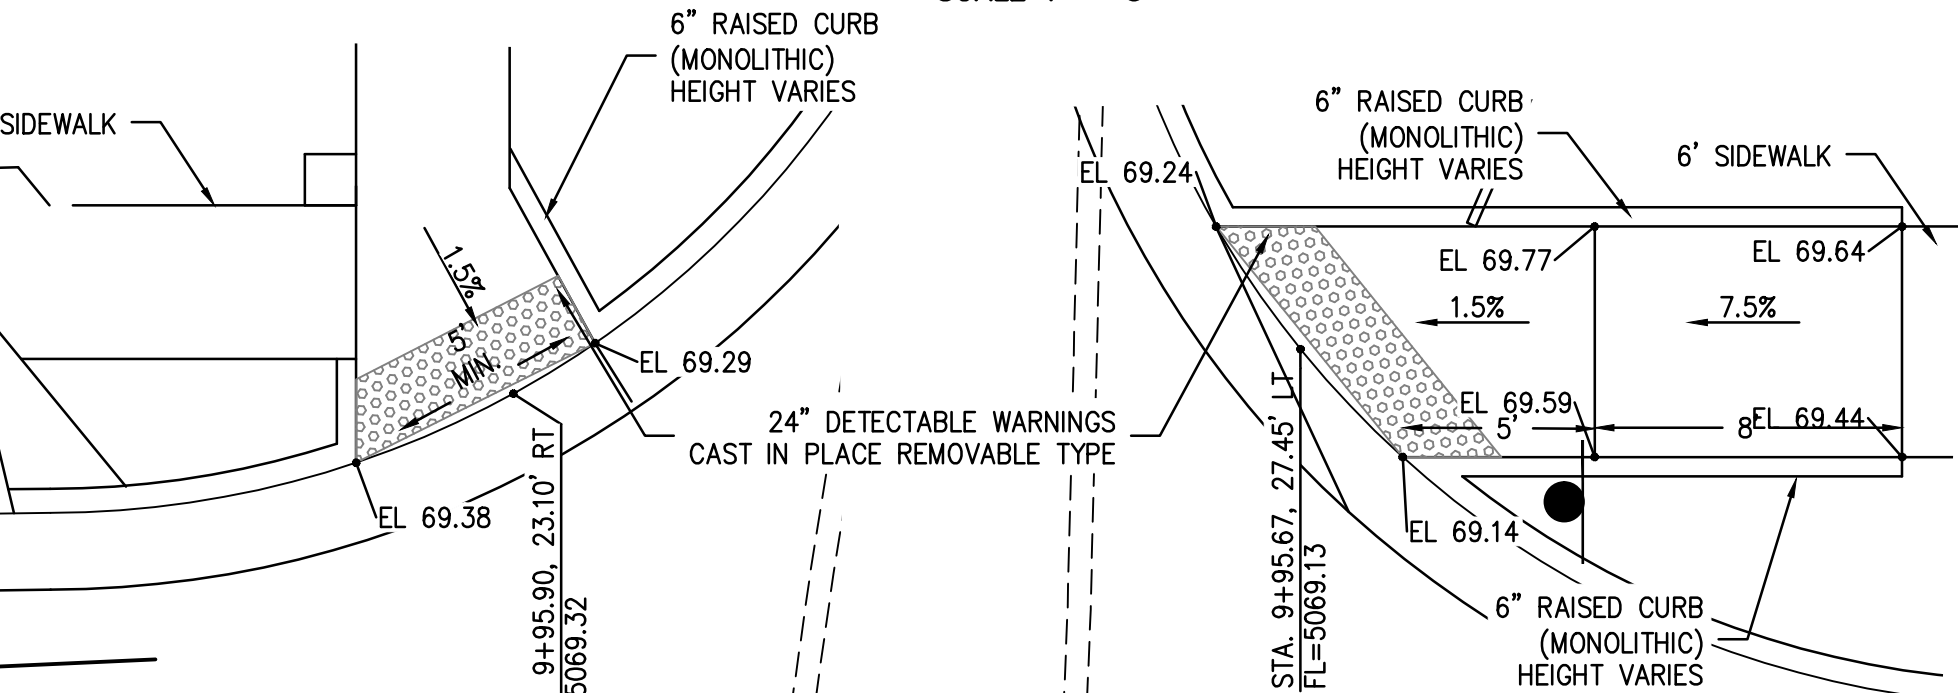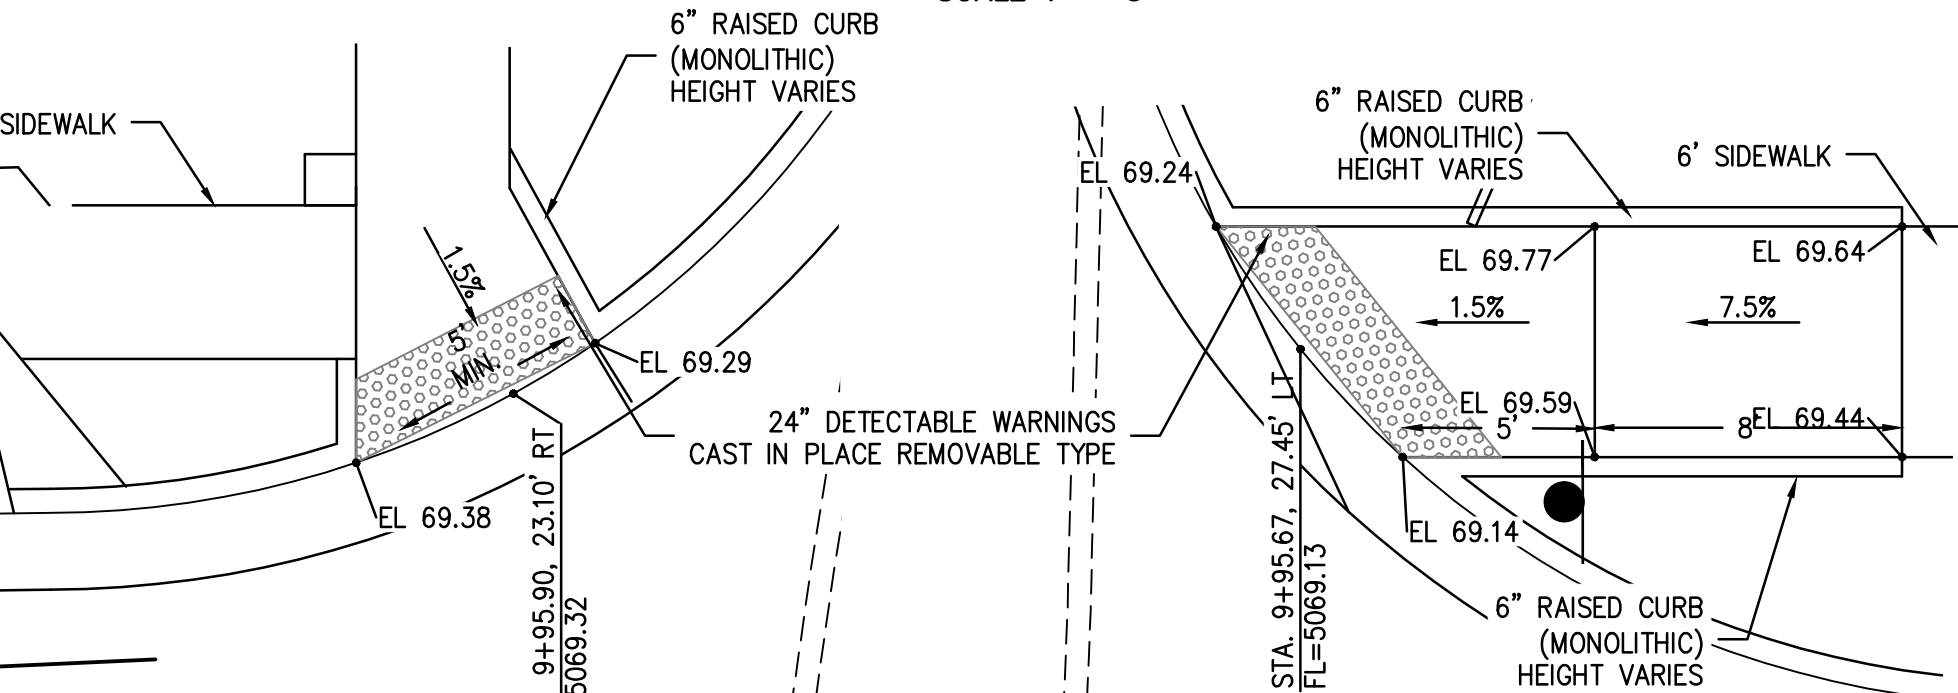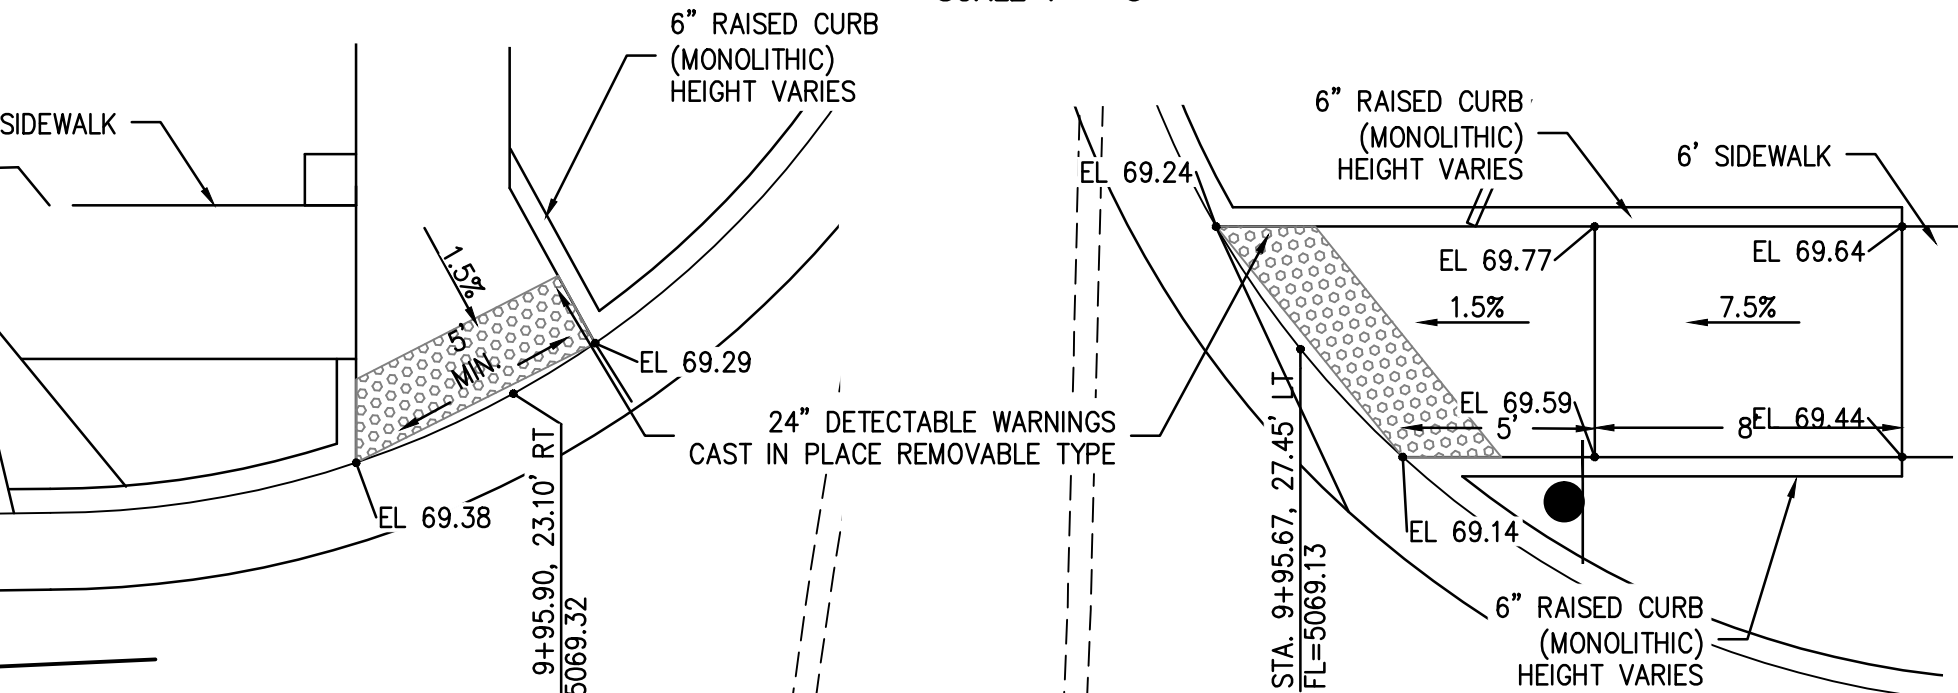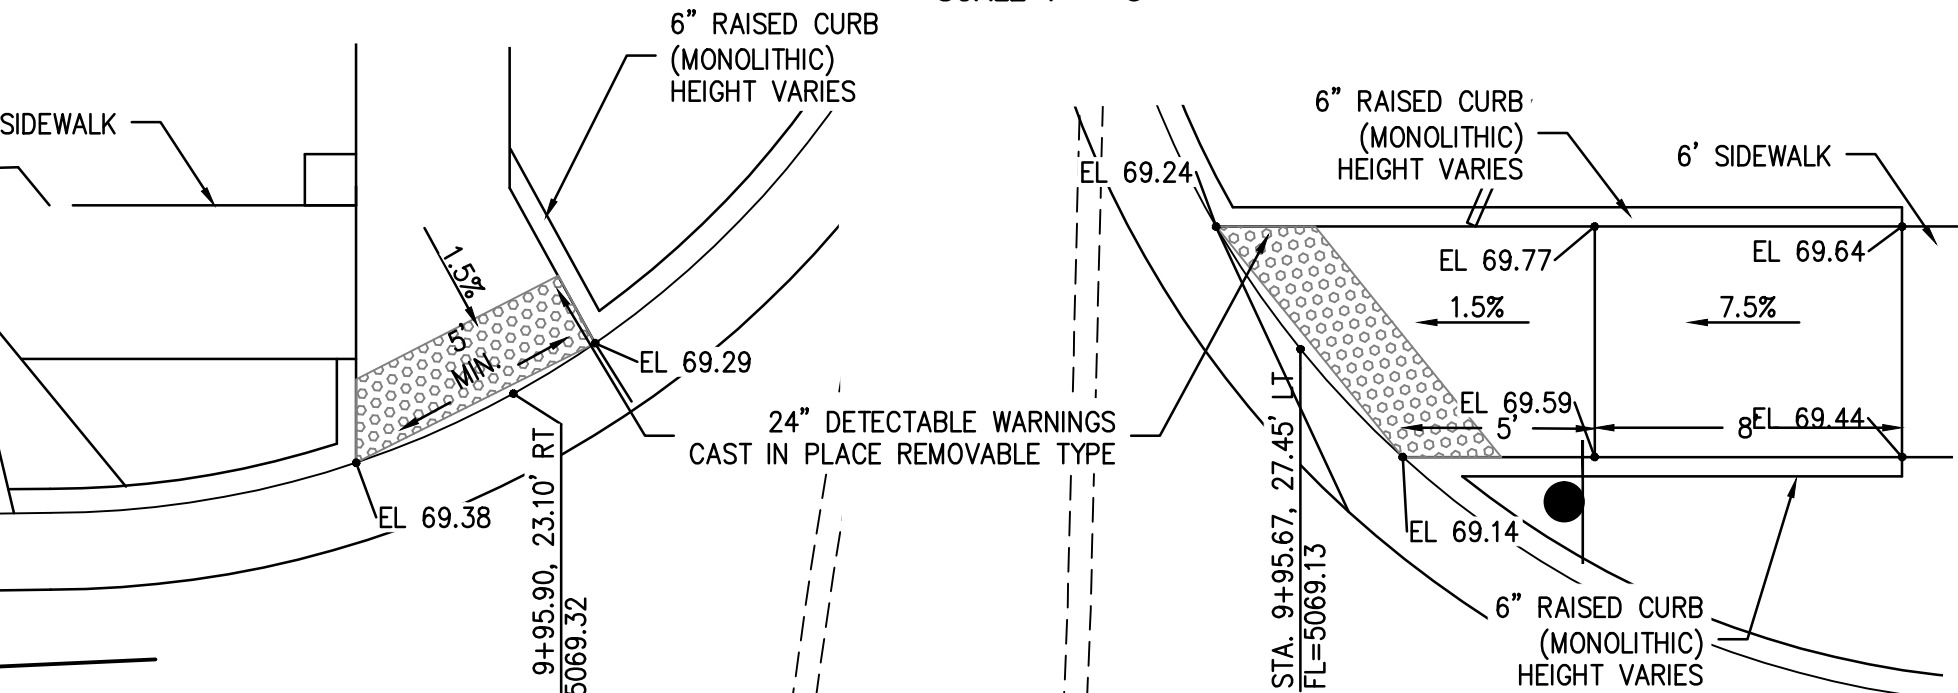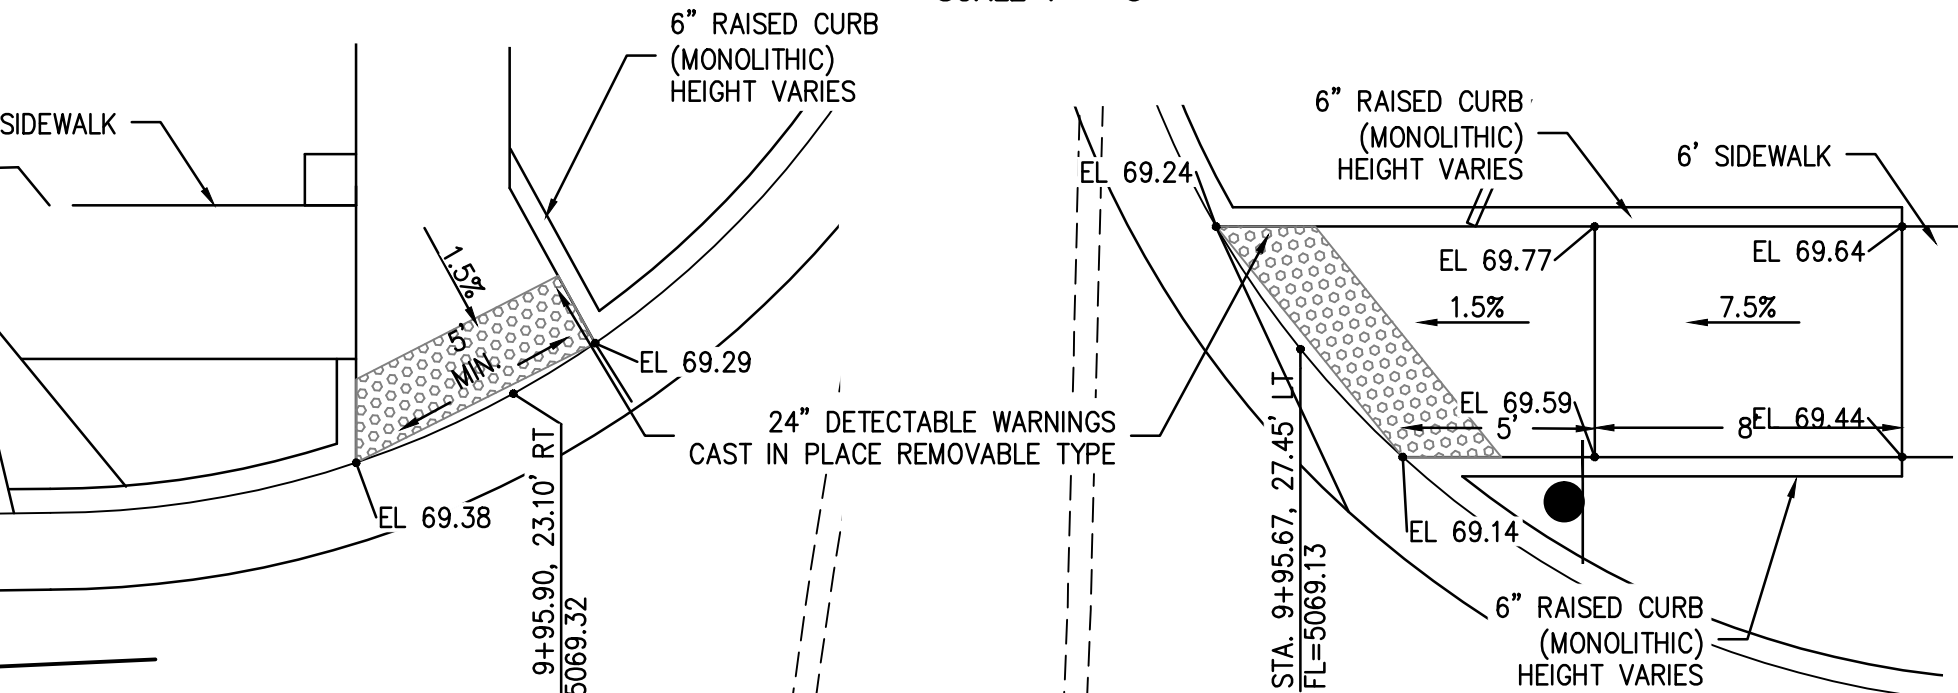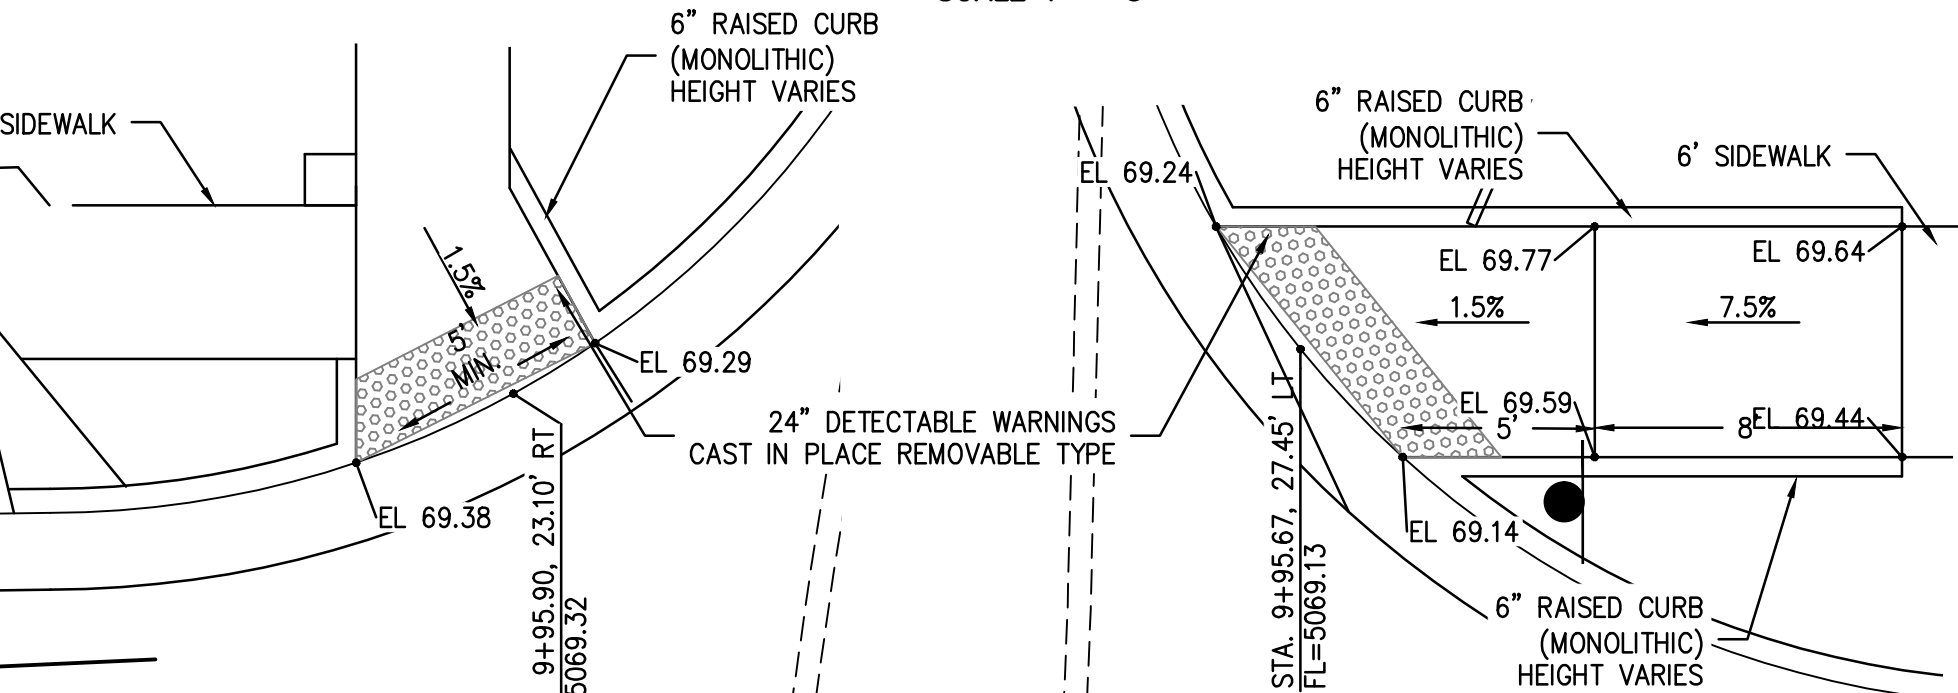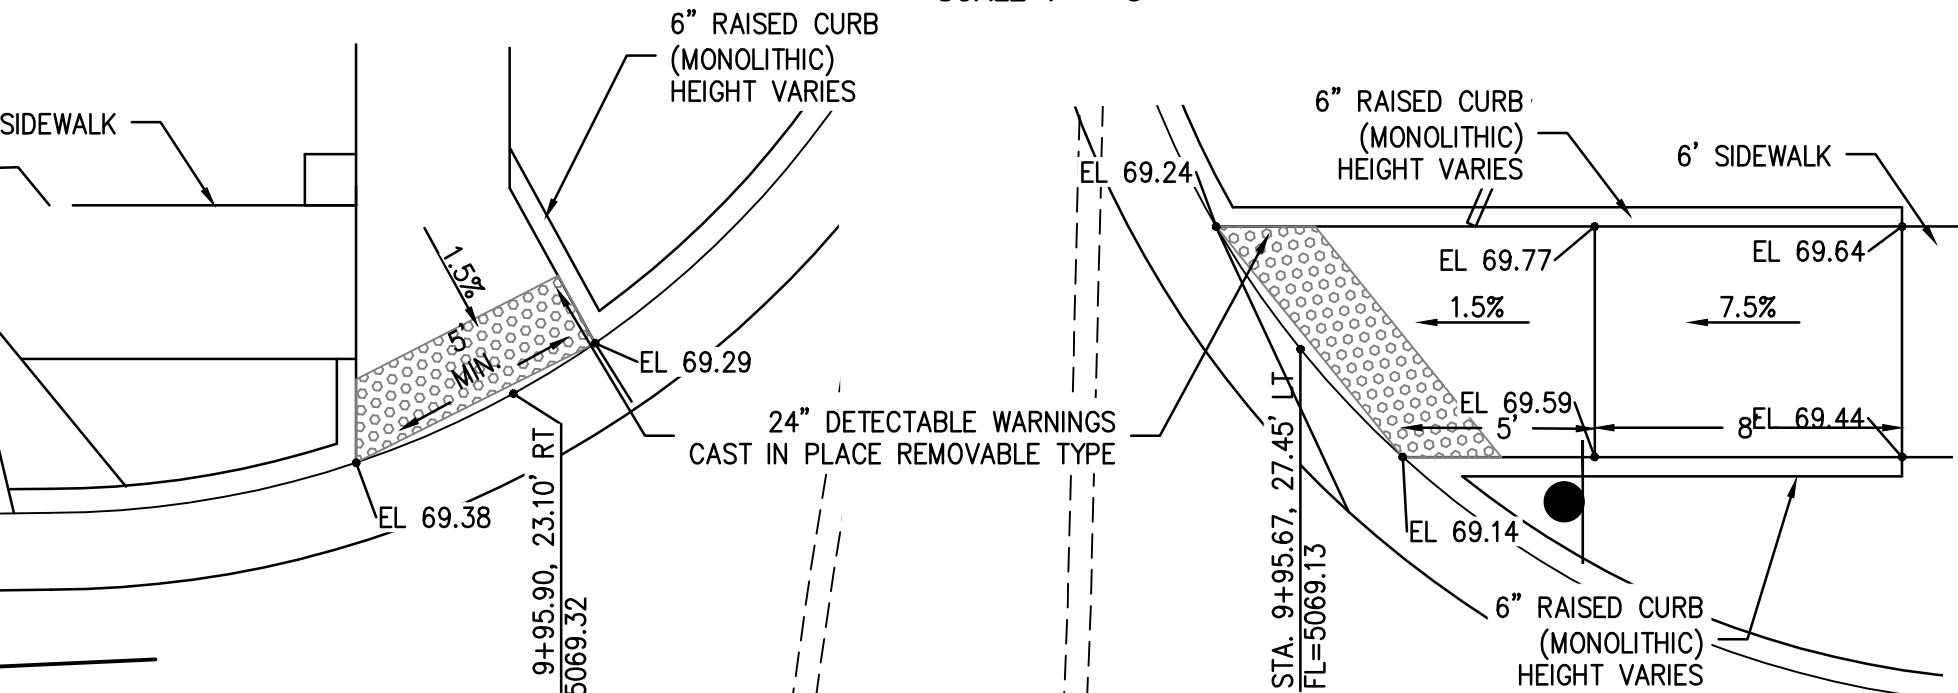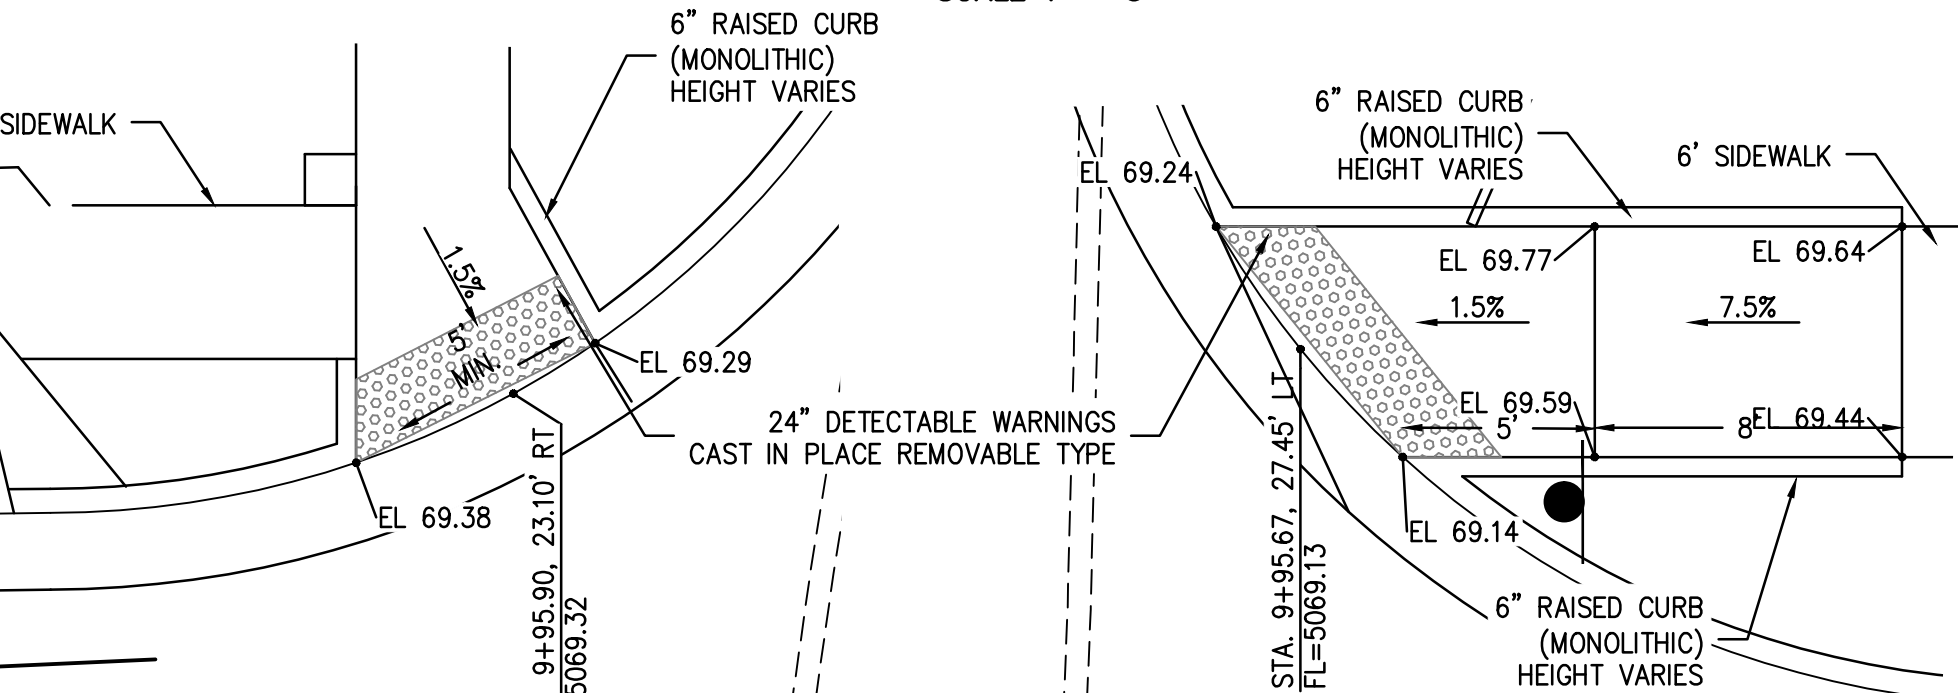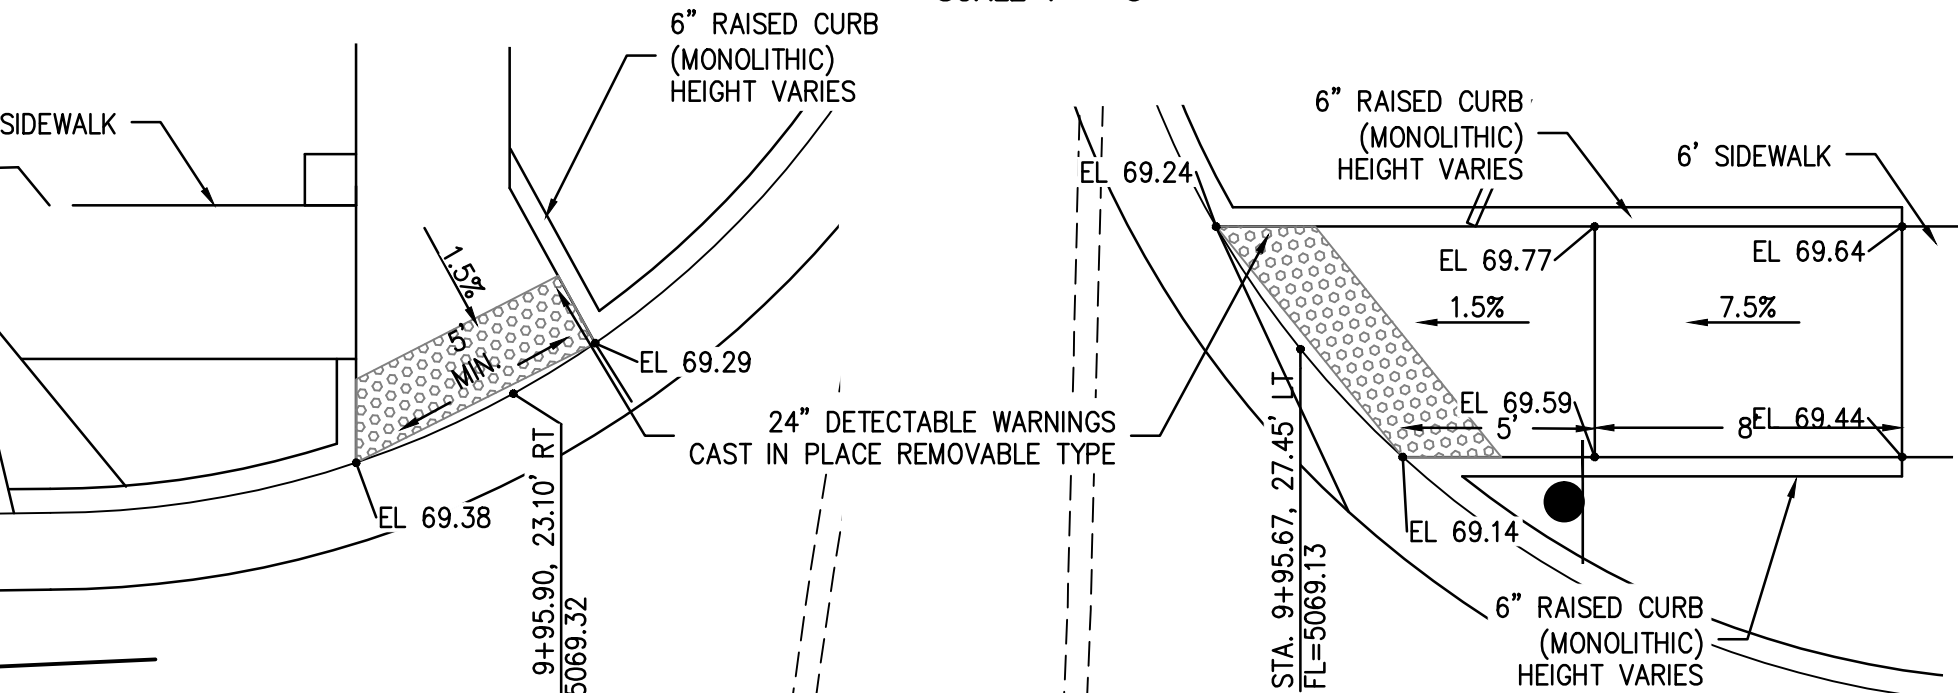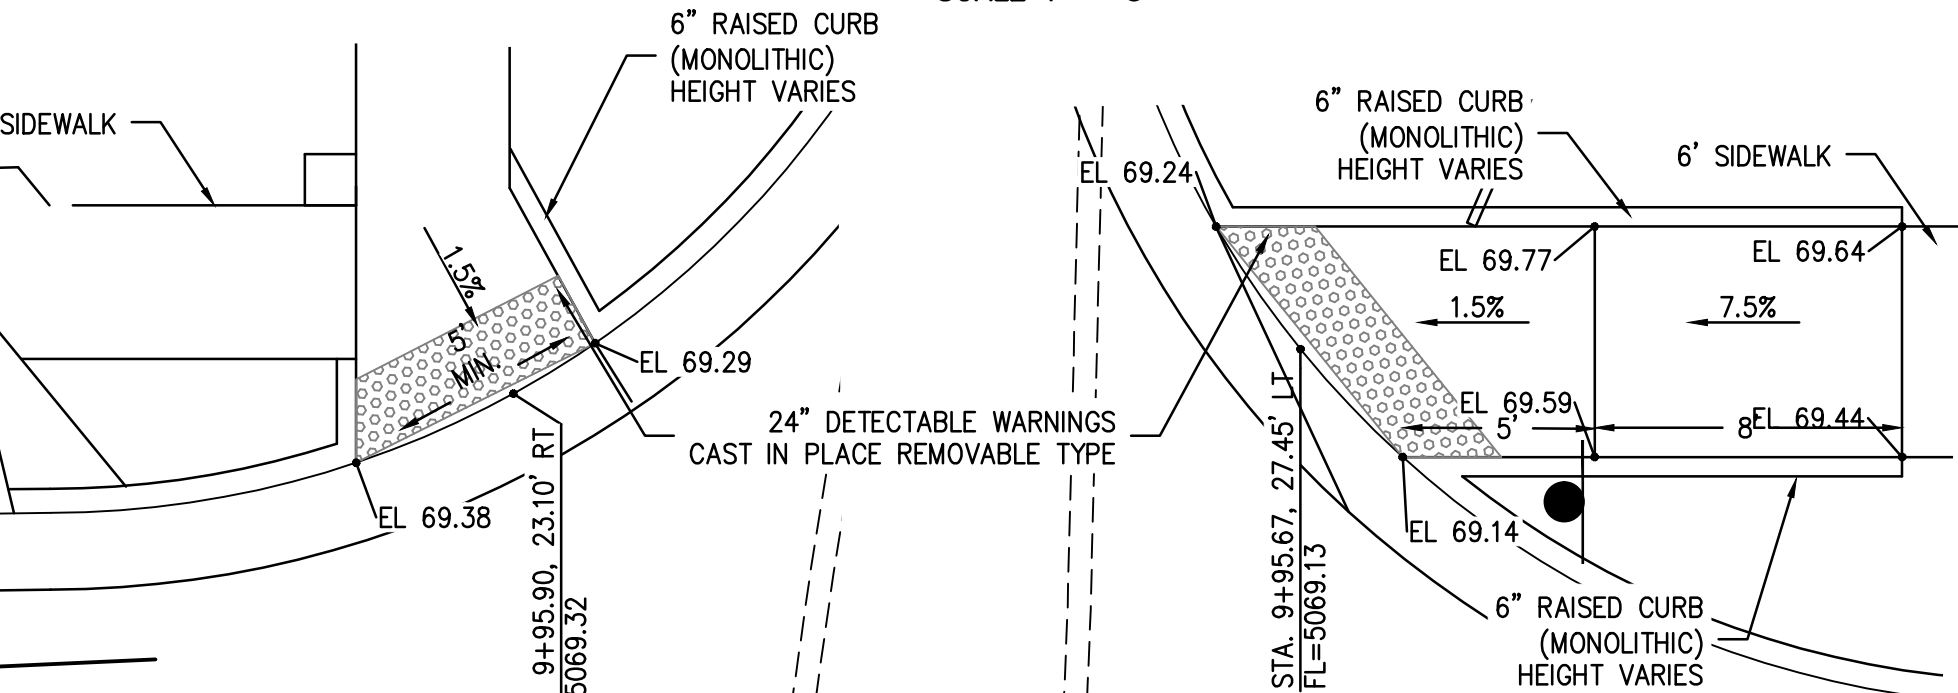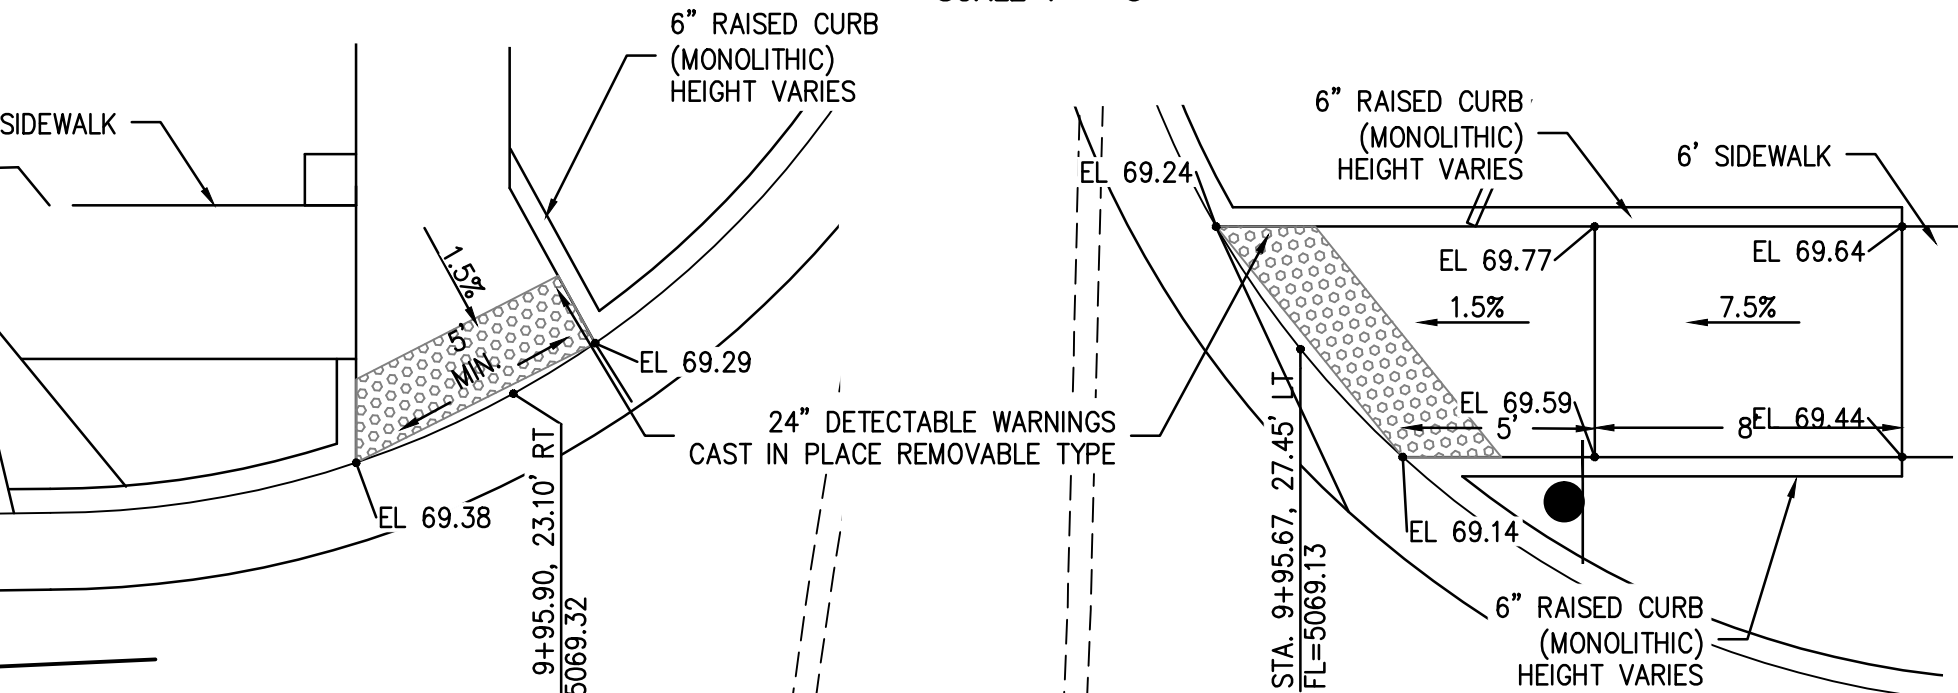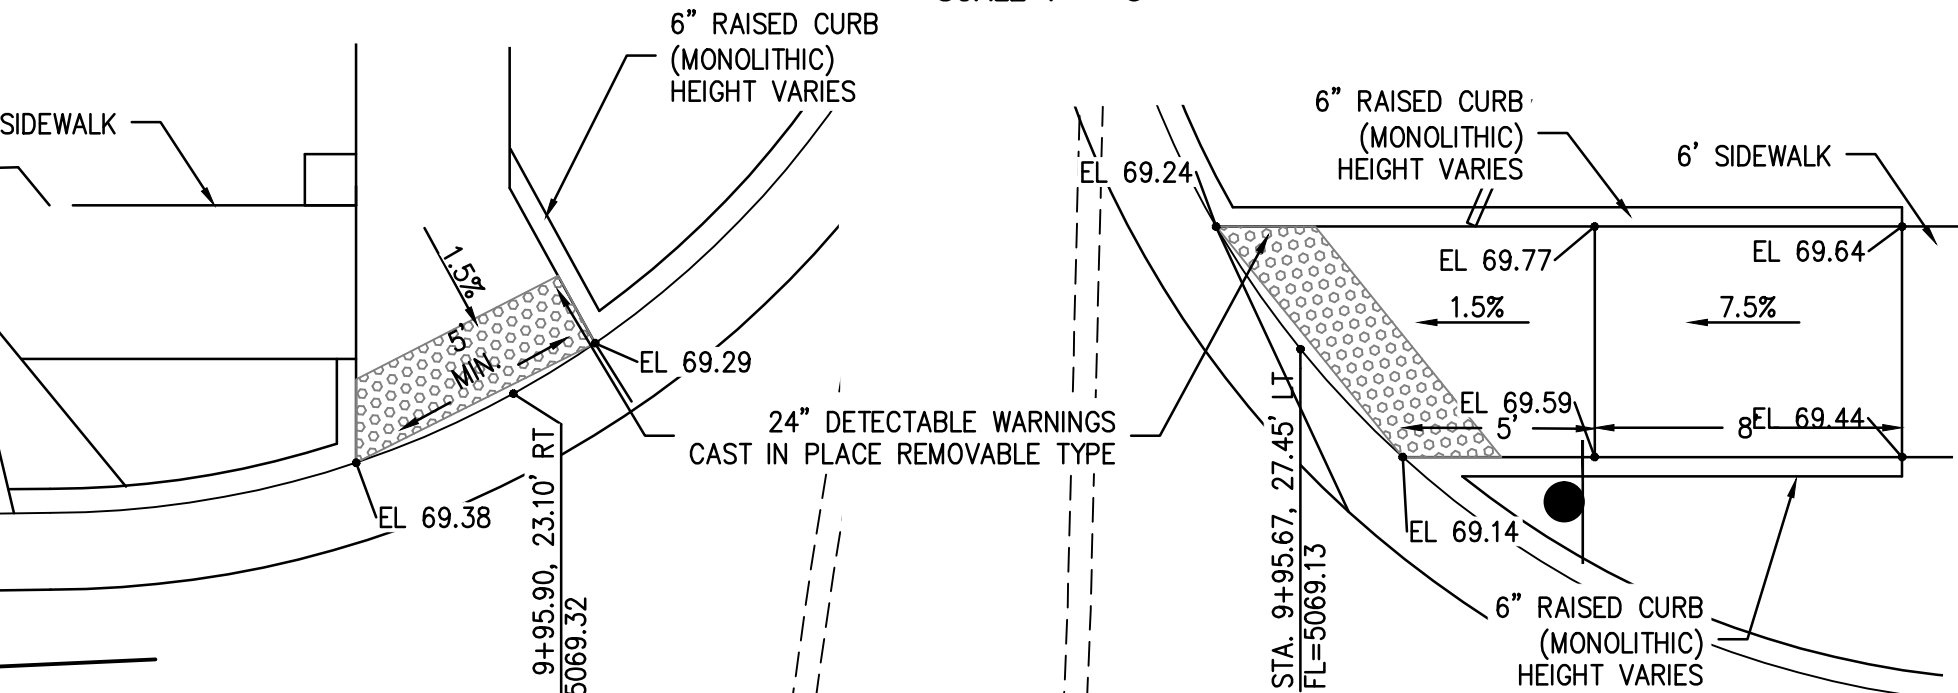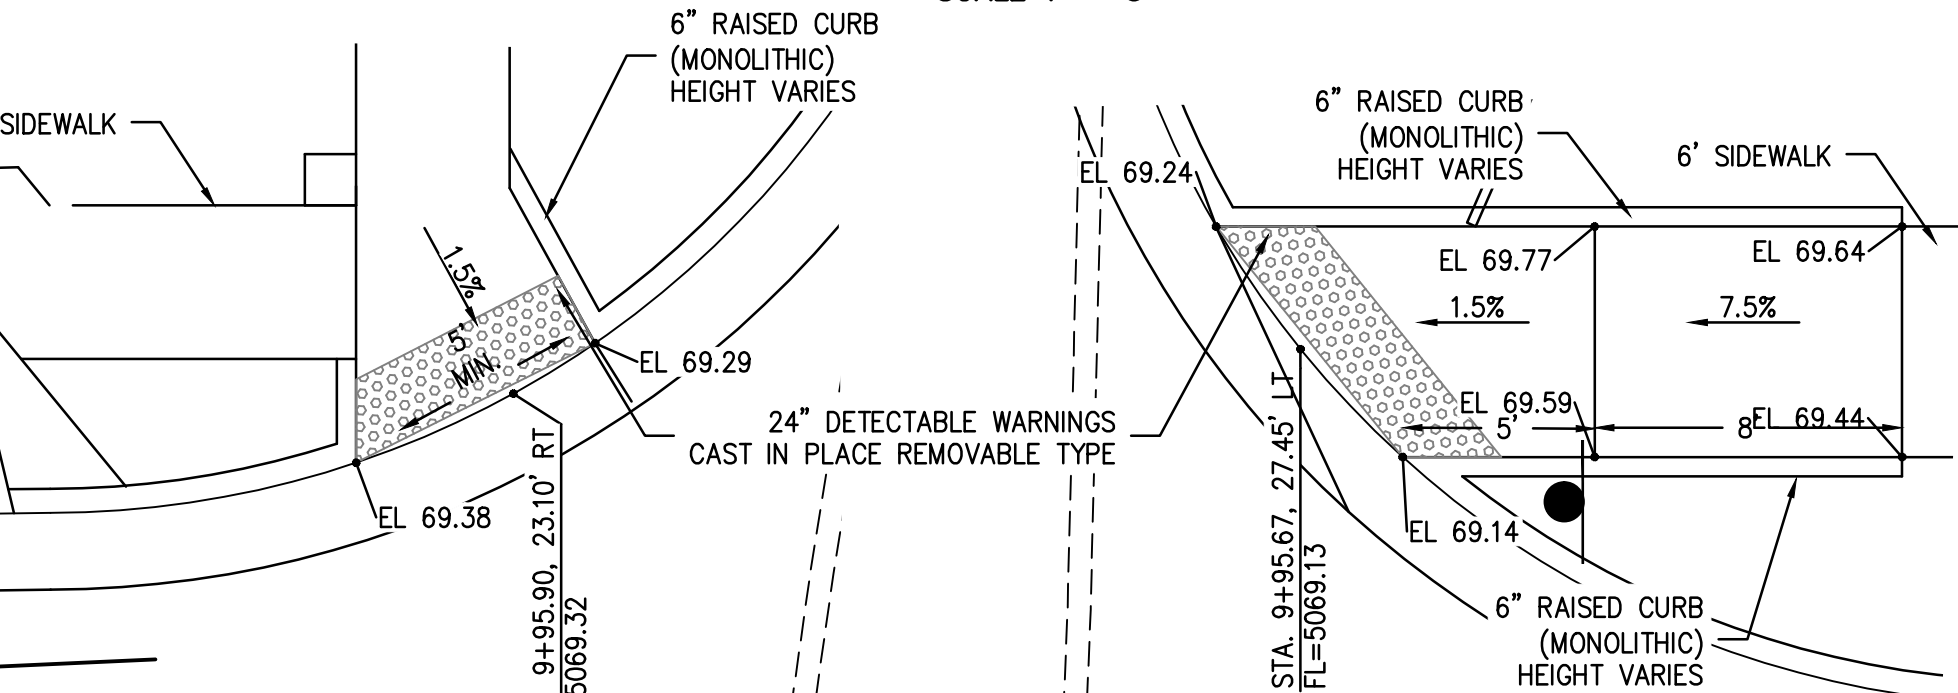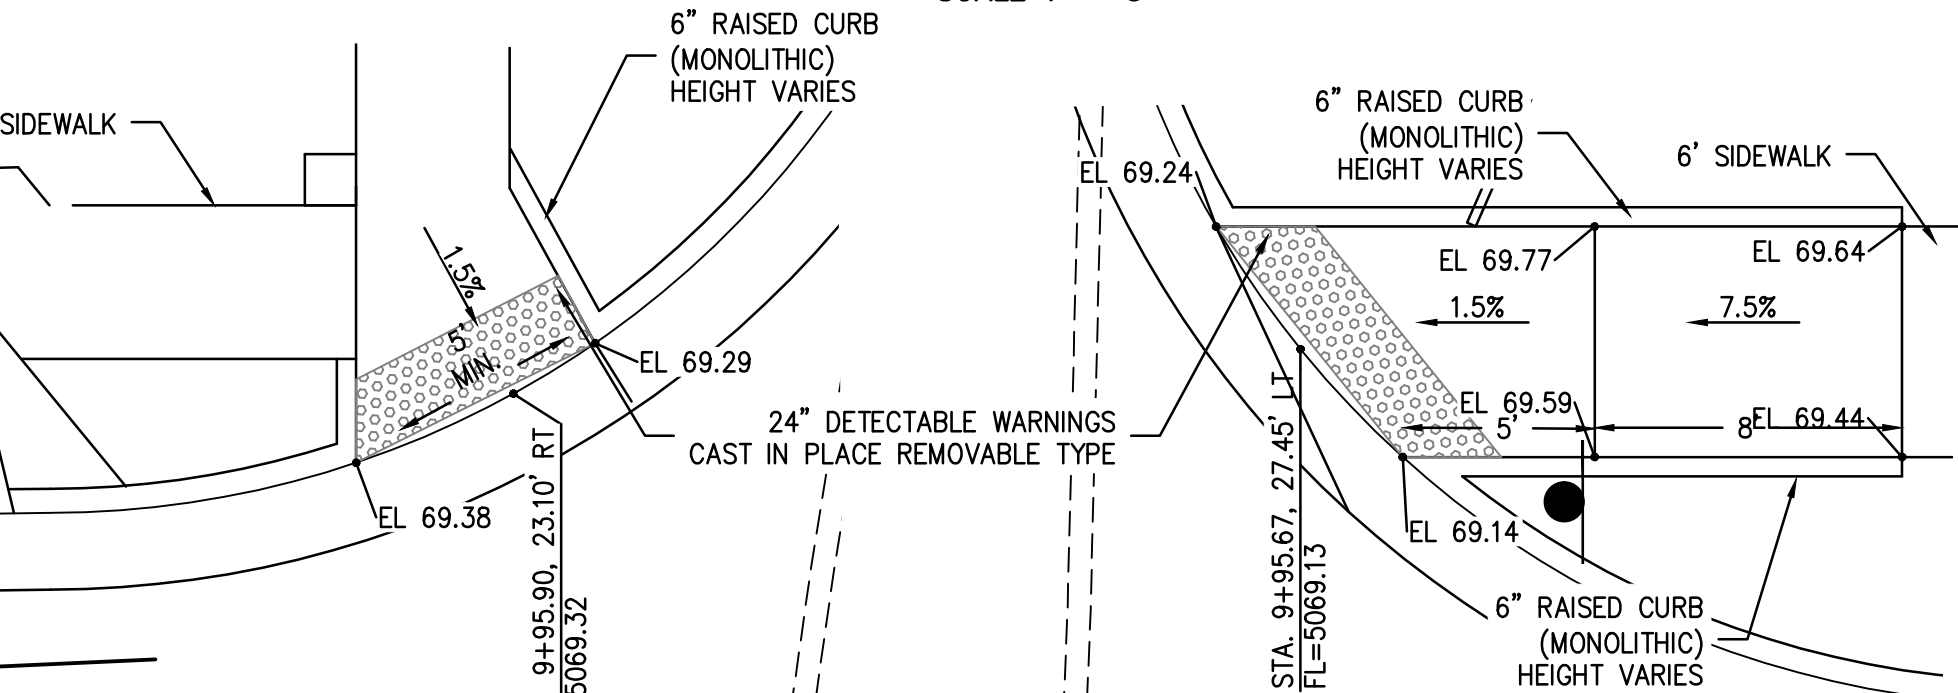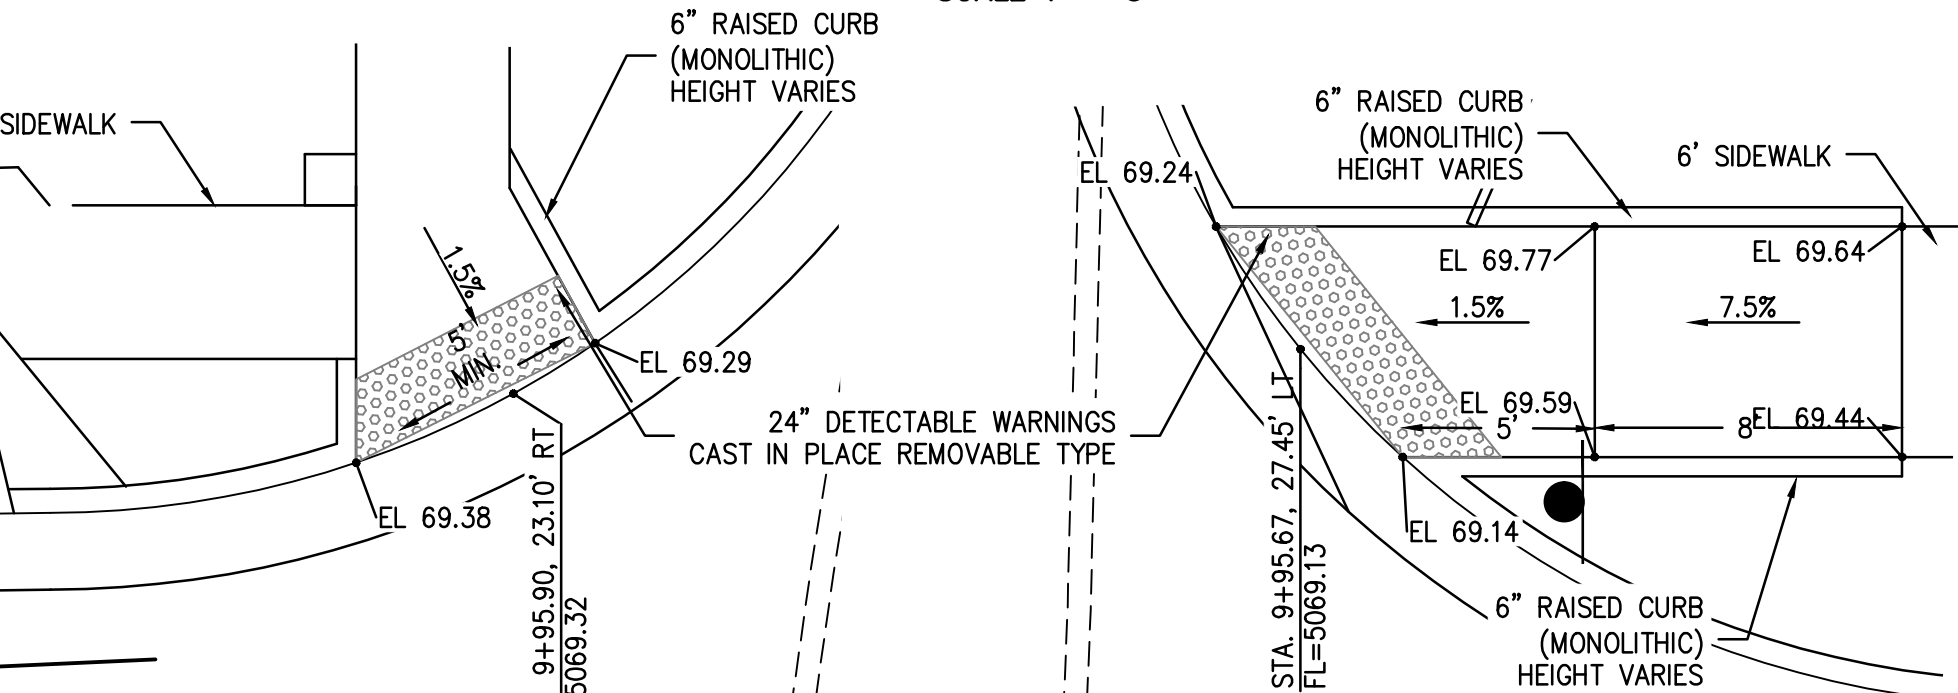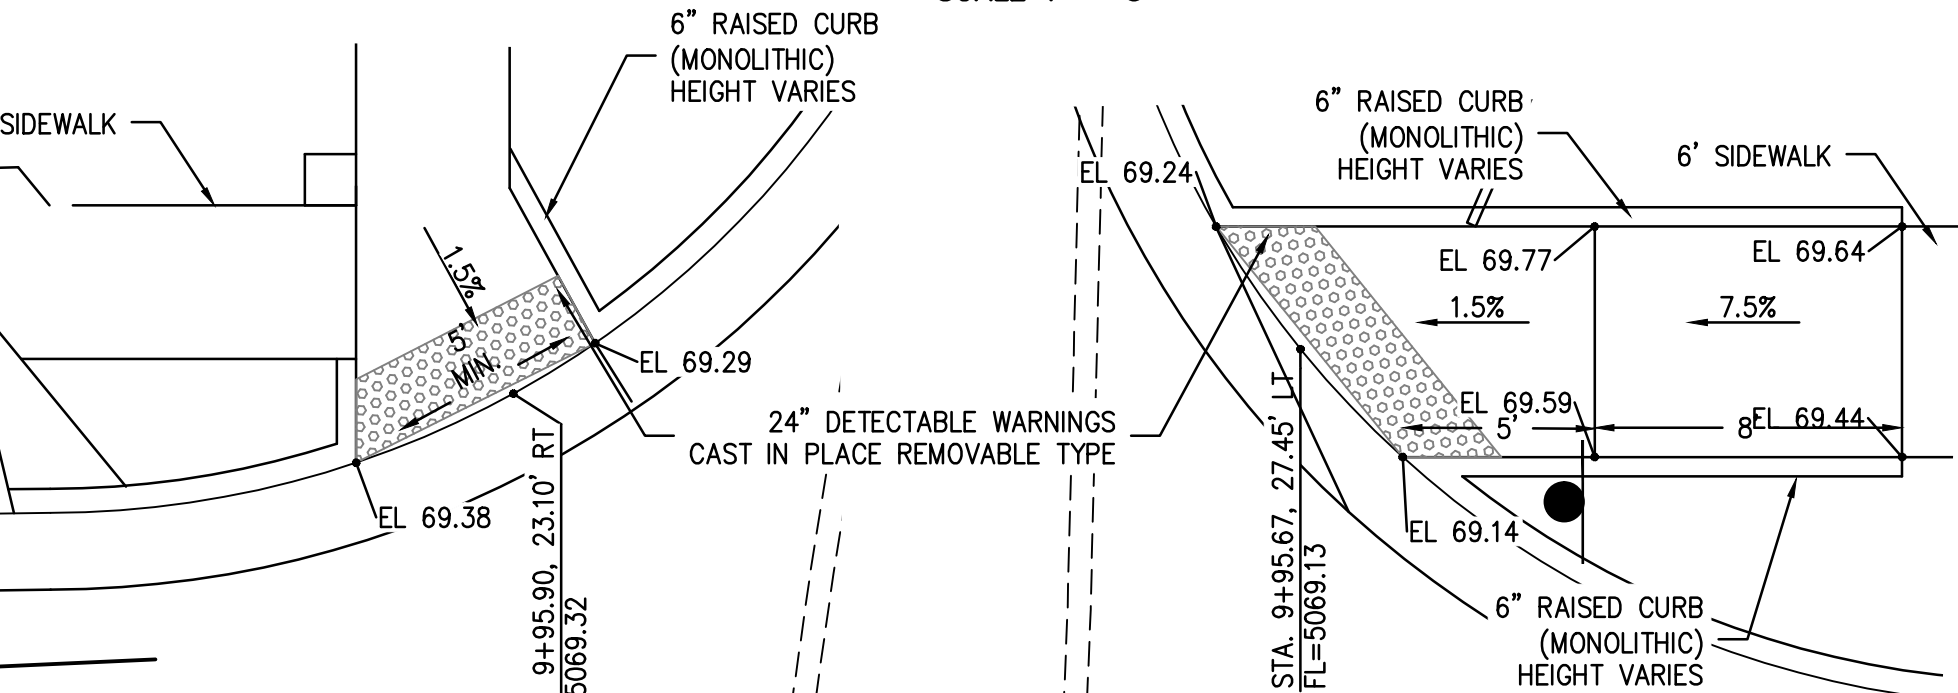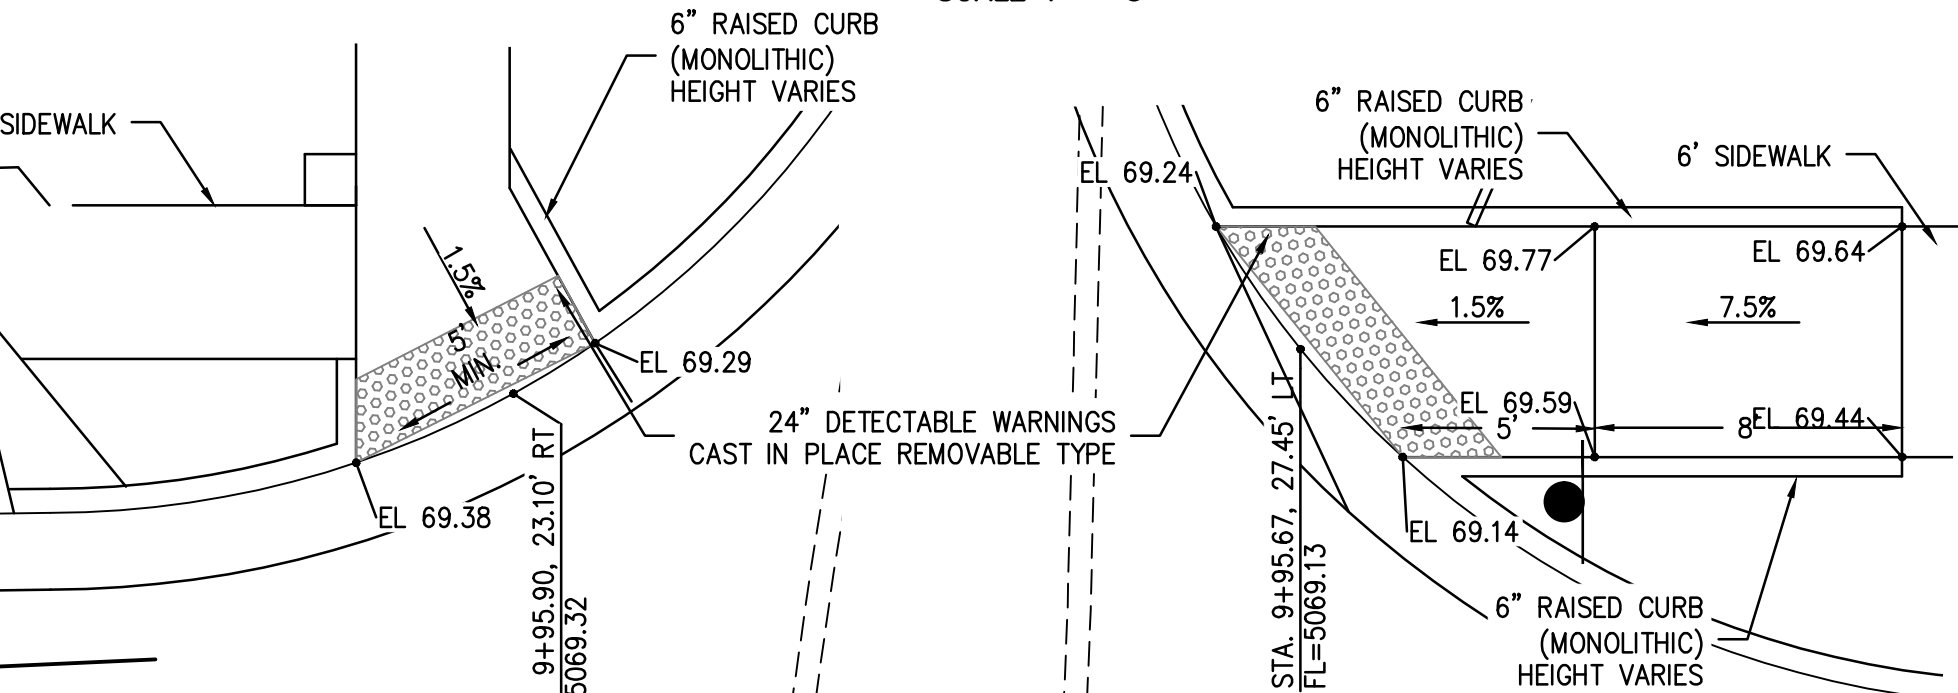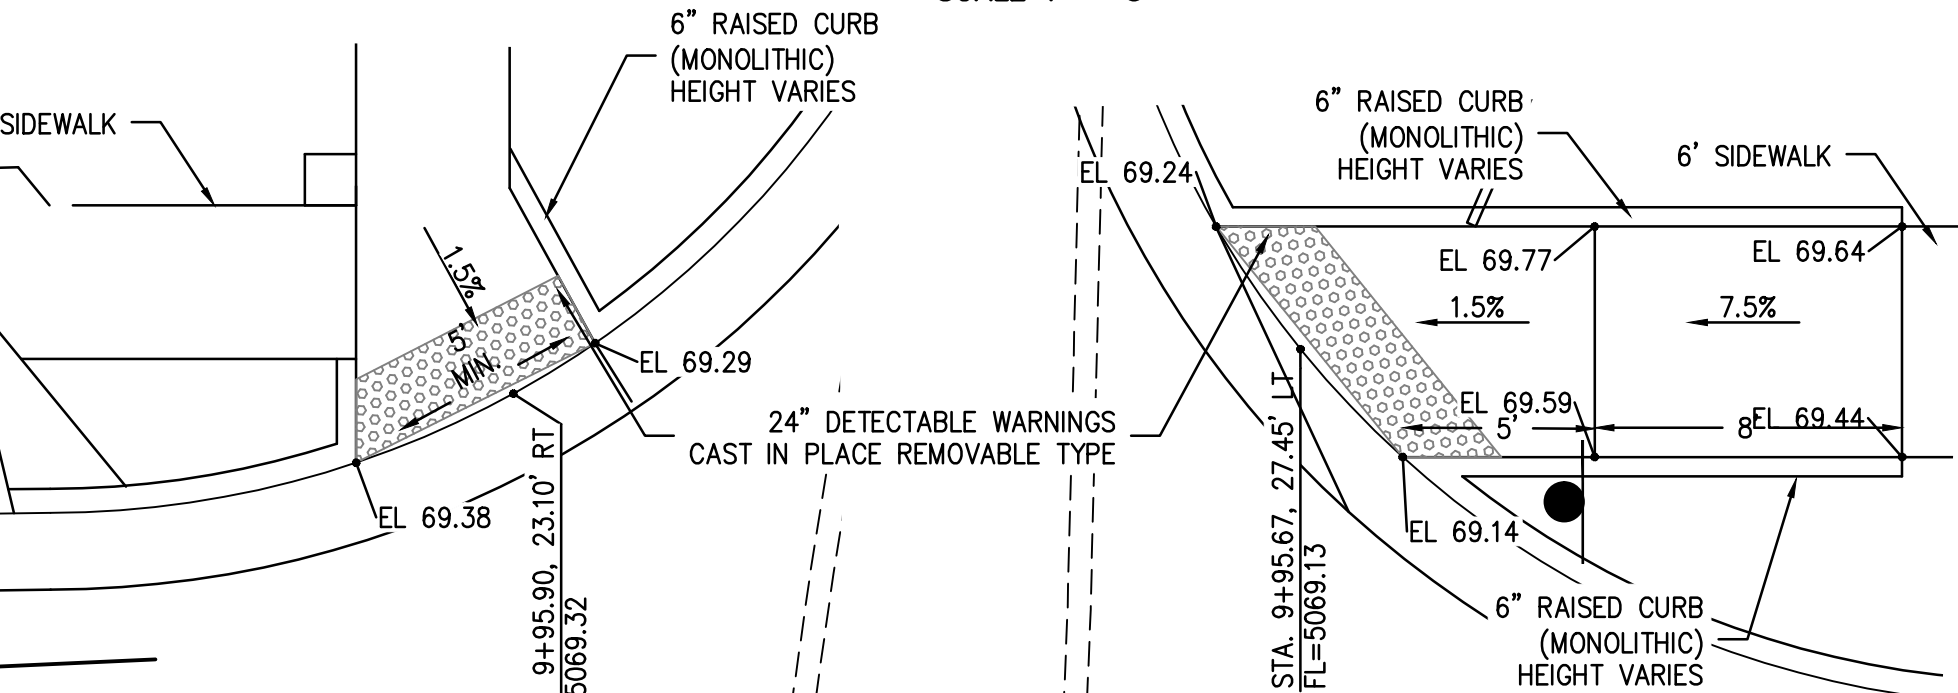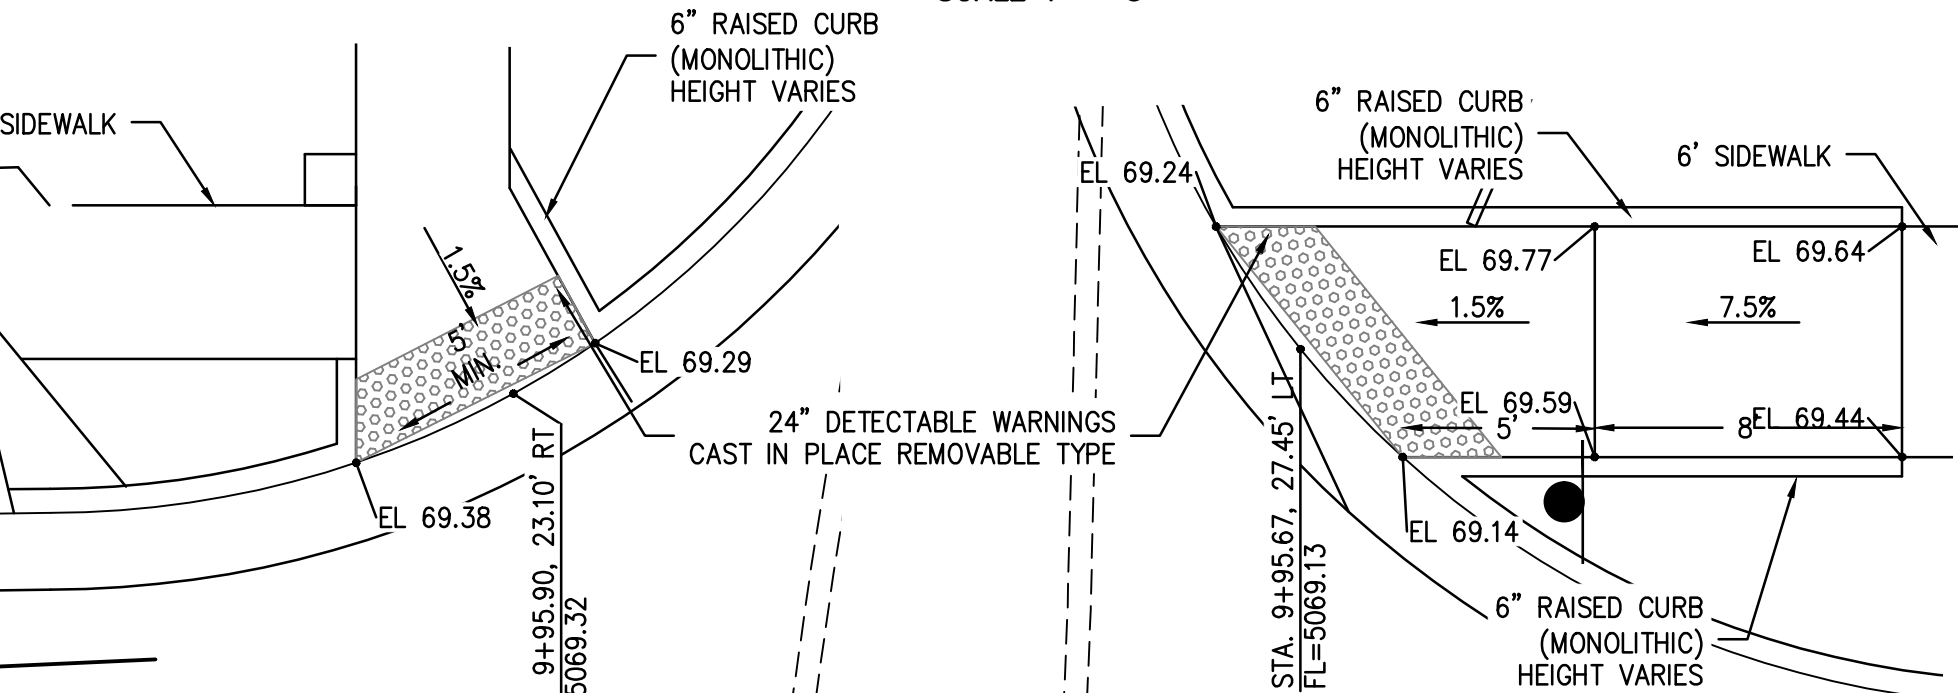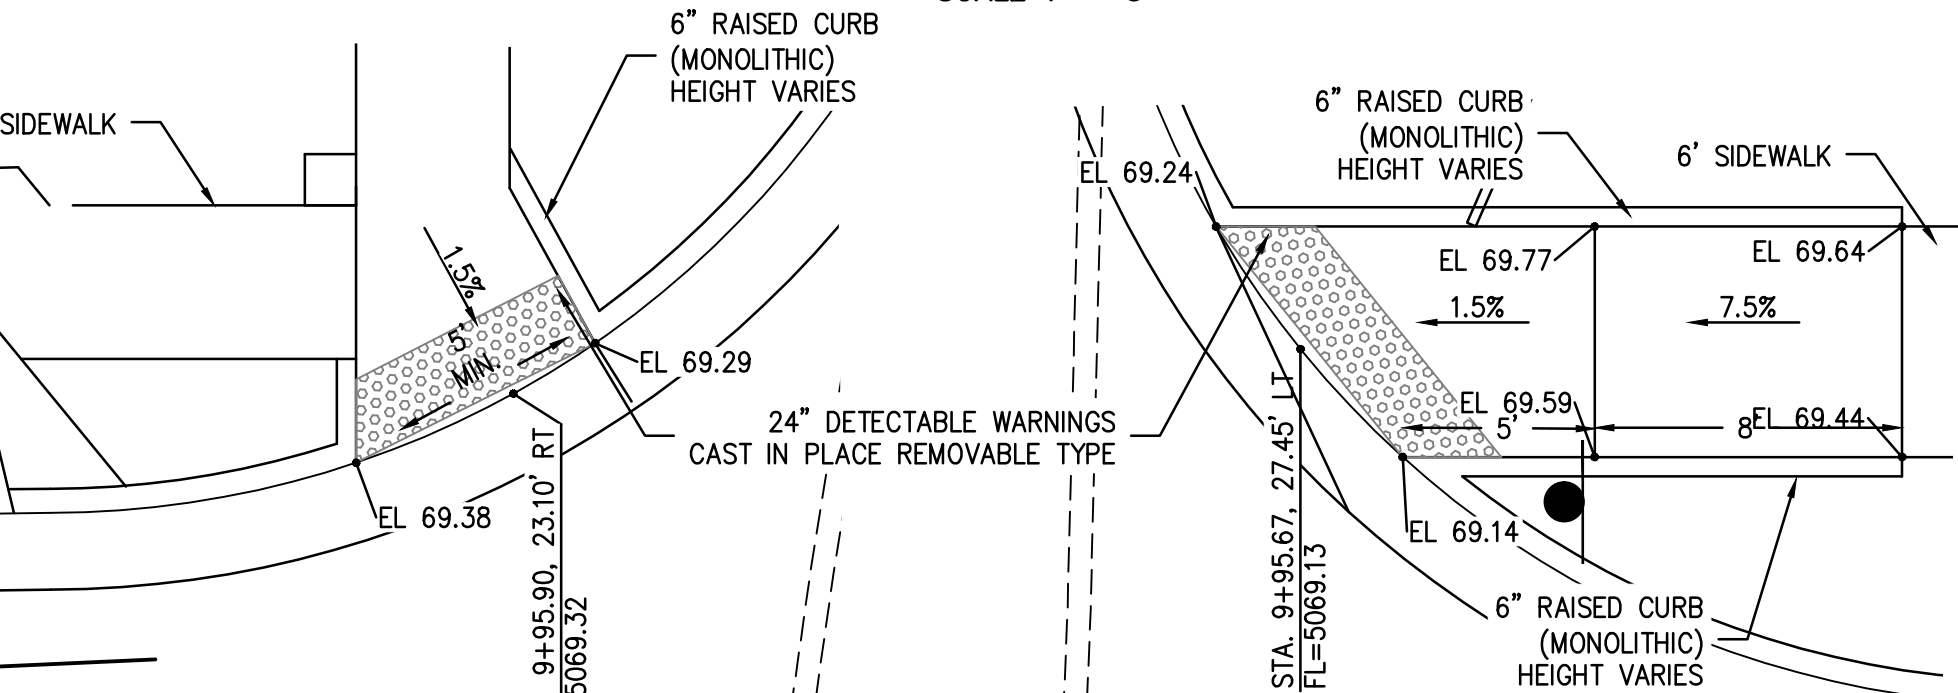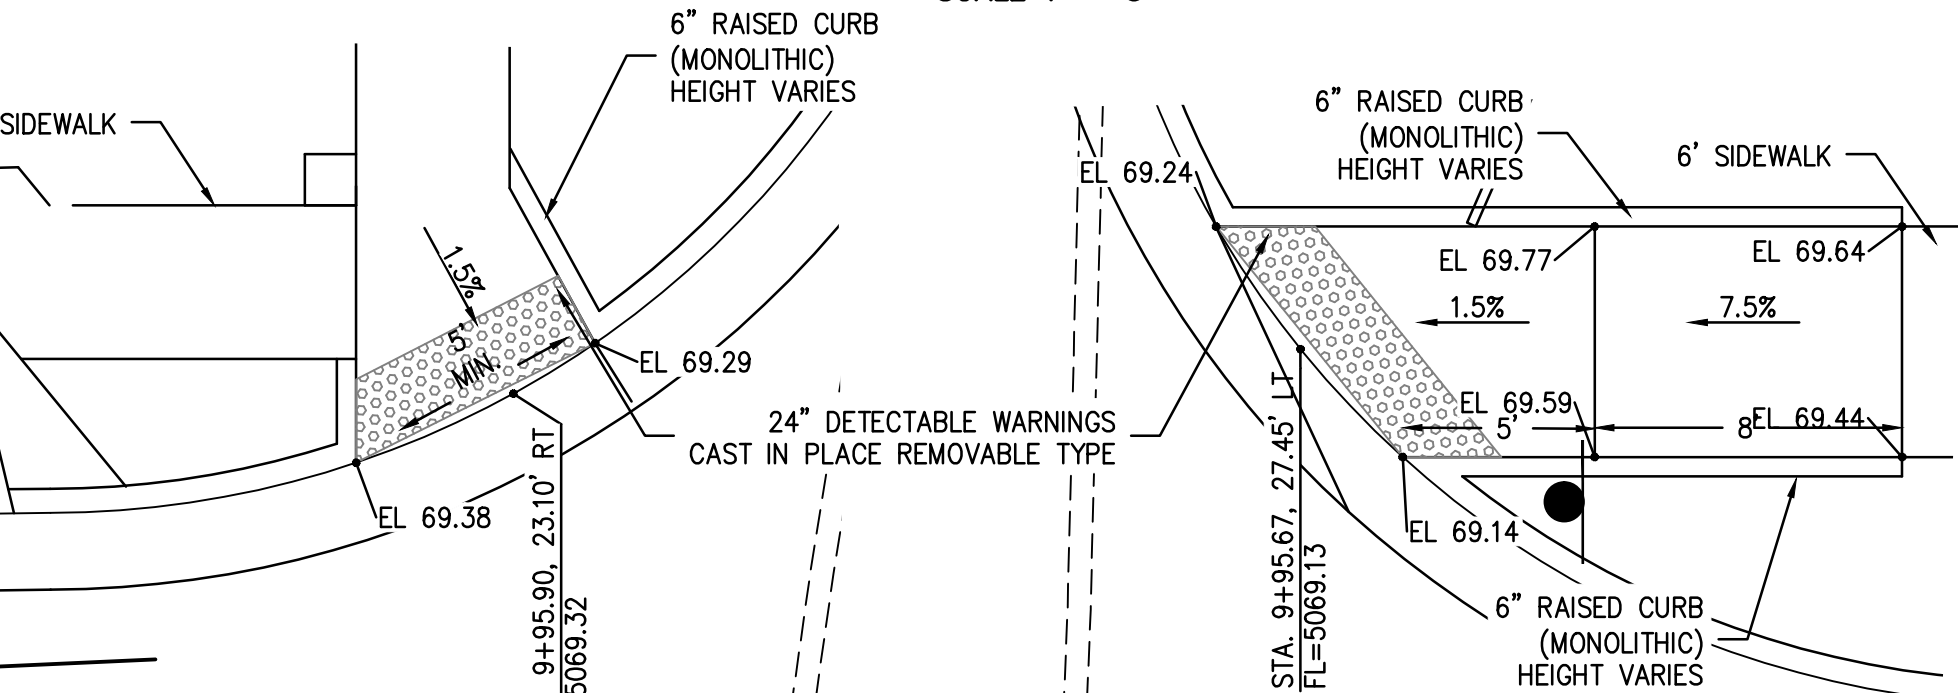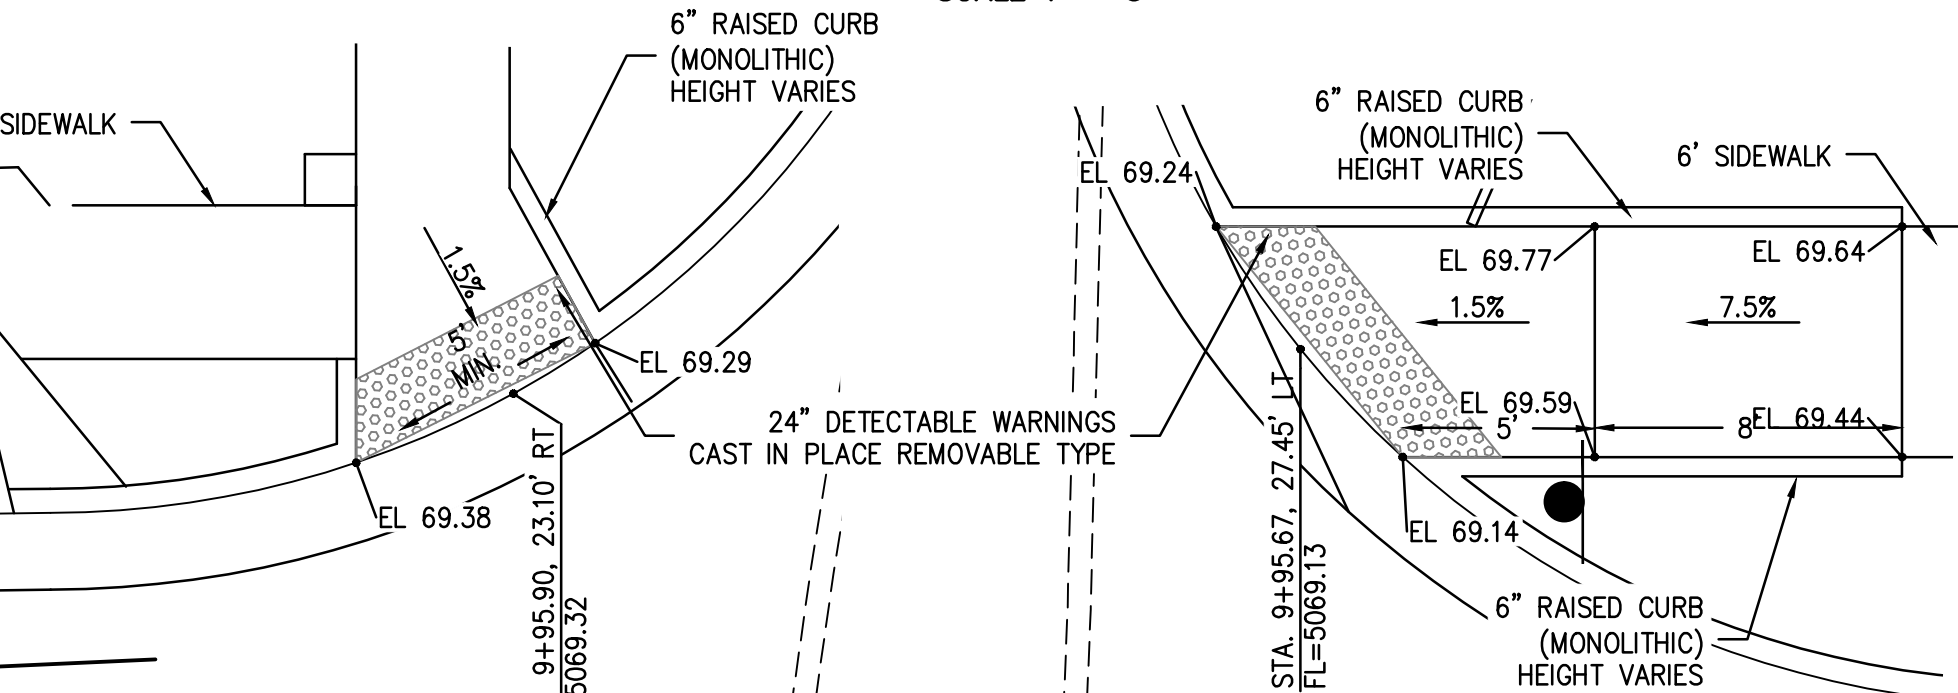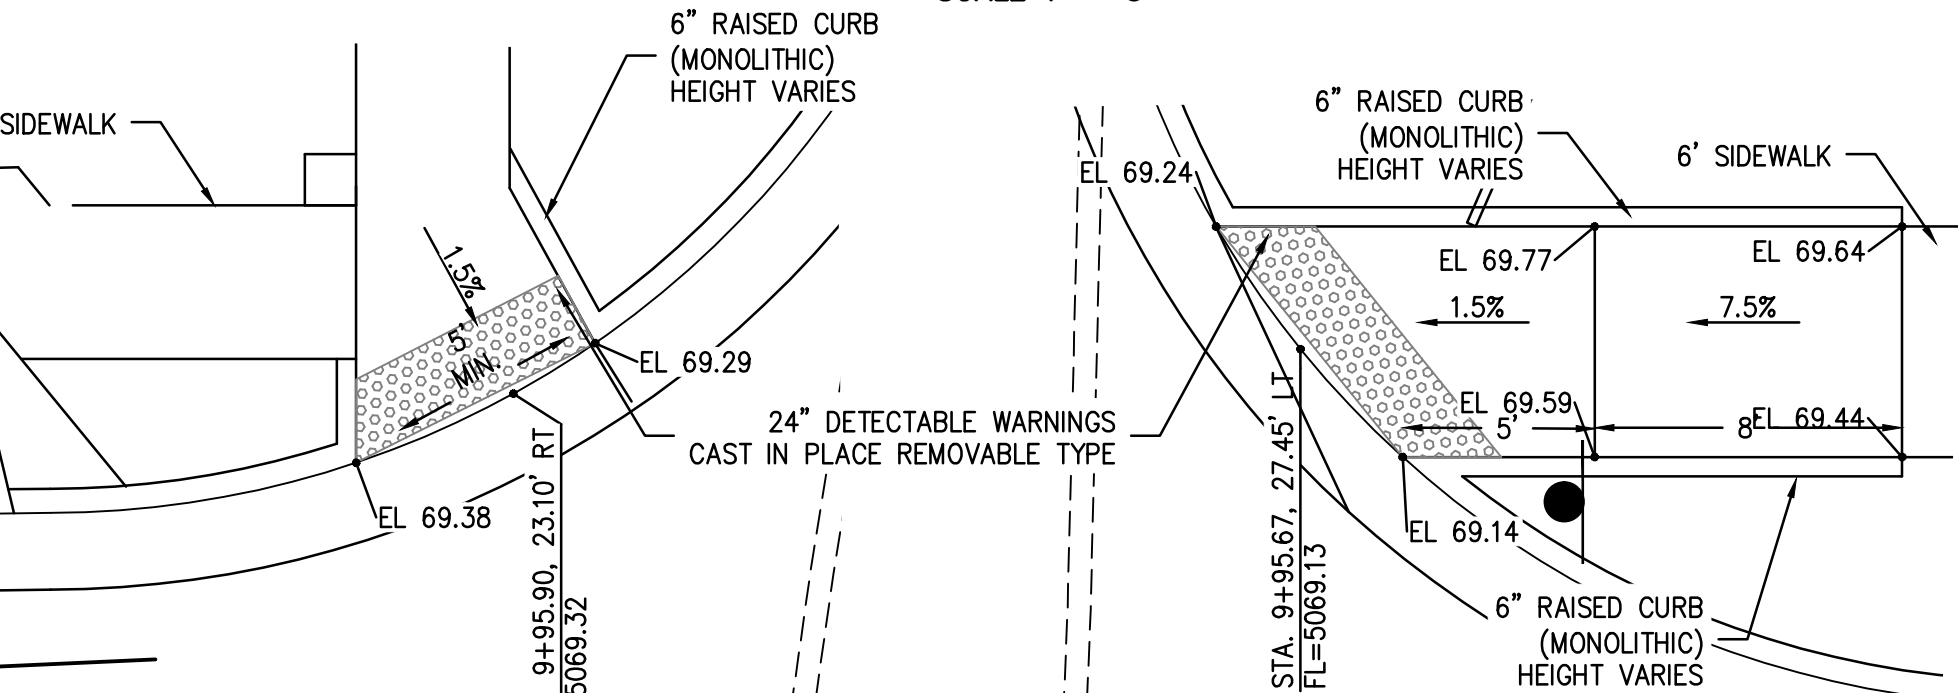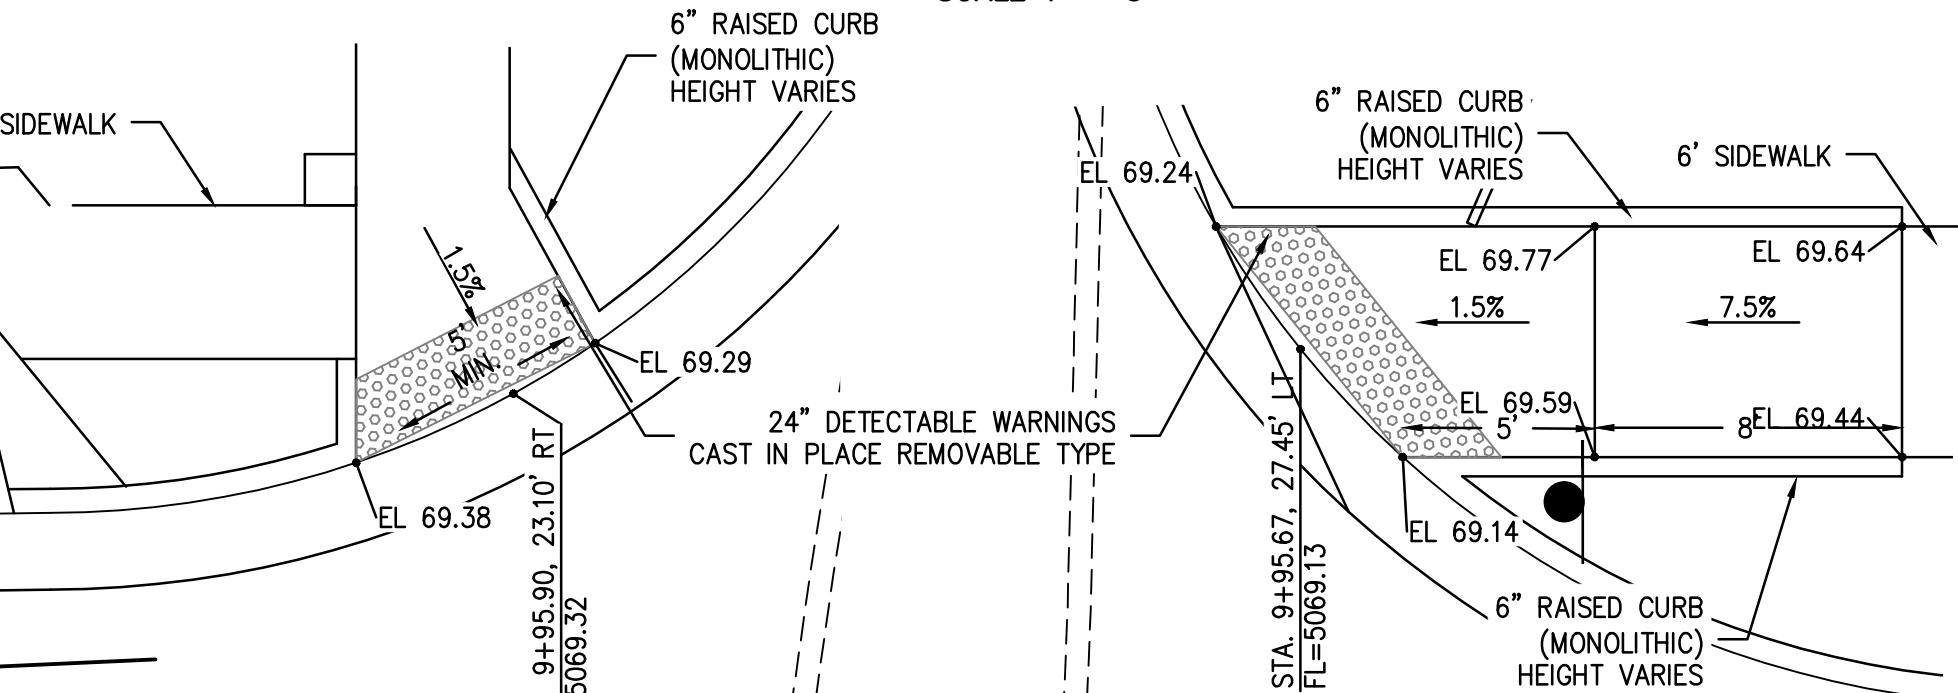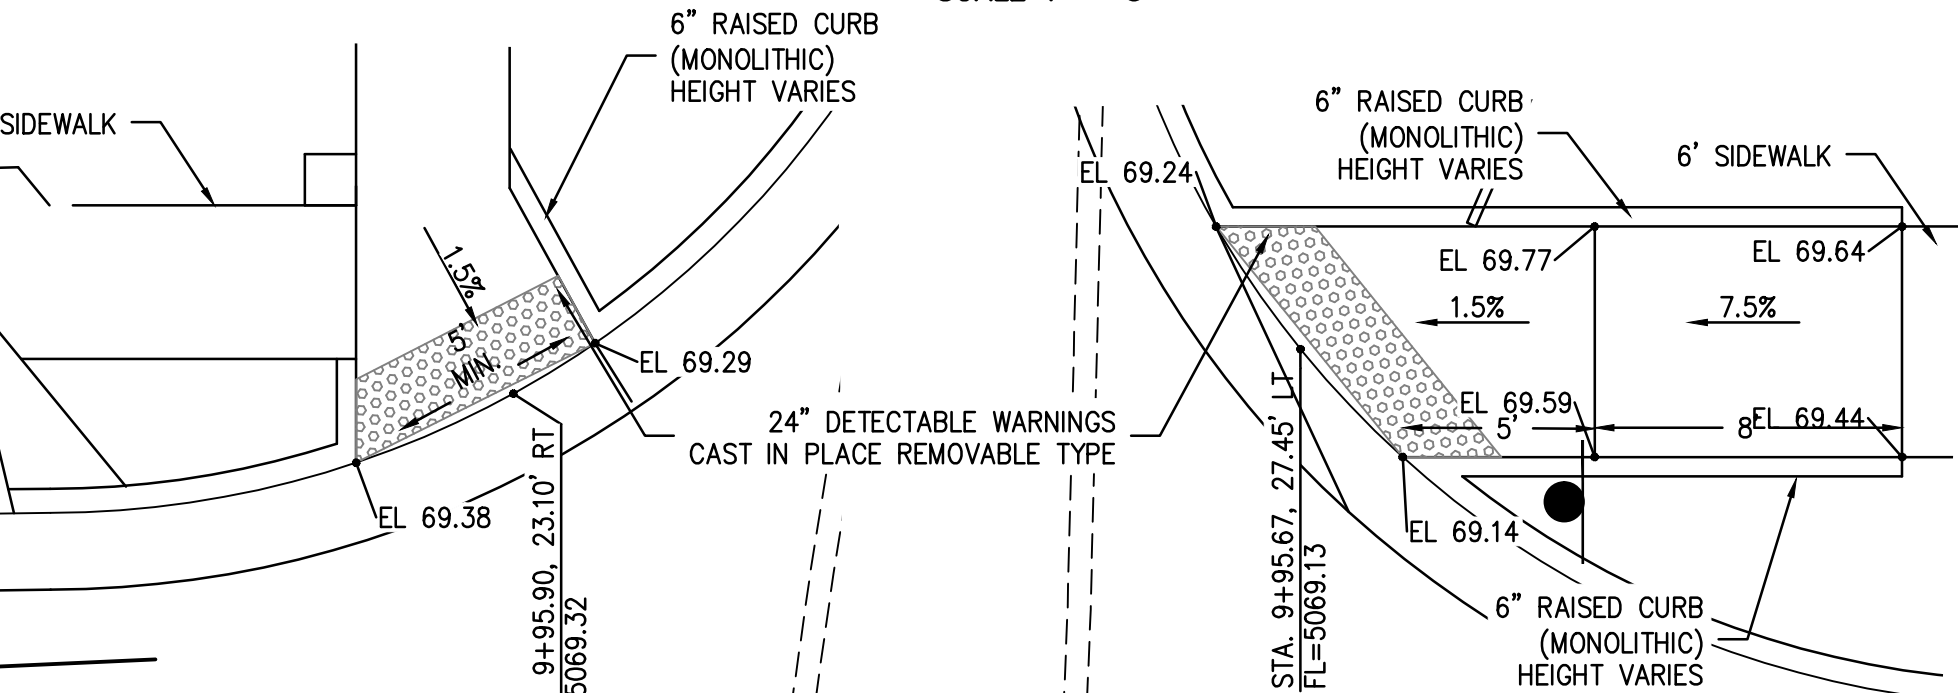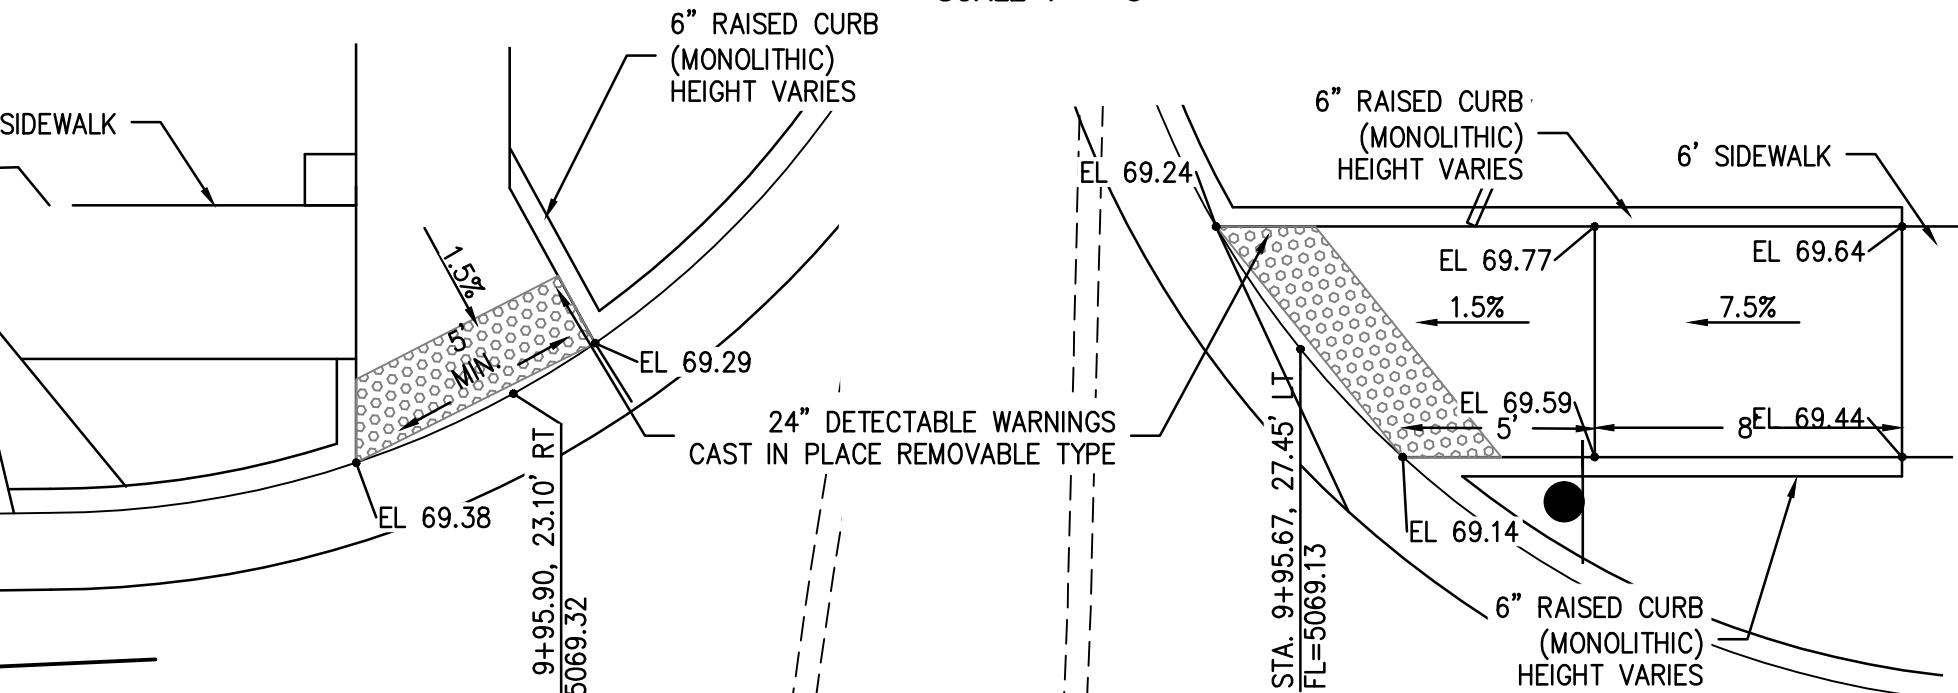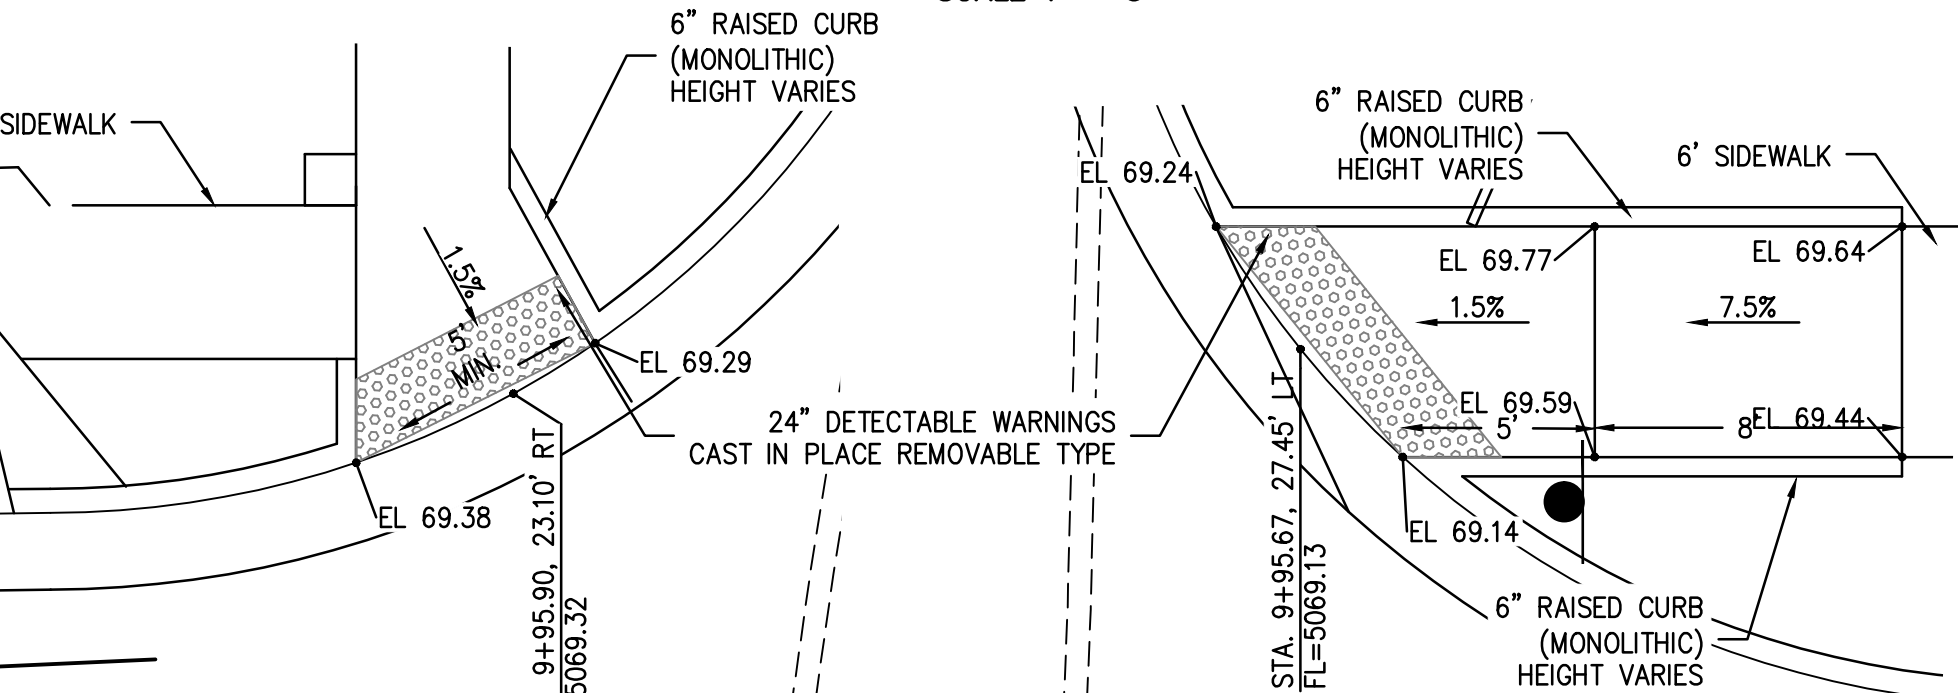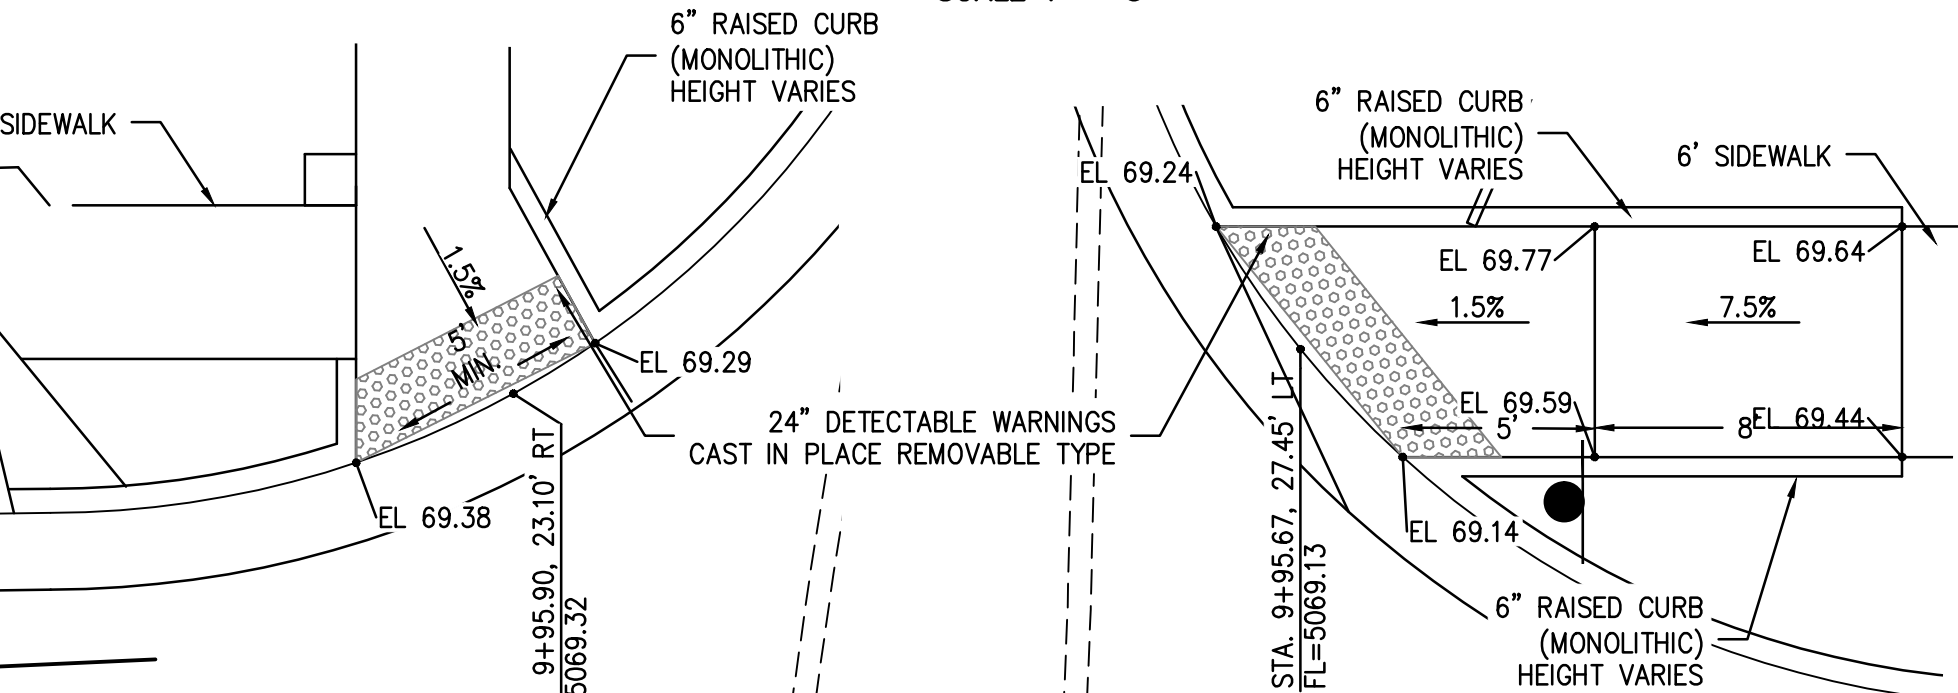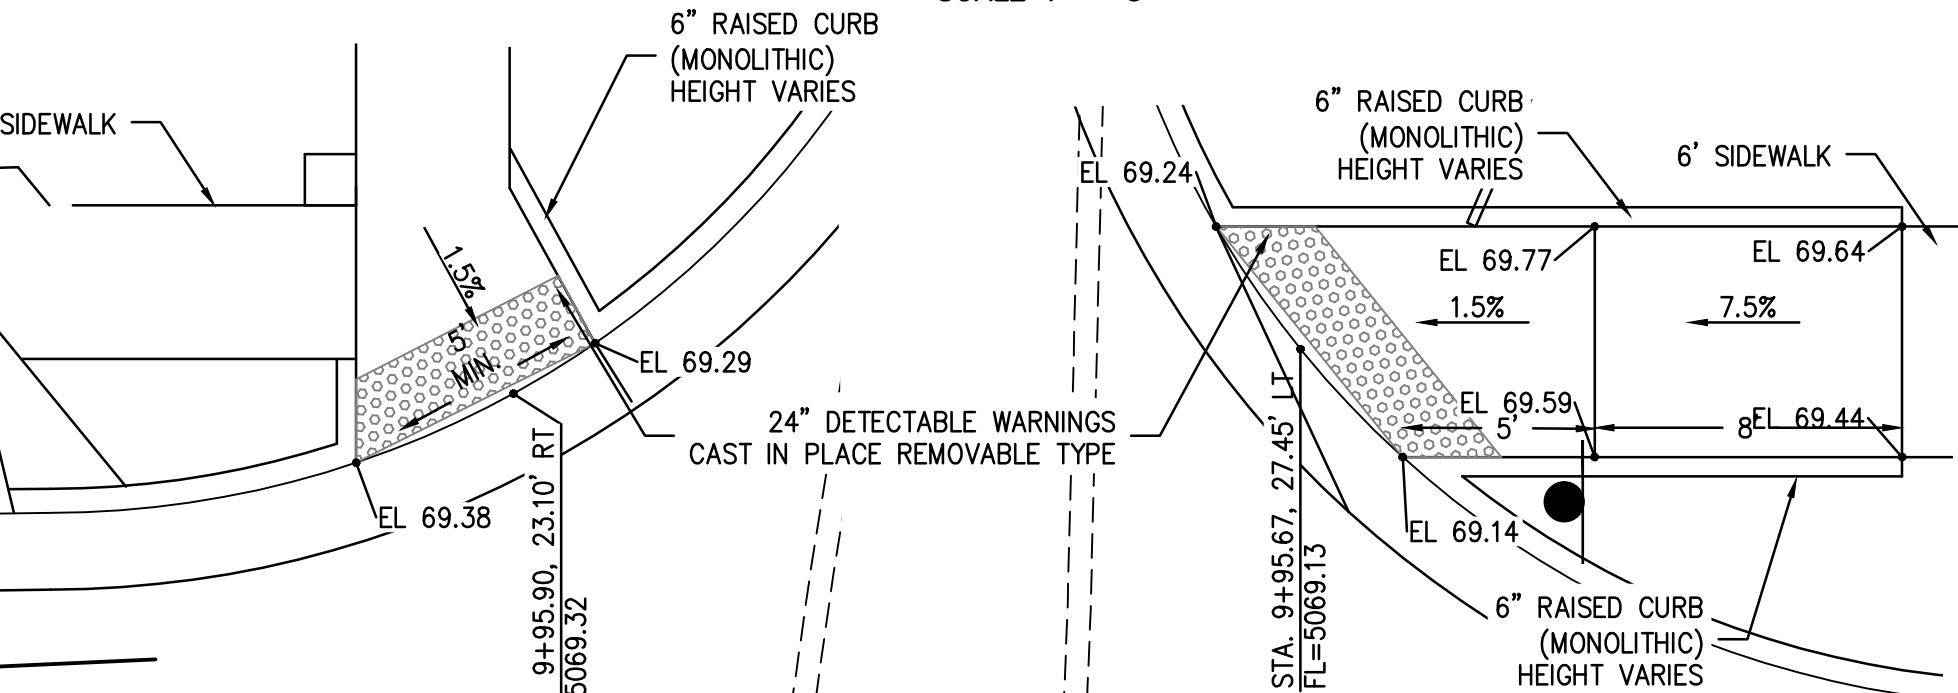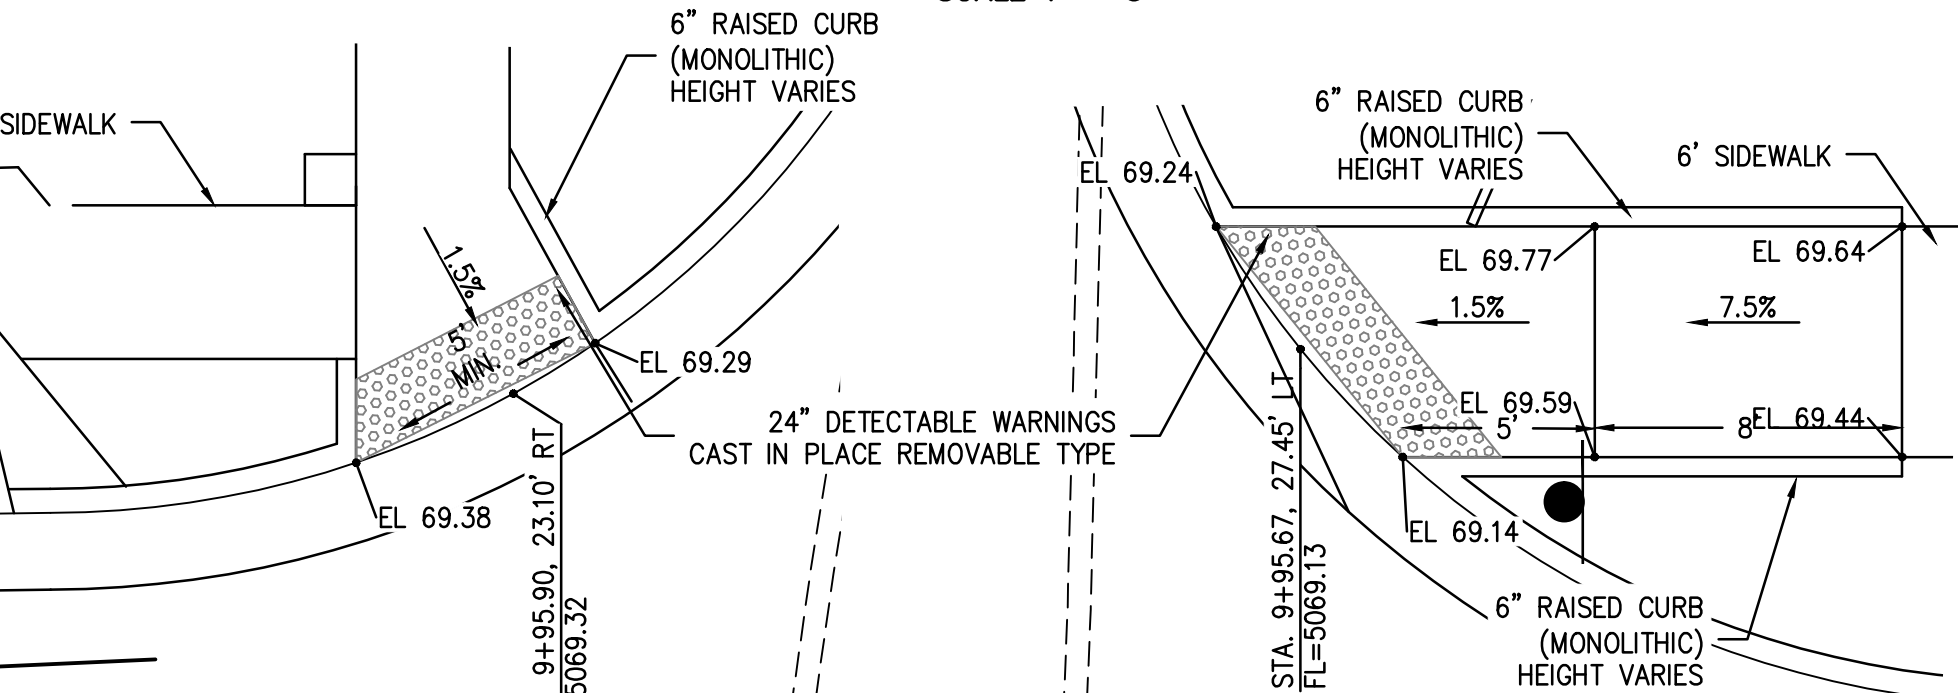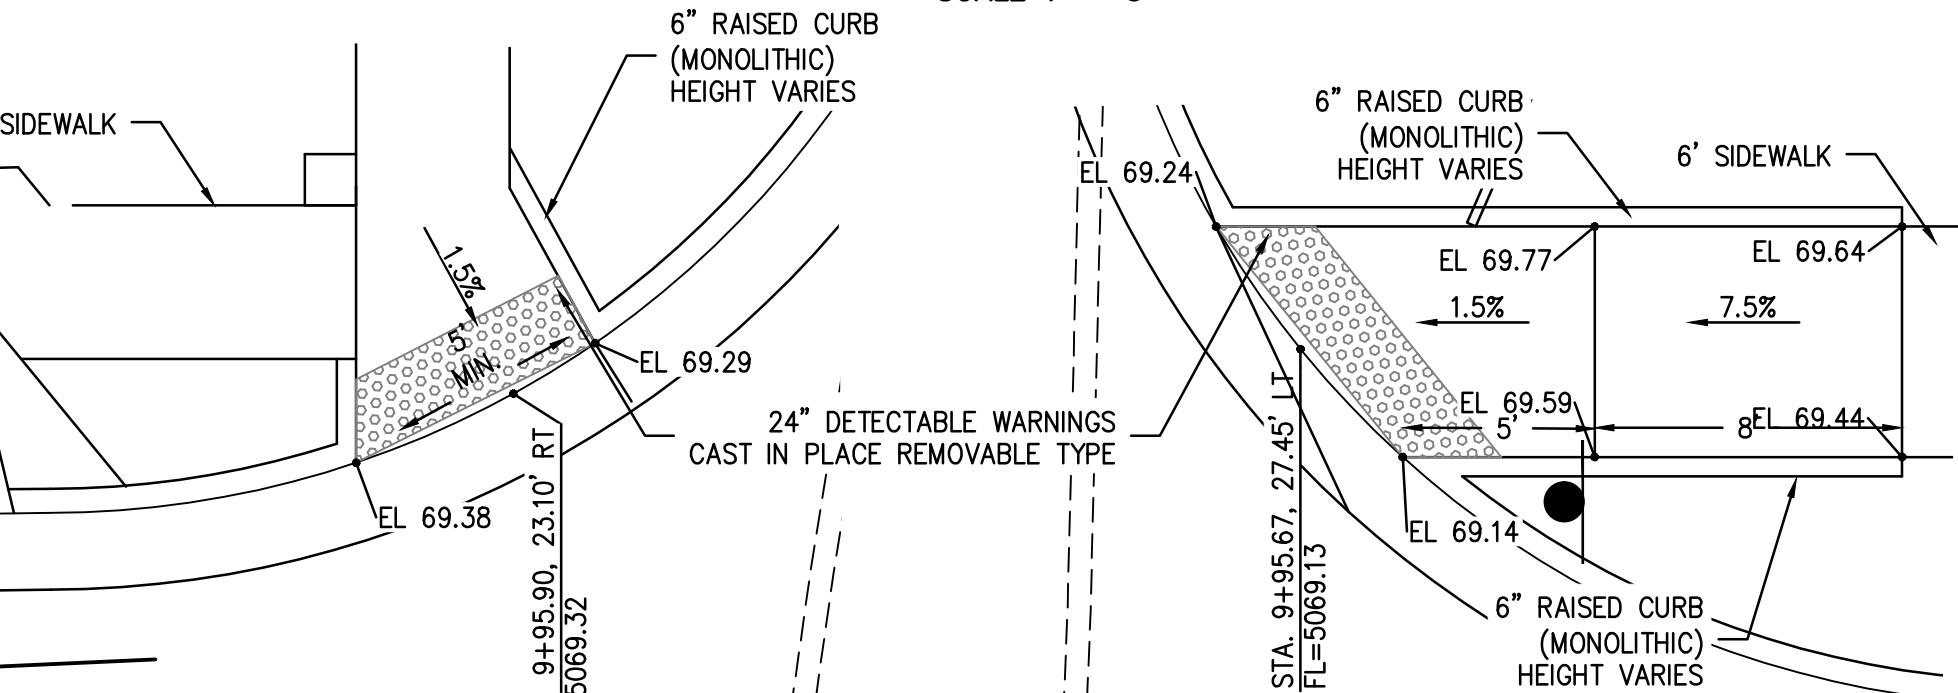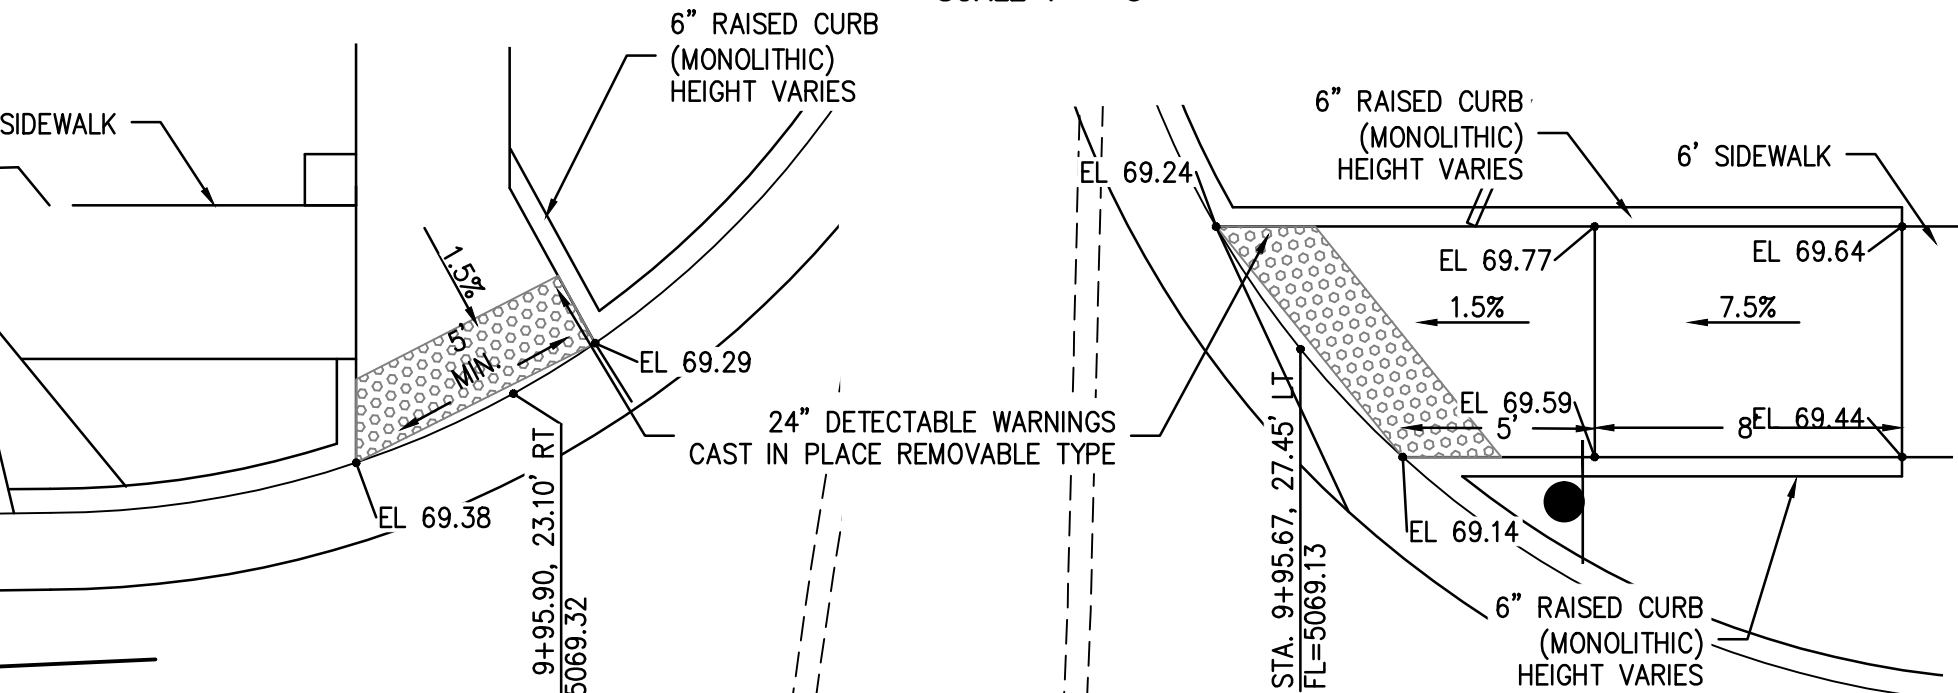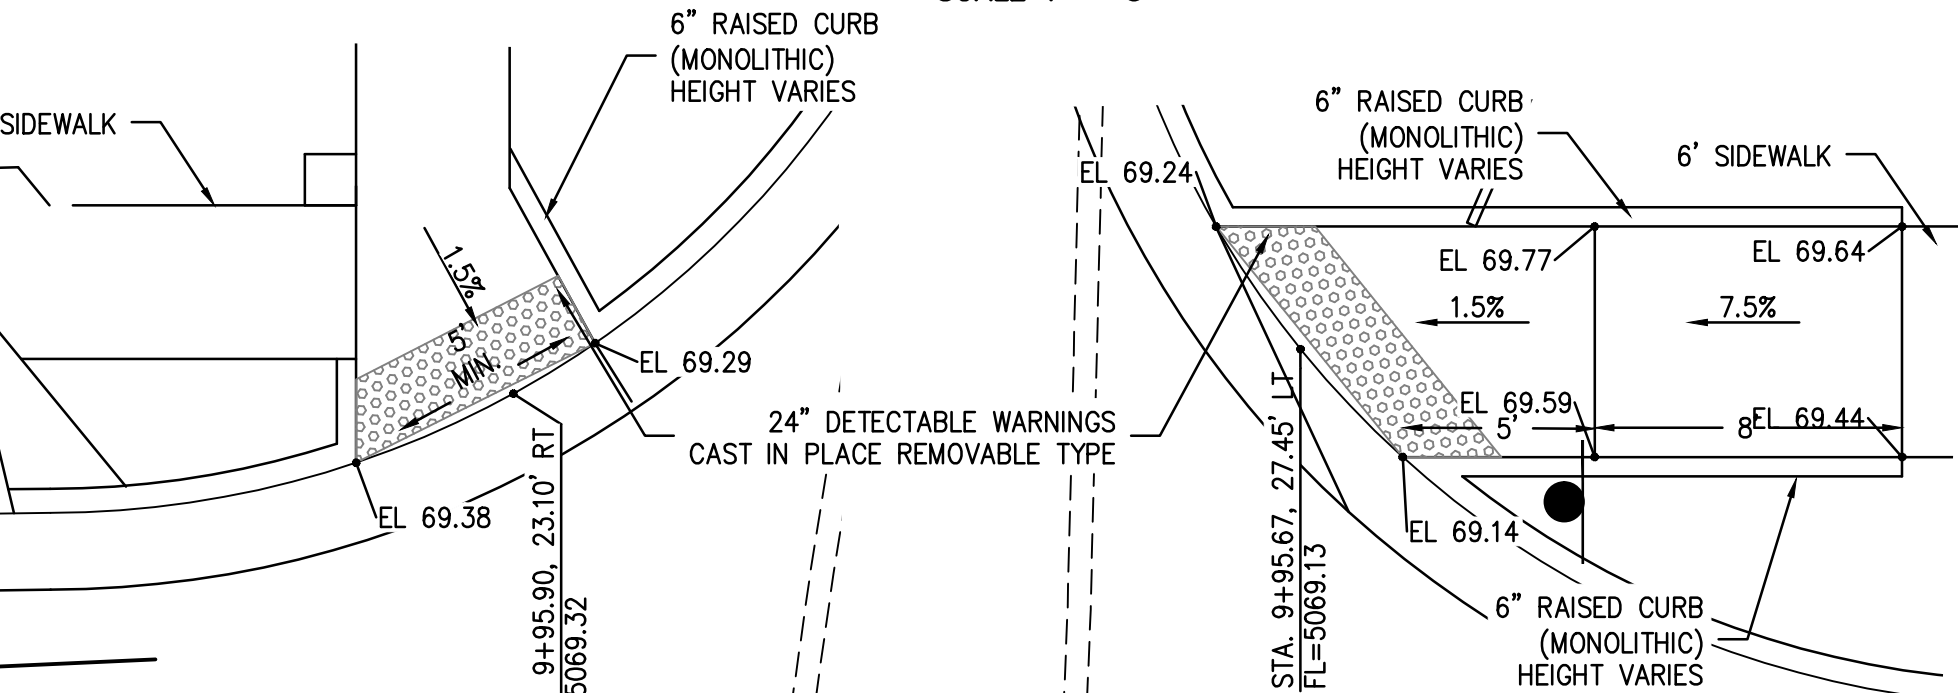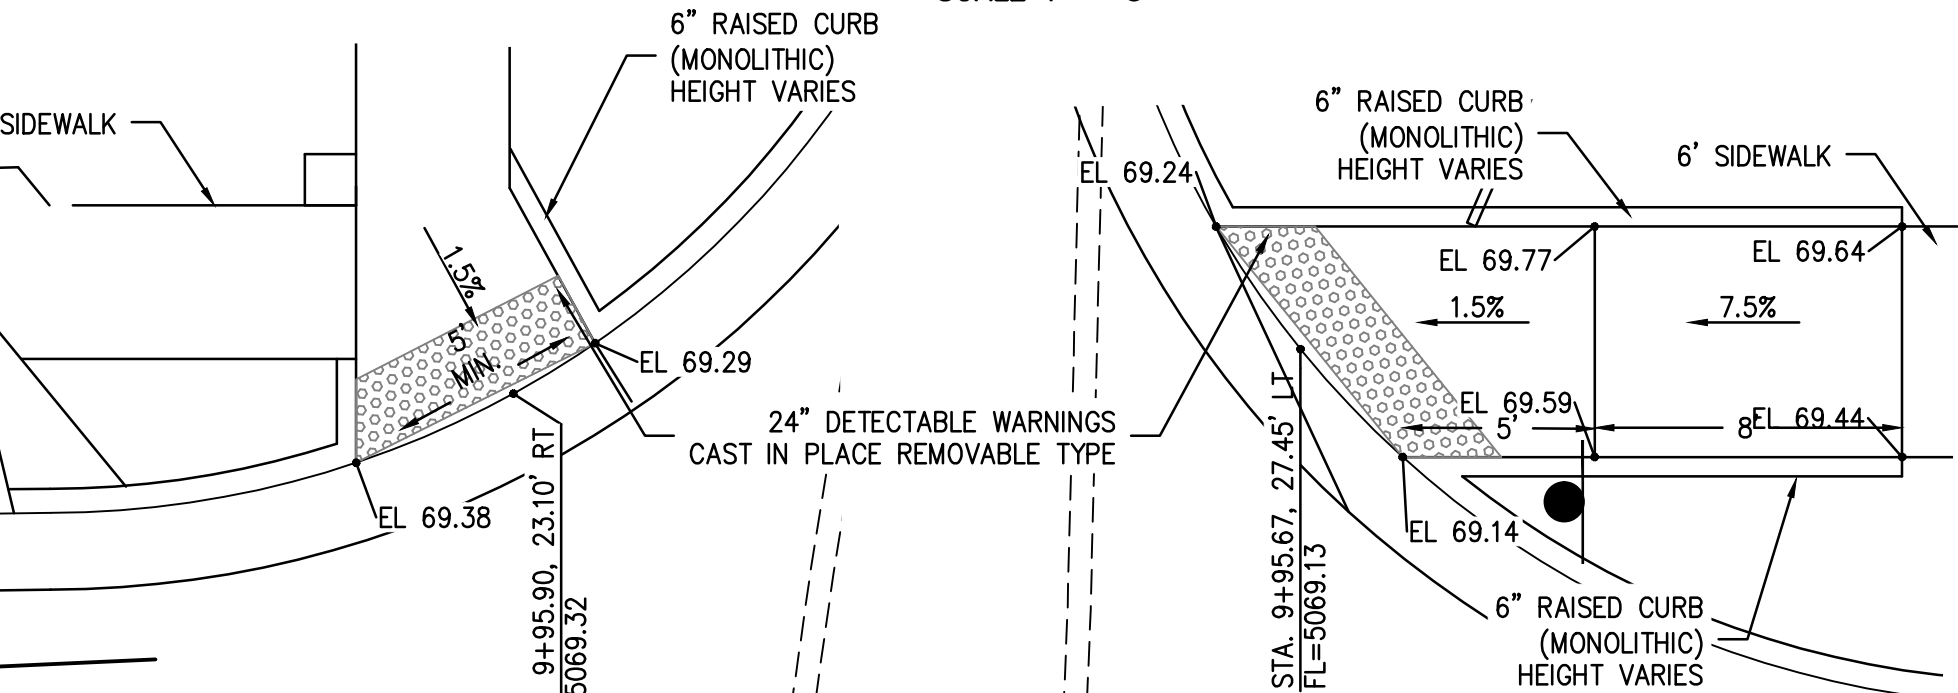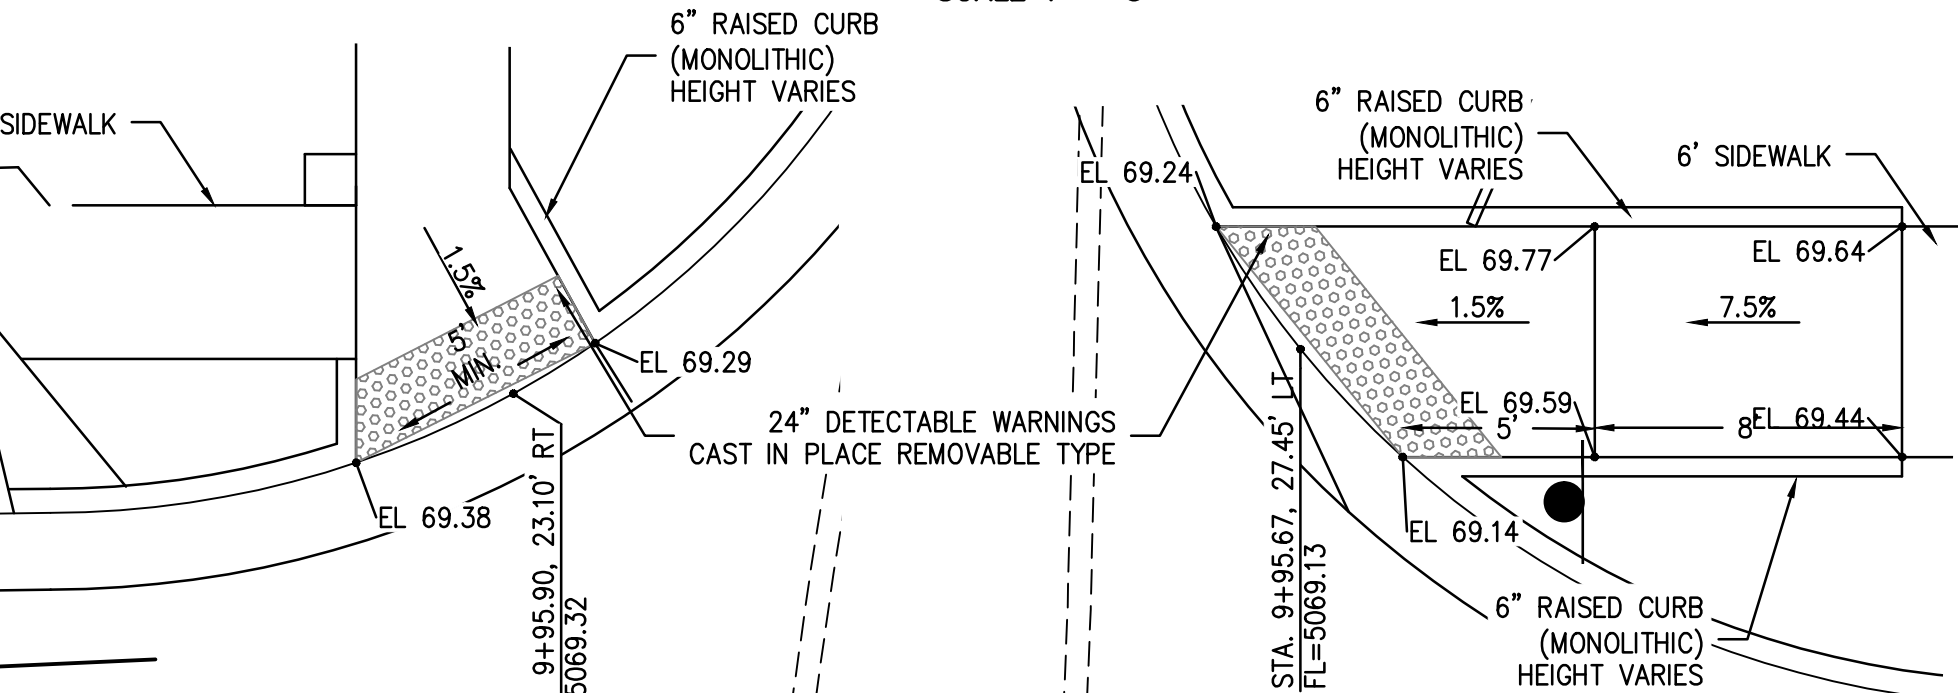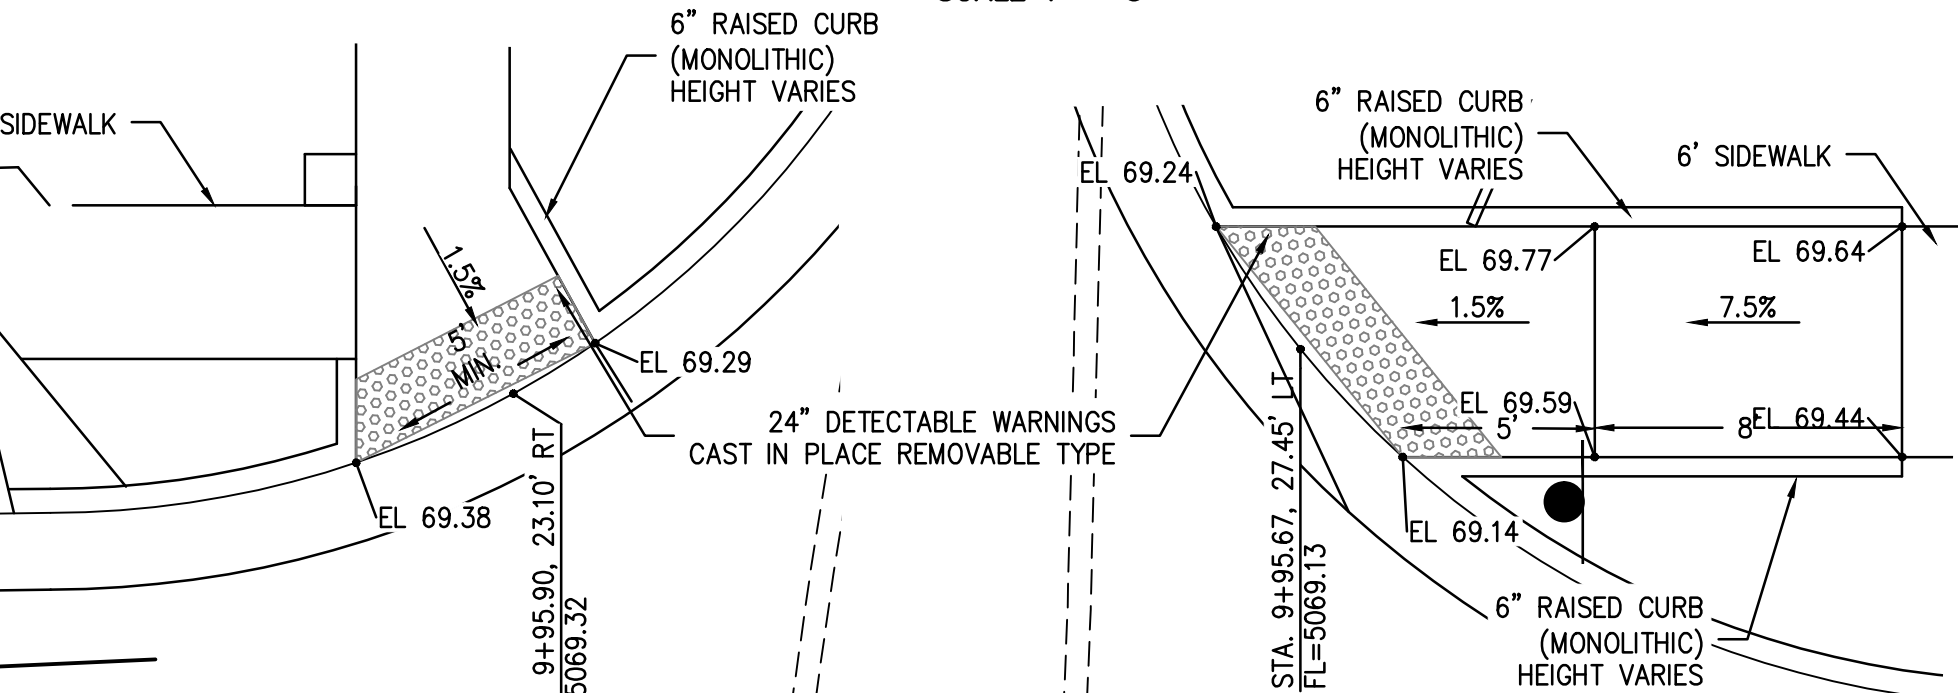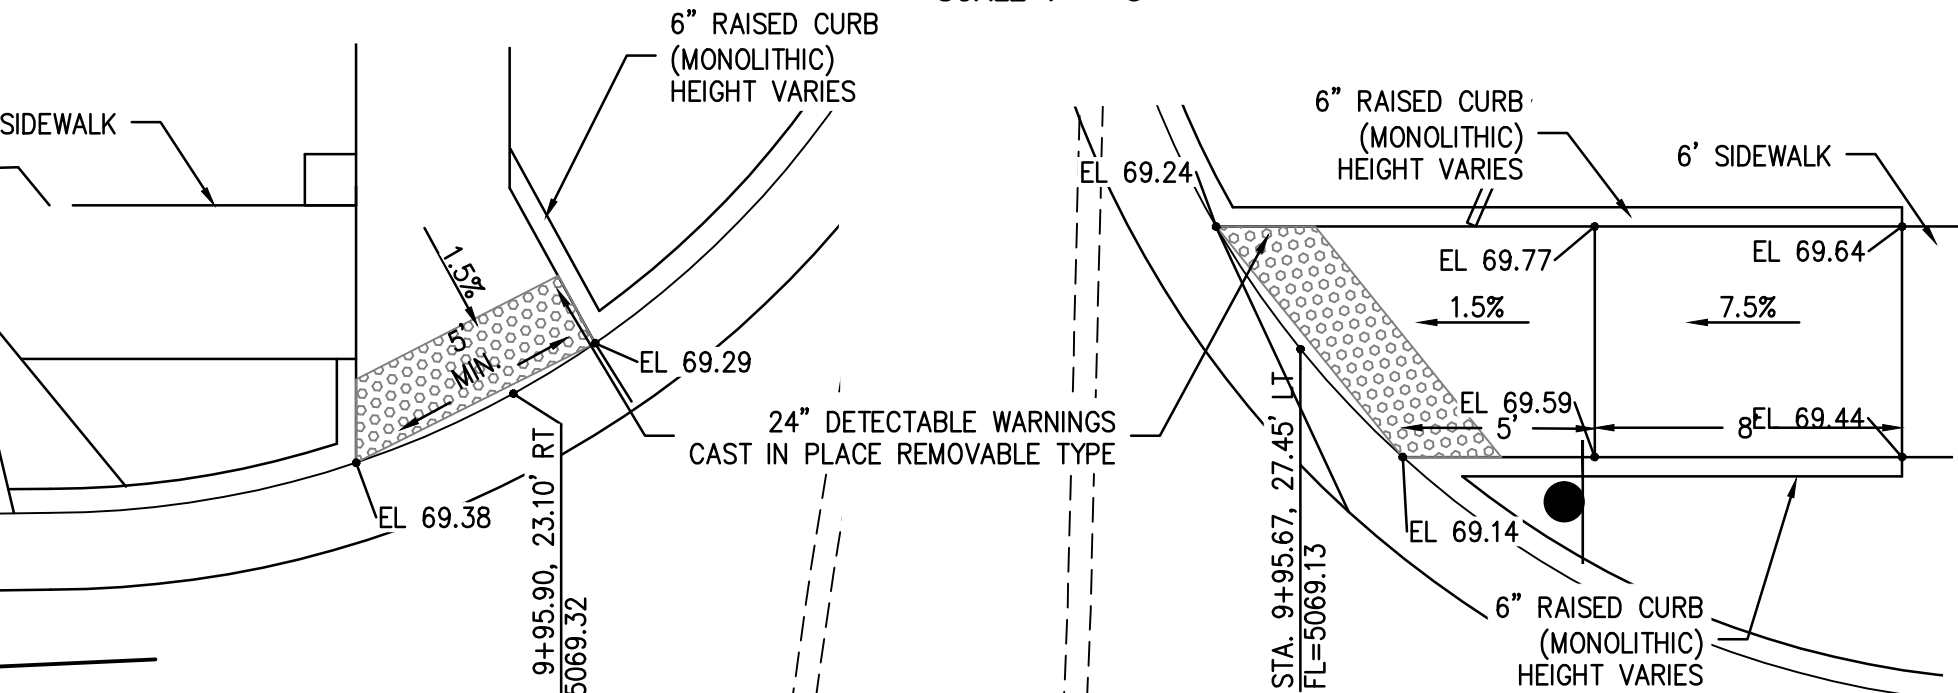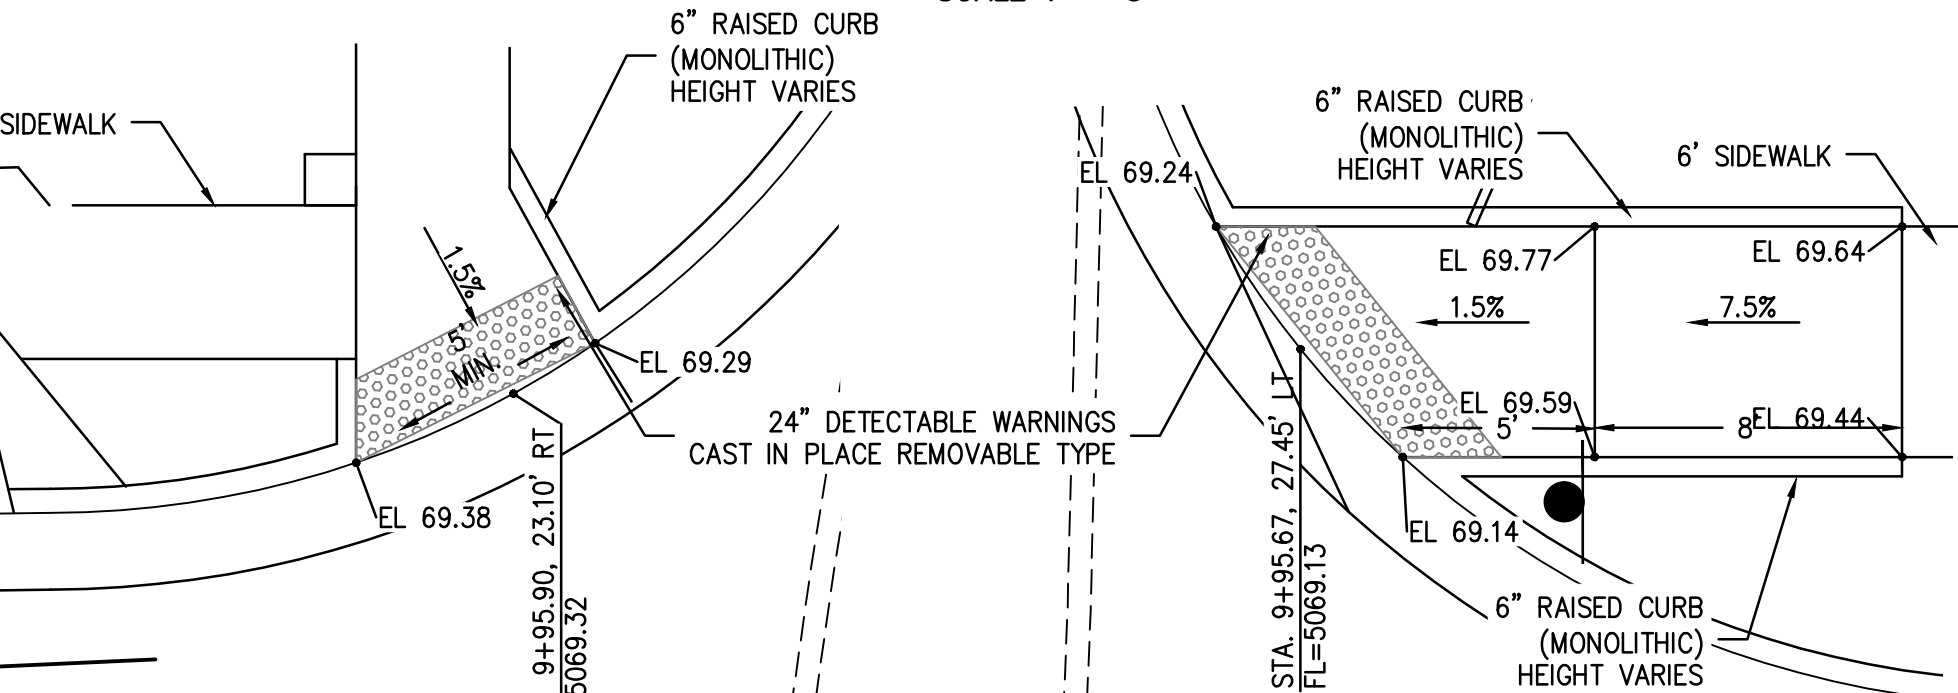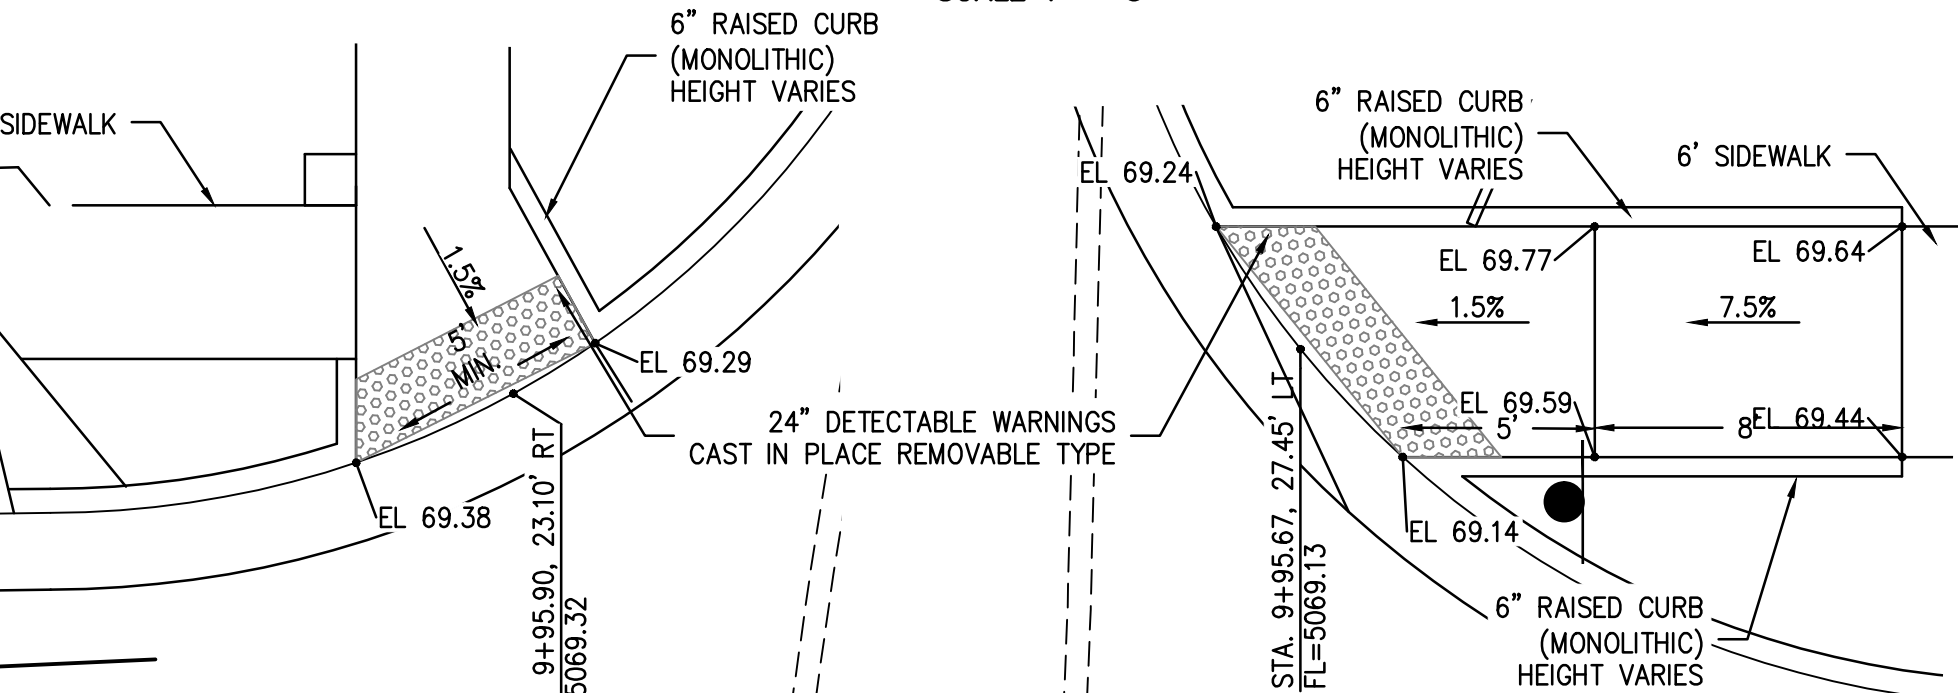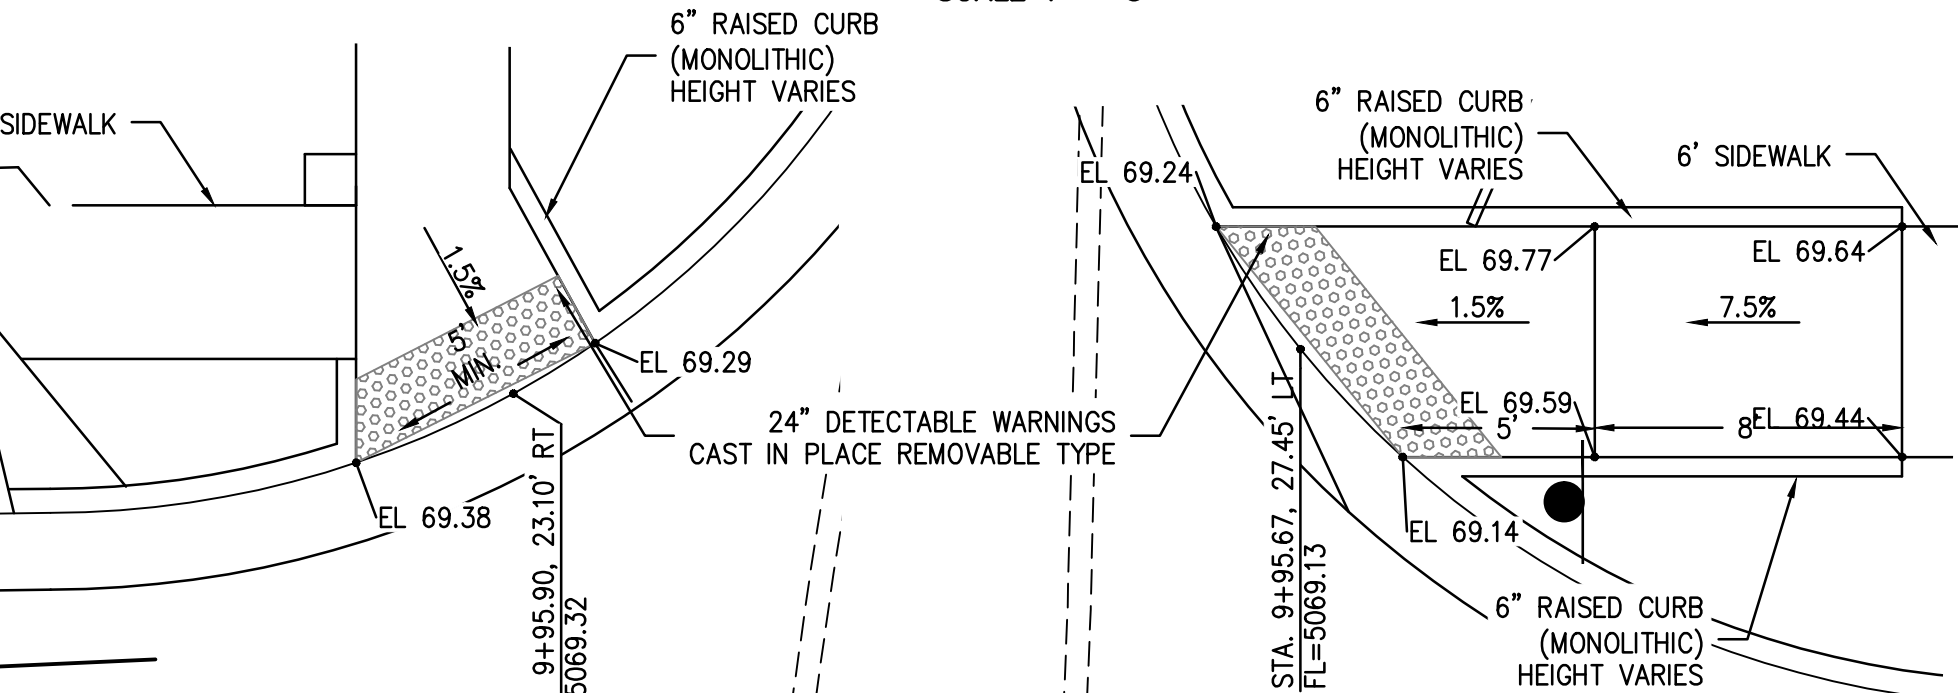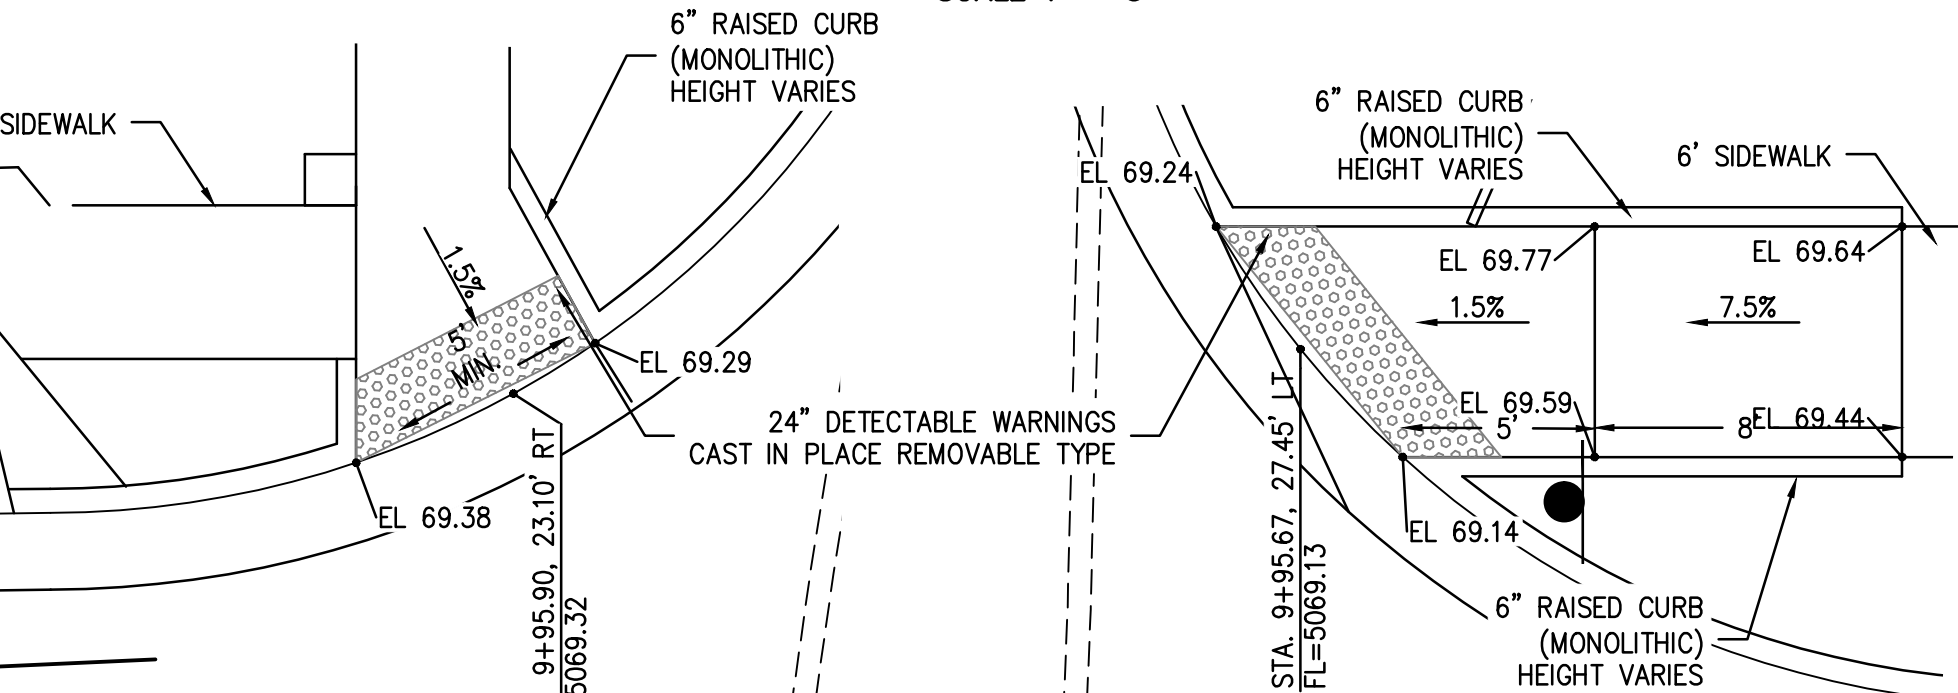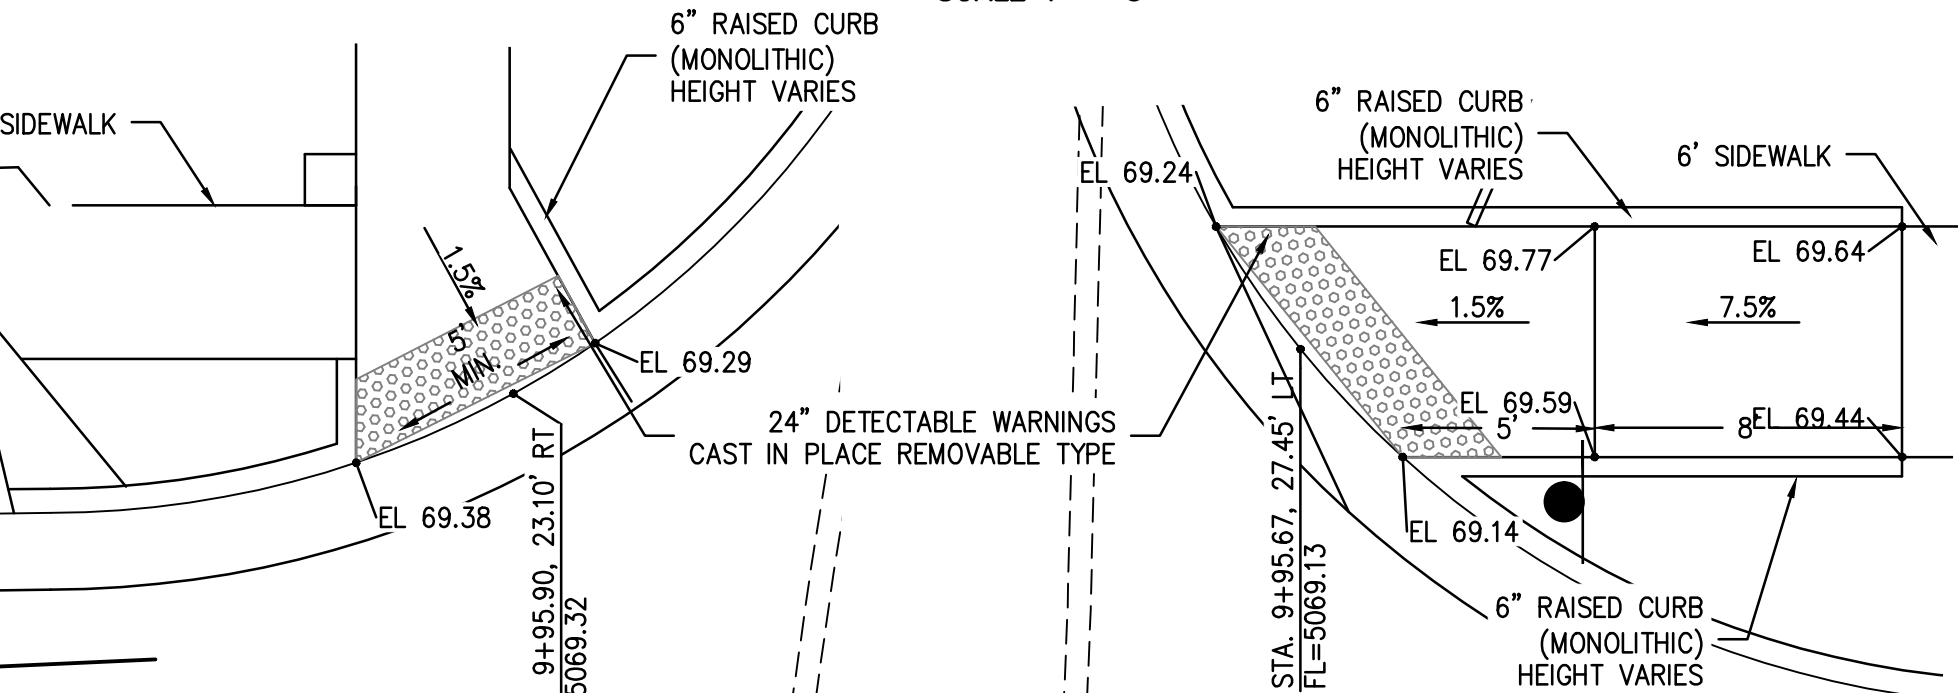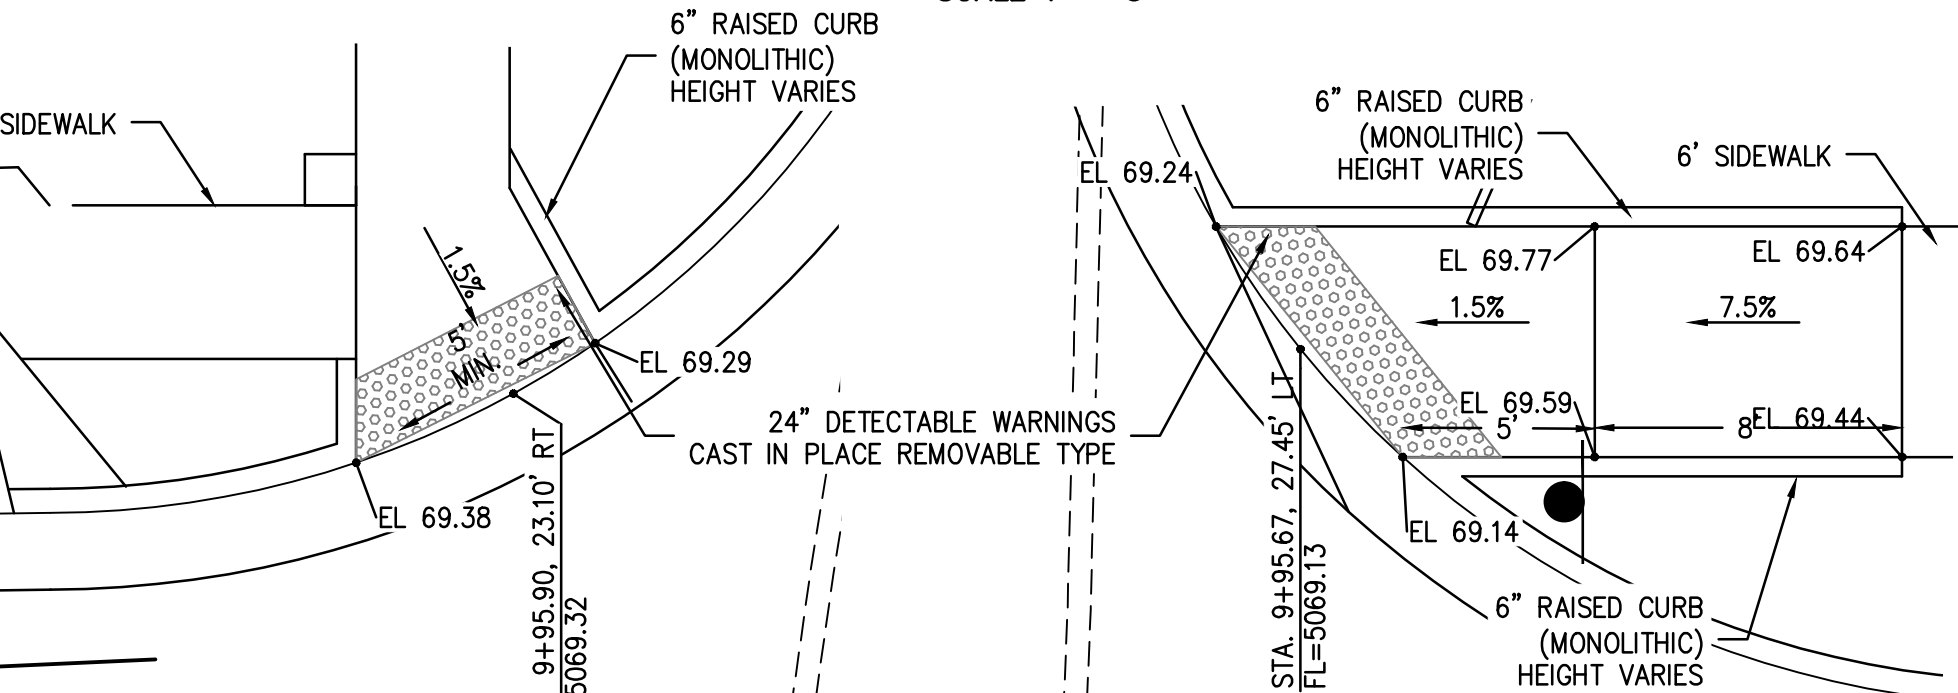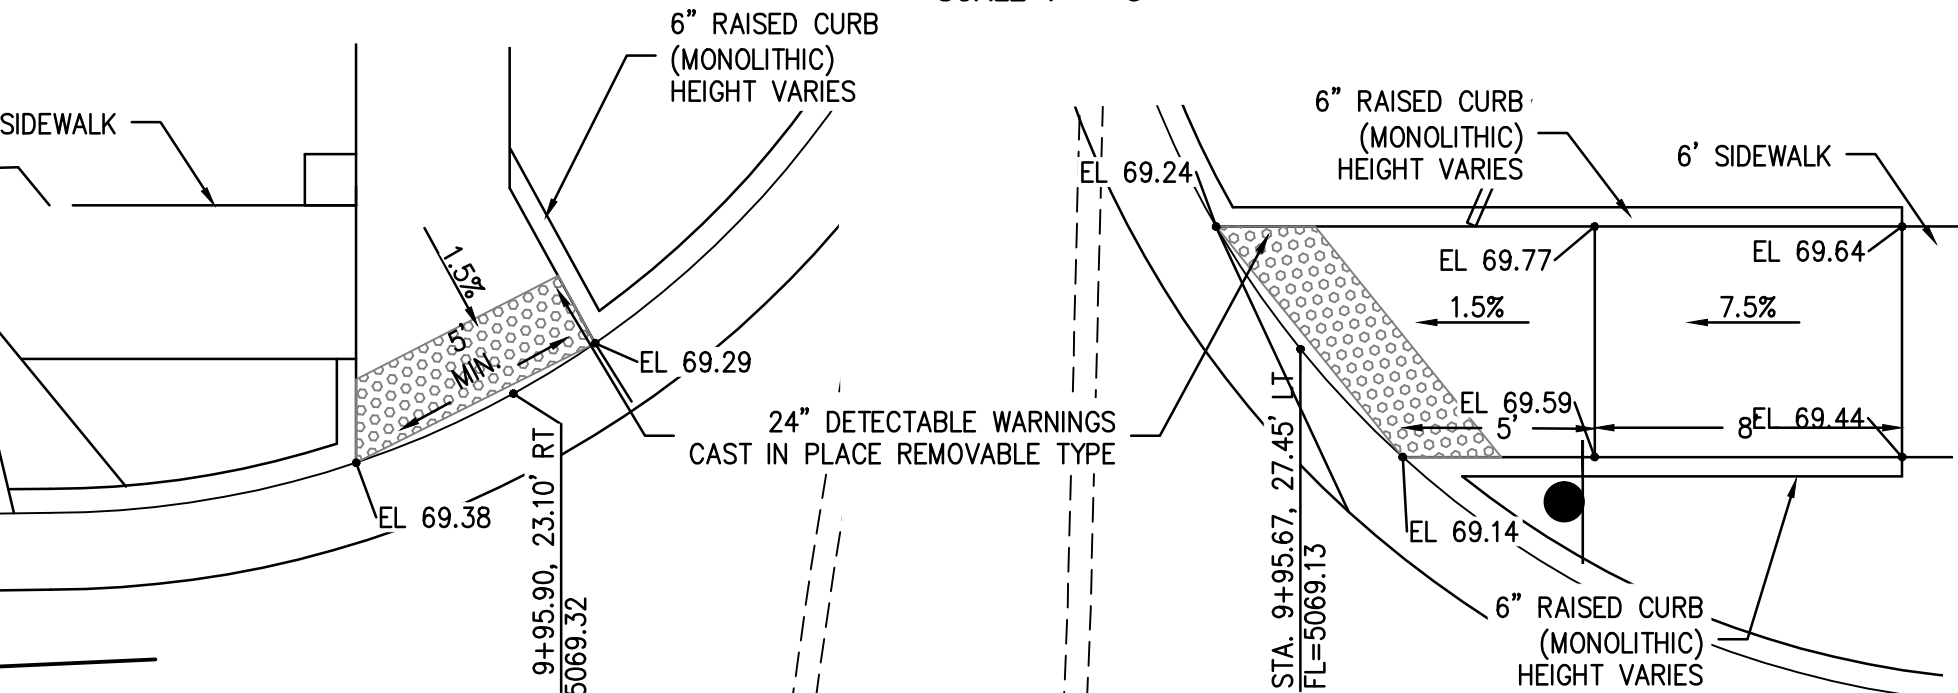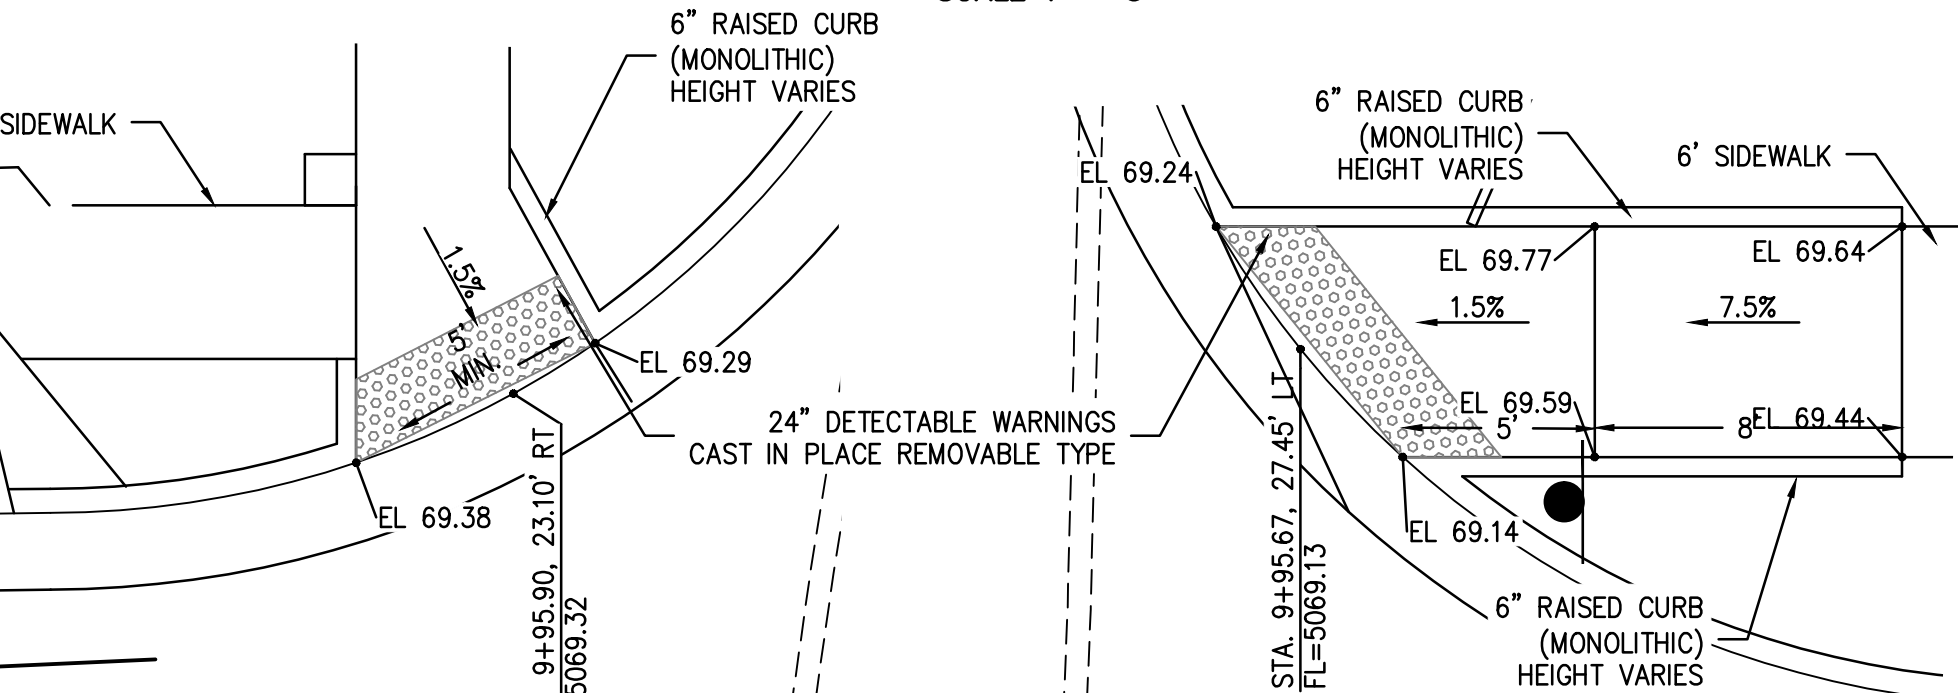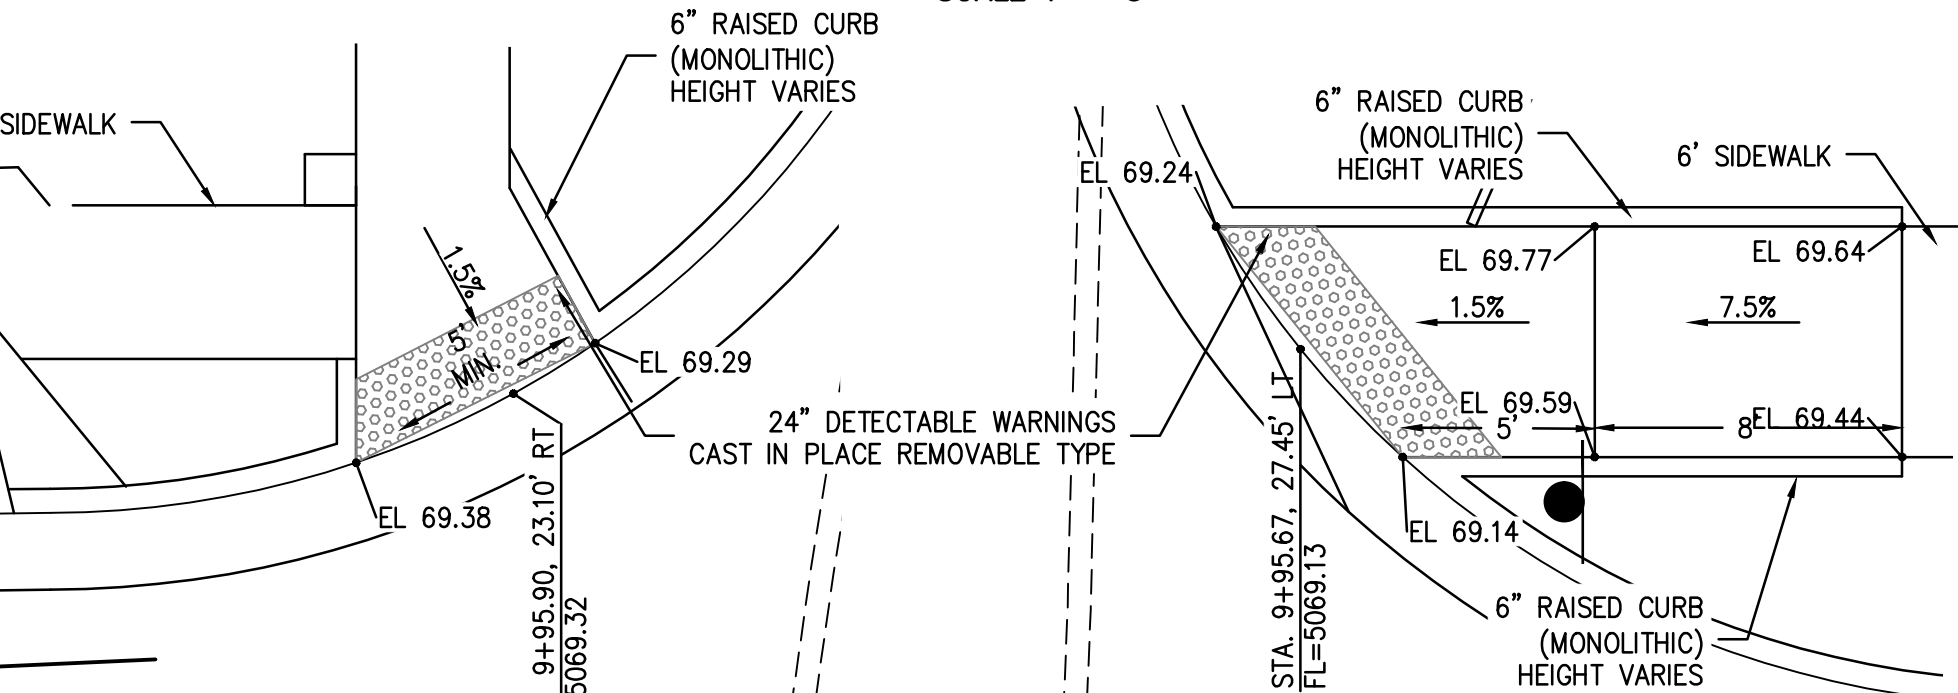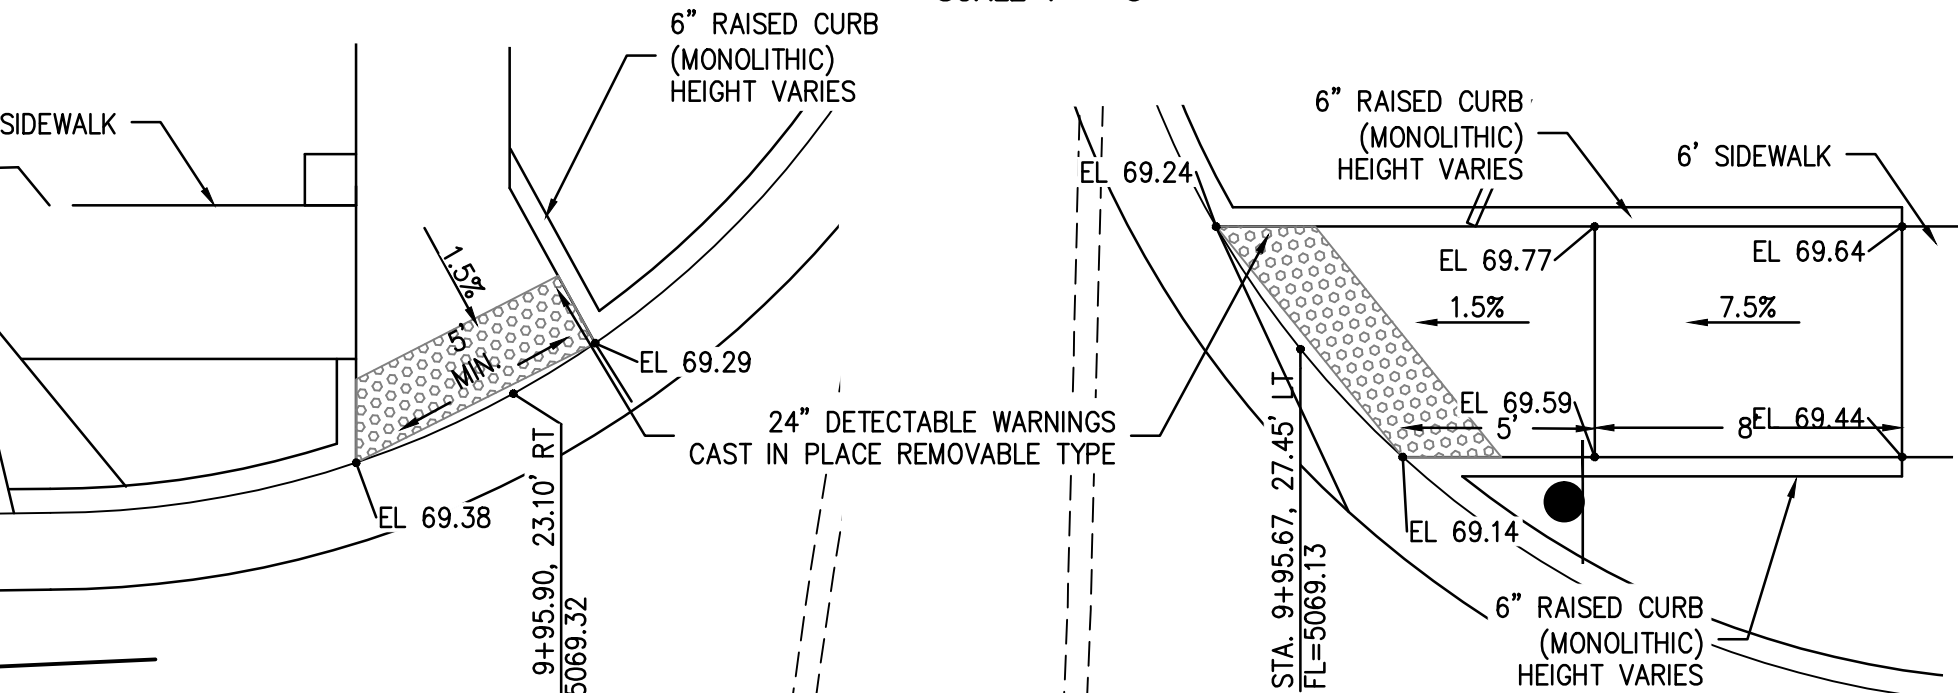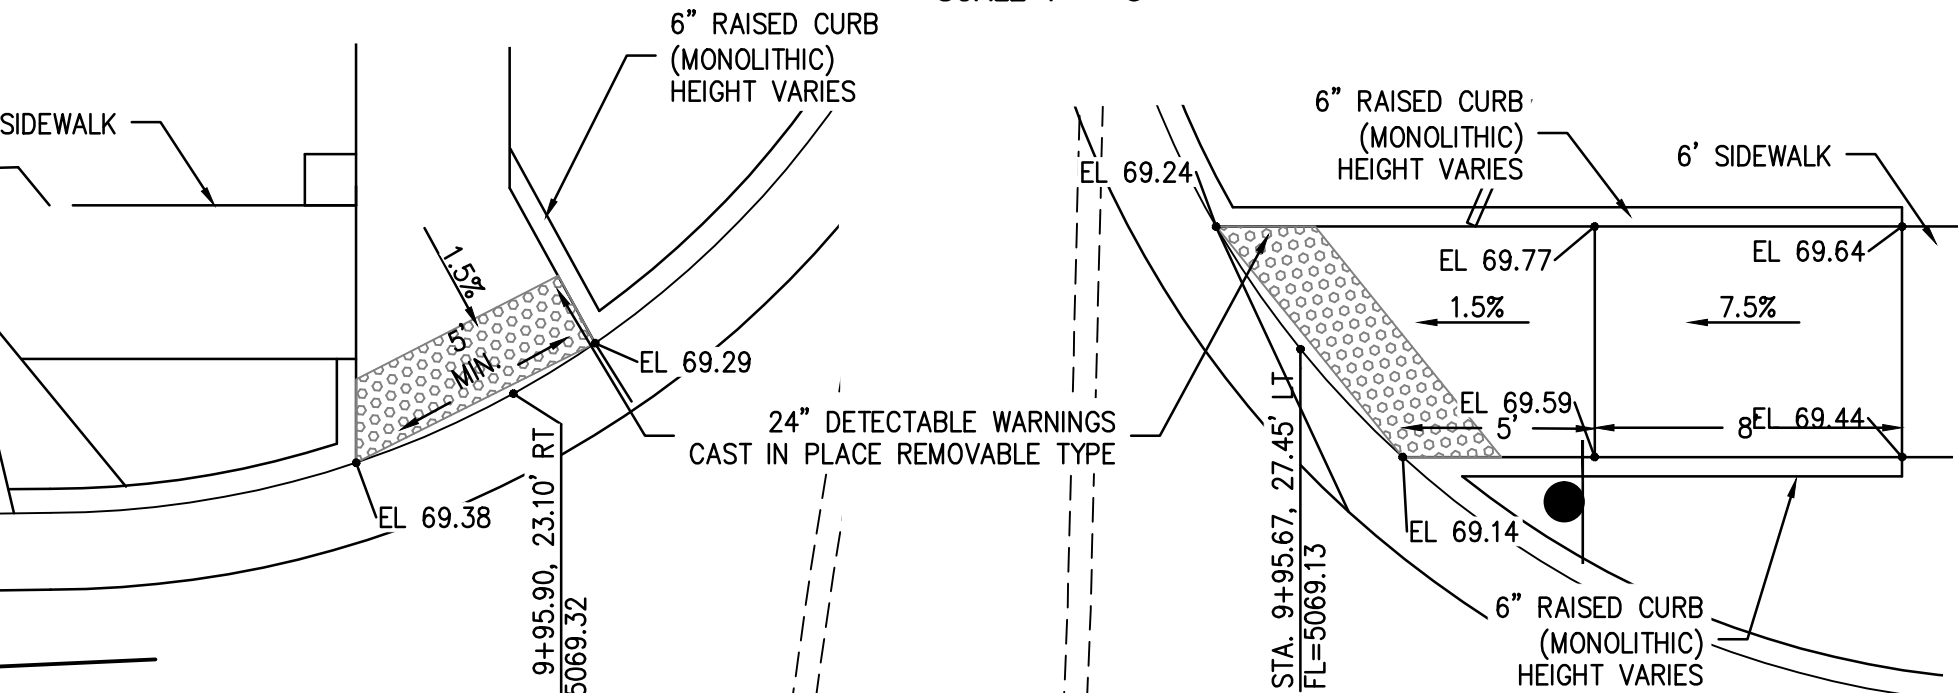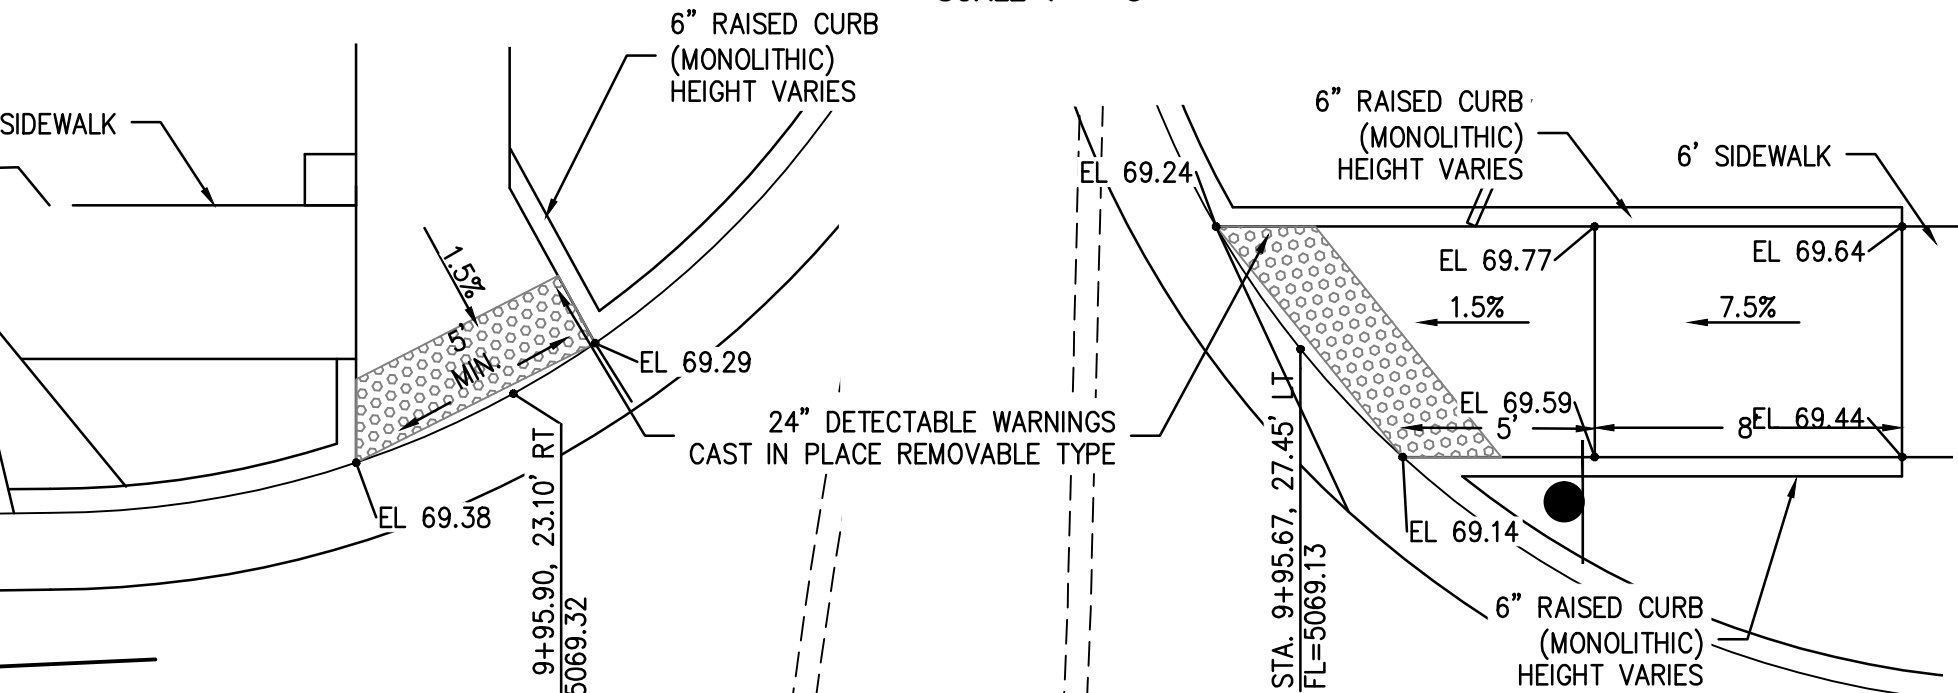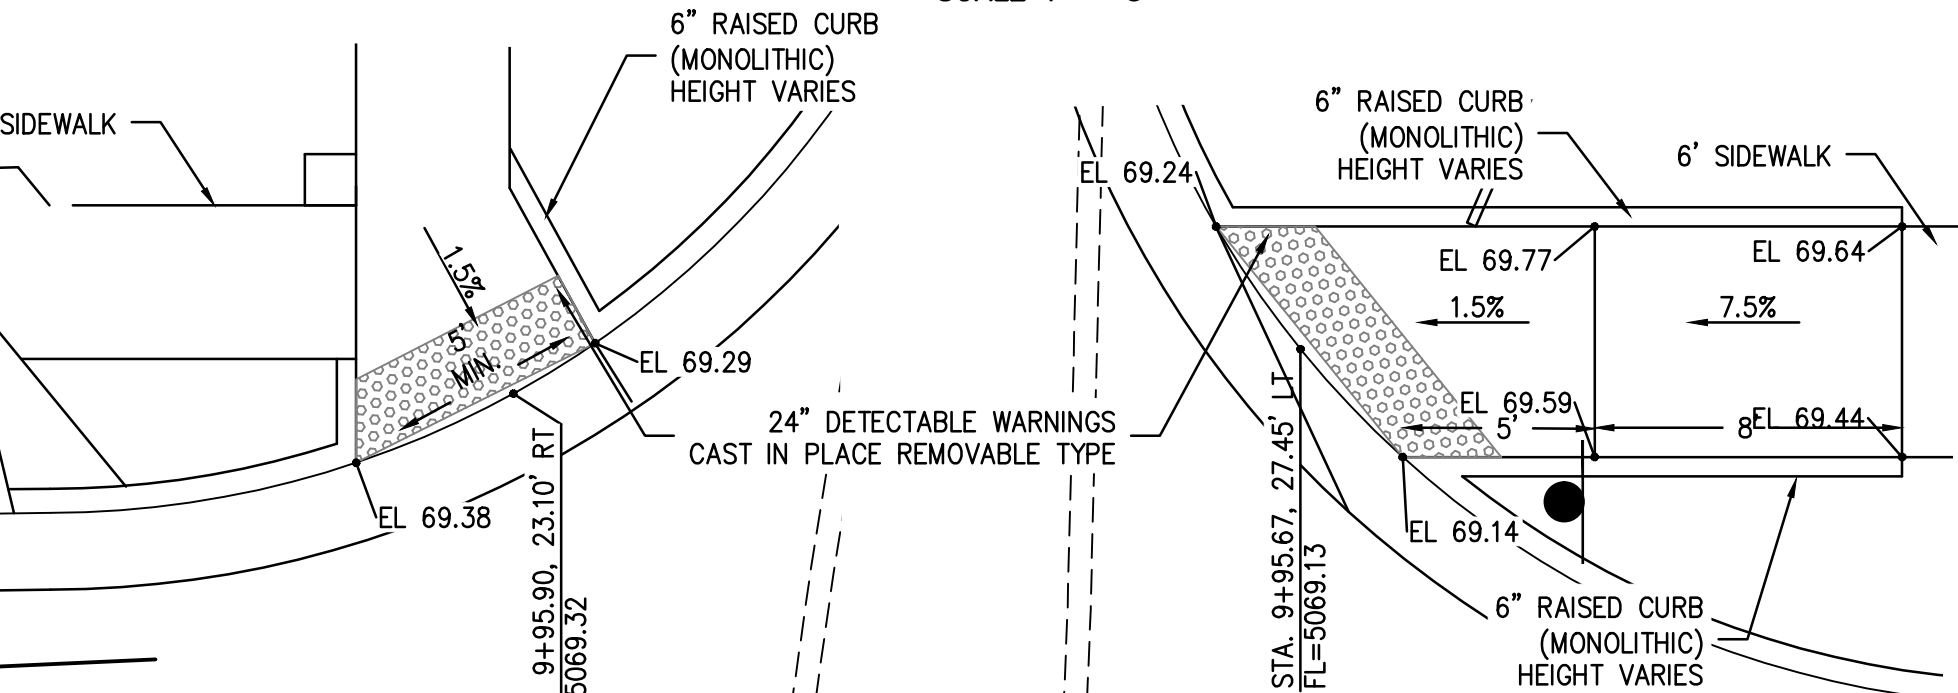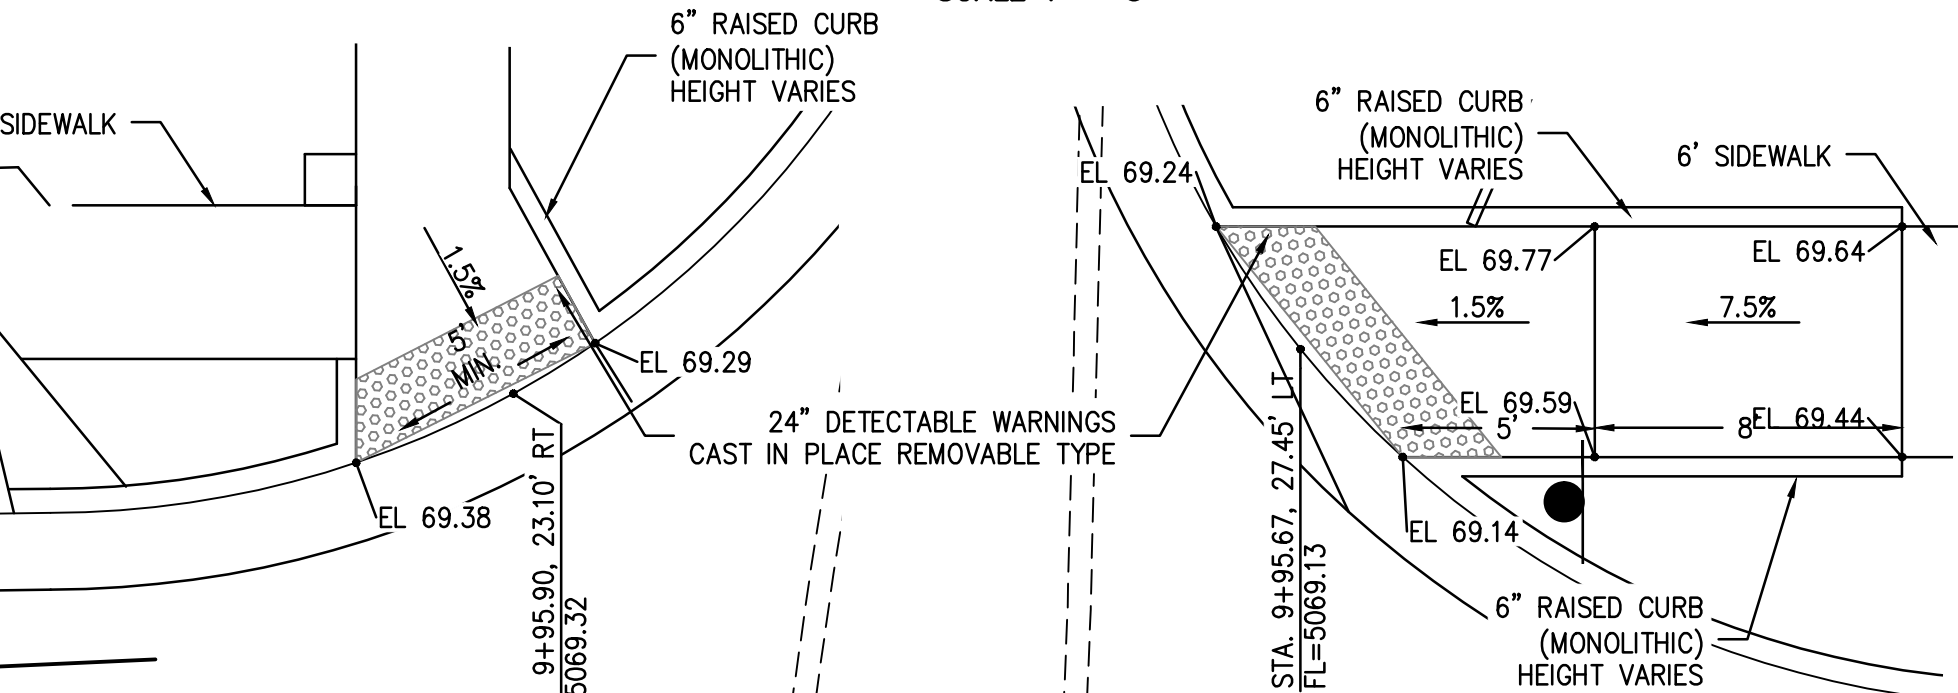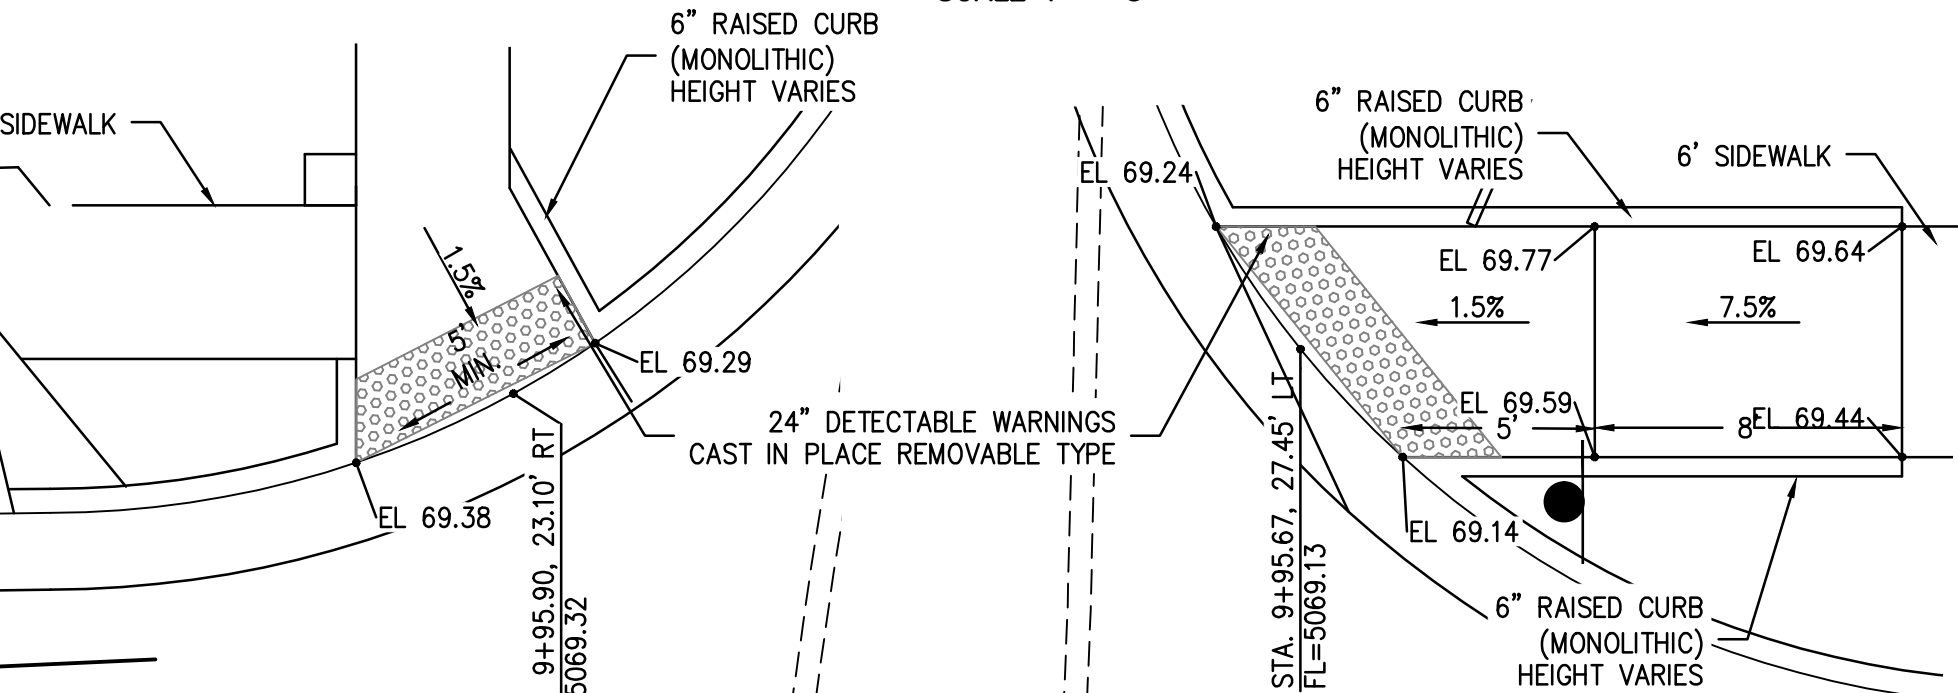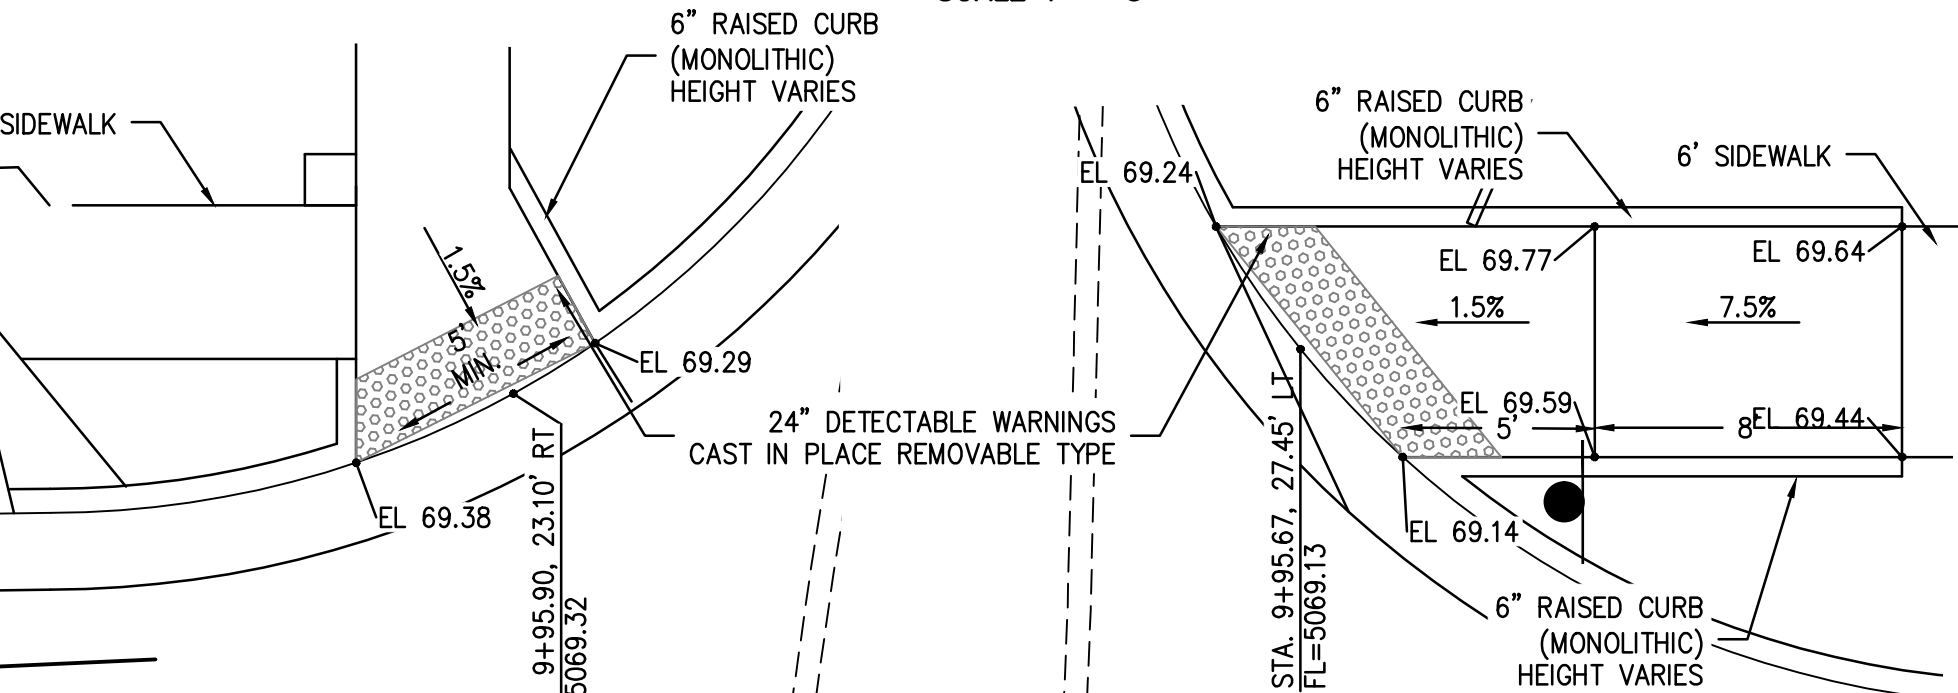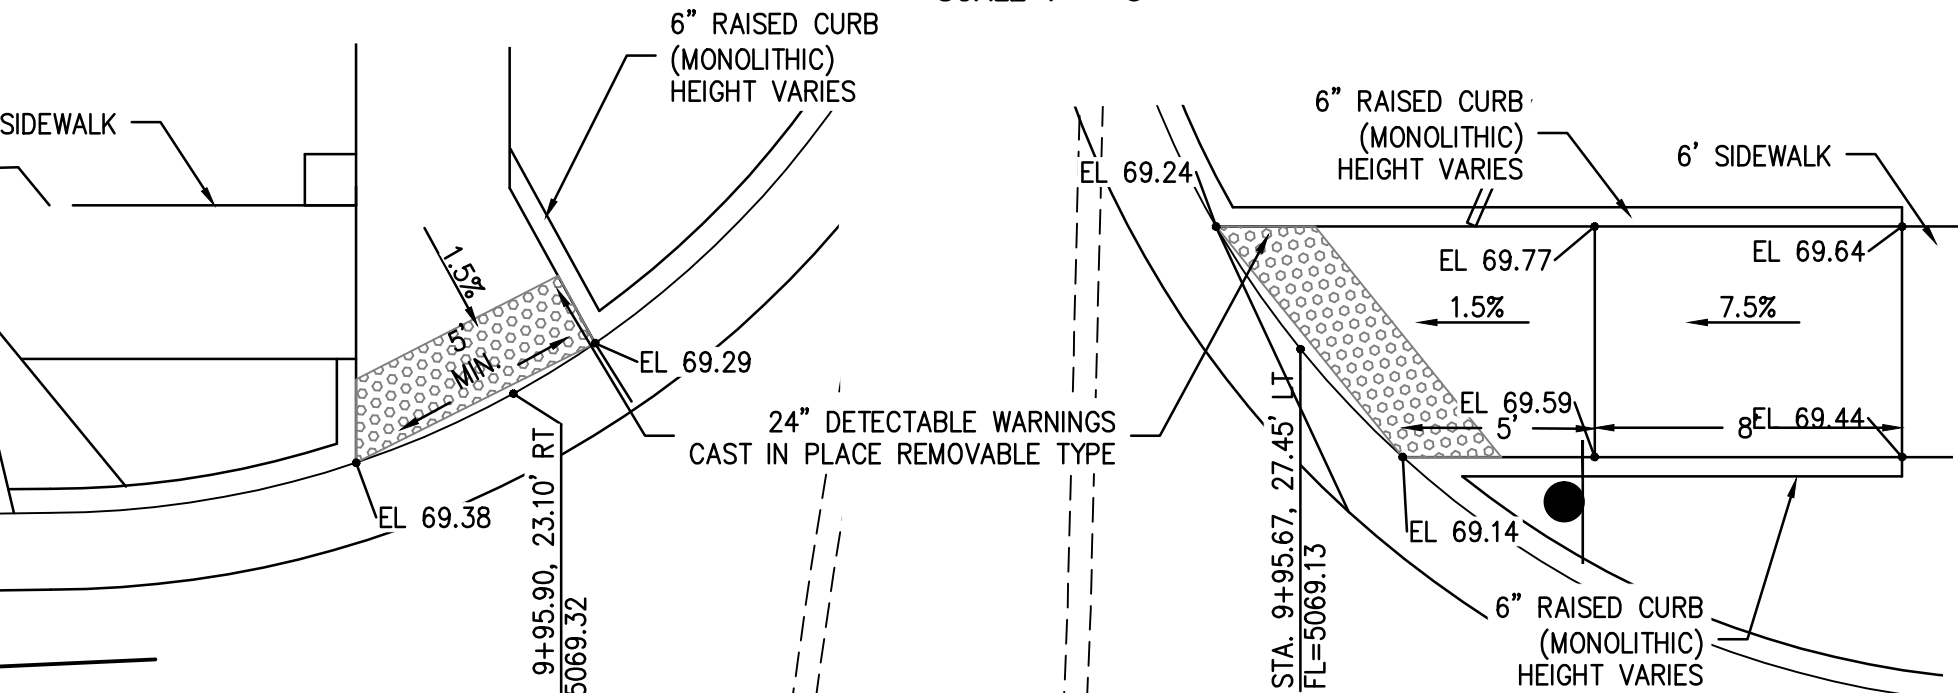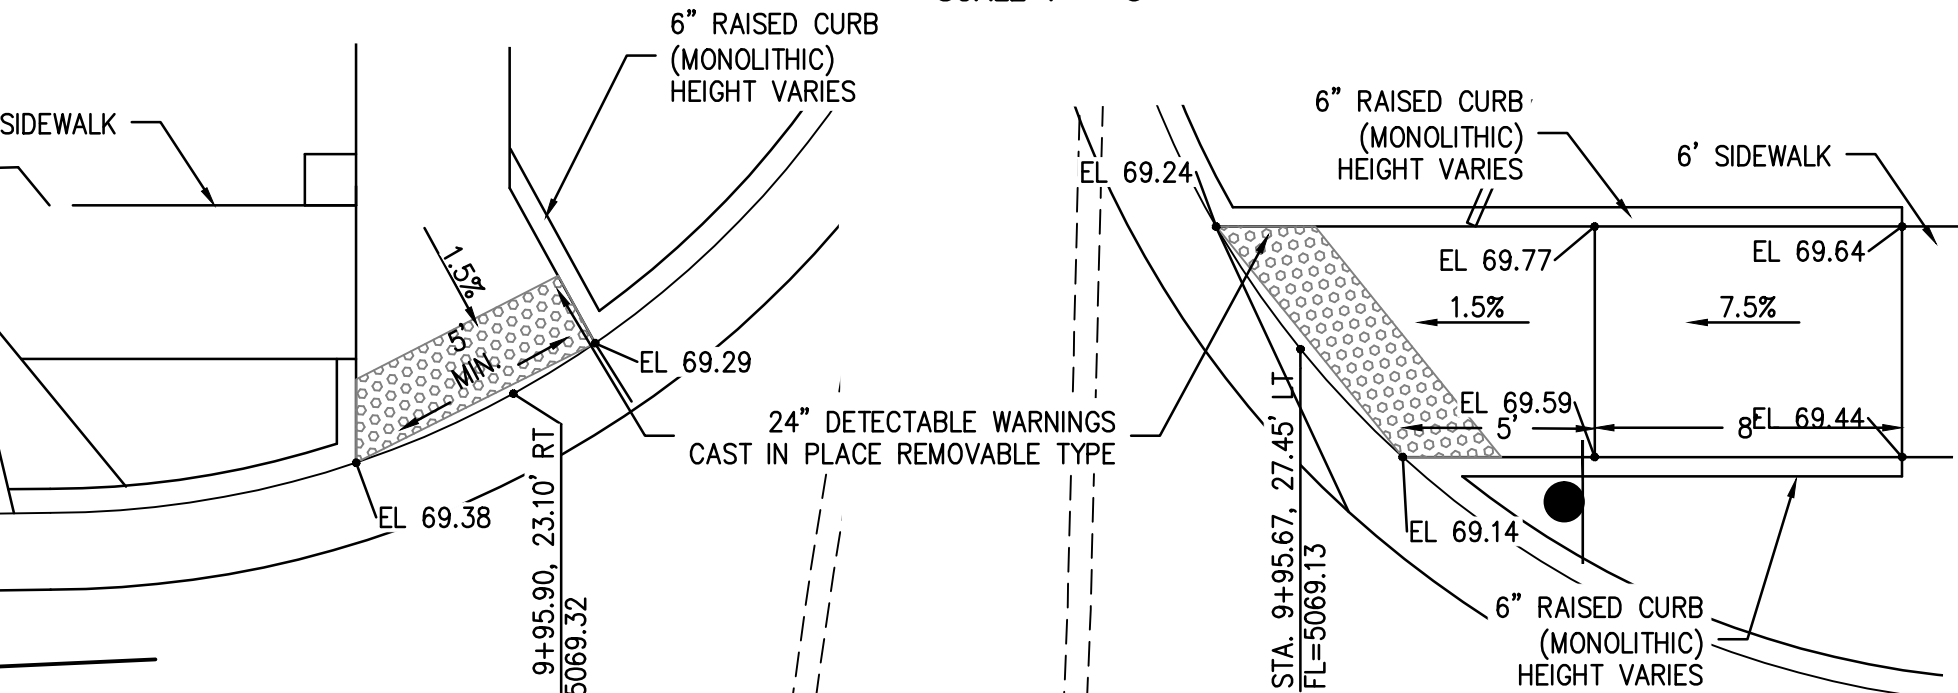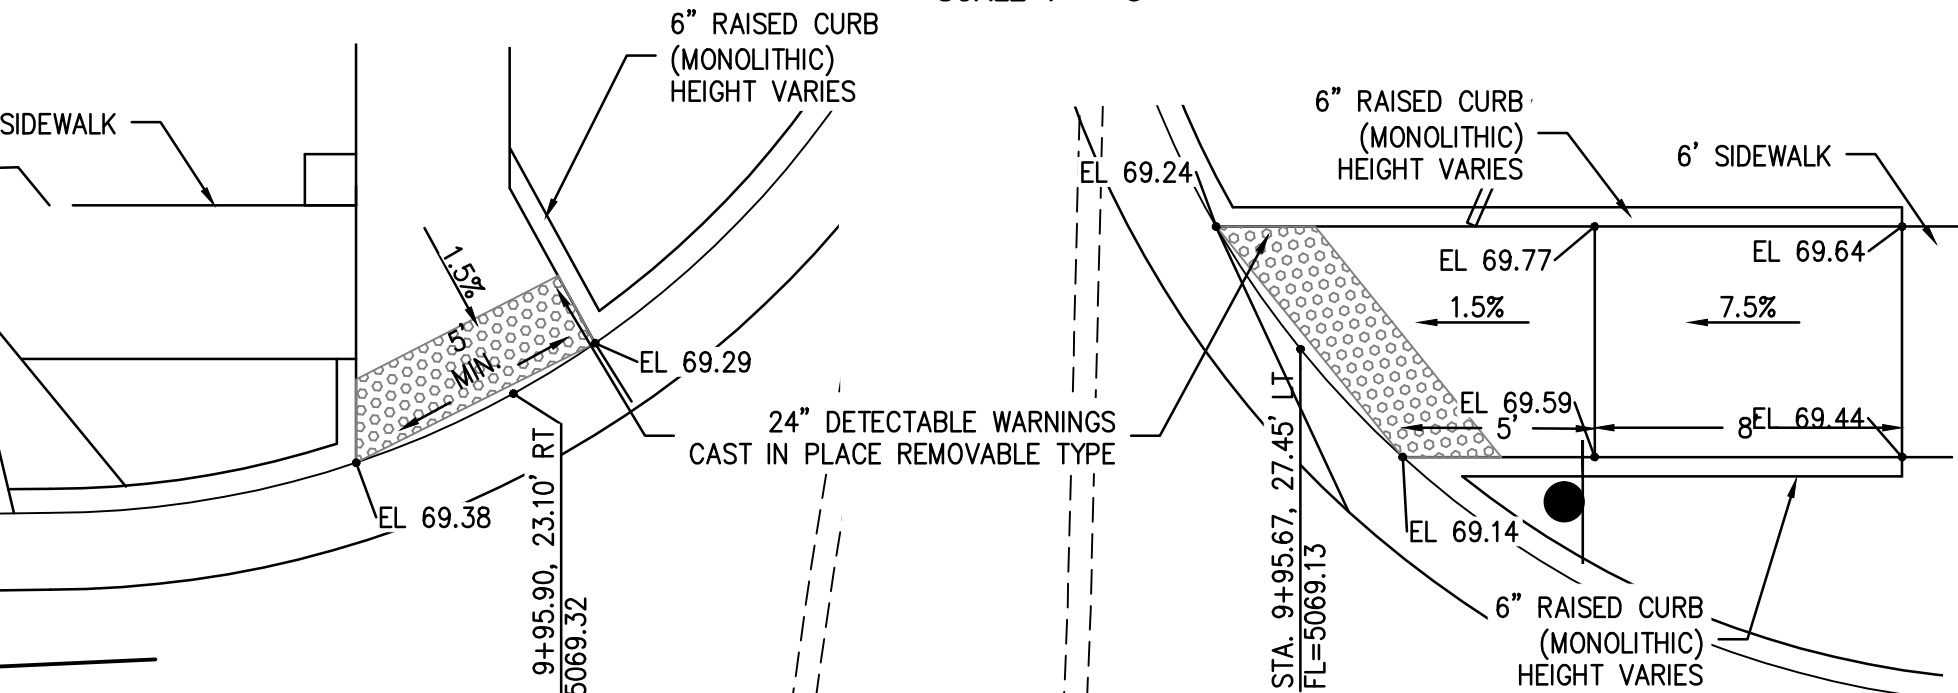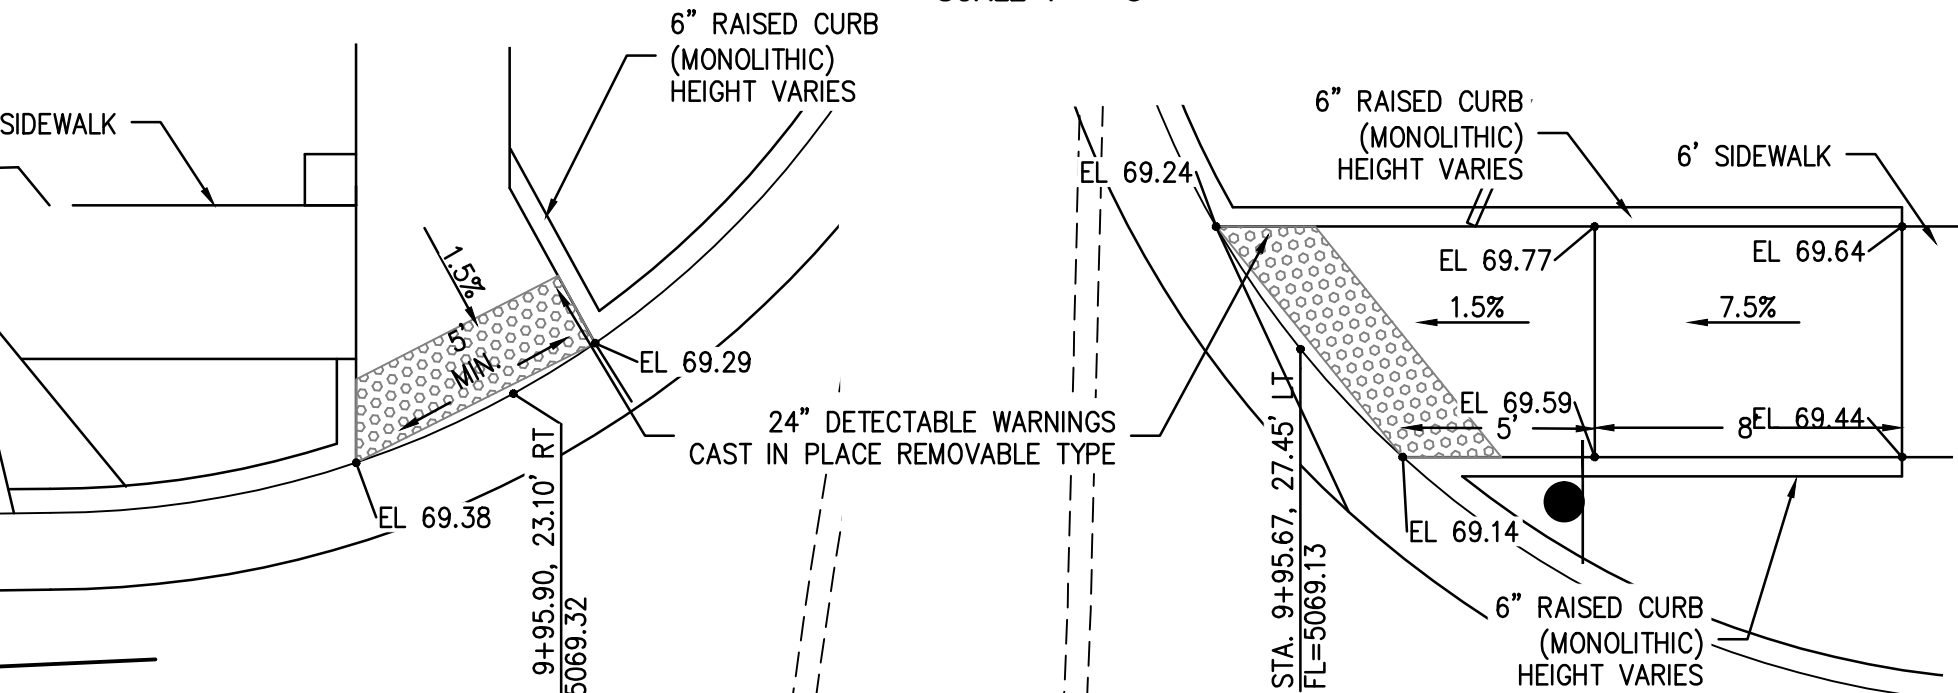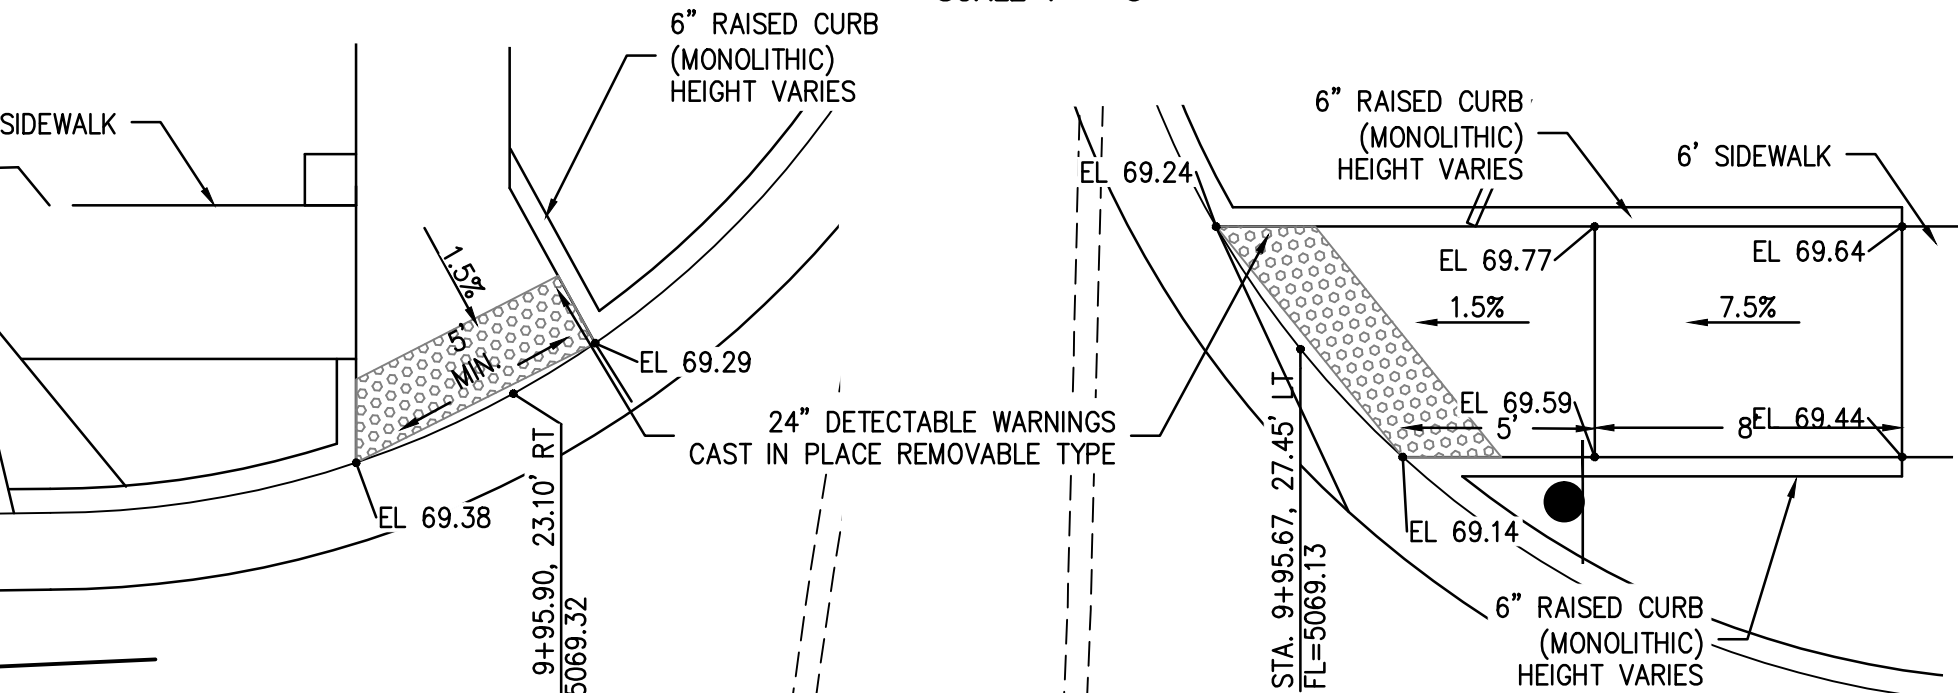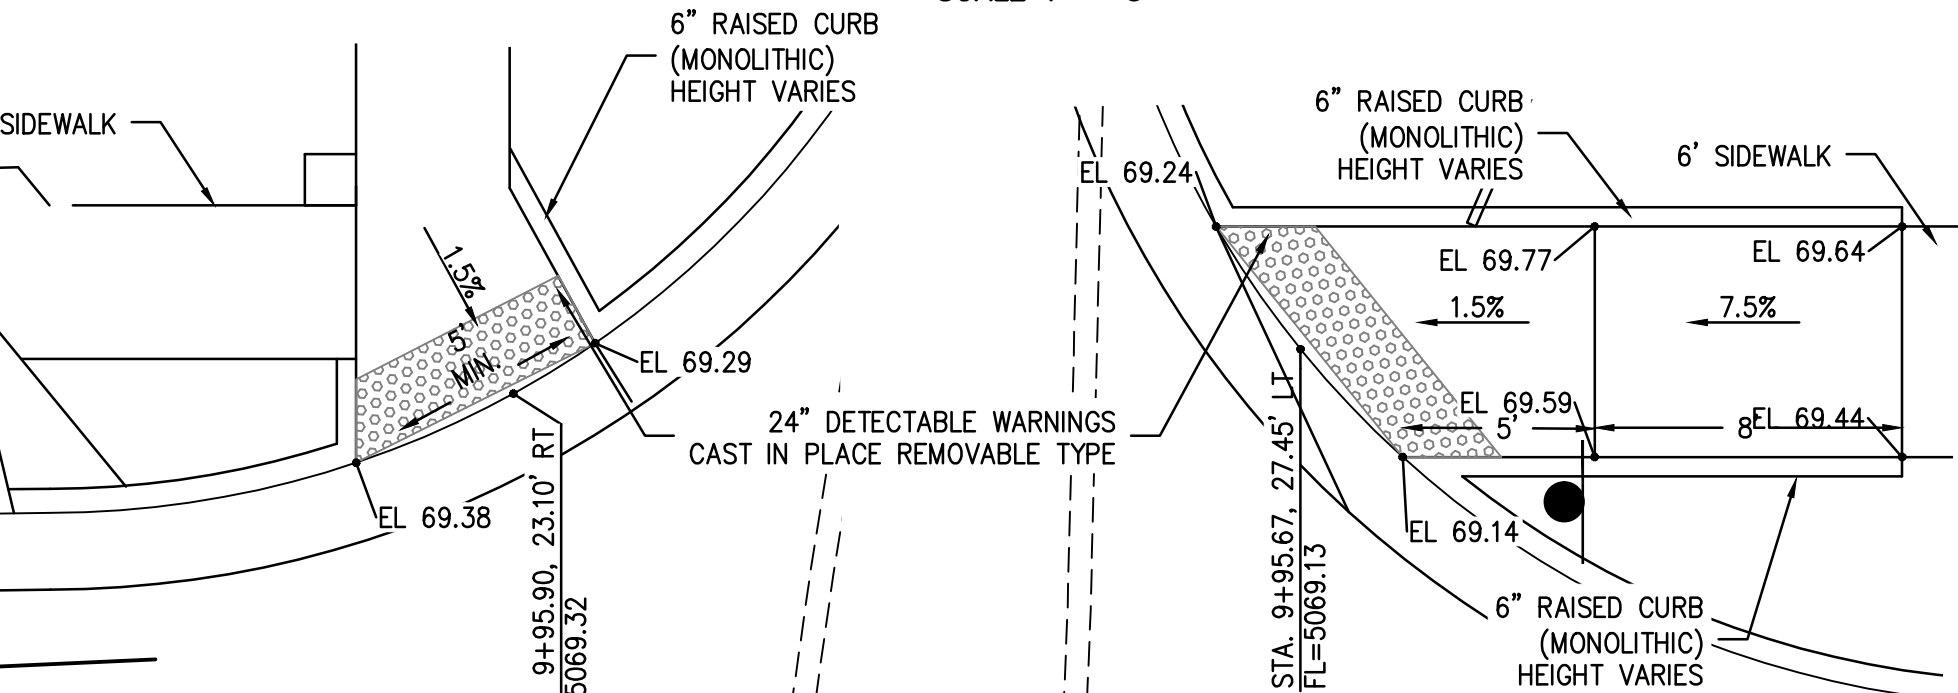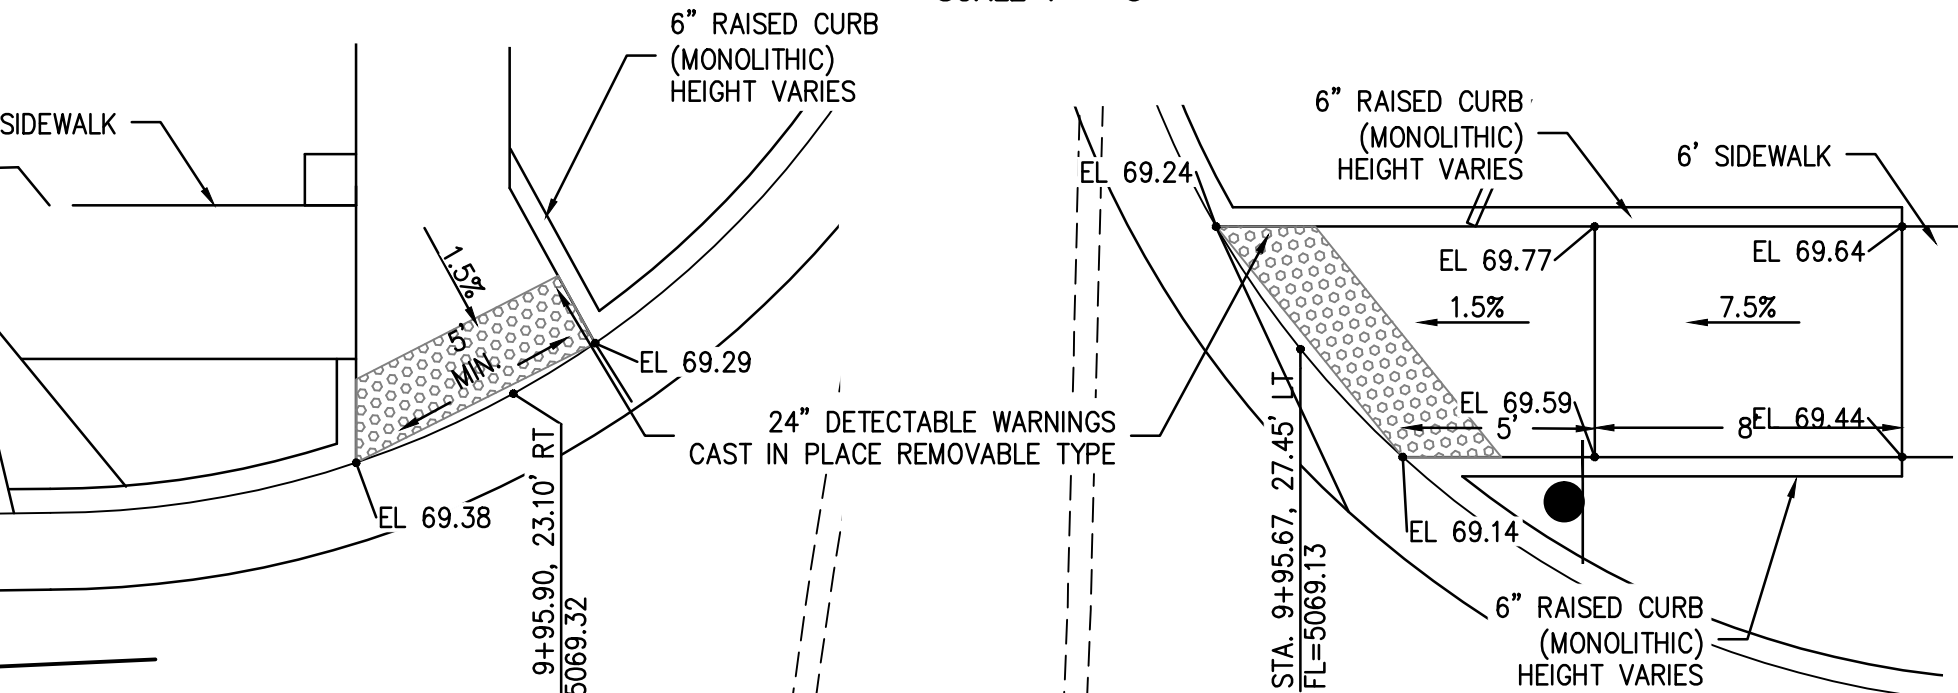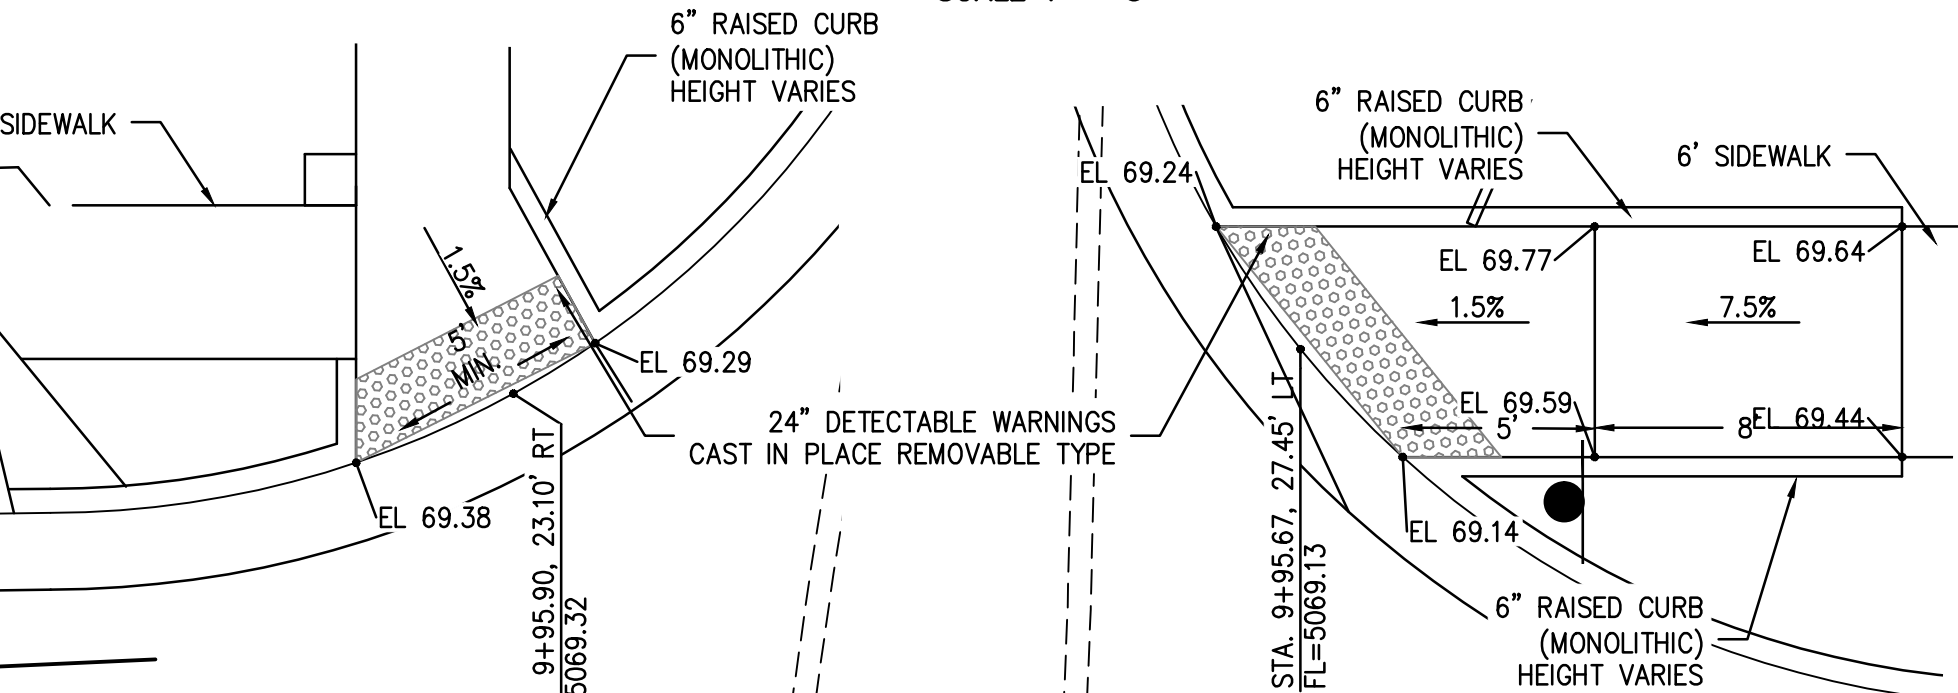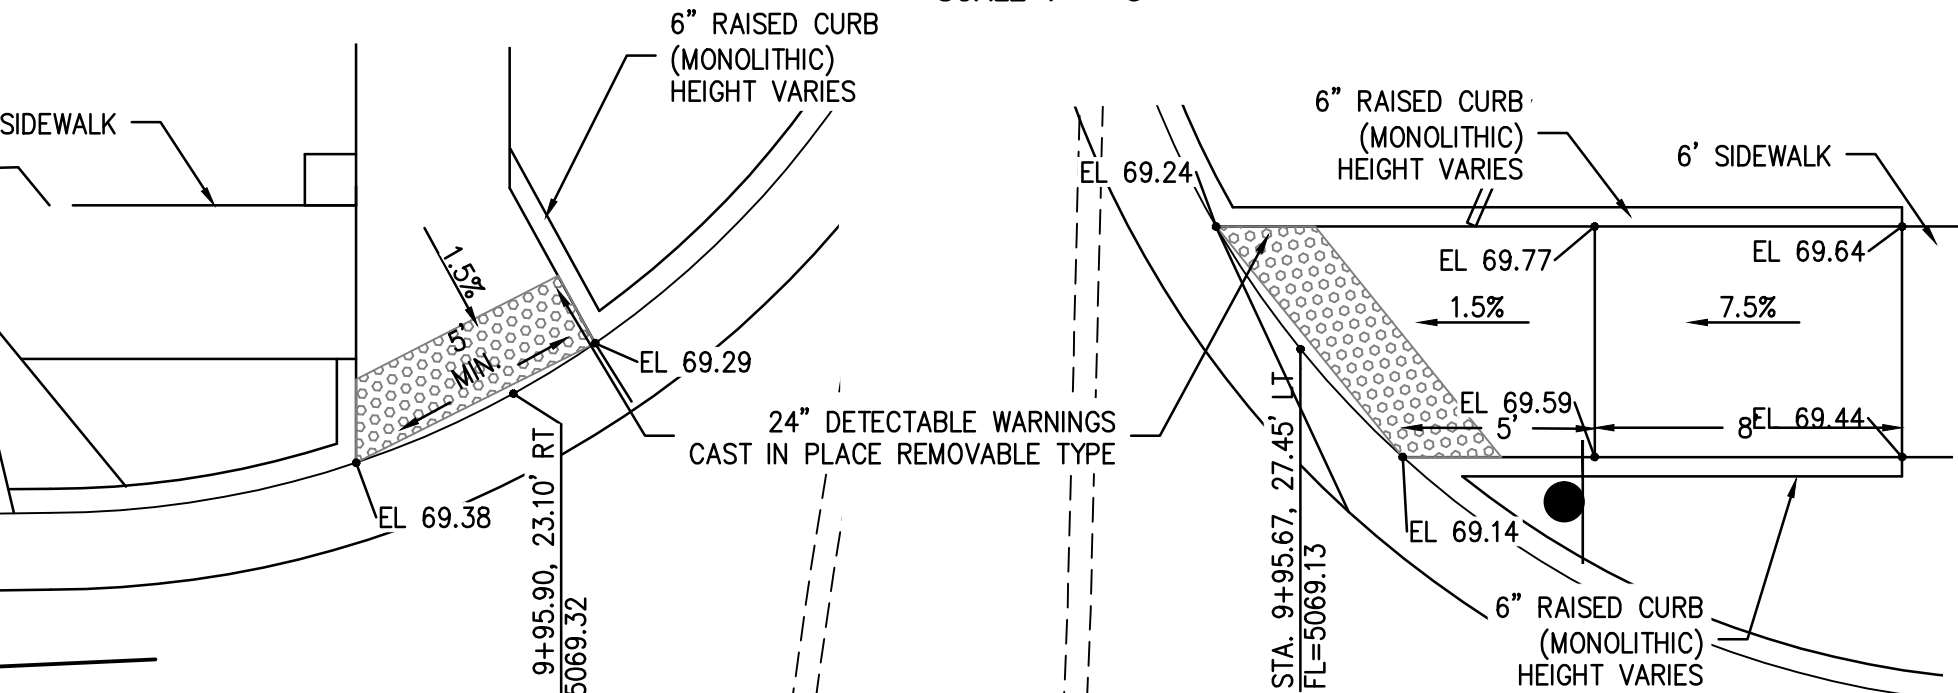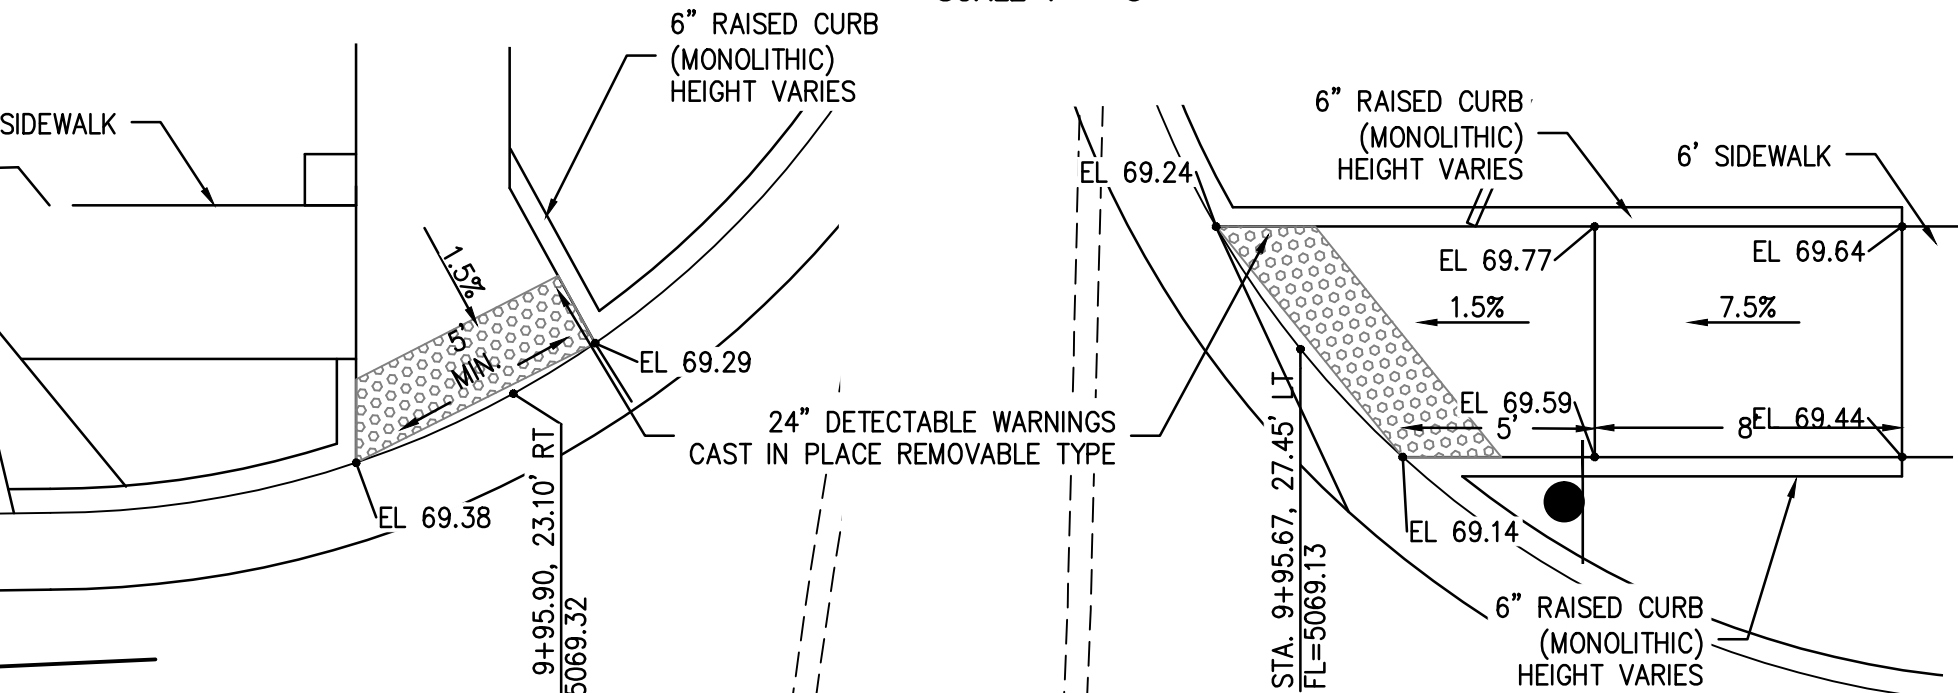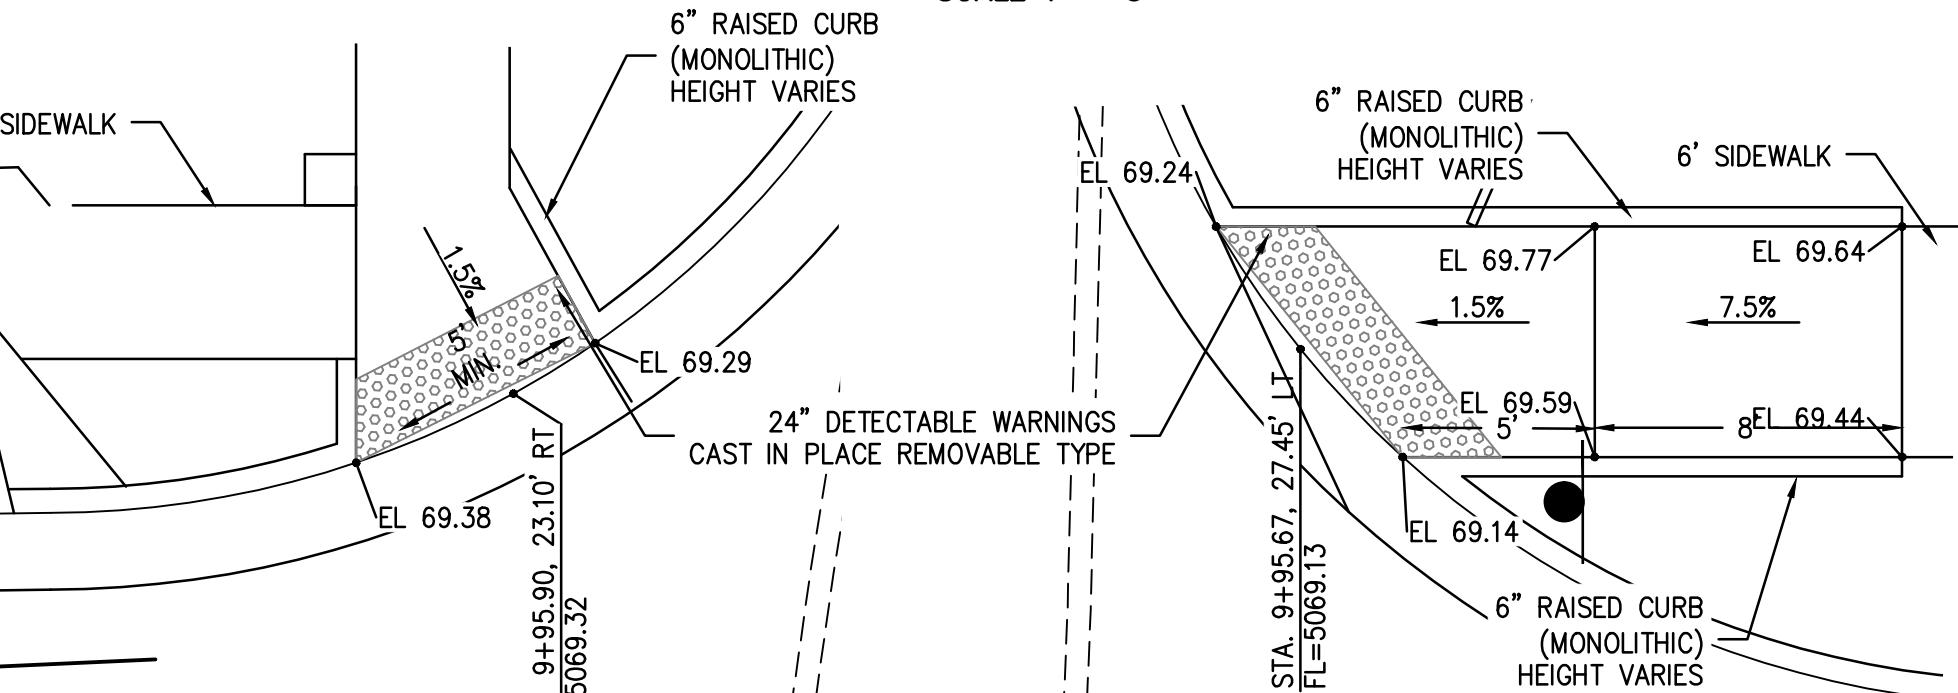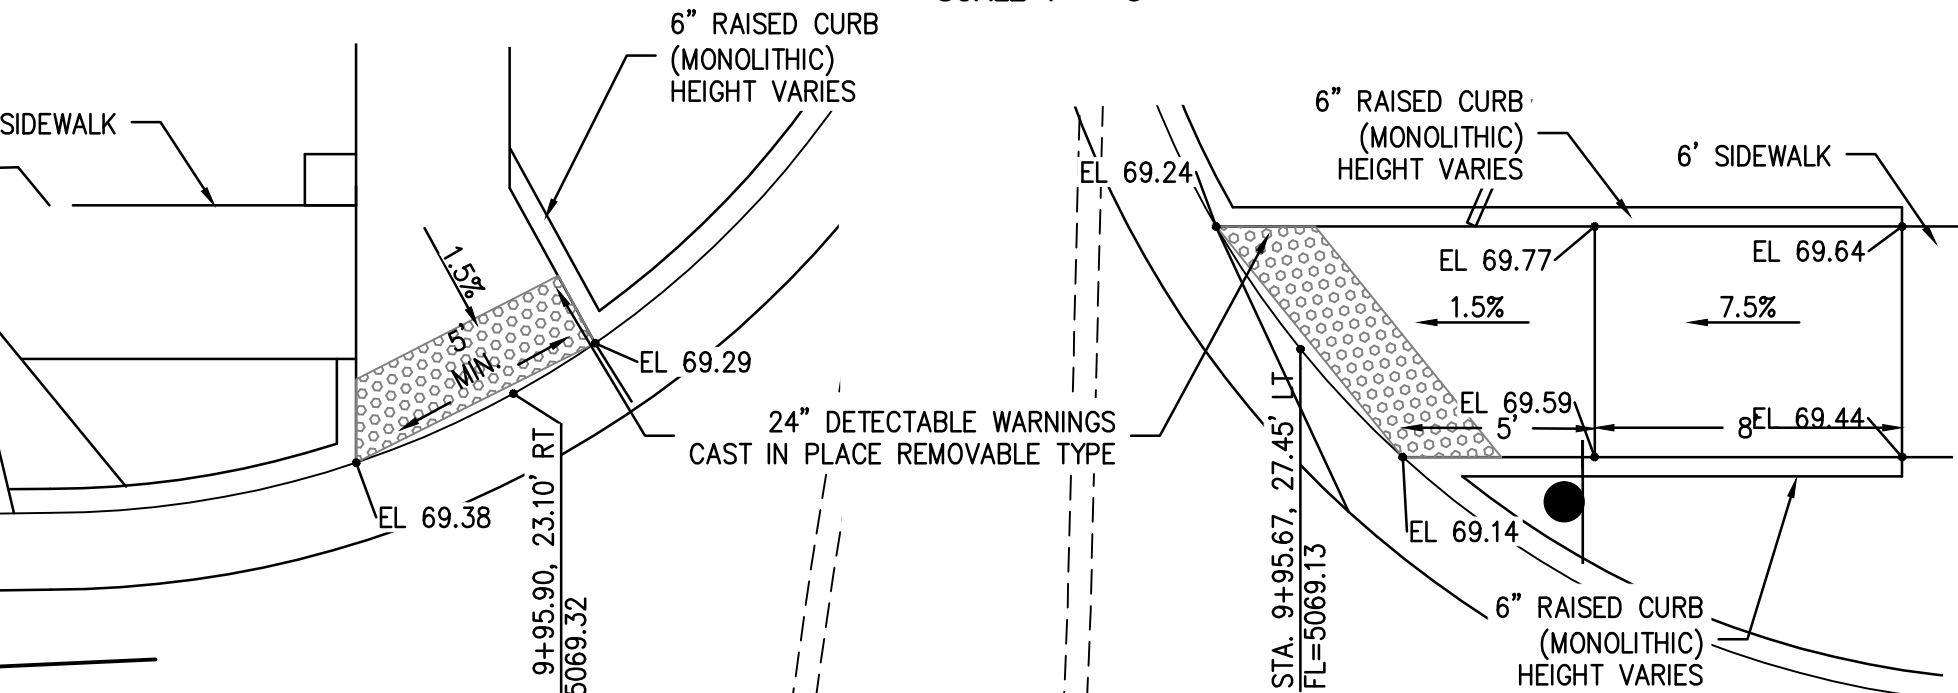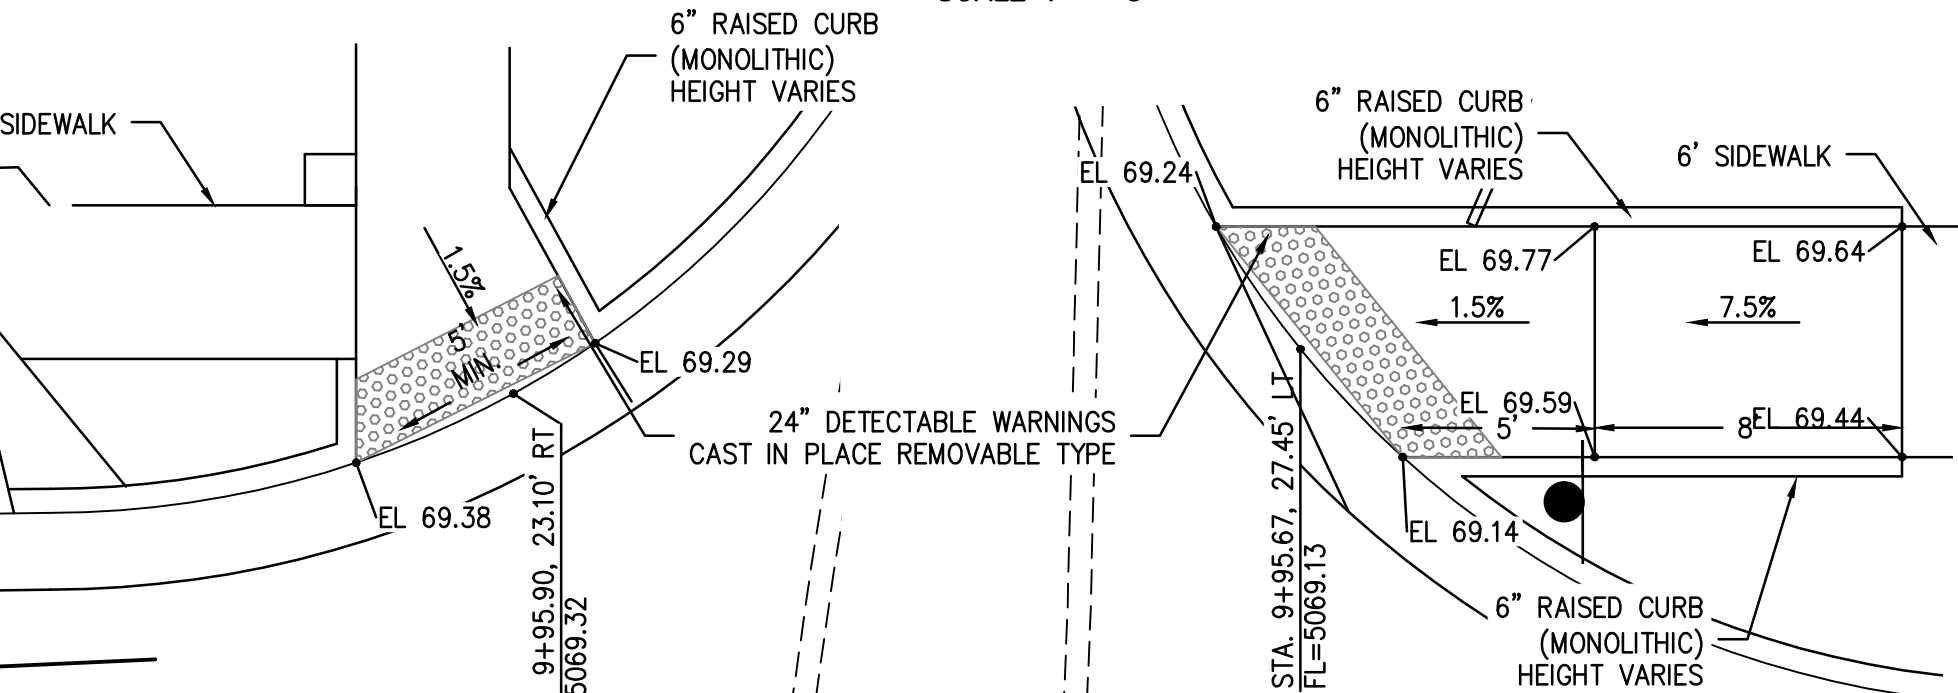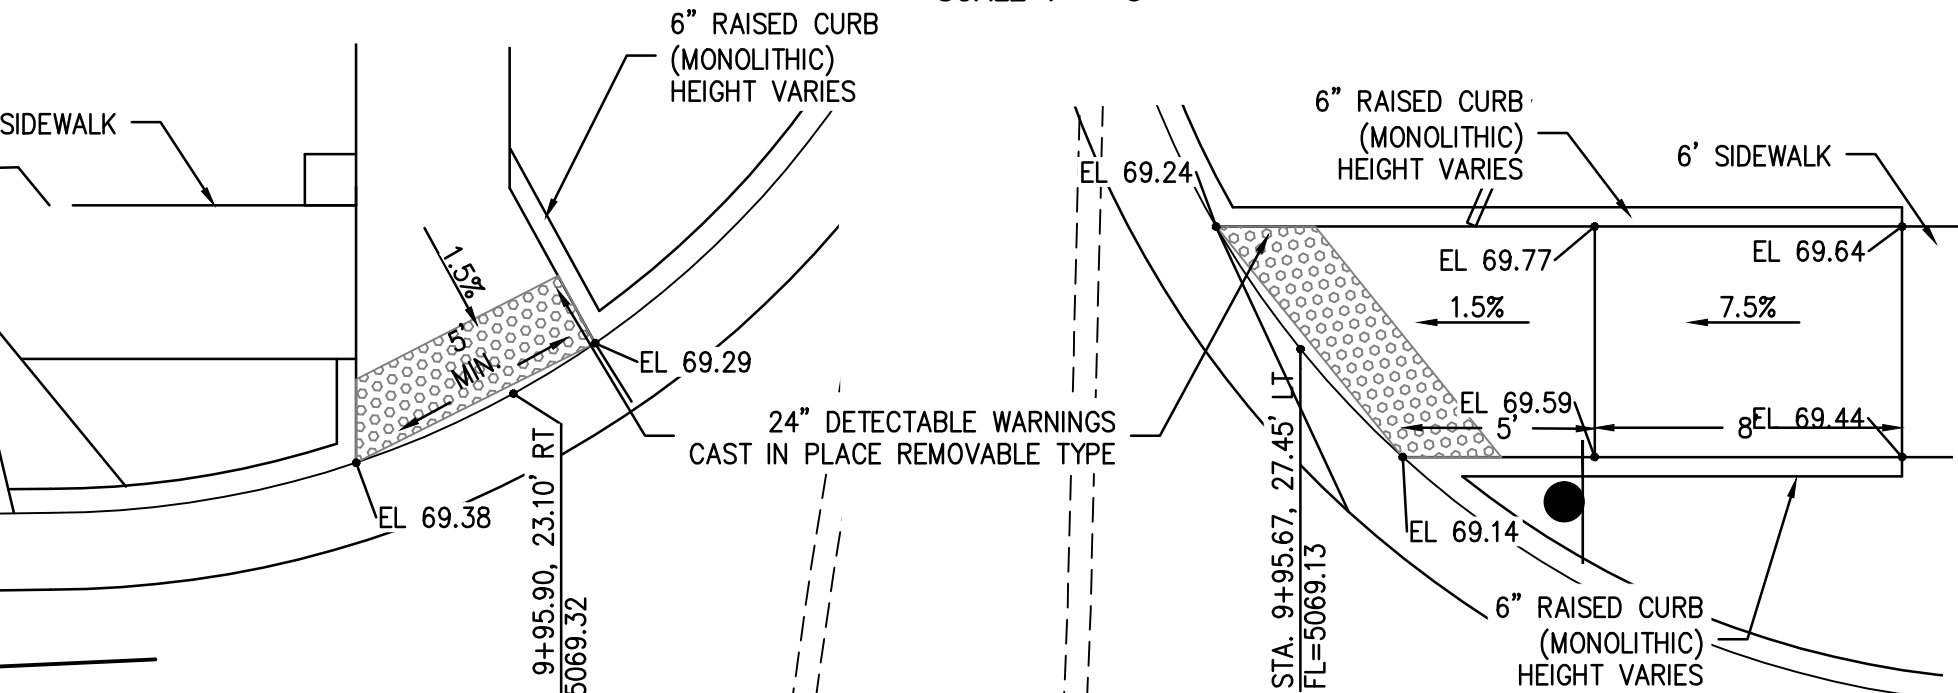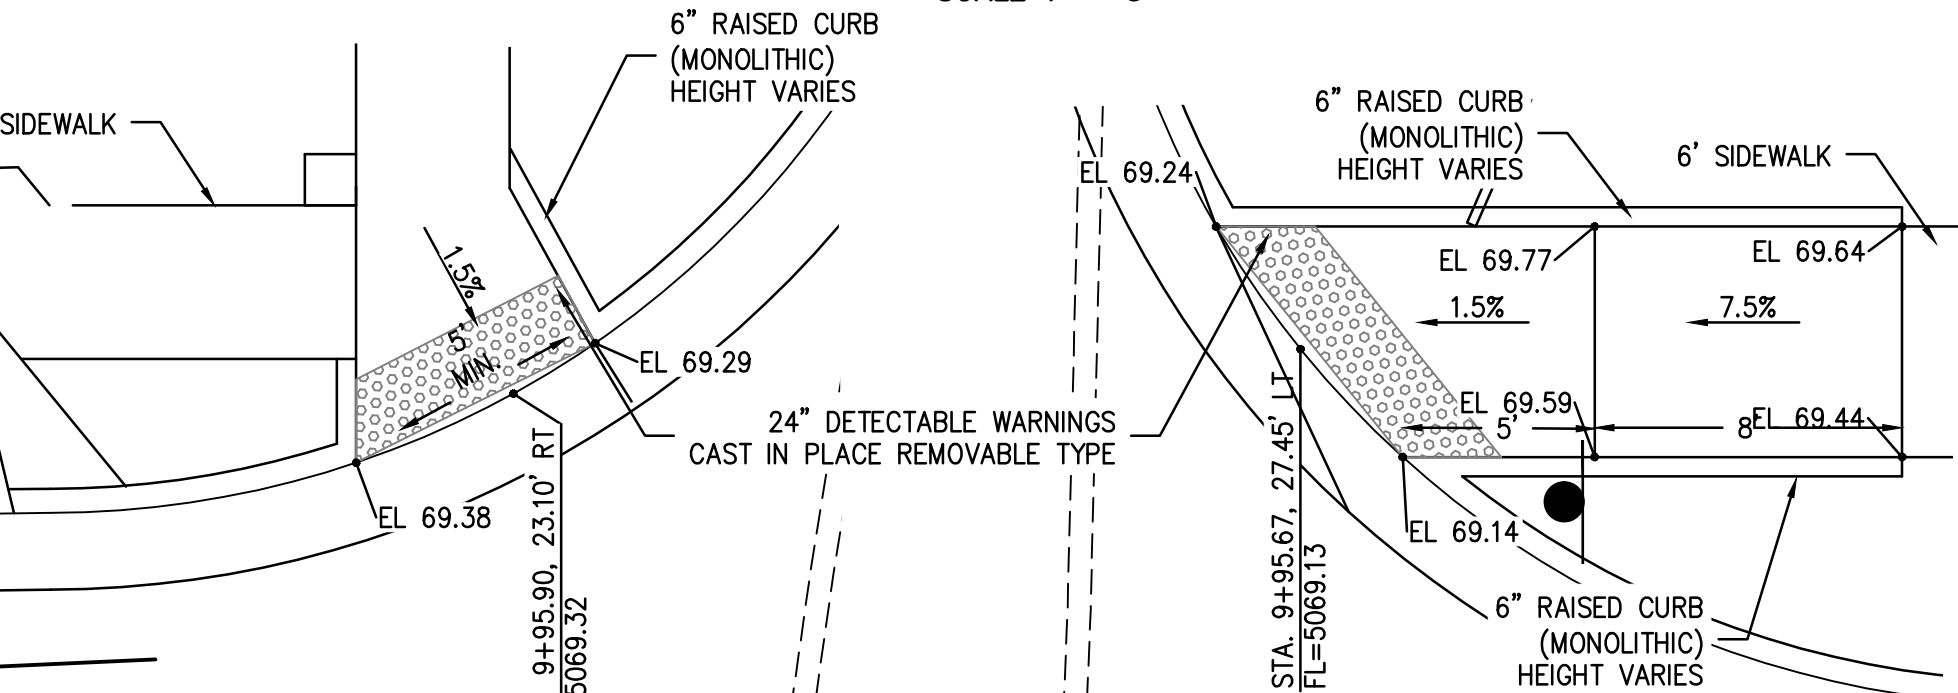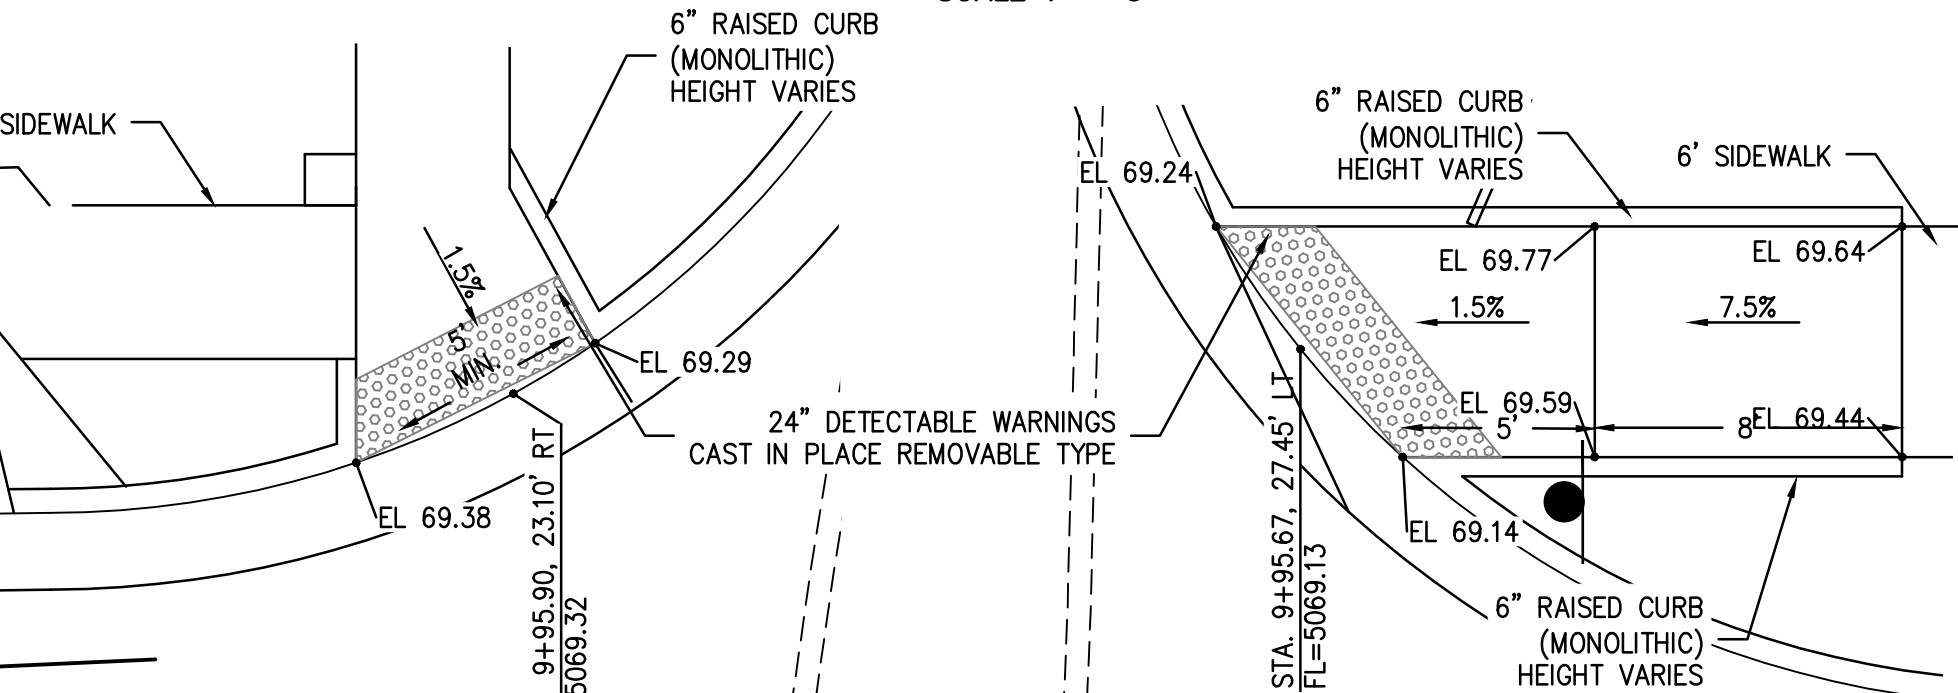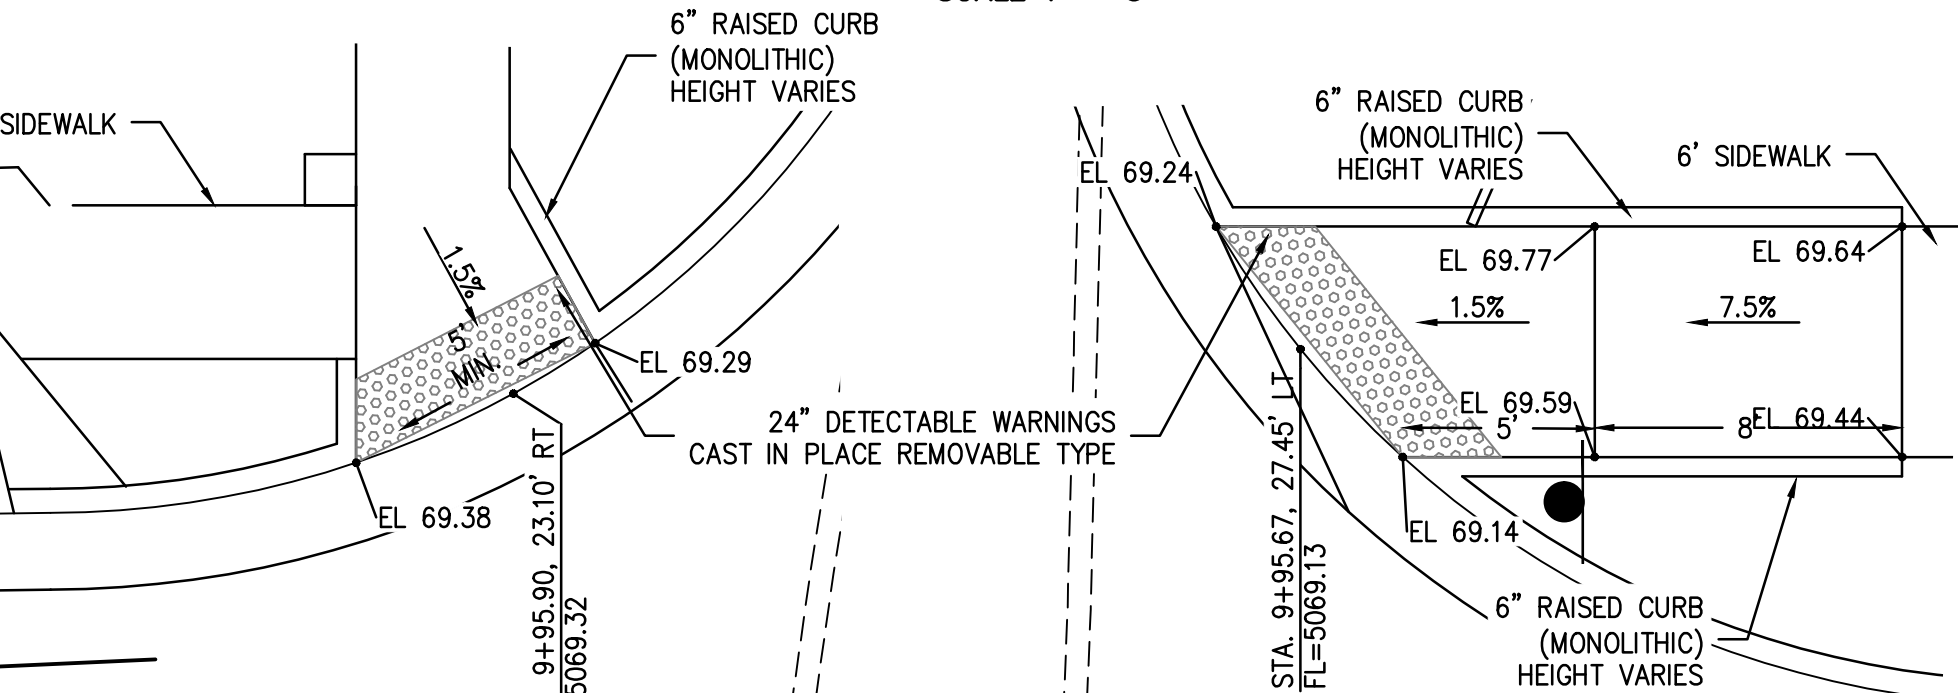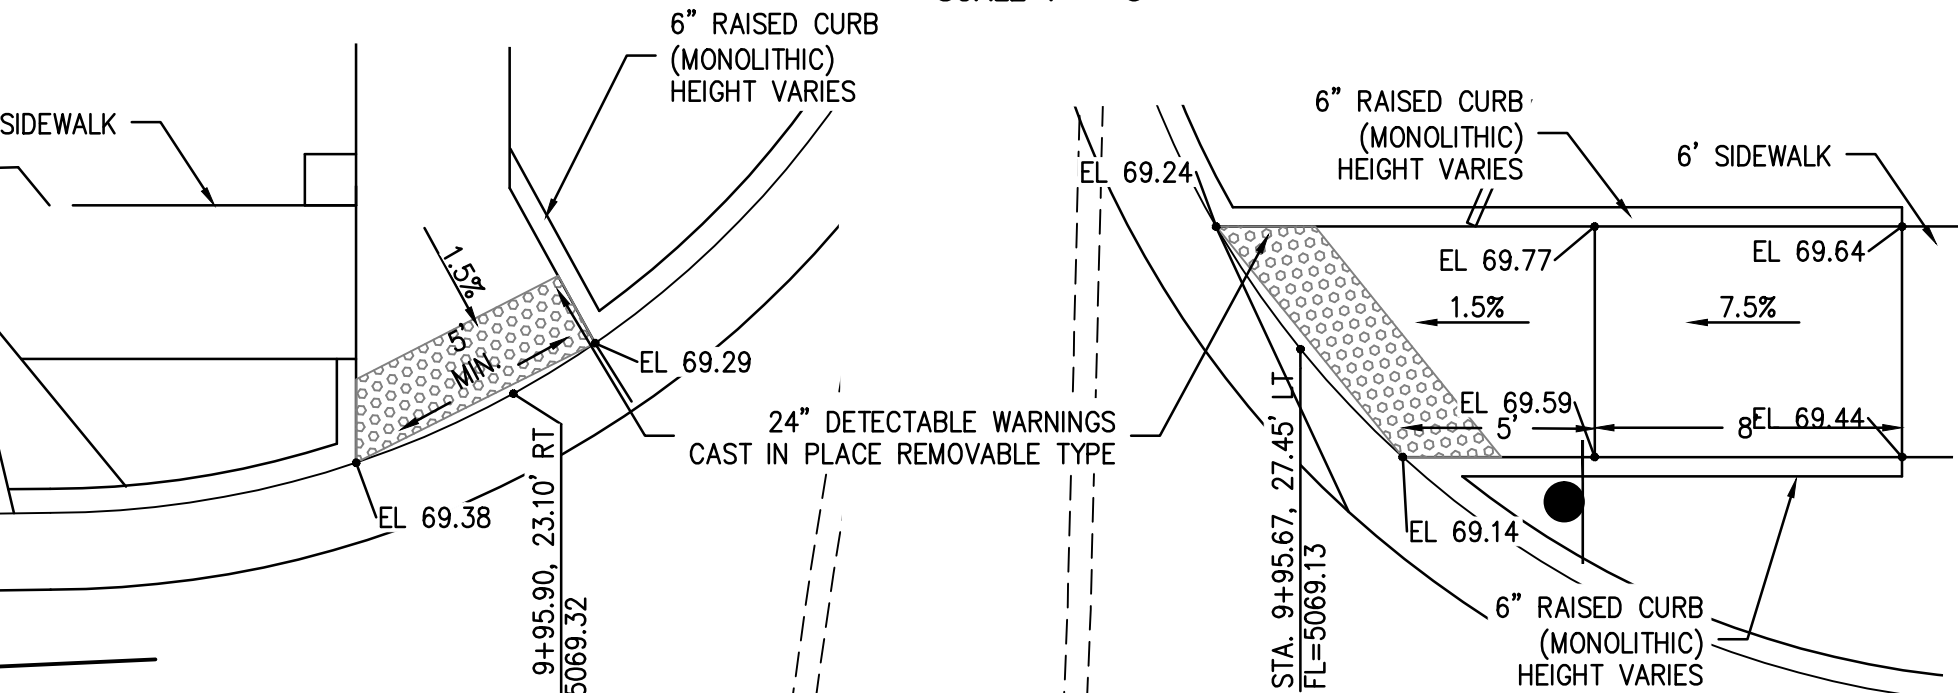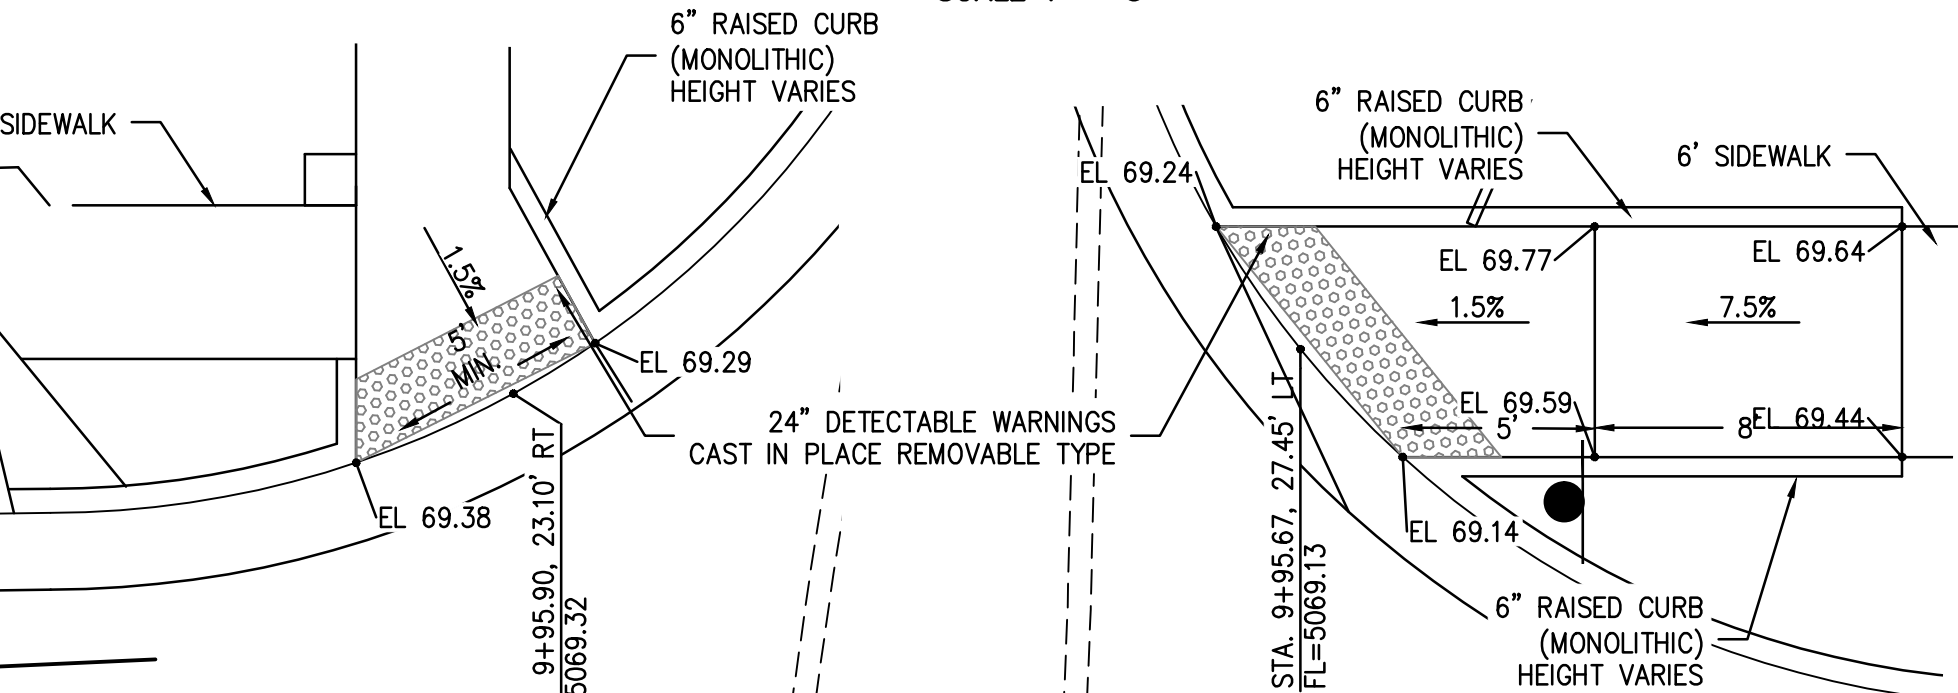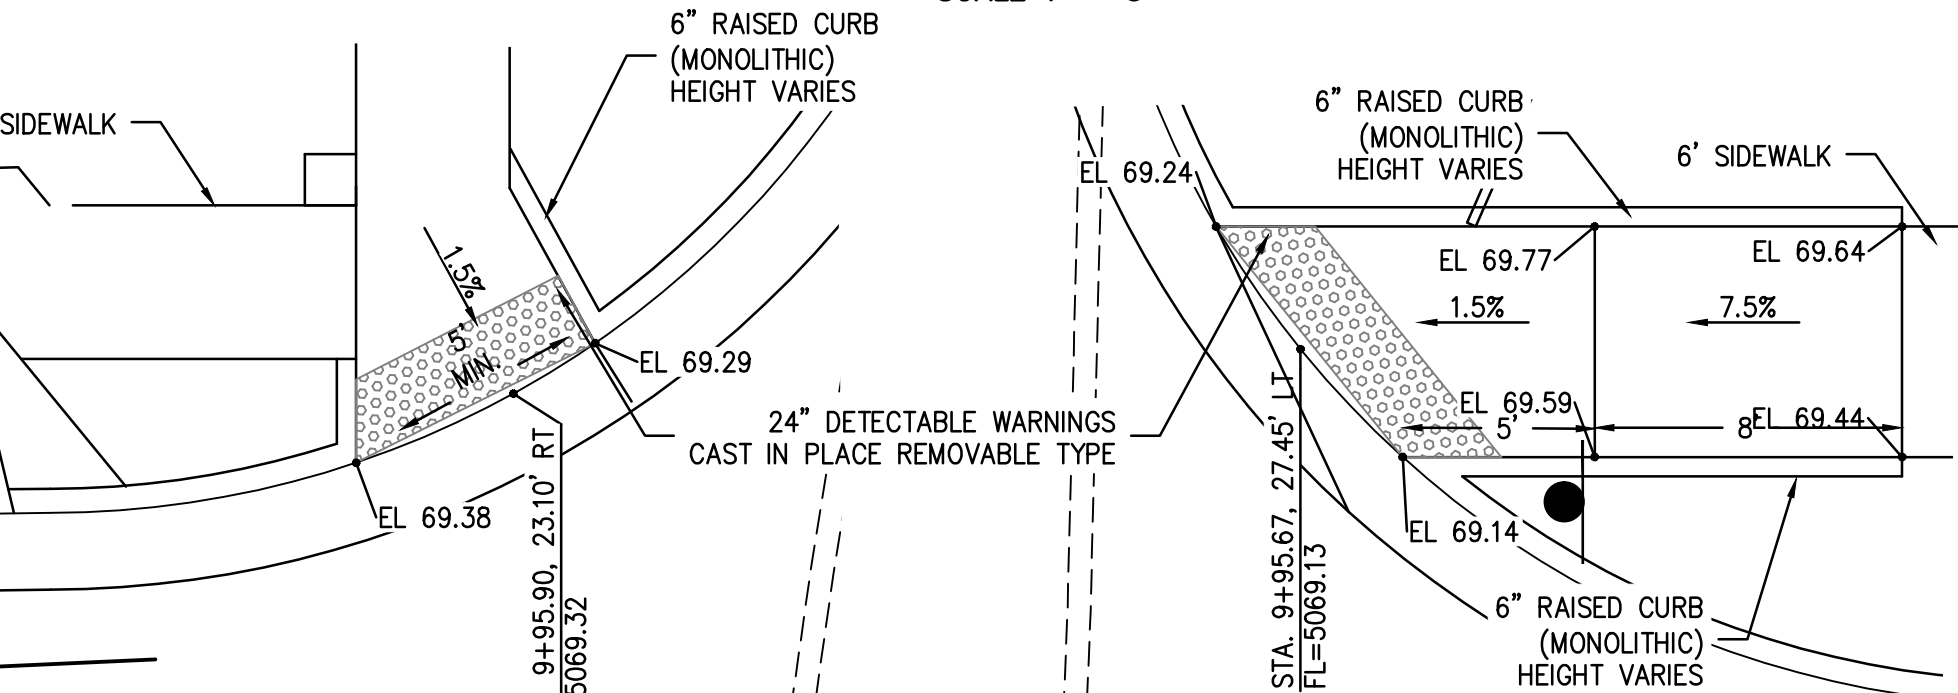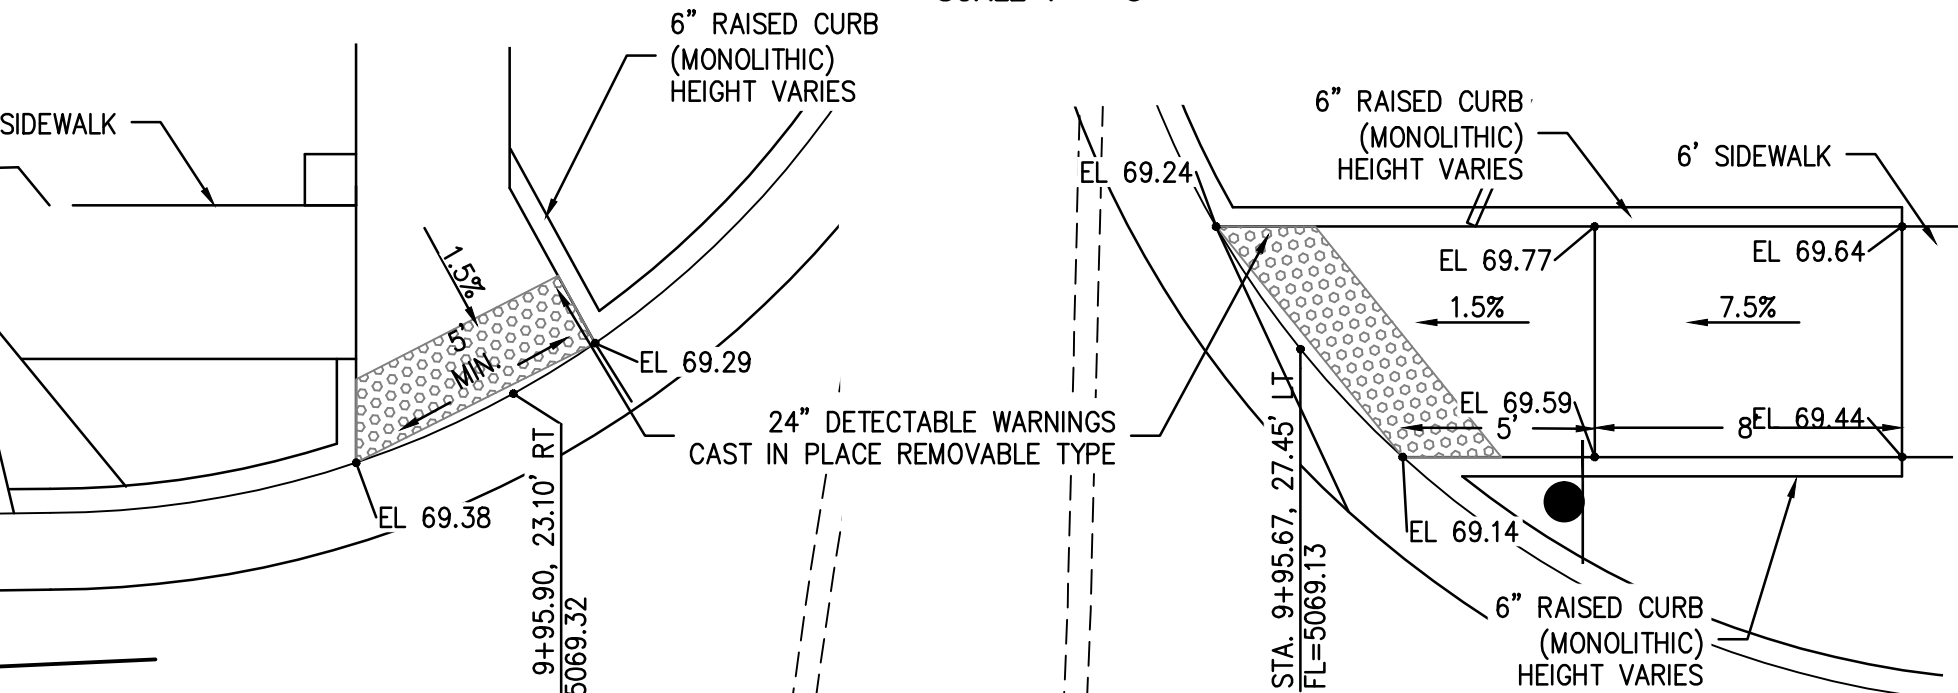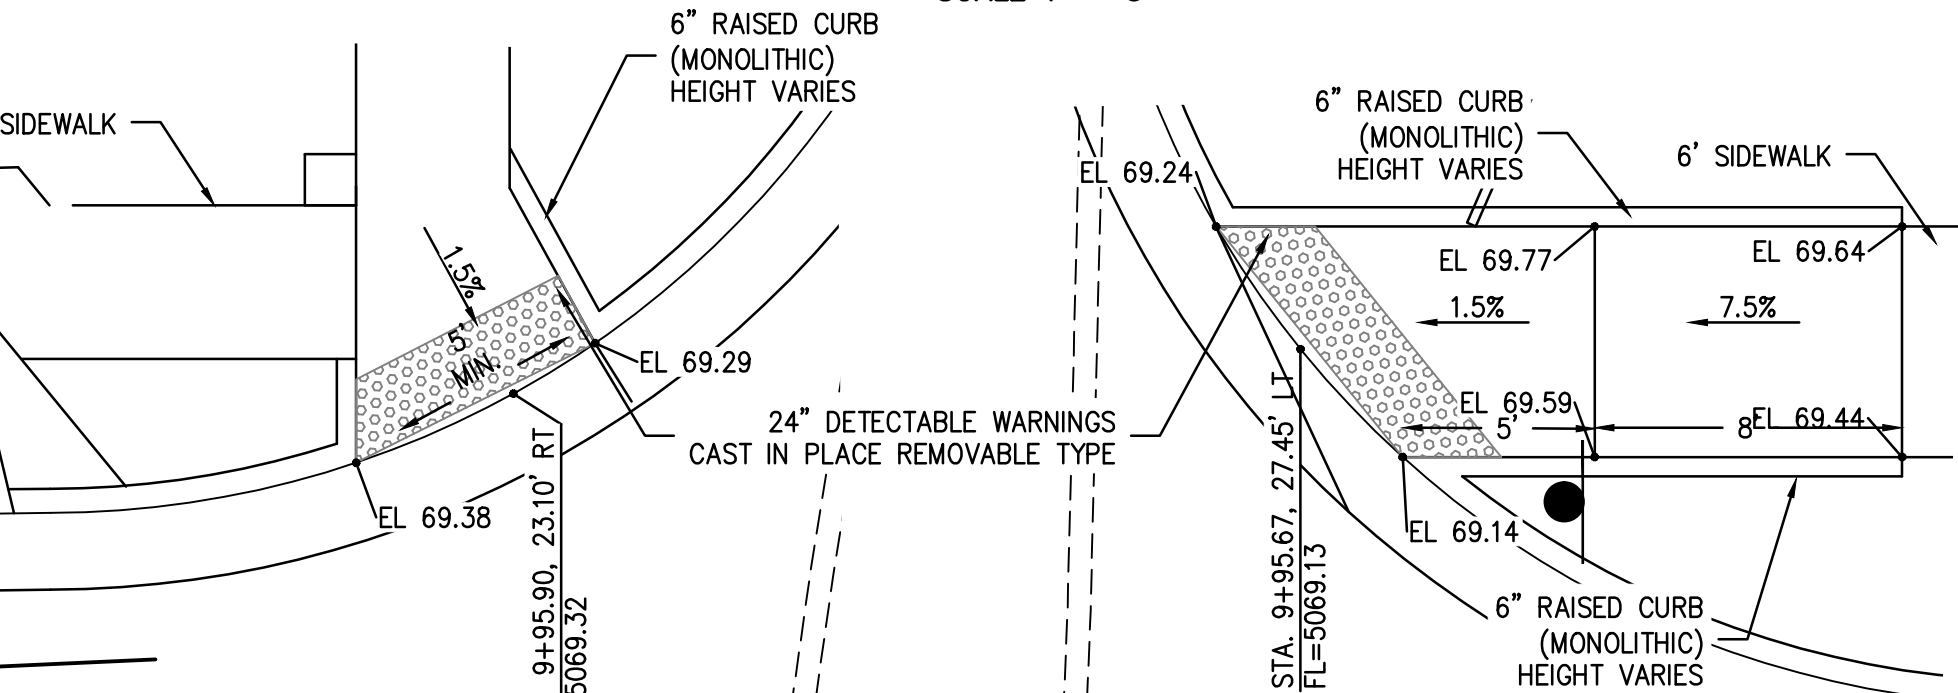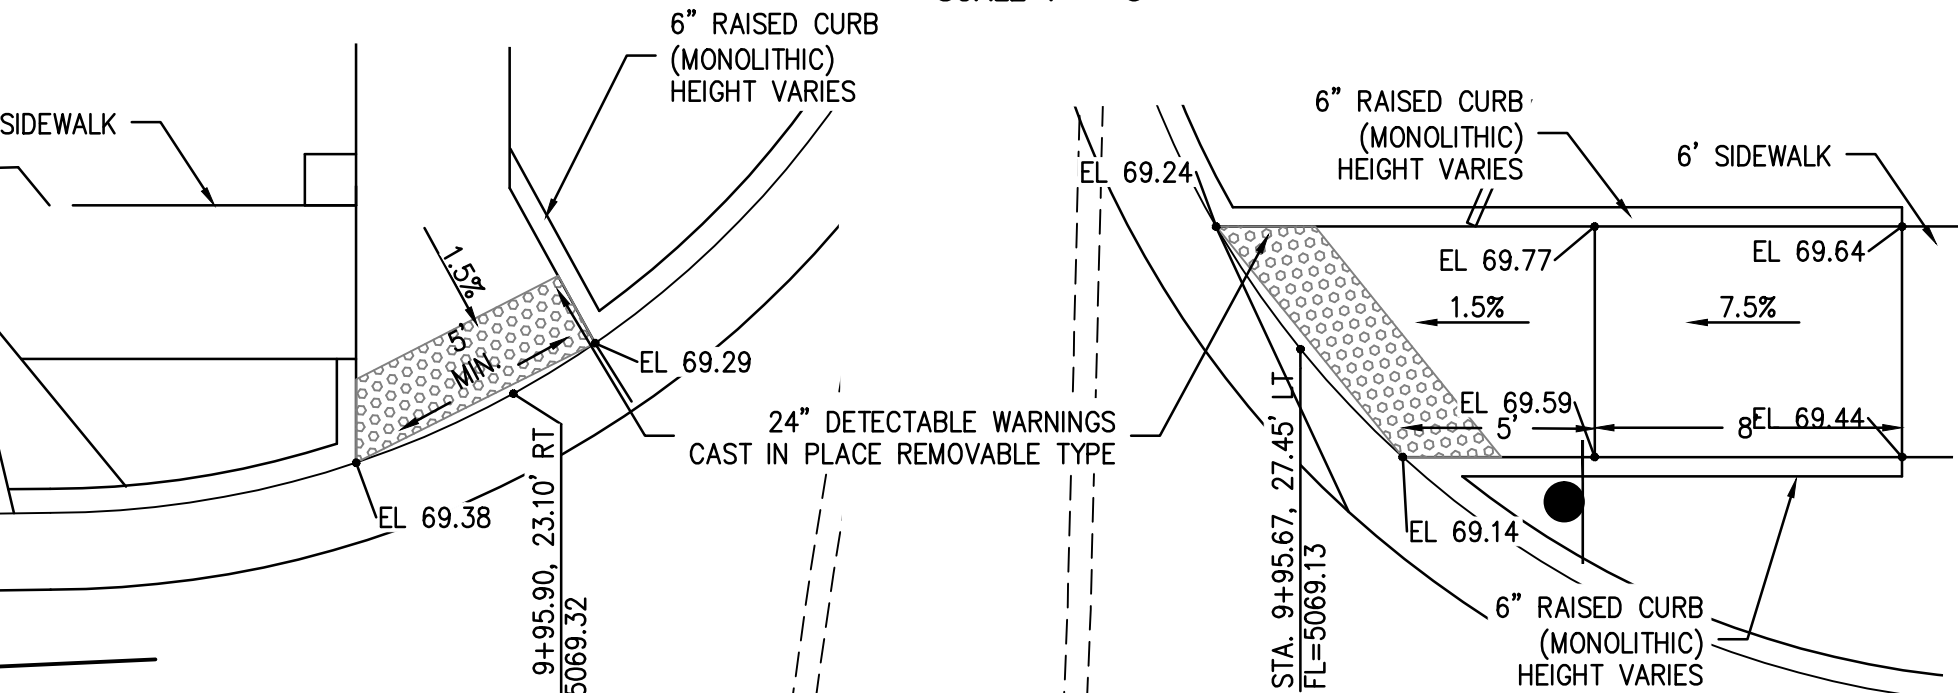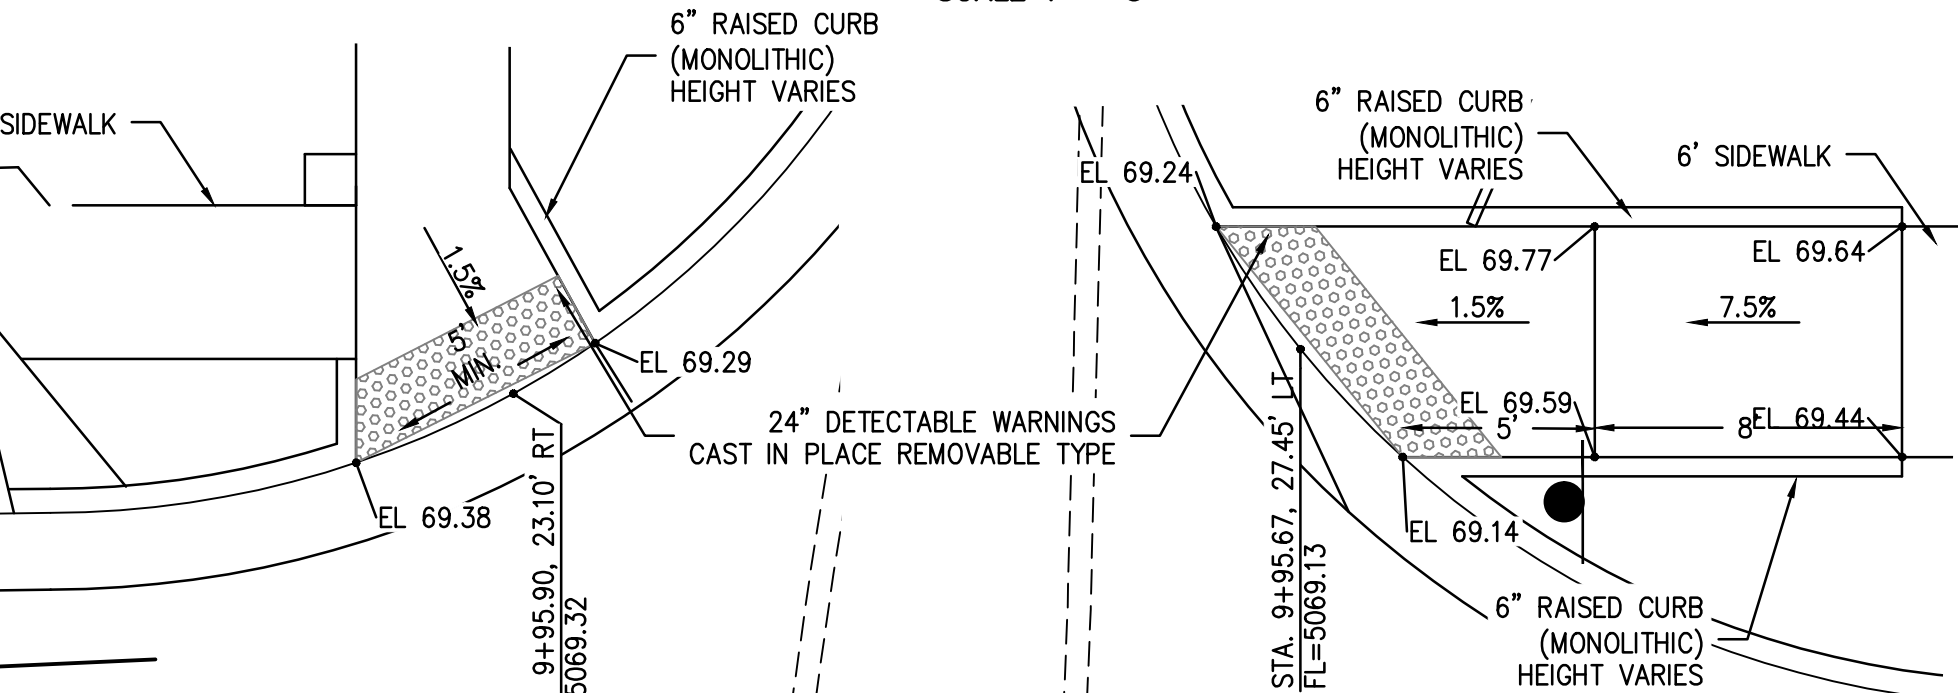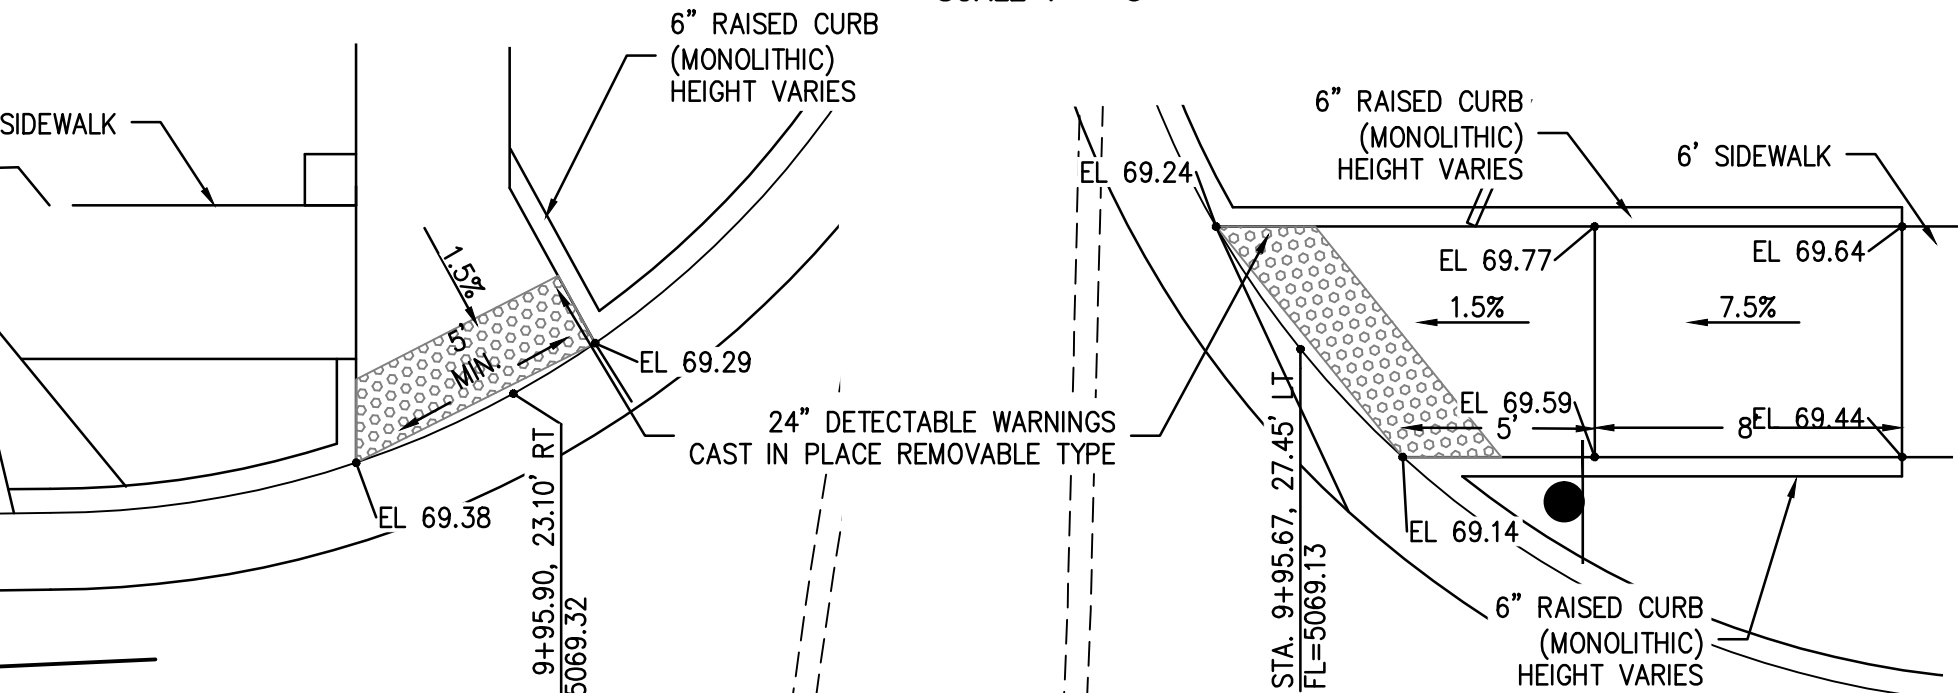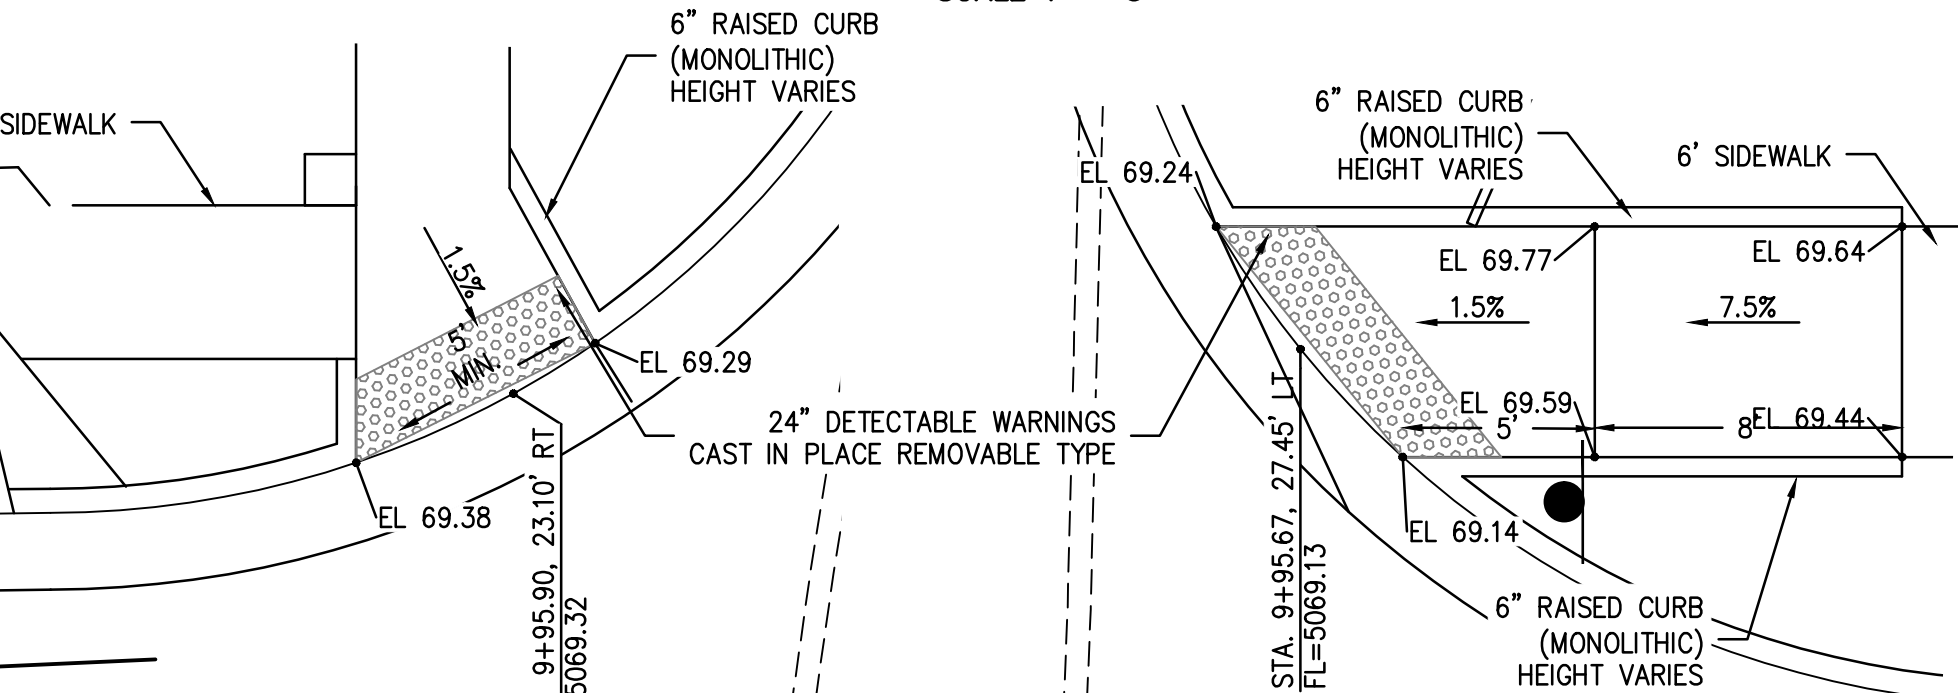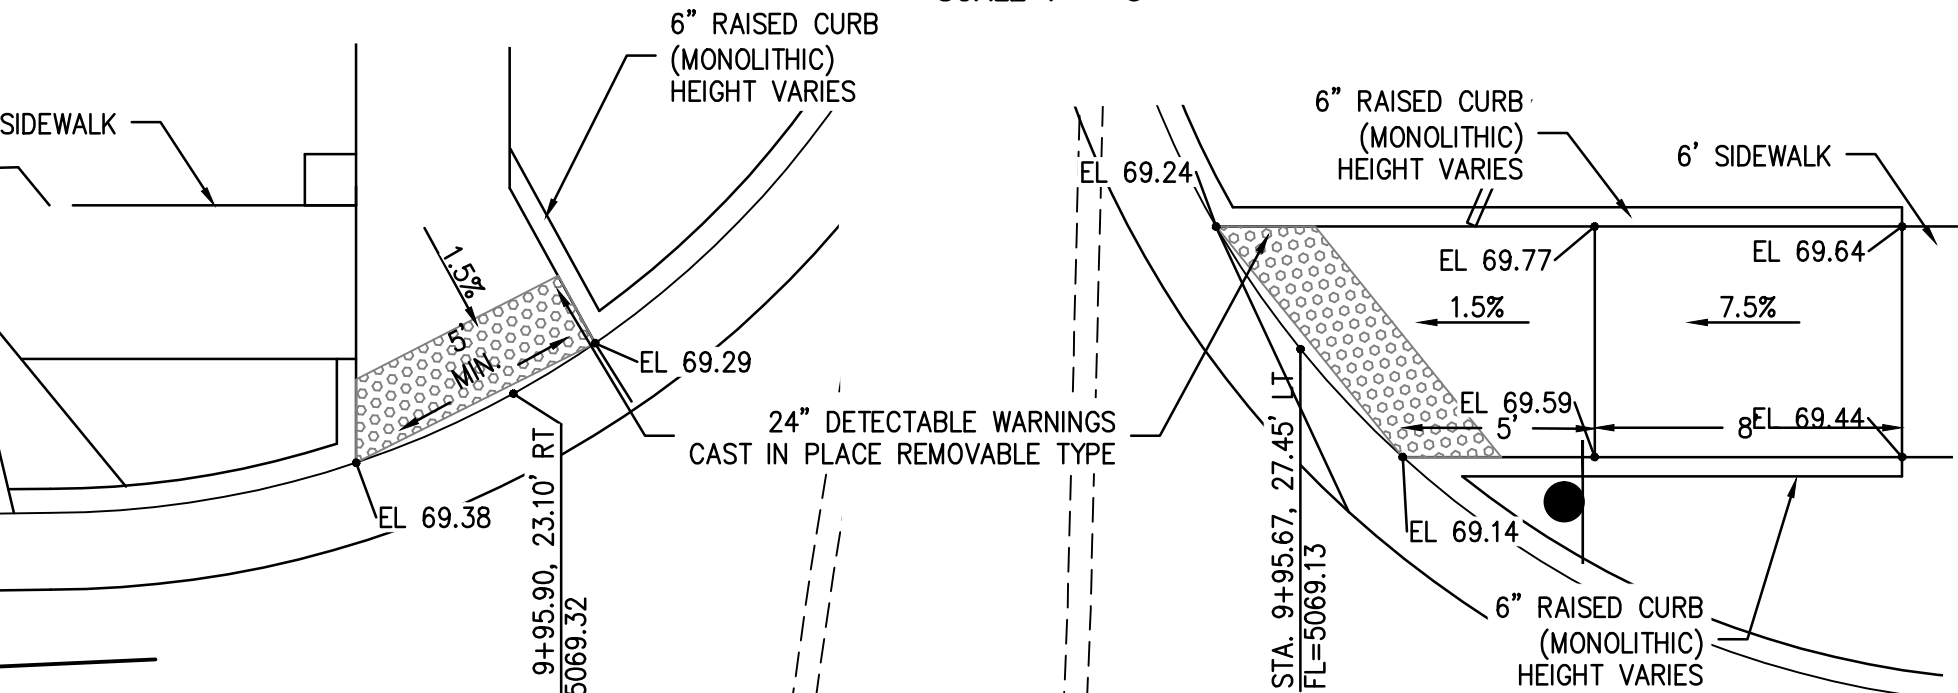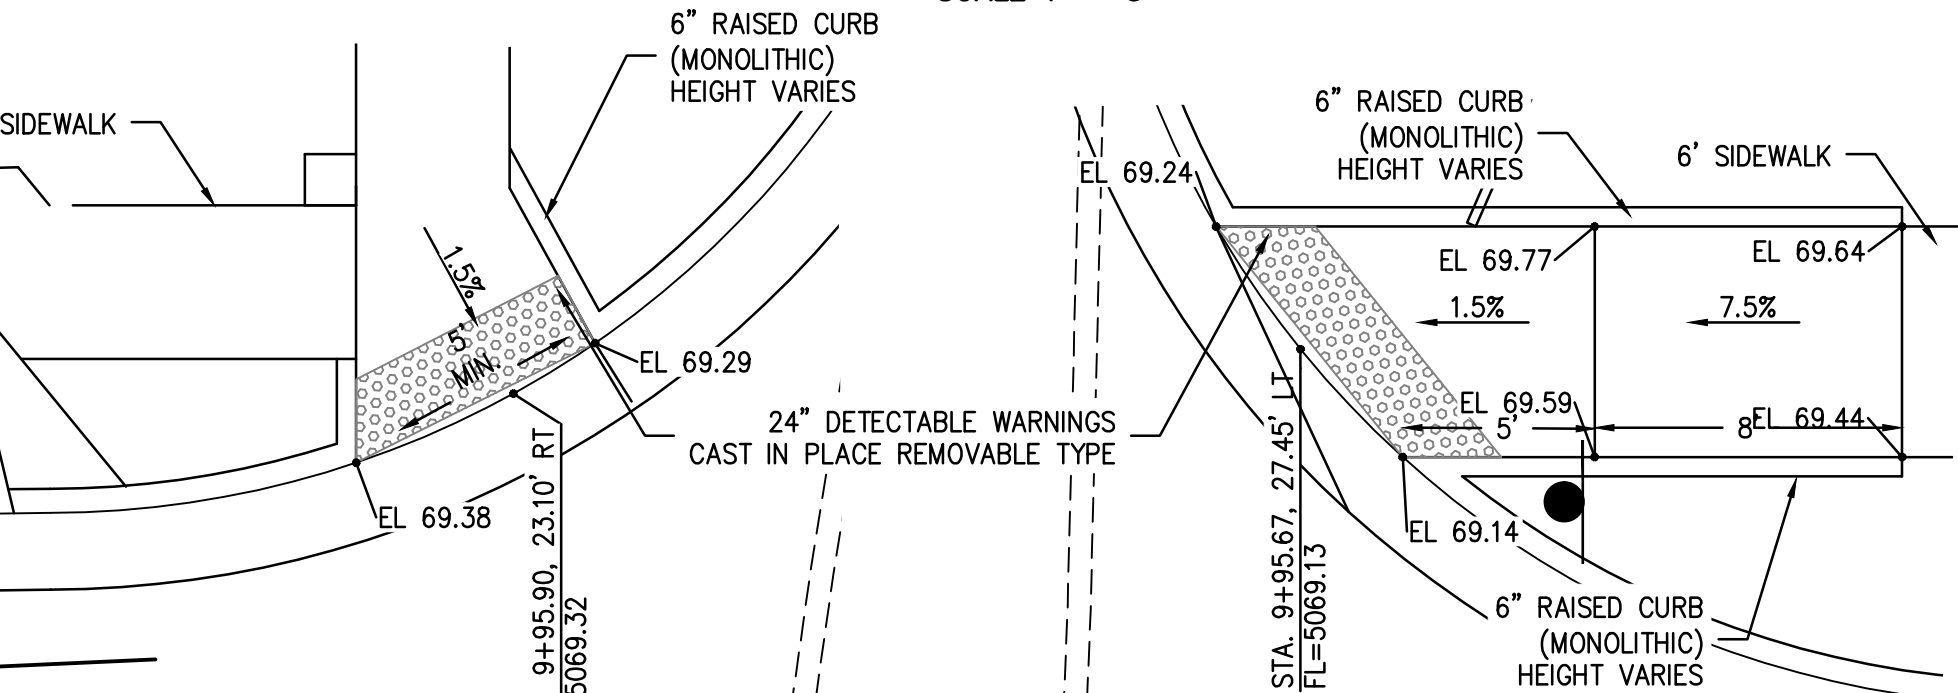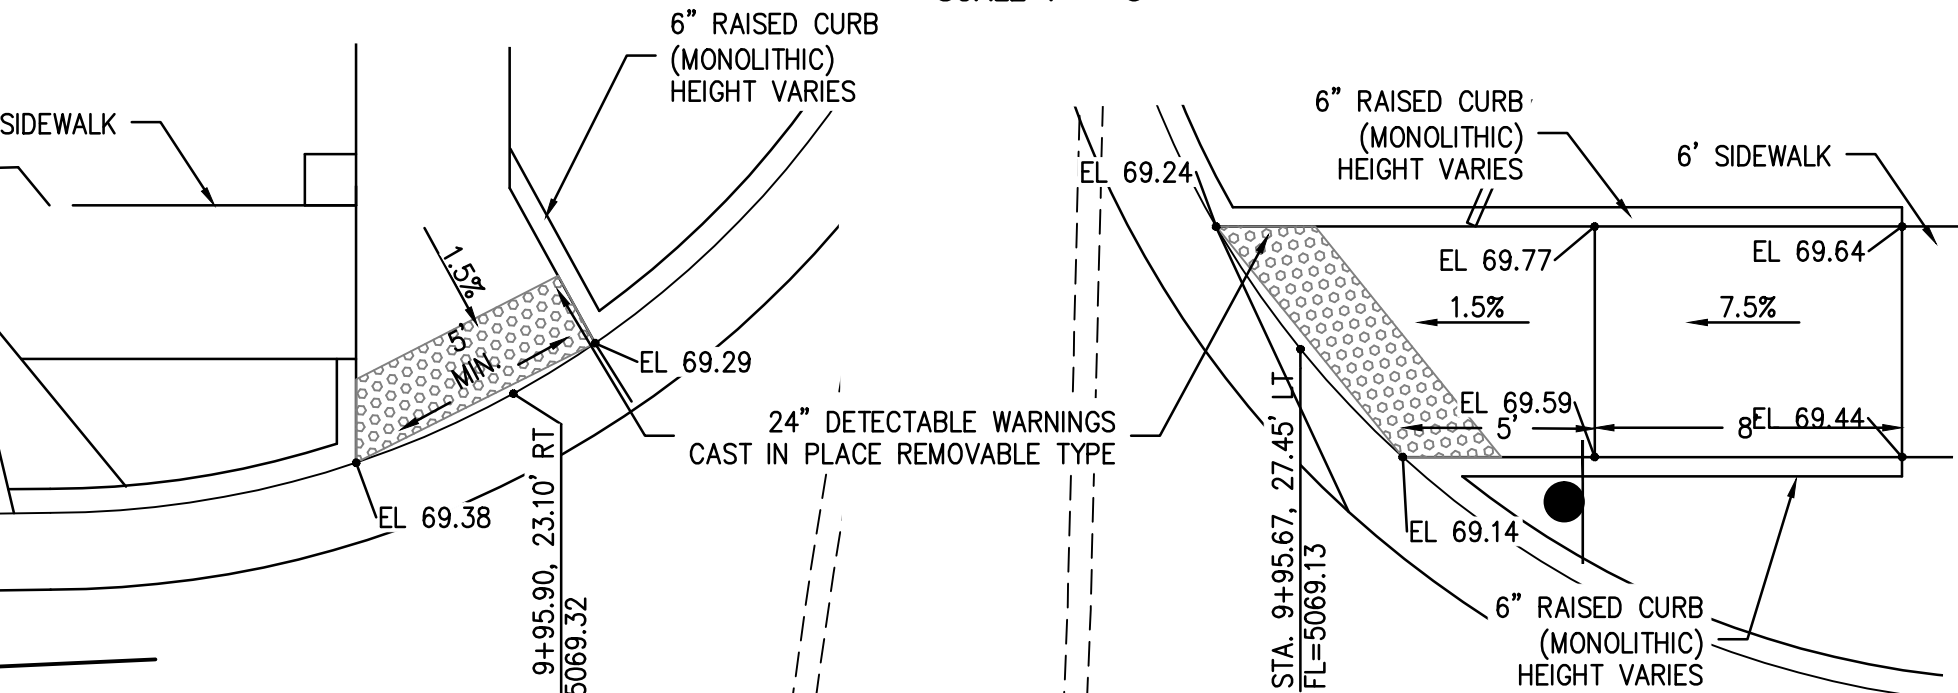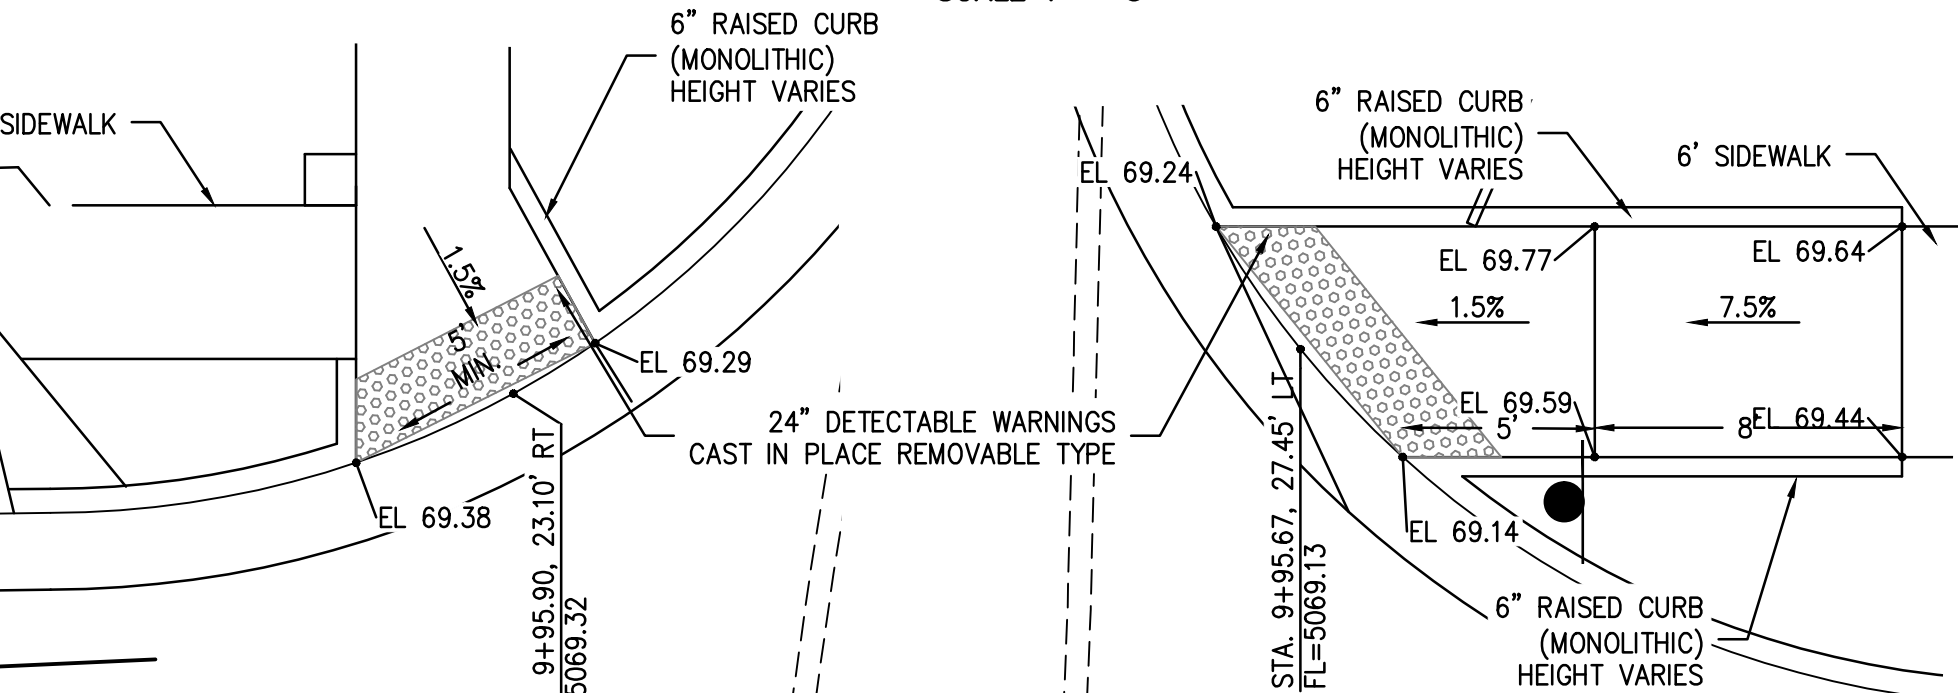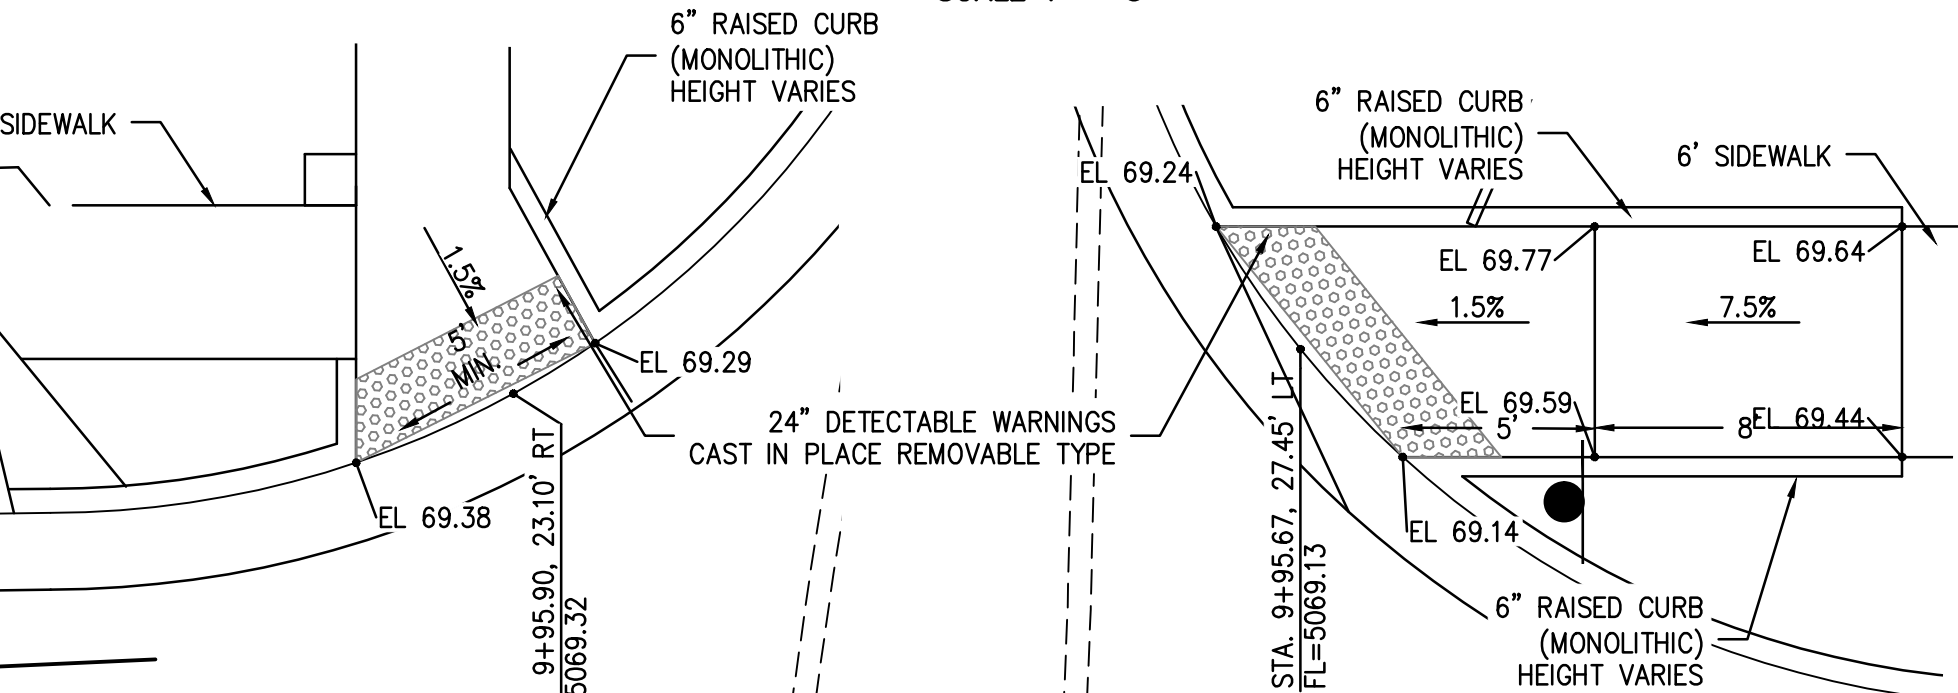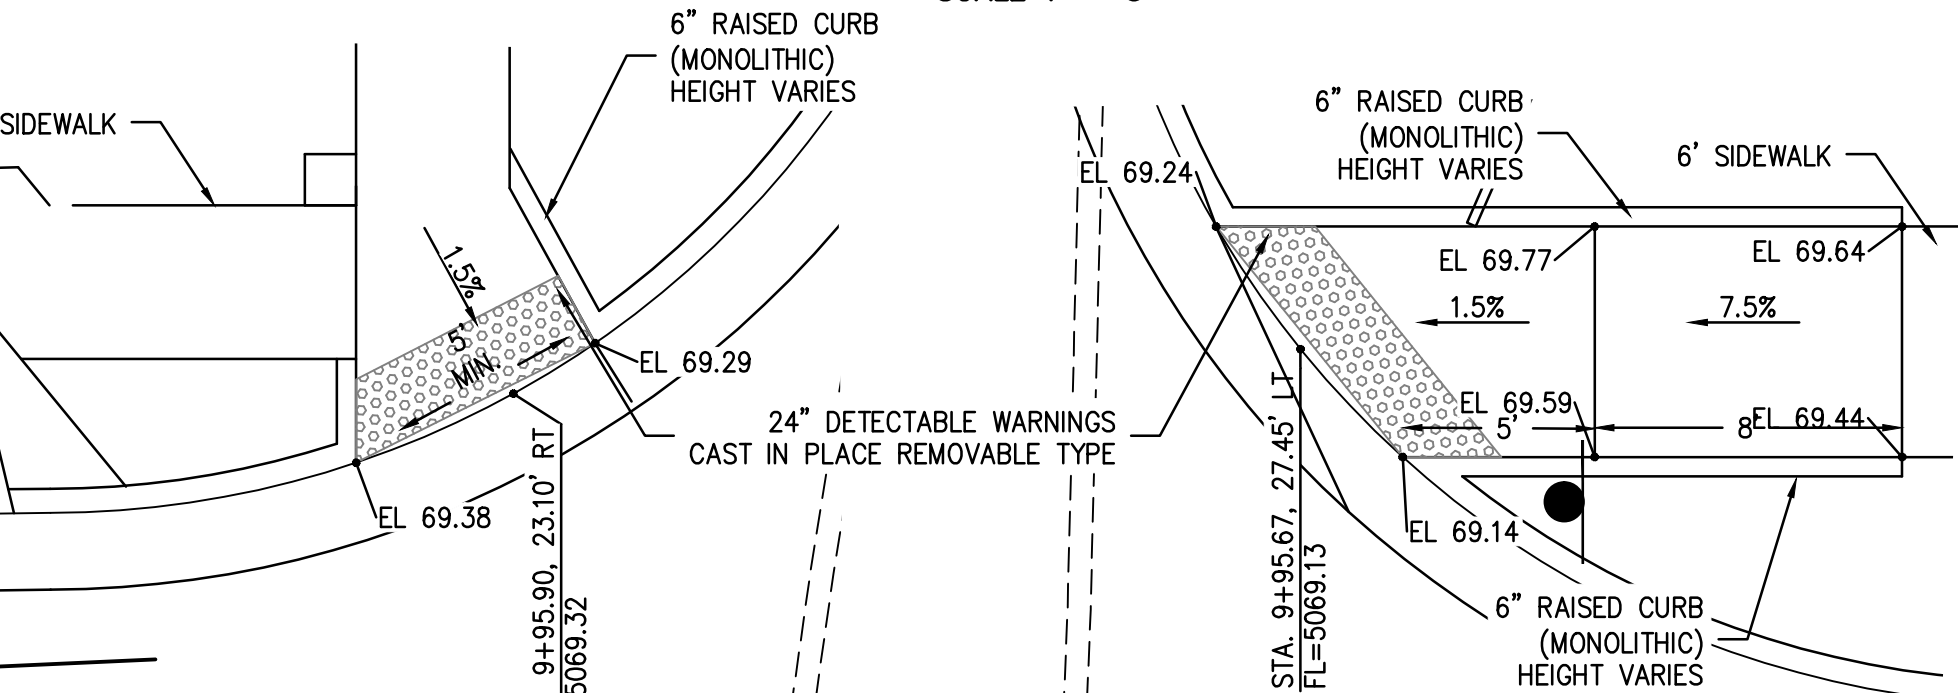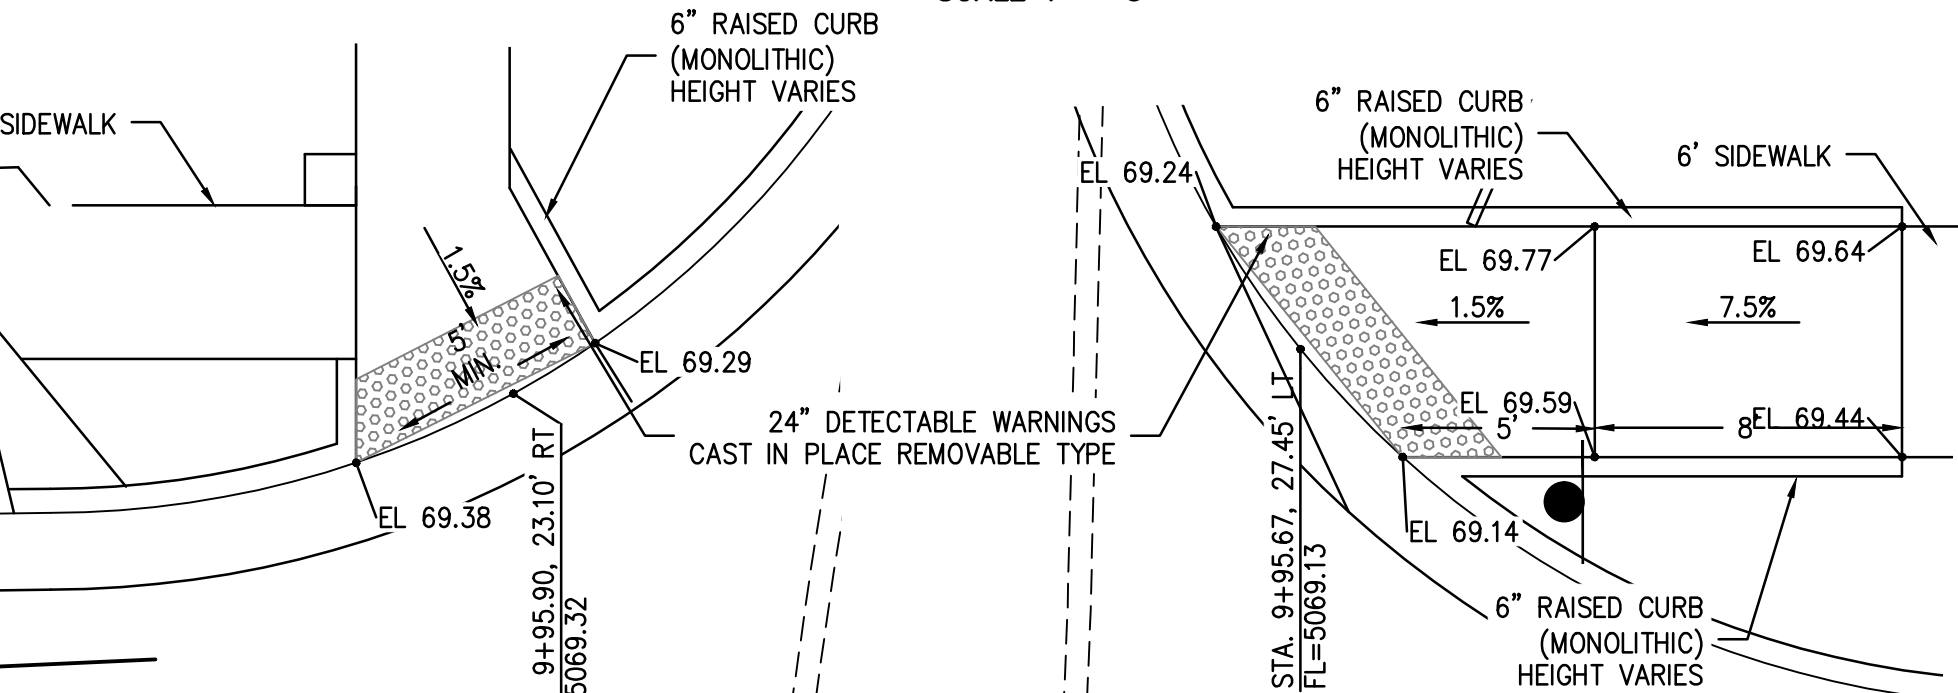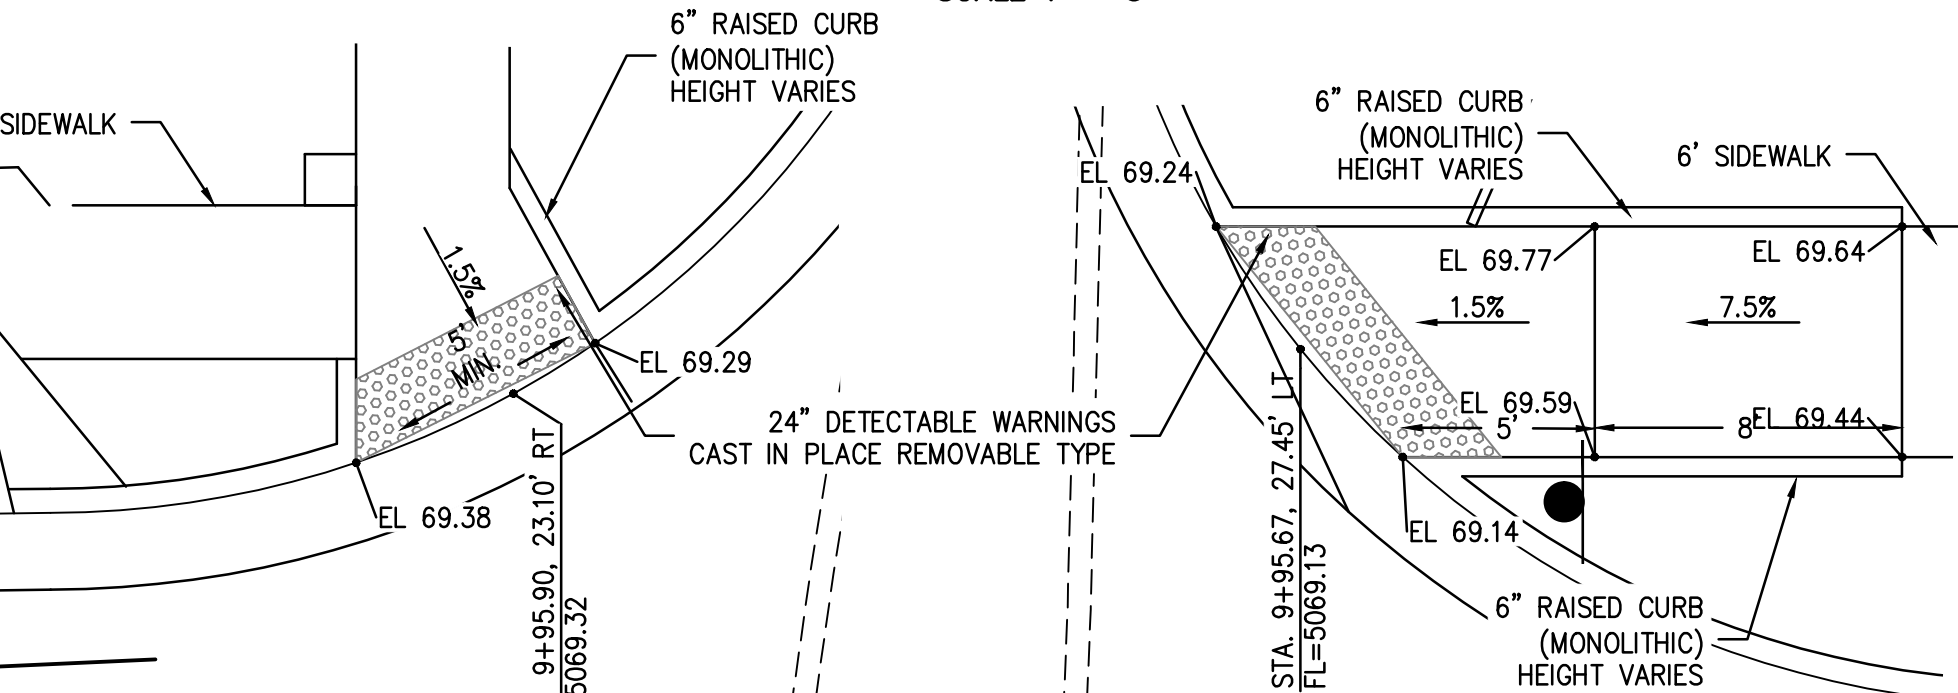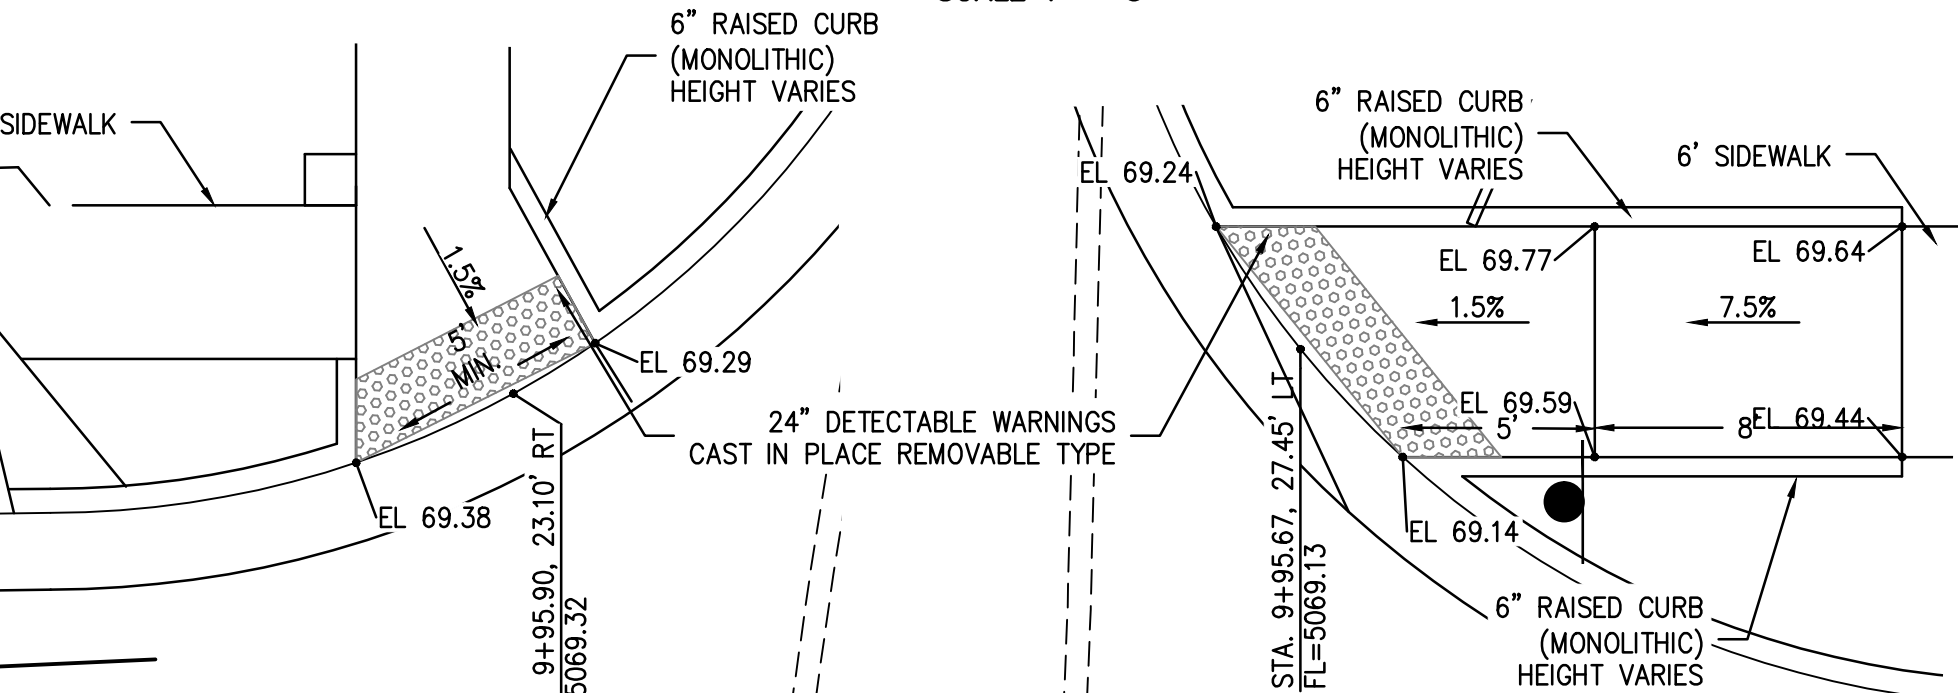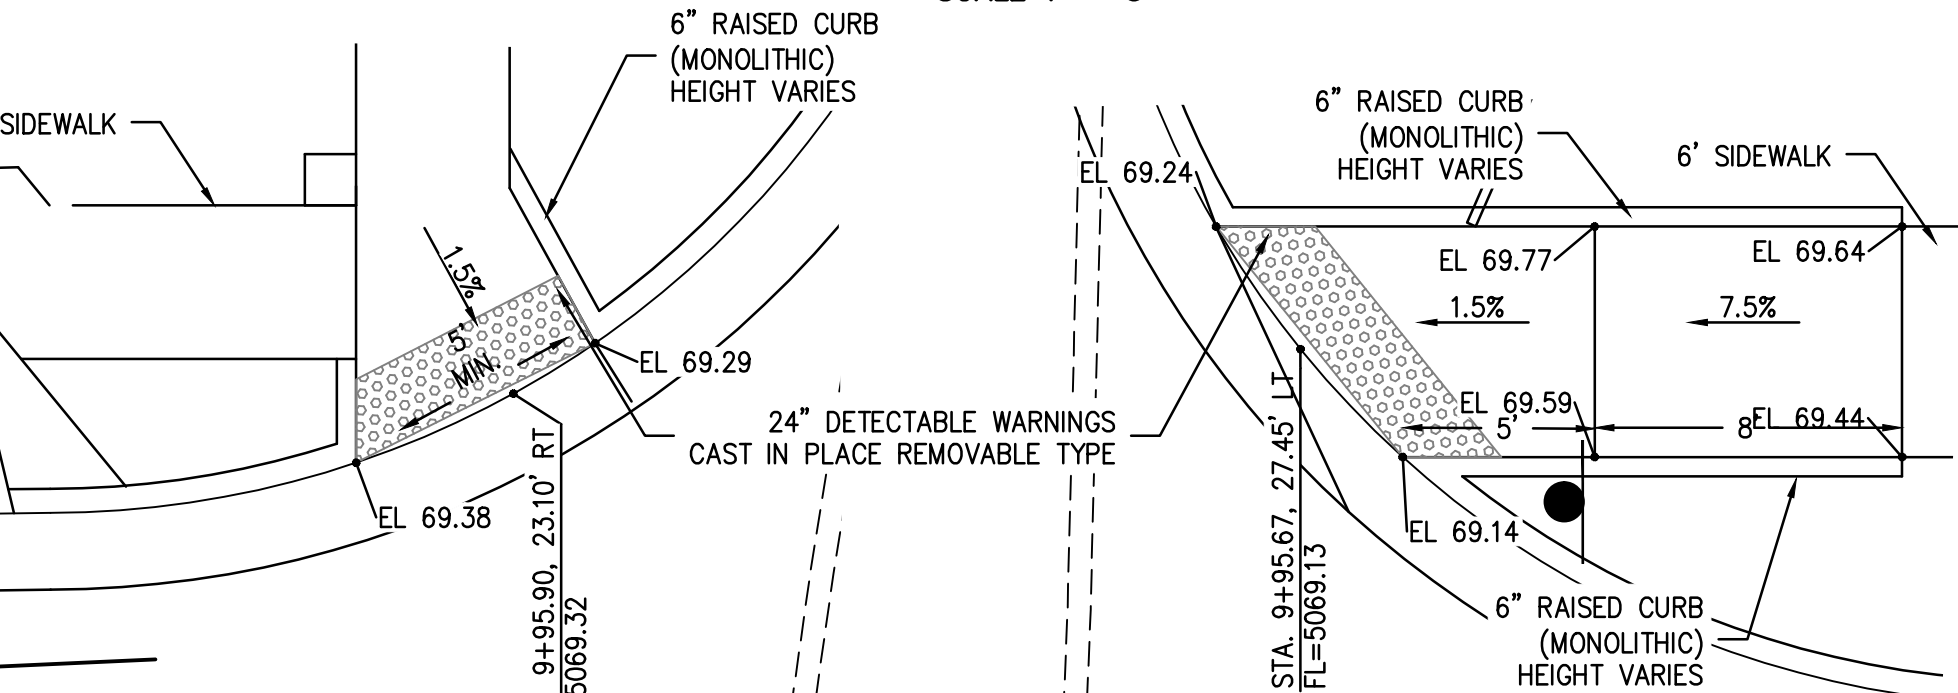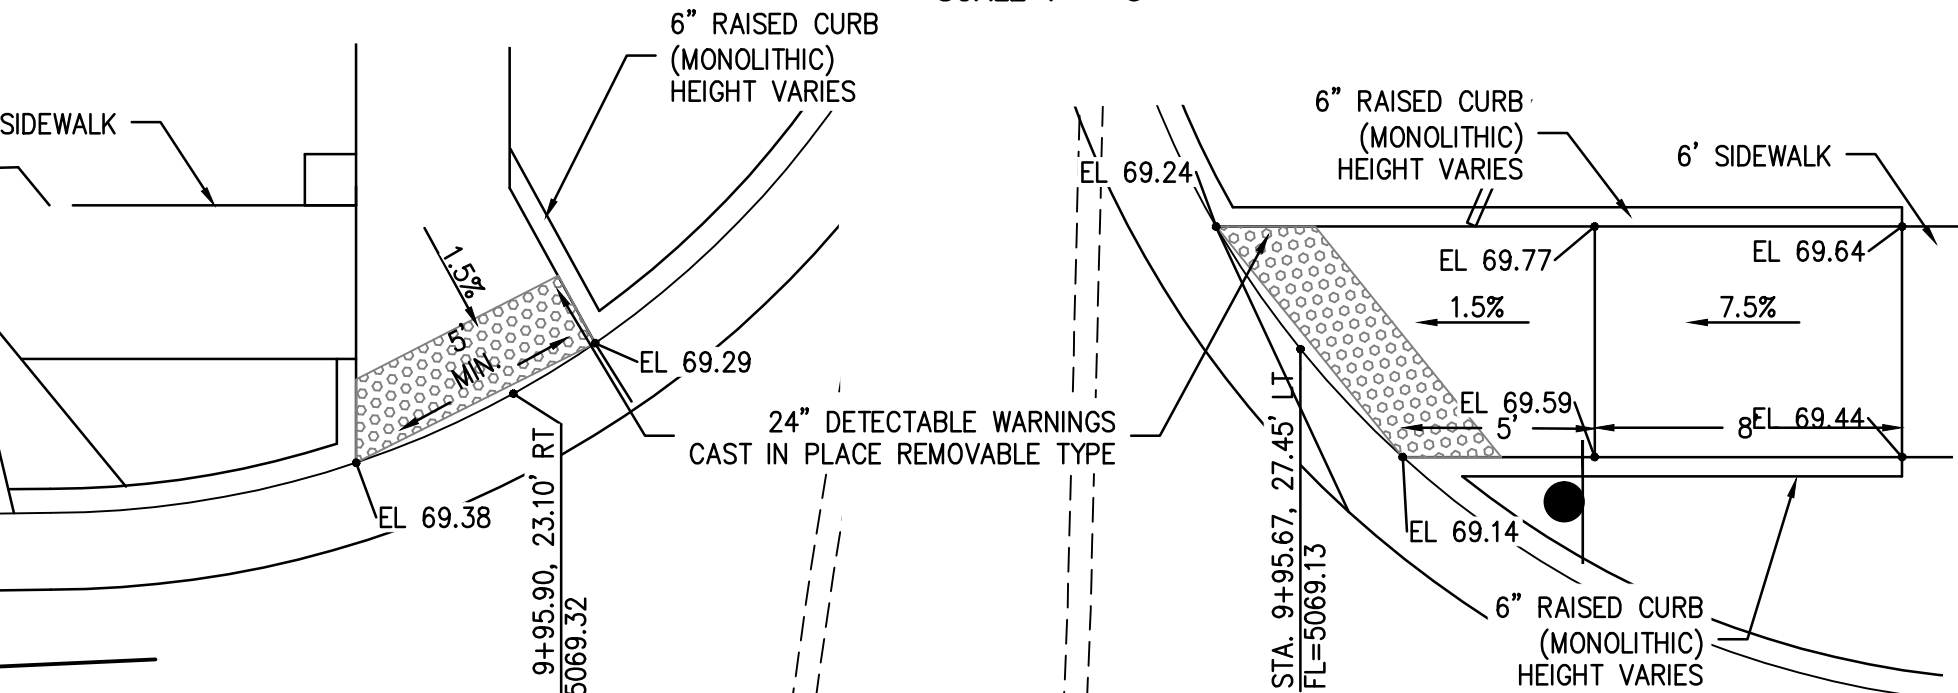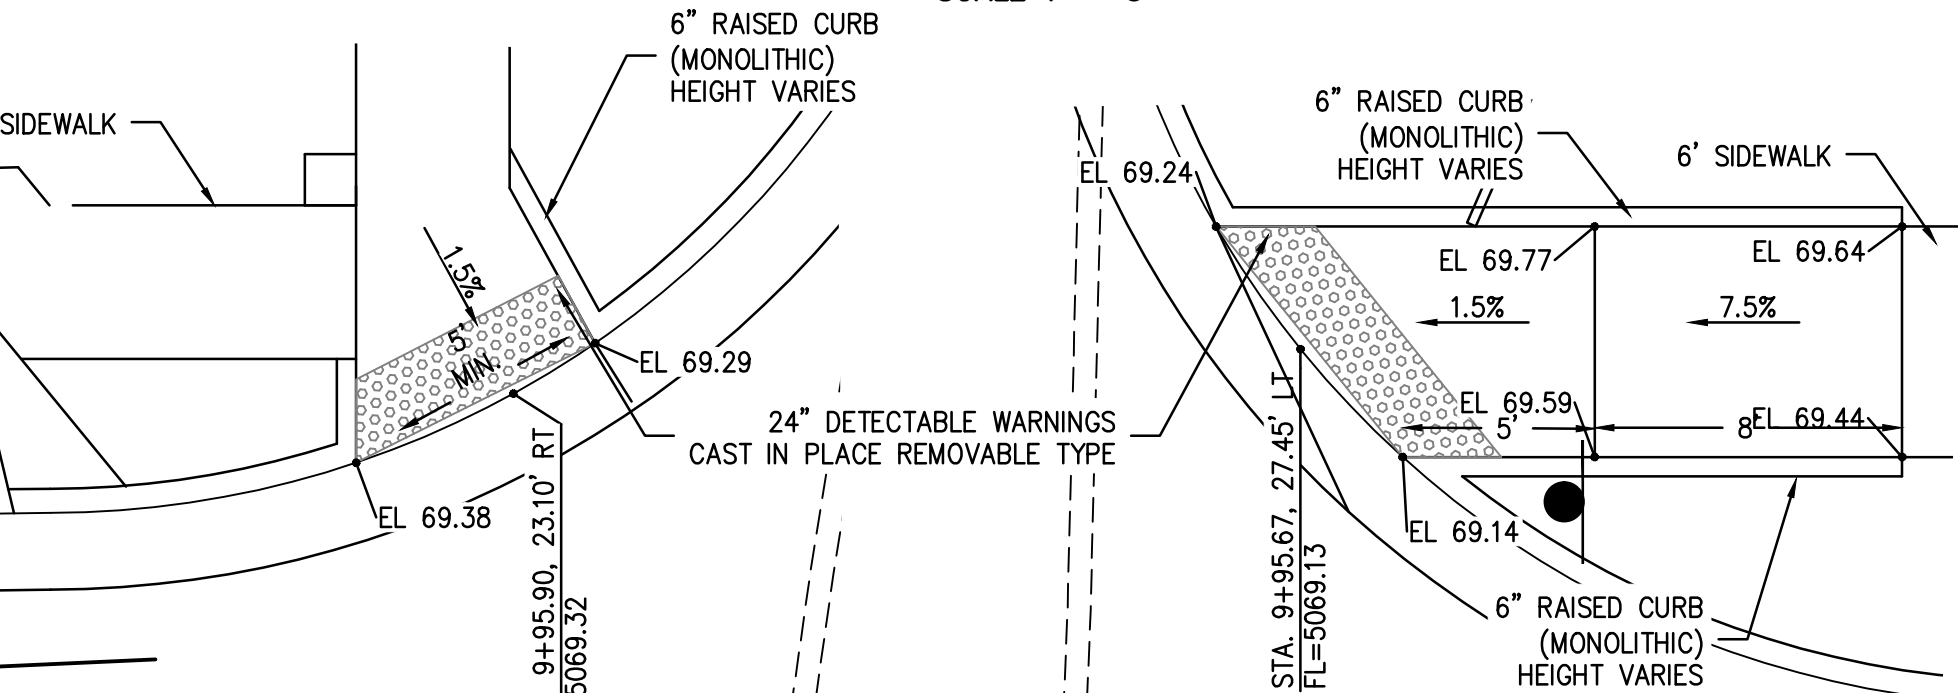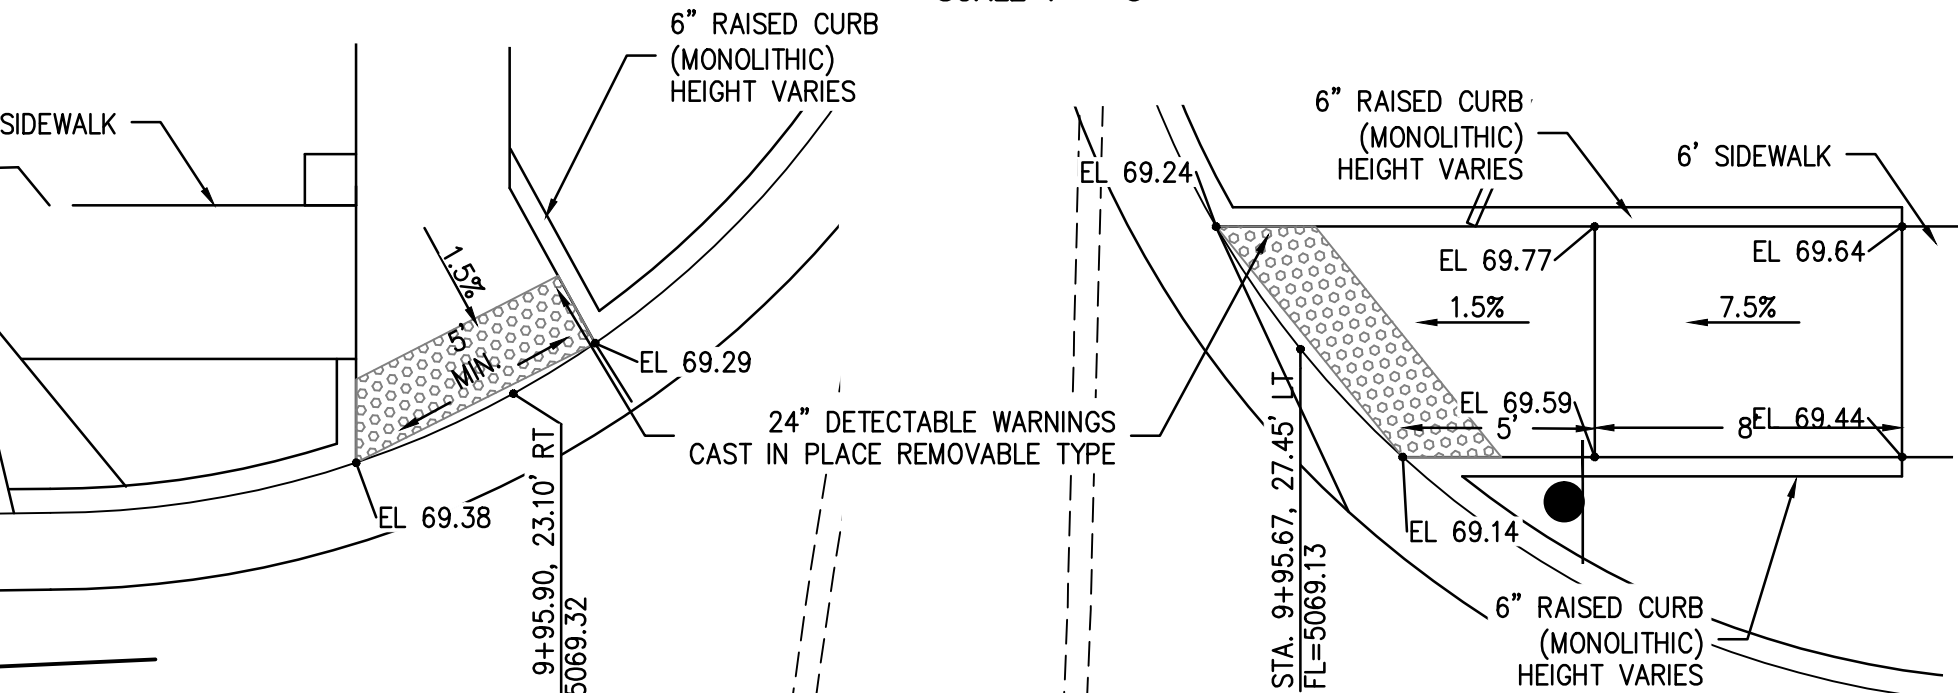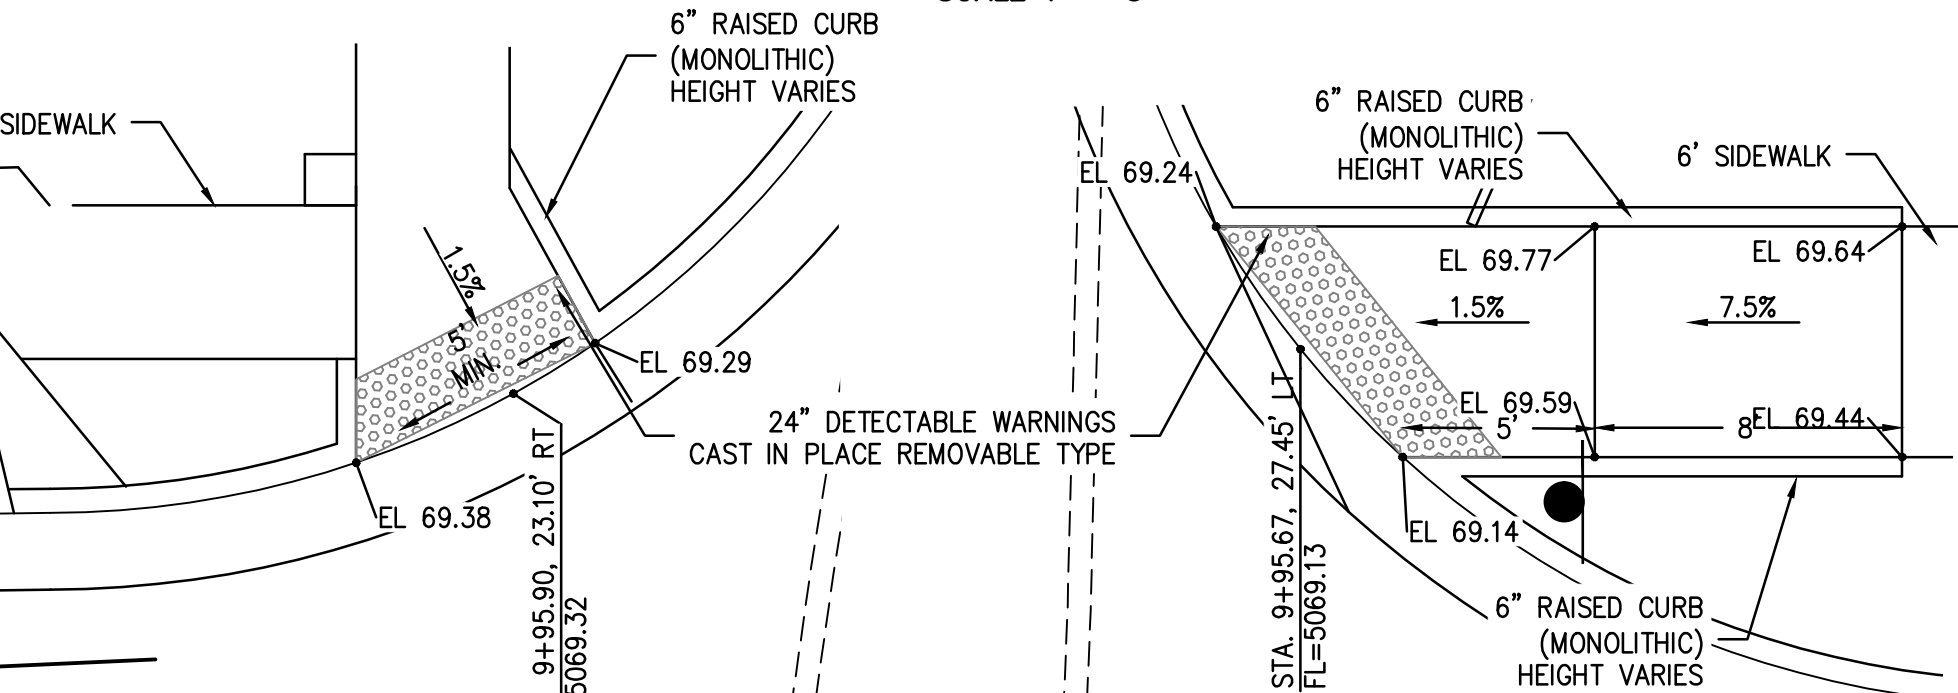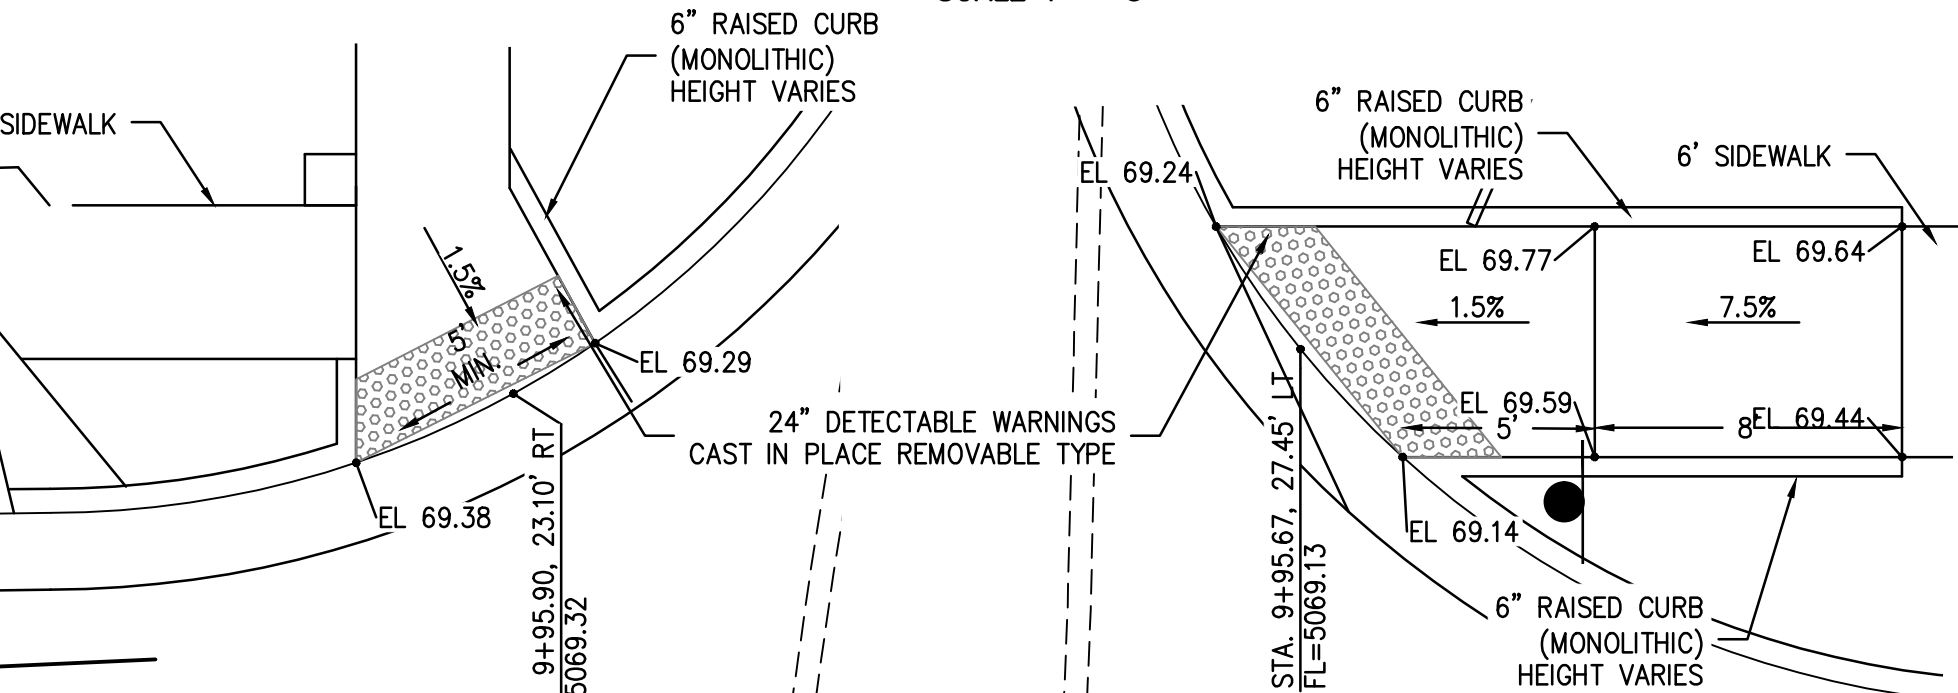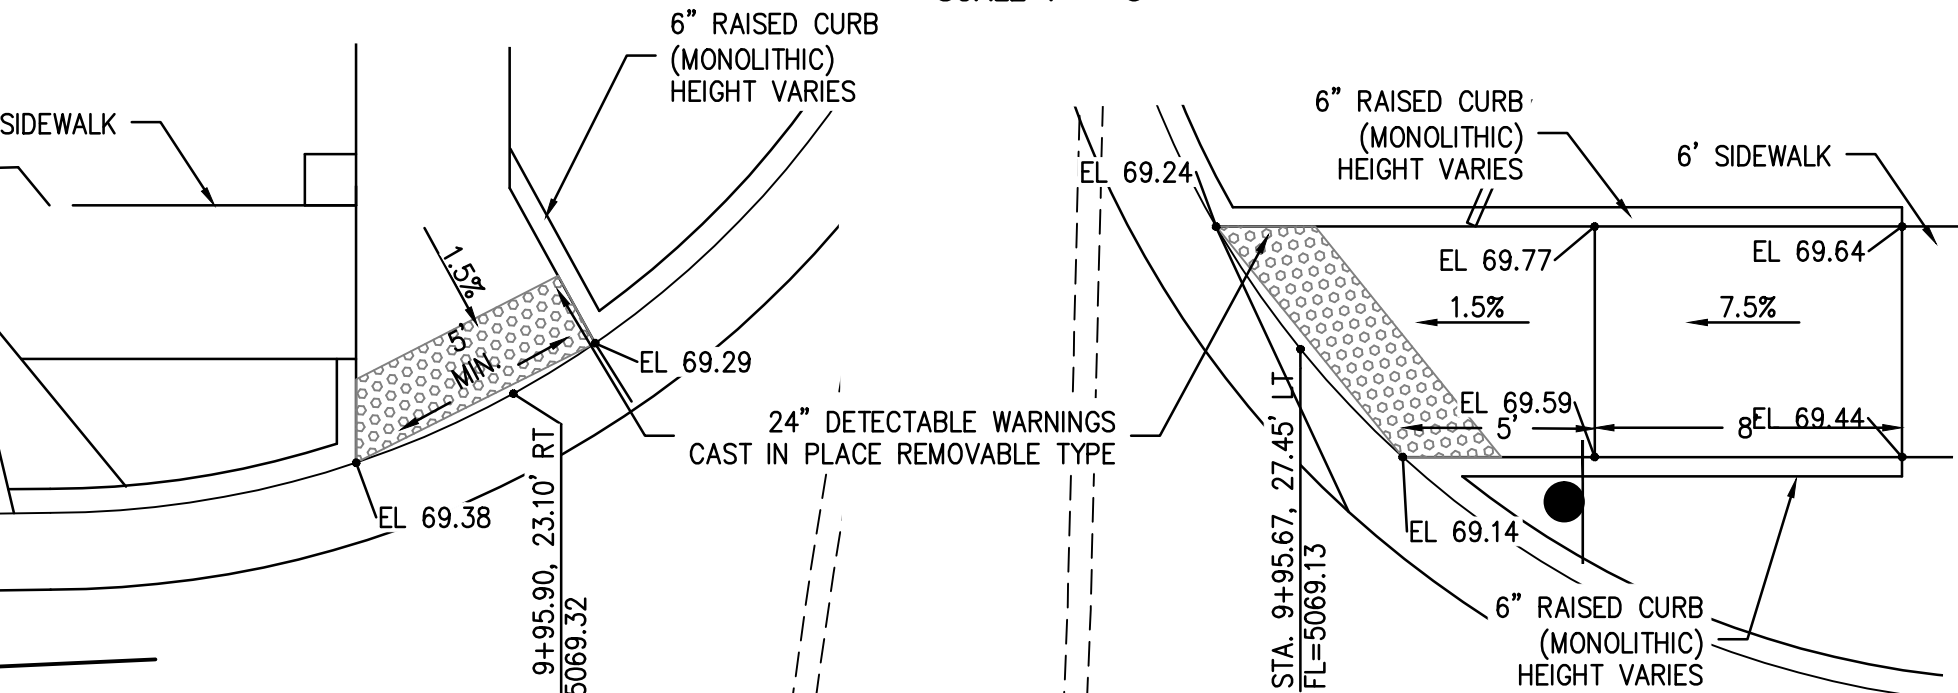


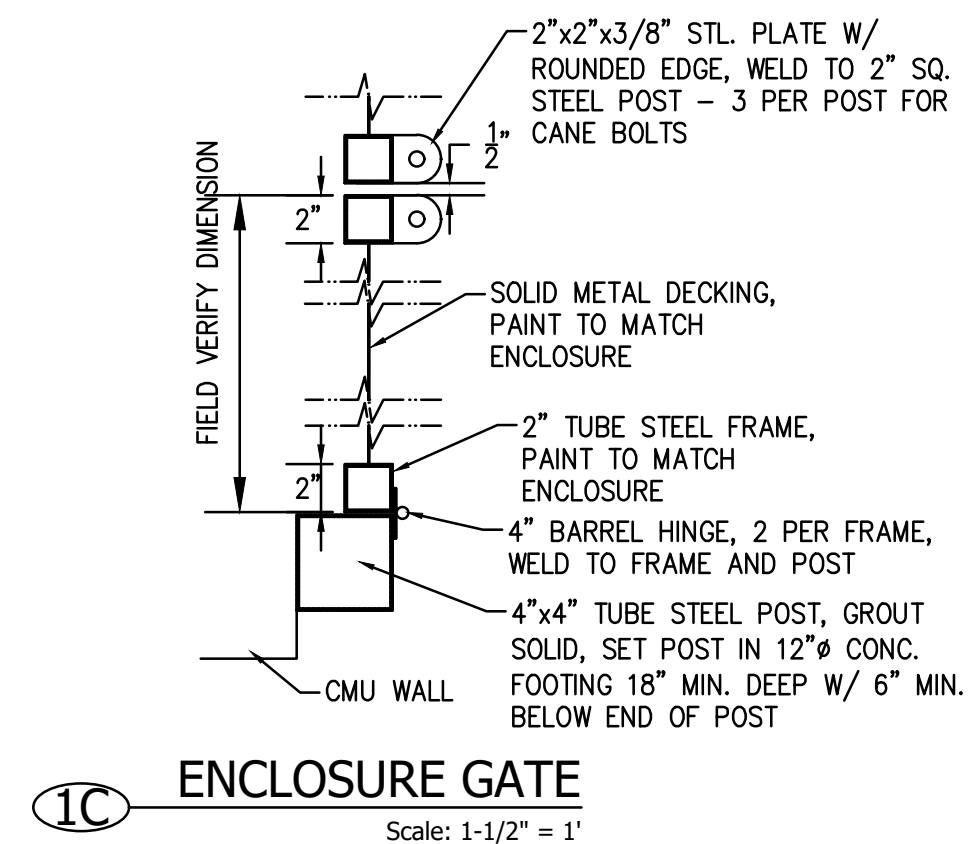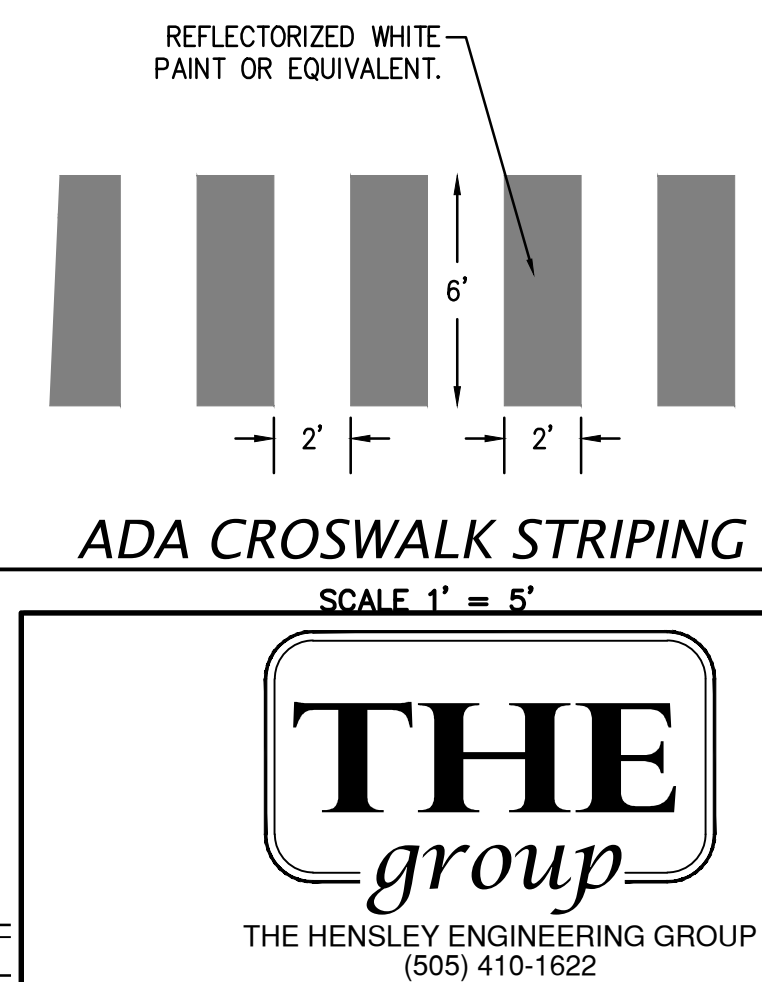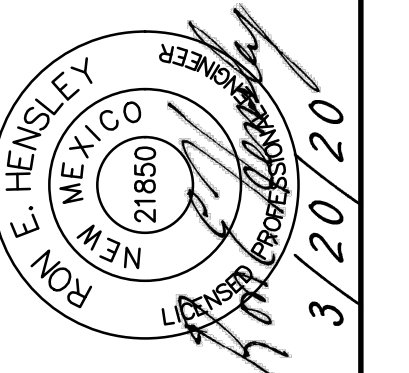[illegible]

HORIZON VILLAGE SUBDIVISION
PAVING DETAILS
PARKING AND REFUSE ENCLOSURE DETAILS

[illegible]

CITY PROJECT No.	799782	ZONE MAP NO.	C-17	SHEET	10	15
------------------	--------	--------------	------	-------	----	----

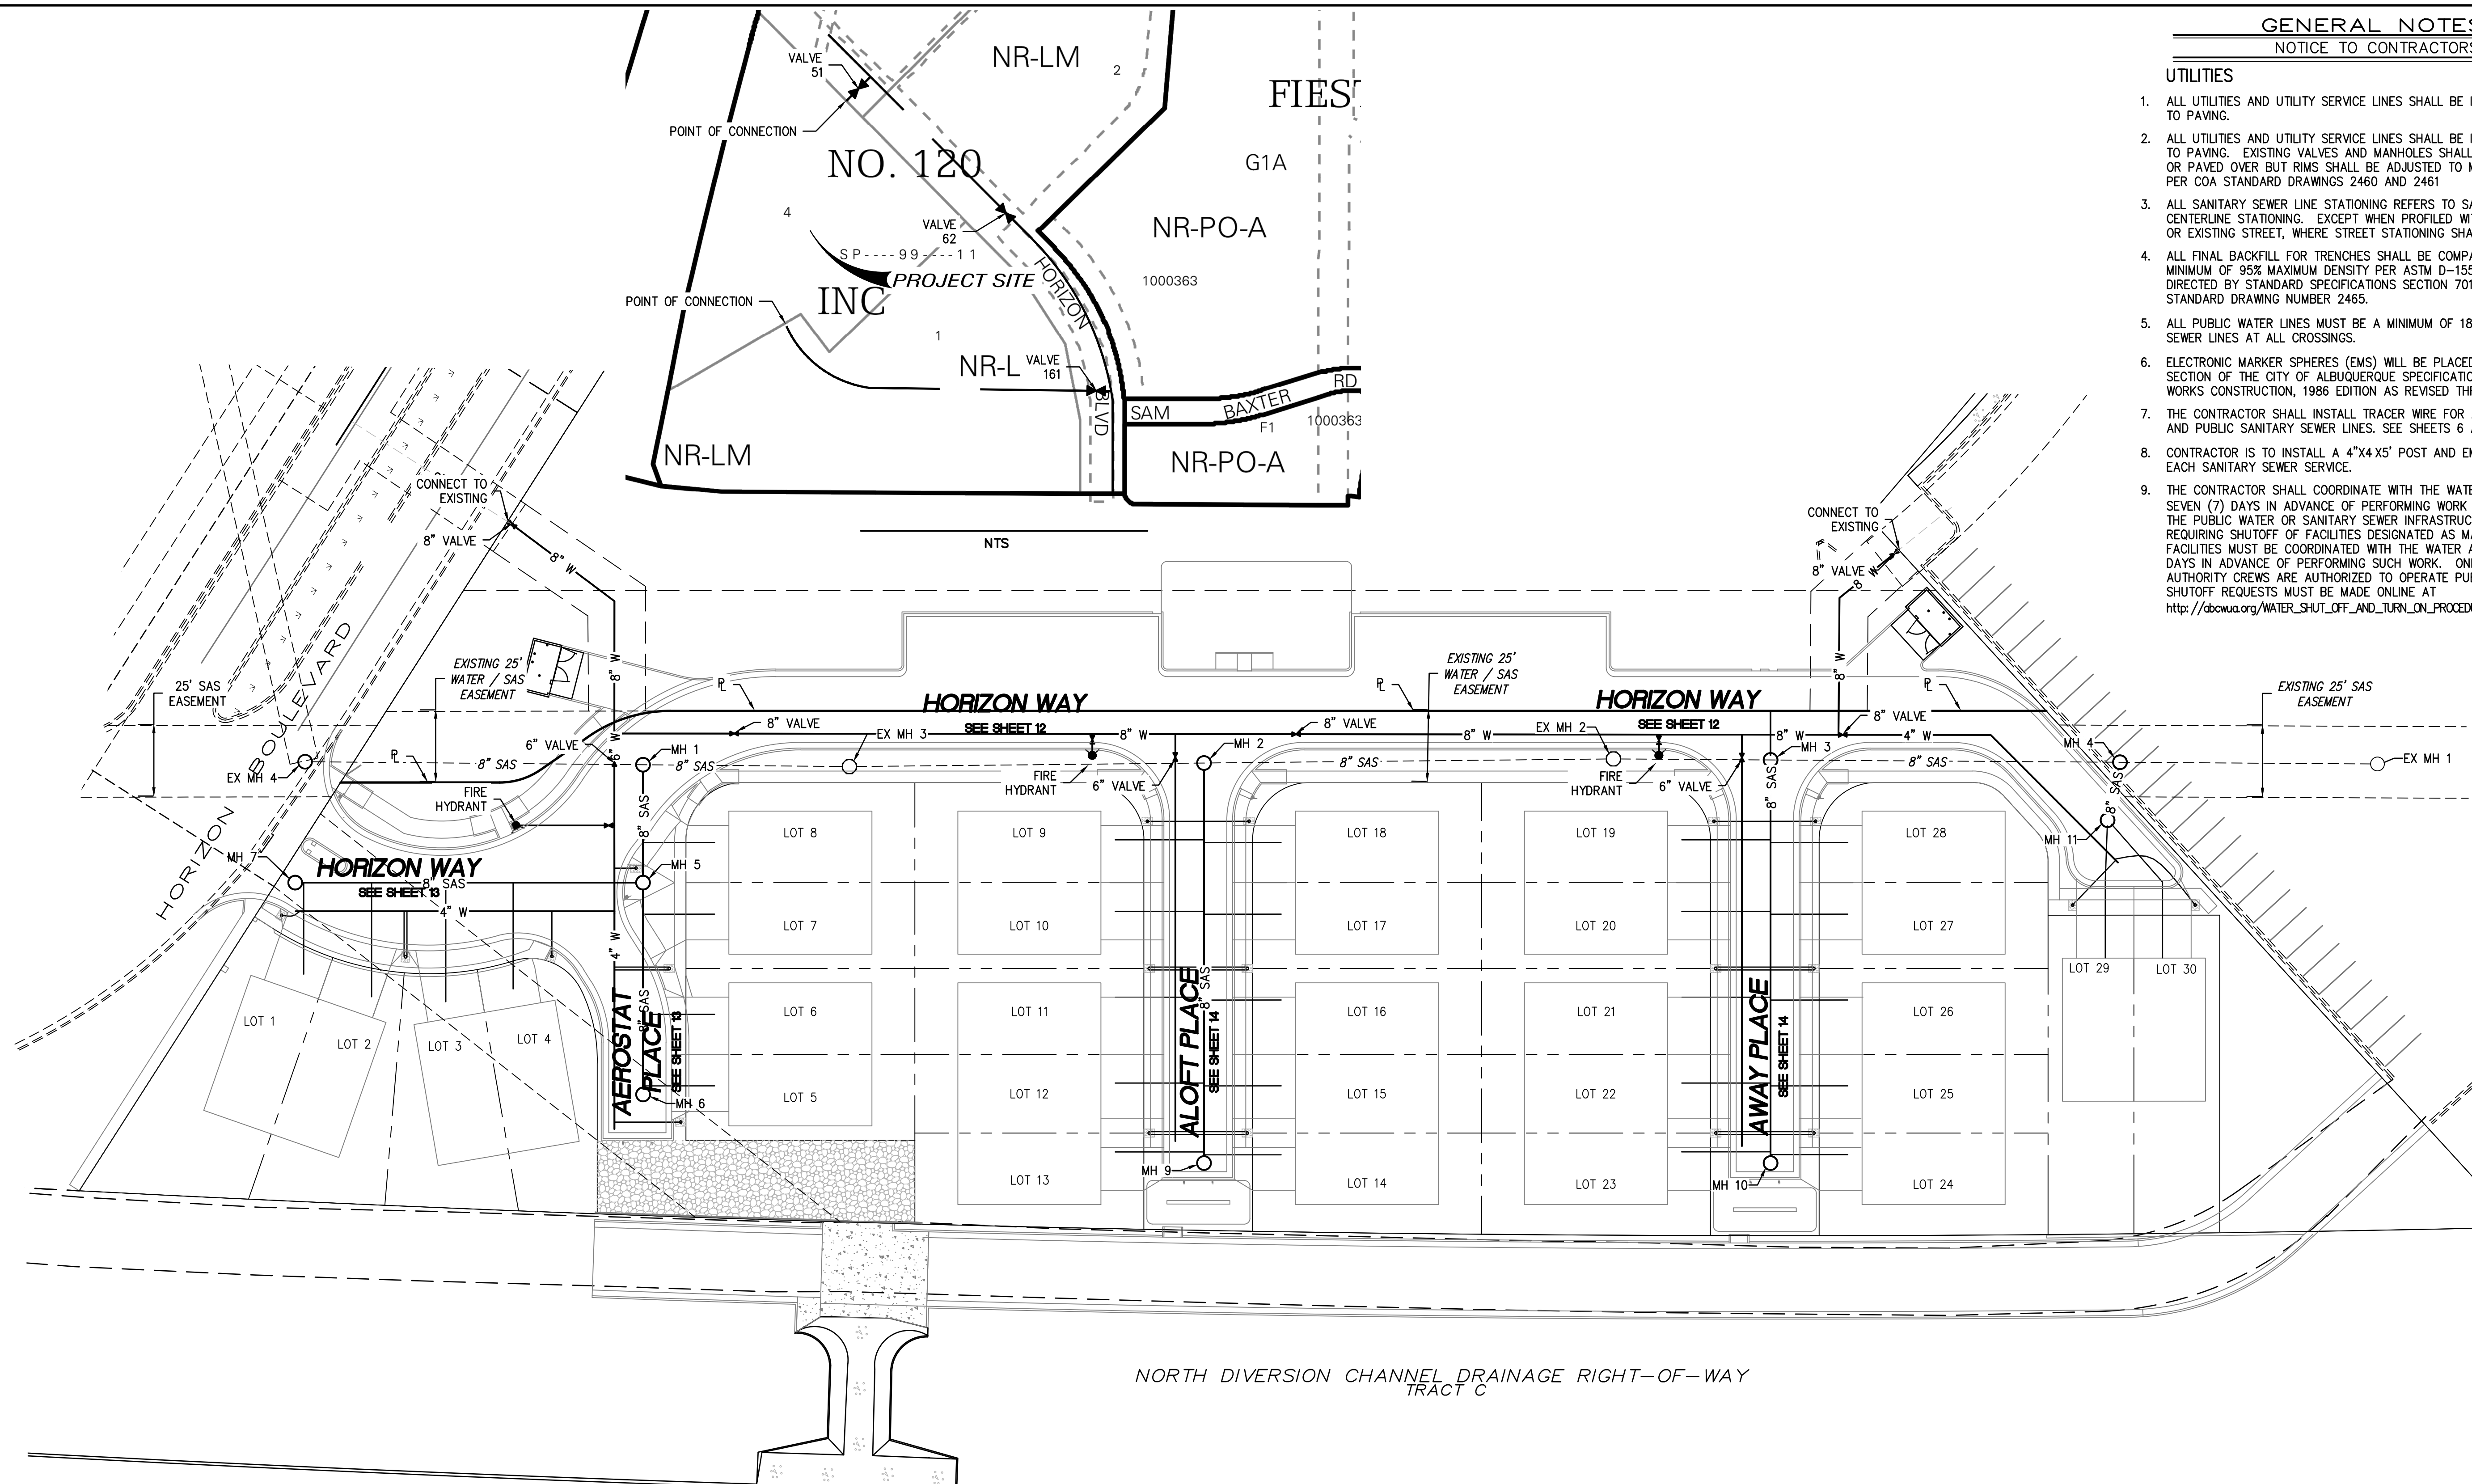

- GENERAL NOTES
NOTICE TO CONTRACTORS
- UTILITIES
1.

ALL UTILITIES AND UTILITY SERVICE LINES SHALL BE INSTALLED PRIOR TO PAVING.
2.

ALL UTILITIES AND UTILITY SERVICE LINES SHALL BE INSTALLED PRIOR TO PAVING. EXISTING VALVES AND MANHOLES SHALL NOT BE BURIED OR PAVED OVER BUT RIMS SHALL BE ADJUSTED TO MATCH NEW GRADE PER COA STANDARD DRAWINGS 2460 AND 2461
3.

ALL SANITARY SEWER LINE STATIONING REFERS TO SANITARY SEWER CENTERLINE STATIONING. EXCEPT WHEN PROFILED WITHIN A PROPOSED OR EXISTING STREET, WHERE STREET STATIONING SHALL GOVERN.
4.

ALL FINAL BACKFILL FOR TRENCHES SHALL BE COMPACTED TO A MINIMUM OF 95% MAXIMUM DENSITY PER ASTM D-1557 AND AS DIRECTED BY STANDARD SPECIFICATIONS SECTION 701.14.2 AND STANDARD DRAWING NUMBER 2465.
5.

ALL PUBLIC WATER LINES MUST BE A MINIMUM OF 18" ABOVE SANITARY SEWER LINES AT ALL CROSSINGS.
6.


ELECTRONIC MARKER SPHERES (EMS) WILL BE PLACED ACCORDING TO SECTION OF THE CITY OF ALBUQUERQUE SPECIFICATIONS FOR PUBLIC WORKS CONSTRUCTION, 1986 EDITION AS REVISED THROUGH UPDATE #9.
7.

THE CONTRACTOR SHALL INSTALL TRACER WIRE FOR ALL PUBLIC WATER AND PUBLIC SANITARY SEWER LINES. SEE SHEETS 6 AND 7
8.

CONTRACTOR IS TO INSTALL A 4"x4"x5' POST AND EMS AT THE END OF EACH SANITARY SEWER SERVICE.
9.

THE CONTRACTOR SHALL COORDINATE WITH THE WATER AUTHORITY SEVEN (7) DAYS IN ADVANCE OF PERFORMING WORK THAT WILL AFFECT THE PUBLIC WATER OR SANITARY SEWER INFRASTRUCTURE. WORK REQUIRING SHUTOFF OF FACILITIES DESIGNATED AS MASTER PLAN FACILITIES MUST BE COORDINATED WITH THE WATER AUTHORITY 14 DAYS IN ADVANCE OF PERFORMING SUCH WORK. ONLY WATER AUTHORITY CREWS ARE AUTHORIZED TO OPERATE PUBLIC VALVES. SHUTOFF REQUESTS MUST BE MADE ONLINE AT http://abowua.org/WATER_SHUT_OFF_AND_TURN_ON_PROCEDURES.ASPX

- LEGEND
- PROP FIRE HYDRANT
- PROP WATER VALVE
- EX SAS MANHOLE
- PROP SAS MANHOLE
- PROP WATER METER
- PROPOSED SANITARY SEWER LINE
- EX SANITARY SEWER LINE
- PROPOSED WATER LINE
- EX WATER LINE

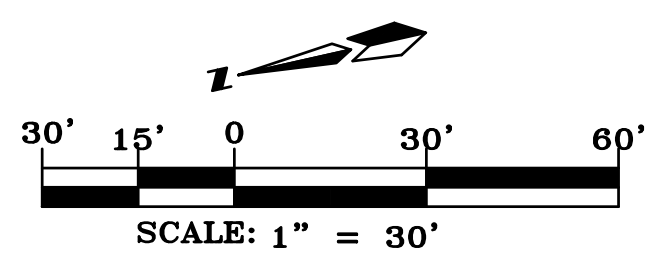

THE

HORIZON VILLAGE SUBDIVISION
GENERAL UTILITY
GENERAL UTILITY NOTES AND SHEET MAP

DESIGN REVIEW COMMITTEE

CITY ENGINEER APPROVAL

CITY PROJECT NO. 799782

ZONE MAP NO. C-17

SHEET 11 OF 15

AS BUILT INFORMATION				BENCH MARKS				SURVEY INFORMATION				ENGINEER'S SEAL			
CONTRACTOR	DATE	BY	DATE	CONTRACTOR	DATE	BY	DATE	NO.	DATE	BY	DATE	NO.	DATE	BY	DATE
STAKED BY	DATE	BY	DATE	NO.	DATE	BY	DATE	NO.	DATE	BY	DATE	NO.	DATE	BY	DATE
INSPECTED BY	DATE	BY	DATE	NO.	DATE	BY	DATE	NO.	DATE	BY	DATE	NO.	DATE	BY	DATE
FIELD CHANGE BY	DATE	BY	DATE	NO.	DATE	BY	DATE	NO.	DATE	BY	DATE	NO.	DATE	BY	DATE
VERIFICATION BY	DATE	BY	DATE	NO.	DATE	BY	DATE	NO.	DATE	BY	DATE	NO.	DATE	BY	DATE
CORRECTED BY	DATE	BY	DATE	NO.	DATE	BY	DATE	NO.	DATE	BY	DATE	NO.	DATE	BY	DATE
MICRO-FILM INFORMATION				REVISIONS				DESIGN				REVISIONS			
RECORDED BY				DESIGNED BY				DESIGNED BY				DESIGNED BY			
NO.				DATE				DATE				DATE			
DATE				DATE				DATE				DATE			
DATE				DATE				DATE				DATE			
DATE															

RESTRAINING JOINT TABLE / NOTES

RESTRAINED JOINT TABLE		
MECHANICAL JOINT TYPE	DISTANCE FROM FITTING OF JOINTS RESTRAINED	
	PIPE SIZE	PIPE SIZE
6"X8" TEE	6"	4"
6"X6"X6" TEE	6"	4"
45° HORIZ. BEND	7	8
22.5° HORIZ. BEND	4	4
11.25° HORIZ. BEND	2	2
GATE VALVE/CAP	47	55
45° VERT. BEND (UPPER)	18	23
(LOWER)	6	7
22.5° VERT. BEND (UPPER)	9	7
(LOWER)	3	2


- NOTES:
- ALL MECHANICAL JOINTS SHALL BE RESTRAINED AT FITTING.
 - ALL JOINTS WITHIN DISTANCE FROM FITTING SHALL BE RESTRAINED.
 - THE CONTRACTOR SHALL PROVIDE A MINIMUM PIPE LENGTH OF 20 LF FROM ALL MECHANICAL JOINTS. ALL PIPE JOINTS WITHIN 20 LF OF MJ SHALL BE RESTRAINED AT THE CONTRACTORS EXPENSE.
 - THE CONTRACTOR SHALL RESTRAIN ALL PIPE JOINTS IN THE SPECIFIED DISTANCE LISTED IN THE TABLE AT LEFT (SEE NOTE 2 ABOVE).
 - THE CONTRACTOR SHALL RESTRAIN ALL FIRE HYDRANT JOINTS FROM THE TEE ON THE MAIN TO THE FIRE HYDRANT FLANGE.
 - ALL CAPS SHALL UTILIZE PCC BLOCKING, UNLESS OTHERWISE NOTED.
 - RESTRAINED LENGTH IS ON LARGE SIDE WHERE REDUCERS ARE USED.
 - RESTRAIN ALL JOINTS BETWEEN UPPER AND LOWER VERTICAL BENDS.
 - TRACE WIRE ON ALL ABCWUA LINES FIRE HYDRANT LEGS

WATER LINE TABLE		
LINE	LENGTH	BEARING
W1	190.17	S 12°45'29" W
W2	198.00	S 12°45'29" W
W3	33.76	S 12°45'29" W
W4	53.18	S 12°45'29" W


WATER LINE ALIGNMENT INTERSECTION DISTANCE

SEWER CONSTRUCTION NOTES	
I.D.#	DESCRIPTION
1	INSTALL 4' DIA. TYPE "C" MANHOLE PER COA STD. DTL. 2101, 2109


WATER CONSTRUCTION NOTES	
I.D.#	DESCRIPTION
1	INSTALL WATERLINE PER STD. SPEC. SEC. 801
2	INSTALL GATE VALVE AND VALVE BOX PER COA STD. DTL. 2326, 2328
3	INSTALL FIRE HYDRANT PER COA STD. DTL. 2340, 2347
4	INSTALL HYDRANT LEG W/ TRACE WIRE AND "MEG A LUG" ALL FITTINGS AND JOINTS FROM TEE TO FIRE HYDRANT

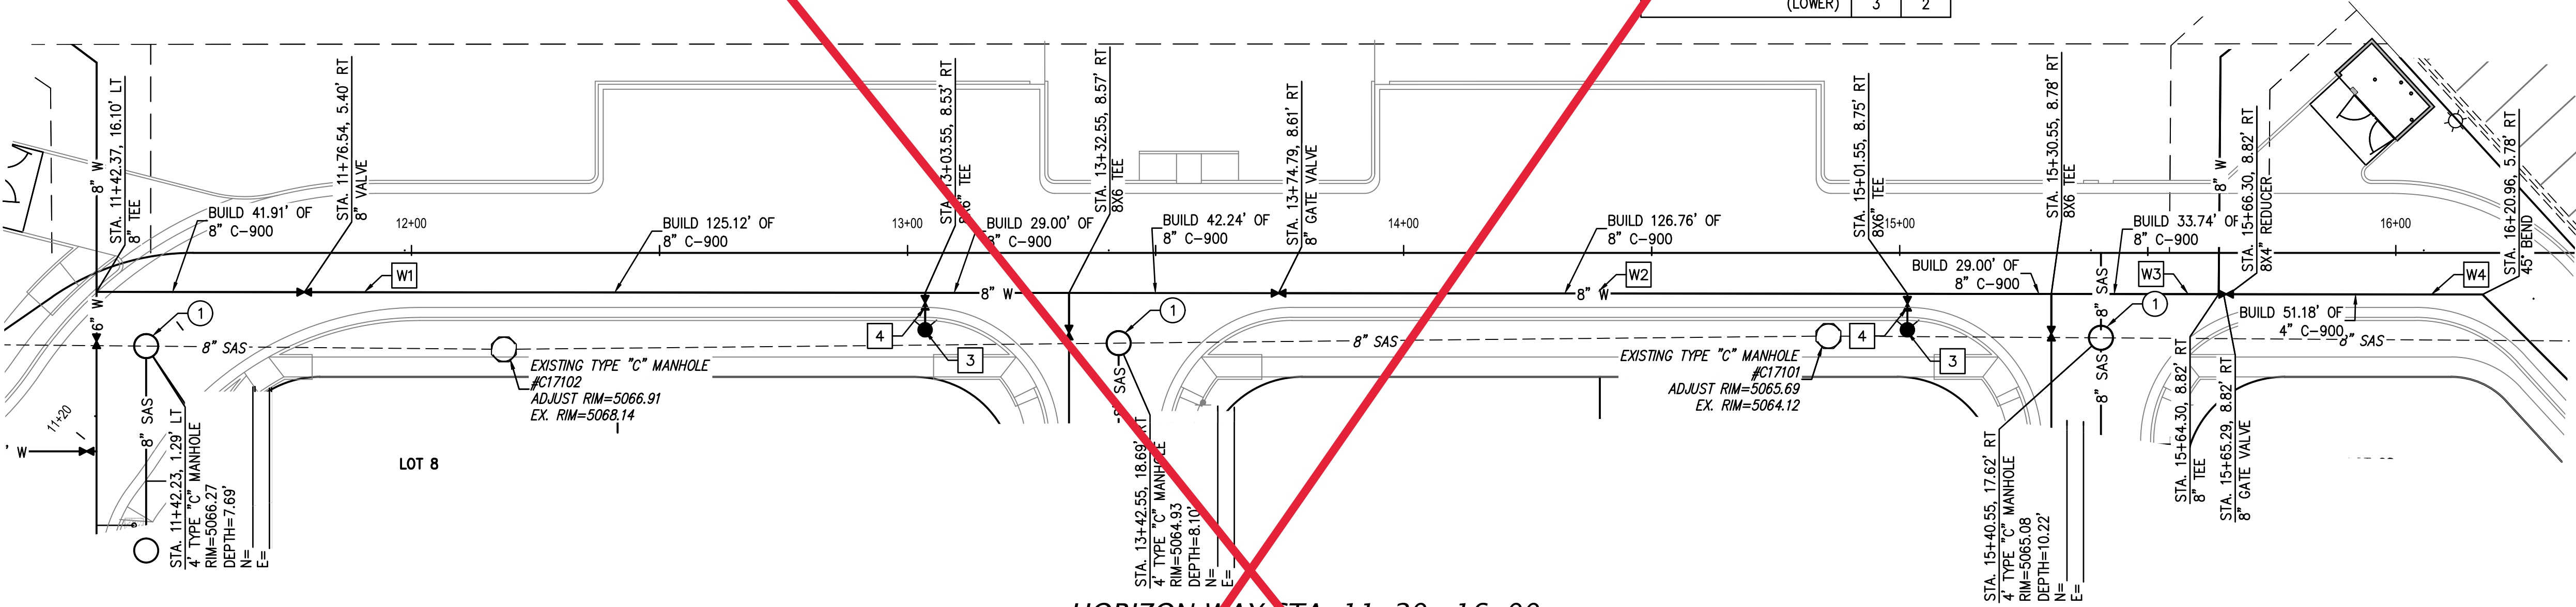

HORIZON WAY STA. 11+20 - 16+00

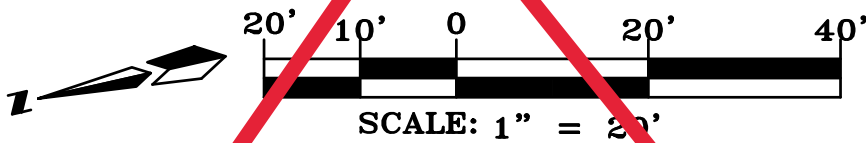

SUPERSEDED -- SEE SHEET 12R, Rev. 9/10/2020.

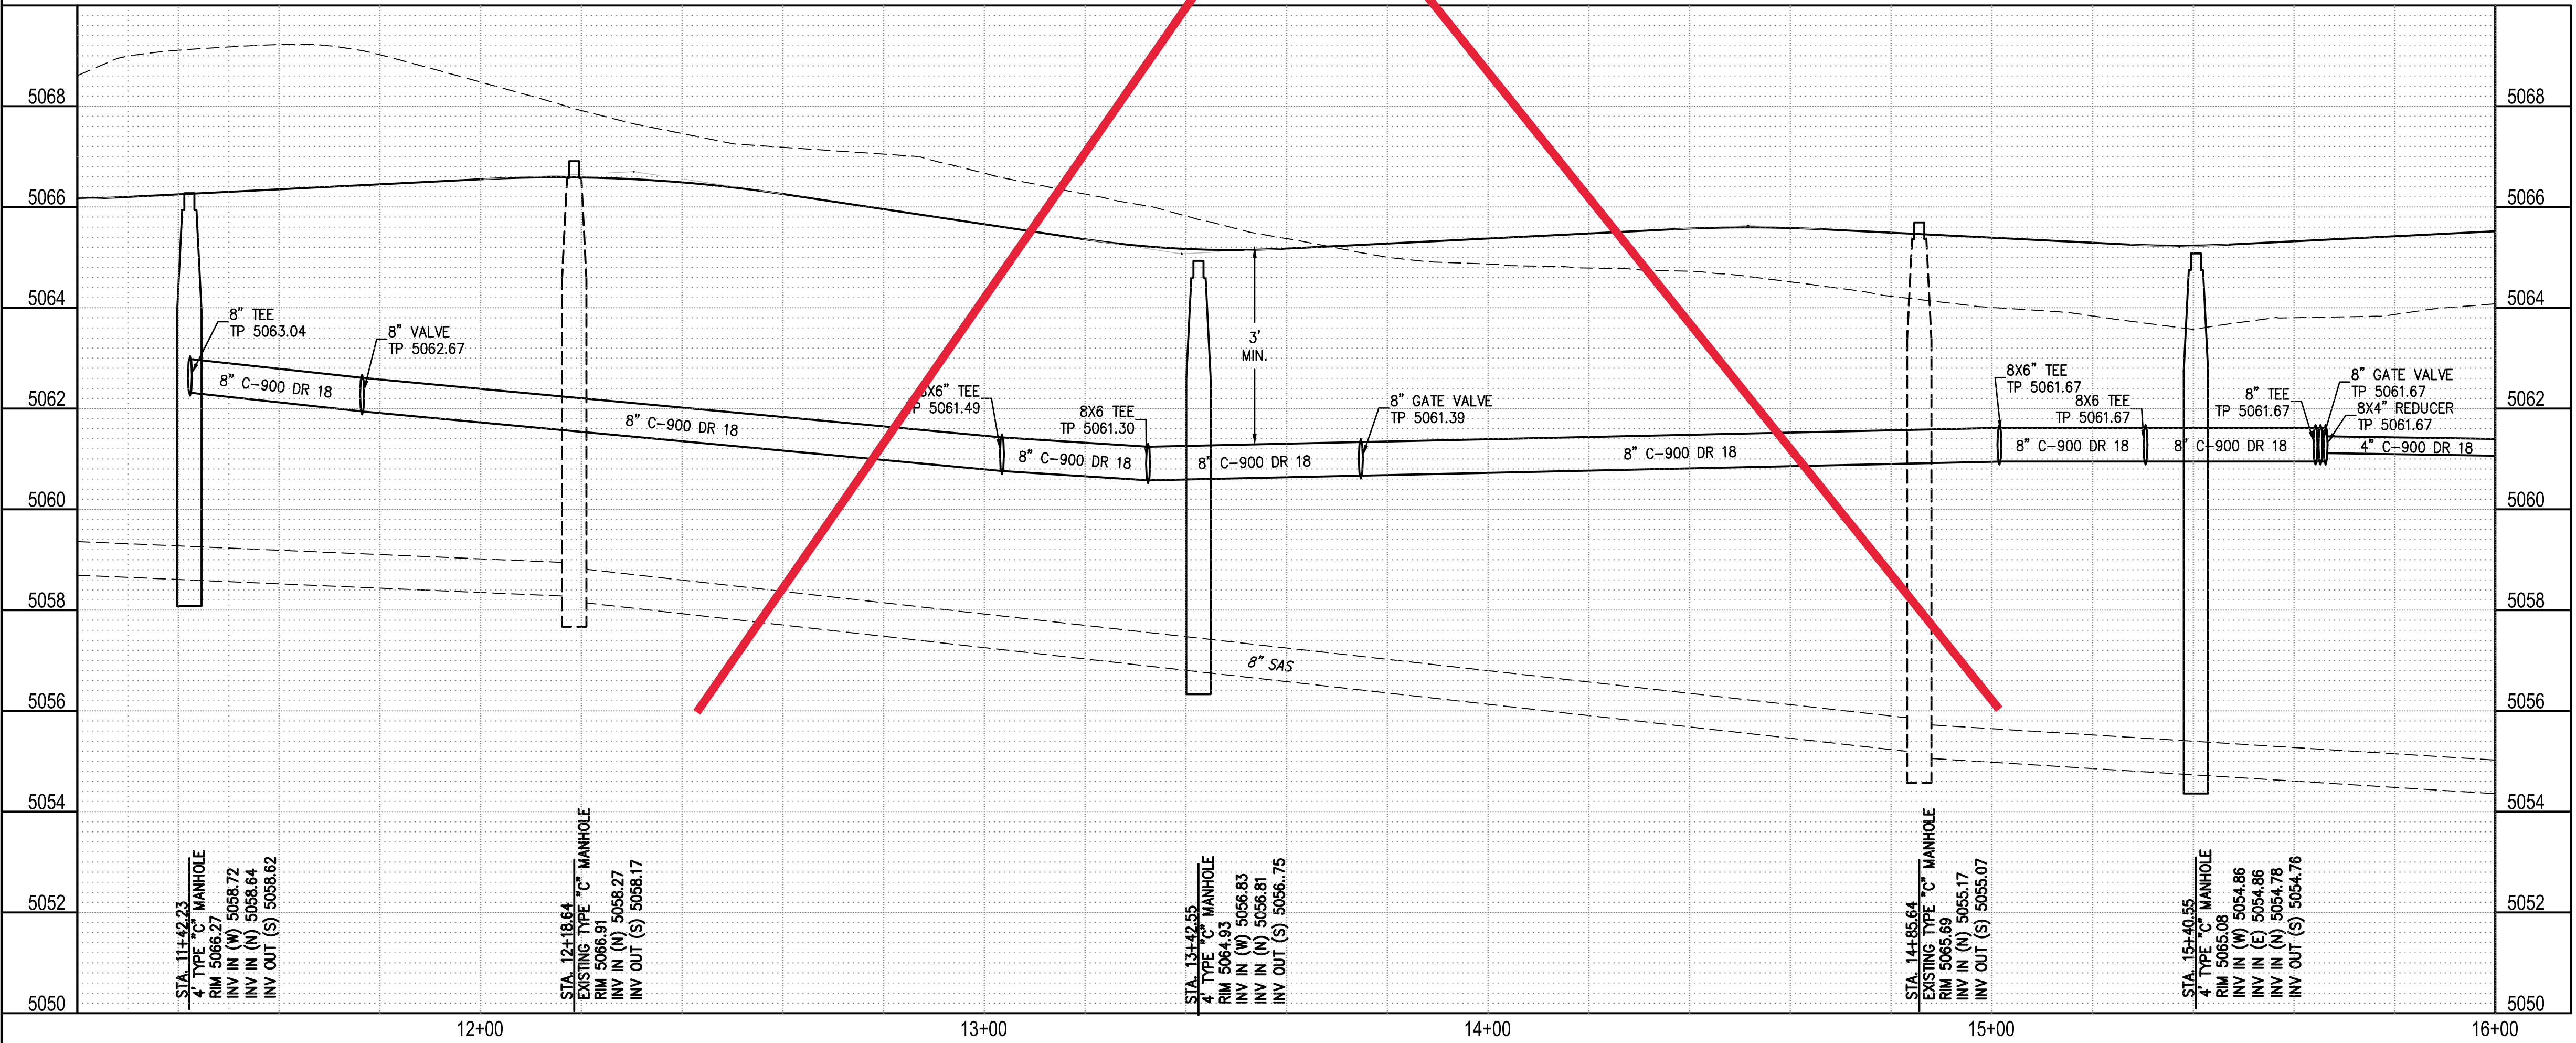

LEGEND

- PROF FIRE HYDRANT
- PROF WATER VALVE
- EX SAS MANHOLE
- PROF SAS MANHOLE
- PROF WATER METER
- 8" SAS — PROPOSED SANITARY SEWER LINE
- SAS — EX SANITARY SEWER LINE
- 6" W — PROPOSED WATER LINE
- 8" W — EX WATER LINE

THE group
THE HENSLEY ENGINEERING GROUP
(505) 410-1622

HORIZON VILLAGE SUBDIVISION
HORIZON WAY STA. 11+20 - 16+00
UTILITY PLAN AND PROFILE



CITY PROJECT No. 799782

ZONE MAP NO. C-17

SHEET 12 OF 15

ENGINEER'S SEAL		SURVEY INFORMATION		BENCH MARKS		AS BUILT INFORMATION						
	DATE	BY	NO.	DATE	NO.	DATE	NO.					
		REVISIONS		REMARKS		DESIGNED BY		CHECKED BY				
		DESIGN		REH		REH		REH				
		DATE 10/31/19		DATE 12/07/19		DATE 02/21/20		DATE				



RESTRAINING JOINT TABLE / NOTES

RESTRAINED JOINT TABLE		
MECHANICAL JOINT TYPE	DISTANCE FROM FITTING OF JOINTS RESTRAINED	
	PIPE SIZE	PIPE SIZE
6"X8" TEE	6"	4"
6"X6"X6" TEE	1	
45° HORZ. BEND	7	8
22.5° HORZ. BEND	4	4
11.25° HORZ. BEND	2	2
GATE VALVE/CAP	47	55
45° VERT. BEND (UPPER)	18	23
(LOWER)	6	7
22.5° VERT. BEND (UPPER)	9	7
(LOWER)	3	2

- NOTES:
- ALL MECHANICAL JOINTS SHALL BE RESTRAINED AT FITTING.
 - ALL JOINTS WITHIN DISTANCE FROM FITTING SHALL BE RESTRAINED.
 - THE CONTRACTOR SHALL PROVIDE A MINIMUM PIPE LENGTH OF 20 LF FROM ALL MECHANICAL JOINTS. ALL PIPE JOINTS WITHIN 20 LF OF MJ SHALL BE RESTRAINED AT THE CONTRACTORS EXPENSE.
 - THE CONTRACTOR SHALL RESTRAIN ALL PIPE JOINTS IN THE SPECIFIED DISTANCE LISTED IN THE TABLE AT LEFT (SEE NOTE 2 ABOVE).
 - THE CONTRACTOR SHALL RESTRAIN ALL FIRE HYDRANT JOINTS FROM THE TEE ON THE MAIN TO THE FIRE HYDRANT FLANGE.
 - ALL CAPS SHALL UTILIZE PCC BLOCKING, UNLESS OTHERWISE NOTED.
 - RESTRAINED LENGTH IS ON LARGE SIDE WHERE REDUCERS ARE USED.
 - RESTRAIN ALL JOINTS BETWEEN UPPER AND LOWER VERTICAL BENDS.
 - TRACE WIRE ON ALL ABCWUA LINES FIRE HYDRANT LEGS

WATER LINE TABLE		
LINE	LENGTH	BEARING
W1	190.17	S 12°45'29" W
W2	198.00	S 12°45'29" W
W3	33.76	S 12°45'29" W
W4	53.18	S 12°45'29" W

WATER LINE ALIGNMENT INTERSECTION DISTANCE

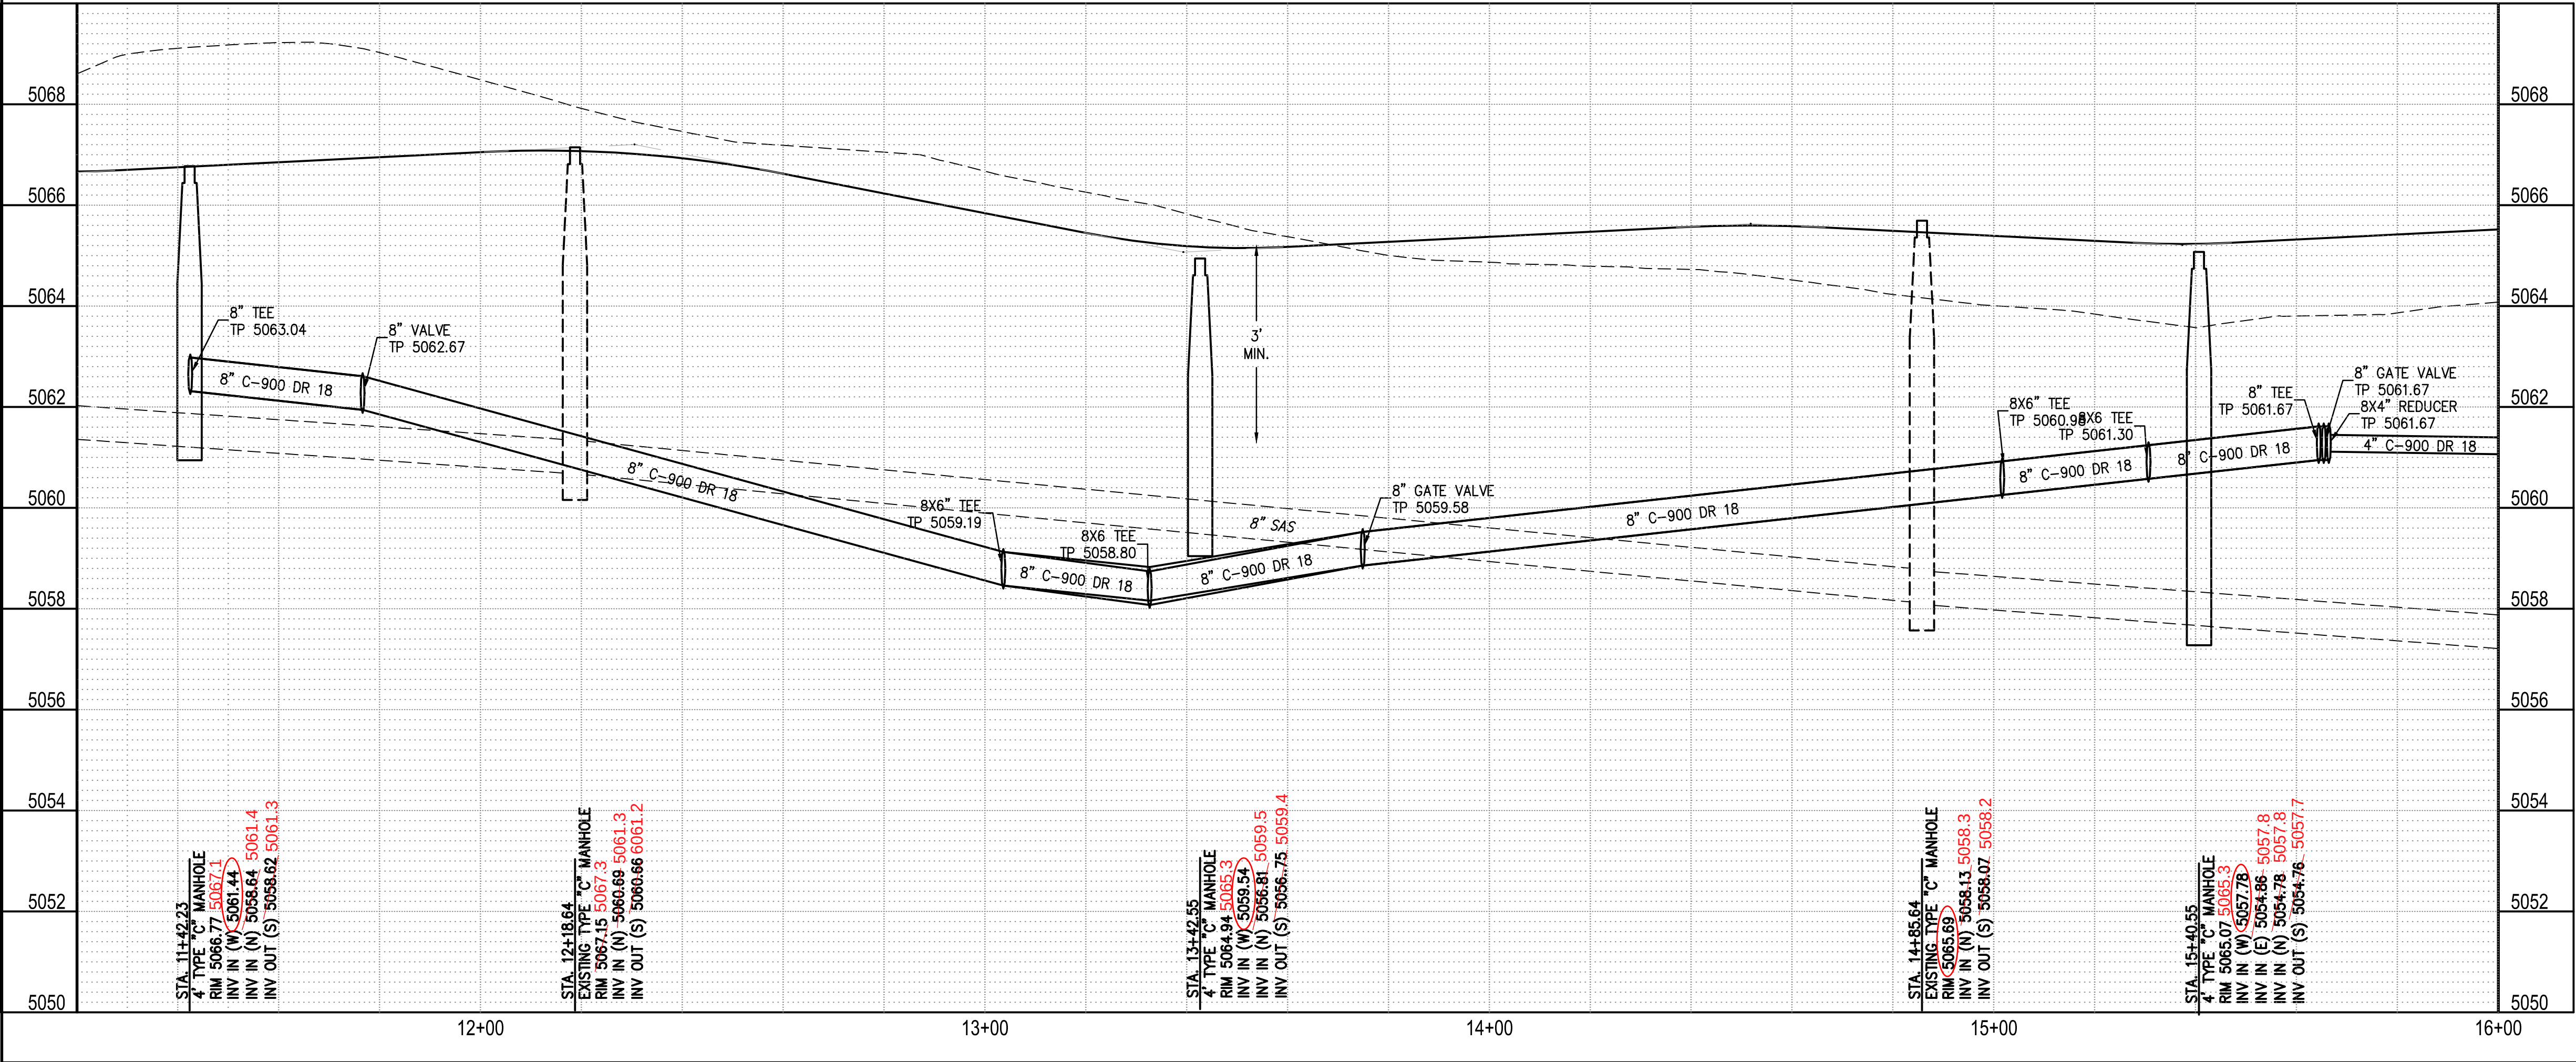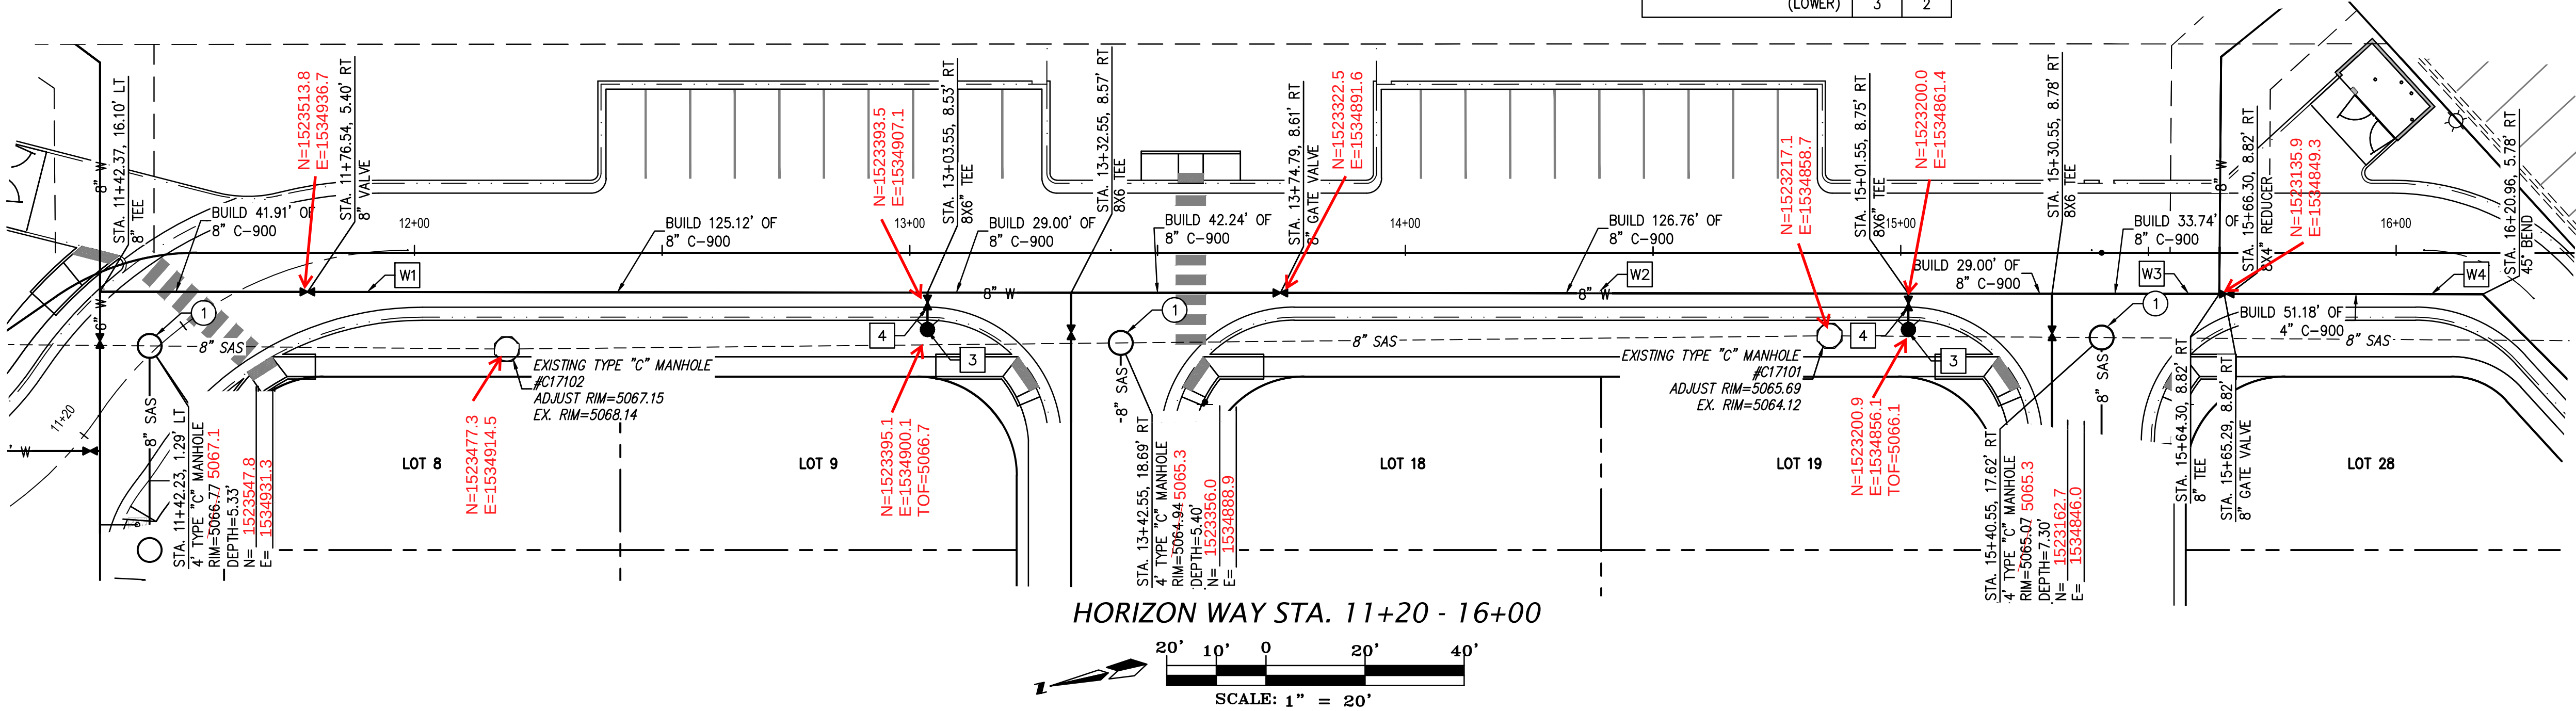

SEWER CONSTRUCTION NOTES

I.D.#	DESCRIPTION
1	INSTALL 4" DIA. TYPE "C" MANHOLE PER COA STD. DTL. 2101, 2109

WATER CONSTRUCTION NOTES

I.D.#	DESCRIPTION
1	INSTALL WATERLINE PER STD. SPEC. SEC. 801
2	INSTALL GATE VALVE AND VALVE BOX PER COA STD. DTL. 2326, 2328
3	INSTALL FIRE HYDRANT PER COA STD. DTL. 2340, 2347
4	INSTALL HYDRANT LEG W/ TRACE WIRE AND "MEG A LUG" ALL FITTINGS AND JOINTS FROM TEE TO FIRE HYDRANT

AS BUILT INFORMATION

CONTRACTOR	DATE	INSPECTOR'S	DATE	FIELD	DATE	VERIFICATION	DATE	CORRECTED	DATE
CARTESIAN SURVEYS	7/20/12	CARTESIAN SURVEYS	2021						

BENCH MARKS

NO.	FIELD NOTES	DATE
	"ACS BM NM 448 N8"	
	X=1,514,900.643 Y=1,512,770.226 (NAD 83), ELEV=5021.651 (NAVD 1988)	

ENGINEER'S SEAL

NEW MEXICO
21650
RON E. HENSLEY
3/20/20

LEGEND

- PROP FIRE HYDRANT
- PROP WATER VALVE
- EX SAS MANHOLE
- PROP SAS MANHOLE
- PROP WATER METER
- 8" SAS PROPOSED SANITARY SEWER LINE
- SAS EX SANITARY SEWER LINE
- 6" W PROPOSED WATER LINE
- 8"W EX WATER LINE

THE group
THE HENSLEY ENGINEERING GROUP
(505) 410-1622

HORIZON VILLAGE SUBDIVISION
HORIZON WAY STA. 11+20 - 16+00
UTILITY PLAN AND PROFILE

DESIGN REVIEW COMMITTEE
APPROVED
Sept. 10, 2020
DESIGN REVIEW COMMITTEE

CITY ENGINEER APPROVAL
APPROVED
Sept. 10, 2020
CITY ENGINEER

CITY PROJECT No. **799782** ZONE MAP NO. **C-17**

SHEET **12** OF **15**

HORIZON WAY SANITARY SEWER SERVICES					
LOT	SAS STATION & OFFSET	SAS LENGTH	INV BEGIN	TOP OF PIPE AT END	
1	100+02.06 26.97' RT	31.97	5062.69	5065.56	
2	100+25.78 34.86' RT	39.86	5062.15	5065.50	
3	100+51.70 36.63' RT	41.63	5061.55	5064.25	
4	100+75.25 32.15' RT	52.00	5061.00	5064.21	

SAS LINE TABLE		
LINE	LENGTH	BEARING
S1	121.57	S 12°41'45" W
MH CENTER TO CENTER DISTANCE		

HORIZON WAY WATER SERVICES				
LOT NO.	WL STATION & OFFSET	GPS X-COORDINATE	GPS Y-COORDINATE	
1	99+94.32 6.38 RT			
2	100+37.65 20.96 RT			
3	100+37.65 20.96 RT			
4	100+88.78 20.74 RT			

WATER LINE TABLE		
LINE	LENGTH	BEARING
W1	104.91	S 12°41'45" W
W5	10.50	S 42°41'45" W
WATER LINE ALIGNMENT INTERSECTION DISTANCE		

AEROSTAT PLACE SANITARY SEWER SERVICES					
LOT	SAS STATION & OFFSET	SAS LENGTH	INV BEGIN	TOP OF PIPE AT END	
5	100+14.84 30.00' RT	25.00	5060.70	5062.69	
6	100+39.84 30.00' RT	25.00	5060.45	5062.70	
7	100+74.84 30.00' RT	25.00	5060.10	5063.15	
8	100+99.84 30.00' RT	25.00	5059.74	5063.15	



SAS LINE TABLE		
LINE	LENGTH	BEARING
S2	74.02	S 77°18'54" E
S3	41.21	S 77°18'54" E
MH CENTER TO CENTER DISTANCE		

AEROSTAT PLACE COURT WATER SERVICES				
LOT NO.	WL STATION & OFFSET	GPS X-COORDINATE	GPS Y-COORDINATE	
5	10+80.23 15.98 LT			
6	11+26.23 15.98 LT			
7	11+26.23 15.98 LT			
8	12+17.75 44.71 LT			



WATER LINE TABLE		
LINE	LENGTH	BEARING
W2	76.11	S 77°18'54" E
W3	108.38	S 77°18'54" E
W4	44.61	S 32°18'54" E
WATER LINE ALIGNMENT INTERSECTION DISTANCE		

SEWER CONSTRUCTION NOTES	
I.D.#	DESCRIPTION
1	INSTALL 4" DIA. TYPE "C" MANHOLE PER COA STD. DTL. 2101, 2109
2	INSTALL 8" SEWER PIPE PER STD. SPEC. SEC. 901
3	INSTALL 4" SEWER SERVICE PER COA STD. DTL. 2125
4	INSTALL 8" CAP

WATER CONSTRUCTION NOTES	
I.D.#	DESCRIPTION
1	INSTALL WATERLINE PER STD. SPEC. SEC. 801
2	NON-PRESSURE CONNECTION OF NEW WATERLINE TO EXISTING WATERLINE PER COA STD. DTL. 2301
3	INSTALL GATE VALVE AND VALVE BOX PER COA STD. DTL. 2326, 2328
4	INSTALL 3/4" WATER SERVICE WITH METER BOX PER COA STD. DTL. 2361 AND 2362
5	INSTALL 8" CAP
6	INSTALL FIRE HYDRANT PER COA STD. DTL. 2340, 2347
7	INSTALL HYDRANT LEG W/ TRACE WIRE AND "MEG A LUG" ALL FITTINGS AND JOINTS FROM TEE TO FIRE HYDRANT

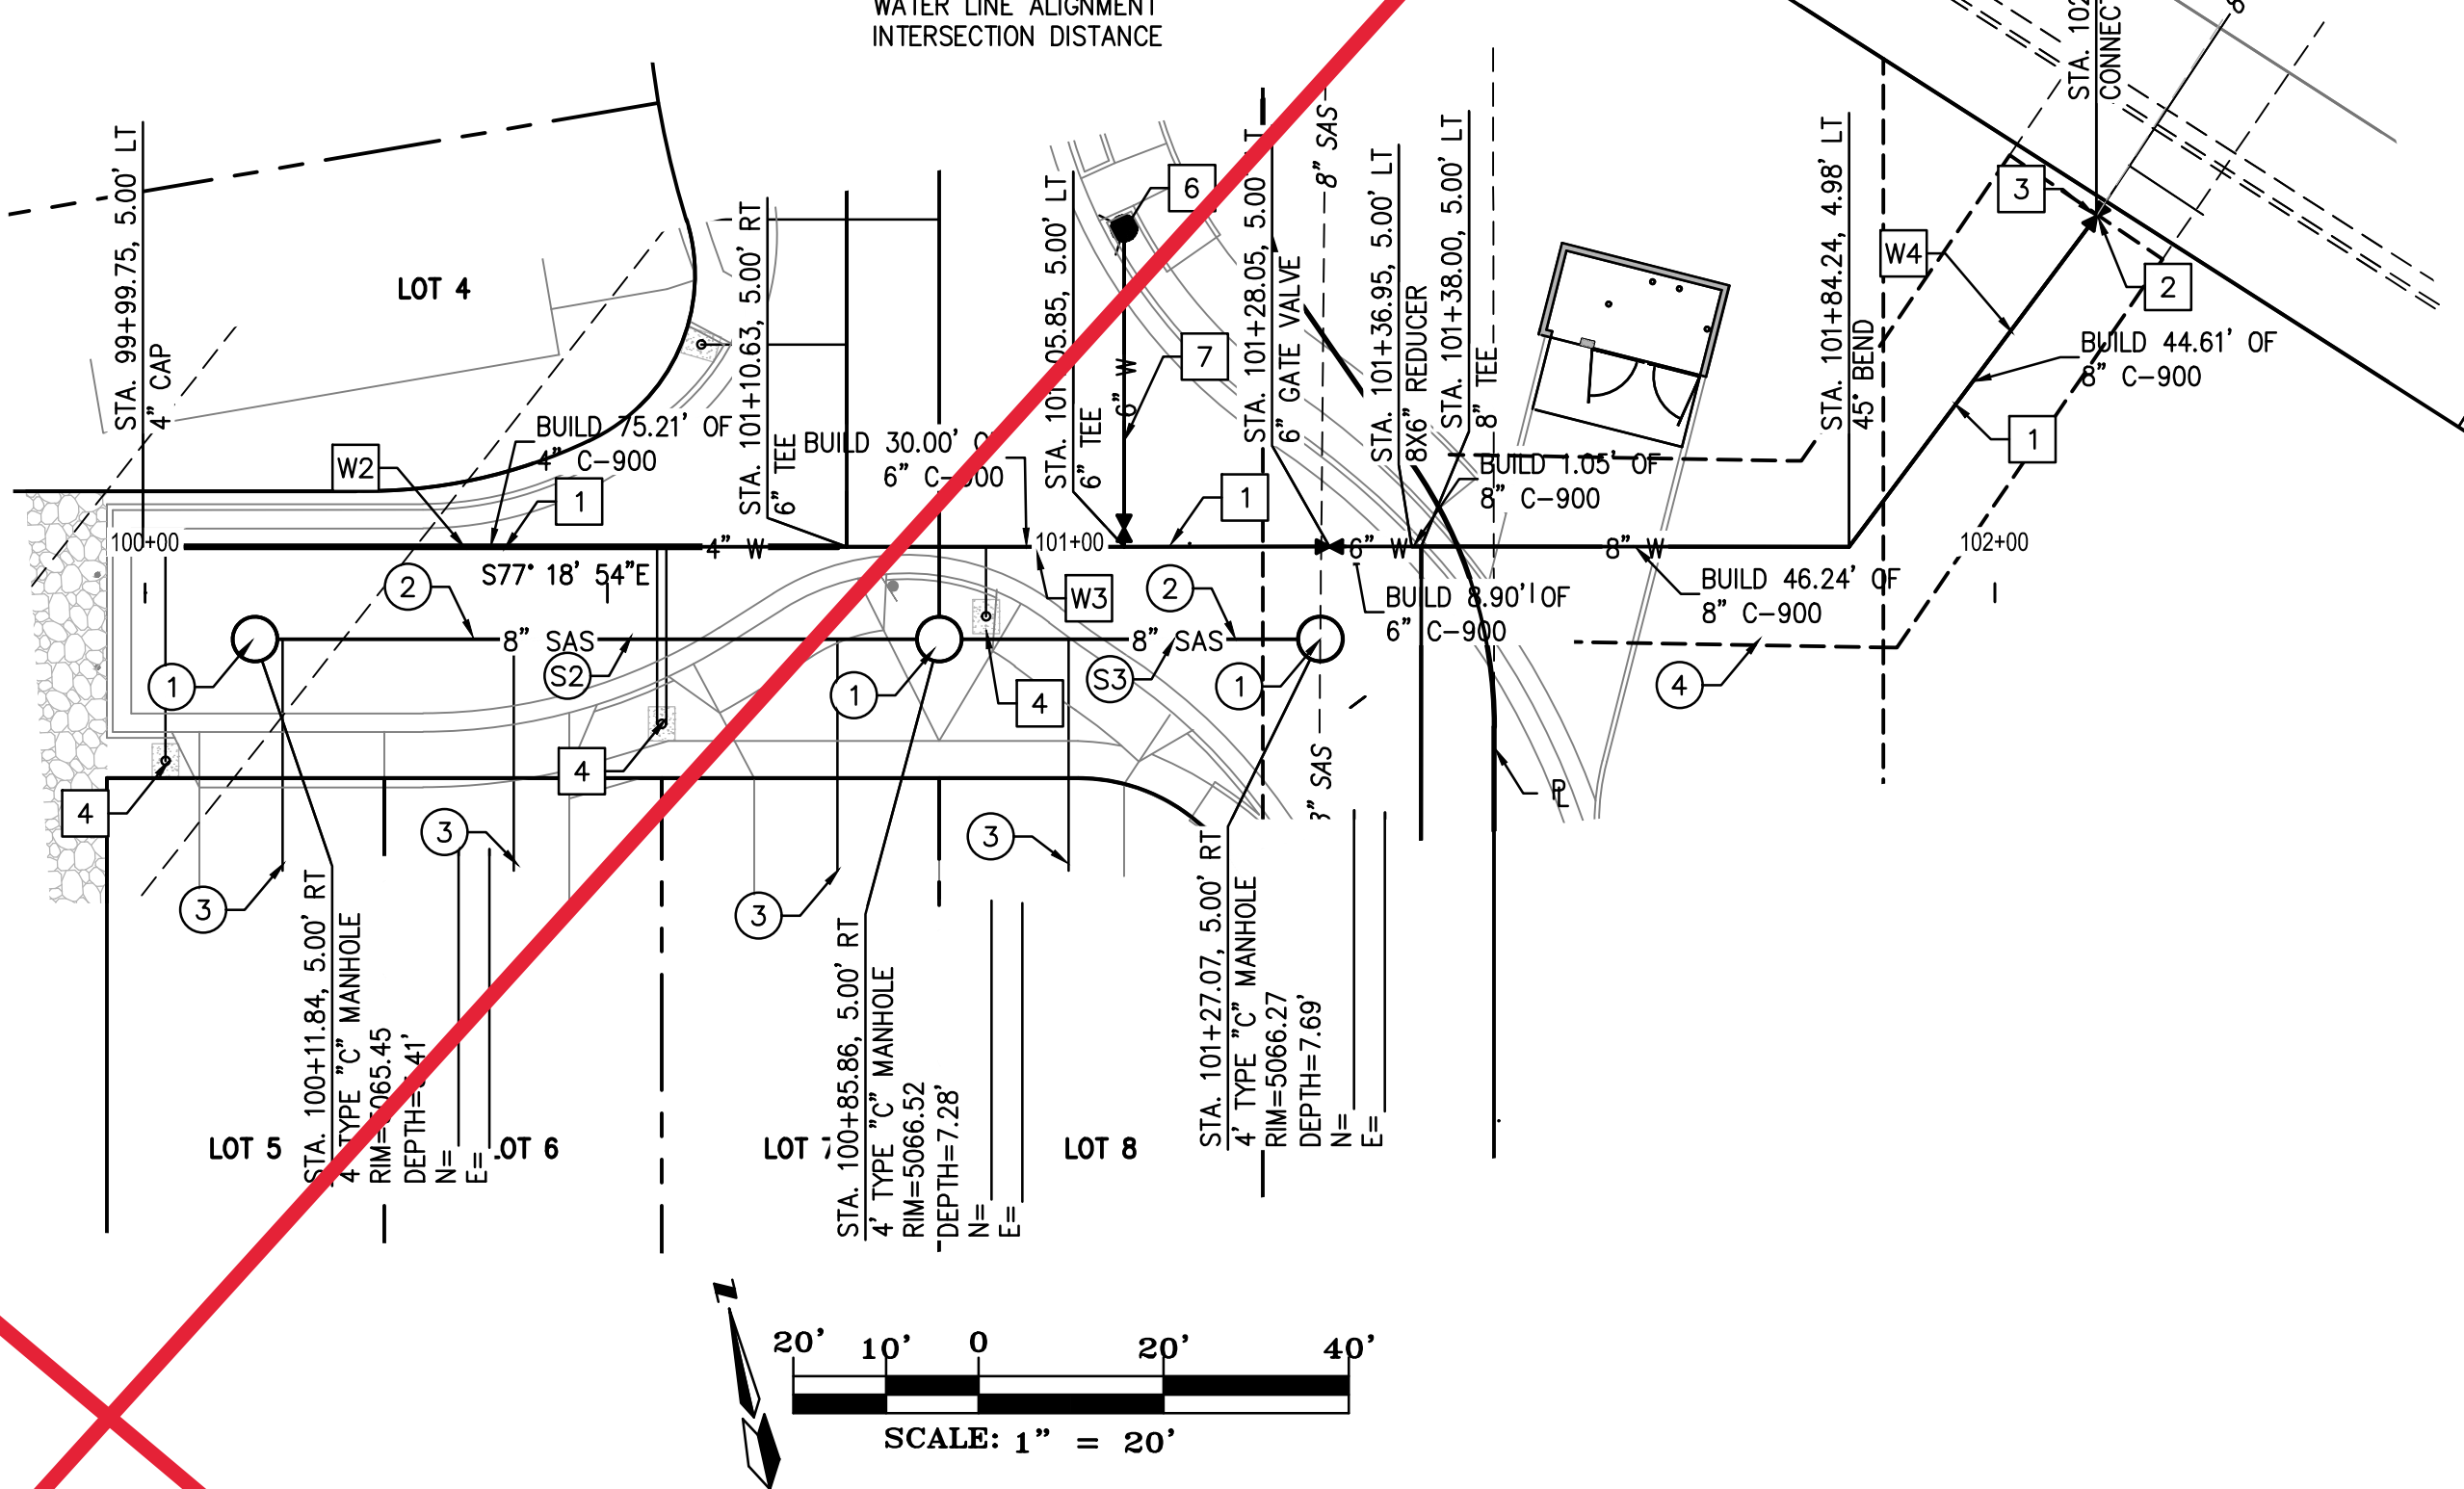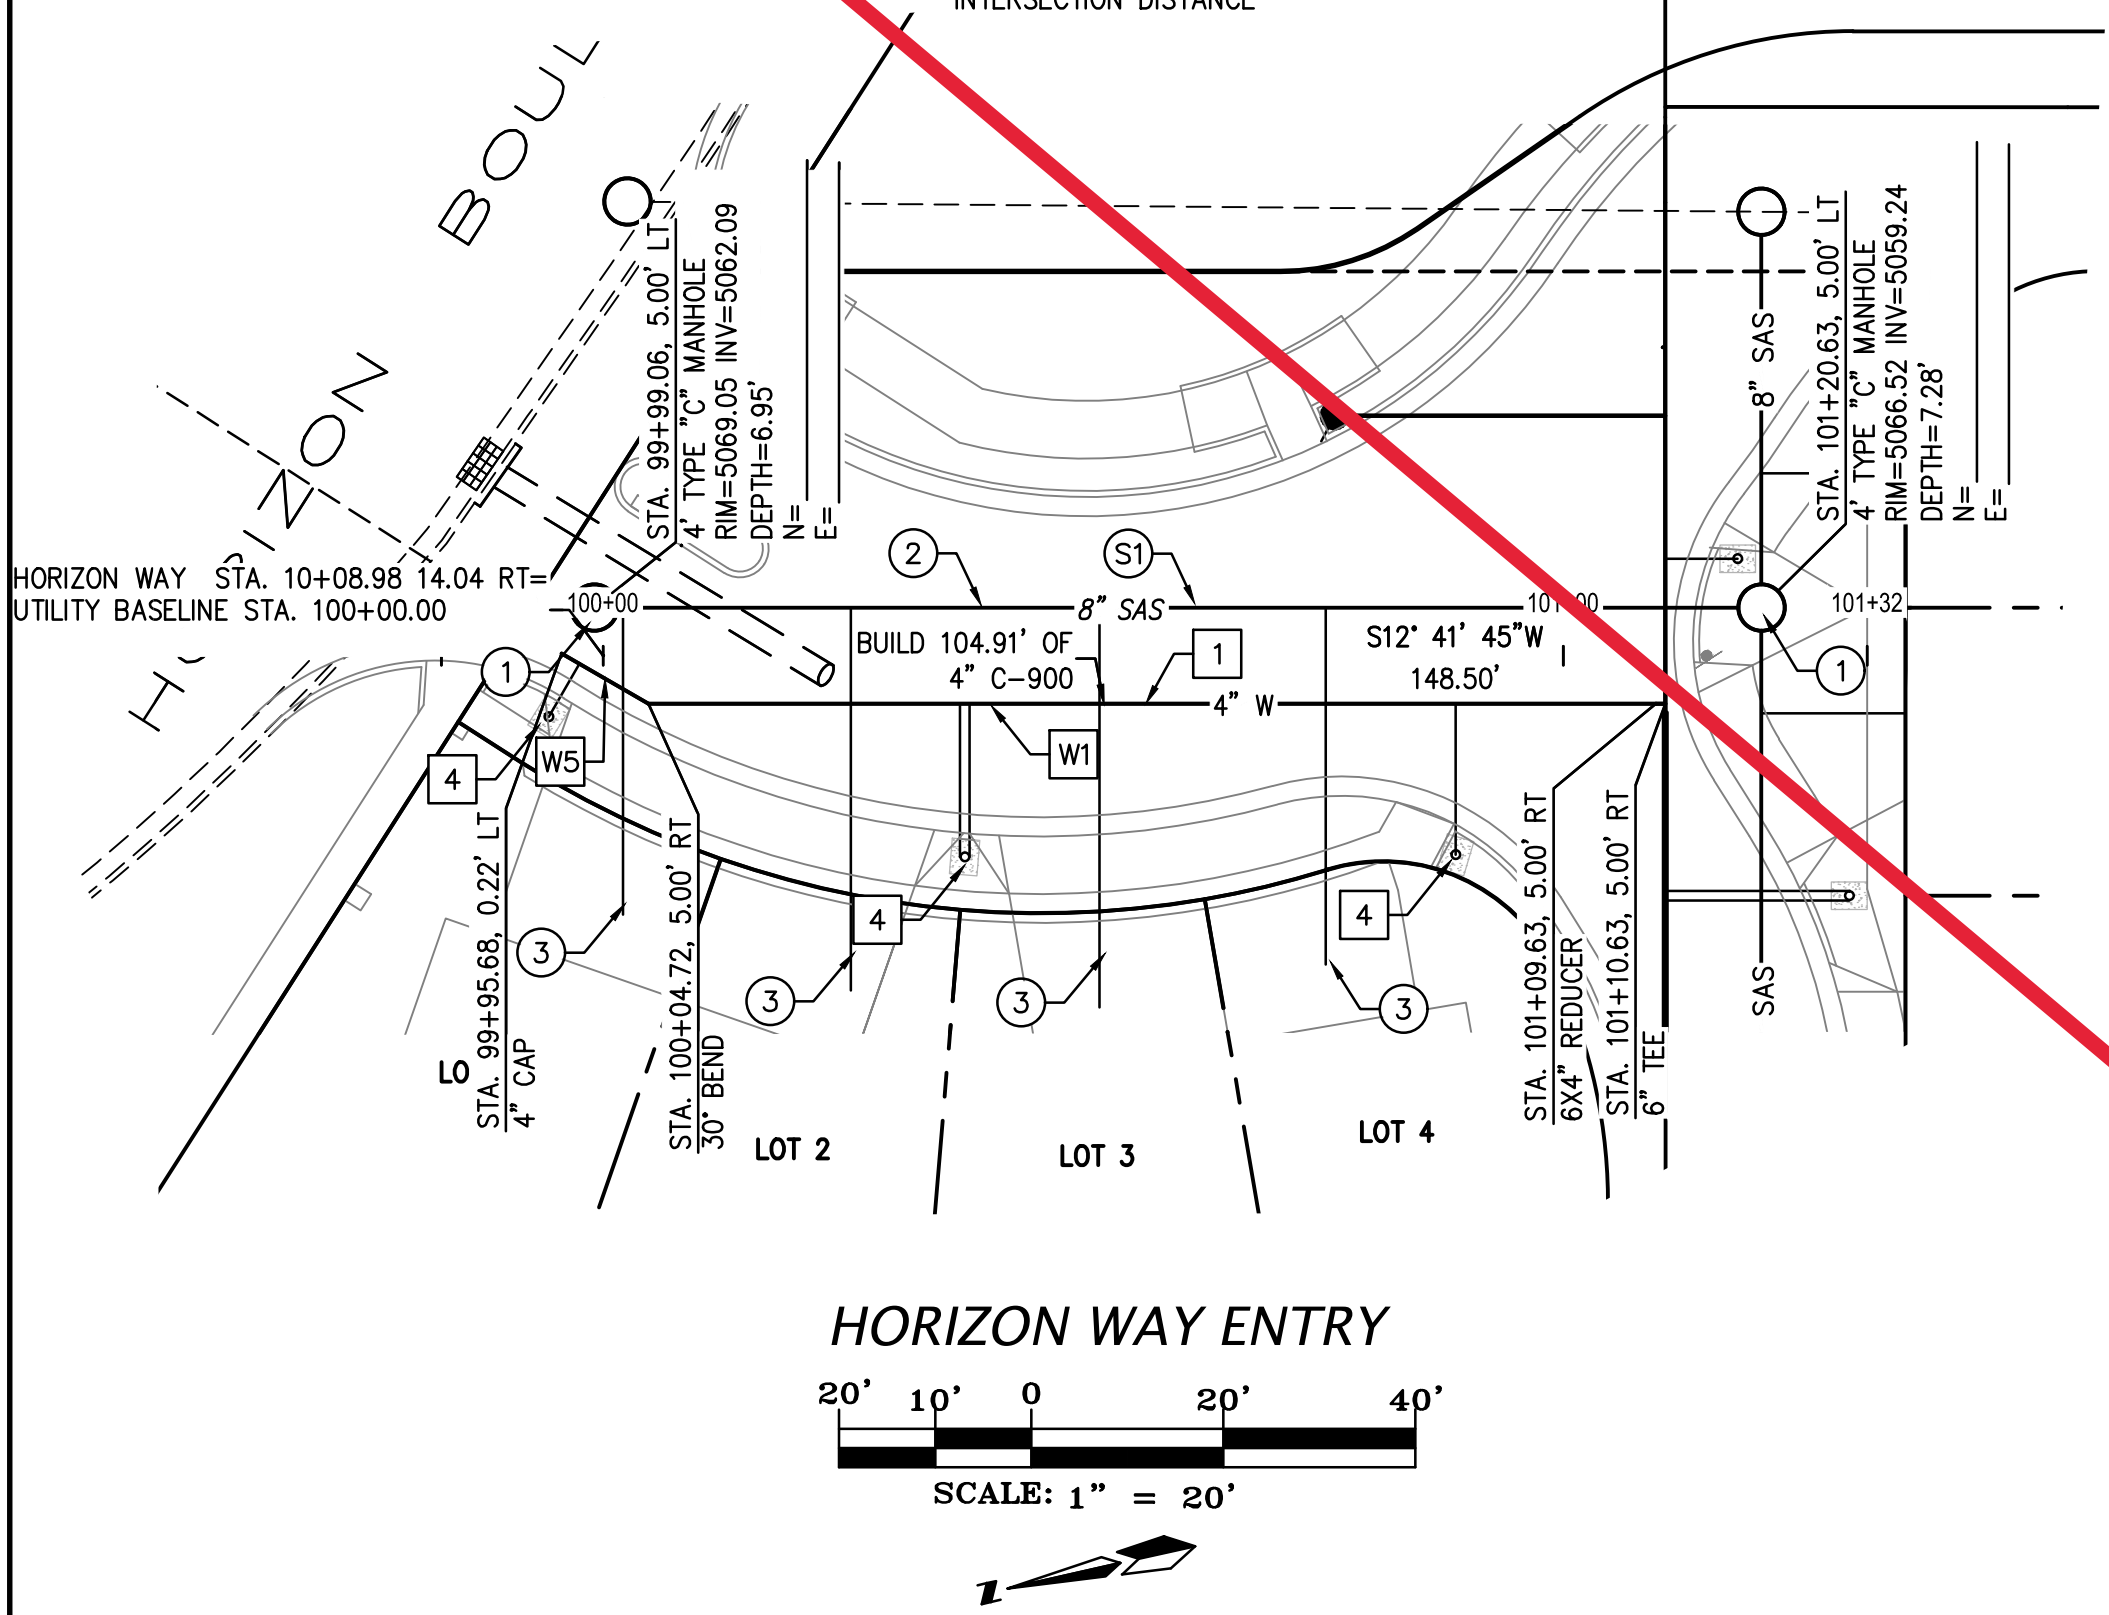

SUPERSEDED -- SEE SHEET 13R, Rev. 9/10/2020.

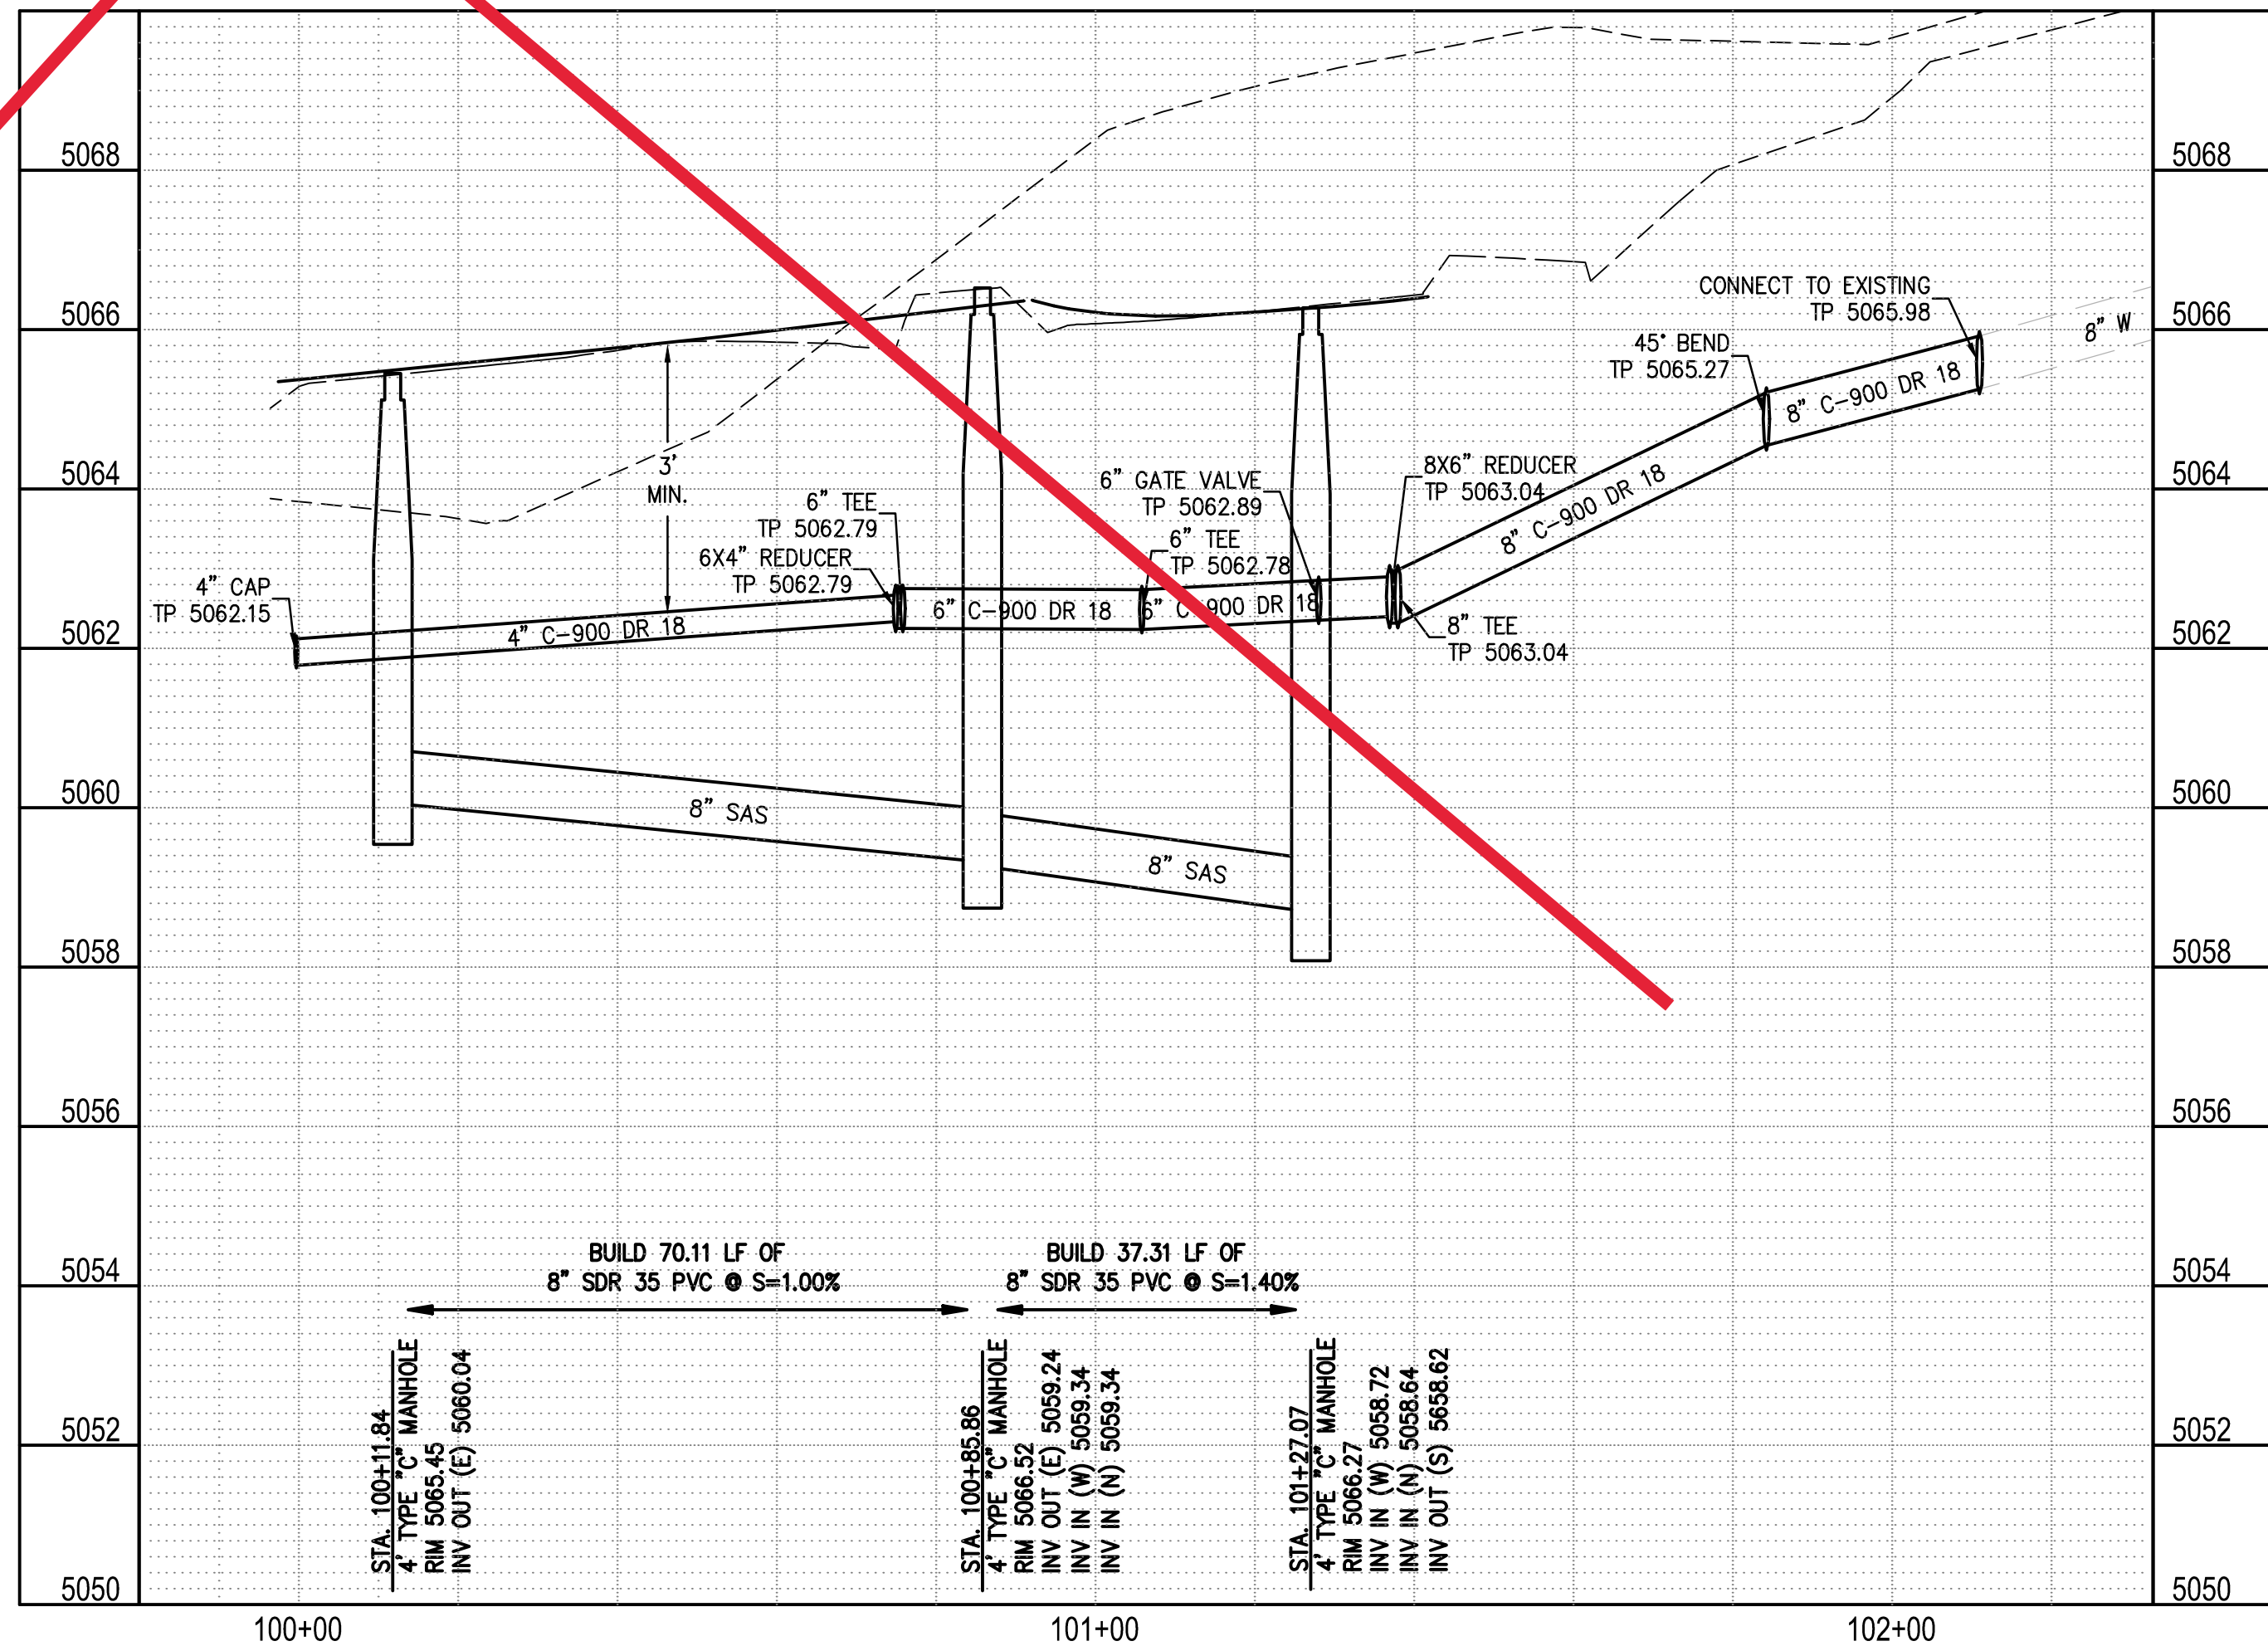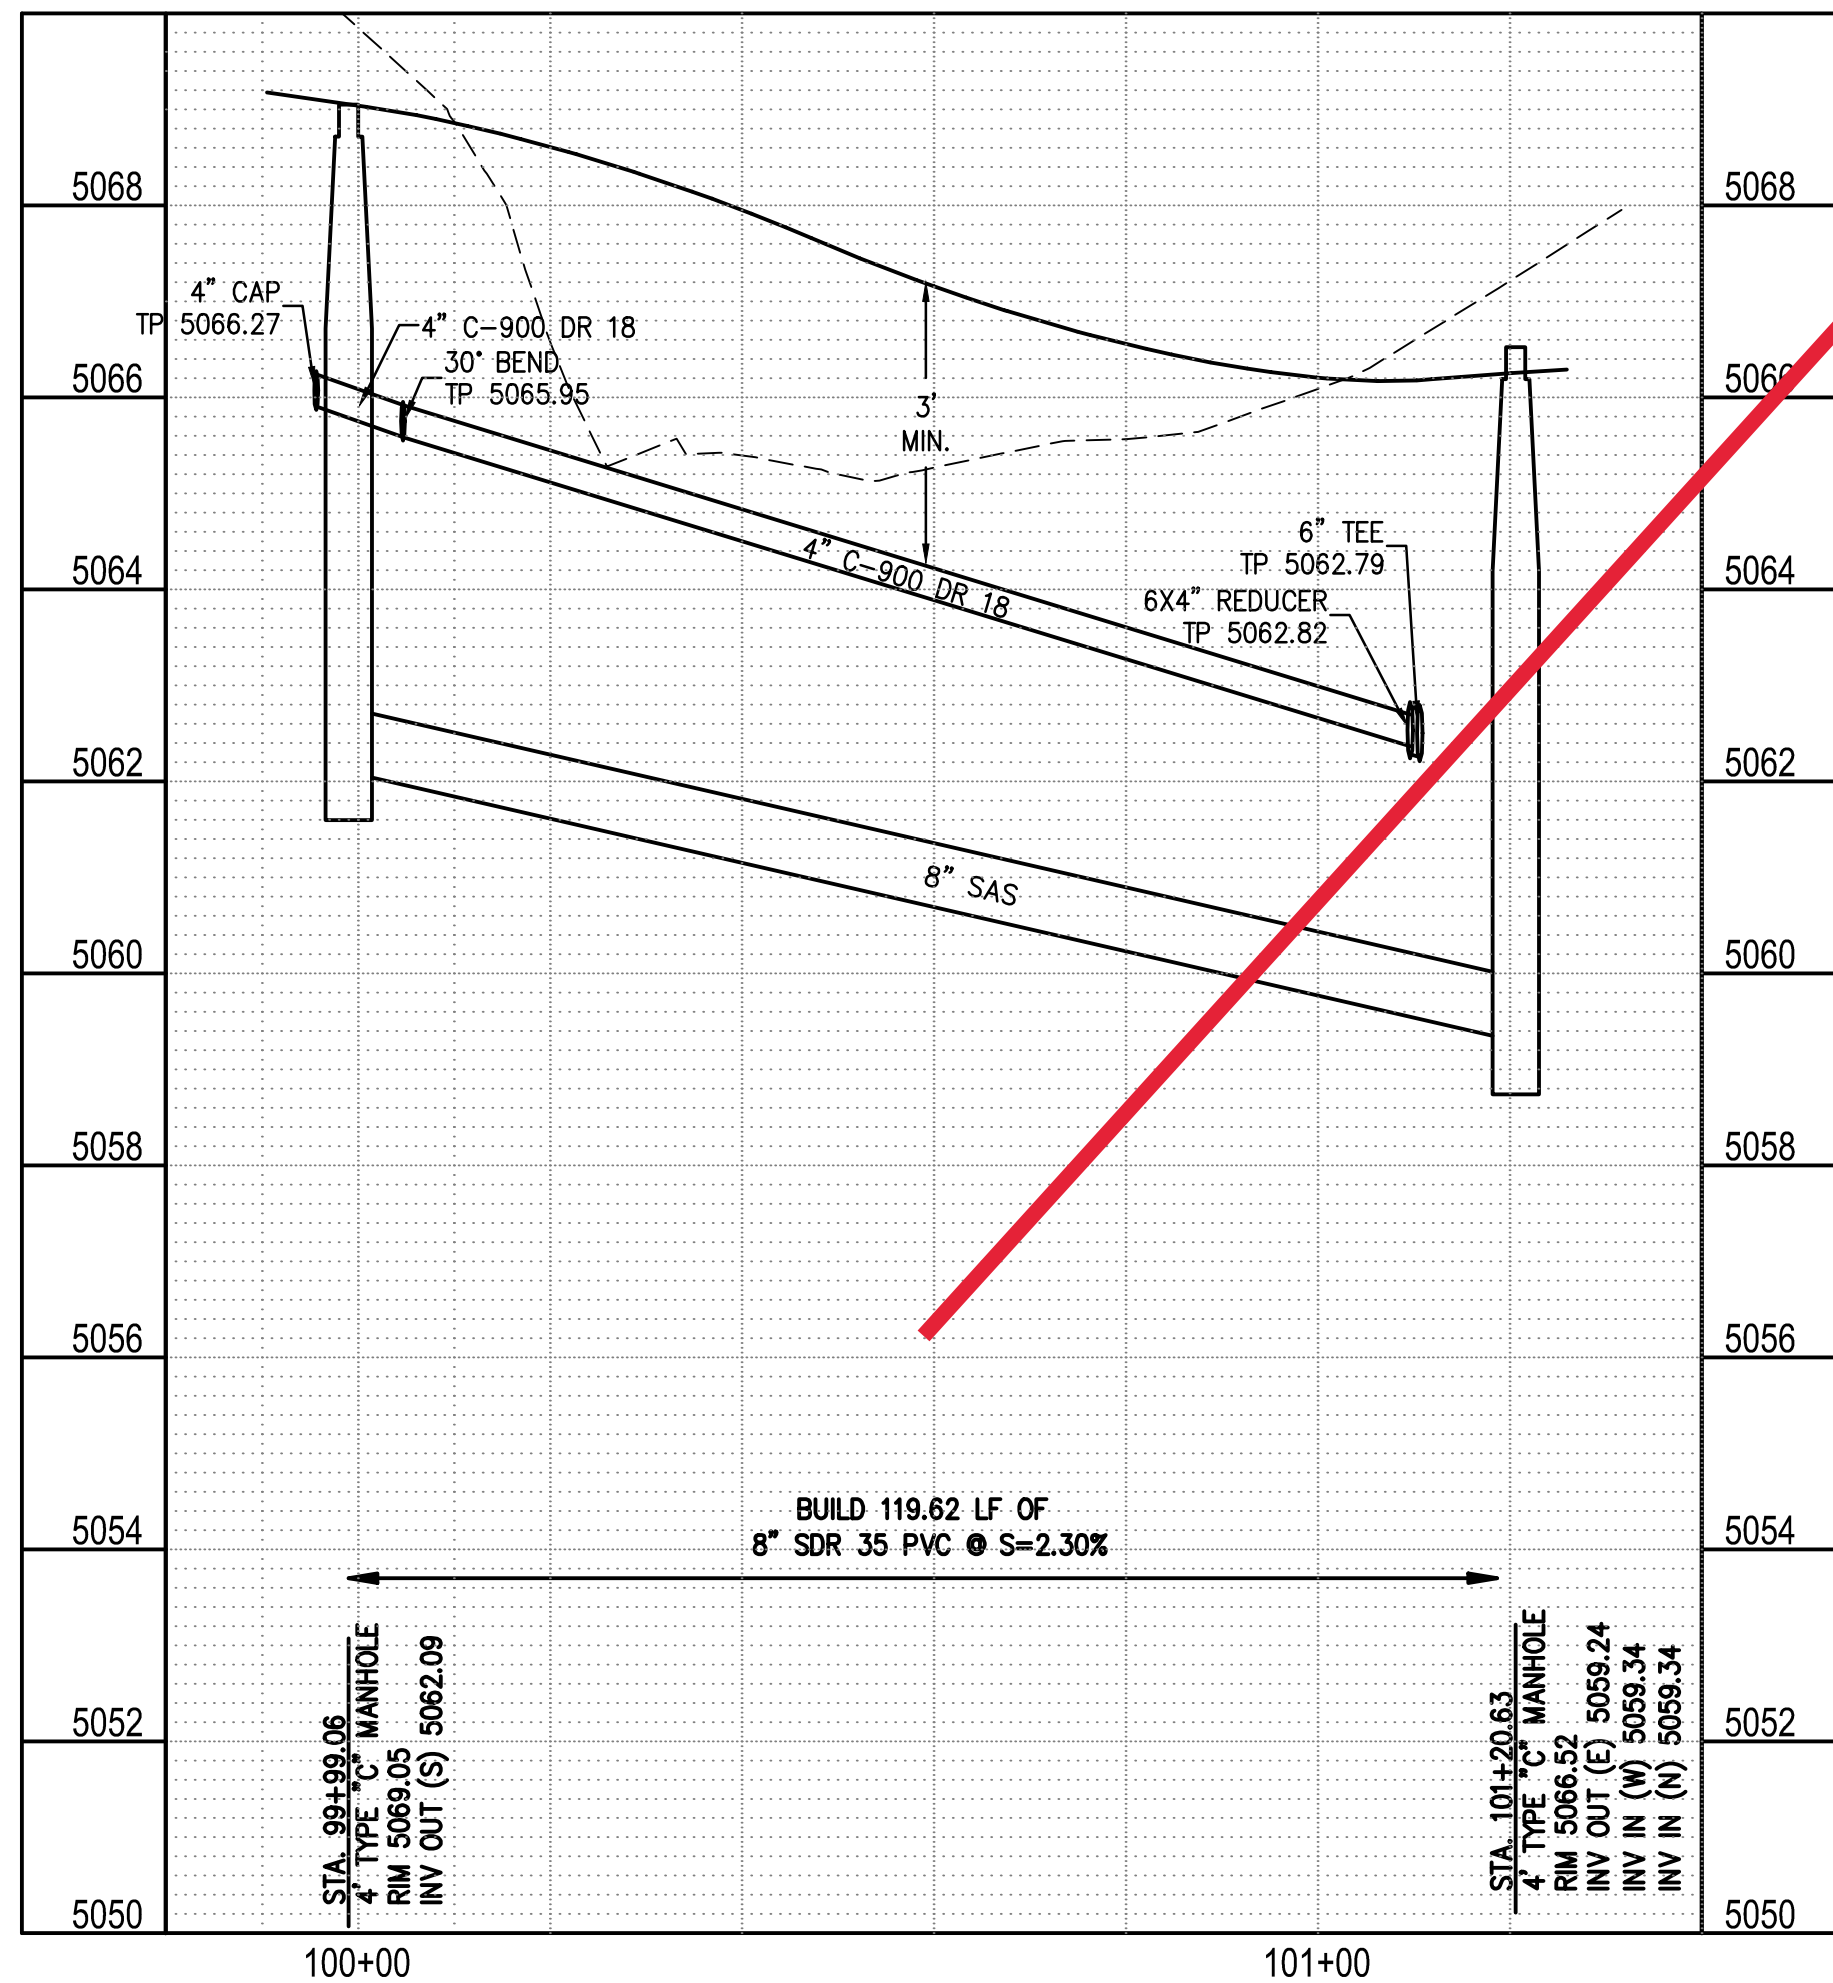

LEGEND	
	PROP FIRE HYDRANT
	PROP WATER VALVE
	EX SAS MANHOLE
	PROP SAS MANHOLE
	PROP WATER METER
	PROPOSED SANITARY SEWER LINE
	EX SANITARY SEWER LINE
	PROPOSED WATER LINE
	EX WATER LINE

THE group
THE HENSLEY ENGINEERING GROUP
(505) 410-1622

HORIZON VILLAGE SUBDIVISION
HORIZON WAY ENTRY AND AEROSTAT PLACE
UTILITY PLAN AND PROFILE

DESIGN REVIEW COMMITTEE	CITY ENGINEER APPROVAL	Mo./DAY/YR.	Mo./DAY/YR.
APPROVED July 21, 2020	APPROVED Aug 6, 2020		
LAST DESIGN UPDATE			

CITY PROJECT No. **799782** ZONE MAP NO. **C-17** SHEET **13** OF **15**

AS BUILT INFORMATION	
CONTRACTOR	DATE
STARTED BY	DATE
ACCEPTANCE BY	DATE
FIELD DRAWINGS	DATE
CORRECTED BY	DATE
MICRO-FILM INFORMATION	
RECORDED BY	DATE
NO.	

ENGINEER'S SEAL
RON E. HENSLEY
NEW MEXICO
21860
3/20/20

SURVEY INFORMATION	
FIELD NOTES	DATE
BY	
NO.	

REVISIONS	
NO.	DATE
DESIGNED BY	REH
DRAWN BY	REH
CHECKED BY	REH

HORIZON WAY SANITARY SEWER SERVICES				
LOT	SAS STATION & OFFSET	SAS LENGTH	INV BEGIN	TOP OF PIPE AT END
1	100+02.06 26.97' RT	31.97	5063.13	5065.56
2	100+25.78 34.86' RT	39.86	5062.99	5065.50
3	100+51.70 36.63' RT	41.63	5062.84	5064.25
4	100+75.25 32.15' RT	52.00	5062.70	5064.21

NOTE: STATIONING IS AT PUE

SAS LINE TABLE		
LINE	LENGTH	BEARING
S1	121.57	S 12°41'45" W


MH CENTER TO CENTER
DISTANCE

HORIZON WAY WATER SERVICES			
LOT NO.	WL STATION & OFFSET	GPS X-COORDINATE	GPS Y-COORDINATE
1	99+94.32 6.38 RT	1534903.8	1523685.7
2	100+37.65 20.96 RT	1534882.7	1523643.8
3	100+37.65 20.96 RT	1534882.7	1523643.8
4	100+88.78 20.74 RT	1534872.5	1523593.2



NOTE: STATIONING IS AT METER

WATER LINE TABLE		
LINE	LENGTH	BEARING
W1	104.91	S 12°41'45" W
W5	10.50	S 42°41'45" W

NO.	DATE	BY	TIME
WATER LINE ALIGNMENT			
INTERSECTION DISTANCE			

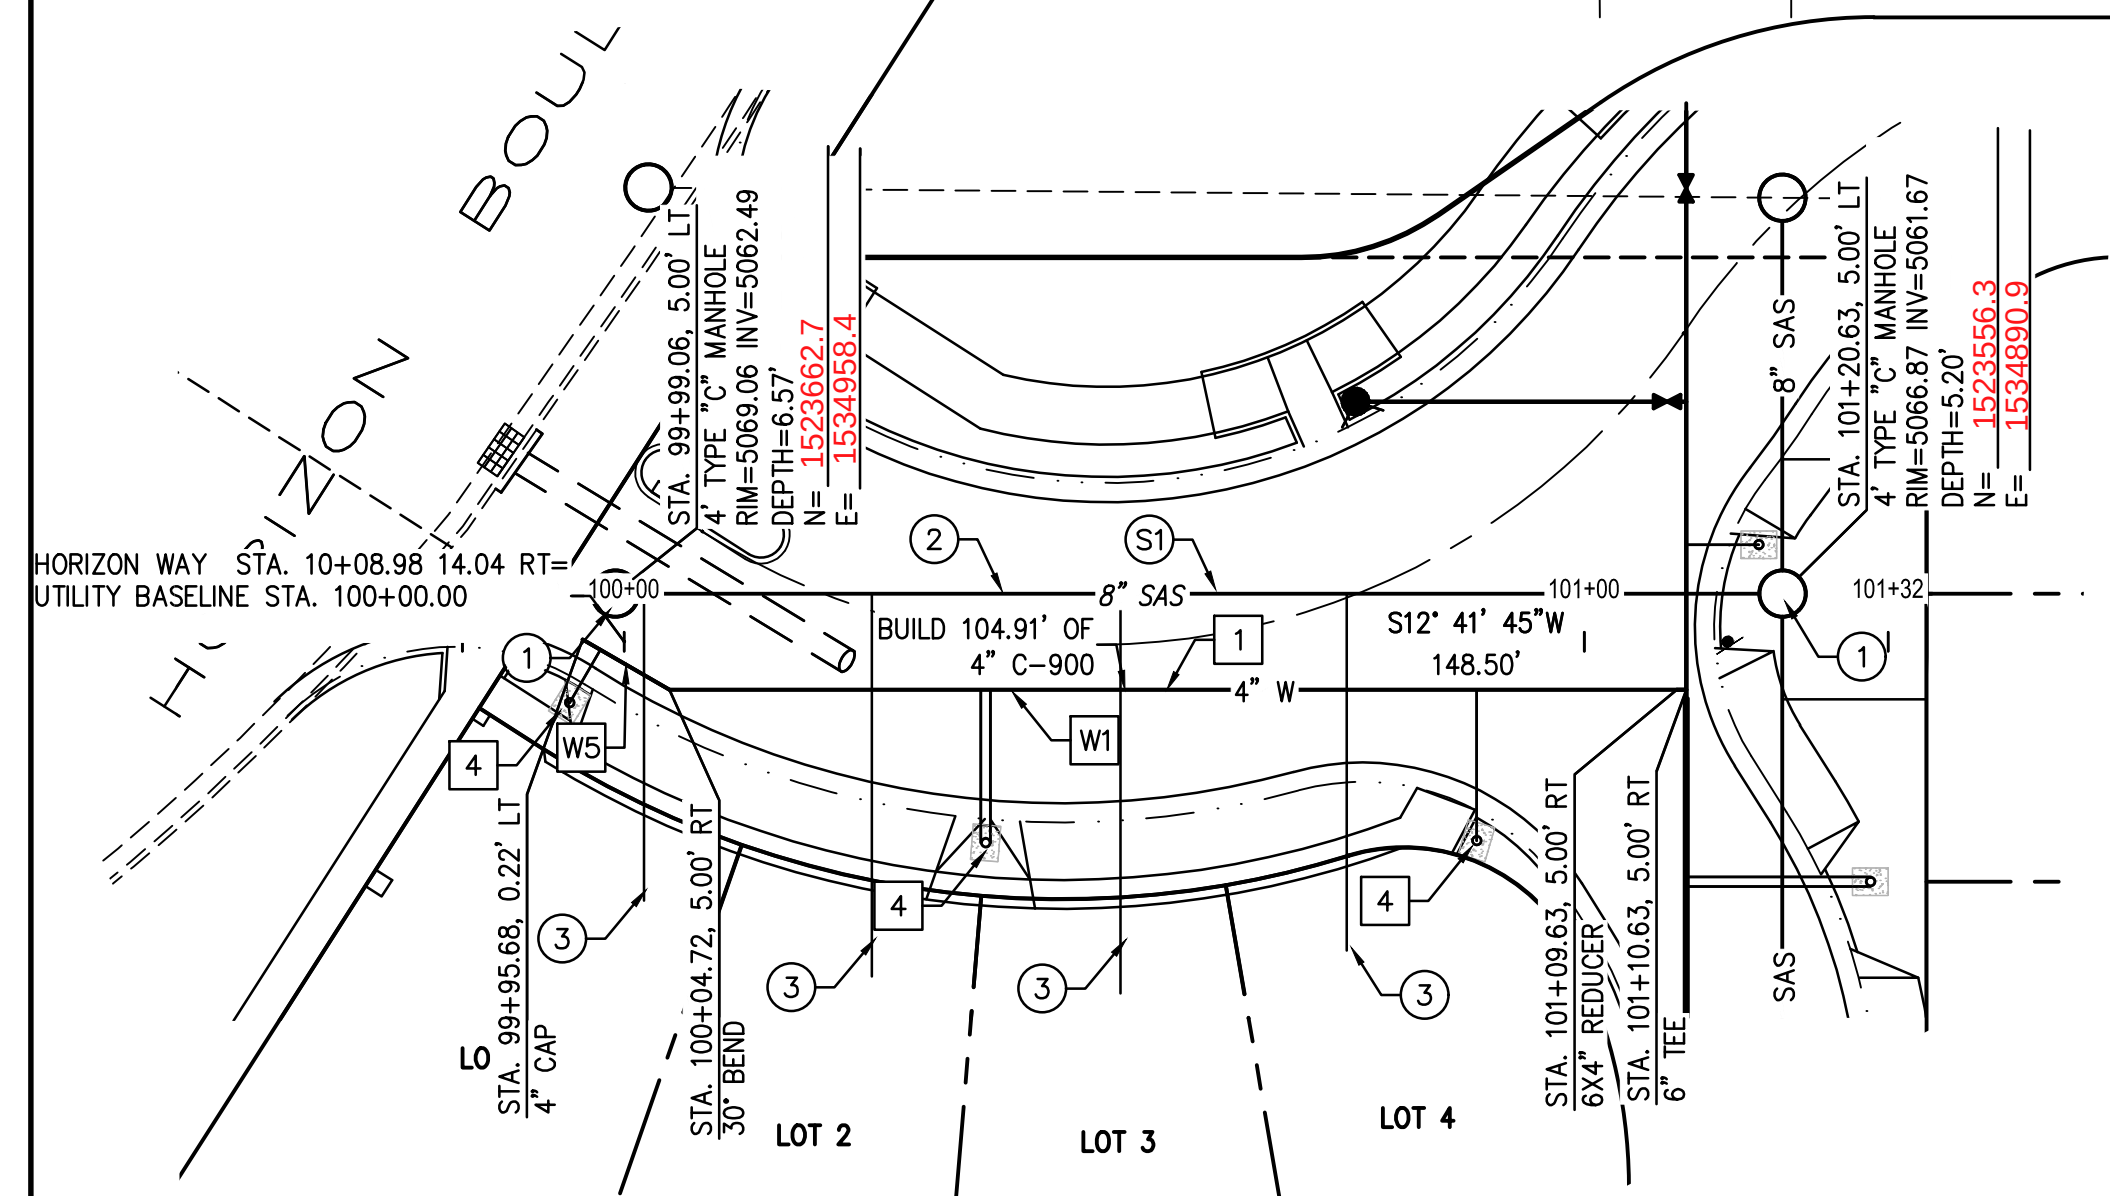

HORIZON WAY ENTRY

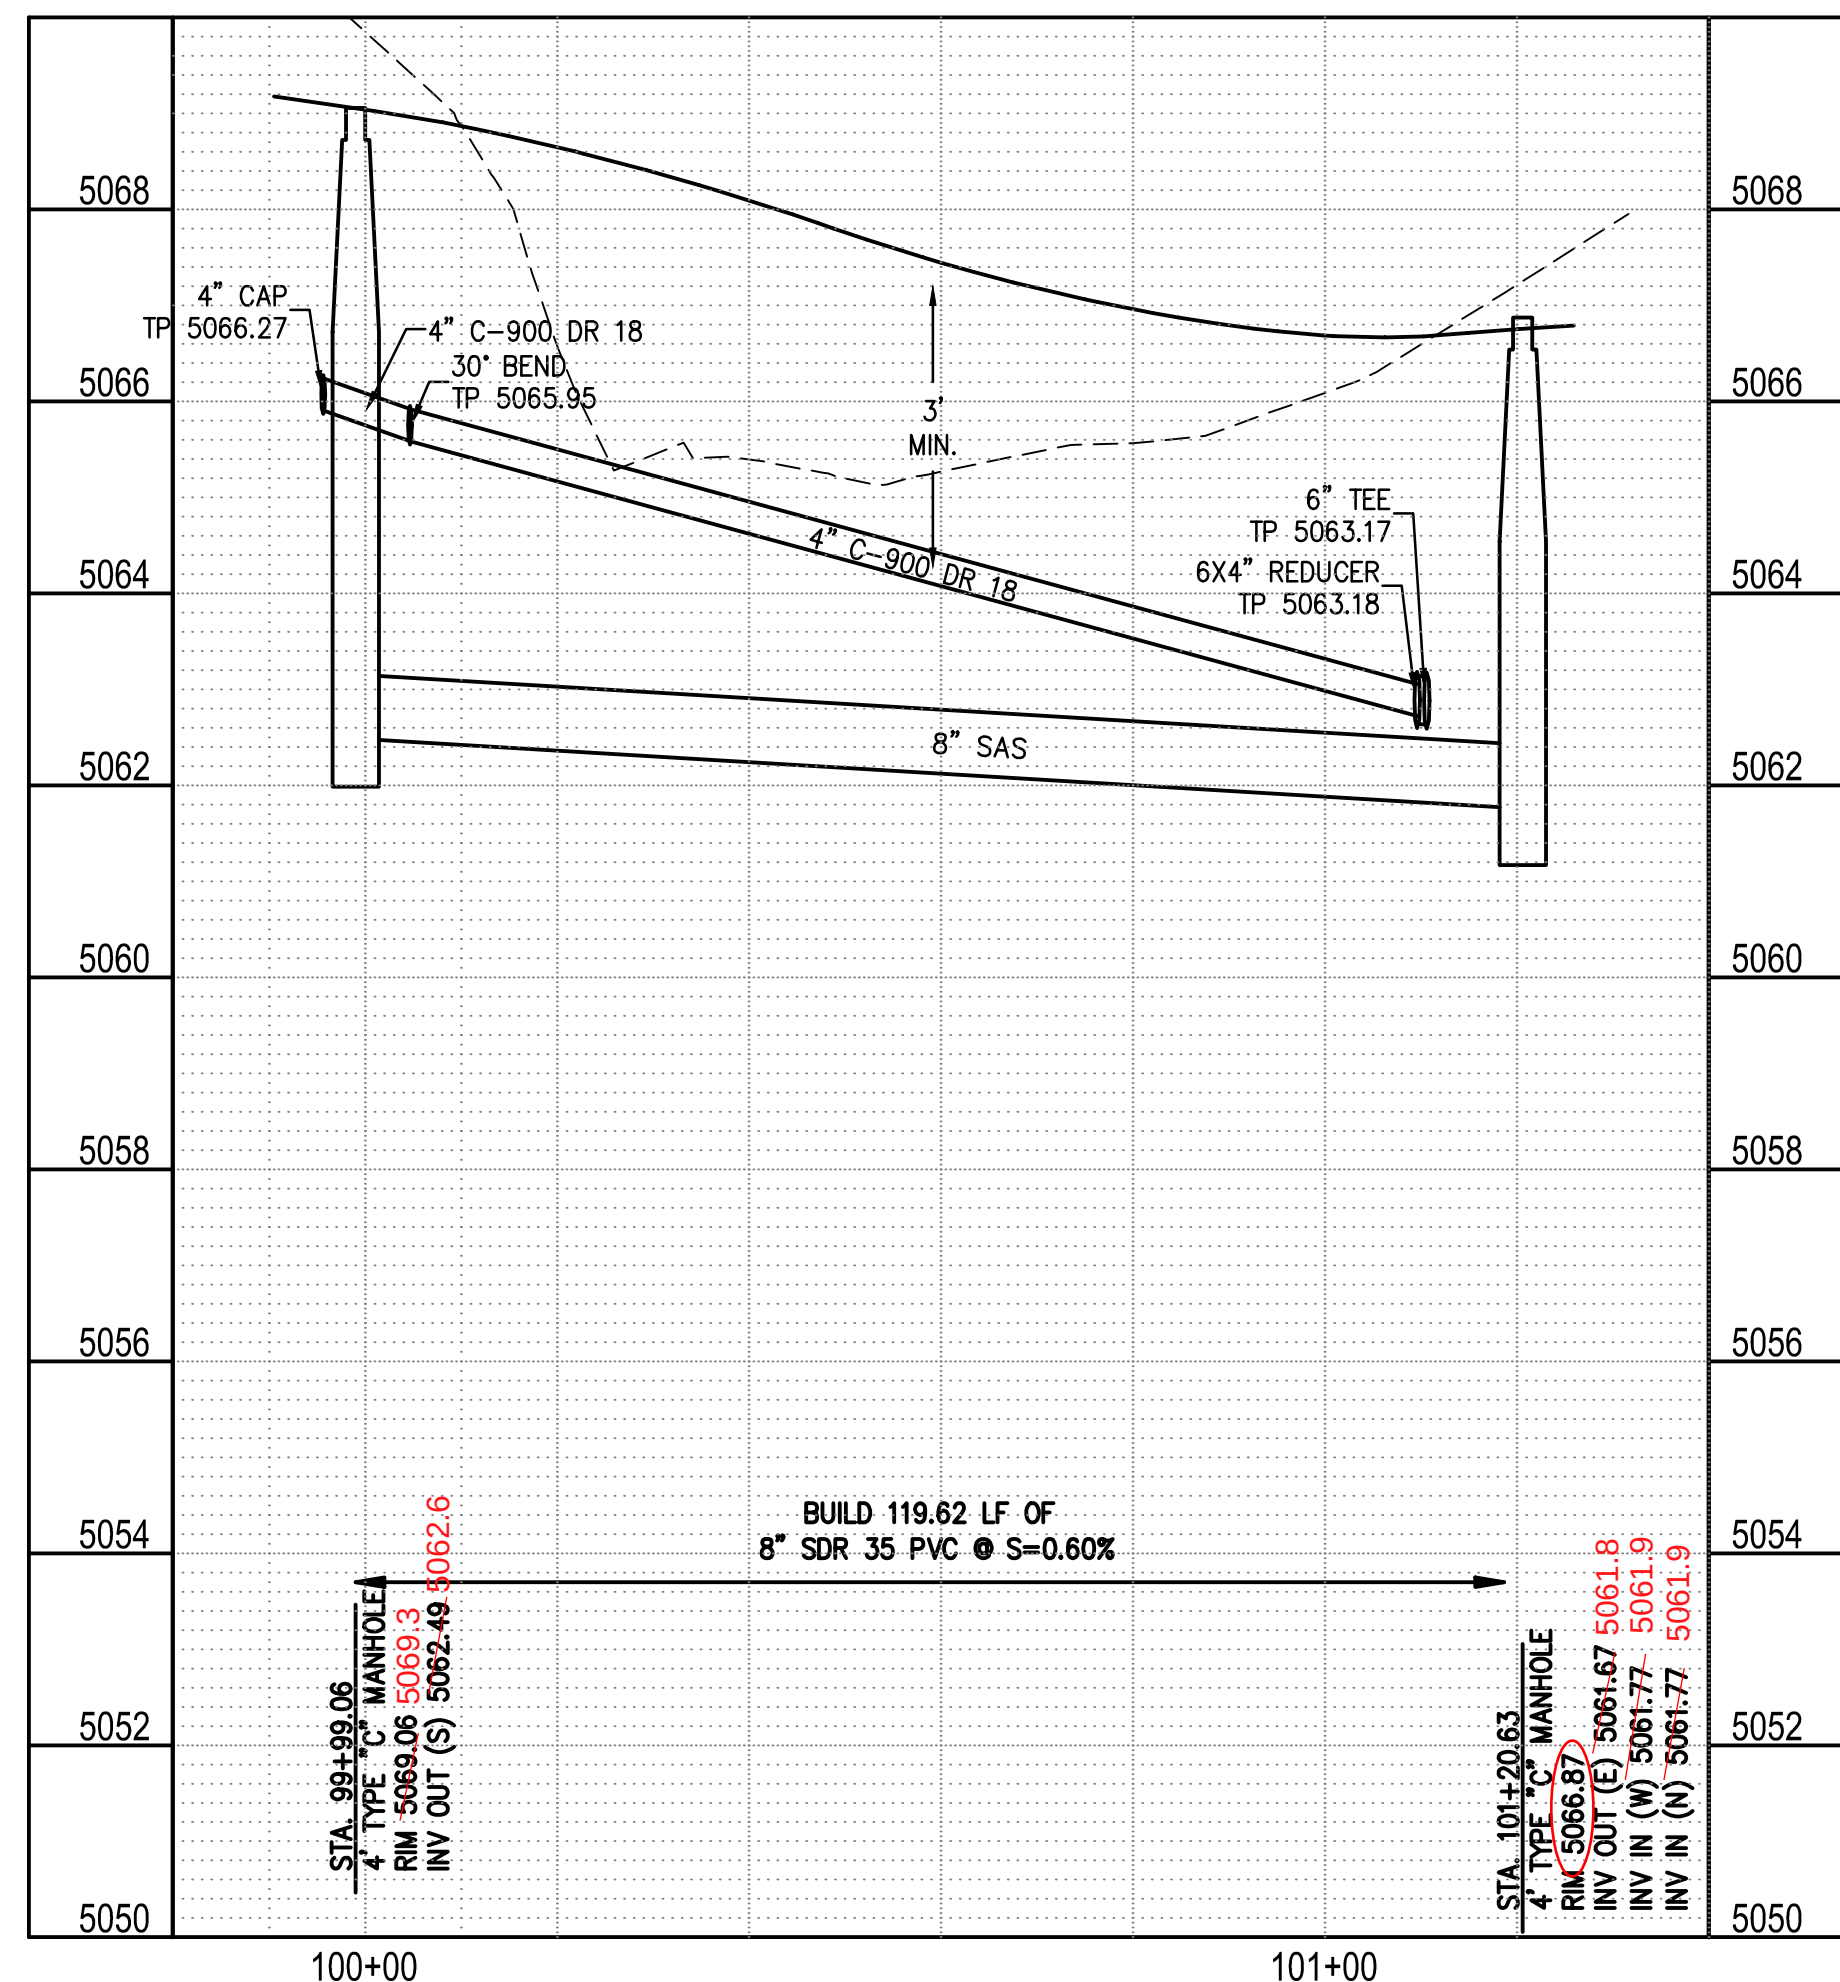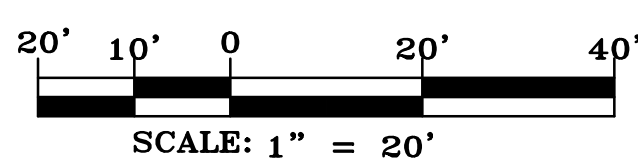


AEROSTAT PLACE SANITARY SEWER SERVICES				
LOT	SAS STATION & OFFSET	SAS LENGTH	INV BEGIN	TOP OF PIPE AT END
5	100+14.84 30.00' RT	25.00	5063.35	5063.68
6	100+39.84 30.00' RT	25.00	5062.70	5063.53
7	100+74.84 30.00' RT	25.00	5062.49	5063.32
8	100+99.84 30.00' RT	25.00	5062.26	5063.09

NOTE: STATIONING IS AT PUE


SAS LINE TABLE		
LINE	LENGTH	BEARING
S2	74.02	S 77°18'54" E
S3	41.21	S 77°18'54" E

MH CENTER TO CENTER

DISTANCE

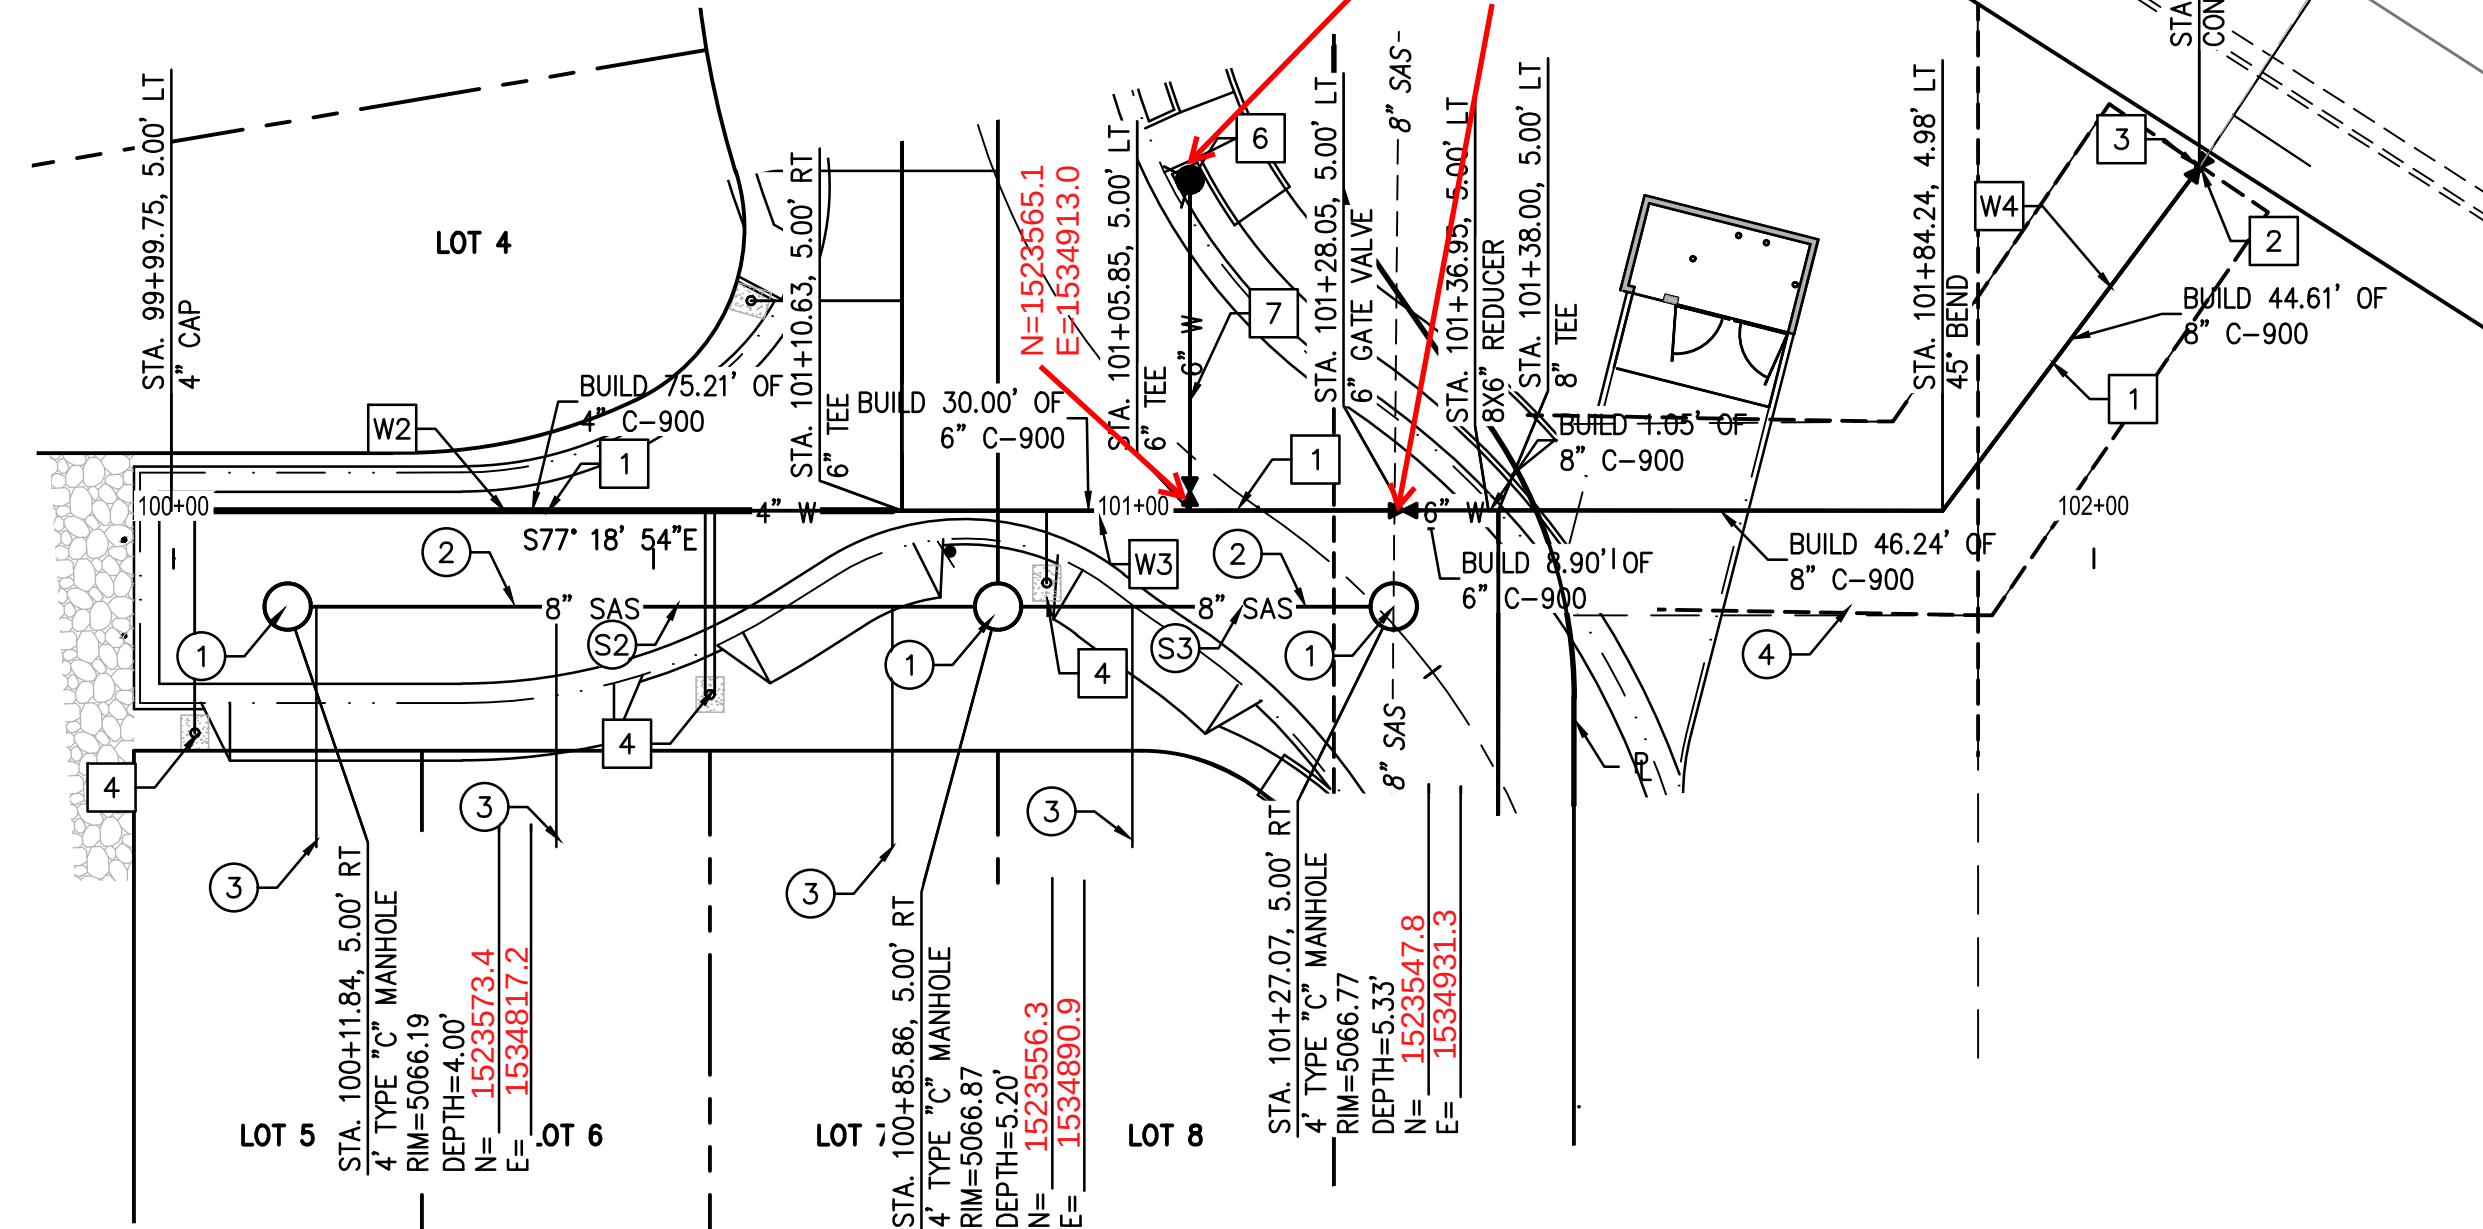

AEROSTAT PLACE

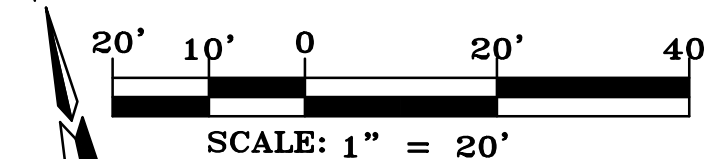


AEROSTAT PLACE COURT WATER SERVICES				
LOT NO.	ML STATION & OFFSET	GPS X-COORDINATE	GPS Y-COORDINATE	
5	10+80.23 15.98 LT	1534806.5	1523562.1	
6	11+26.23 15.98 LT	1534859.2	1523553.9	
7	11+26.23 15.98 LT	1534859.2	1523553.9	
8	12+17.75 44.71 LT	1534896.9	1523557.5	

NOTE: STATIONING IS AT METERS

WATER LINE TABLE		
LINE	LENGTH	BEARING
W2	76.11	S 77°18'54" E
W3	108.38	S 77°18'54" E

W4	44.61	S 32°18'
----	-------	----------

WATER LINE ALIGNMENT

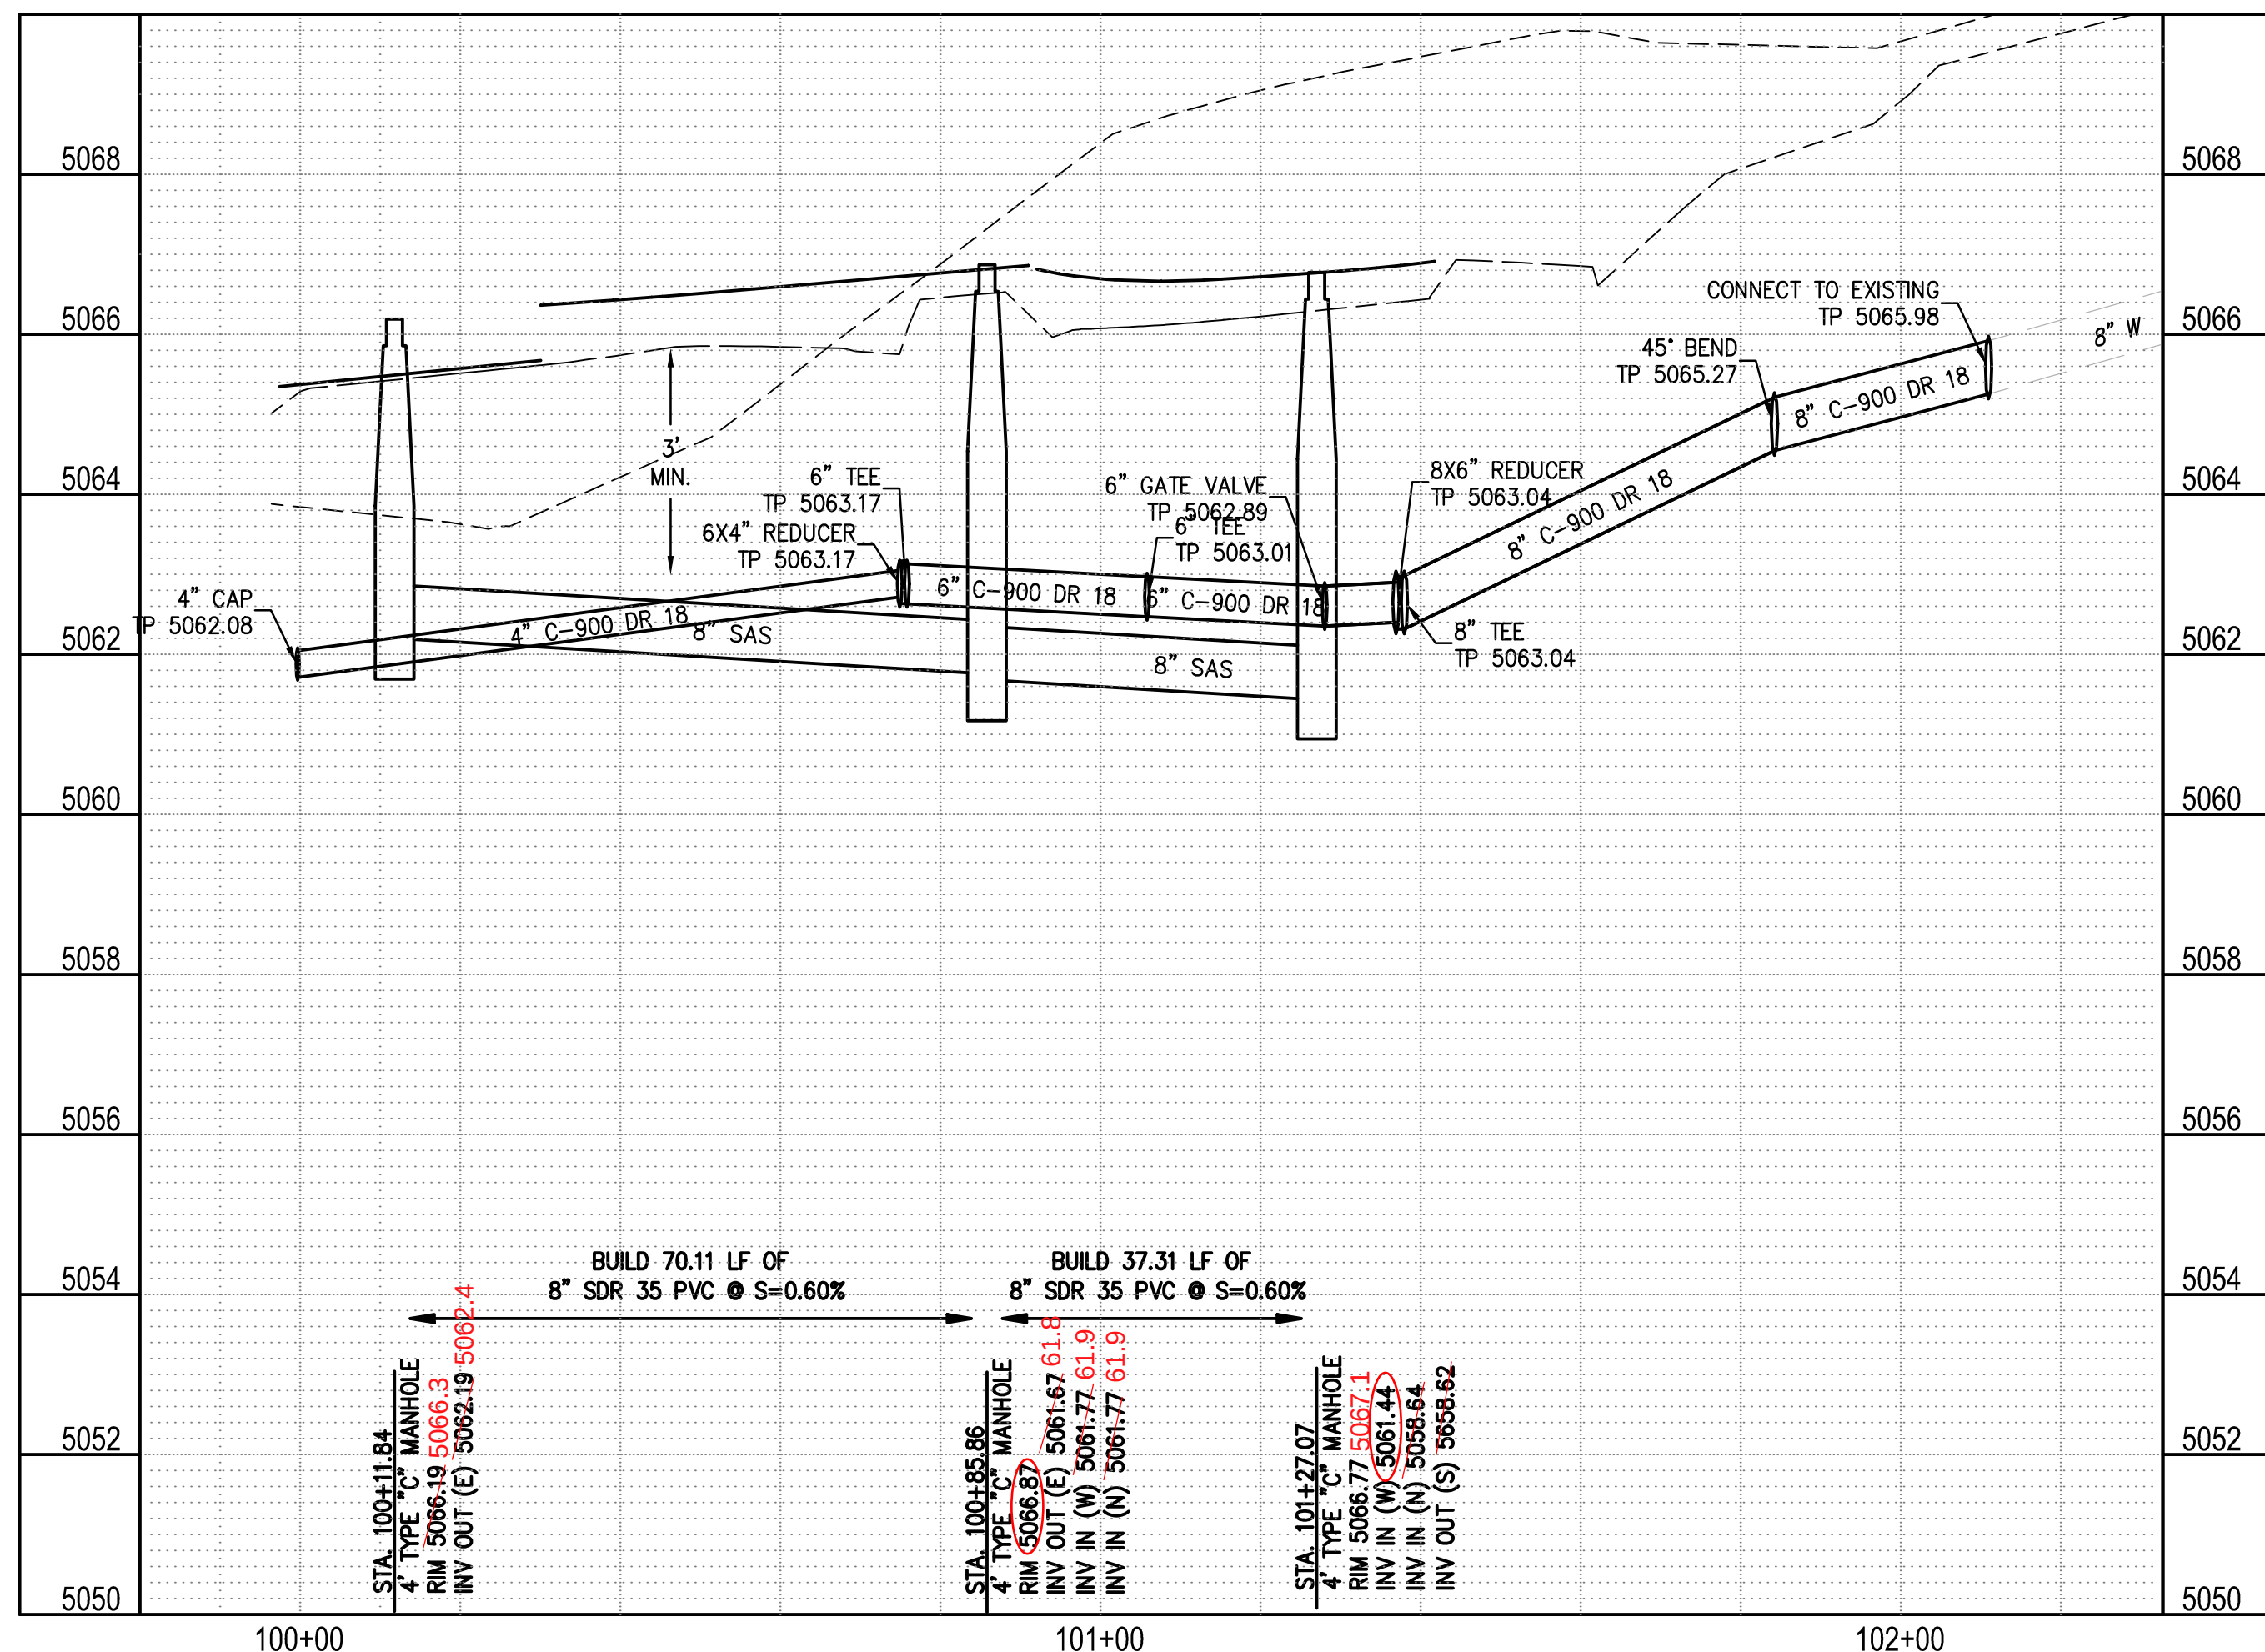

SEWER CONSTRUCTION NOTES	
I.D. #	DESCRIPTION
①	INSTALL 4' DIA. TYPE "C" MANHOLE PER COA STD. DTL. 2101, 2109
②	INSTALL 8" SEWER PIPE PER STD. SPEC. SEC. 901
③	INSTALL 4" SEWER SERVICE PER COA STD. DTL. 2125
④	INSTALL 8" CAP

WATER CONSTRUCTION NOTES	
I.D. #	DESCRIPTION
1	INSTALL WATERLINE PER STD. SPEC. SEC. 801
2	NON-PRESSURE CONNECTION OF NEW WATERLINE TO EXISTING WATERLINE PER COA STD. DTL. 2301
3	INSTALL GATE VALVE AND VALVE BOX PER COA STD. DTL. 2326, 2328
4	INSTALL 3/4" WATER SERVICE WITH METER BOX PER COA STD. DTLs. 2361 AND 2362
5	INSTALL 8" CAP
6	INSTALL FIRE HYDRANT PER COA STD. DTL. 2340, 2347
7	INSTALL HYDRANT LEG W/ TRACE WIRE AND "MEG A LUG" ALL FITTINGS AND JOINTS FROM TEE TO FIRE HYDRANT

SURVEY INFORMATION		BENCH MARKS	AS BUILT INFORMATION
NO.	FIELD NOTES		
	BY DATE	"ACS BM NM 448 N8" X=1,514,900.643 Y=1,512,770.226 (NAD 83), ELEV=5021.651 (NAVD 1988)	CONTRACTOR WORK STAKED BY DATE ACCEPTANCE BY DATE FIELD DRAWINGS DATE CORRECTED BY DATE MICRO-FILM INFORMATION
			RECORDED BY DATE NO.

1	8/25/20	SEWER DEPTH REVISION
NO.	DATE	REMARKS
		BY
REVISIONS		
DESIGN		
DESIGNED BY	REH	DATE 10/31/19
DRAWN BY	REH	DATE 12/07/19
CHECKED BY	REH	DATE 02/21/20

HORIZON VILLAGE SUBDIVISION HORIZON WAY ENTRY AND AEROSTAT PLACE UTILITY PLAN AND PROFILE													
DESIGN REVIEW COMMITTEE APPROVED Sept. 10, 2020 DESIGN REVIEW COMMITTEE	CITY ENGINEER APPROVAL APPROVED Sept. 10, 2020 CITY ENGINEER	LAST DESIGN UPDATE <table><tr><td>Mo./DAY/YR.</td><td>Mo./DAY/YR.</td></tr><tr><td></td><td></td></tr><tr><td></td><td></td></tr><tr><td></td><td></td></tr><tr><td></td><td></td></tr></table>	Mo./DAY/YR.	Mo./DAY/YR.									
Mo./DAY/YR.	Mo./DAY/YR.												
CITY PROJECT No. 799782	ZONE MAP No. C-17	SHEET 13 OF 15											

ALOFT PLACE SANITARY SEWER SERVICES				
LOT	SAS STATION & OFFSET	SAS LENGTH	INV BEGN	TOP OF PIPE AT END
9	10+45.52 29.00' RT	31.00	5057.82	5061.07
10	10+70.52 29.00' RT	31.00	5058.07	5061.11
11	11+00.52 29.00' RT	31.00	5058.37	5060.55
12	11+30.52 29.00' RT	31.00	5058.67	5060.28
13	11+54.52 29.00' RT	31.00	5058.91	5060.26
14	11+55.52 29.00' LT	27.00	5058.92	5060.58
15	11+31.52 29.00' LT	27.00	5058.68	5060.58
16	11+01.52 29.00' LT	27.00	5058.38	5060.71
17	10+71.52 29.00' LT	27.00	5058.08	5061.28
18	10+46.52 29.00' LT	27.00	5057.83	5061.27

NOTE: STATIONING IS AT PUE

ALOFT PLACE WATER SERVICES				
LOT NO.	WL STATION & OFFSET	GPS X-COORDINATE	GPS Y-COORDINATE	
9	10+39.06 17.78 RT			
10	10+90.50 17.15 RT			
11	10+90.50 17.15 RT			
12	11+48.00 17.15 RT			
13	11+48.00 17.15 RT			
14	11+47.99 17.15 LT			
15	11+47.99 17.15 LT			
16	10+90.49 17.15 LT			
17	10+90.49 17.15 LT			
18	10+39.06 17.78 LT			



NOTE: STATIONING IS AT METER

AWAY PLACE SANITARY SEWER SERVICES				
LOT	SAS STATION & OFFSET	SAS LENGTH	INV BEGN	TOP OF PIPE AT END
19	10+45.52 29.00' RT	31.00	5056.08	5061.57
20	10+70.52 29.00' RT	31.00	5056.58	5061.57
21	11+00.52 29.00' RT	31.00	5057.18	5061.10
22	11+30.52 29.00' RT	31.00	5057.78	5061.24
23	11+54.52 29.00' RT	31.00	5058.26	5061.24
24	11+55.52 29.00' LT	27.00	5058.28	5061.17
25	11+31.52 29.00' LT	27.00	5057.80	5061.17
26	11+01.52 29.00' LT	27.00	5057.20	5061.22
27	10+71.52 29.00' LT	27.00	2056.60	5061.49
28	10+46.52 29.00' LT	27.00	5056.10	5061.49



NOTE: STATIONING IS AT PUE

AWAY PLACE WATER SERVICES				
LOT NO.	WL STATION & OFFSET	GPS X-COORDINATE	GPS Y-COORDINATE	
19	10+39.06 17.78 RT			
20	10+90.50 17.15 RT			
21	10+90.50 17.15 RT			
22	11+48.00 17.15 RT			
23	11+48.00 17.15 RT			
24	11+48.00 17.15 RT			
25	11+48.00 17.15 RT			
26	10+90.50 17.15 RT			
27	10+90.50 17.15 RT			
28	10+39.06 15.98 RT			

NOTE: STATIONING IS AT METER

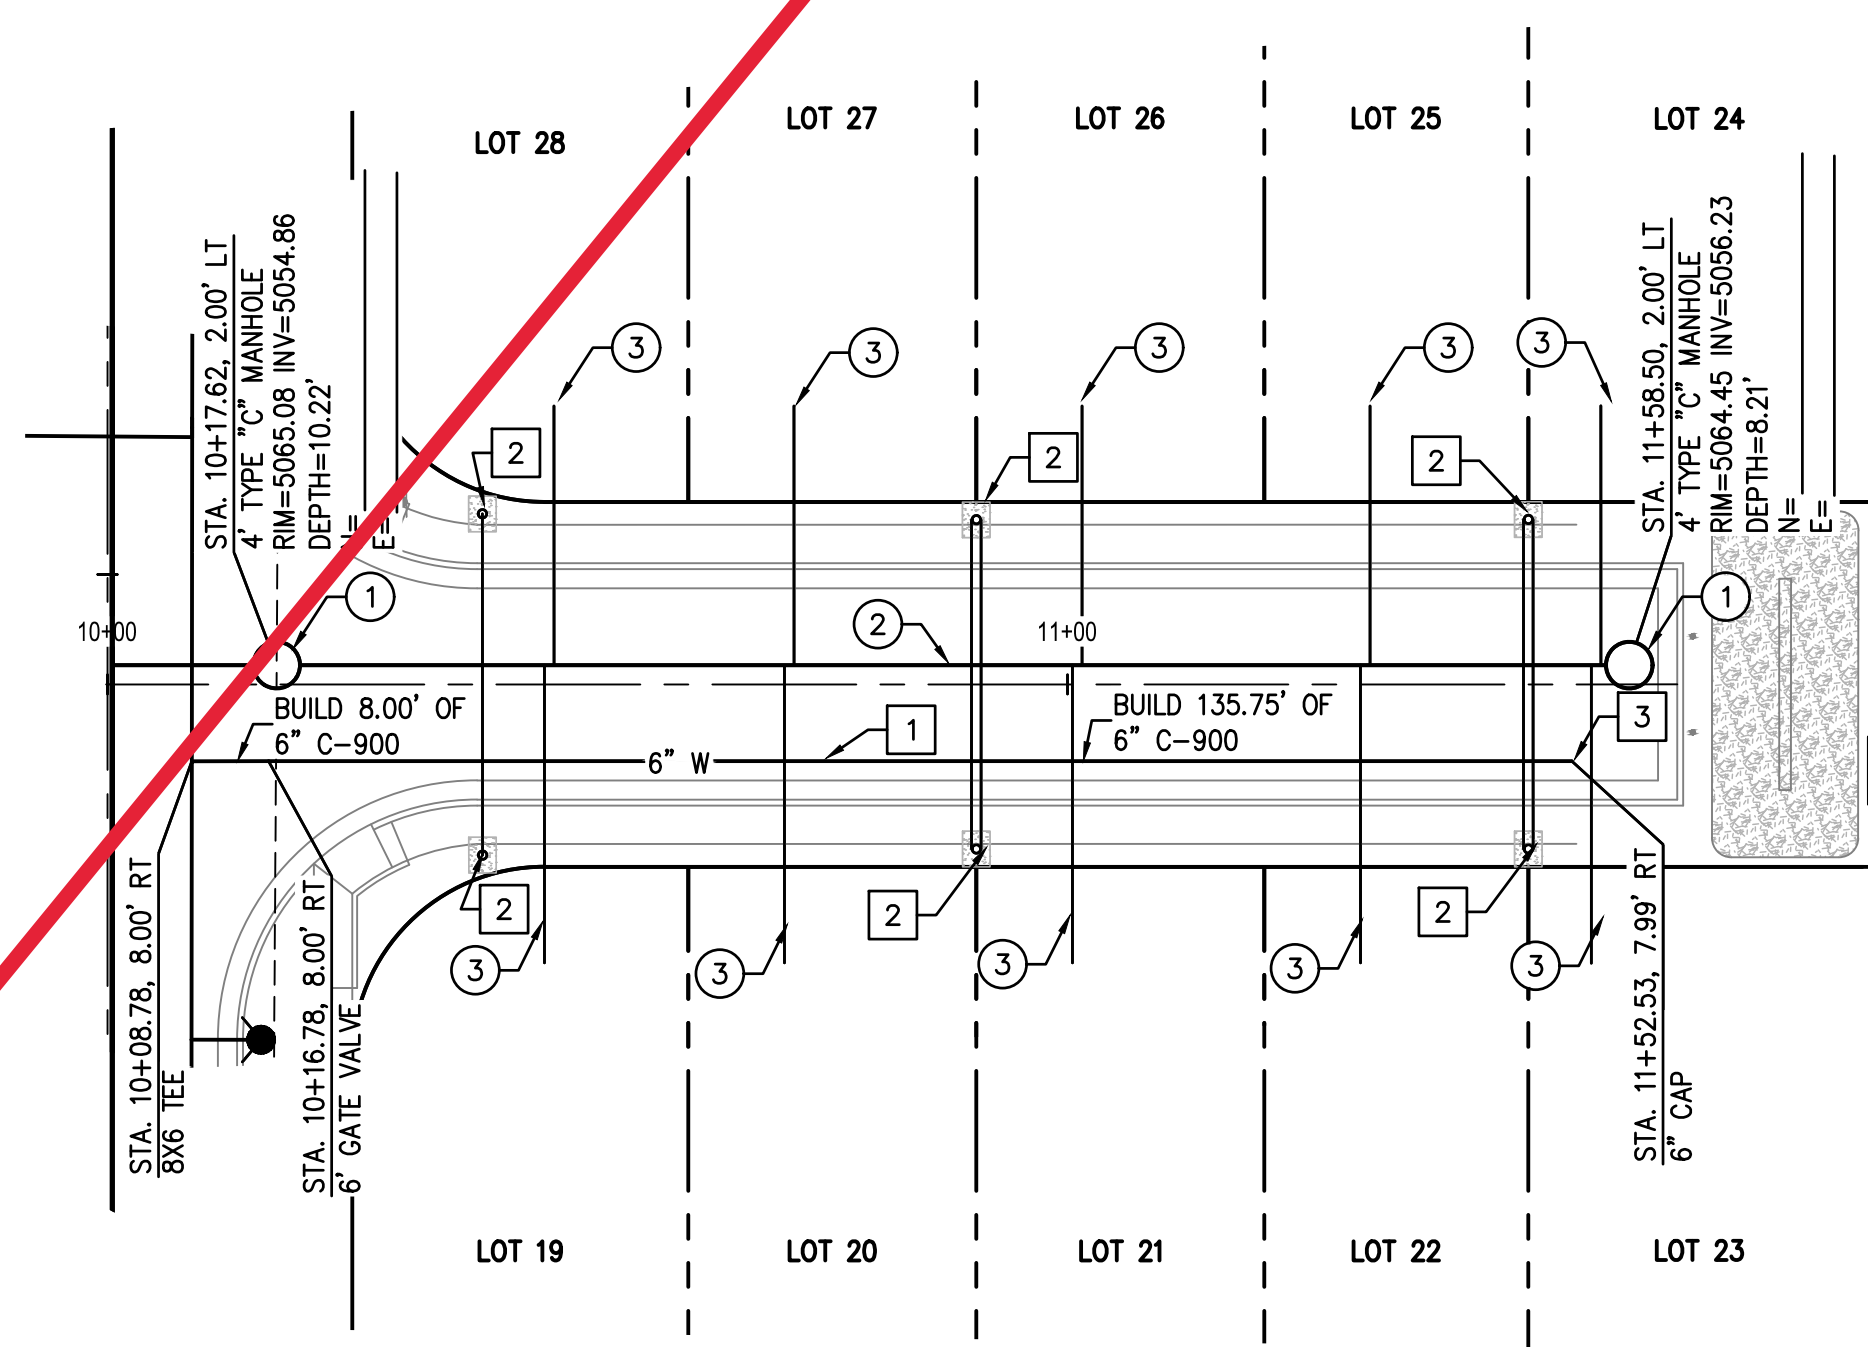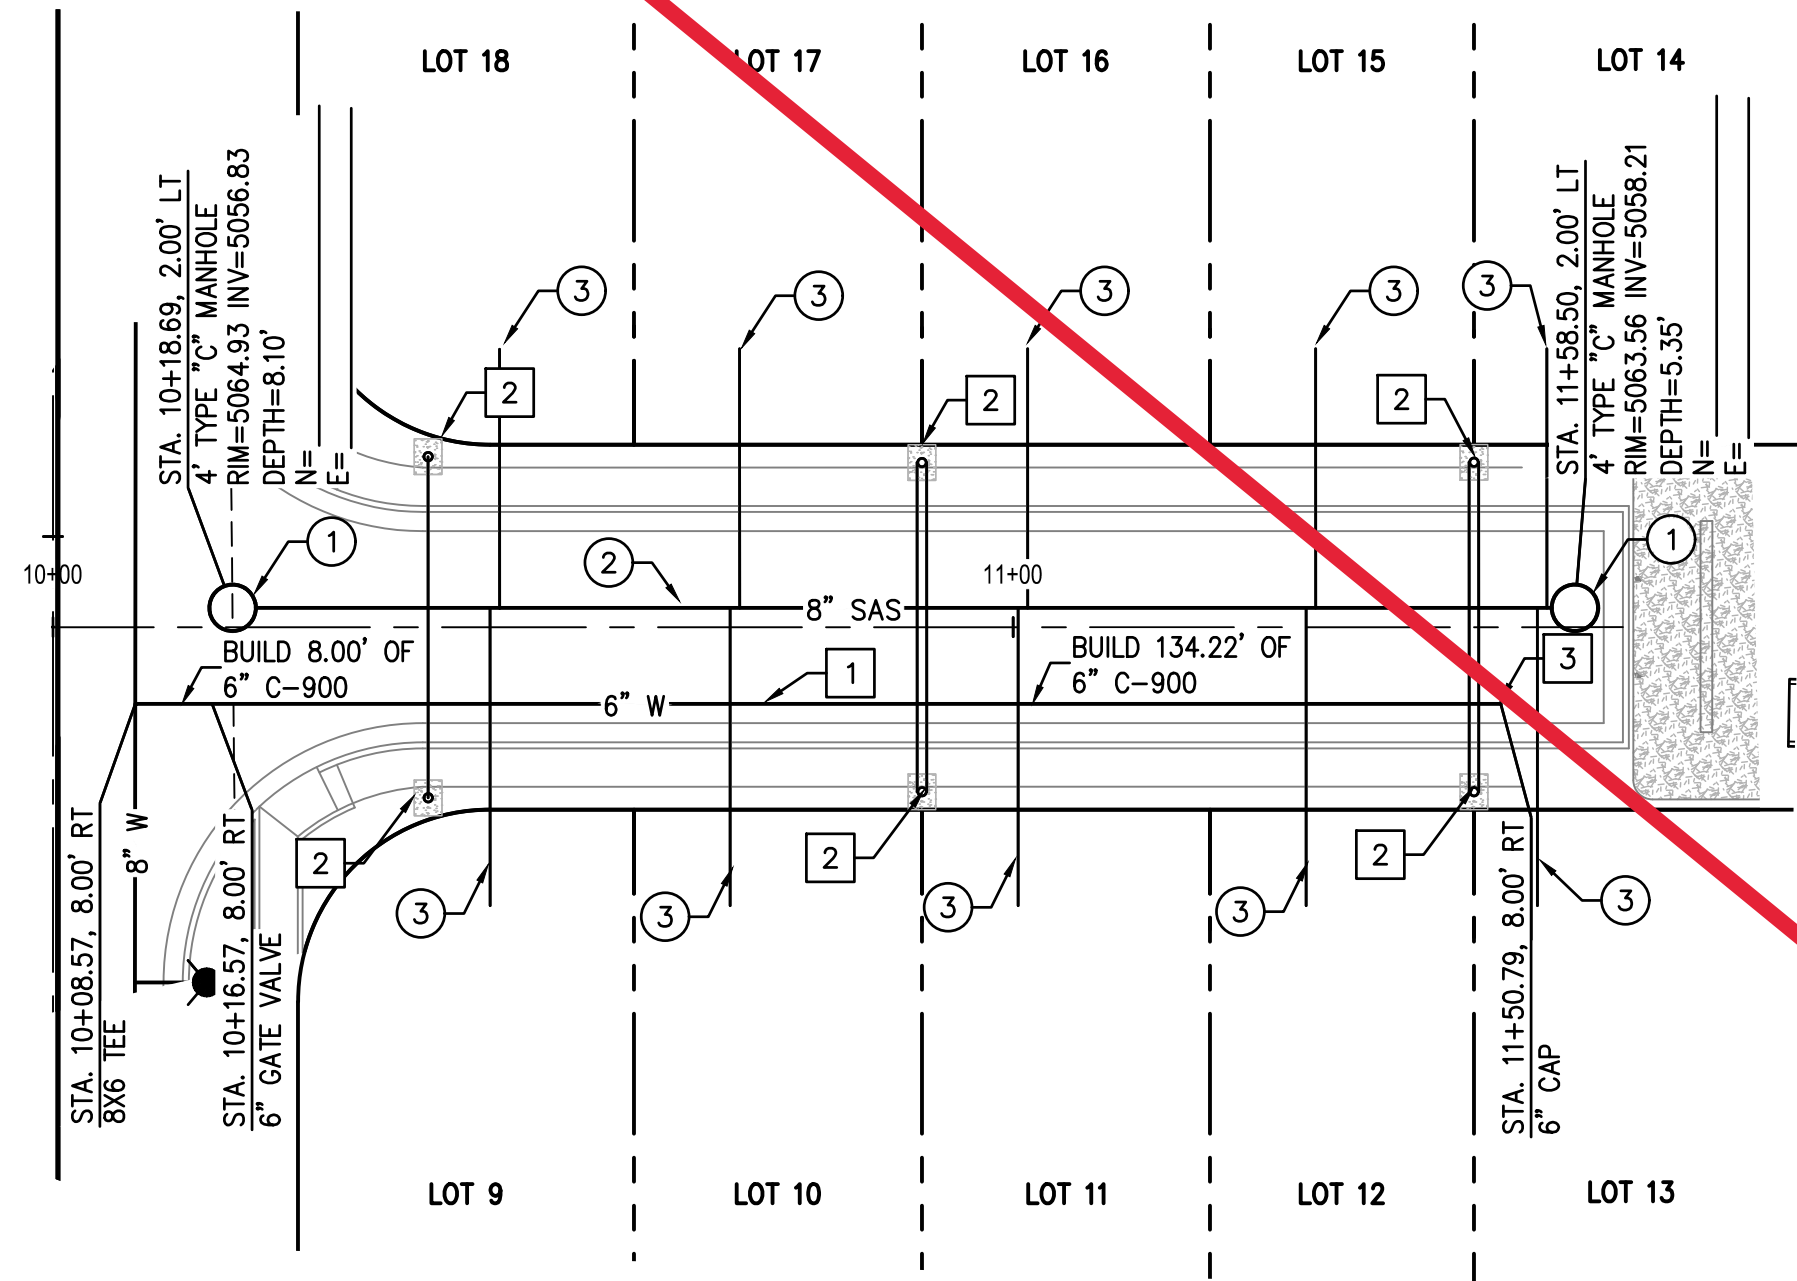

SUPERSEDED -- SEE SHEET 14R, Rev. 9/10//2020.

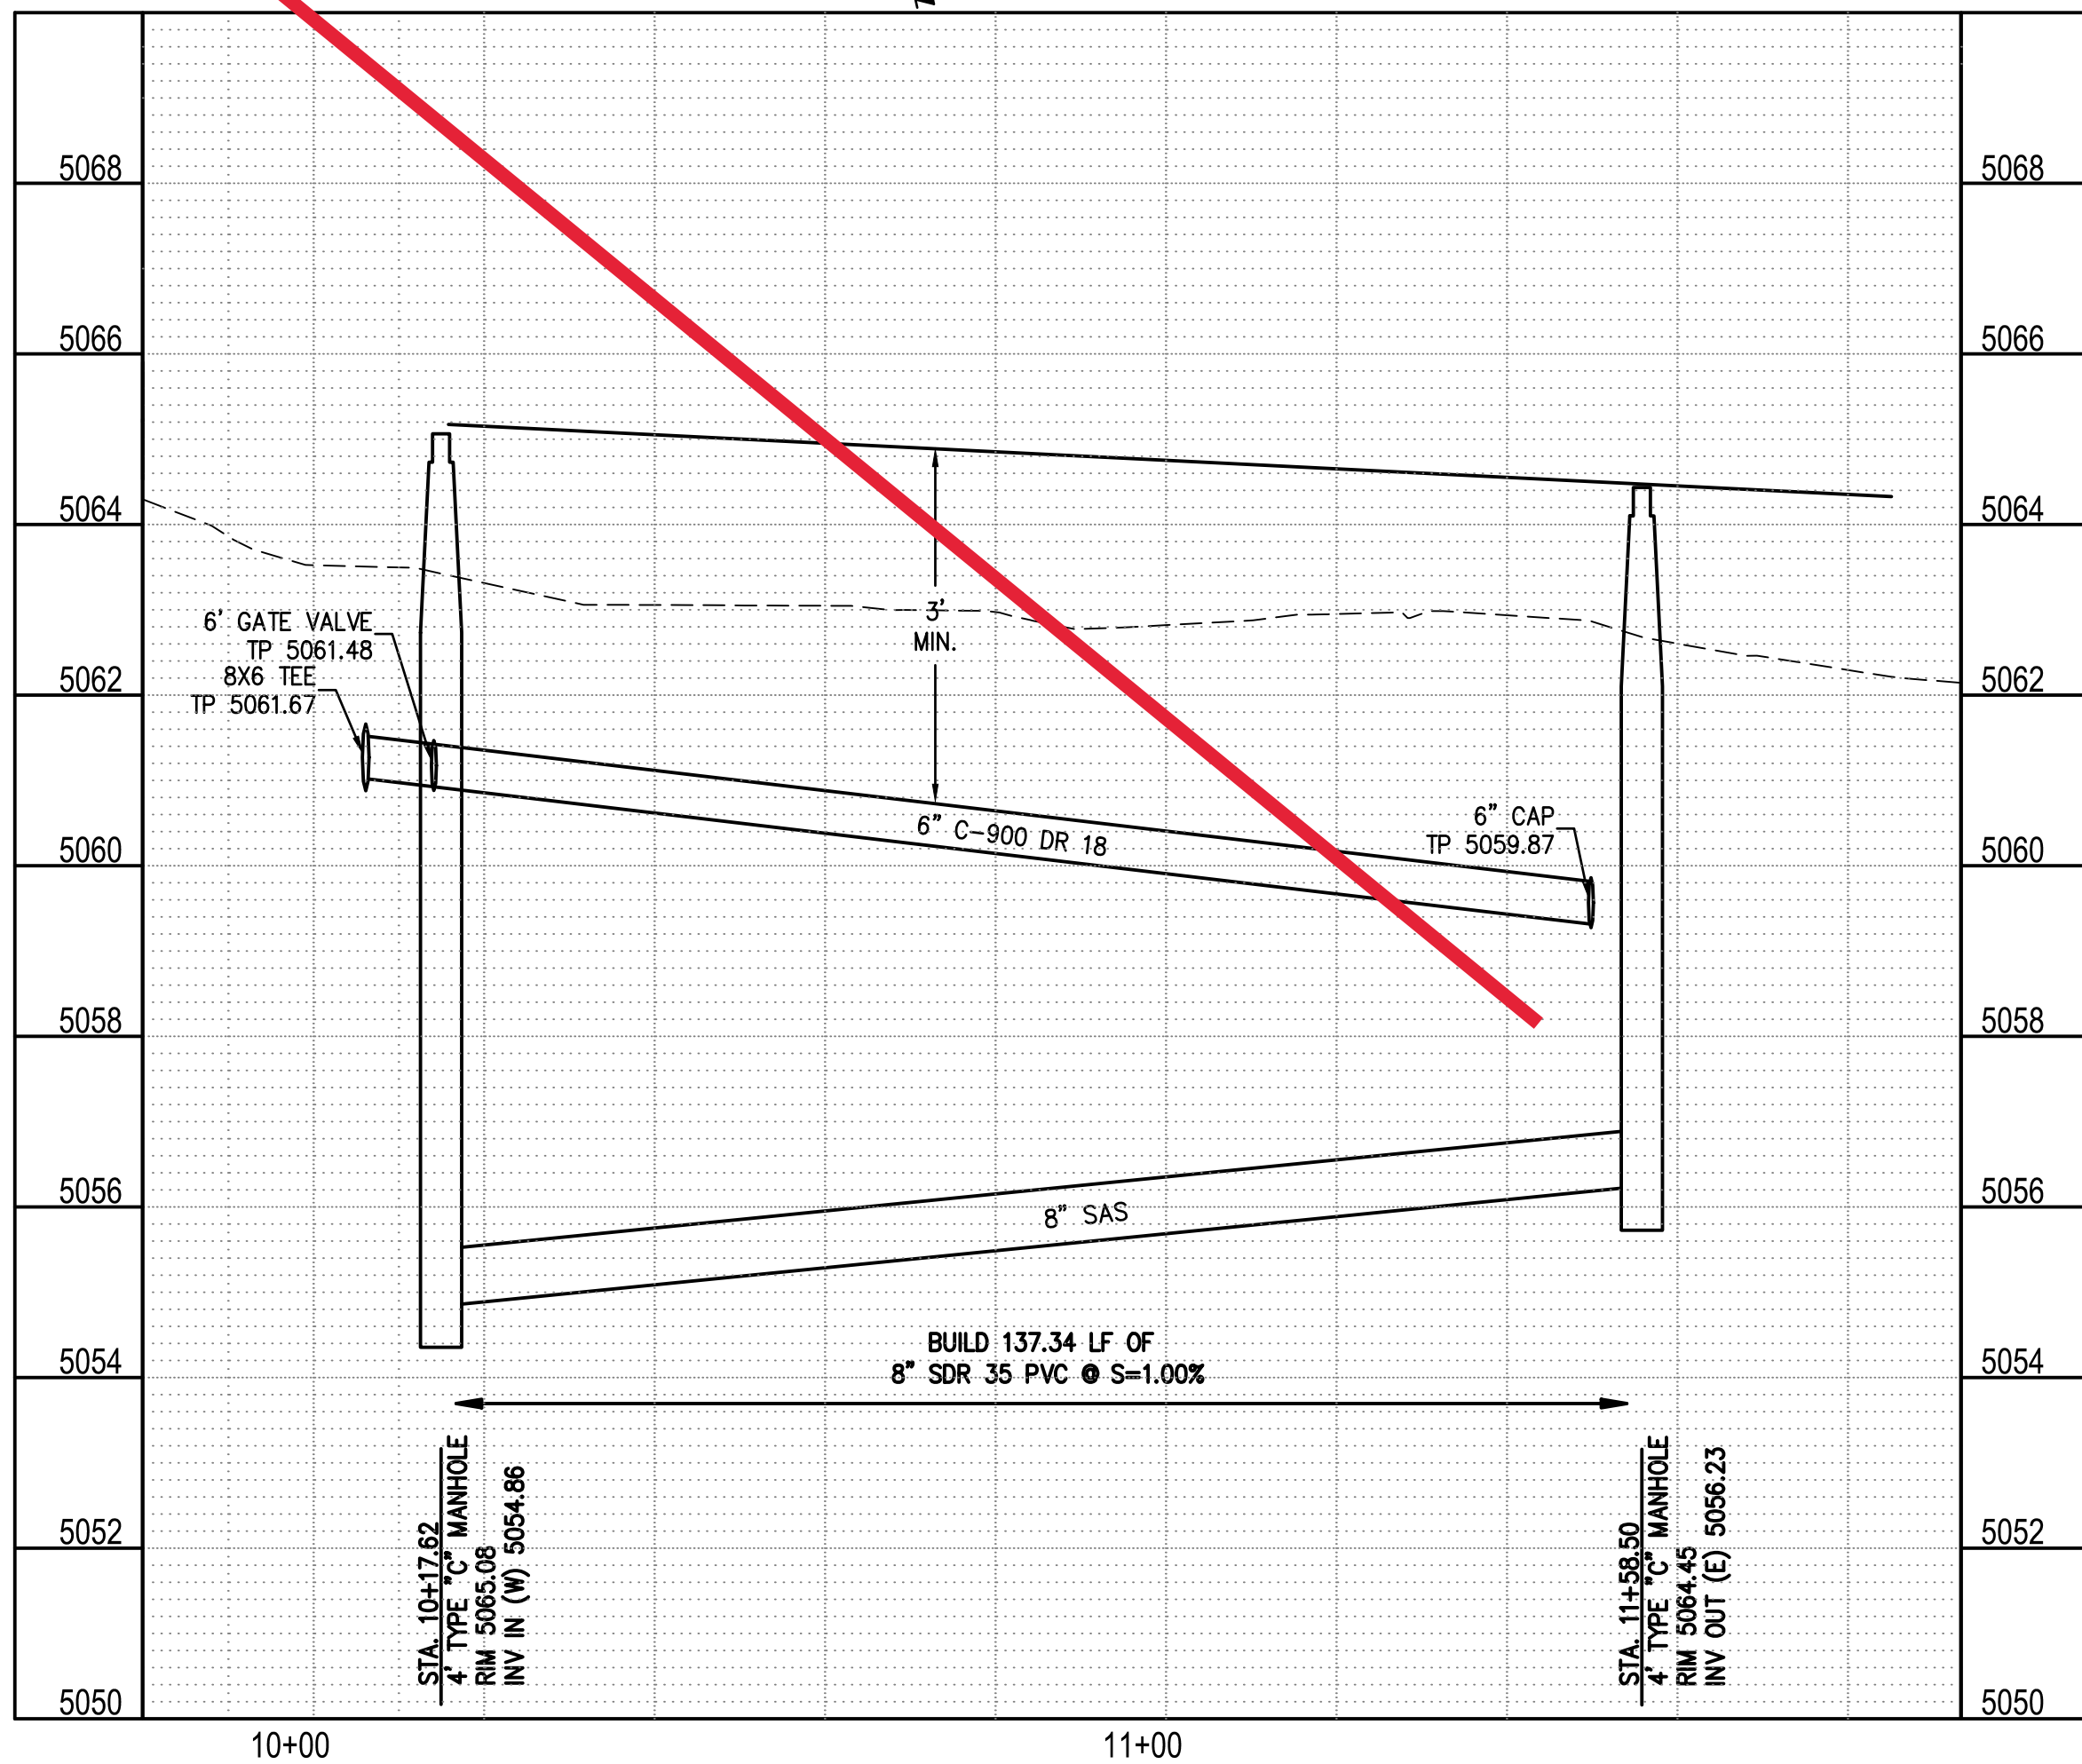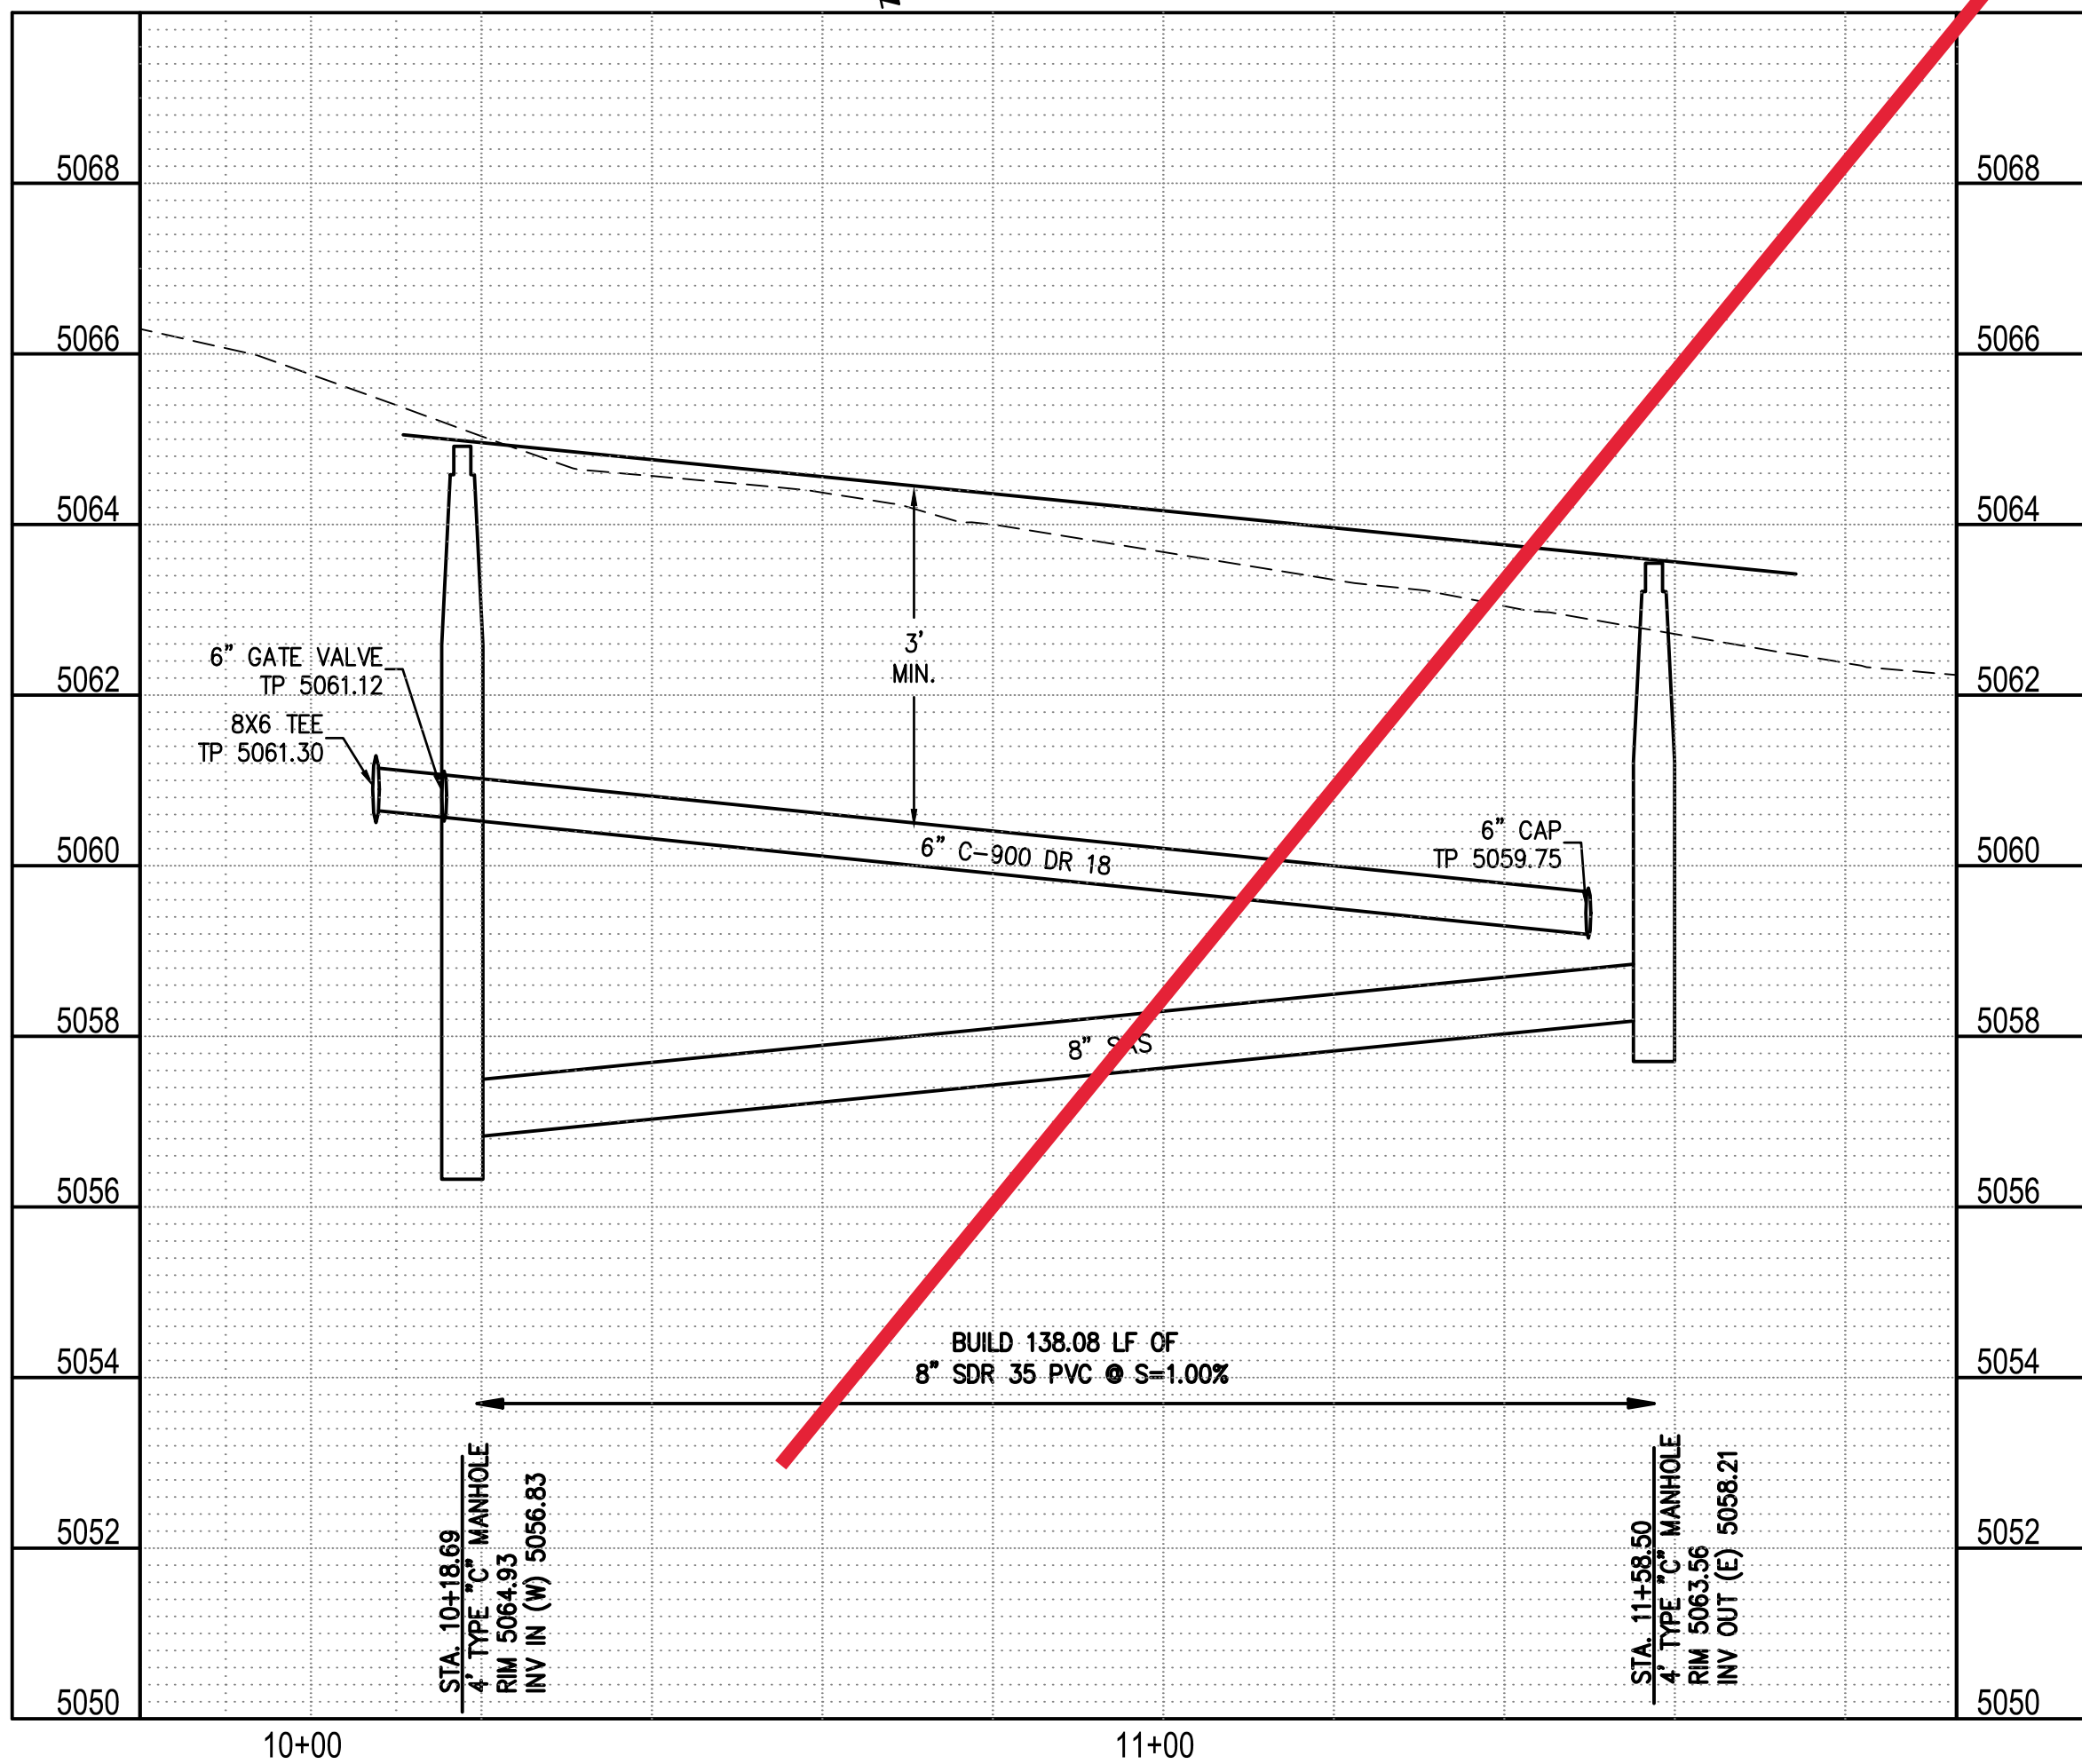

SEWER CONSTRUCTION NOTES	
I.D.#	DESCRIPTION
1	INSTALL 4" DIA. TYPE "C" MANHOLE PER COA STD. DTL. 2101, 2109
2	INSTALL 8" SEWER PIPE PER STD. SPEC. SEC. 901
3	INSTALL 4" SEWER SERVICE PER COA STD. DTL. 2125

WATER CONSTRUCTION NOTES	
I.D.#	DESCRIPTION
1	INSTALL WATERLINE PER STD. SPEC. SEC. 801
2	INSTALL 3/4" WATER SERVICE WITH METER BOX PER COA STD. DTLs. 2361 AND 2362
3	INSTALL 6" CAP

SURVEY INFORMATION	
NO.	FIELD NOTES
1	DATE
2	BY
3	DATE
4	BY
5	DATE
28	BY

ENGINEER'S SEAL	
NO.	REMARKS
1	DATE
2	BY
3	DATE
4	BY
5	DATE
28	BY

BENCH MARKS	
NO.	DESCRIPTION
1	DATE
2	BY
3	DATE
4	BY
5	DATE
28	BY

LEGEND	
NO.	DESCRIPTION
1	DATE
2	BY
3	DATE
4	BY
5	DATE
28	BY

HORIZON VILLAGE SUBDIVISION	
NO.	DESCRIPTION
1	DATE
2	BY
3	DATE
4	BY
5	DATE
28	BY


CITY PROJECT No. 799782	
NO.	DESCRIPTION
1	DATE
2	BY
3	DATE
4	BY
5	DATE
28	BY

ALOFT PLACE SANITARY SEWER SERVICES				
LOT	SAS STATION & OFFSET	SAS LENGTH	INV BEGN	TOP OF PIPE AT END
9	10+45.52 29.00' RT	31.00	5060.36	5061.22
10	10+70.52 29.00' RT	31.00	5060.51	5061.38
11	11+00.52 29.00' RT	31.00	5060.66	5061.53
12	11+30.52 29.00' RT	31.00	5060.87	5061.74
13	11+54.52 29.00' RT	31.00	5061.02	5061.88
14	11+55.52 29.00' LT	27.00	5061.02	5061.88
15	11+31.52 29.00' LT	27.00	5060.88	5060.75
16	11+01.52 29.00' LT	27.00	5060.65	5061.52
17	10+71.52 29.00' LT	27.00	5060.52	5061.56
18	10+46.52 29.00' LT	27.00	5060.37	5061.30


NOTE: STATIONING IS AT PUE

ALOFT PLACE WATER SERVICES				
LOT NO.	STATION & OFFSET	GPS X-COORDINATE	GPS Y-COORDINATE	
9	10+39.06 17.78 RT	1534873.0	1523379.6	
10	10+90.50 17.15 RT	1534822.8	1523390.4	
11	10+90.50 17.15 RT	1534822.8	1523390.4	
12	11+48.00 17.15 RT	1534766.6	1523403.0	
13	11+48.00 17.15 RT	1534766.6	1523403.0	
14	11+47.99 17.15 LT	1534759.2	1523369.7	
15	11+47.99 17.15 LT	1534759.2	1523369.7	
16	10+90.49 17.15 LT	1534815.6	1523357.0	
17	10+90.49 17.15 LT	1534815.6	1523357.0	
18	10+39.06 17.78 LT	1534865.8	1523344.8	

NOTE: STATIONING IS AT METER

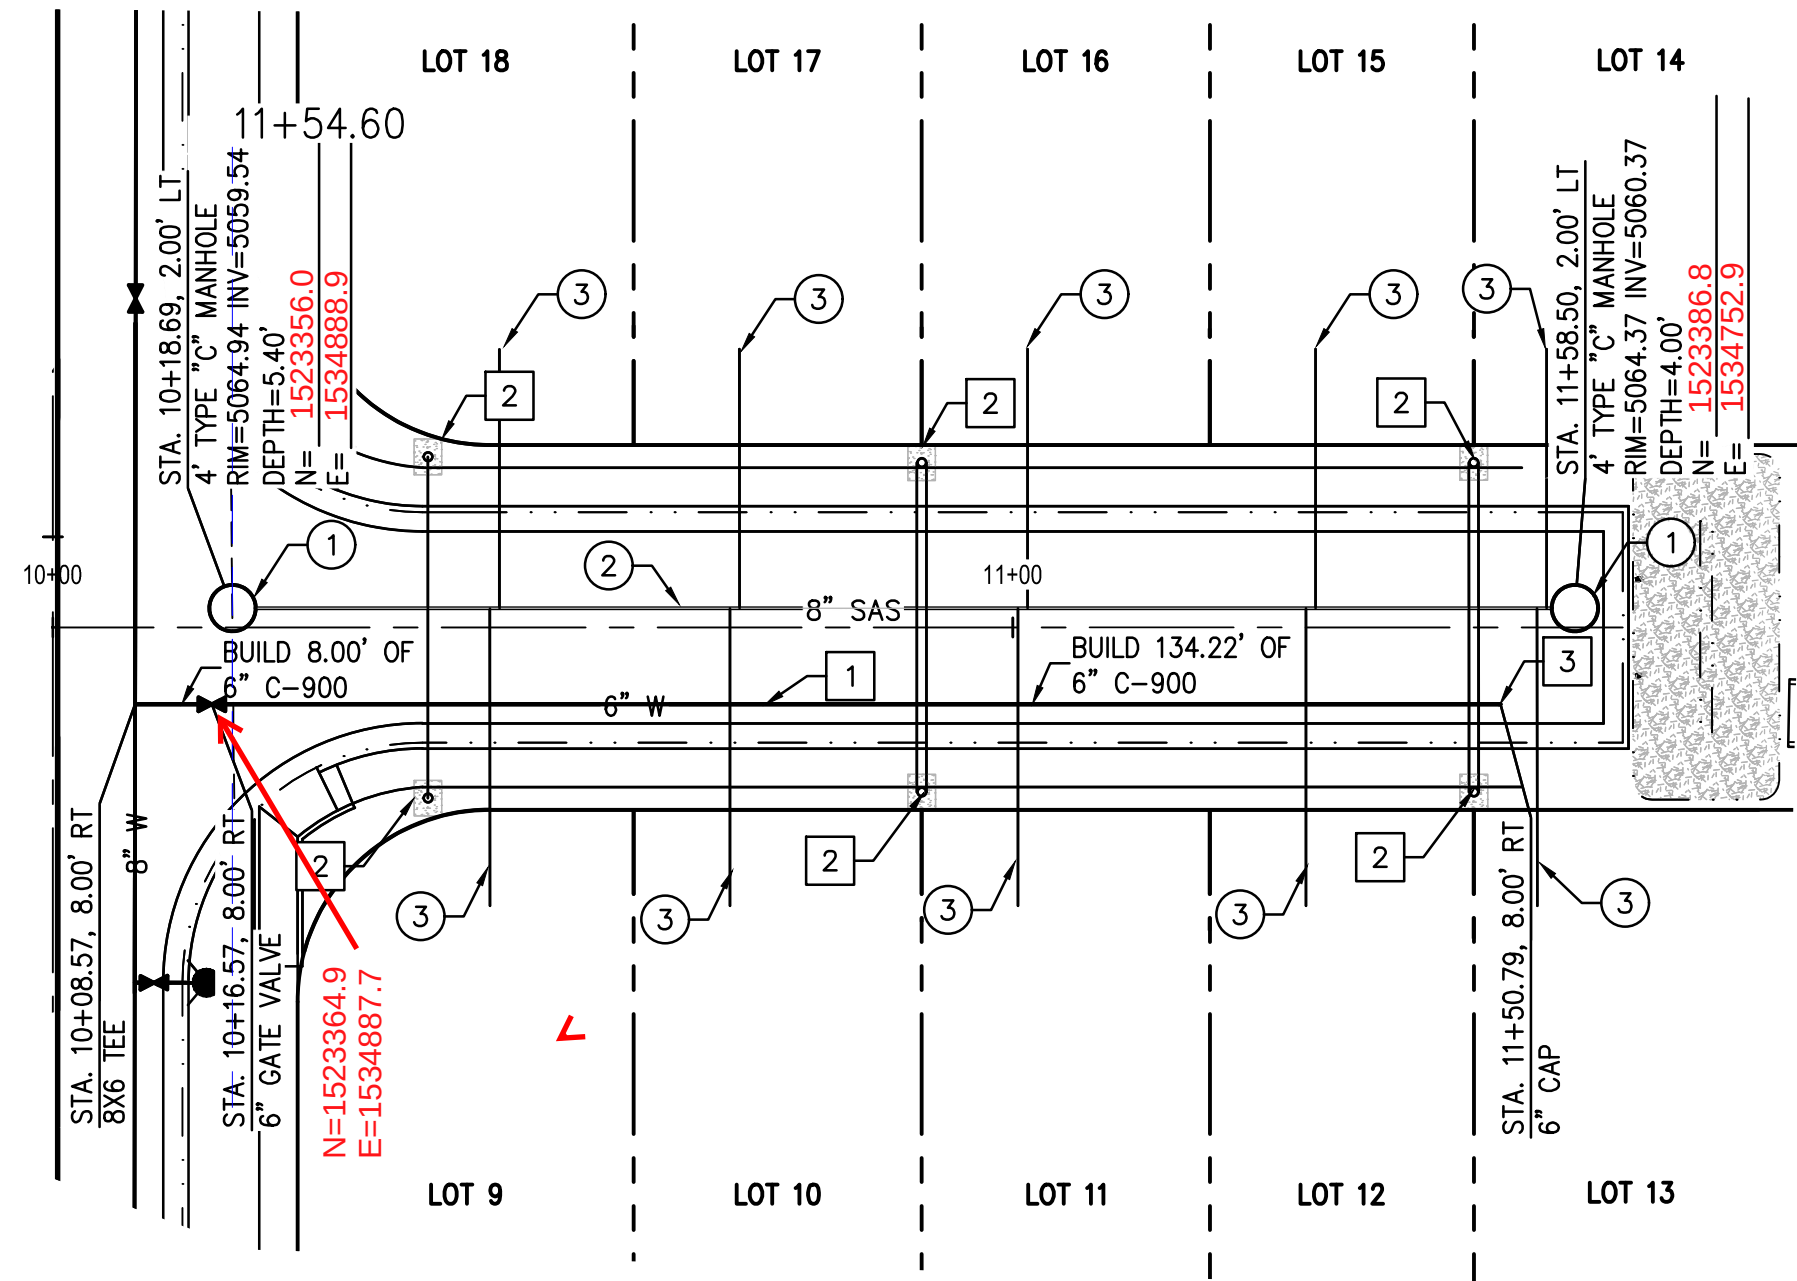

ALOFT PLACE

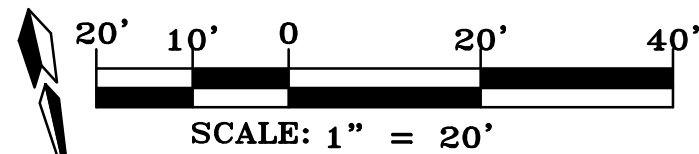


AWAY PLACE SANITARY SEWER SERVICES				
LOT	SAS STATION & OFFSET	SAS LENGTH	INV BEGN	TOP OF PIPE AT END
19	10+45.52 29.00' RT	31.00	5058.60	5061.56
20	10+70.52 29.00' RT	31.00	5058.75	5061.56
21	11+00.52 29.00' RT	31.00	5058.93	5061.20
22	11+30.52 29.00' RT	31.00	5059.10	5061.27
23	11+54.52 29.00' RT	31.00	5059.25	5061.23
24	11+55.52 29.00' LT	27.00	5059.26	5061.17
25	11+31.52 29.00' LT	27.00	5059.12	5061.17
26	11+01.52 29.00' LT	27.00	5058.94	5061.22
27	10+71.52 29.00' LT	27.00	5058.76	5061.49
28	10+46.52 29.00' LT	27.00	5058.61	5061.49


NOTE: STATIONING IS AT PUE

AWAY PLACE WATER SERVICES				
LOT NO.	STATION & OFFSET	GPS X-COORDINATE	GPS Y-COORDINATE	
19	10+39.06 17.78 RT	1534829.5	1523186.9	
20	10+90.50 17.15 RT	1534779.4	1523197.6	
21	10+90.50 17.15 RT	1534779.4	1523197.6	
22	11+48.00 17.15 RT	1534722.8	1523210.2	
23	11+48.00 17.15 RT	1534722.8	1523210.2	
24	11+48.00 17.15 RT	1534715.6	1523176.6	
25	11+48.00 17.15 RT	1534715.6	1523176.6	
26	10+90.50 17.15 RT	1534771.9	1523164.0	
27	10+90.50 17.15 RT	1534771.9	1523164.0	
28	10+39.06 15.98 RT	1534821.4	1523152.2	

NOTE: STATIONING IS AT METER

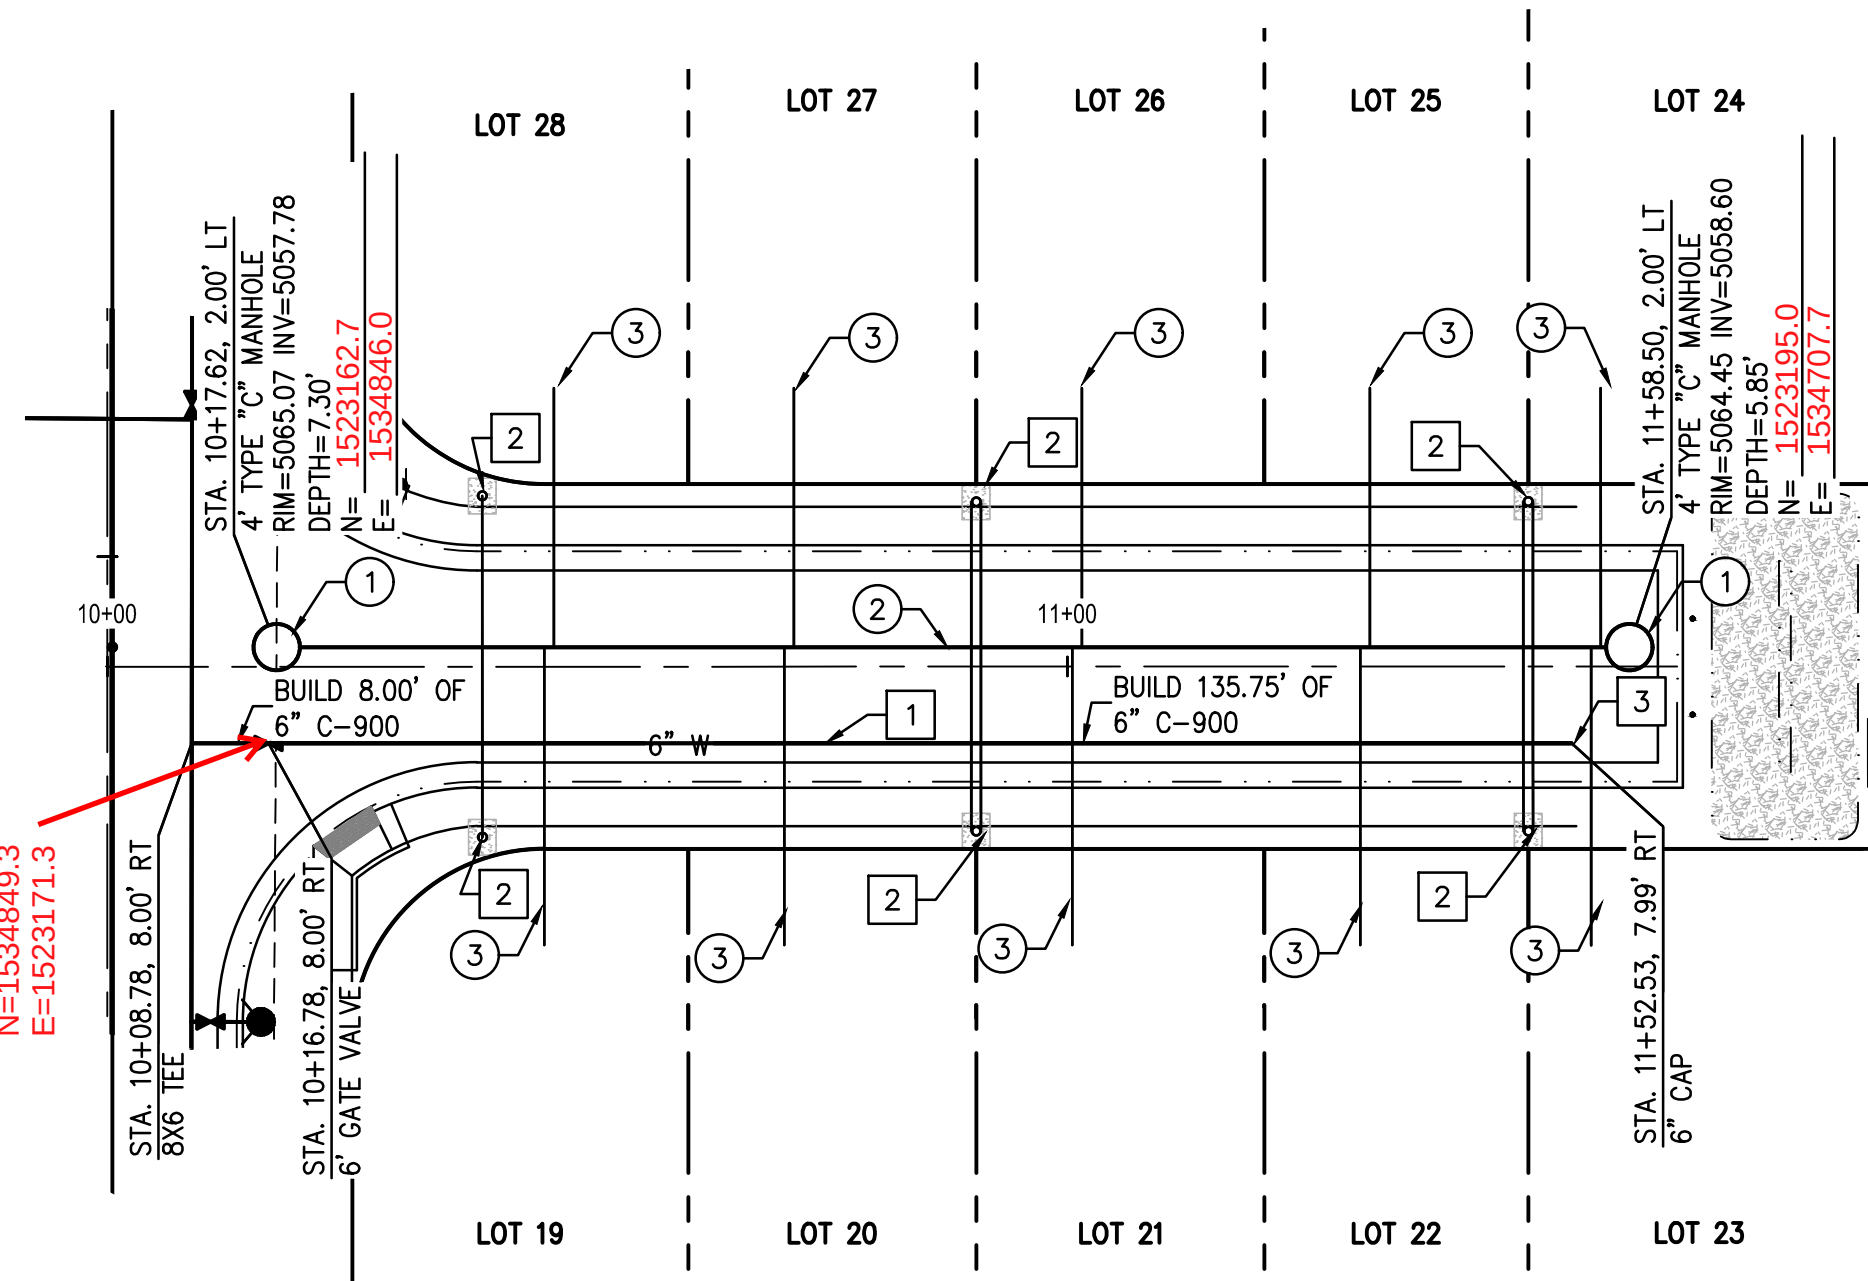

AWAY PLACE

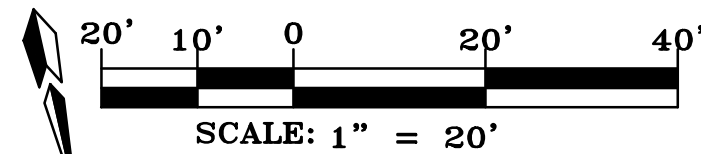



SEWER CONSTRUCTION NOTES	
I.D.#	DESCRIPTION
1	INSTALL 4" DIA. TYPE "C" MANHOLE PER COA STD. DTL. 2101, 2109
2	INSTALL 8" SEWER PIPE PER STD. SPEC. SEC. 901
3	INSTALL 4" SEWER SERVICE PER COA STD. DTL. 2125

WATER CONSTRUCTION NOTES	
I.D.#	DESCRIPTION
1	INSTALL WATERLINE PER STD. SPEC. SEC. 801
2	INSTALL 3/4" WATER SERVICE WITH METER BOX PER COA STD. DTLs. 2361 AND 2362
3	INSTALL 6" CAP

AS BUILT INFORMATION	
CONTRACTOR	STAKED BY
INSPECTOR'S	DATE
FIELD OFFICE	DATE
VERIFICATION BY	DATE
CORRECTED BY	DATE
MICRO-FILM INFORMATION	
RECORDED BY	DATE
NO.	

SURVEY INFORMATION	
FIELD NOTES	DATE
BY	
NO.	

BENCH MARKS	
"ACS BM NM 448 N8"	
X=1,514,900.643 Y=1,512,770.226 (NAD 83)	
ELEV=5021.651 (NAVD 1988)	

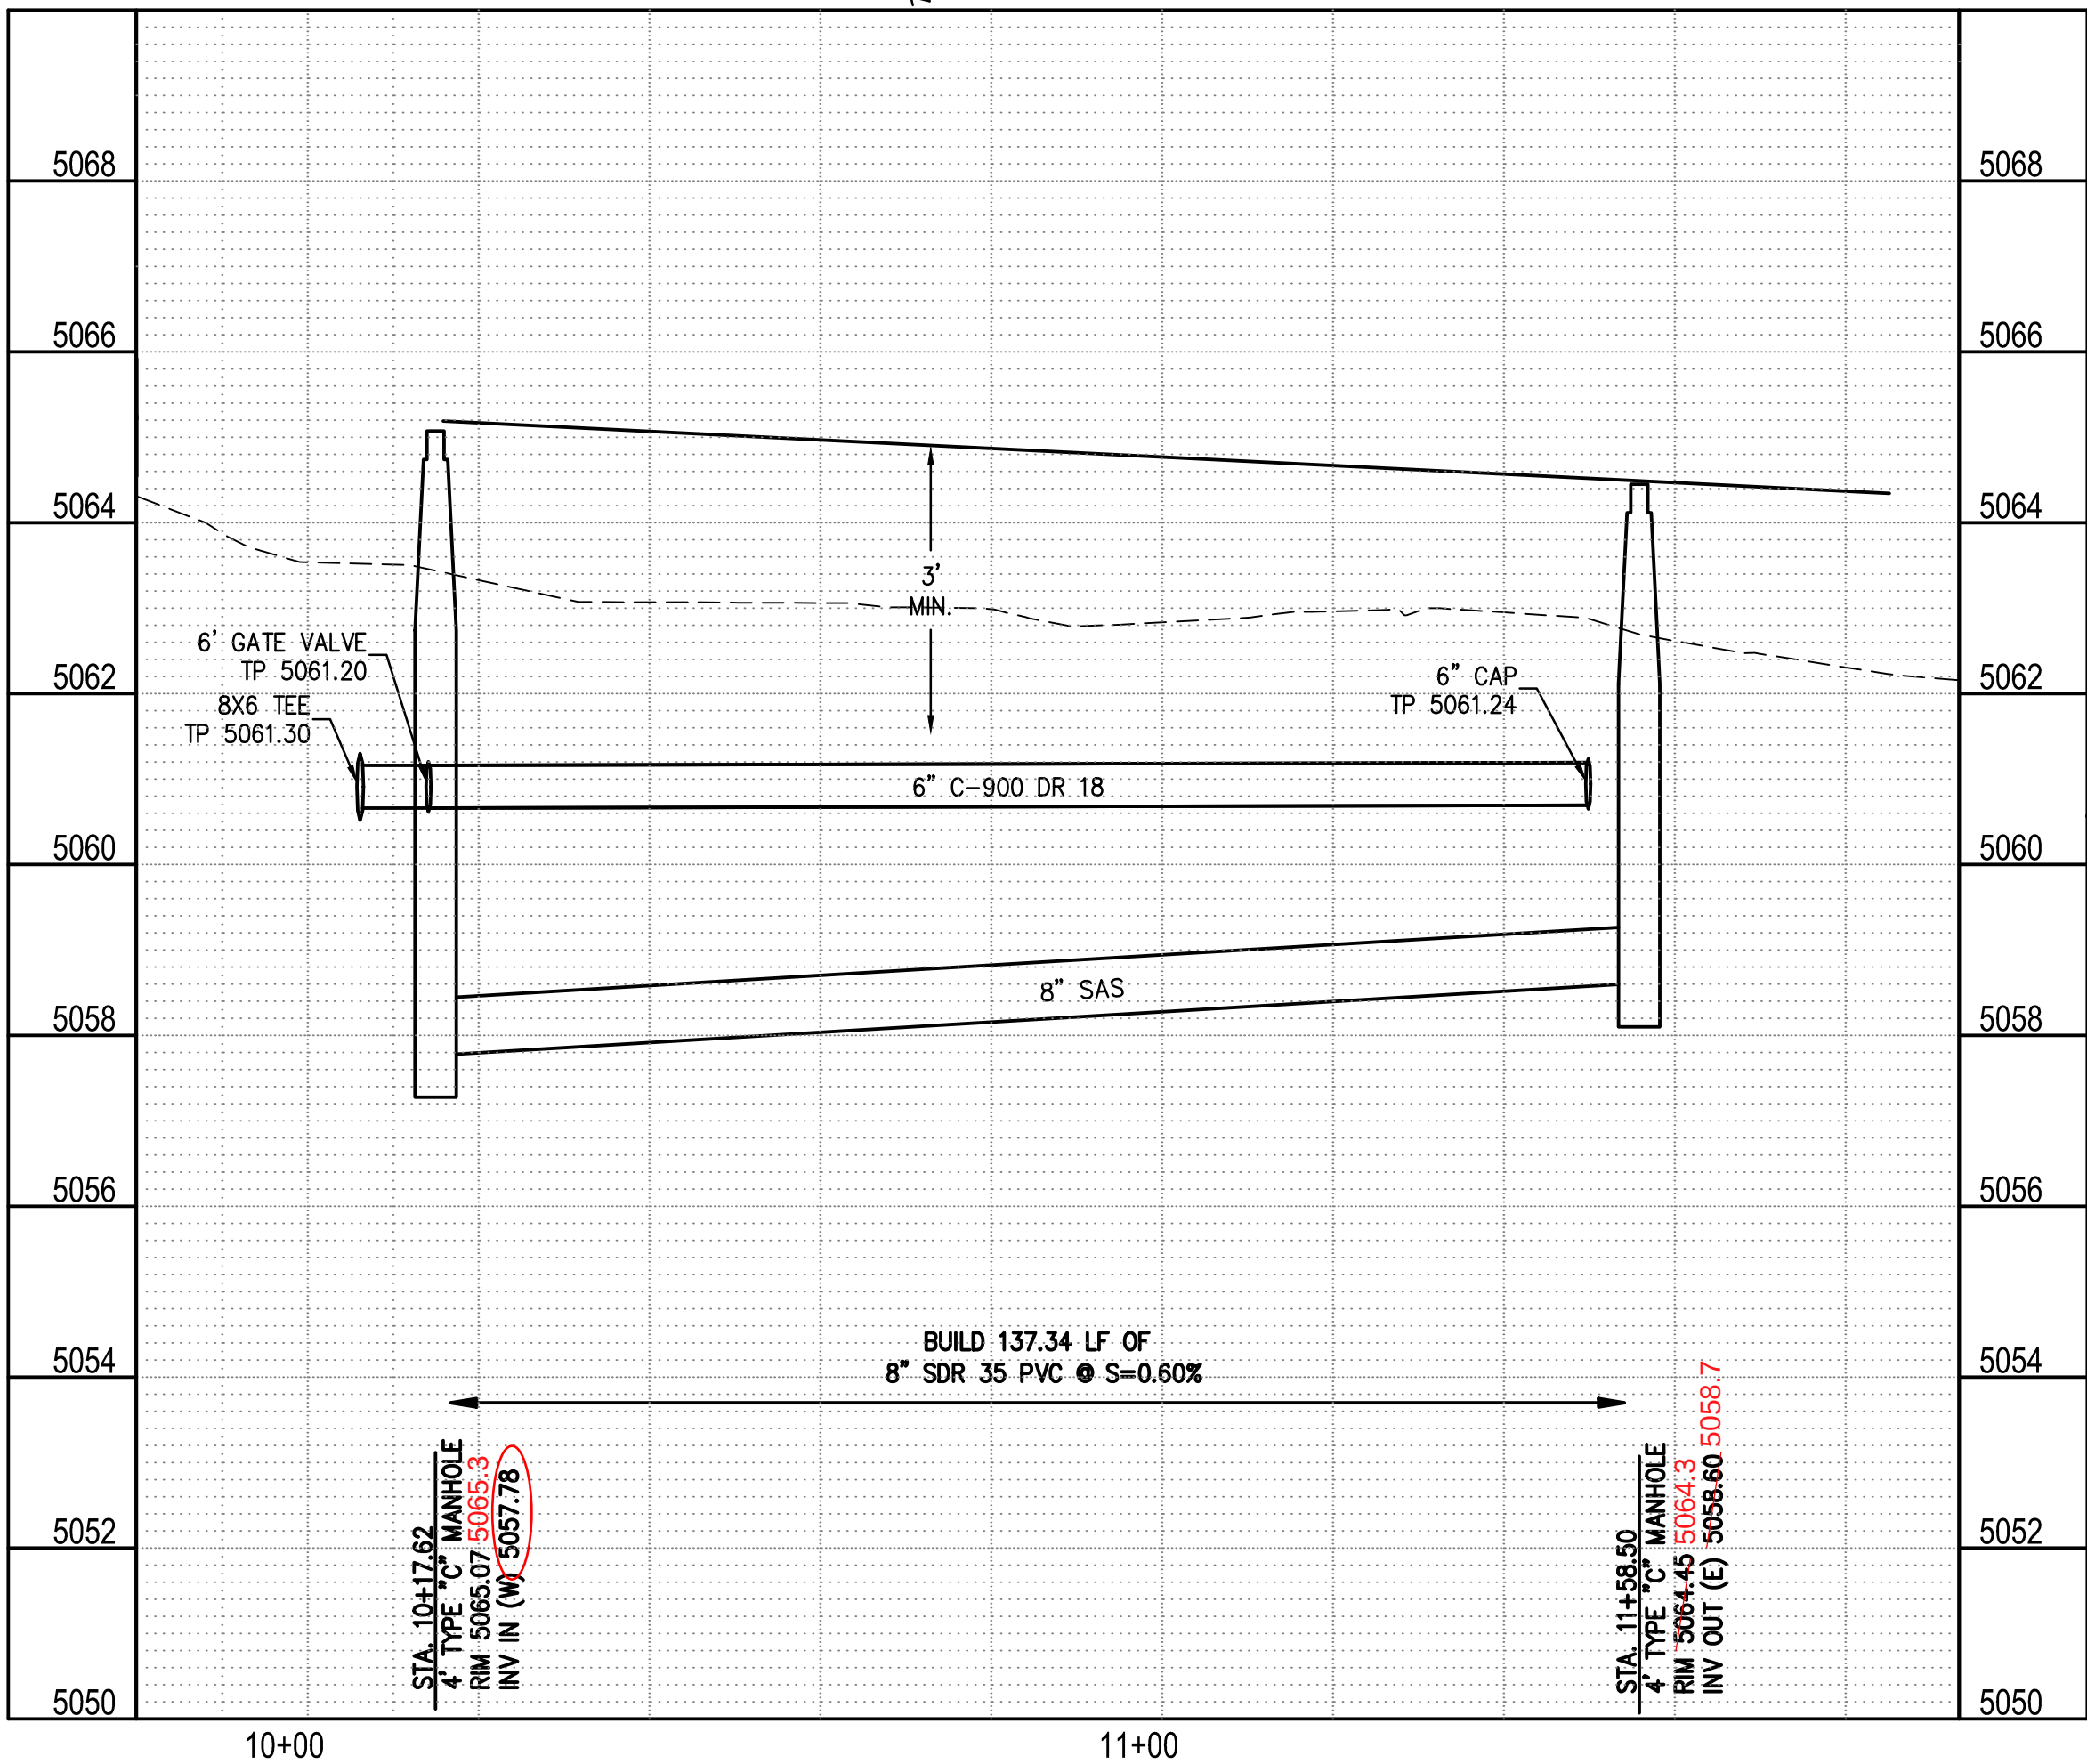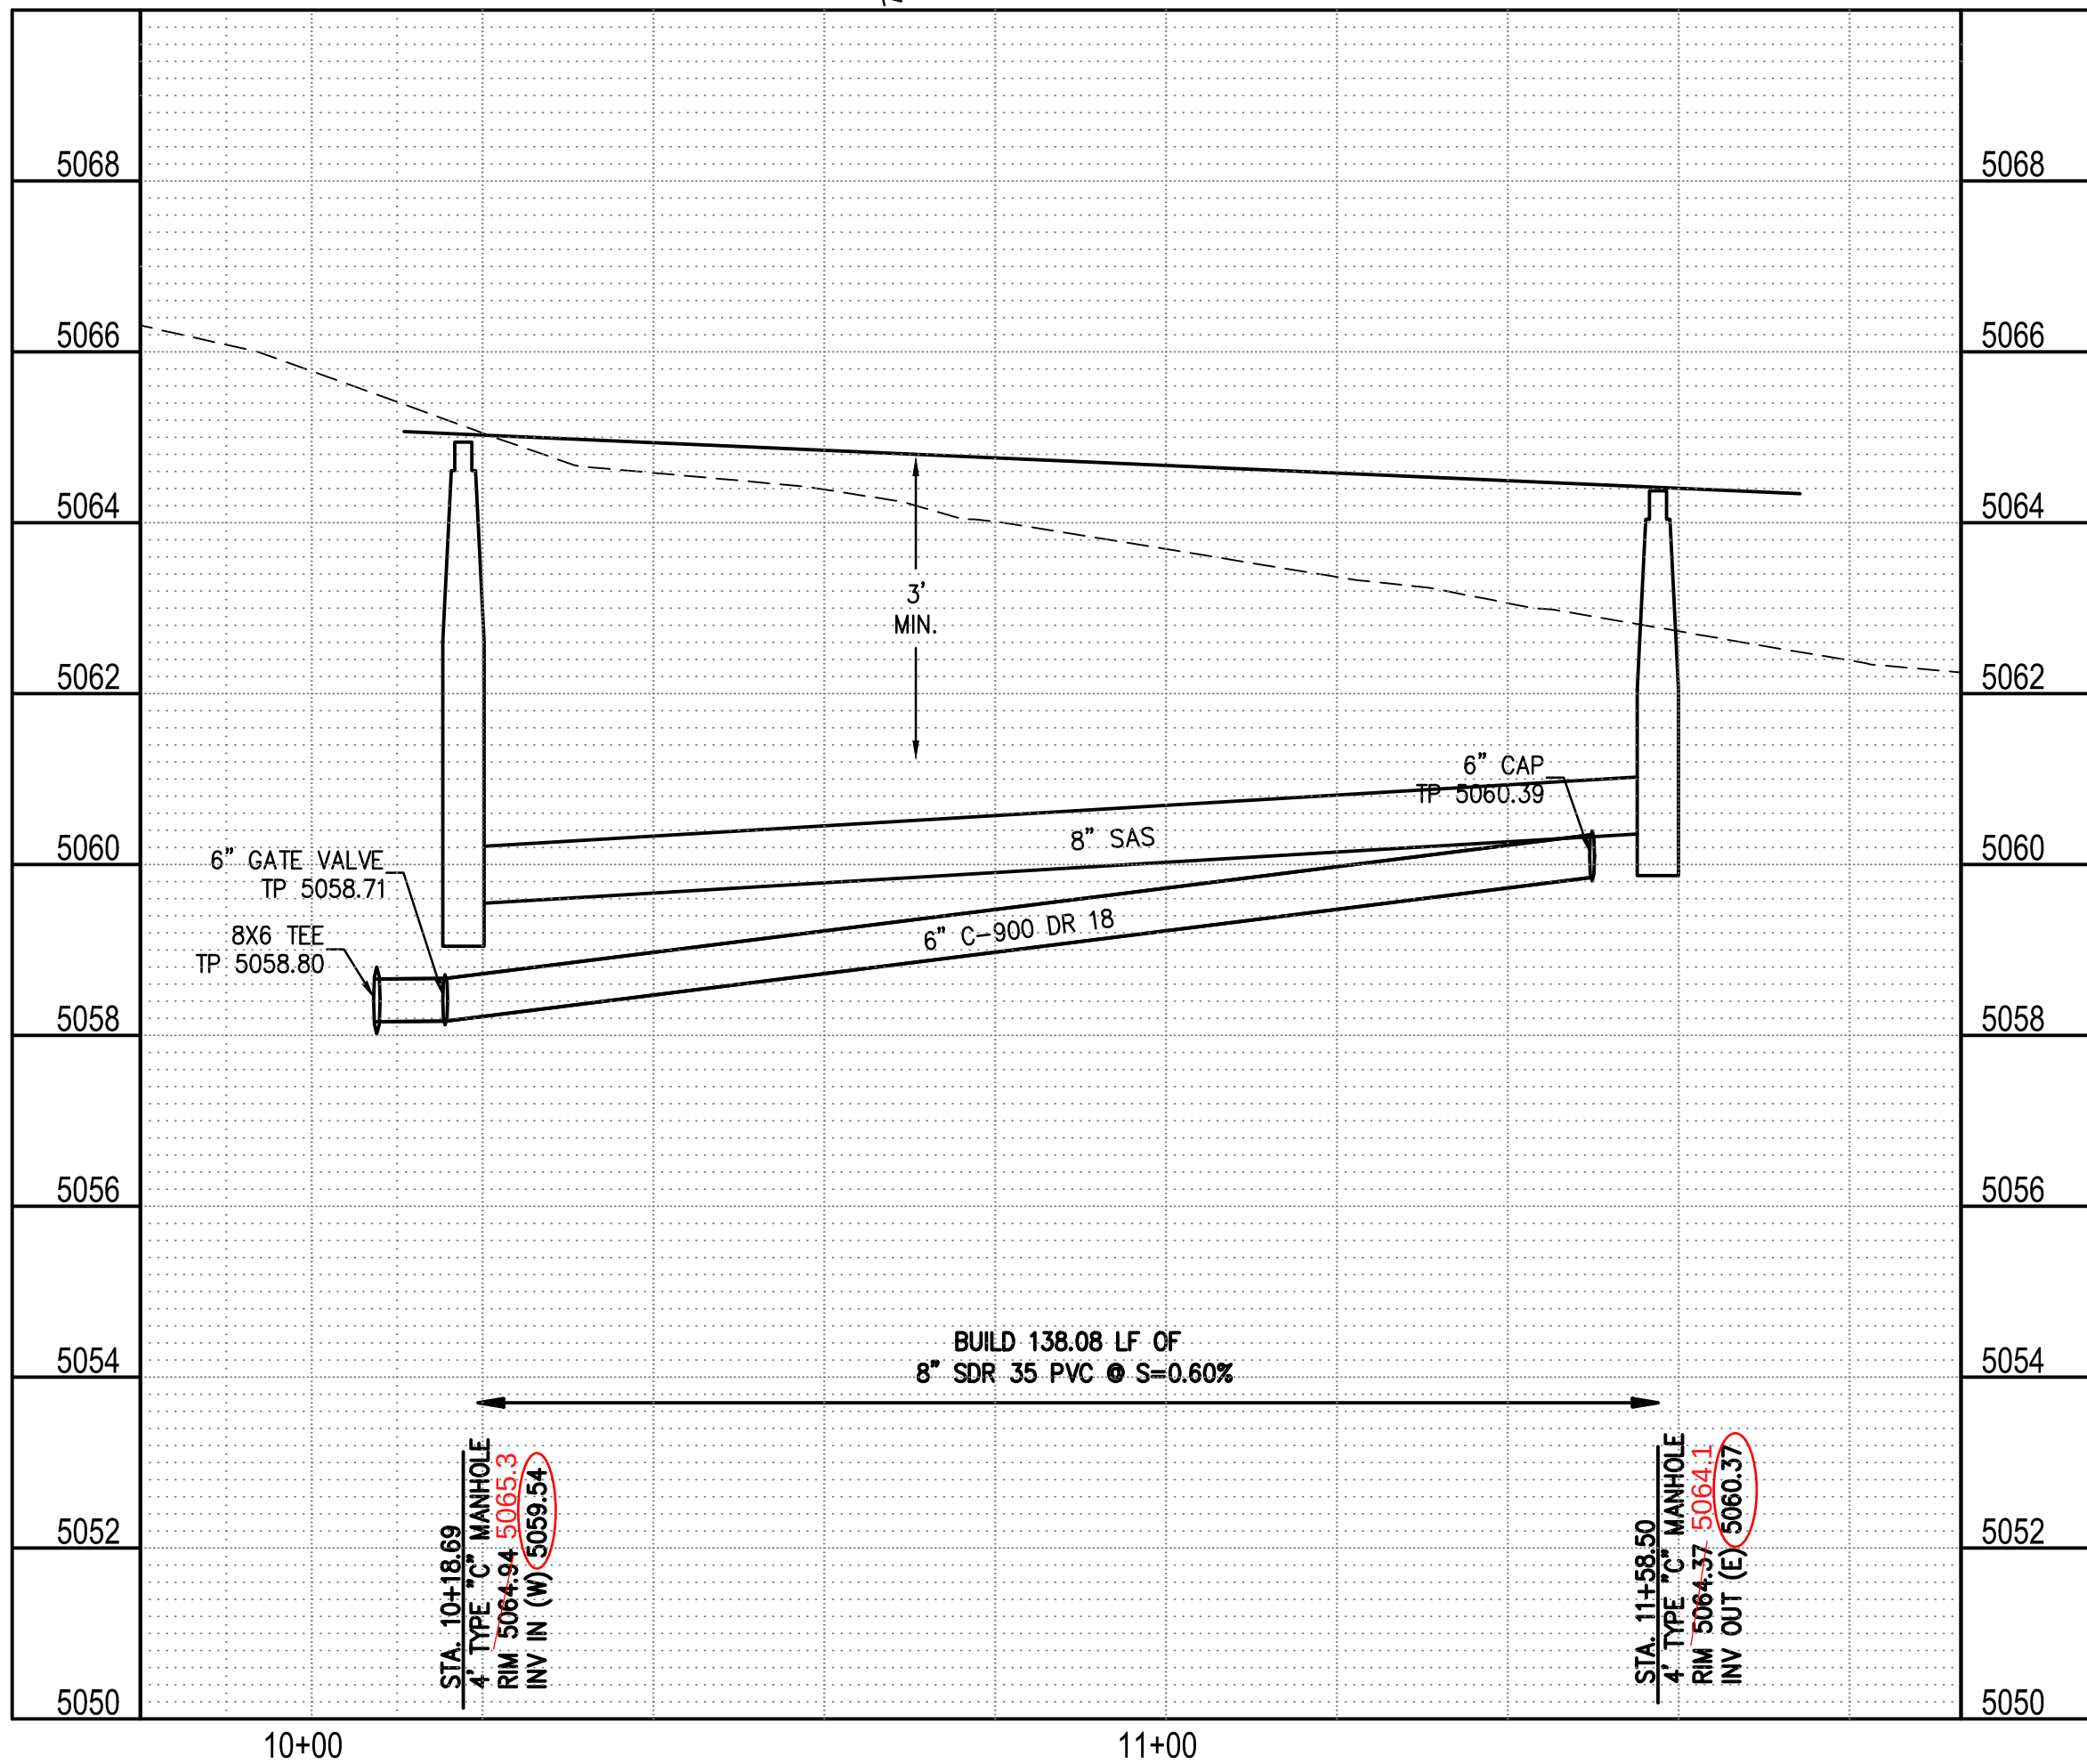

LEGEND	
	PROP FIRE HYDRANT
	PROP WATER VALVE
	EX SAS MANHOLE
	PROP SAS MANHOLE
	PROP WATER METER
	PROPOSED SANITARY SEWER LINE
	EX SANITARY SEWER LINE
	PROPOSED WATER LINE
	EX WATER LINE

THE HENSLEY ENGINEERING GROUP
(505) 410-1622

HORIZON VILLAGE SUBDIVISION
ALOFT PLACE AND AWAY PLACE
UTILITY PLAN AND PROFILE

DESIGN REVIEW COMMITTEE	CITY ENGINEER APPROVAL
APPROVED Sept. 10, 2020 DESIGN REVIEW COMMITTEE	APPROVED Sept. 10, 2020 CITY ENGINEER

CITY PROJECT No.	799782	ZONE MAP NO.	C-17	SHEET	14 OF 15
------------------	--------	--------------	------	-------	----------

HORIZON WAY SANITARY SEWER SERVICES				
LOT	SAS STATION & OFFSET	SAS LENGTH	INV BEGN	TOP OF PIPE AT END
29	100+68.47 4.62' LT	46.18	5054.68	5062.52
30	100+68.34 15.36' RT	53.90	5054.68	5062.52

SAS LINE TABLE		
LINE	LENGTH	BEARING
S1	24.72	N 65°14'56" W



MH CENTER TO CENTER DISTANCE

HORIZON WAY WATER SERVICES				
LOT NO.	WL STATION & OFFSET	GPS X-COORDINATE	GPS Y-COORDINATE	
29	10+80.23 15.98 LT			
30	11+26.23 15.98 LT			

NOTE: STATIONING IS AT METER

WATER LINE TABLE		
LINE	LENGTH	BEARING
W1	23.17	N 26°15'09" W
W2	47.84	N 76°51'53" W
W3	62.96	S 57°45'29" W

WATER LINE ALIGNMENT INTERSECTION DISTANCE

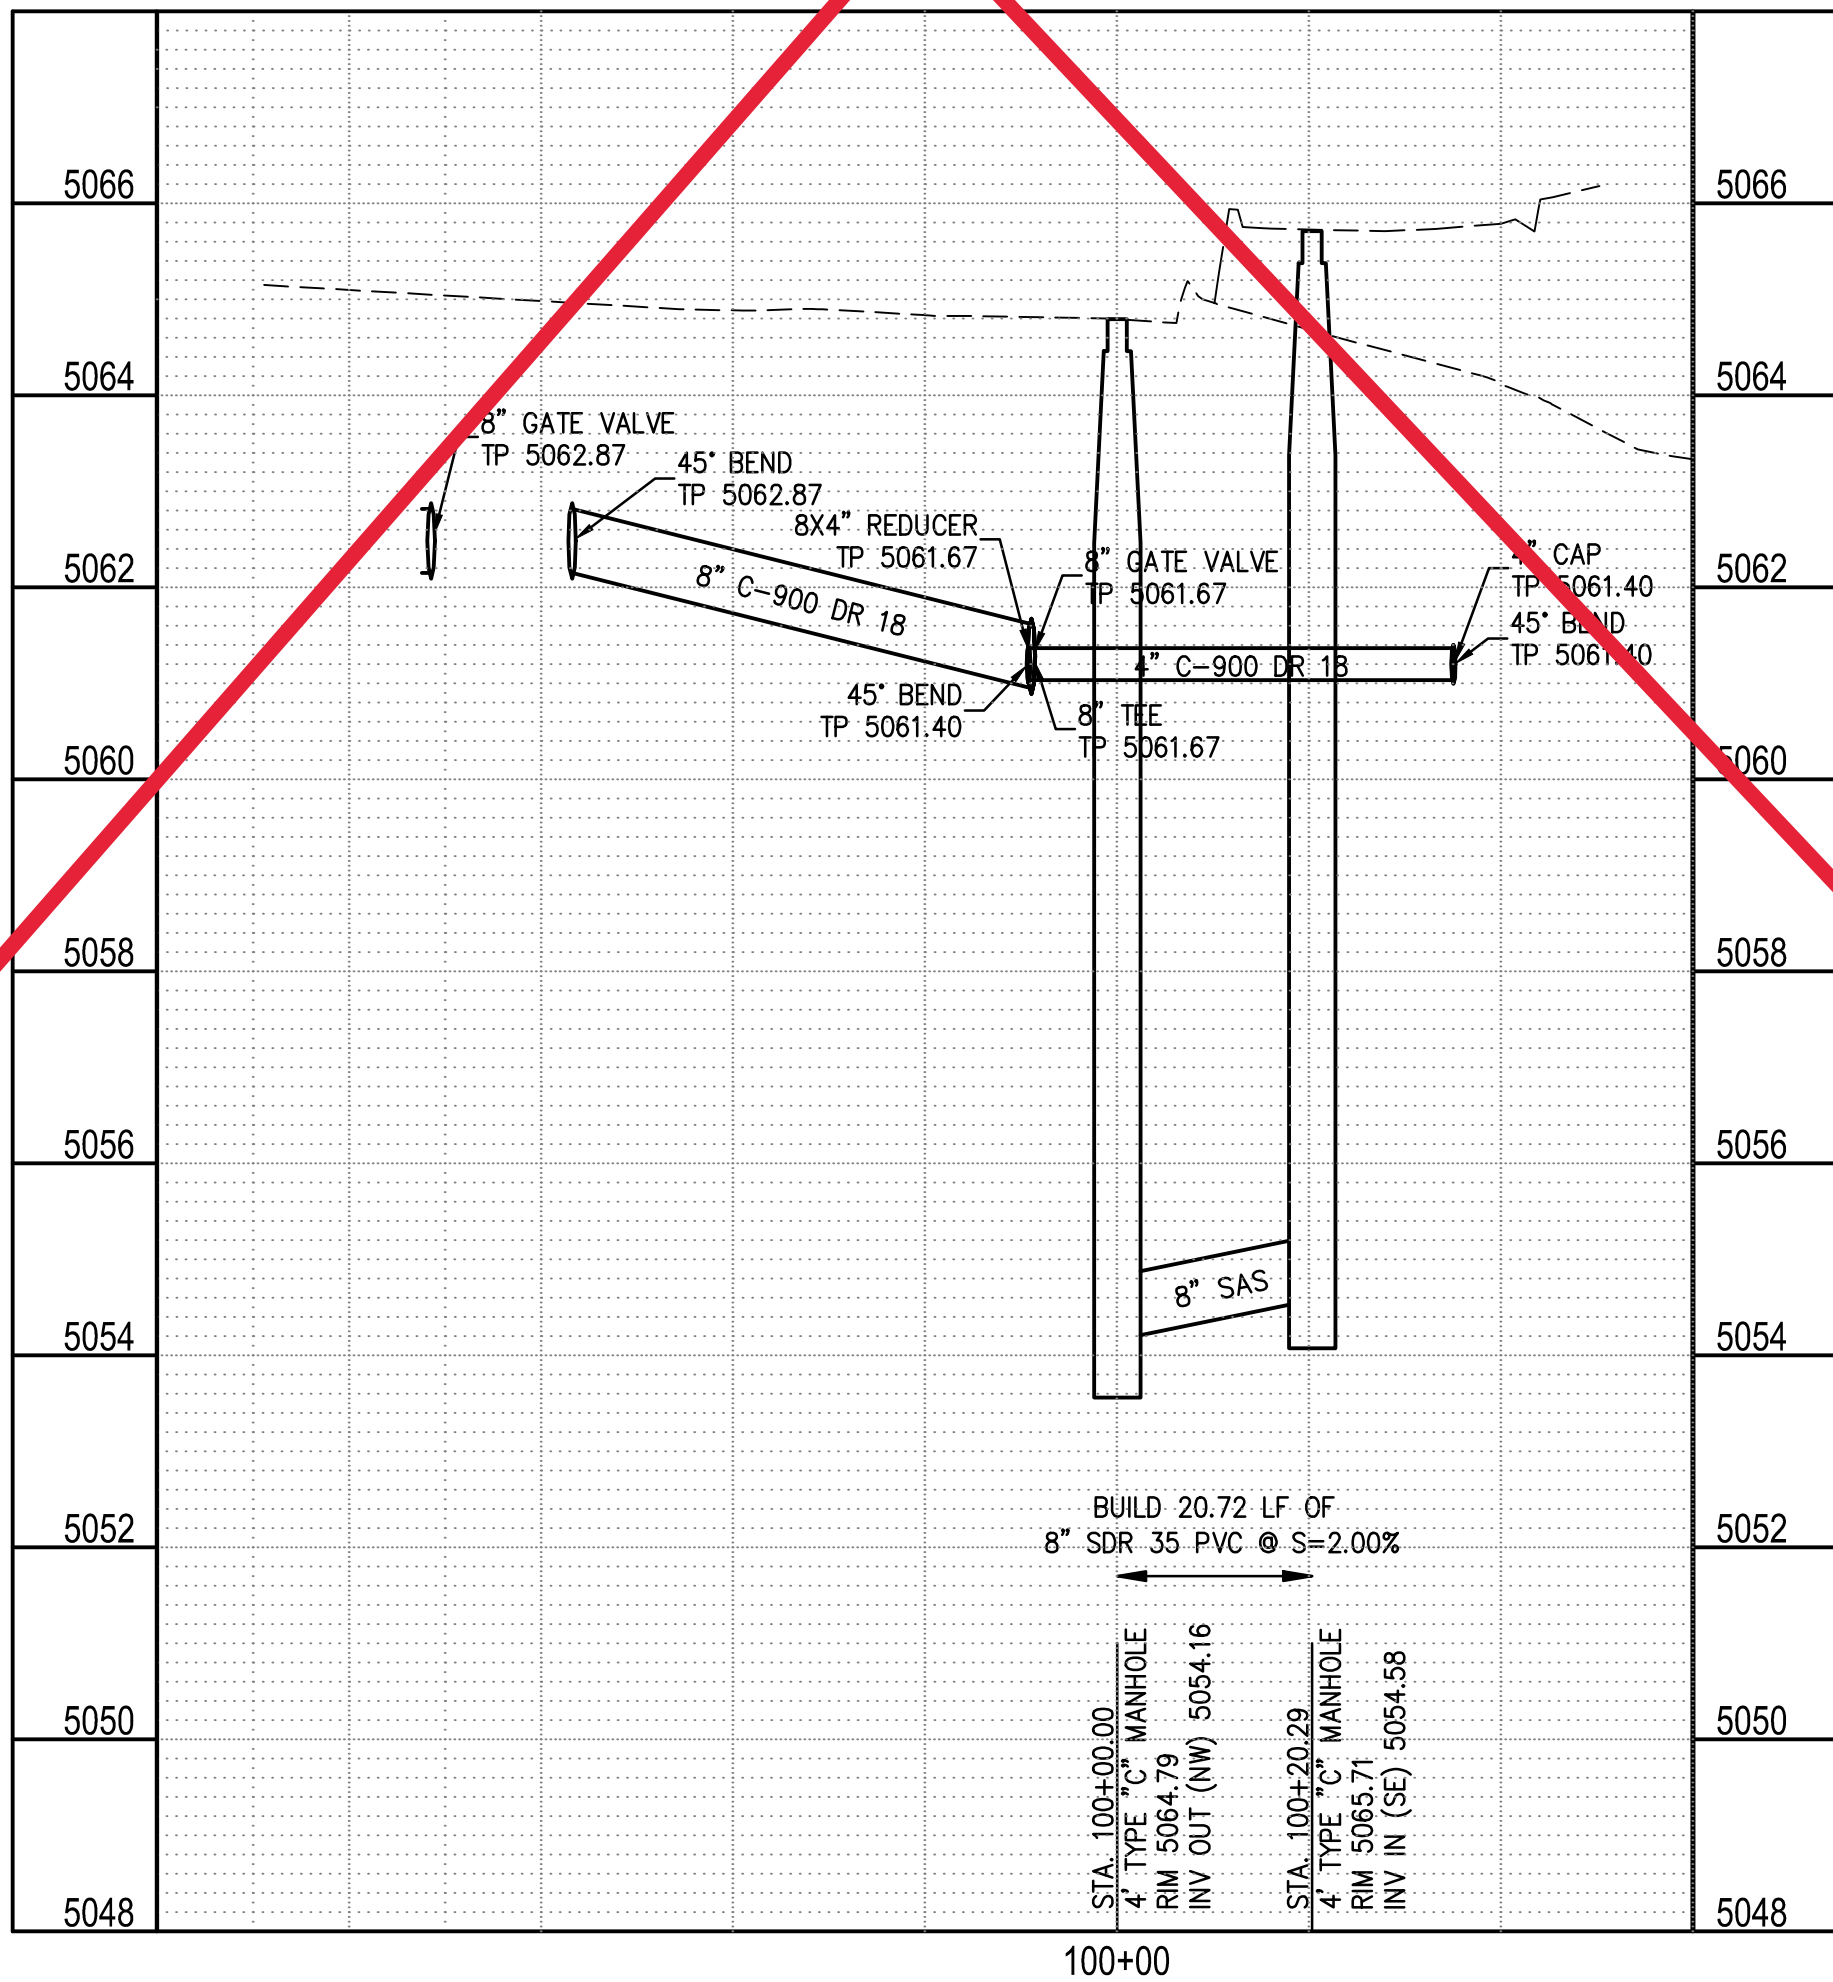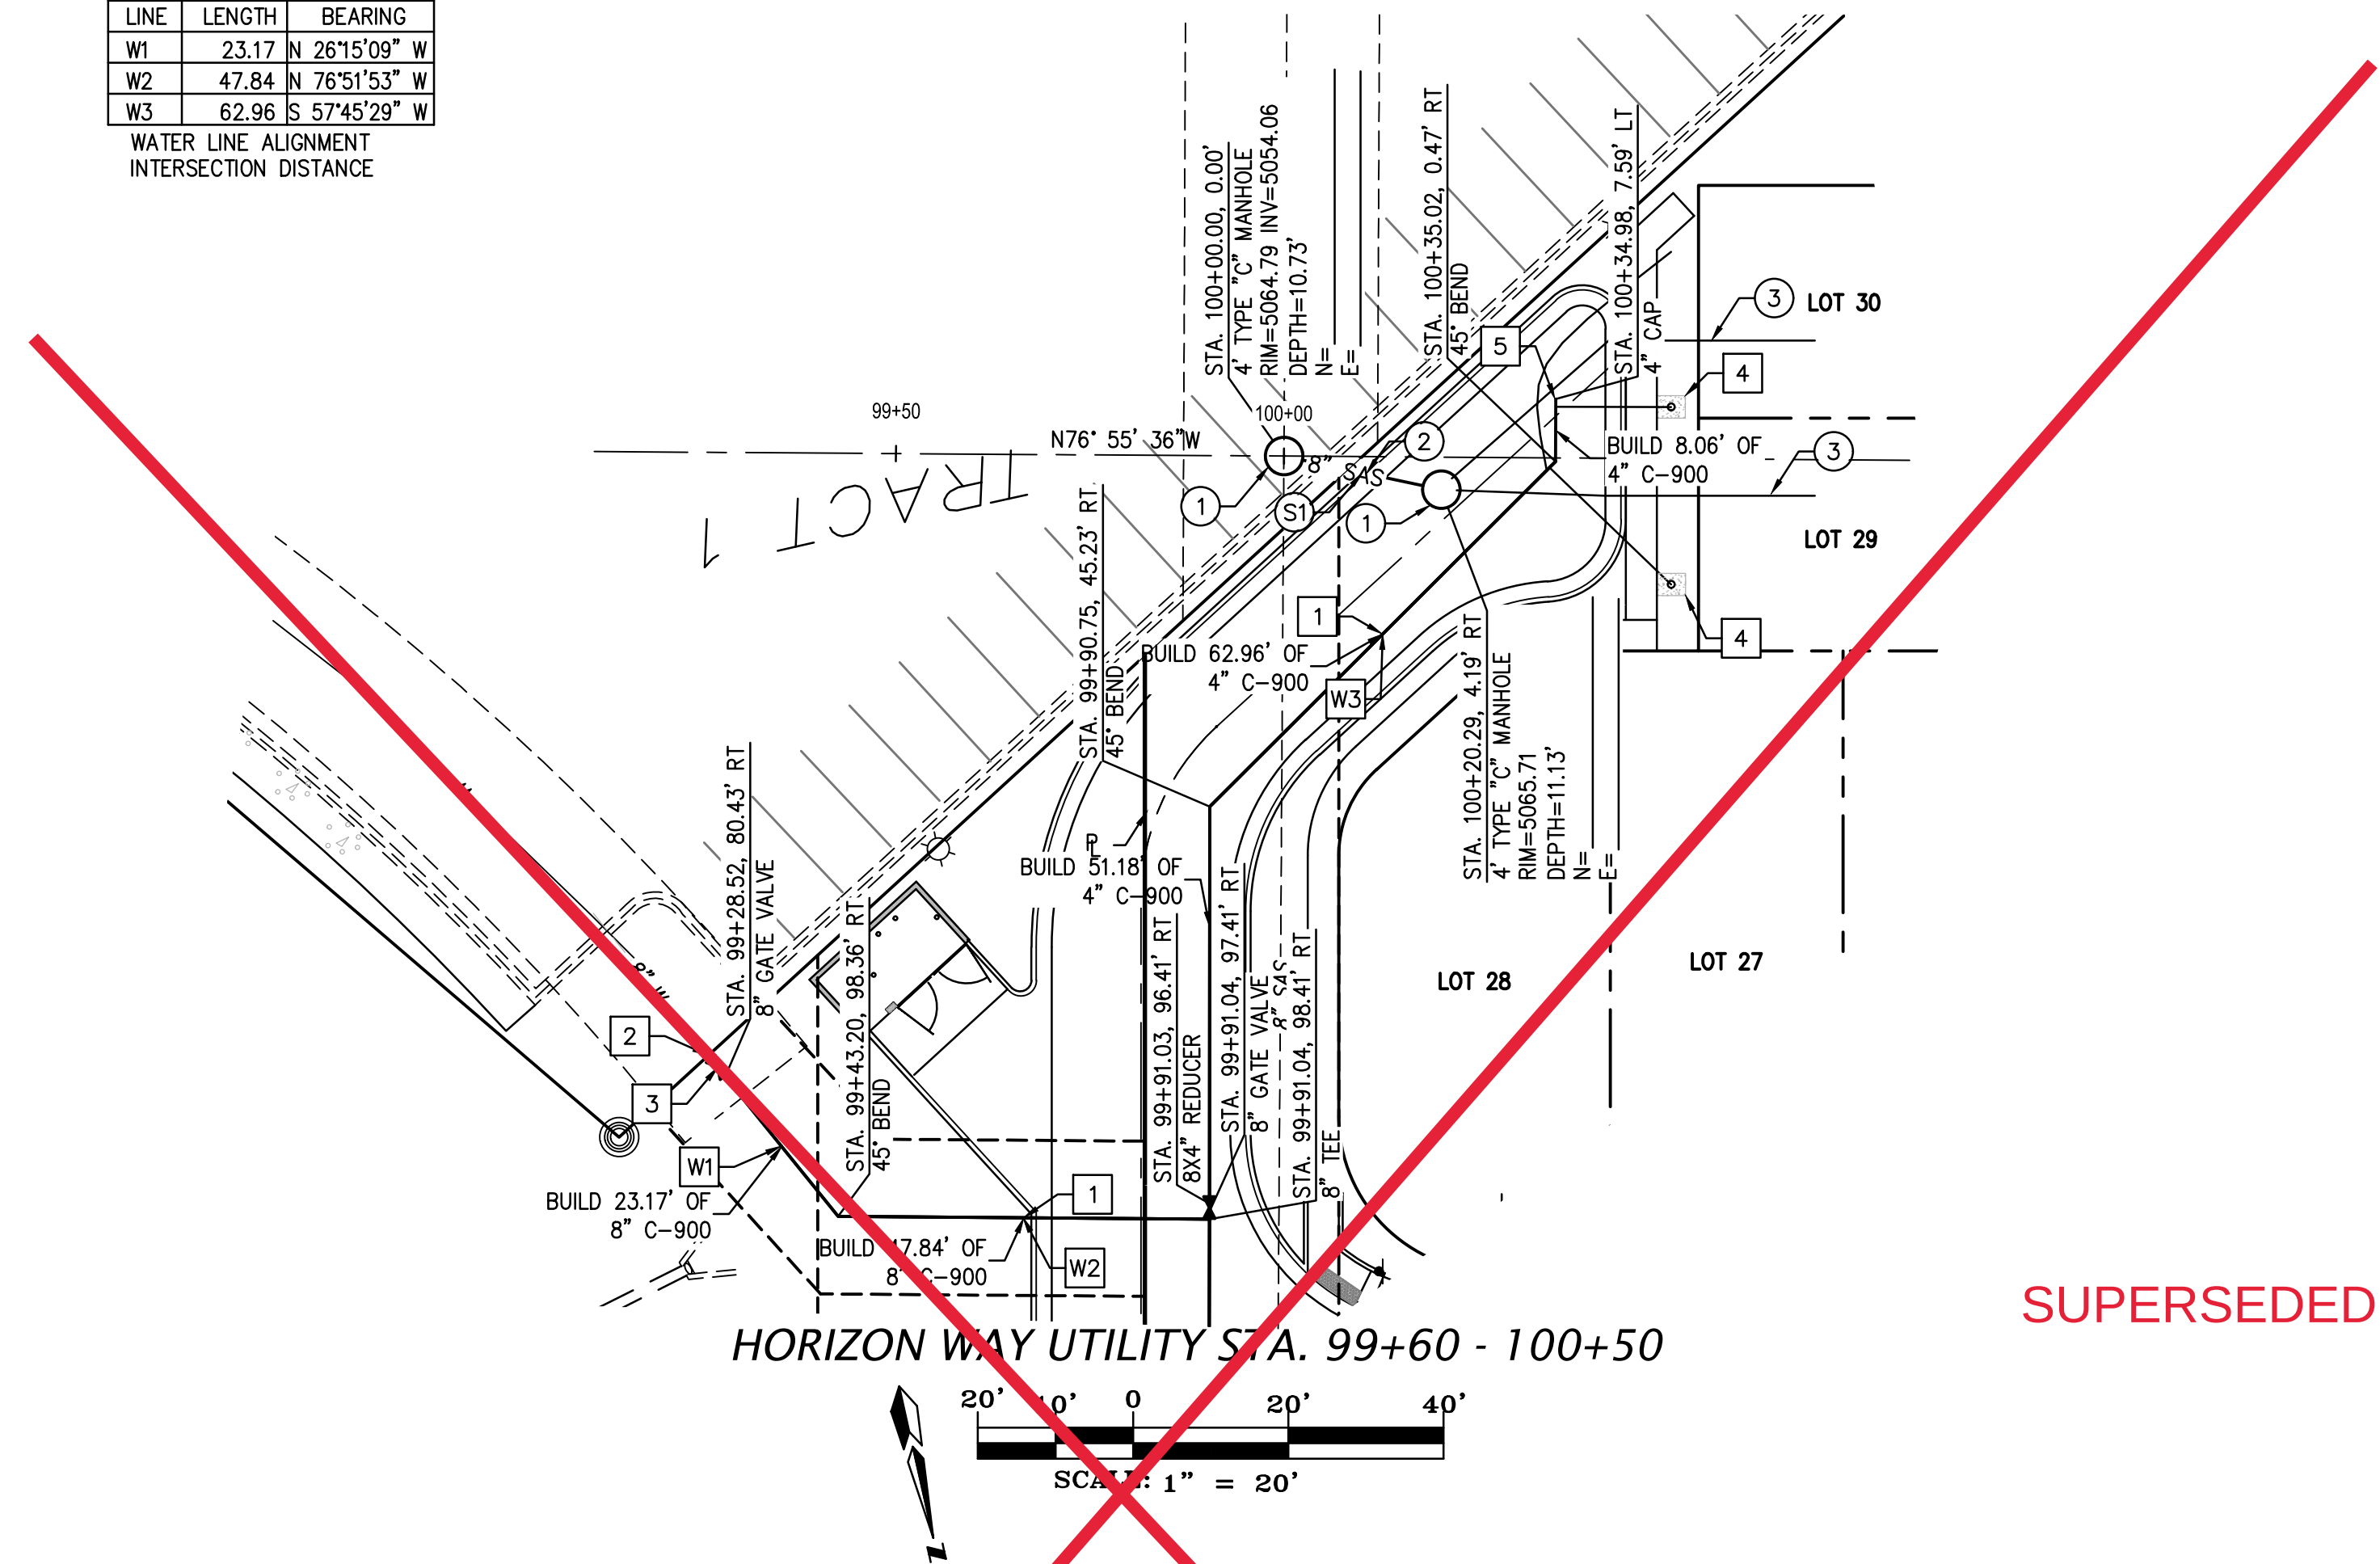

SUPERSEDED -- SEE SHEET 15R, Rev. 9/10/2020.

SEWER CONSTRUCTION NOTES	
I.D.#	DESCRIPTION
①	INSTALL 4" DIA. TYPE "C" MANHOLE PER COA STD. DTL. 2101, 2109
②	INSTALL 8" SEWER PIPE PER STD. SPEC. SEC. 901
③	INSTALL 4" SEWER SERVICE PER COA STD. DTL. 2125

WATER CONSTRUCTION NOTES	
I.D.#	DESCRIPTION
1	INSTALL WATERLINE PER STD. SPEC. SEC. 801
2	NON-PRESSURE CONNECTION OF NEW WATERLINE TO EXISTING WATERLINE PER COA STD. DTL. 2301
3	INSTALL GATE VALVE AND VALVE BOX PER COA STD. DTL. 2326, 2328
4	INSTALL 3/4" WATER SERVICE WITH METER BOX PER COA STD. DTL. 2361 AND 2362
5	INSTALL 4" CAP

- LEGEND**
- PROP FIRE HYDRANT
 - ⊕ PROP WATER VALVE
 - ⊙ EX SAS MANHOLE
 - ⊙ PROP SAS MANHOLE
 - ⊙ PROP WATER METER
 - 8" SAS — PROPOSED SANITARY SEWER LINE
 - SAS — EX SANITARY SEWER LINE
 - 6" W — PROPOSED WATER LINE
 - 6"W — EX WATER LINE



HORIZON VILLAGE SUBDIVISION
HORIZON WAY UTILITY STA. 99+60 - 100+50
UTILITY PLAN AND PROFILE




CITY PROJECT No. 799782

ZONE MAP NO. C-17

SHEET 15 OF 15

AS BUILT INFORMATION	
CONTRACTOR	DATE
INSPECTOR'S	DATE
FIELD CHIEF	DATE
VERIFICATION BY	DATE
CORRECTED BY	DATE
MICRO-FILM INFORMATION	
RECORDED BY	DATE
NO.	

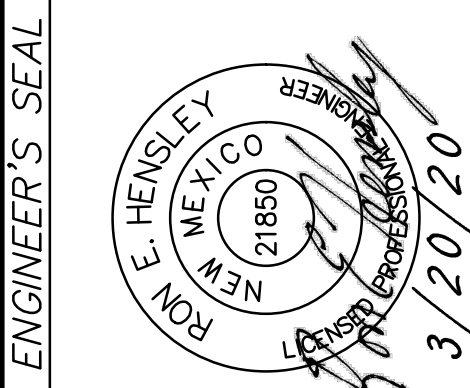

SURVEY INFORMATION	
FIELD NOTES	DATE
BY	
NO.	

ENGINEER'S SEAL	
REMARKS	BY
DESIGN	
DESIGNED BY	DATE 10/31/19
DRAWN BY	DATE 12/07/19
CHECKED BY	DATE 02/21/20

HORIZON WAY SANITARY SEWER SERVICES				
LOT	SAS STATION & OFFSET	SAS LENGTH	INV BEGN	TOP OF PIPE AT END
29	100+68.47 4.62' LT	46.18	5057.29	5062.52
30	100+68.34 15.36' RT	53.50	5057.29	5062.52

SAS LINE TABLE		
LINE	LENGTH	BEARING
S1	24.72	N 65°14'56" W



MH CENTER TO CENTER DISTANCE

HORIZON WAY WATER SERVICES				
LOT NO.	WL STATION & OFFSET	GPS X-COORDINATE	GPS Y-COORDINATE	
29	10+80.23 15.98 LT	1534773.6	1523070.9	
30	11+26.23 15.98 LT	1534768.0	1523048.3	

NOTE: STATIONING IS AT METER

WATER LINE TABLE		
LINE	LENGTH	BEARING
W1	23.17	N 26°15'09" W
W2	47.84	N 76°51'53" W
W3	62.96	S 57°45'29" W

WATER LINE ALIGNMENT INTERSECTION DISTANCE

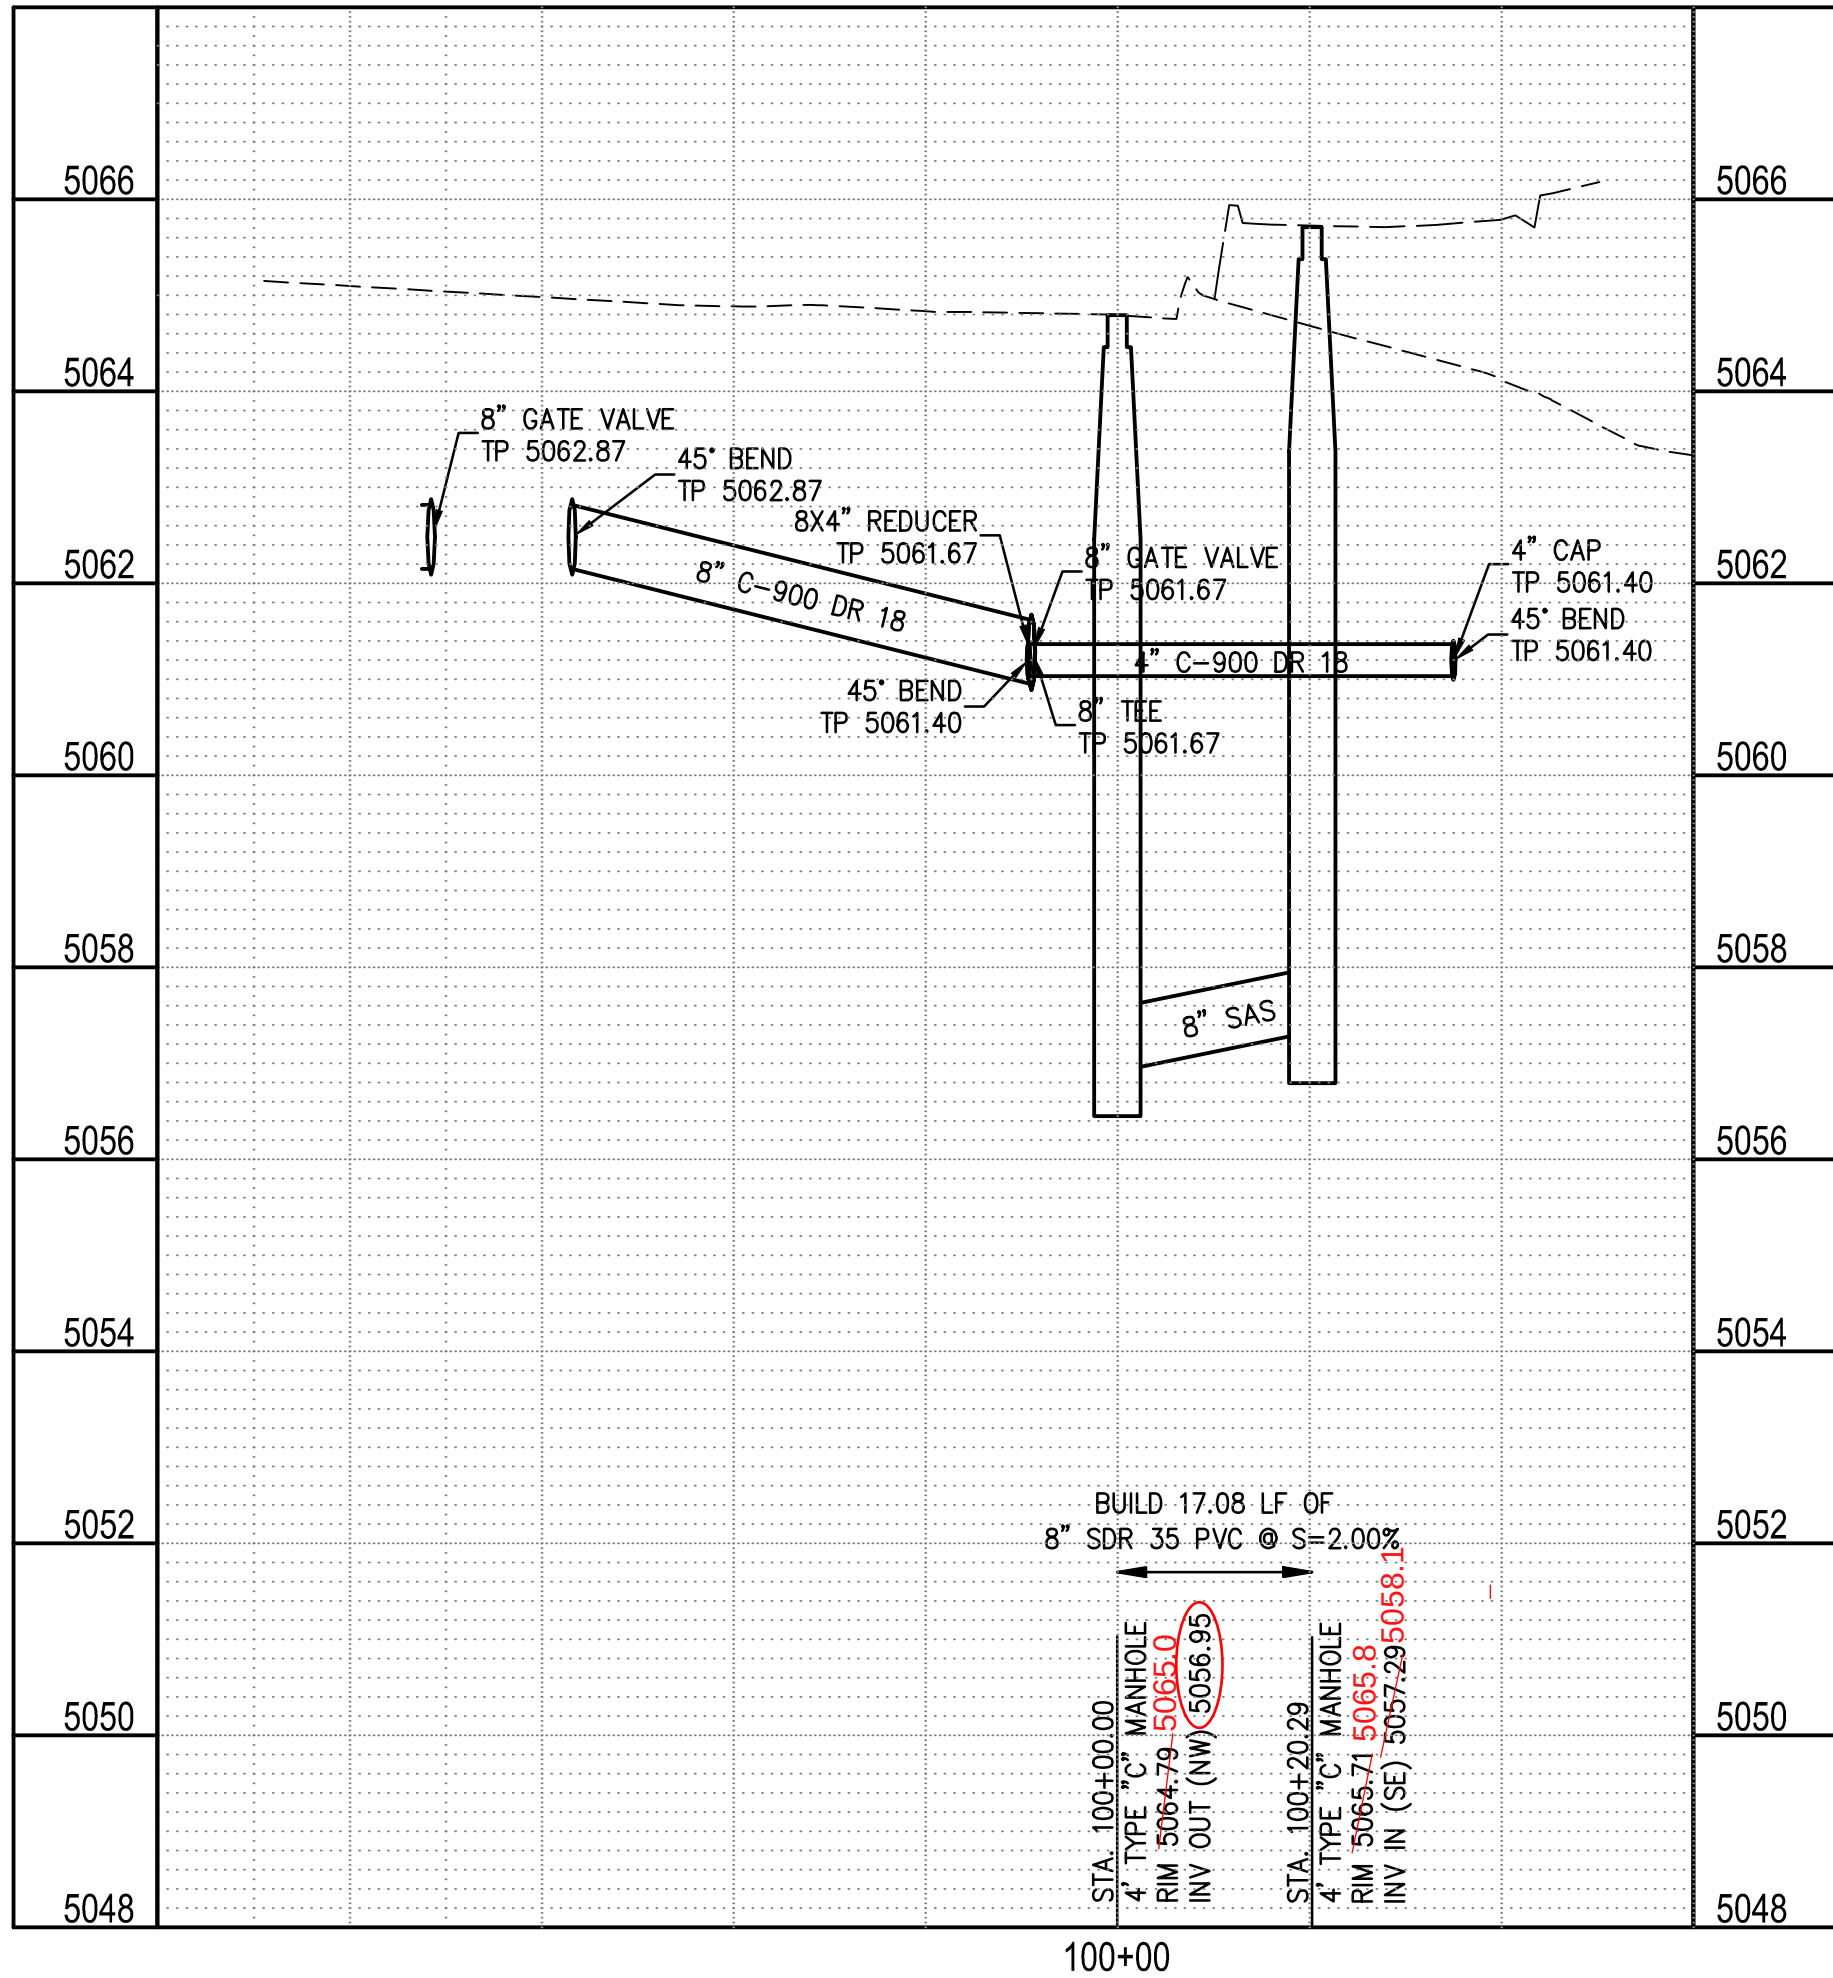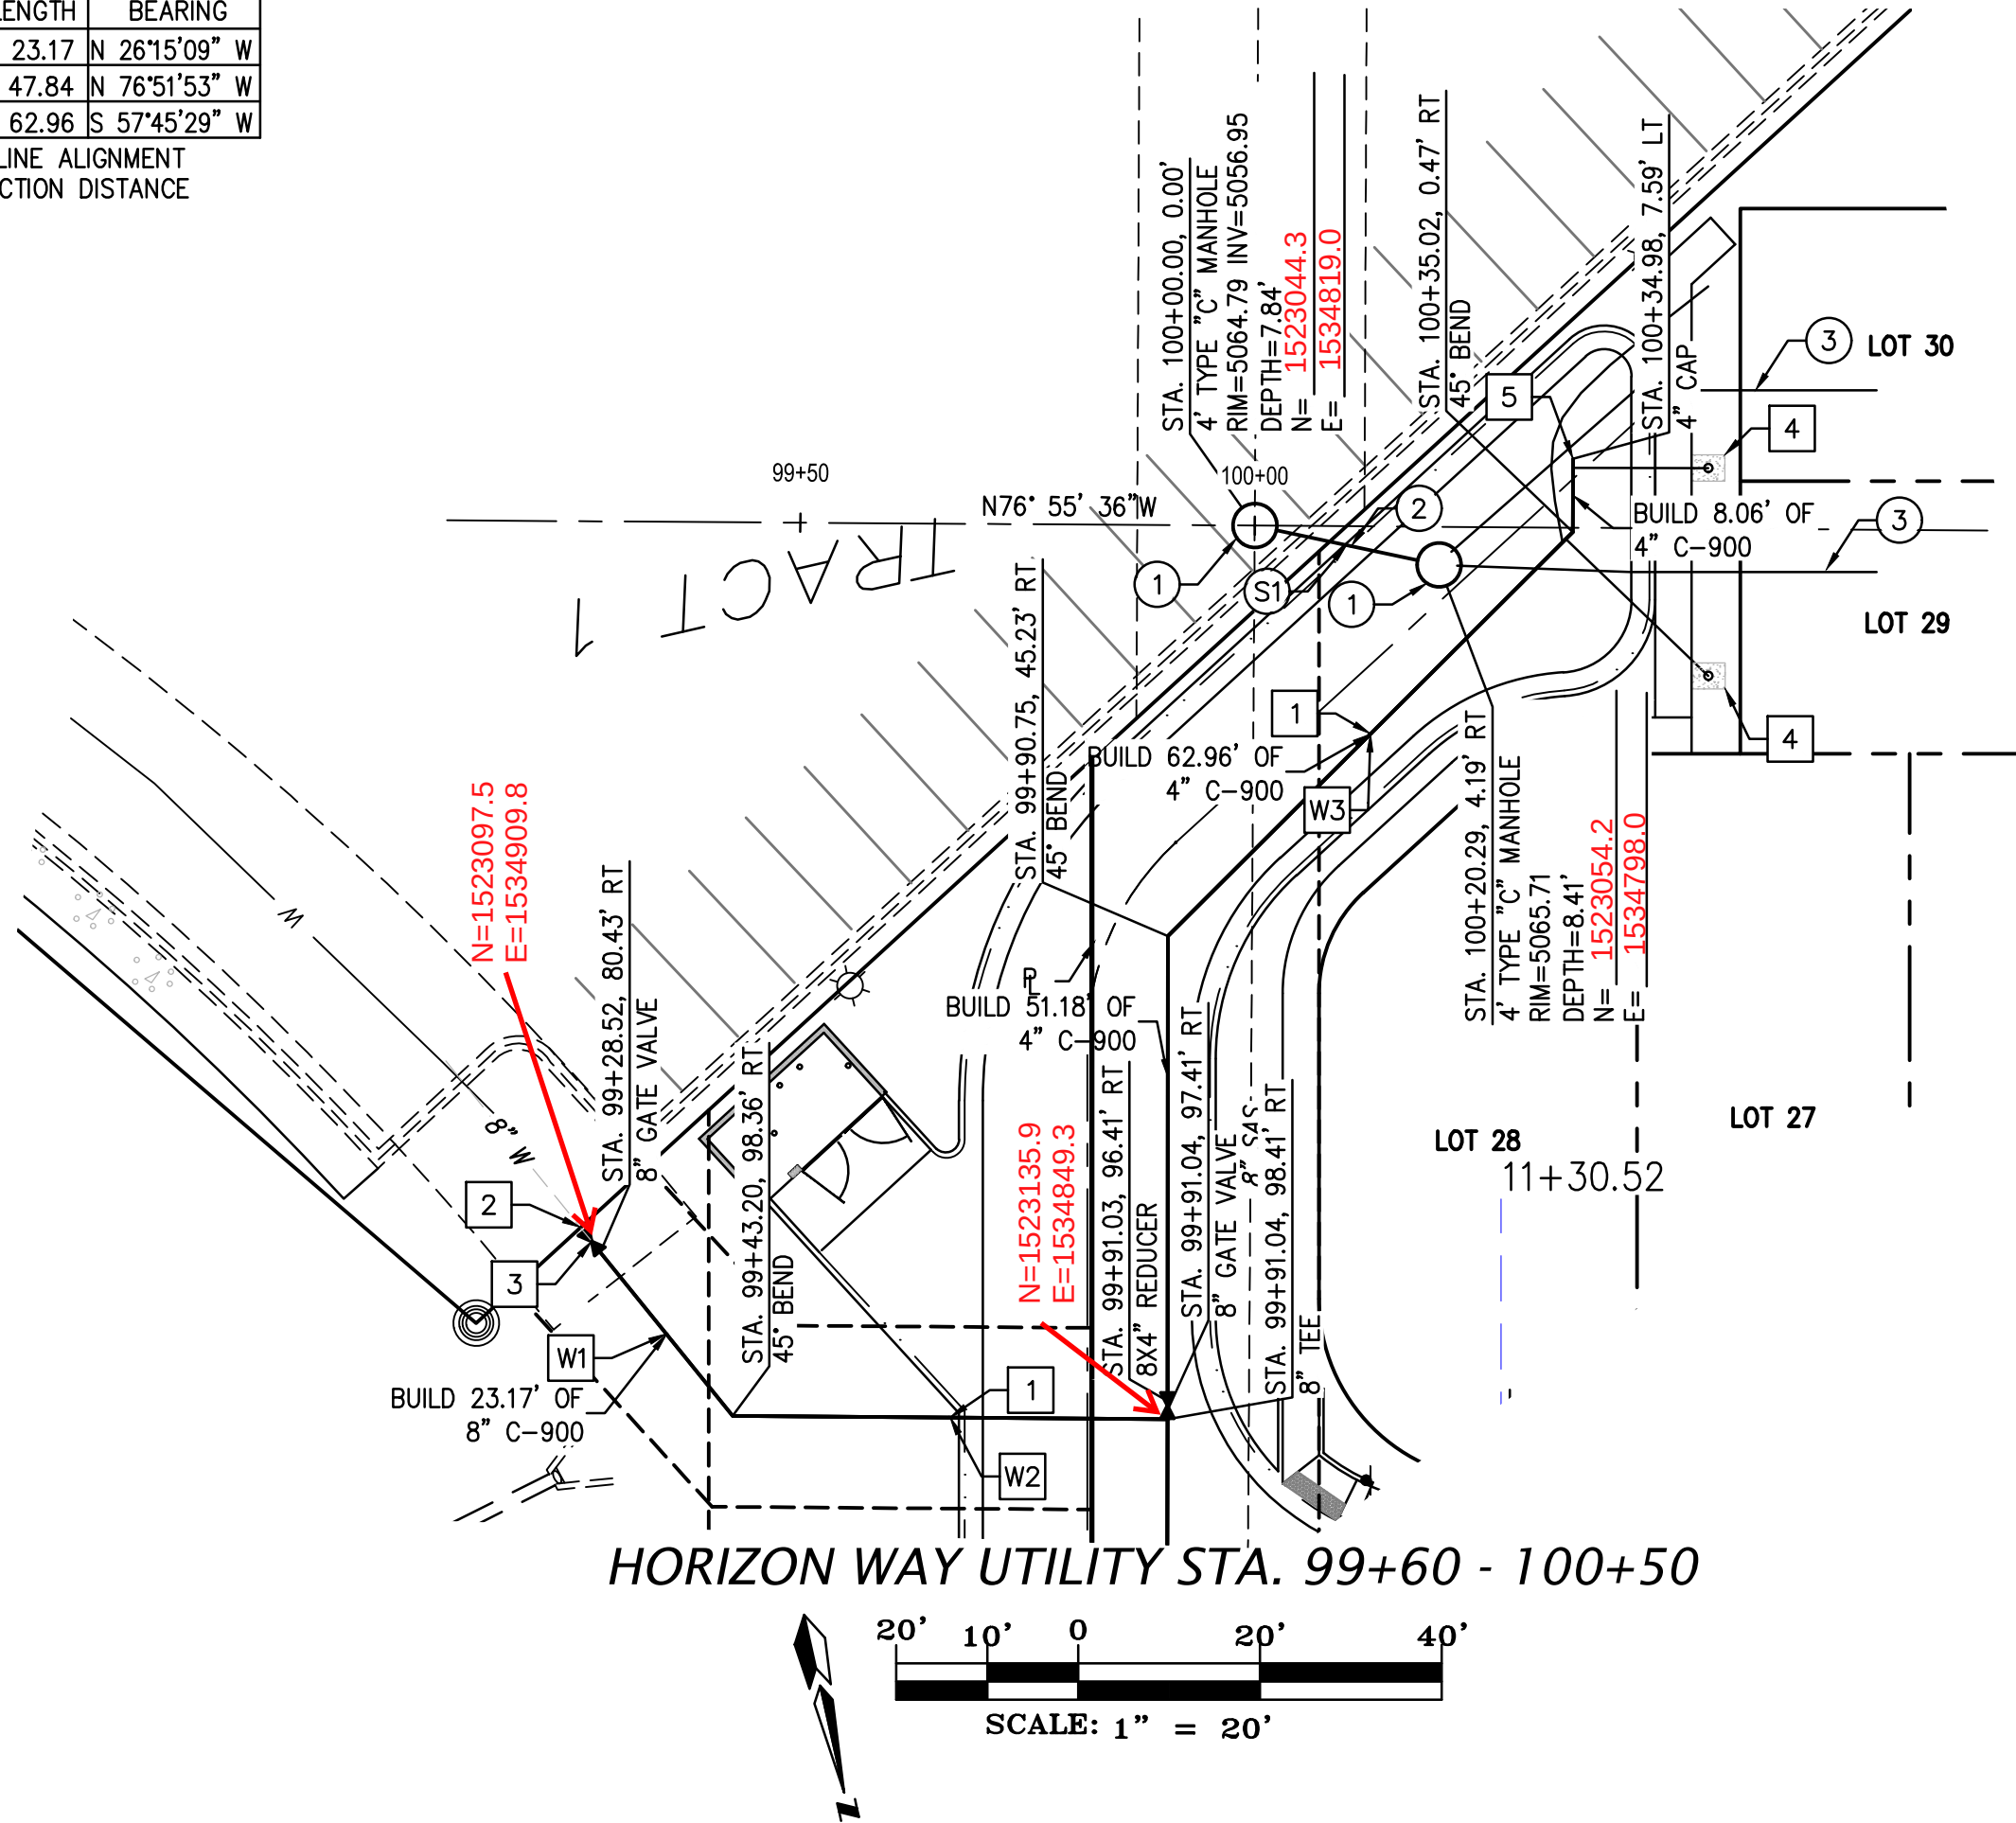

SEWER CONSTRUCTION NOTES	
I.D.#	DESCRIPTION
①	INSTALL 4' DIA. TYPE "C" MANHOLE PER COA STD. DTL. 2101, 2109
②	INSTALL 8" SEWER PIPE PER STD. SPEC. SEC. 901
③	INSTALL 4" SEWER SERVICE PER COA STD. DTL. 2125

WATER CONSTRUCTION NOTES	
I.D.#	DESCRIPTION
1	INSTALL WATERLINE PER STD. SPEC. SEC. 801
2	NON-PRESSURE CONNECTION OF NEW WATERLINE TO EXISTING WATERLINE PER COA STD. DTL. 2301
3	INSTALL GATE VALVE AND VALVE BOX PER COA STD. DTL. 2326, 2328
4	INSTALL 3/4" WATER SERVICE WITH METER BOX PER COA STD. DTL. 2361 AND 2362
5	INSTALL 4" CAP

LEGEND

- PROP FIRE HYDRANT
- ⊕ PROP WATER VALVE
- ⊙ EX SAS MANHOLE
- ⊙ PROP SAS MANHOLE
- PROP WATER METER
- 8" SAS — PROPOSED SANITARY SEWER LINE
- SAS — EX SANITARY SEWER LINE
- 6" W — PROPOSED WATER LINE
- 8"W — EX WATER LINE

THE
group

THE HENSLEY ENGINEERING GROUP
(505) 410-1622

HORIZON VILLAGE SUBDIVISION
HORIZON WAY UTILITY STA. 99+60 - 100+50
UTILITY PLAN AND PROFILE



CITY PROJECT No. 799782

ZONE MAP NO. C-17

SHEET 15 OF 15
R

AS BUILT INFORMATION

BENCH MARKS

SURVEY INFORMATION

ENGINEER'S SEAL

SEWER DEPTH REVISION

LAST DESIGN UPDATE

CONTRACTOR

INSPECTOR'S

FIELD NOTES

REVISIONS

DESIGNED BY

DATE

DATE

