


Aviation Sanitary Sewer Pipe Bursting, WO 800725

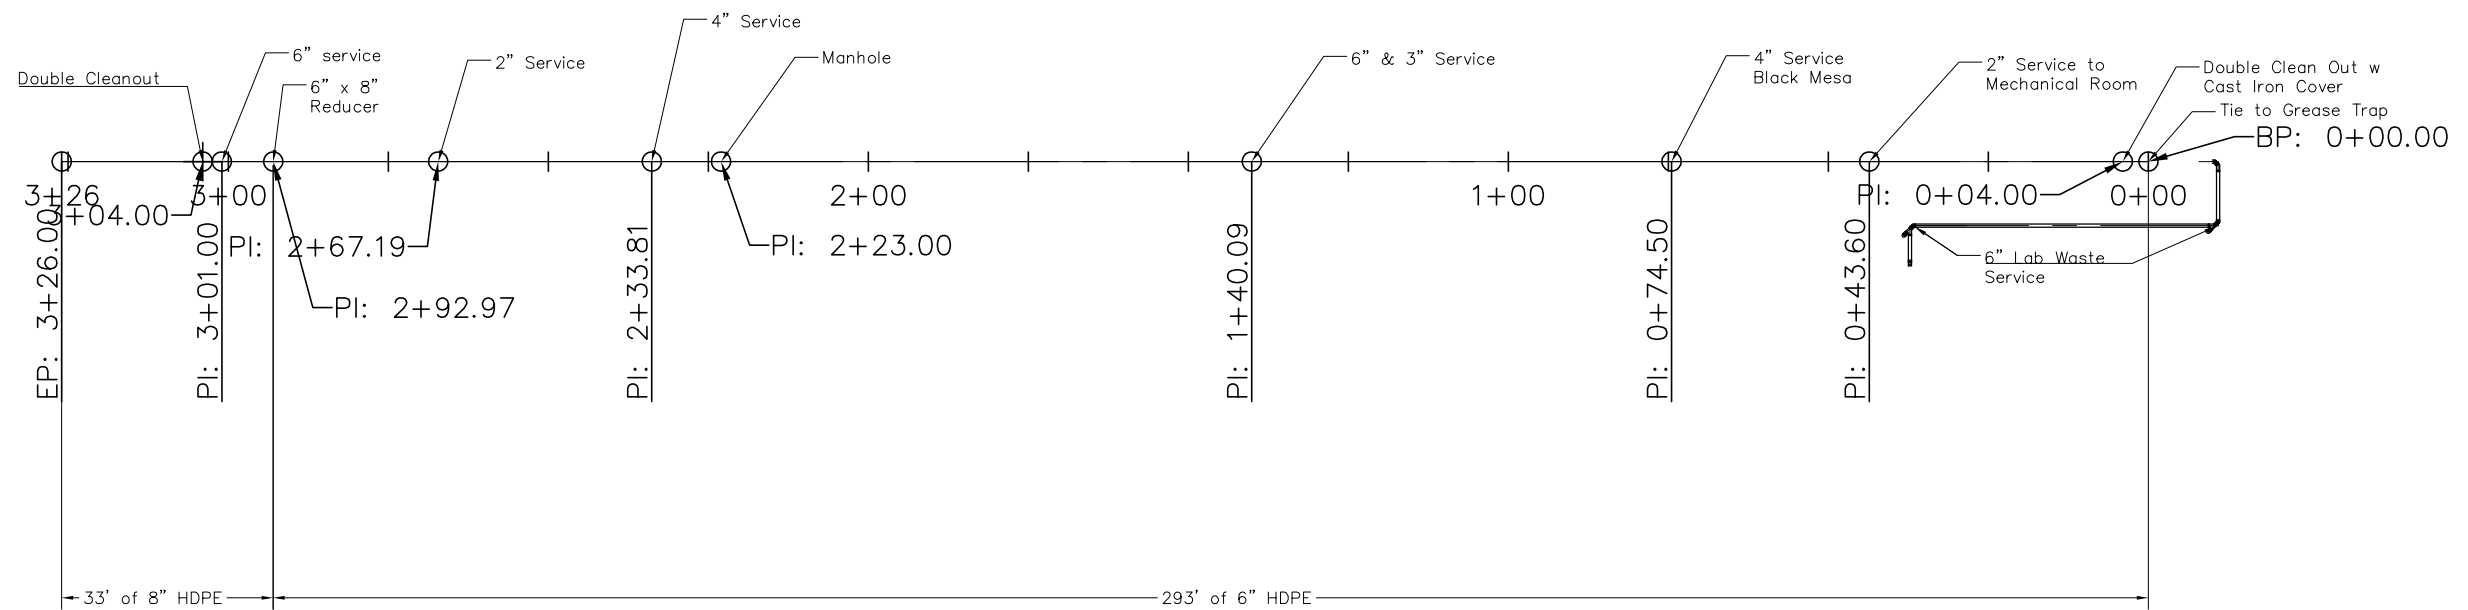

Terminal Building Sewer Service As-Built