


0 30 60 120 Feet

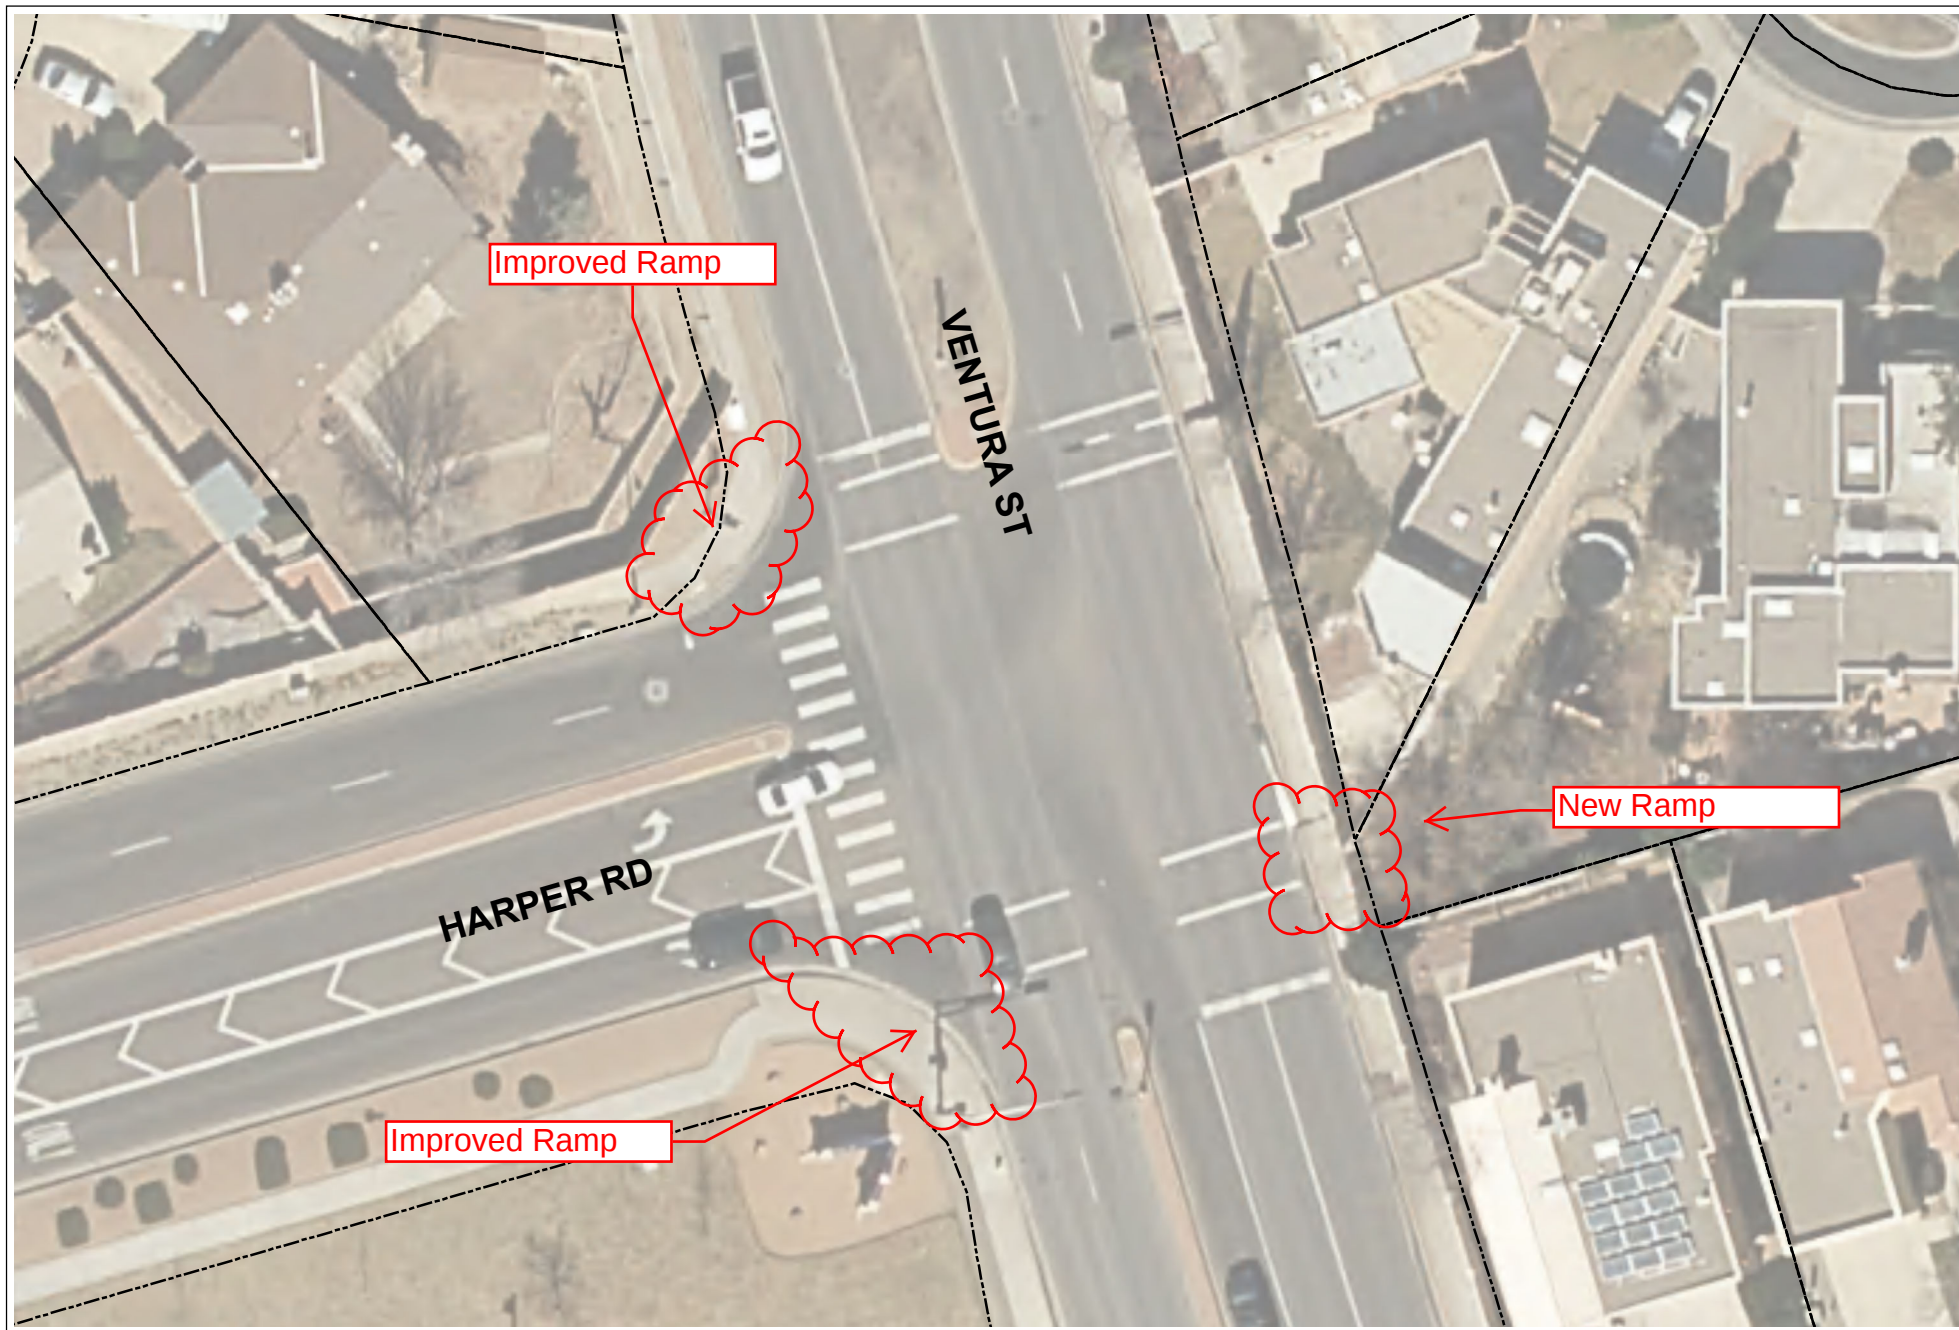

Ventura and Harper ADA improvements