


APD Osuna Substation



0 40 80 160 Feet

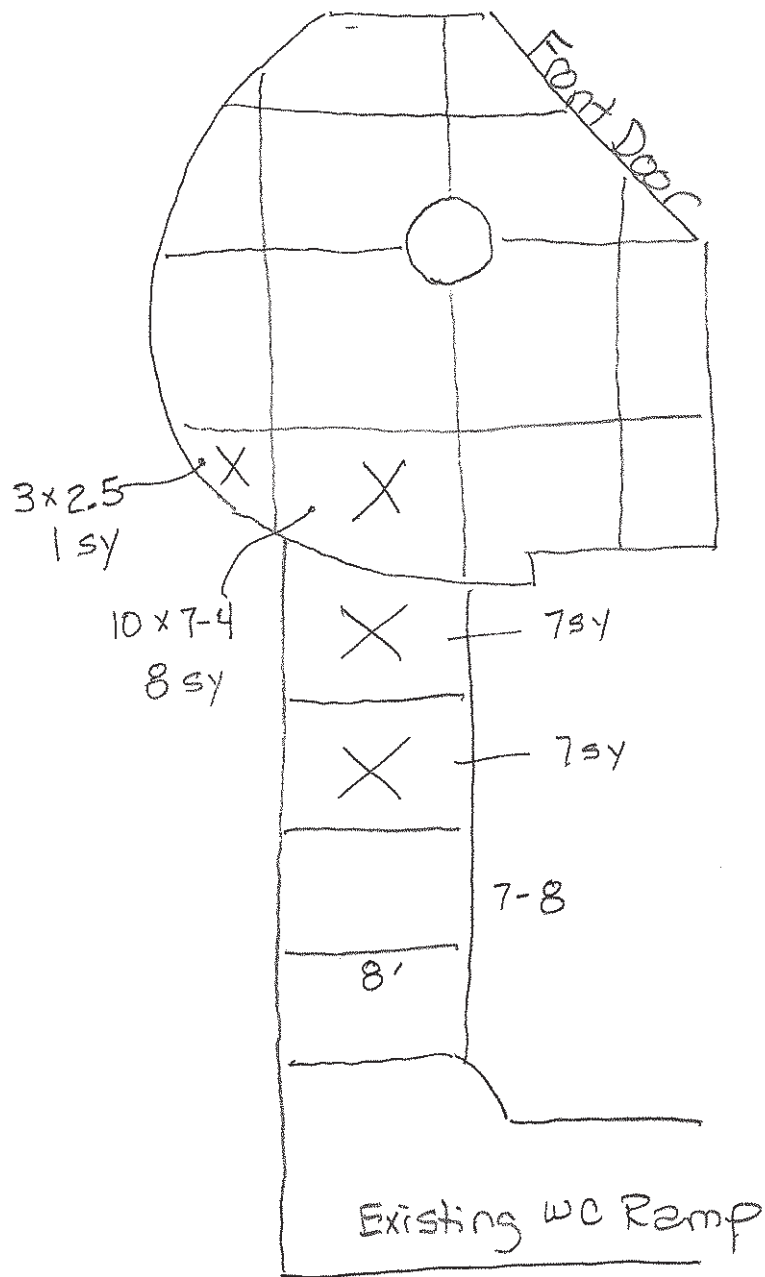


Civilian Call Trip Hazard



OSUNA RD

WYOMING BLVD

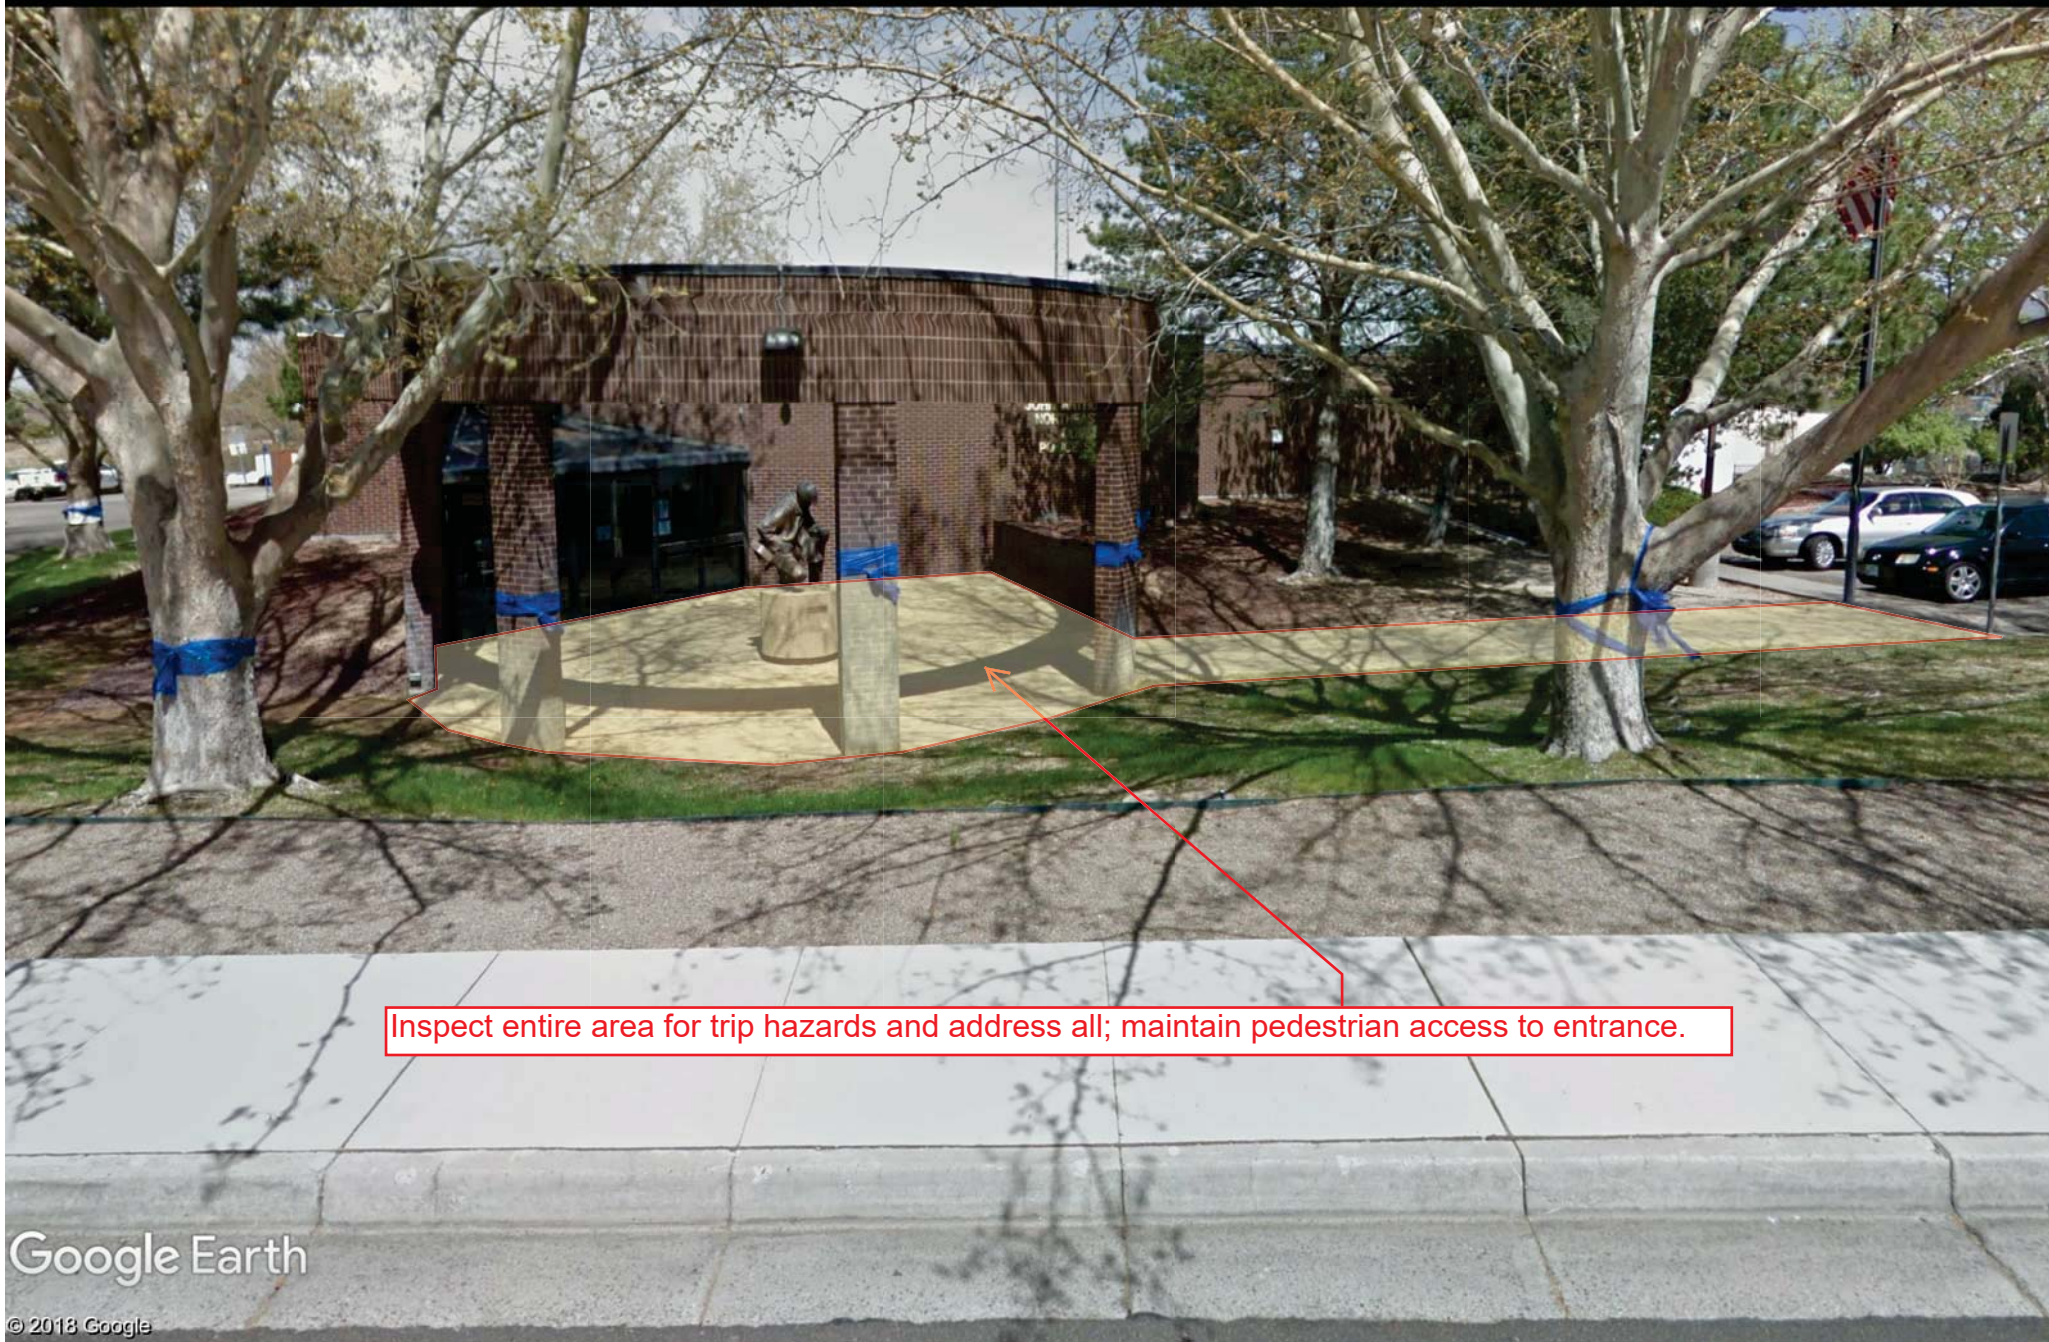

Inspect entire area for trip hazards and address all; maintain pedestrian access to entrance.