


EXISTING RAILROAD TRACKS

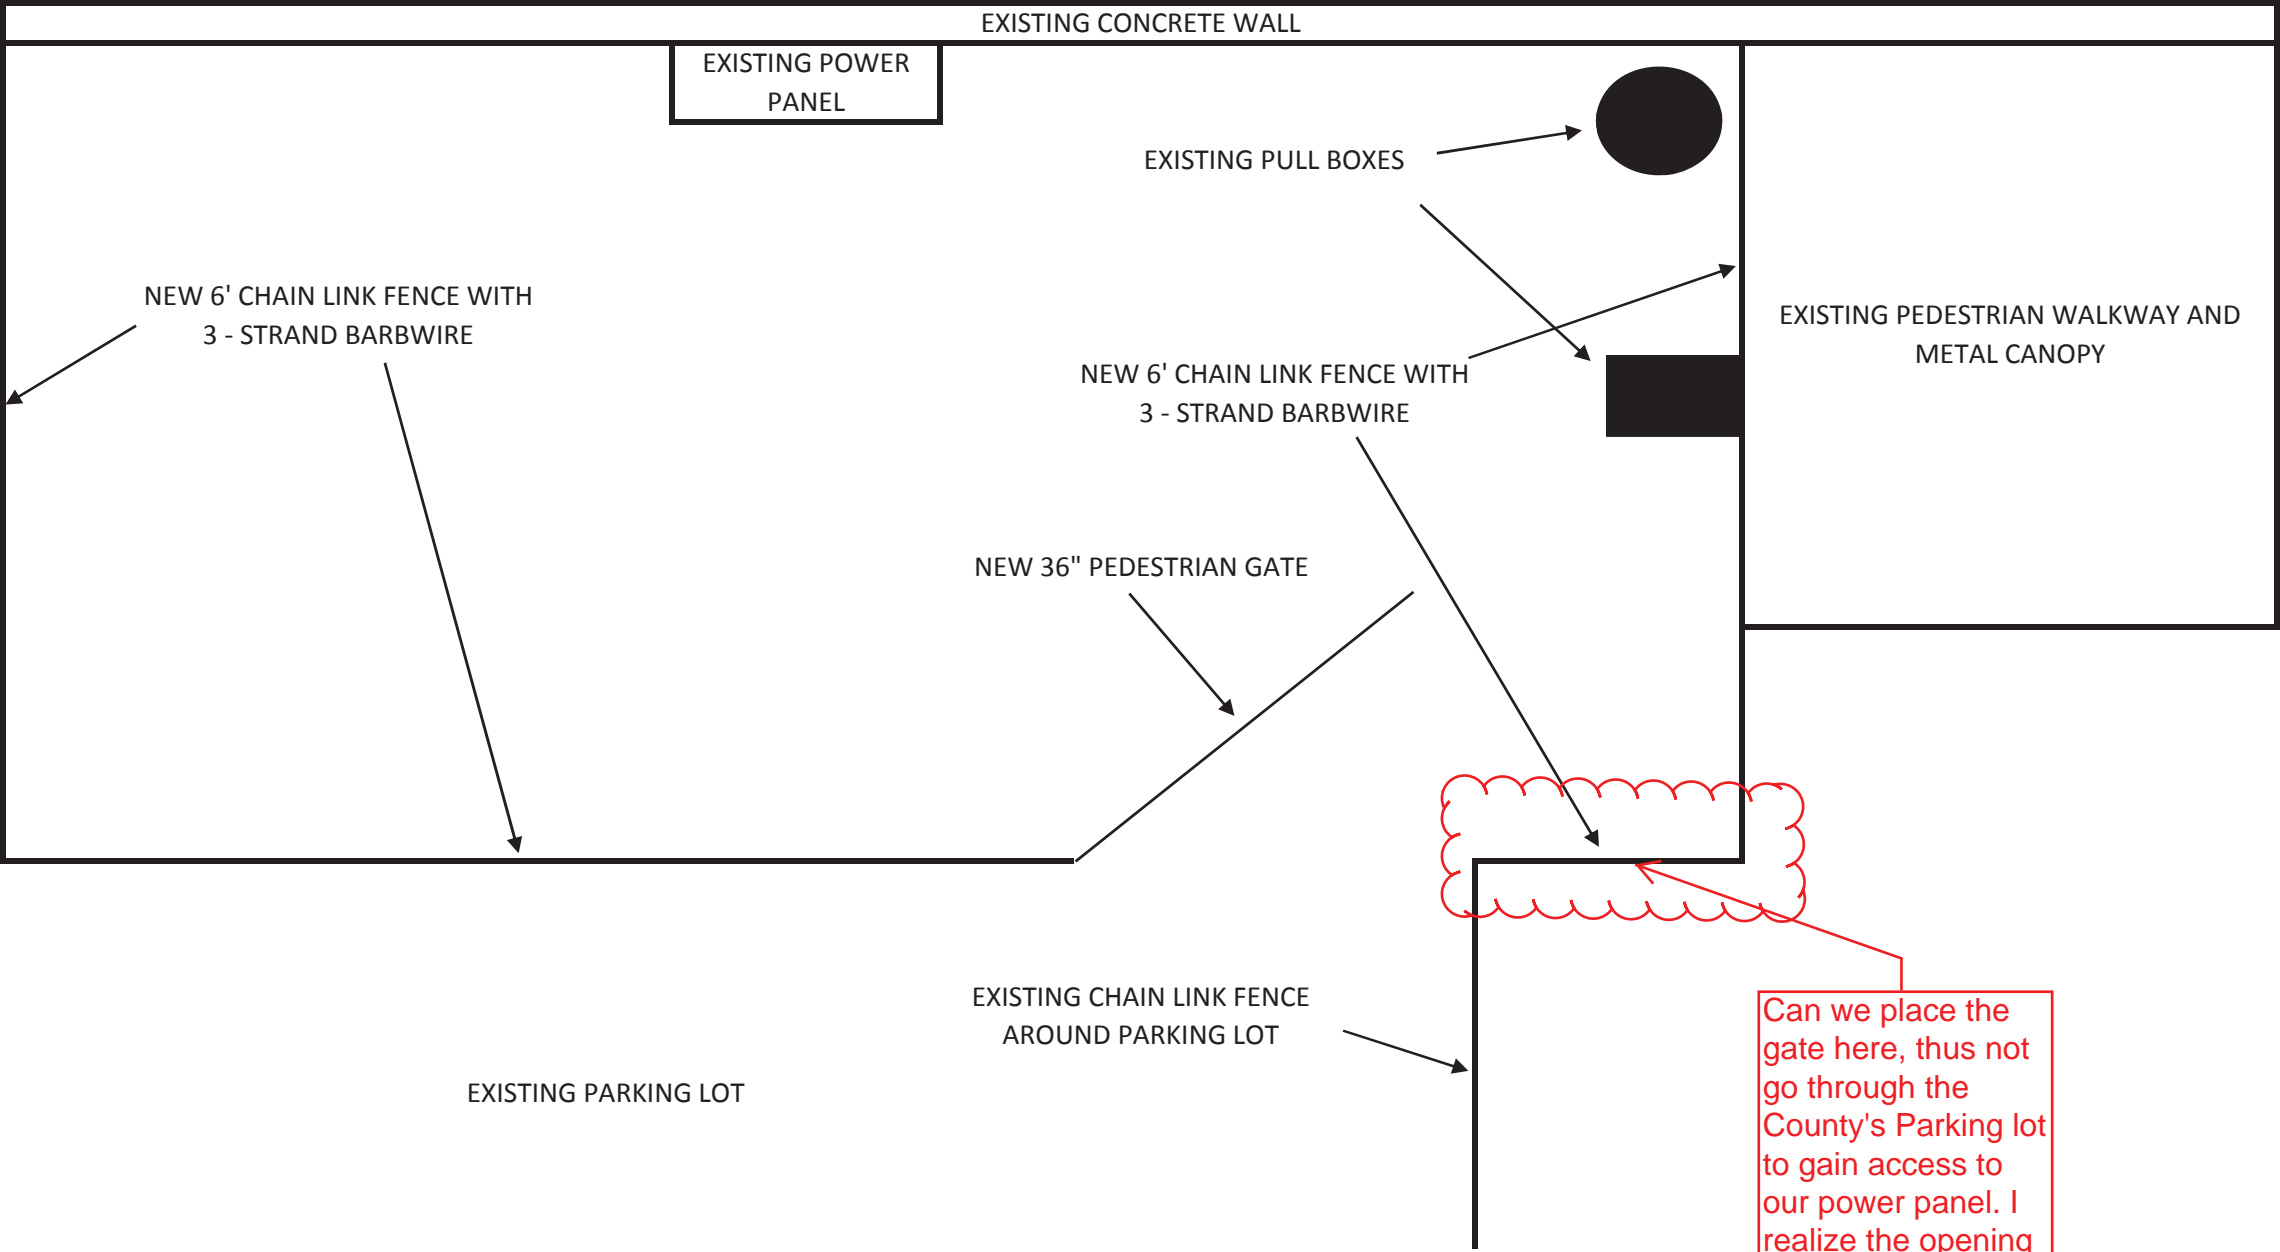

Can we place the gate here, thus not go through the County's Parking lot to gain access to our power panel. I realize the opening may be less than 36-inches. Possibly a minimum of 24-inches.