


Google Earth

© 2017 Google



Locate existing storm drain
manhole and adjust to grade
with new ring and cover.

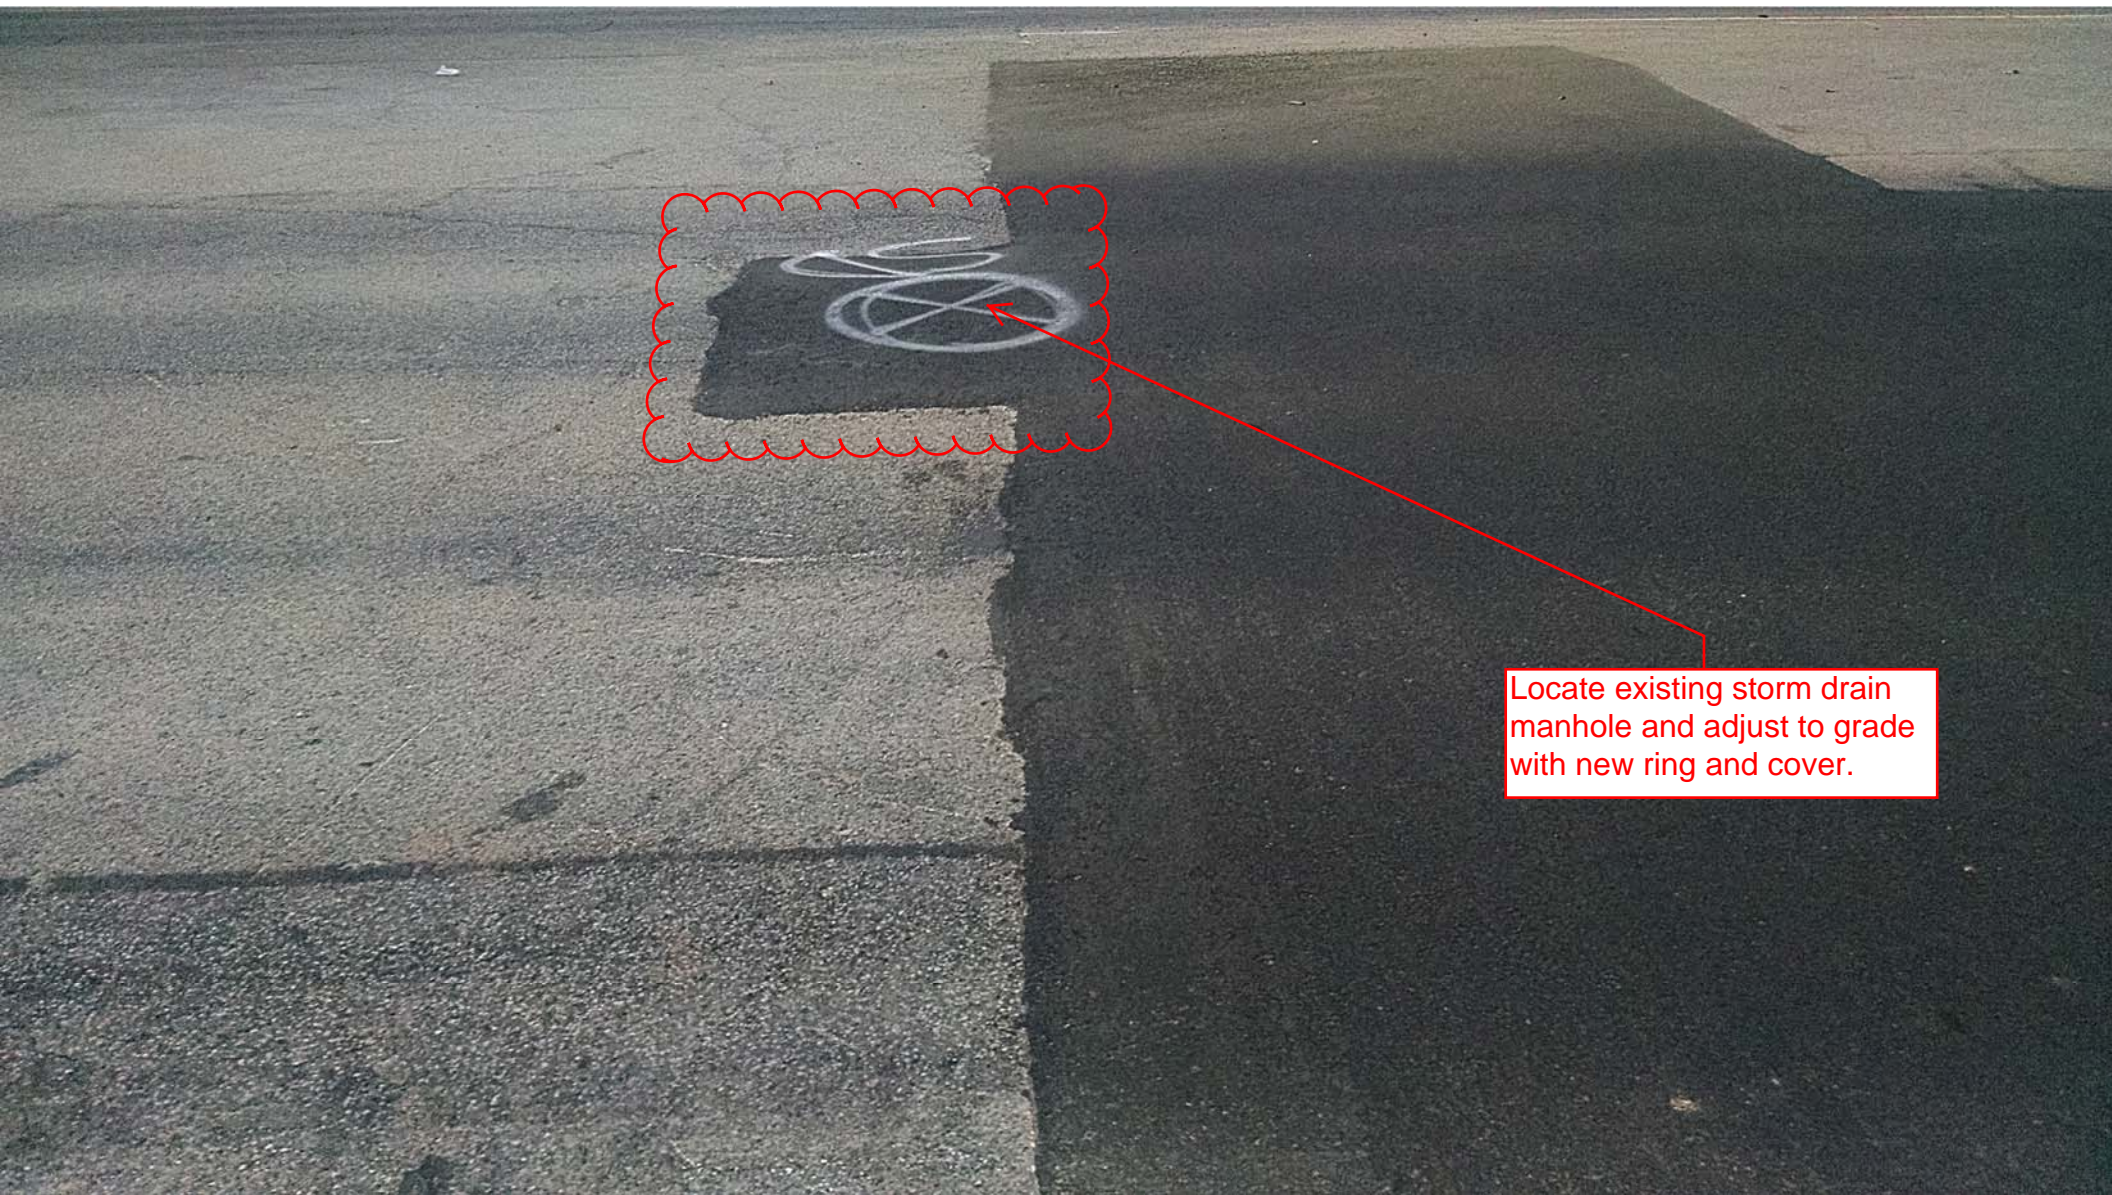