



- Grind  $1/4" < h < 1/2"$
- Remove & Replace  $1/2" < h$

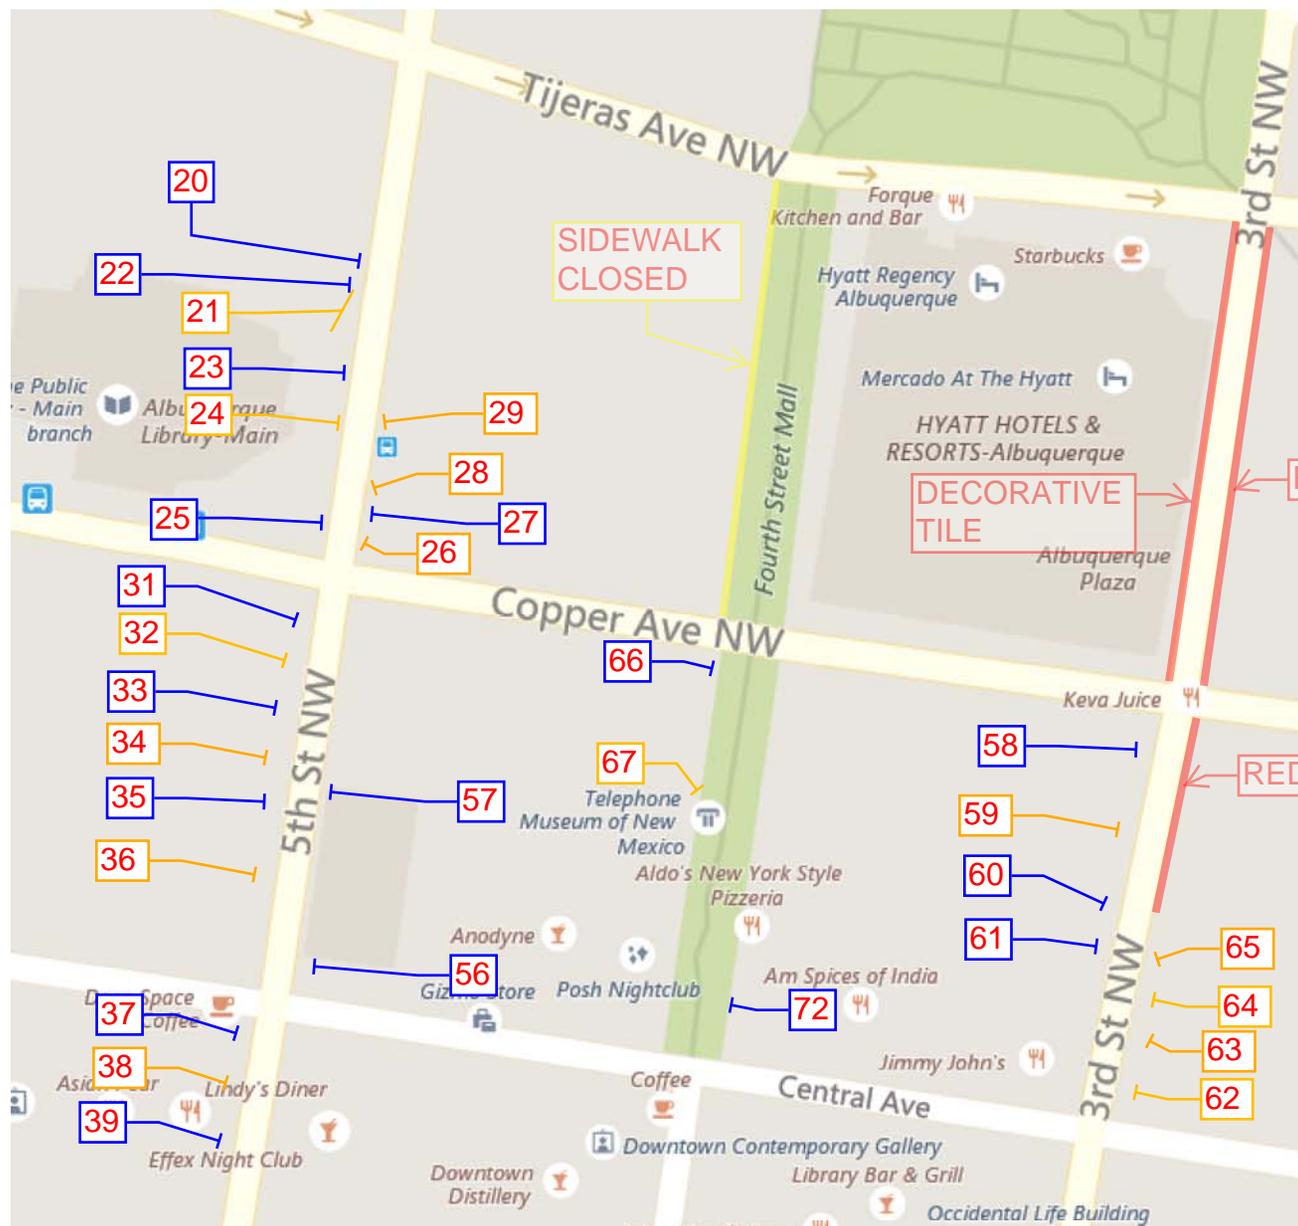

- Grind  $1/4" < h < 1/2"$
- Remove & Replace  $1/2" < h$

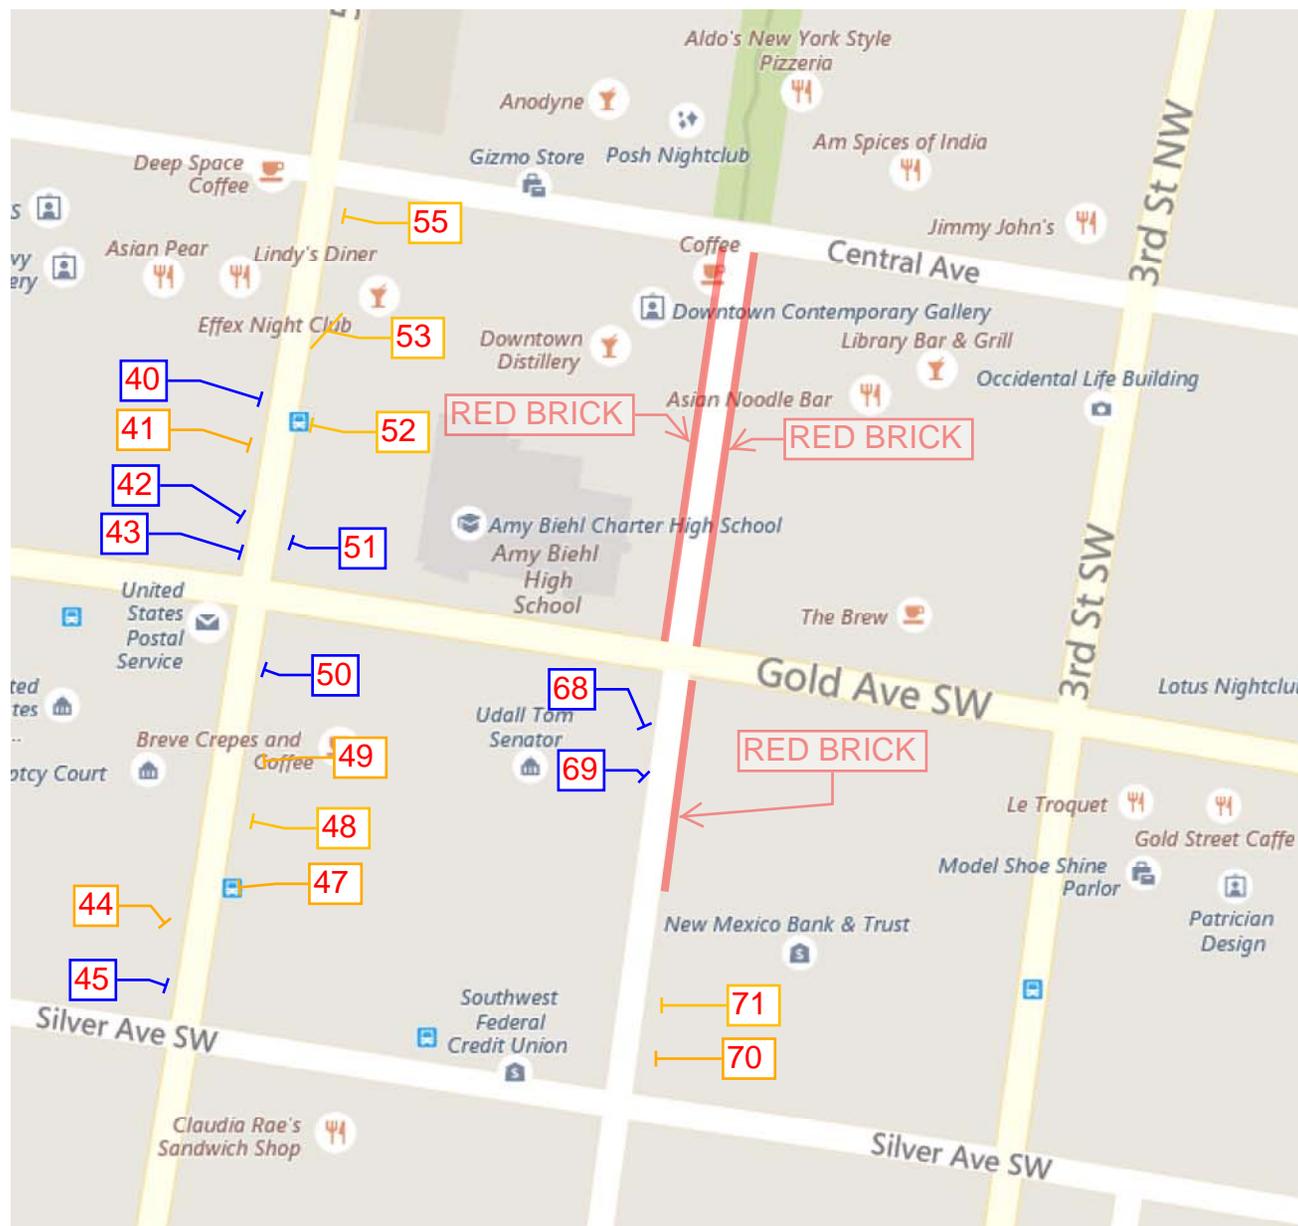

- Grind 1/4" < h < 1/2"
- Remove & Replace 1/2" < h



Street	Date	Number	Type	Location	Avg. Width (in.)	Length (in.)
5th	07.19.17	1	Grind	Between Marquette & Tijeras (west)	N/A	N/A
		2	Grind	Between Marquette & Tijeras (west)	N/A	N/A
		3	Remove & Replace	Between Marquette & Tijeras (west)	77.5	93
		4	Remove & Replace	Between Marquette & Tijeras (west)	N/A	N/A
		5	Remove & Replace	Between Marquette & Tijeras (west)	90	288
		8	Grind	Between Marquette & Tijeras (west)	N/A	N/A
		9	Remove & Replace	Between Marquette & Tijeras (west)	91, 64	74, 44
		10	Grind	Between Marquette & Tijeras (west)	N/A	N/A
		11	Remove & Replace	Between Marquette & Tijeras (west)	72	90
		12	Previously Marked	Between Marquette & Tijeras (west)		
		13	Remove & Replace	Between Marquette & Tijeras (east)	100	225
		14	Remove & Replace	Between Marquette & Tijeras (east)	102	116.5
		15	Remove & Replace	Between Marquette & Tijeras (east)	115	115
		16	Previously Marked	Between Marquette & Tijeras (east)		
		17	Remove & Replace	Between Marquette & Tijeras (east)		
		18	Grind	Between Marquette & Tijeras (east)	N/A	N/A
		19	Remove & Replace	Between Marquette & Tijeras (east)		
		20	Grind	Between Tijeras & Copper (west)	N/A	N/A
		21	Remove & Replace	Between Tijeras & Copper (west)		
		22	Grind	Between Tijeras & Copper (west)	N/A	N/A
		23	Grind	Between Tijeras & Copper (west)	N/A	N/A
		24	Remove & Replace	Between Tijeras & Copper (west)	85	216
		25	Grind	Between Tijeras & Copper (west)	N/A	N/A
		26	Remove & Replace	Between Tijeras & Copper (east)	80	72
		27	Grind	Between Tijeras & Copper (east)	N/A	N/A
		28	Previously Marked	Between Tijeras & Copper (east)	85	282
		29	Previously Marked	Between Tijeras & Copper (east)	38	72
		30	Grind	Between Marquette & Tijeras (west)	N/A	N/A
		31	Grind	Between Copper & Central (west)	N/A	N/A
		32	Remove & Replace	Between Copper & Central (west)	93	223
	33	Grind	Between Copper & Central (west)	N/A	N/A	
	34	Remove & Replace	Between Copper & Central (west)	54	60	
	35	Grind	Between Copper & Central (west)	N/A	N/A	
	36	Remove & Replace	Between Copper & Central (west)	60	60	
	37	Grind	Between Central & Gold (west)	N/A	N/A	
	38	Remove & Replace	Between Central & Gold (west)	111	72	
	39	Grind	Between Central & Gold (west)	N/A	N/A	
	40	Grind	Between Central & Gold (west)	N/A	N/A	
	41	Remove & Replace	Between Central & Gold (west)	92	72	
	42	Grind	Between Central & Gold (west)	N/A	N/A	
	43	Grind	Between Central & Gold (west)	N/A	N/A	
	44	Remove & Replace	Between Gold & Silver (west)	32	64	
	45	Grind	Between Gold & Silver (west)	N/A	N/A	
	47	Remove & Replace	Between Gold & Silver (east)	113	75	
	48	Remove & Replace	Between Gold & Silver (east)			
	49	Remove & Replace	Between Gold & Silver (east)	137	62	
	50	Grind	Between Gold & Silver (east)	N/A	N/A	
	51	Grind	Between Central & Gold (east)	N/A	N/A	
	52	Remove & Replace	Between Central & Gold (east)	110	78	
	53	Remove & Replace	Between Central & Gold (east)	110	216	
	55	Remove & Replace	Between Central & Gold (east)			
	56	Grind	Between Copper & Central (east)	N/A	N/A	
	57	Grind	Between Copper & Central (east)	N/A	N/A	

		92	Remove & Replace	Between Tijeras & Copper (west)		
3rd	7.20.17	58	Grind	Between Copper & Central (west)	N/A	N/A
		59	Remove & Replace	Between Copper & Central (west)	89	46
		60	Grind	Between Copper & Central (west)	N/A	N/A
		61	Grind	Between Copper & Central (west)	N/A	N/A
		62	Remove & Replace	Between Copper & Central (east)	86	73
		63	Remove & Replace	Between Copper & Central (east)	86	72
		64	Remove & Replace	Between Copper & Central (east)	86	145
		65	Remove & Replace	Between Copper & Central (east)	88	72
4th	7.24.17	66	Grind	Between Copper & Central (west)	N/A	N/A
		67	Remove & Replace	Between Copper & Central (west)	53	64
		68	Grind	Between Gold & Silver (west)	N/A	N/A
		69	Grind	Between Gold & Silver (west)	N/A	N/A
		70	Remove & Replace	Between Gold & Silver (east)	90	76
		71	Remove & Replace	Between Gold & Silver (east)	88	240
		72	Grind	Between Copper & Central (east)	N/A	N/A
Tijeras	7.24.17	73	Remove & Replace	Between 4th & 5th (north)	104	258
		74	Grind	Between 4th & 5th (north)	N/A	N/A
		75	Remove & Replace	Between 4th & 5th (north)	95	71
		76	Remove & Replace	Between 4th & 5th (north)	70	175
		77	Remove & Replace	Between 4th & 5th (north)	79	144
		78	Remove & Replace	Between 3rd & 4th (north)		
Marquette	7.24.17	79	Remove & Replace	Between 3rd & 4th (north)	86	292
		80	Grind	Between 3rd & 4th (north)	N/A	N/A
		81	Grind	Between 4th & 5th (north)	N/A	N/A
		82	Grind	Between 4th & 5th (north)	N/A	N/A
		83	Remove & Replace	Between 4th & 5th (north)	158	464
		84	Remove & Replace	Between 4th & 5th (north)	133	229
		85	Remove & Replace	Between 4th & 5th (north)	222	466
		86	Remove & Replace	Between 4th & 5th (south)	78	52
		87	Grind	Between 4th & 5th (south)	N/A	N/A
		88	Grind	Between 4th & 5th (south)	N/A	N/A
	89	Grind	Between 4th & 5th (south)	N/A	N/A	
	8.01.17	90	Grind	Between 3rd & 4th (north)	N/A	N/A
	91	Grind	Between 3rd & 4th (north)	N/A	N/A	