
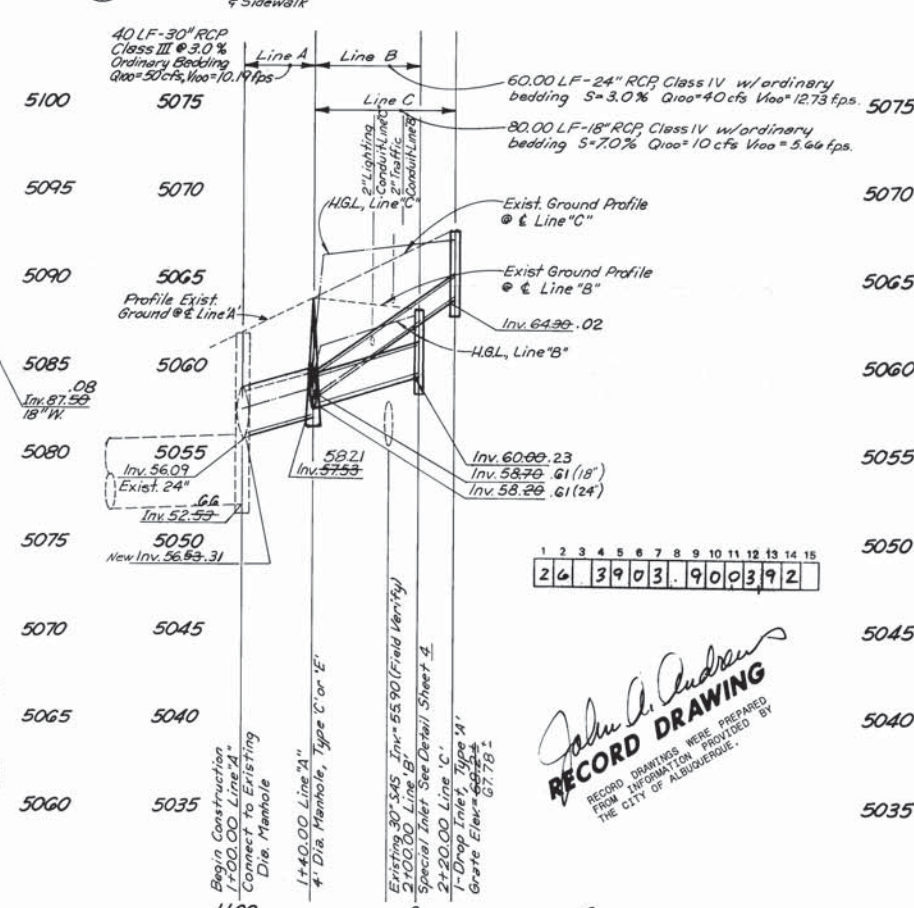
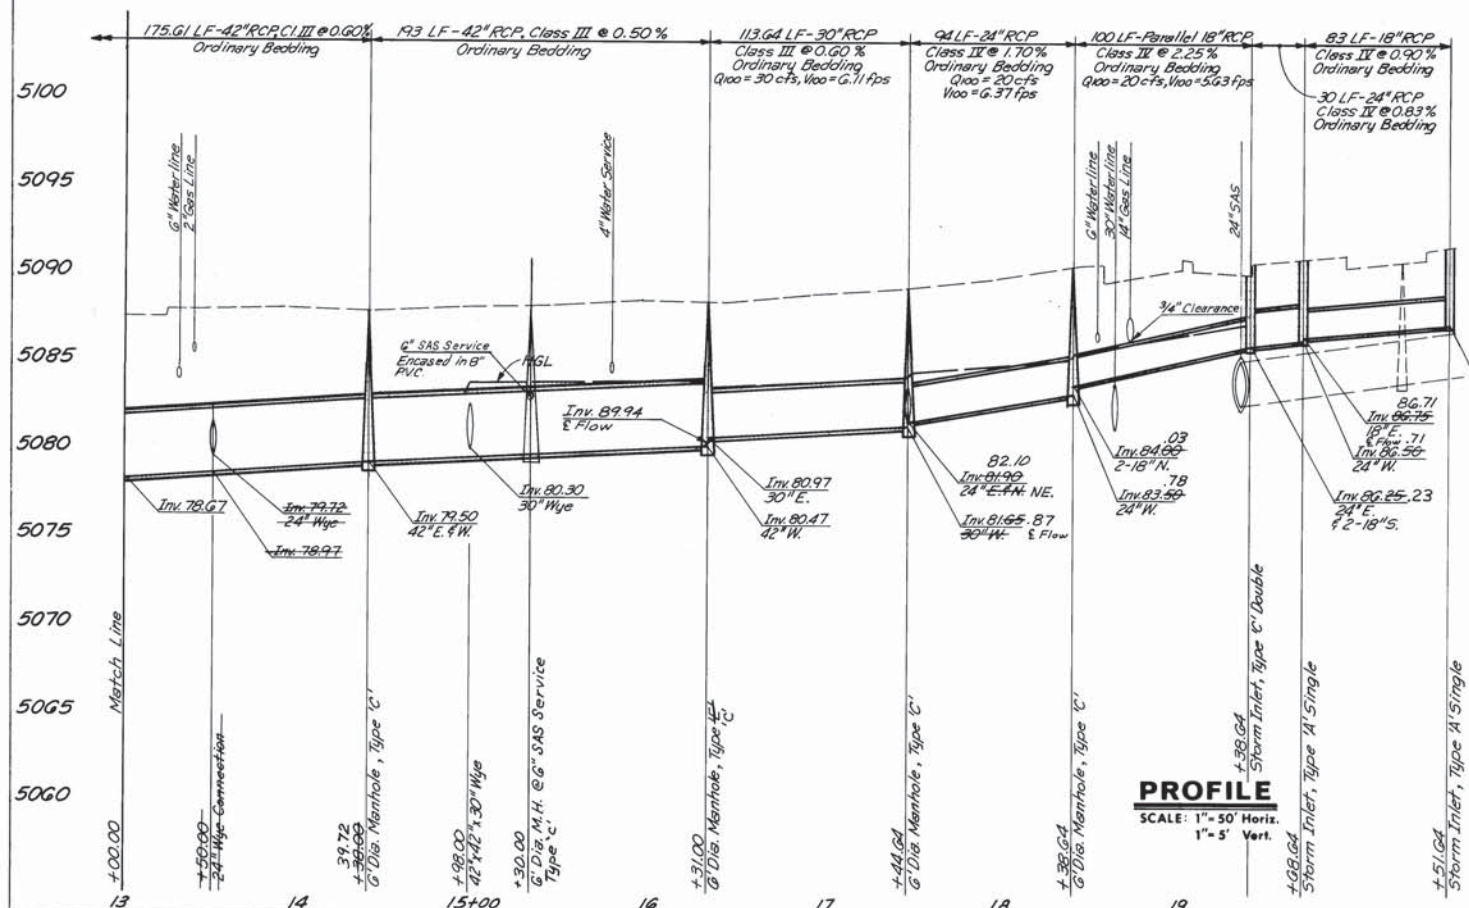
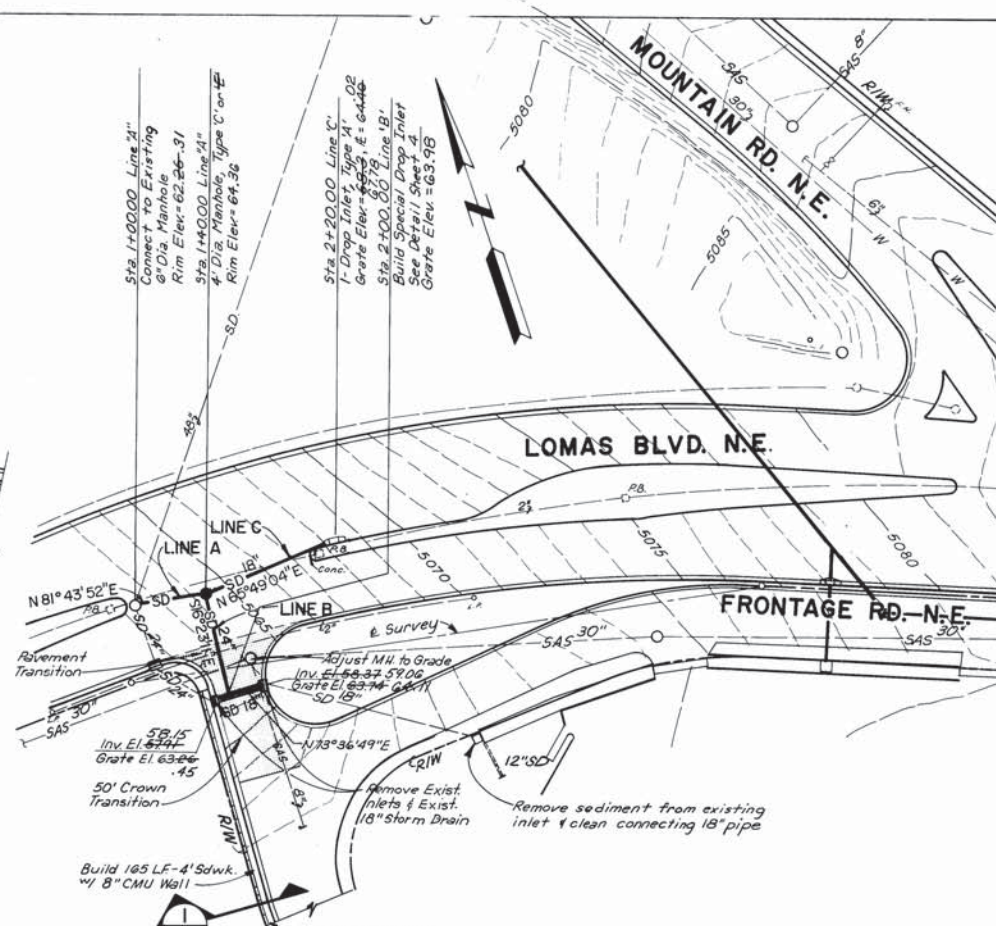



2. Construct new type C single inlet ("G dimension = 1'-10") and connect to existing 36" SD with approx. 210 LF of 8" C900 pipe. Core and grout existing 36" pipe to connect.

Approximate COA R.O.W.


Lomas and Legion Inlet Repair

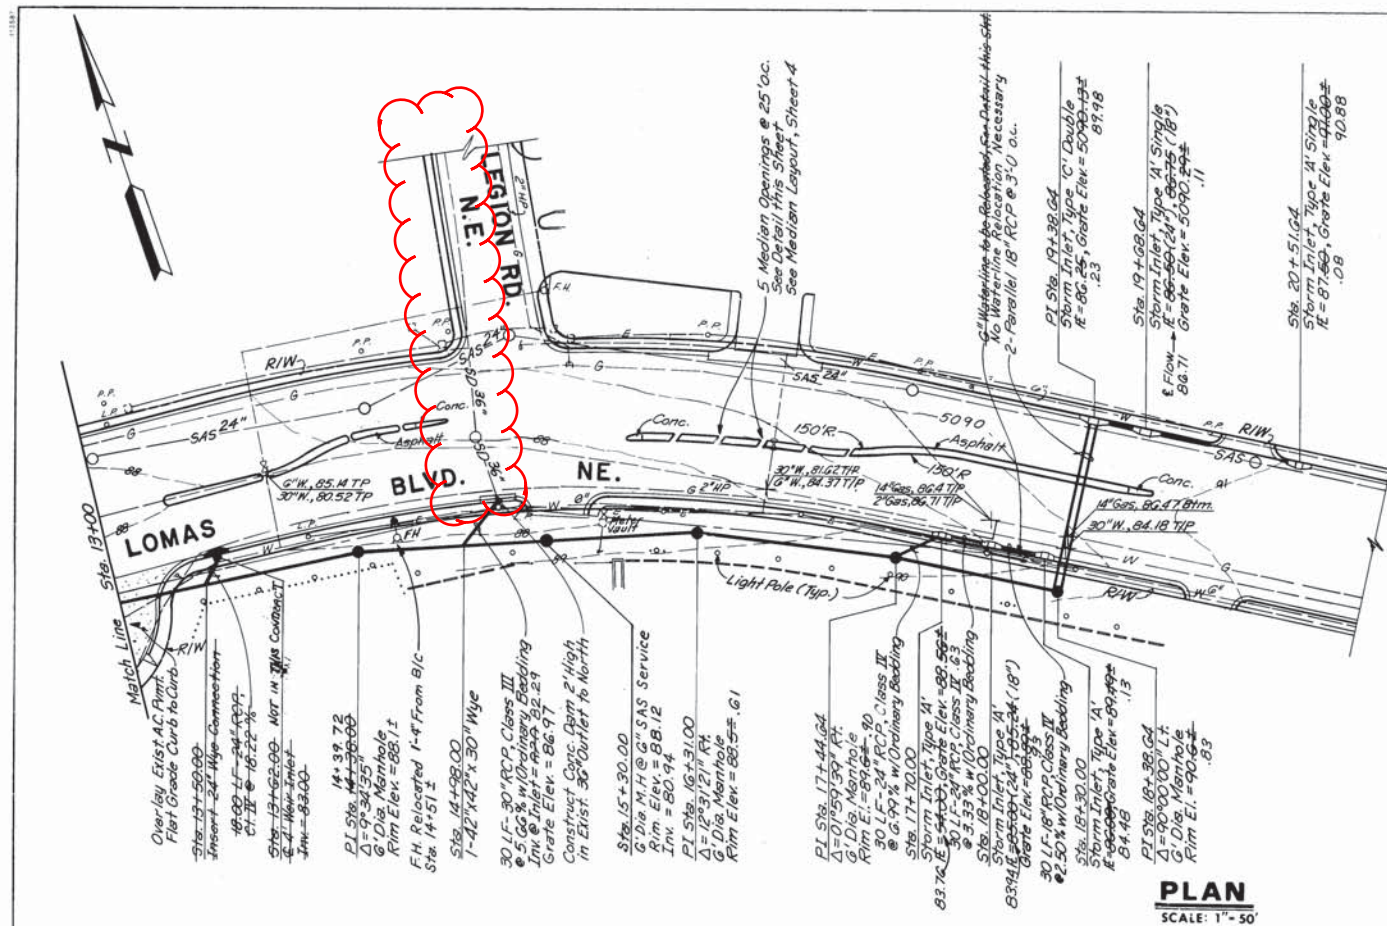


NOTES:
1. CONTRACTOR MUST VERIFY EXACT LOCATION AND ELEVATION OF 30" WATERLINE AND GAS LINE PRIOR TO LAYING PIPE EAST OF MANHOLE STATION 13+51.37. FAILURE TO DO SO WILL RESULT IN ANY REMOVALS AND RE-LAYING OF STORM DRAIN REQUIRED BECAUSE OF GRADE CHANGES TO BE AT THE CONTRACTOR'S EXPENSE.

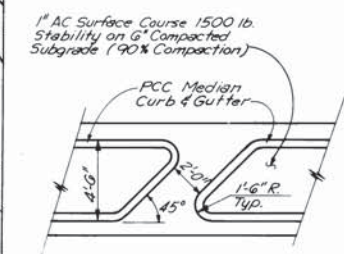

TYPICAL MEDIAN OPENING
SCALE: 1"=5'

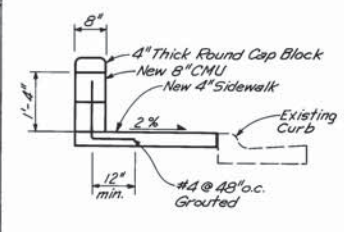

SECTION
SCALE: 1/2"=1'-0'

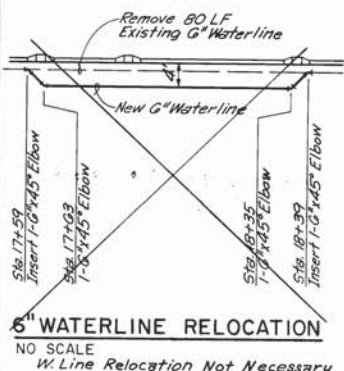


6" WATERLINE RELOCATION
NO SCALE
W. Line Relocation Not Necessary

AS BUILT INFORMATION		BENCH MARKS		SURVEY INFORMATION		ENGINEER'S SEAL		REVISIONS		DESIGN		CITY OF ALBUQUERQUE		TITLE	
DATE	BY	DATE	BY	DATE	BY	DATE	BY	DATE	BY	DATE	BY	DATE	BY	DATE	BY
1/1/91	A.A.R.	1/1/91	A.A.R.	1/1/91	A.A.R.	1/1/91	A.A.R.	1/1/91	A.A.R.	1/1/91	A.A.R.	1/1/91	A.A.R.	1/1/91	A.A.R.
CITY OF ALBUQUERQUE PUBLIC WORKS DEPARTMENT ENGINEERING GROUP															
LOMAS BOULEVARD STORM DRAIN - PHASE I PLAN & PROFILE - STA 13+00 TO STA 19+03.00															
APPROVALS	ENGINEER	DATE	APPROVALS	ENGINEER	DATE										
DRC CHAIRMAN	1/1/91	1/1/91	WATER	1/1/91	1/1/91										
TRANSPORTATION	1/1/91	1/1/91	WASTE WATER	1/1/91	1/1/91										
HYDROLOGY	1/1/91	1/1/91													
DRAWING NO.	3903.90	MAP NO.	J-15	SHEET	3	OF 15									

PLAN

SECTION A-A

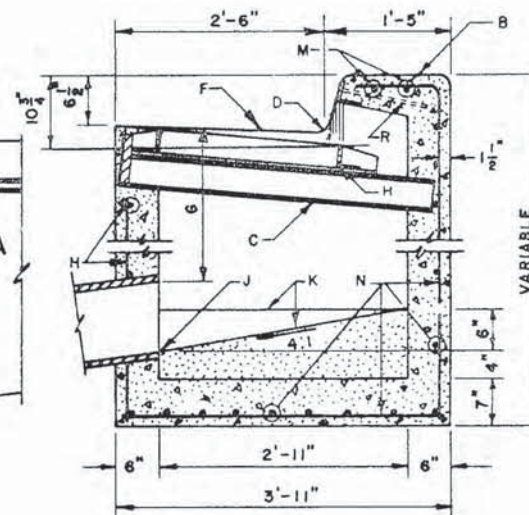

SECTION B-B

ANCHOR DETAIL

GENERAL NOTES:

1. FOR SINGLE GRATE TYPE STORM INLET DELETE CENTER SUPPORT AND MOVE ONE END WALL TO FORM NEW SINGLE GRATE INLET.
2. FOR STORM INLET GUTTER TRANSITION, SEE DWG 2207.
3. OUTLET PIPE SIZE, PER DESIGN REQUIREMENT.
4. FOR FRAME & GRATING, SEE DWG 2216, 2220 & 2221.
5. FOR ANCHOR SEE DETAIL.
6. FOR CENTER SUPPORT ASSEMBLY, SEE DWG 2215.

CONSTRUCTION NOTES:

- A. GUTTER TRANSITION.
- B. TOP OF CURB.
- C. CENTER SUPPORT ASSEMBLY.
- D. FLOWLINE.
- E. CONSTRUCTION JOINT.
- F. NORMAL GUTTER LINE.
- G. 1'-10" MIN, UNLESS OTHERWISE DIRECTED.
- H. FRAME AND GRADE.
- J. INVERT OF OUTLET PIPE.
- K. CONCRETE FILL, MINIMUM SLOPES AS SHOWN.
- L. FOR STORM INLET DEPTHS GREATER THAN 4' INSTALL STD STEPS, SEE DWG 2229, DOWNSTREAM FACE.
- M. EXTEND NO. 4 REBARS 18" INTO CURB ON EACH SIDE OF STORM INLET.
- N. NO. 4 BARS AT 6" O.C.
- P. 3 1/2" X 3 1/2" X 1/2" X 4' - 0" FOR SINGLE GRADE TYPE "C" STORM INLET.
- Q. 3 1/2" X 3 1/2" X 1/2" X 7' - 6" FOR DOUBLE GRADE TYPE "C" STORM INLET.
- R. ANCHOR.

REVISIONS 12-21-92	CITY OF ALBUQUERQUE
	DRAINAGE STORM INLET DOUBLE "C" DWG. 2205
	AUG. 1986





Google Earth

feet
meters



OPTION 2
NTS

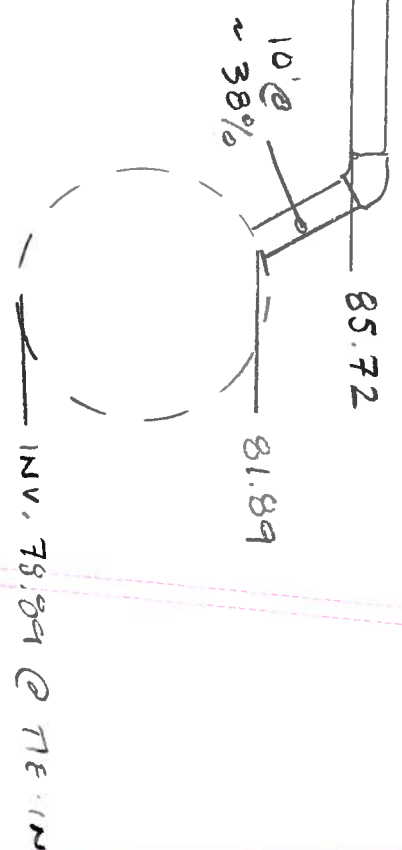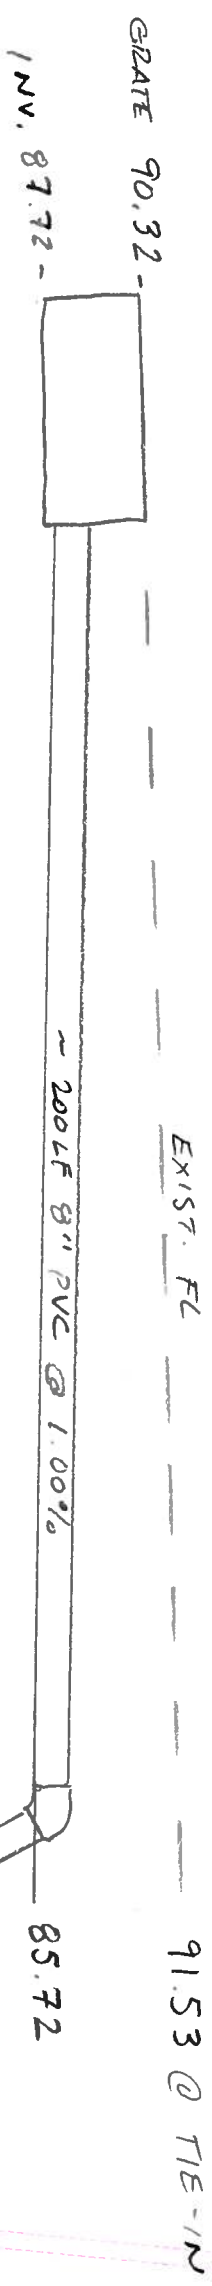

NOTES:
1. ALL ELEVATIONS ARE IN FEET.
2. ALL DISTANCES ARE IN FEET.
3. ALL ANGLES ARE IN DEGREES.
4. ALL DIMENSIONS ARE IN FEET.
5. ALL DIMENSIONS ARE IN FEET.
6. ALL DIMENSIONS ARE IN FEET.
7. ALL DIMENSIONS ARE IN FEET.
8. ALL DIMENSIONS ARE IN FEET.
9. ALL DIMENSIONS ARE IN FEET.
10. ALL DIMENSIONS ARE IN FEET.

