

Paint Existing
~~Install two yellow~~
parking bumpers along
north sidewalk edge Yellow


~~Move Dumpster~~
~~off Sidewalk~~

~~Install "No~~
~~Parking On~~
~~Sidewalk" Sign~~
~~Facing East~~

NO
PARKING
ON
SIDEWALK

INSTALL
CONCRETE
PLANTER

INSTALL
CONCRETE
PLANTER

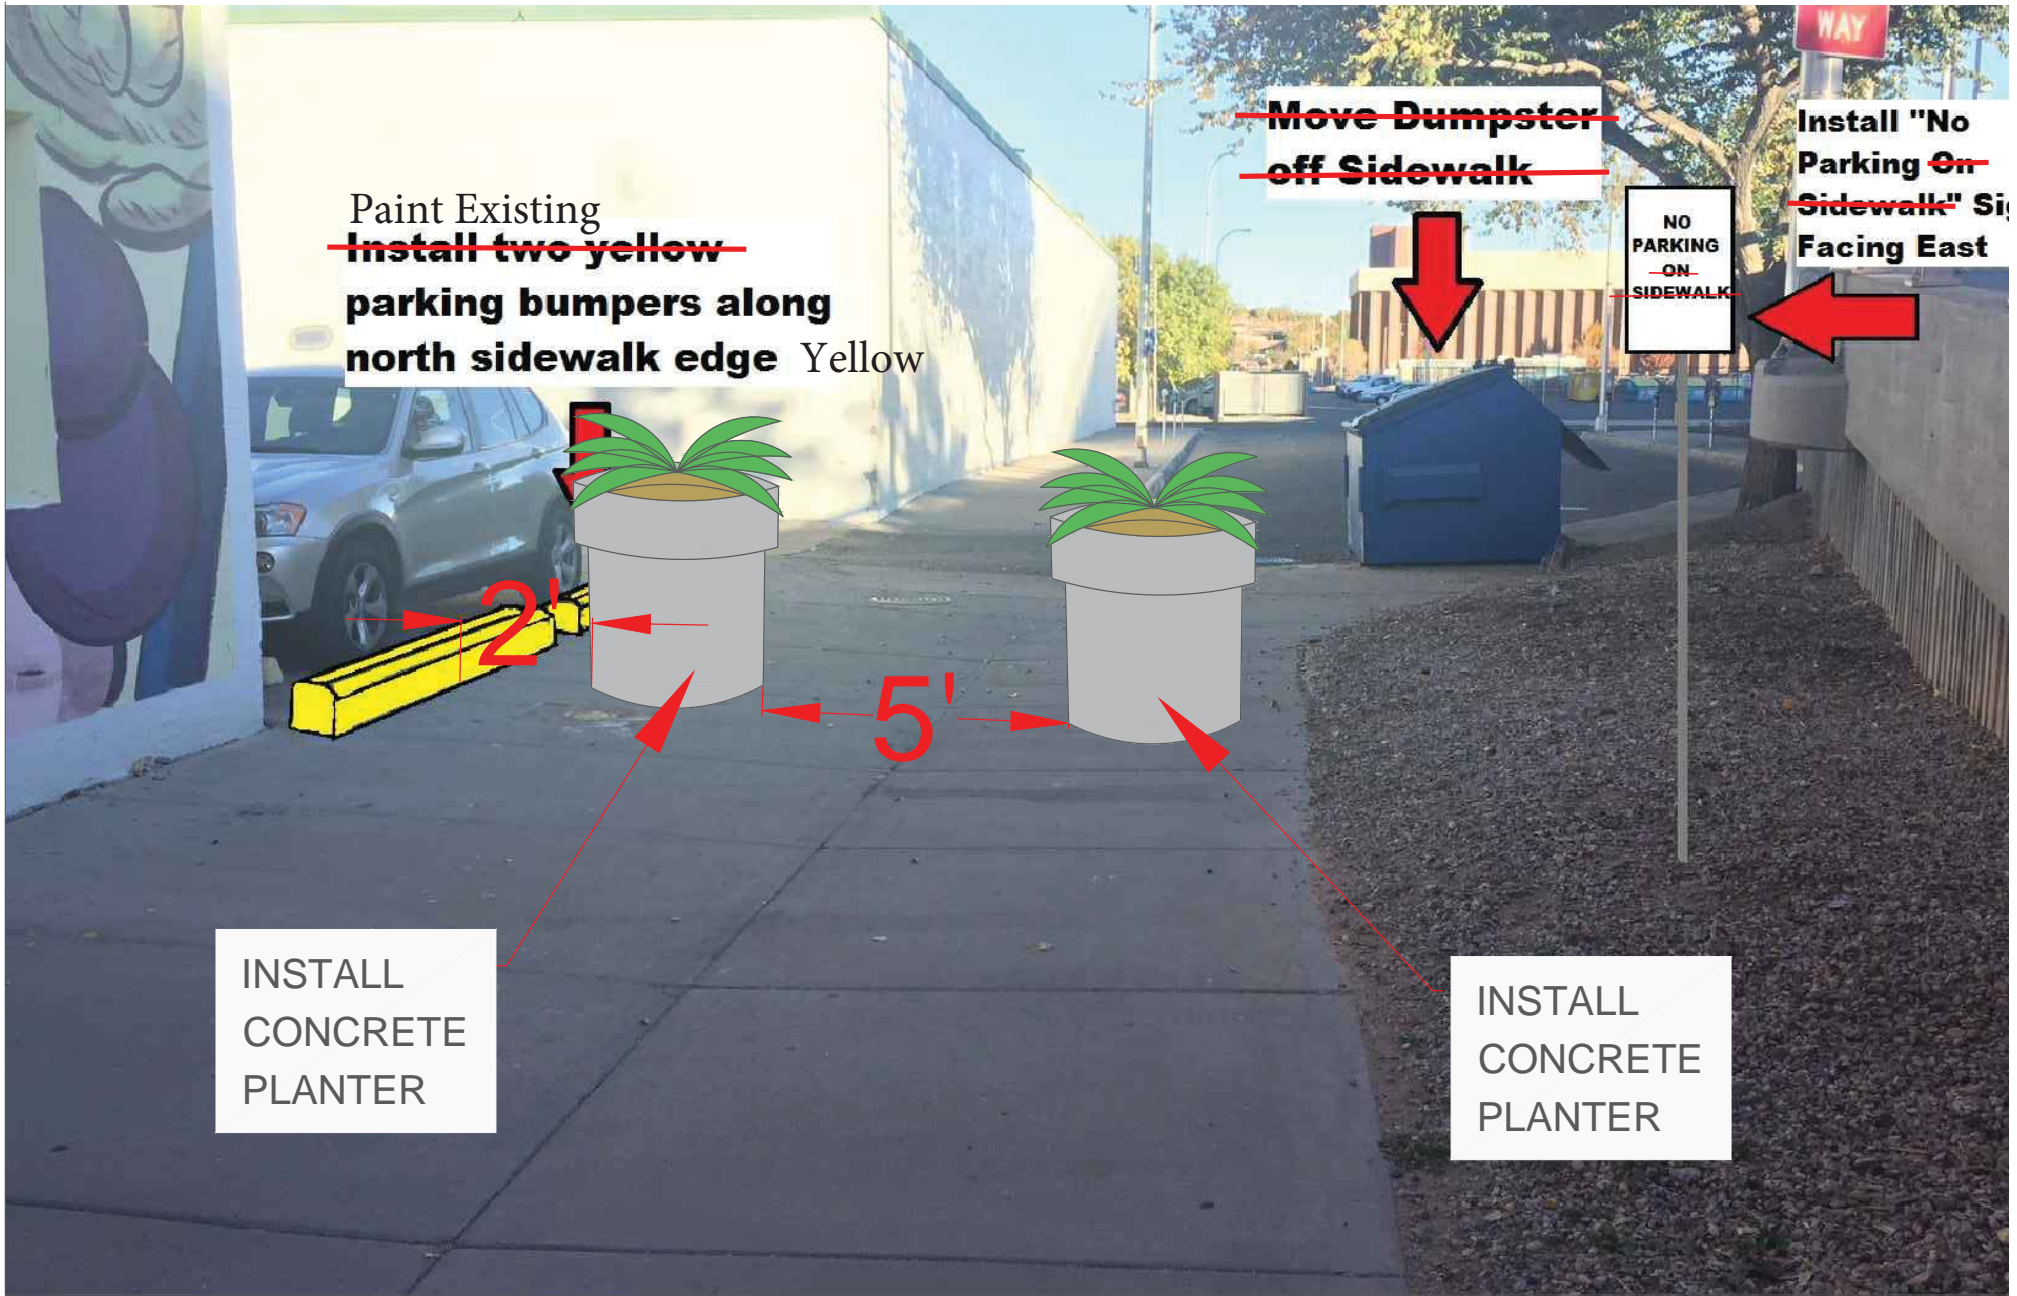



**PAINT PARKING BUMPERS YELLOW
(ALONG NORTH SIDEWALK EDGE)**

This block contains the top-left annotation. A red arrow points from the text box to a yellow rectangular bumper on the sidewalk. The background is an aerial photograph showing a street intersection with buildings and trees.

**INSTALL TWO
CONCRETE PLANTERS
SPACED AT 5'**

This block contains the middle-left annotation. Two red arrows point from the text box to two yellow circular markers on the sidewalk, indicating the locations for concrete planters. A yellow line outlines a proposed area on the sidewalk.

**RELOCATED
DUMPSTER (BY
OTHERS)**

This block contains the middle-right annotation. A red arrow points from the text box to a blue square marker on the sidewalk, indicating the new location for a dumpster. A yellow curved line shows the proposed path or boundary.

MARQUETTE AVE

This block contains the street name label. The text 'MARQUETTE AVE' is written in red, slanted capital letters along the bottom-left edge of the image, identifying the street shown in the aerial view.



