


Untitled Map

Write a description for your map.

Legend

- Coors @ Central
- US Post Office

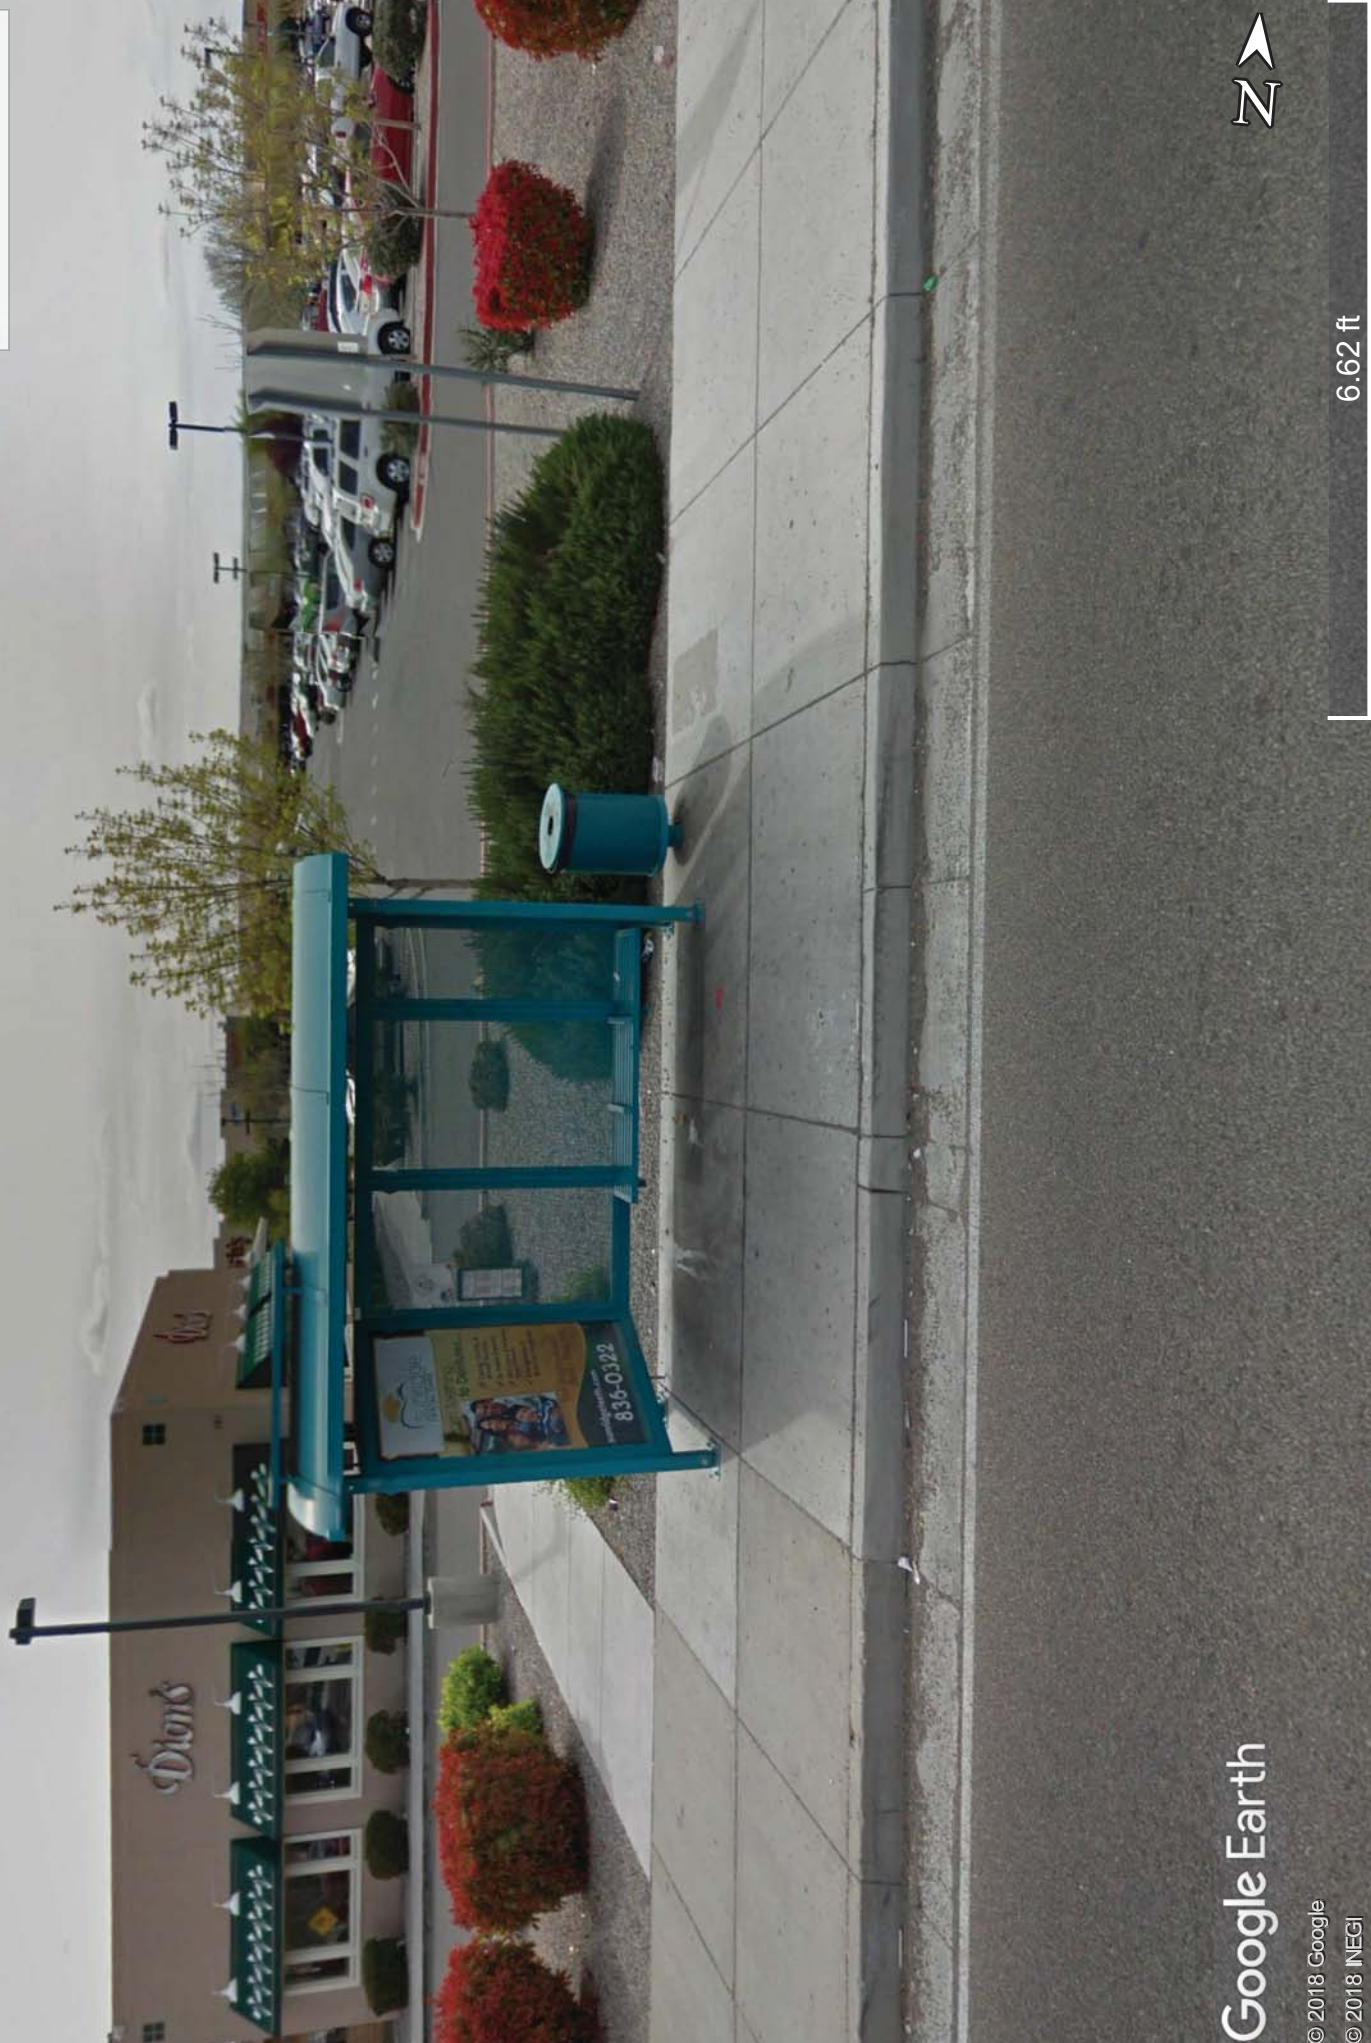


Google Earth

© 2018 Google
© 2018 INEGI



6.62 ft

SB Coors Bus Shelter Removal

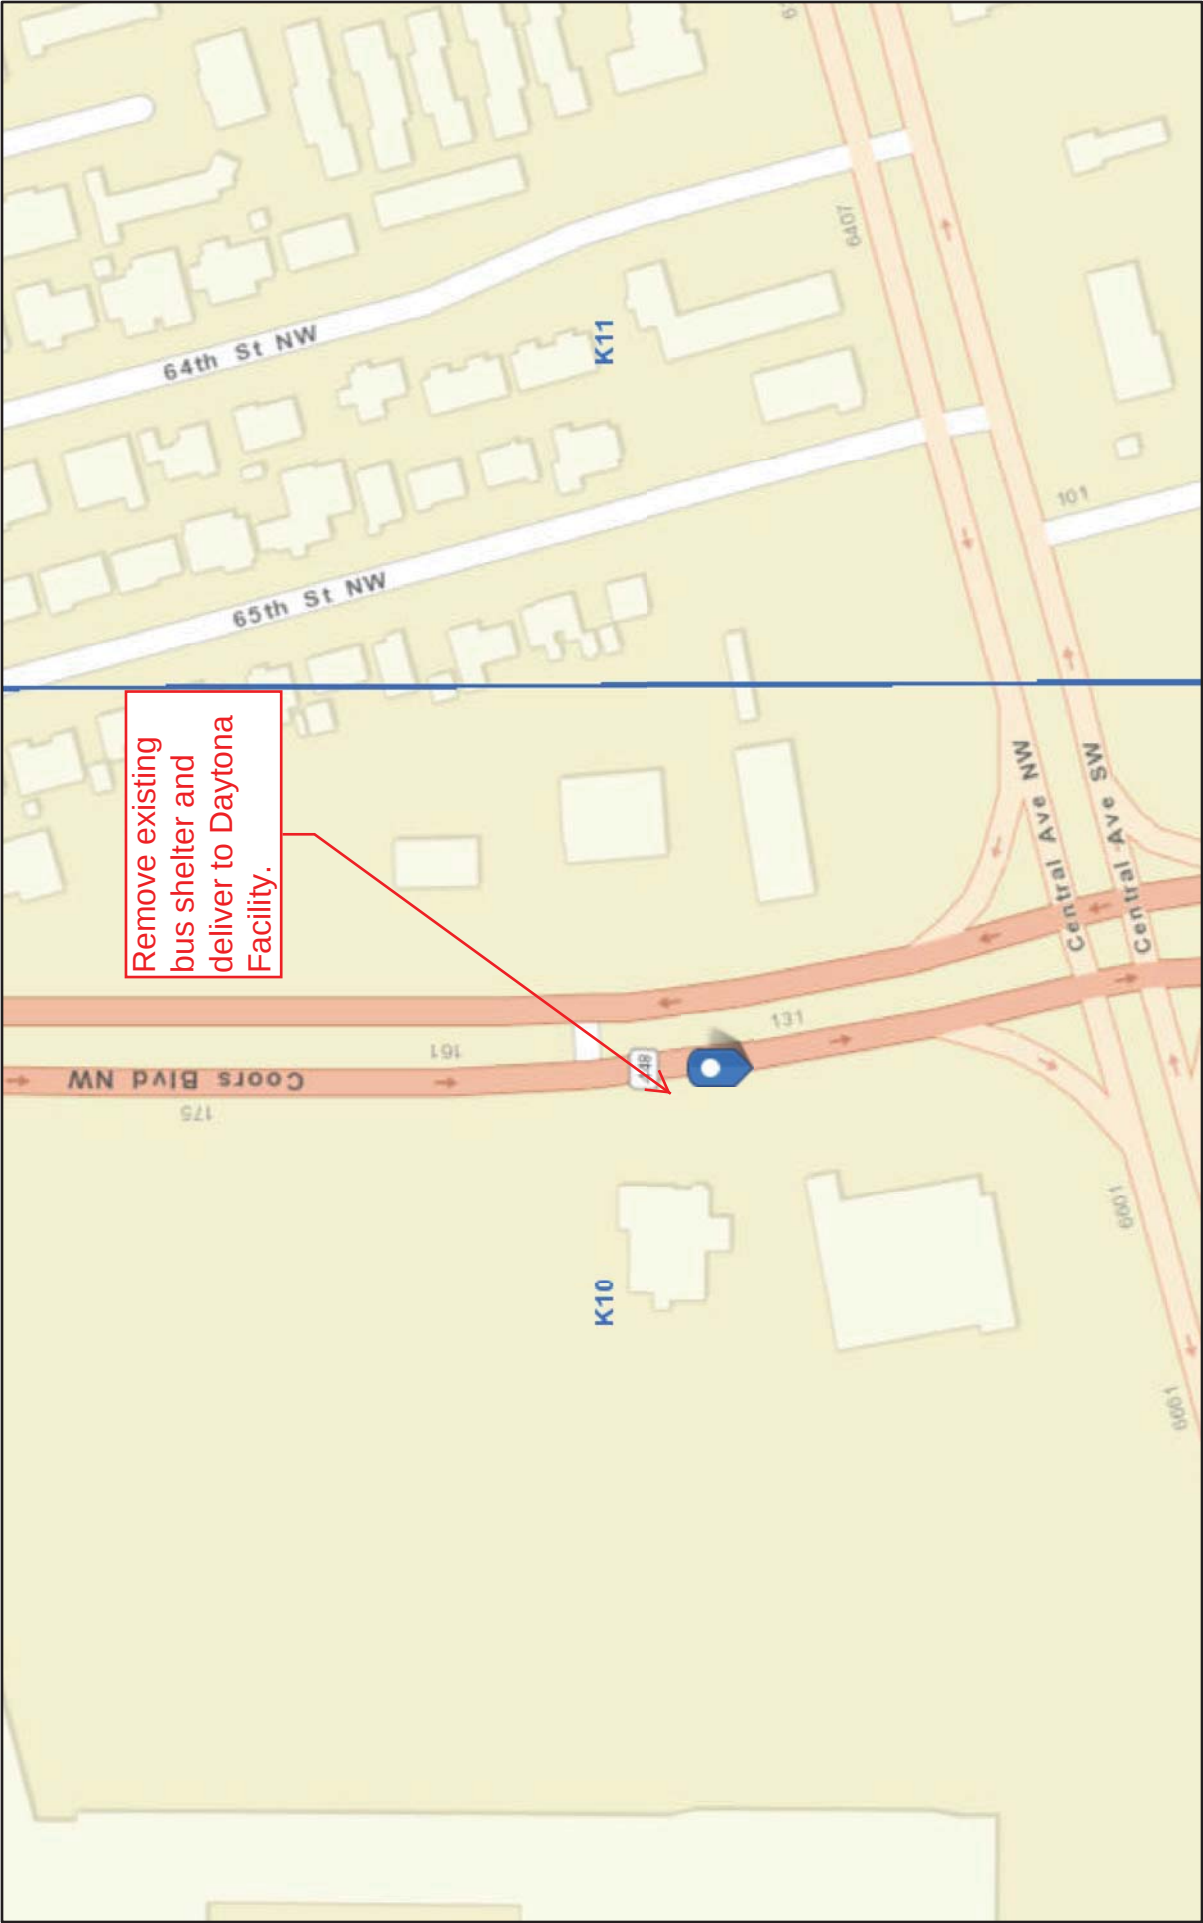

January 15, 2019

1:2,257

