


8th and Freeman DI Repair

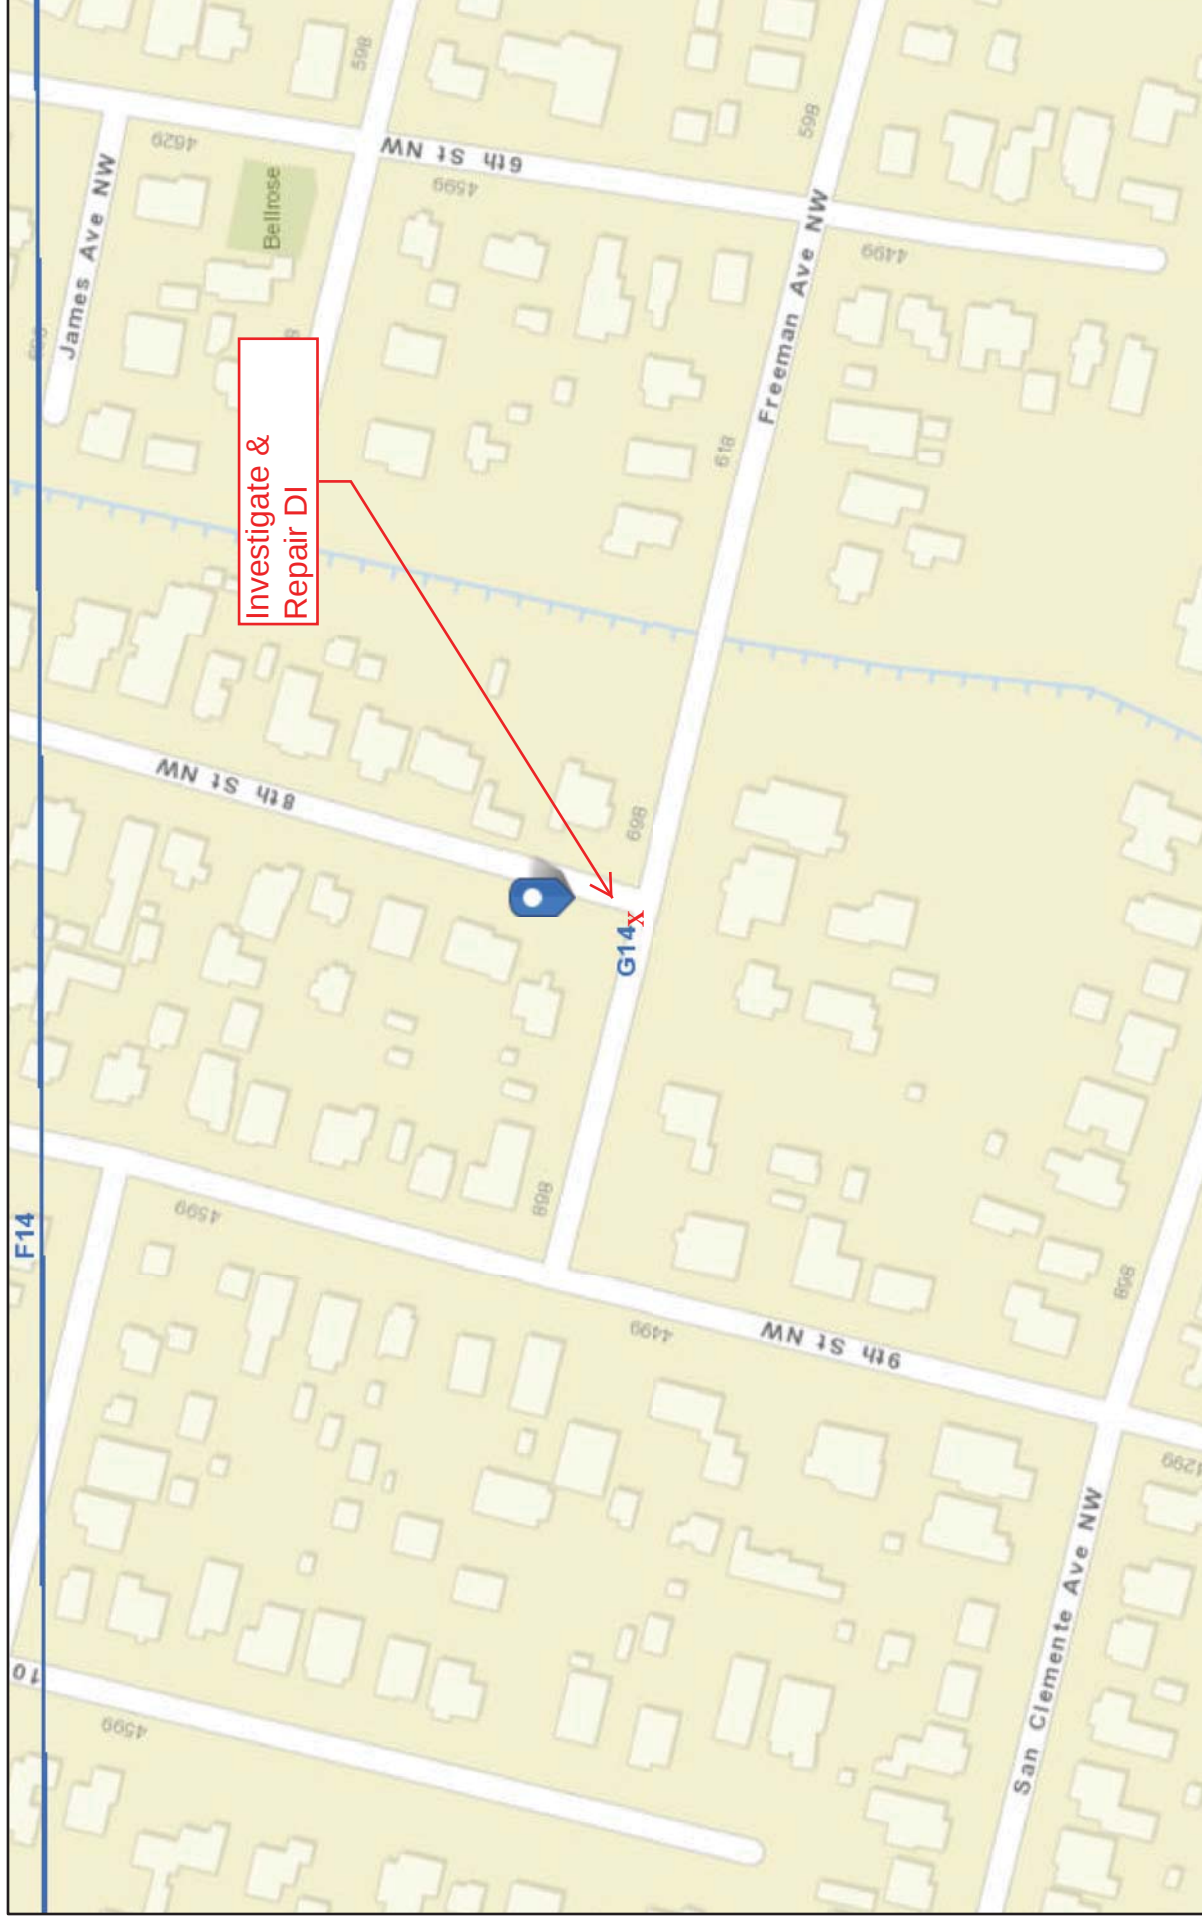

January 31, 2019

1:2,257

0 0.01 0.03 0.05 0.06 mi
0 0.03 0.05 0.1 km

City of Albuquerque, Bureau of Land Management, Esri, HERE, Garmin,

8th and Freeman NW:
Inlet on NW corner does not drain; investigate and repair.

