


SB Louisiana @ Lomas Bus Shelter Removal



February 1, 2019

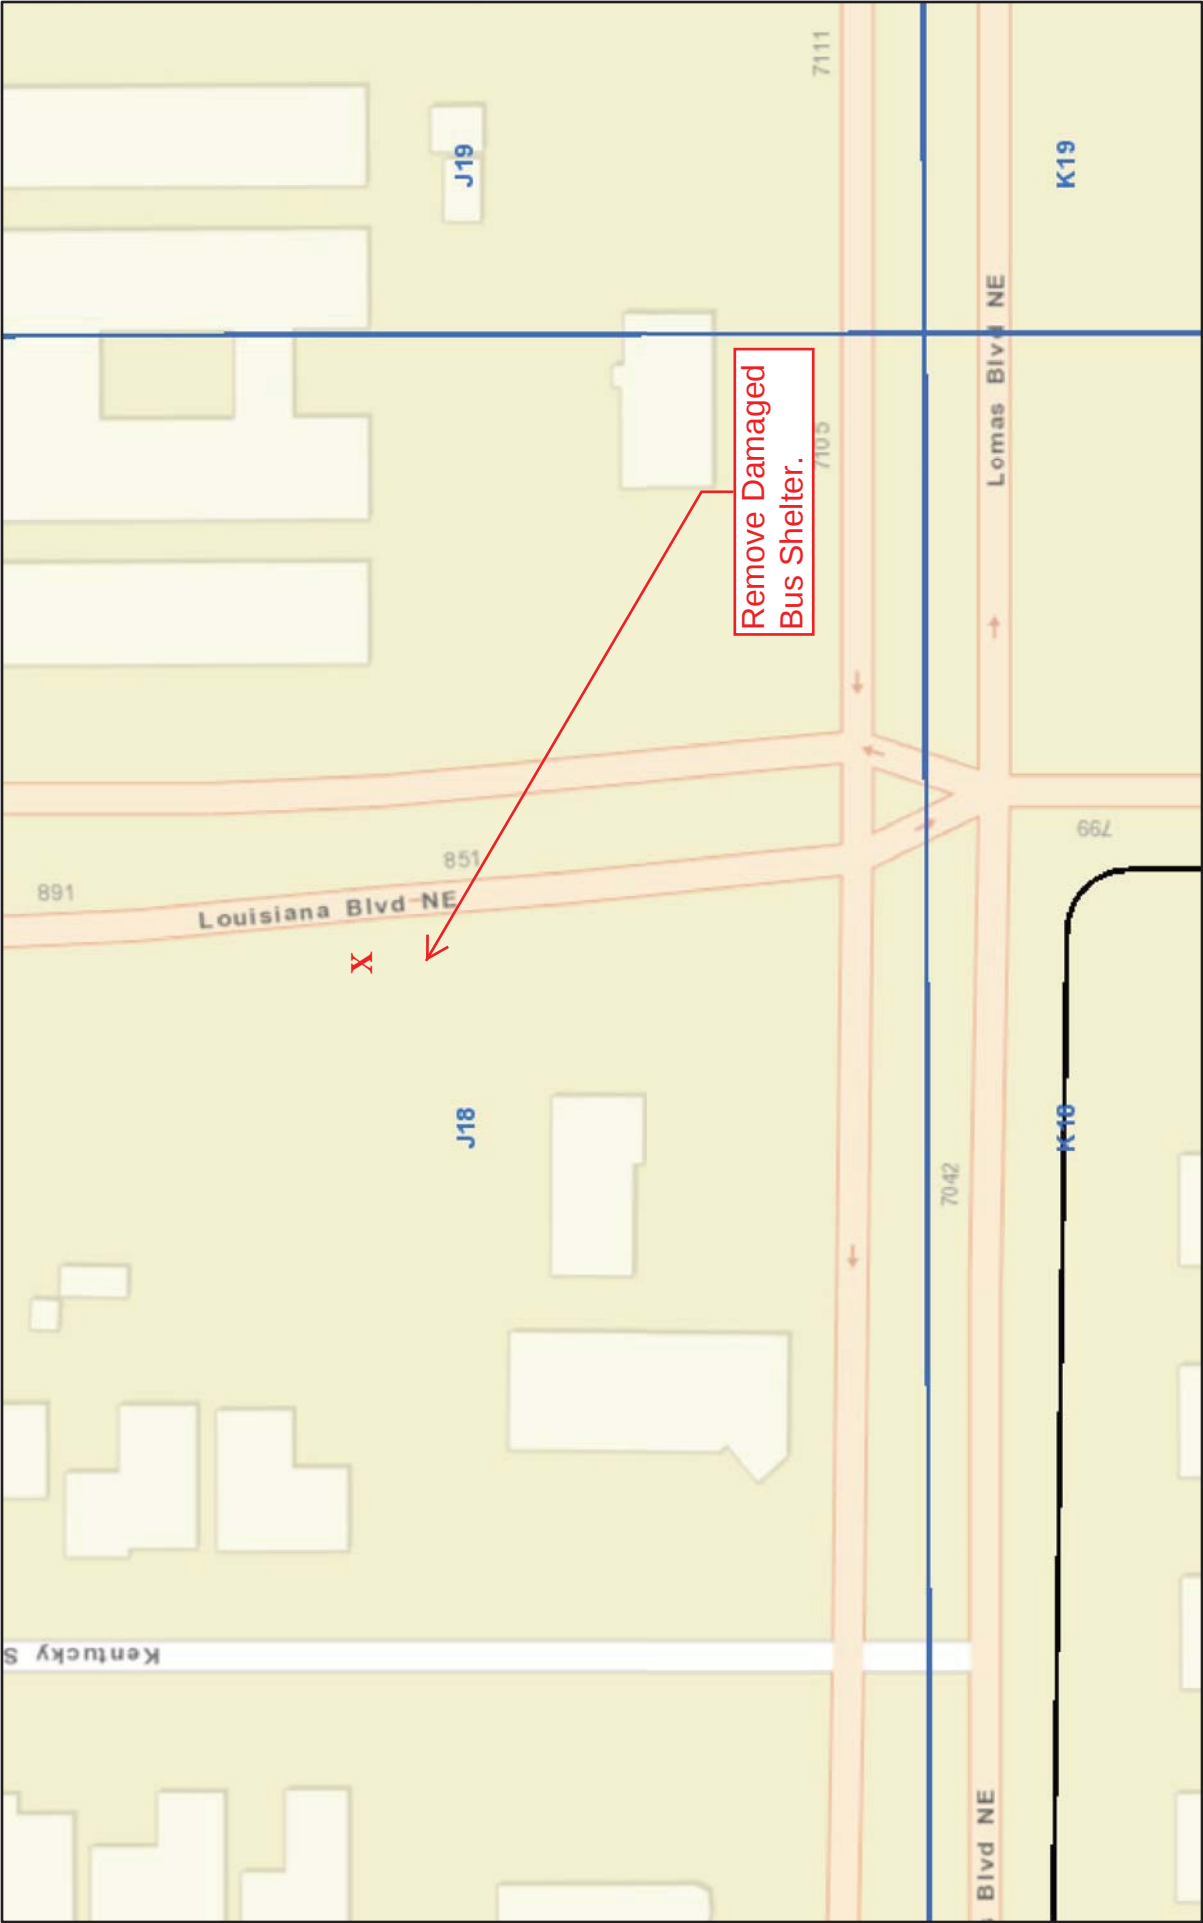

ABC
RIDE

RIVE
SALES
52-9392