


CARLISLE - HANNETT PEDESTRIAN CROSSING

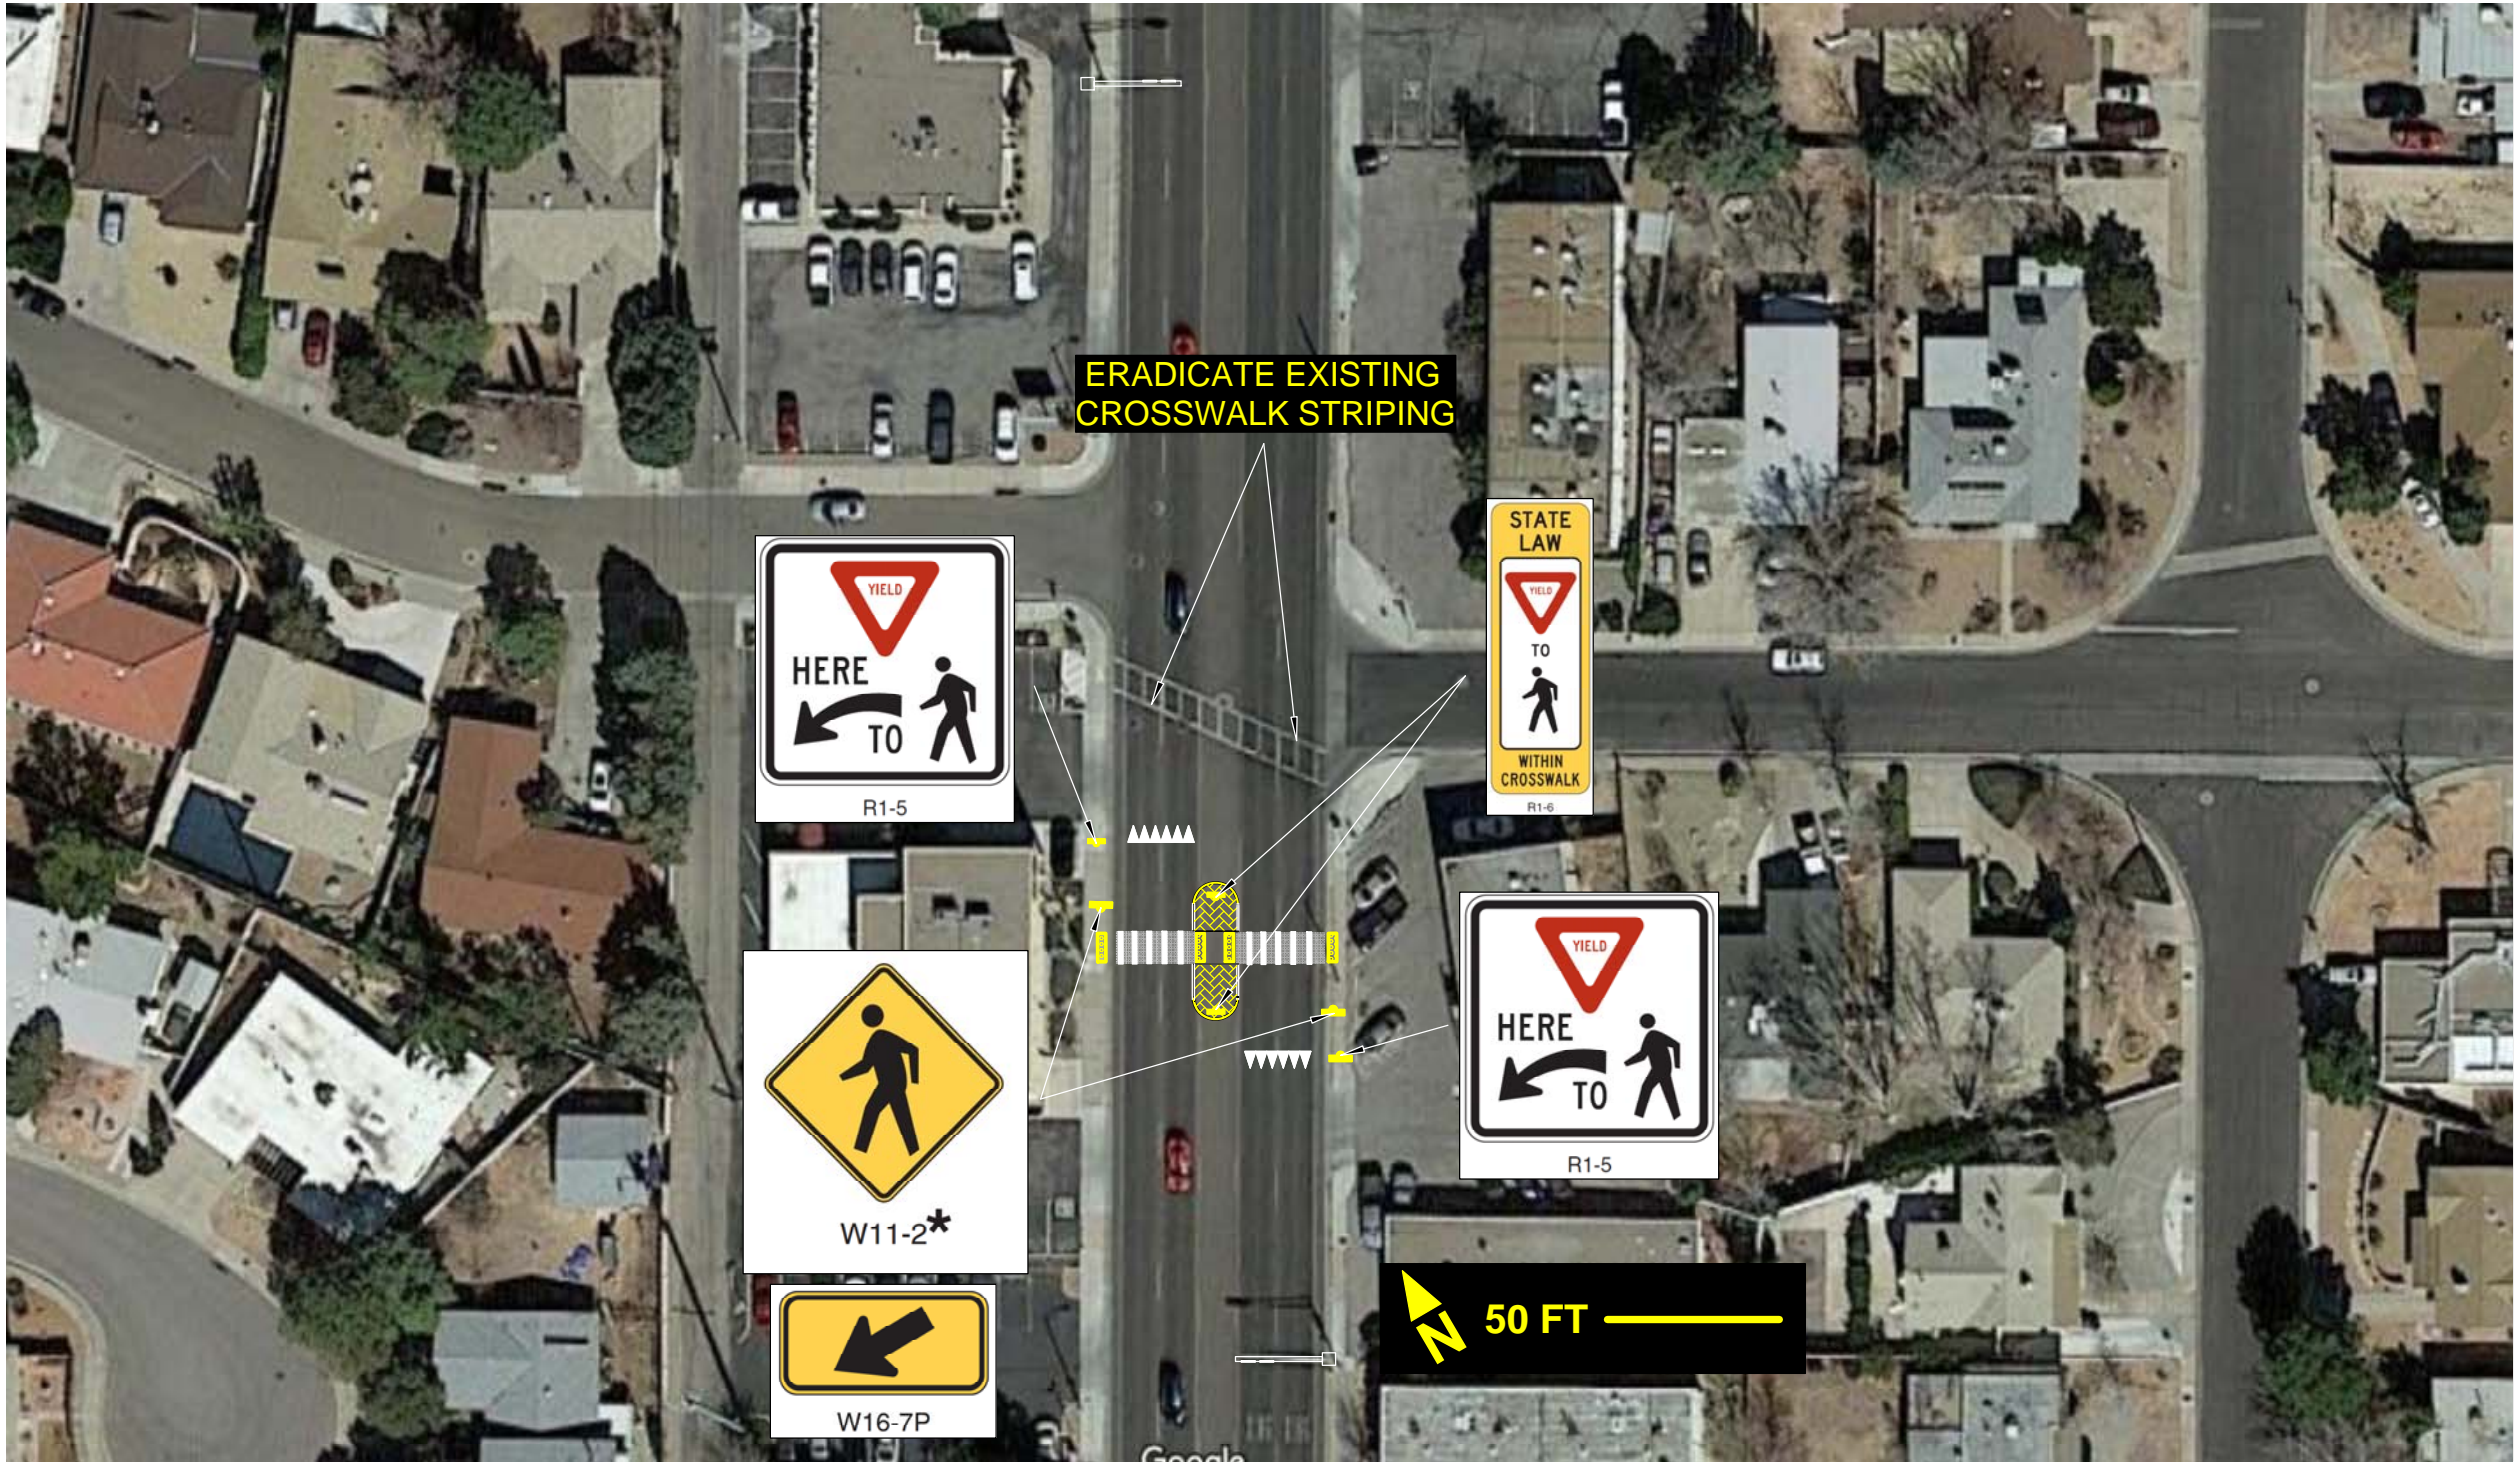

NOTES

- Yield Here to Pedestrians (R1-5) placed alongside "shark's teeth" yield bar approximately 25' from crosswalk.
- Crossing moved south of intersection to provide direct (perpendicular to roadway) pedestrian crossing path.
- CPN 647111

PROPOSED SIGNAGE



Work Location