

- ① REMOVE AND REPLACE EXISTING DRIVE PAD (6.0' x 6.0')
- ② REMOVE AND SALVAGE EXISTING BOLLARD TO "MILLER BONDED" - BACKFILL AS REQUIRED.
- ③ REMOVE, PROTECT & RE-INSTALL EXISTING "NO PARKING SIGN"

④ QUEST MANHOLE CONTRACTOR TO CONTACT QUEST IF ADJUSTMENT REQUIRED TO MEET NEW SIDEWALK STANDARD.

⑤ REMOVE & REPLACE EXISTING CURB & GUTTER (32.0' LF)

⑥ REMOVE EXISTING CONC/ASPHALT - (32.0' x 4.5')

PREP GRADE WITH EXISTING MATERIALS

PLACE NEW 40.0' x 6.0' SIDEWALK

⑦ PLACE NEW 20.0' x 5.0' SIDEWALK


⑧ GRADE SLOPE TO MATCH PROPERTY LINE TO NEW SIDEWALK

⑨ PLACE LANDSCAPE FABRIC & LANDSCAPE STONE (3")

⑩ PLACE NEW 75.0' x 5.0' SIDEWALK

⑪ REMOVE & REPLACE DAMAGED DRIVEPAD (20.0' x 6.0')

CONTRACTOR ~~TO~~ ADVISE "CHAVEZ CONCRETE" 48 HRS PRIOR TO START WORK. PROTECT PATCH 7 DAYS MINIMUM

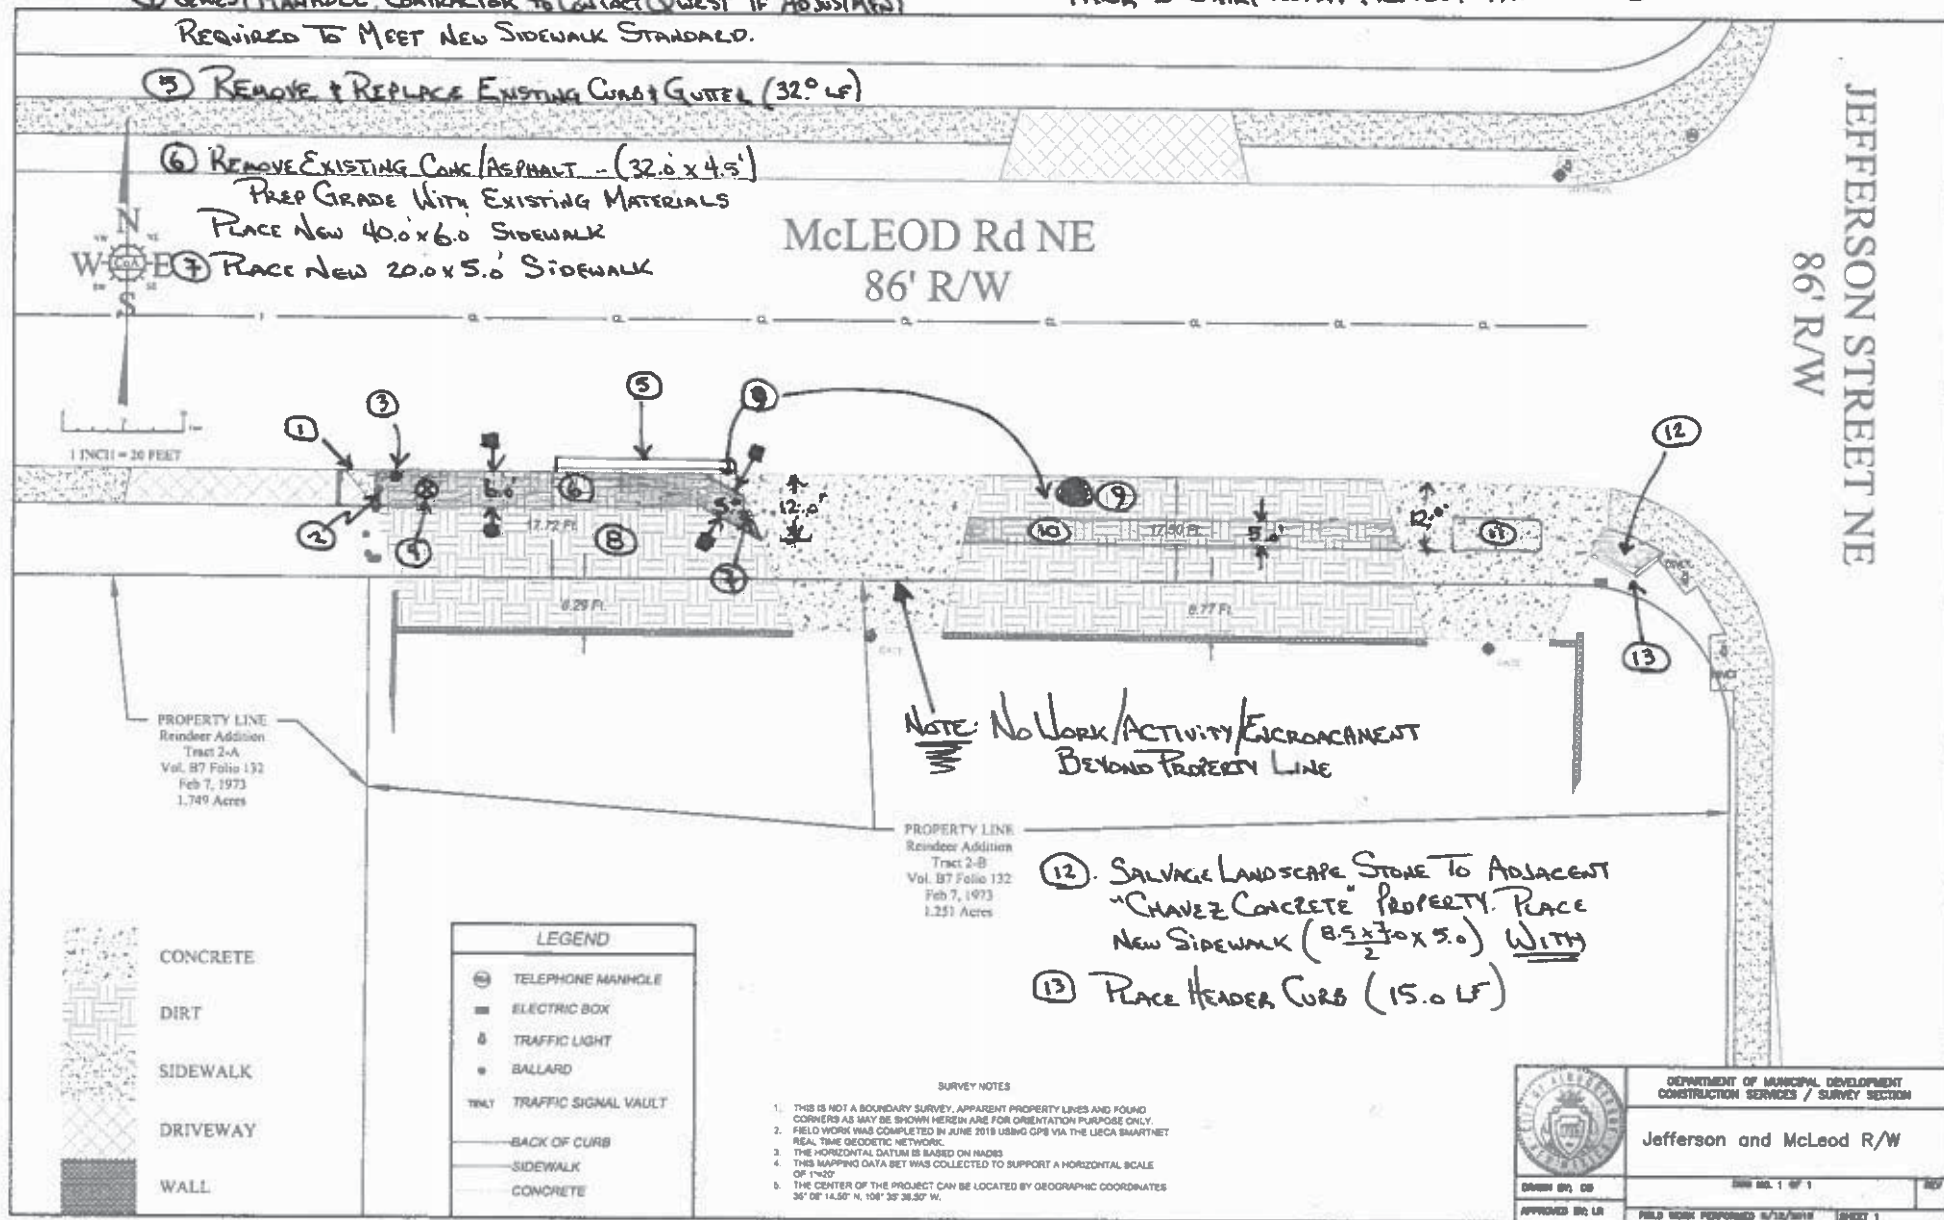

McLeod & Jefferson

New sidewalk

Legend

Job Location

Jefferson St NE & McLeod Rd NE

Hardware Dr NE

McLeod Rd NE

San Mateo Ln NE

Google Earth

© 2018 Google
© 2018 Europa Technologies
© SPOT IMAGE

1000 ft



McLeod & Jefferson

New sidewalk

Legend



Google Earth

© 2018 Google

© SPOT IMAGE

© 2018 INEGI

8.78 ft

McLeod & Jefferson

New sidewalk

Legend



Google Earth

© 2018 Google
© SPOT IMAGE
© 2018 INEGI

8.30 ft