


CARLISLE - HANNETT PEDESTRIAN CROSSING CONSTRUCTION MODIFICATIONS

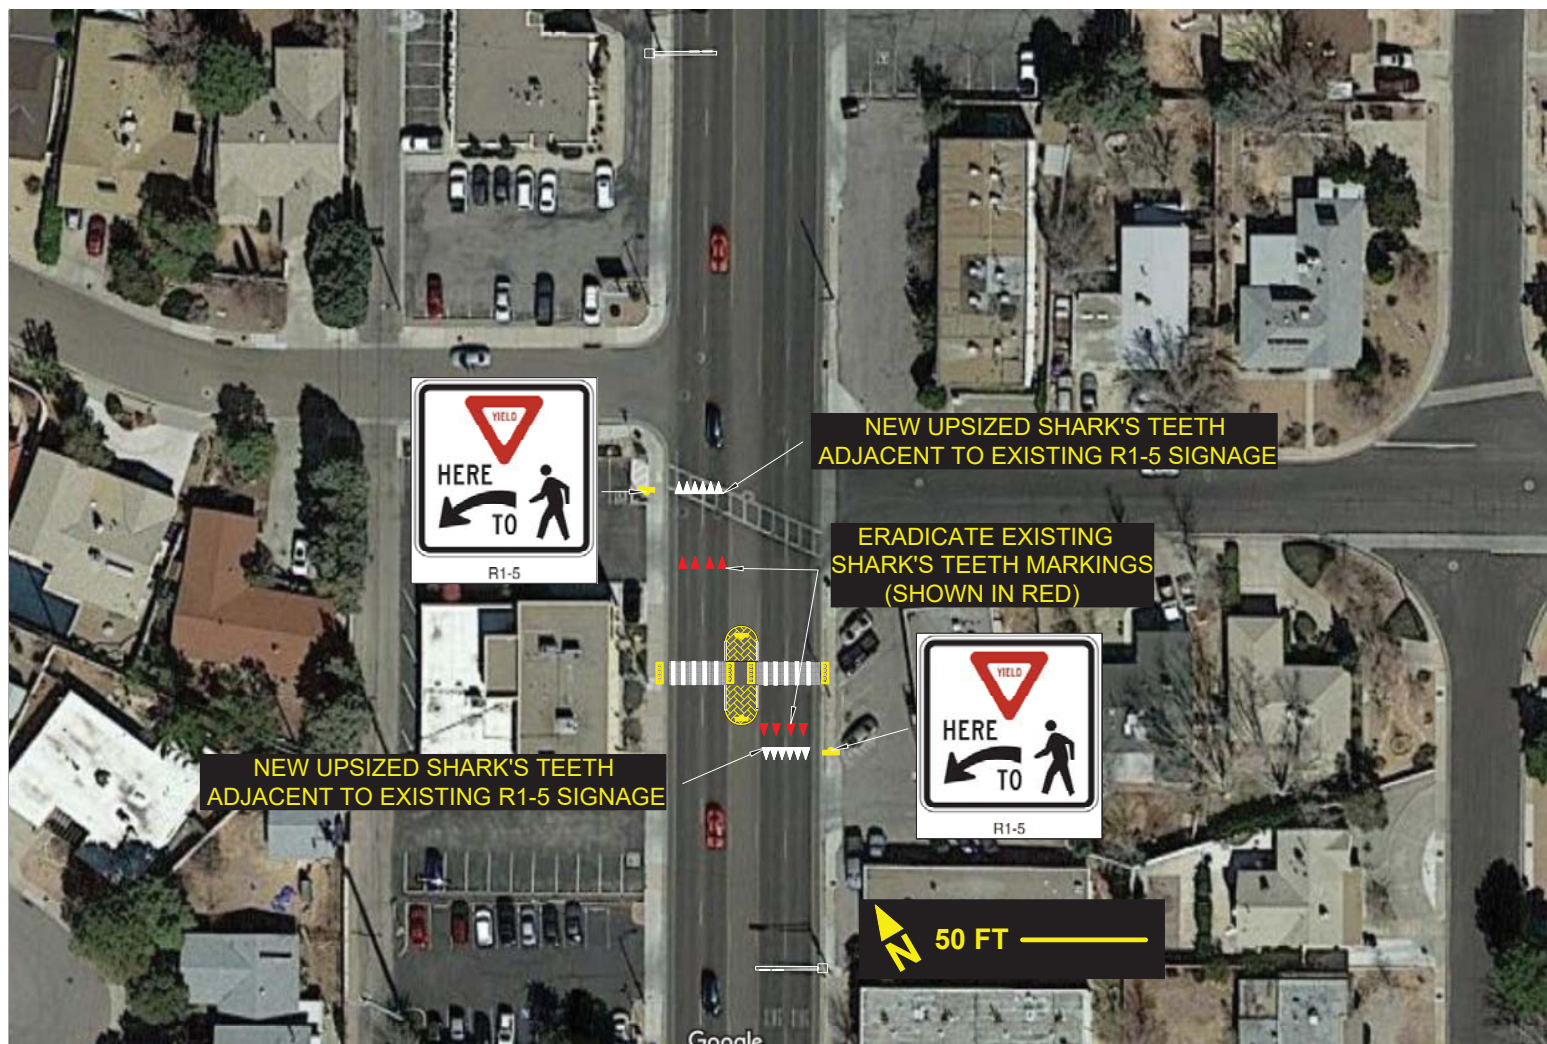

NOTES

- Current "Shark's Teeth" markings to be eradicated and replaced with 24" x 36" shark's teeth that are adjacent to existing R1-5 signage. Preformed thermoplastic must be utilized.
- Confirm proposed layouts and locations with City PM before placement.
- CPN 647111