




Work Location







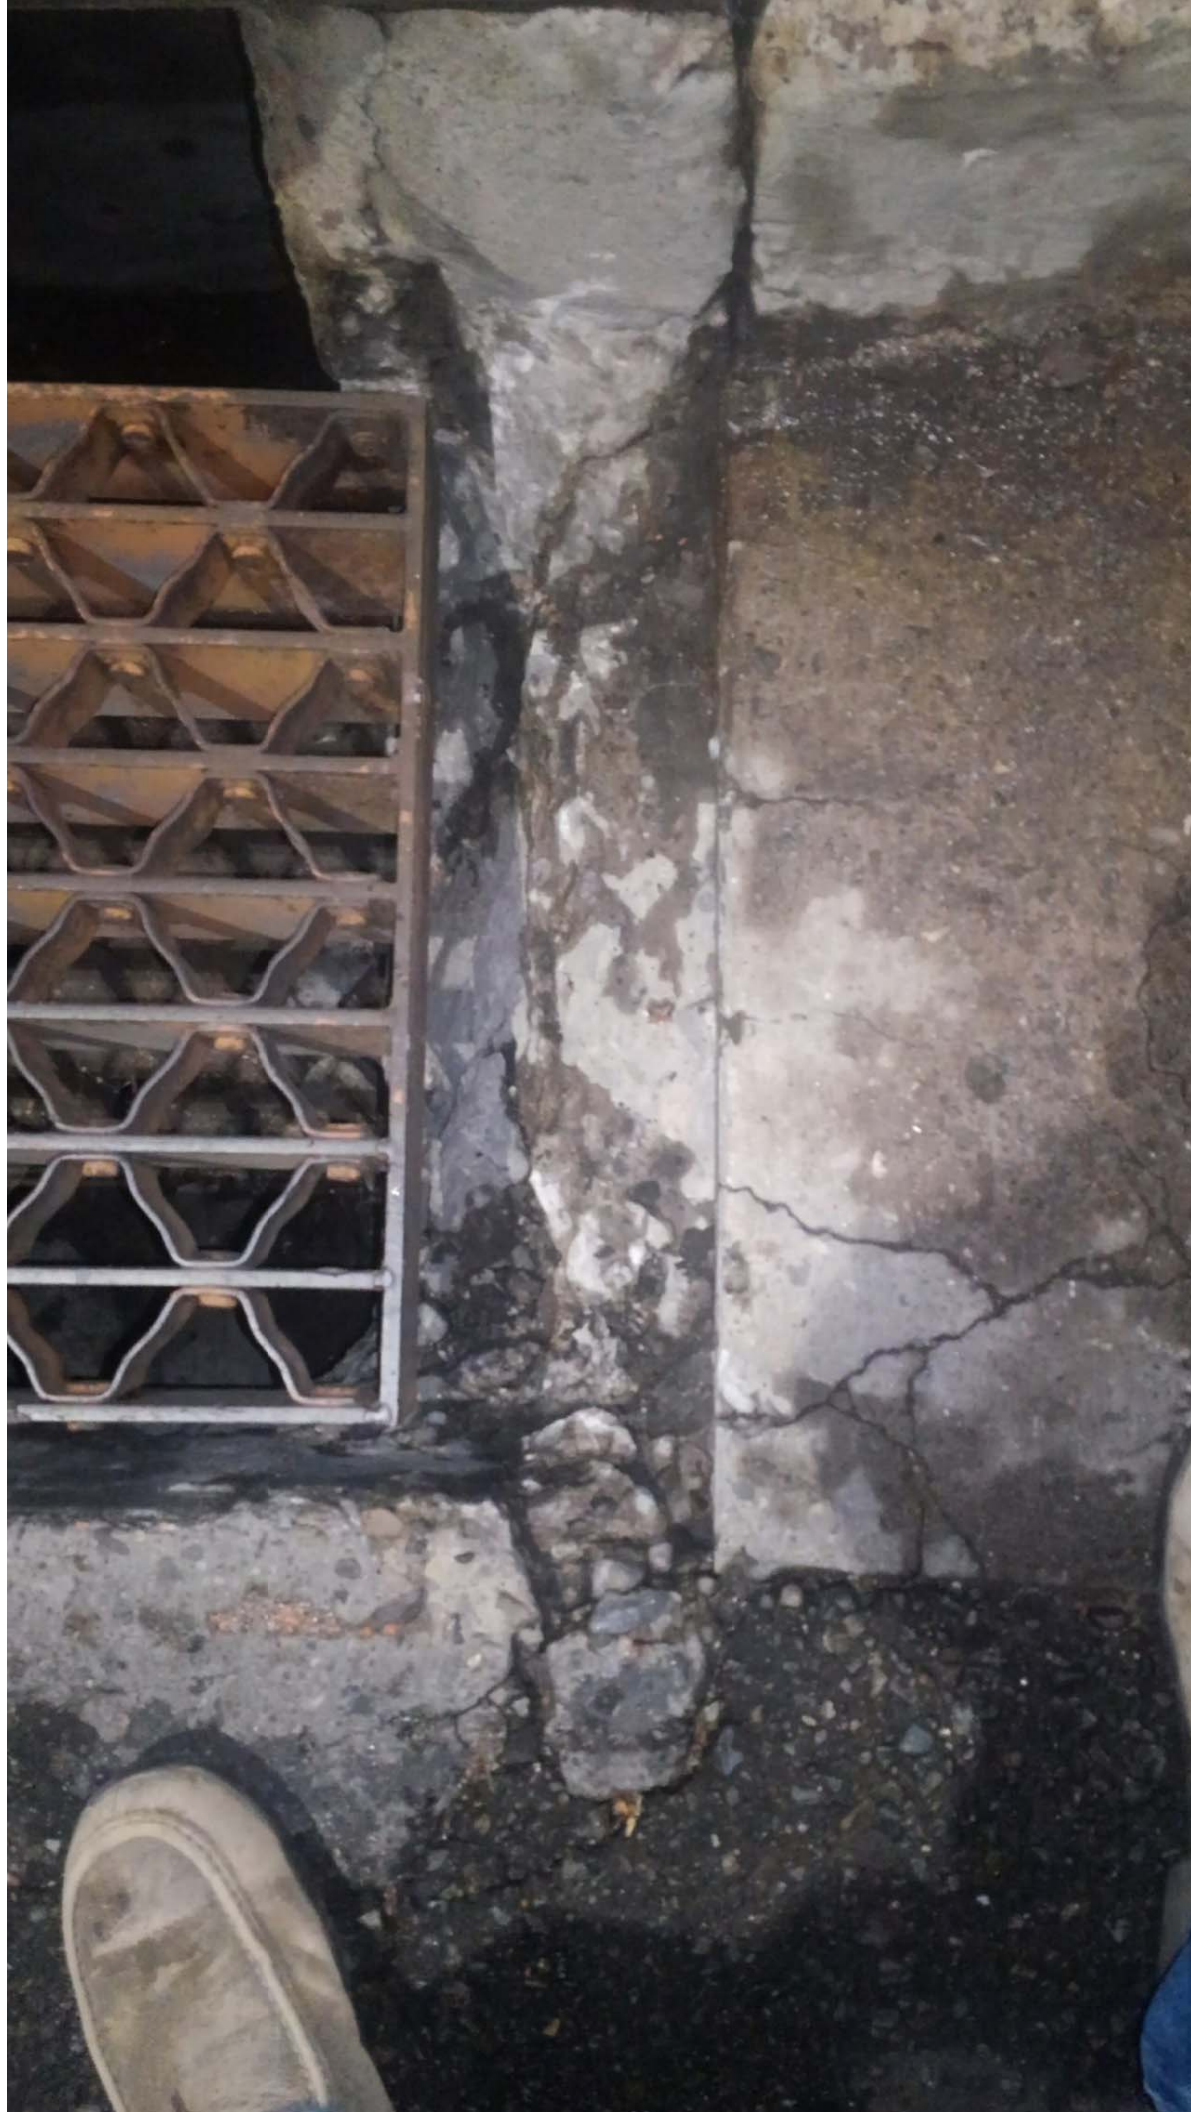





15015

15015





Work was constructed in compliance with details provided on previous pages and City of Albuquerque Standard Specifications and Drawings.

FOR INFORMATION ONLY