

Work Location

86th St SW & Sapphire St SW




SCALE 1"=50'


DEMOLITION NOTES:


1. ERADICATE WHITE STRIPE BY WATER-BLAST METHOD ONLY
2. ERADICATE YELLOW STRIPE BY WATER-BLAST METHOD ONLY

SHEET NOTES:

- A. SEE SHEET 4 FOR EXISTING SECTION A-A

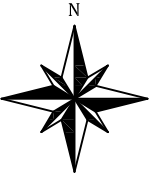

CITY OF ALBUQUERQUE DEPARTMENT OF MUNICIPAL DEVELOPMENT ENGINEERING DIVISION				
TITLE: 86TH STREET CHICANE IMPROVEMENTS				
NOT FOR CONSTRUCTION	DESIGNED BY: DUSTIN DAVIDSON		LAST DESIGN UPDATE	Mo./Day/Yr.
	REVIEWED BY:			09/26/2019
	UPDATED BY: BRIDGETTE GARRETT			10/28/2019
				10/29/2019
				11/05/2019
City Project No. 424292		Zone Map No. M9	Sheet 1	Of 5

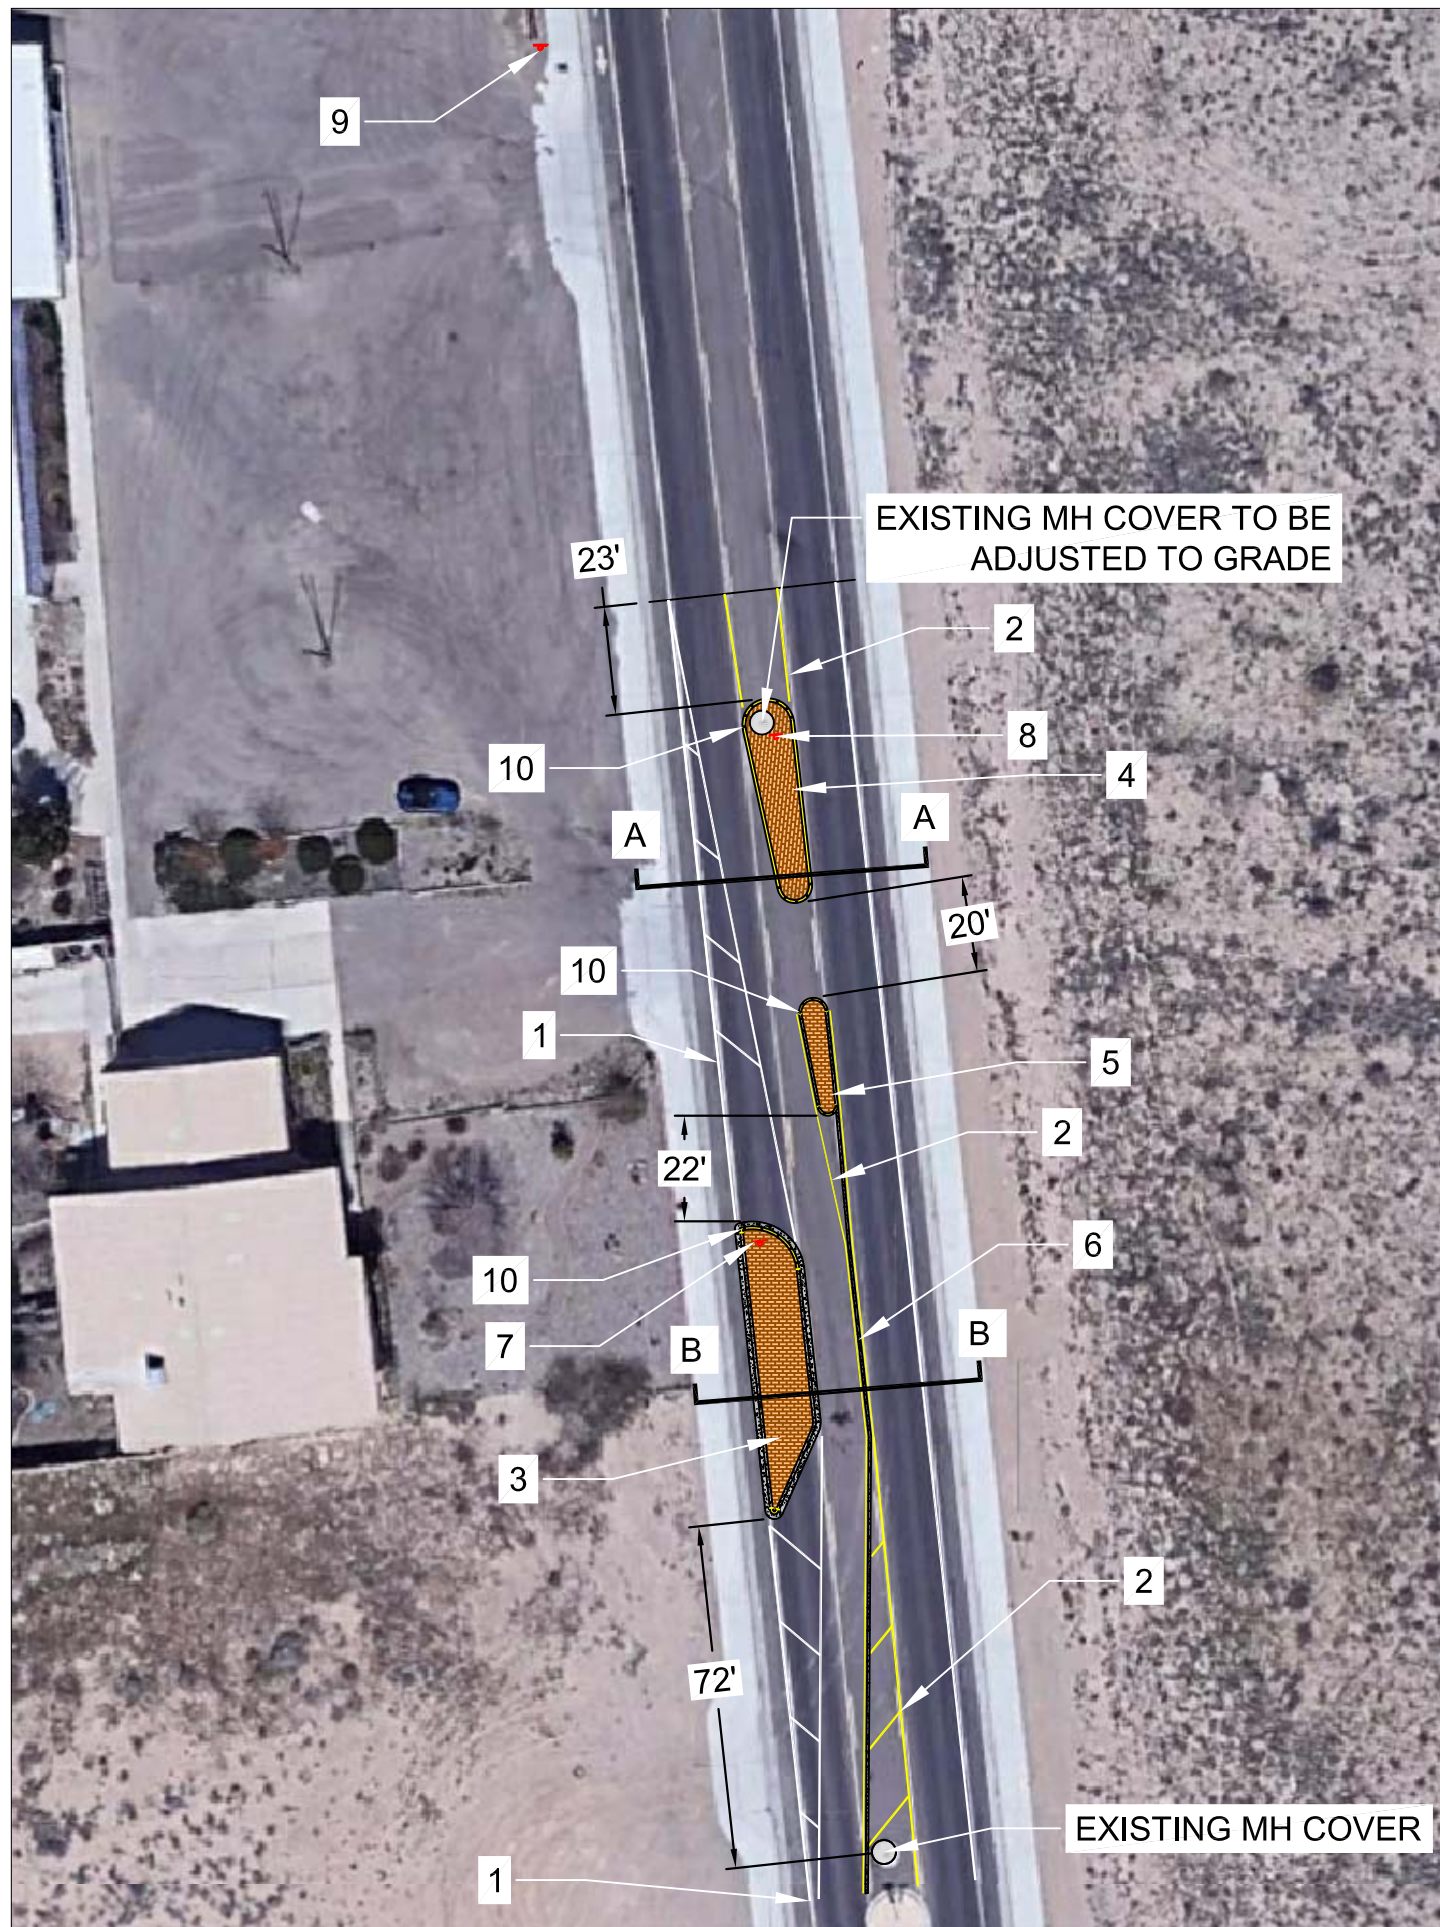

SCALE 1"=40'

KEYED IMPROVEMENT NOTES:


1. INSTALL 6" REFLECTORIZED PLASTIC SOLID WHITE STRIPE (TYP.)
2. INSTALL 4" REFLECTORIZED PLASTIC SOLID YELLOW STRIPE (TYP.)
3. INSTALL CHICANE PER DETAIL ON SHEET 3
4. INSTALL MEDIAN PER MEDIAN PINNED CURB DETAIL 1 ON SHEET 3
5. INSTALL MEDIAN PER MEDIAN PINNED CURB DETAIL 2 ON SHEET 3
6. INSTALL 170 LF - CONCRETE PINNED CURB PER DETAIL ON SHEET 3
7. INSTALL MUTCD OM3-R
8. INSTALL MUTCD R4-7
9. INSTALL MUTCD W5-1
10. INSTALL 1-WAY RAISED PAVEMENT MARKERS, PER DETAILS ON SHEETS 3 & 5

SHEET NOTES:


- A. SEE SHEET 4 FOR SECTIONS A-A AND B-B
- B. SEE SHEET 5 FOR SIGN DETAILS
- C. HATCH SPACING IS 20'




SCALE 1"=100'

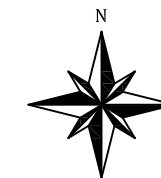

CITY OF ALBUQUERQUE DEPARTMENT OF MUNICIPAL DEVELOPMENT ENGINEERING DIVISION		Mo./Day/Yr. 09/26/2019 10/28/2019 10/29/2019 11/05/2019	
TITLE: 86TH STREET CHICANE IMPROVEMENTS		LAST DESIGN UPDATE	
NOT FOR CONSTRUCTION	DESIGNED BY: DUSTIN DAVIDSON		
	REVIEWED BY:		
	UPDATED BY: BRIDGETTE GARRETT		
City Project No. 424292	Zone Map No. M9	Sheet 2	Of 5

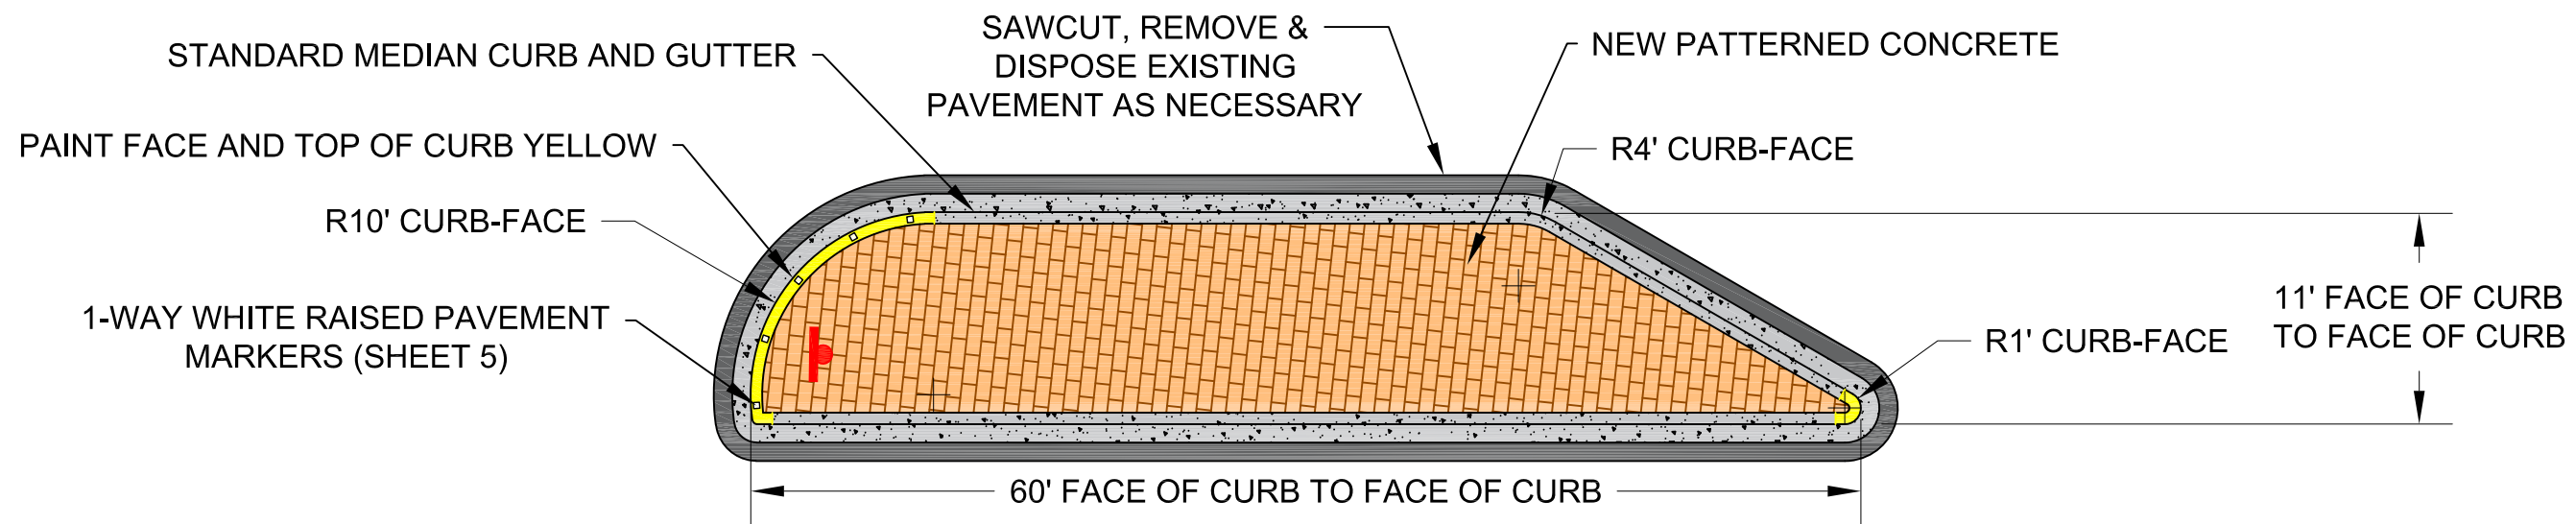


CHICANE DETAIL SCALE 1:10

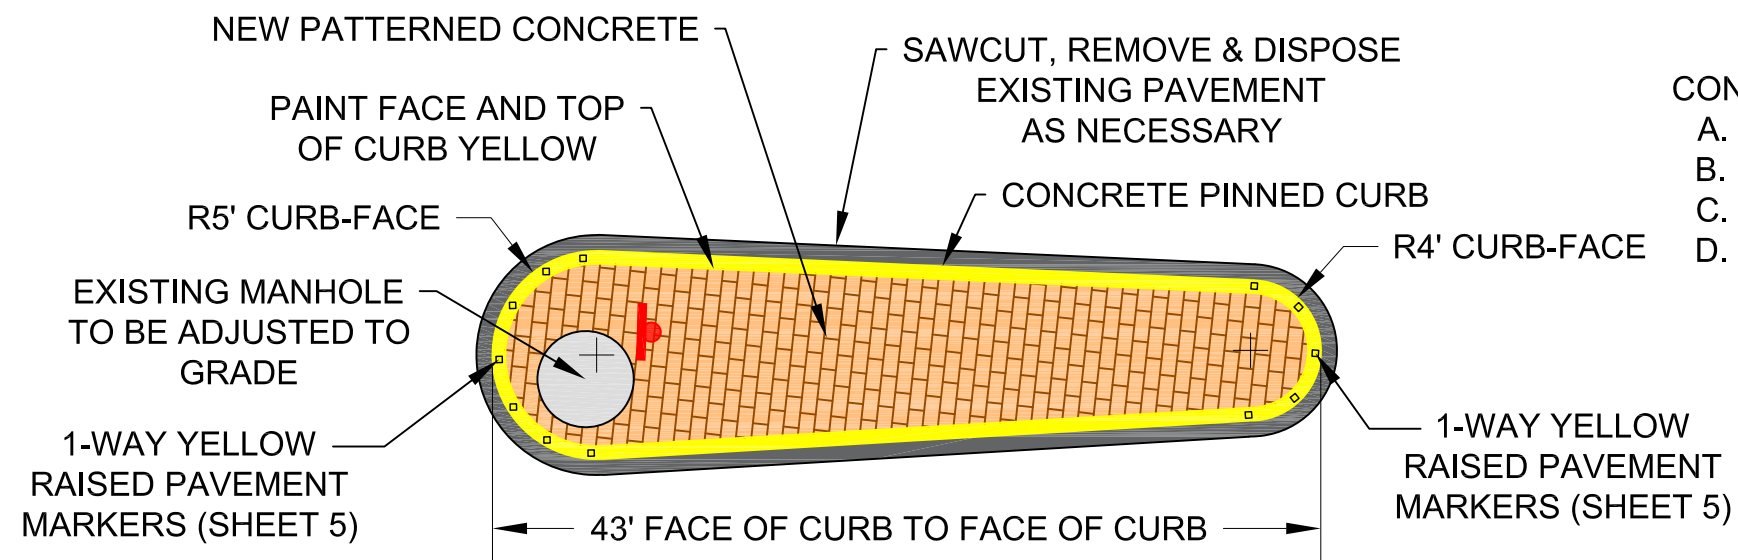


MEDIAN PINNED CURB DETAIL 1
SCALE 1:10

CONSTRUCTION NOTES:


- A. 3/4" RADIUS
- B. 2" RADIUS
- C. EXISTING PAVEMENT
- D. BUILD PER COA SD 2415C



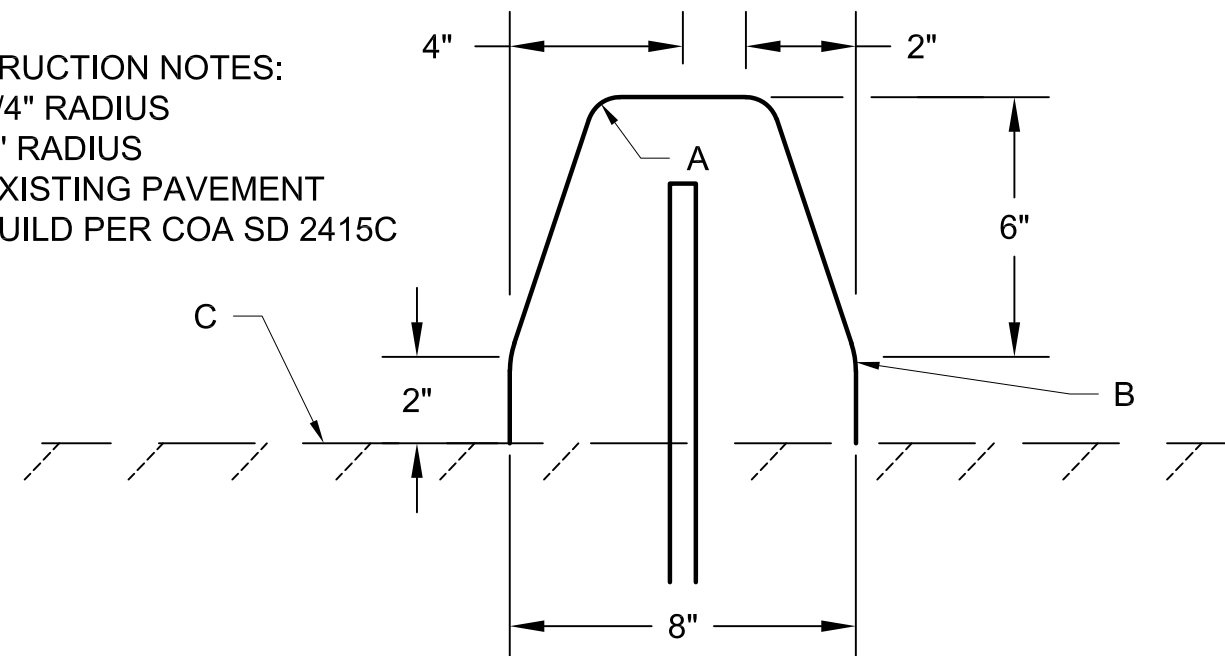



CONCRETE PINNED CURB DETAIL NTS

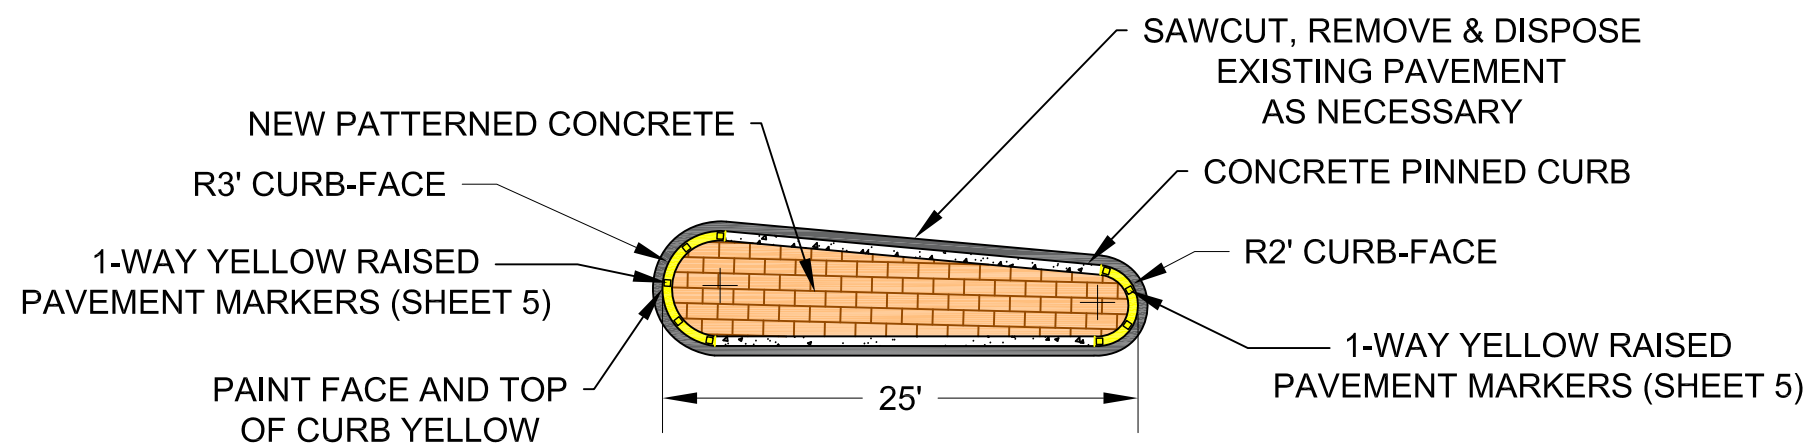

MEDIAN PINNED CURB DETAIL 2
SCALE 1:10

CITY OF ALBUQUERQUE DEPARTMENT OF MUNICIPAL DEVELOPMENT ENGINEERING DIVISION					
TITLE: 86TH STREET CHICANE IMPROVEMENTS					
NOT FOR CONSTRUCTION	DESIGNED BY: DUSTIN DAVIDSON			LAST DESIGN UPDATE	Mo./Day/Yr.
	REVIEWED BY:				09/26/2019
	UPDATED BY: BRIDGETTE GARRETT				10/28/2019
					10/29/2019
					11/05/2019
City Project No. 424292		Zone Map No. M9		Sheet 3	Of 5

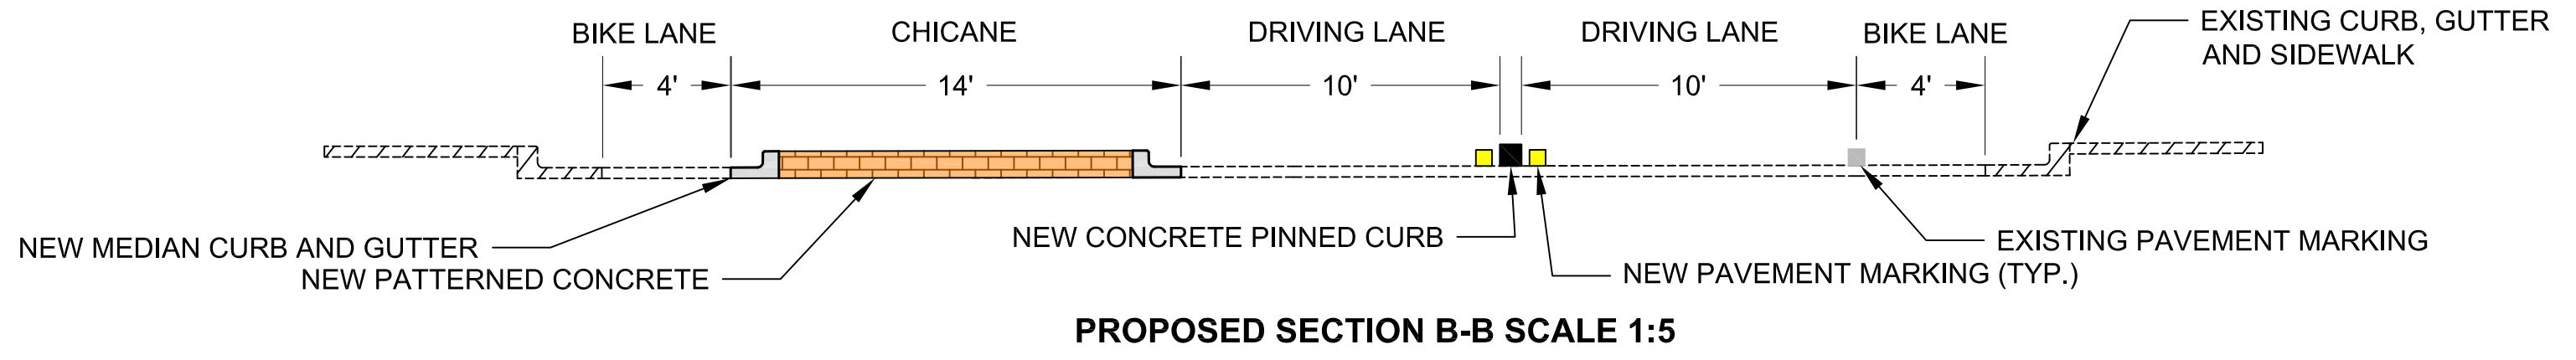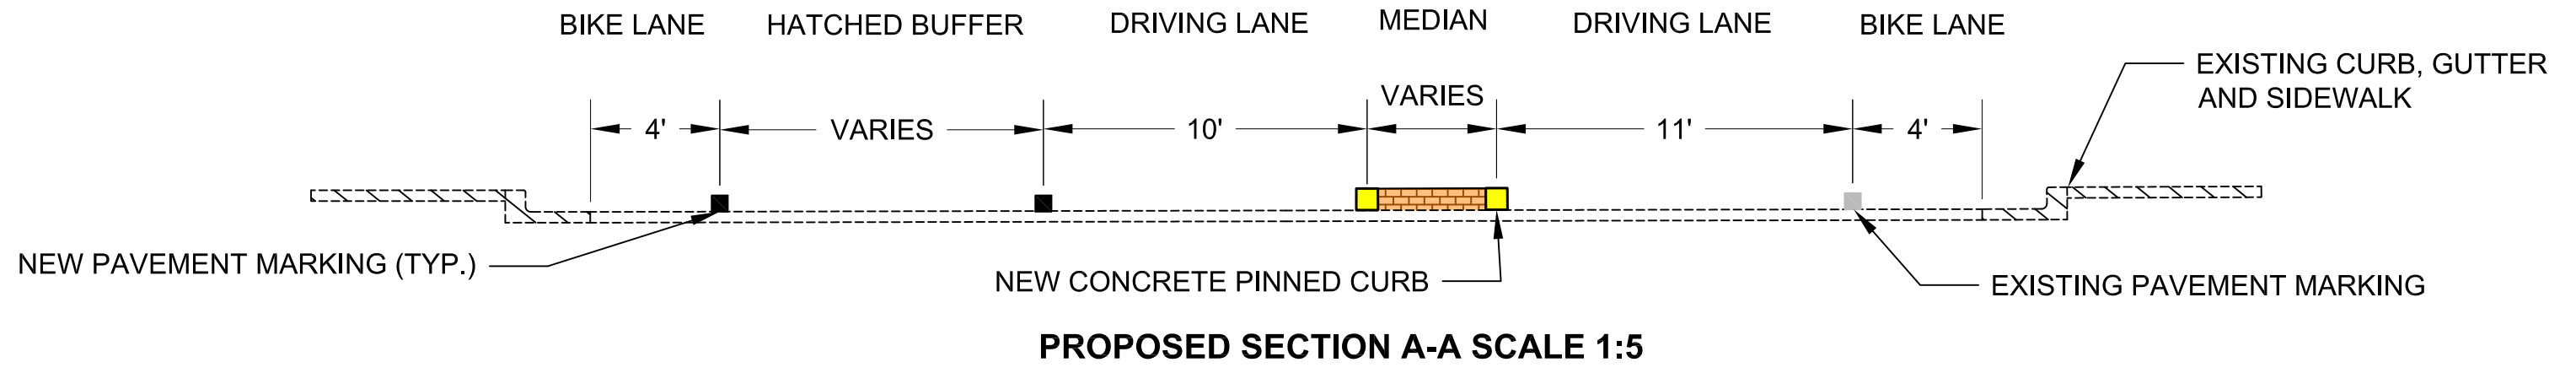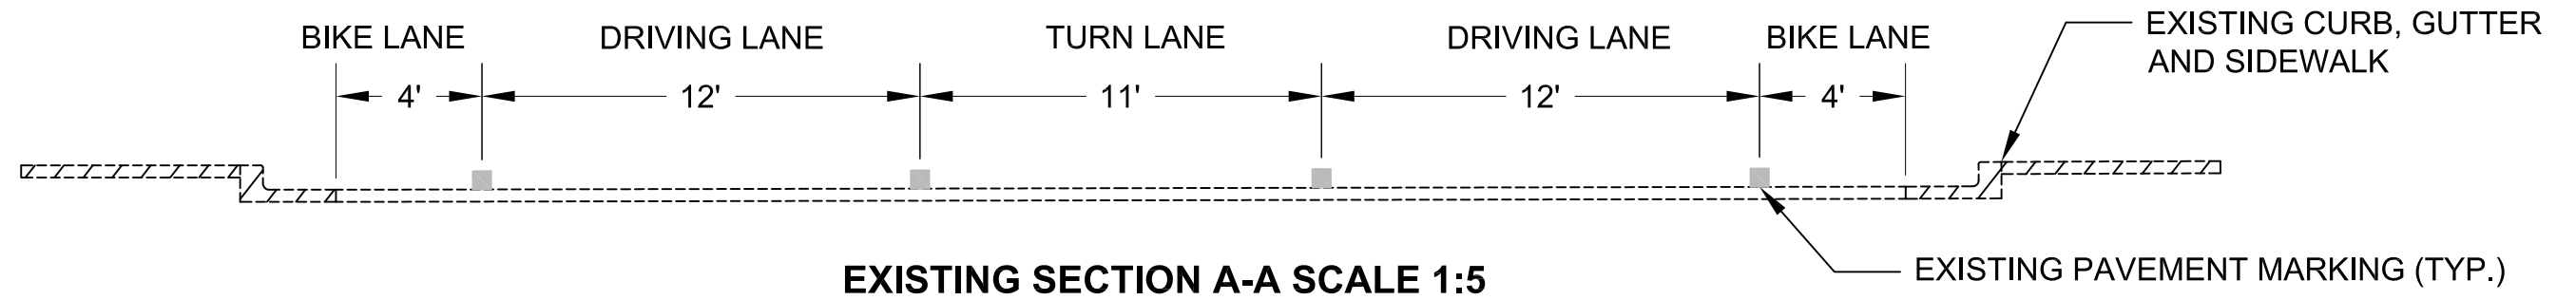


CITY OF ALBUQUERQUE DEPARTMENT OF MUNICIPAL DEVELOPMENT ENGINEERING DIVISION				
TITLE: 86TH STREET CHICANE IMPROVEMENTS				
NOT FOR CONSTRUCTION	DESIGNED BY: DUSTIN DAVIDSON		LAST DESIGN UPDATE	Mo./Day/Yr.
	REVIEWED BY:			09/26/2019
	UPDATED BY: BRIDGETTE GARRETT			10/28/2019
				10/29/2019
				11/05/2019
City Project No. 424292		Zone Map No. M9	Sheet 4	Of 5



W5-1
36X36



OM3-R
12"X36"

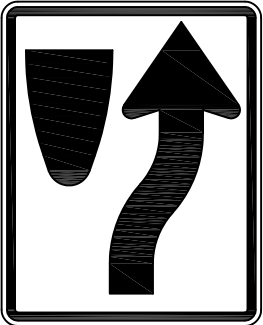


R4-7
24"X30"



1-WAY RAISED PAVEMENT MARKER
REFLECTIVE: YELLOW; 4"X 4"



1-WAY RAISED PAVEMENT MARKER
REFLECTIVE: WHITE; 4"X 4"

CITY OF ALBUQUERQUE DEPARTMENT OF MUNICIPAL DEVELOPMENT ENGINEERING DIVISION				
TITLE: 86TH STREET CHICANE IMPROVEMENTS				
<div>NOT FOR CONSTRUCTION</div>	DESIGNED BY: DUSTIN DAVIDSON		LAST DESIGN UPDATE	Mo./Day/Yr.
	REVIEWED BY:			09/26/2019
	UPDATED BY: BRIDGETTE GARRETT			10/28/2019
				10/29/2019
				11/05/2019
City Project No. 424292		Zone Map No. M9	Sheet 5	Of 5

Remove 3140 SF
existing landscaping
& irrigation.

Add 3140 SF pattern
concrete in median,
nose to nose


Add 175 Ft.
Guardrail with
end treatments

Remove &
Replace 30 Ft. of
damaged curb

86th St SW & Sapphire St SW

Bosque Pointe Ave SW

Scottdale St SW

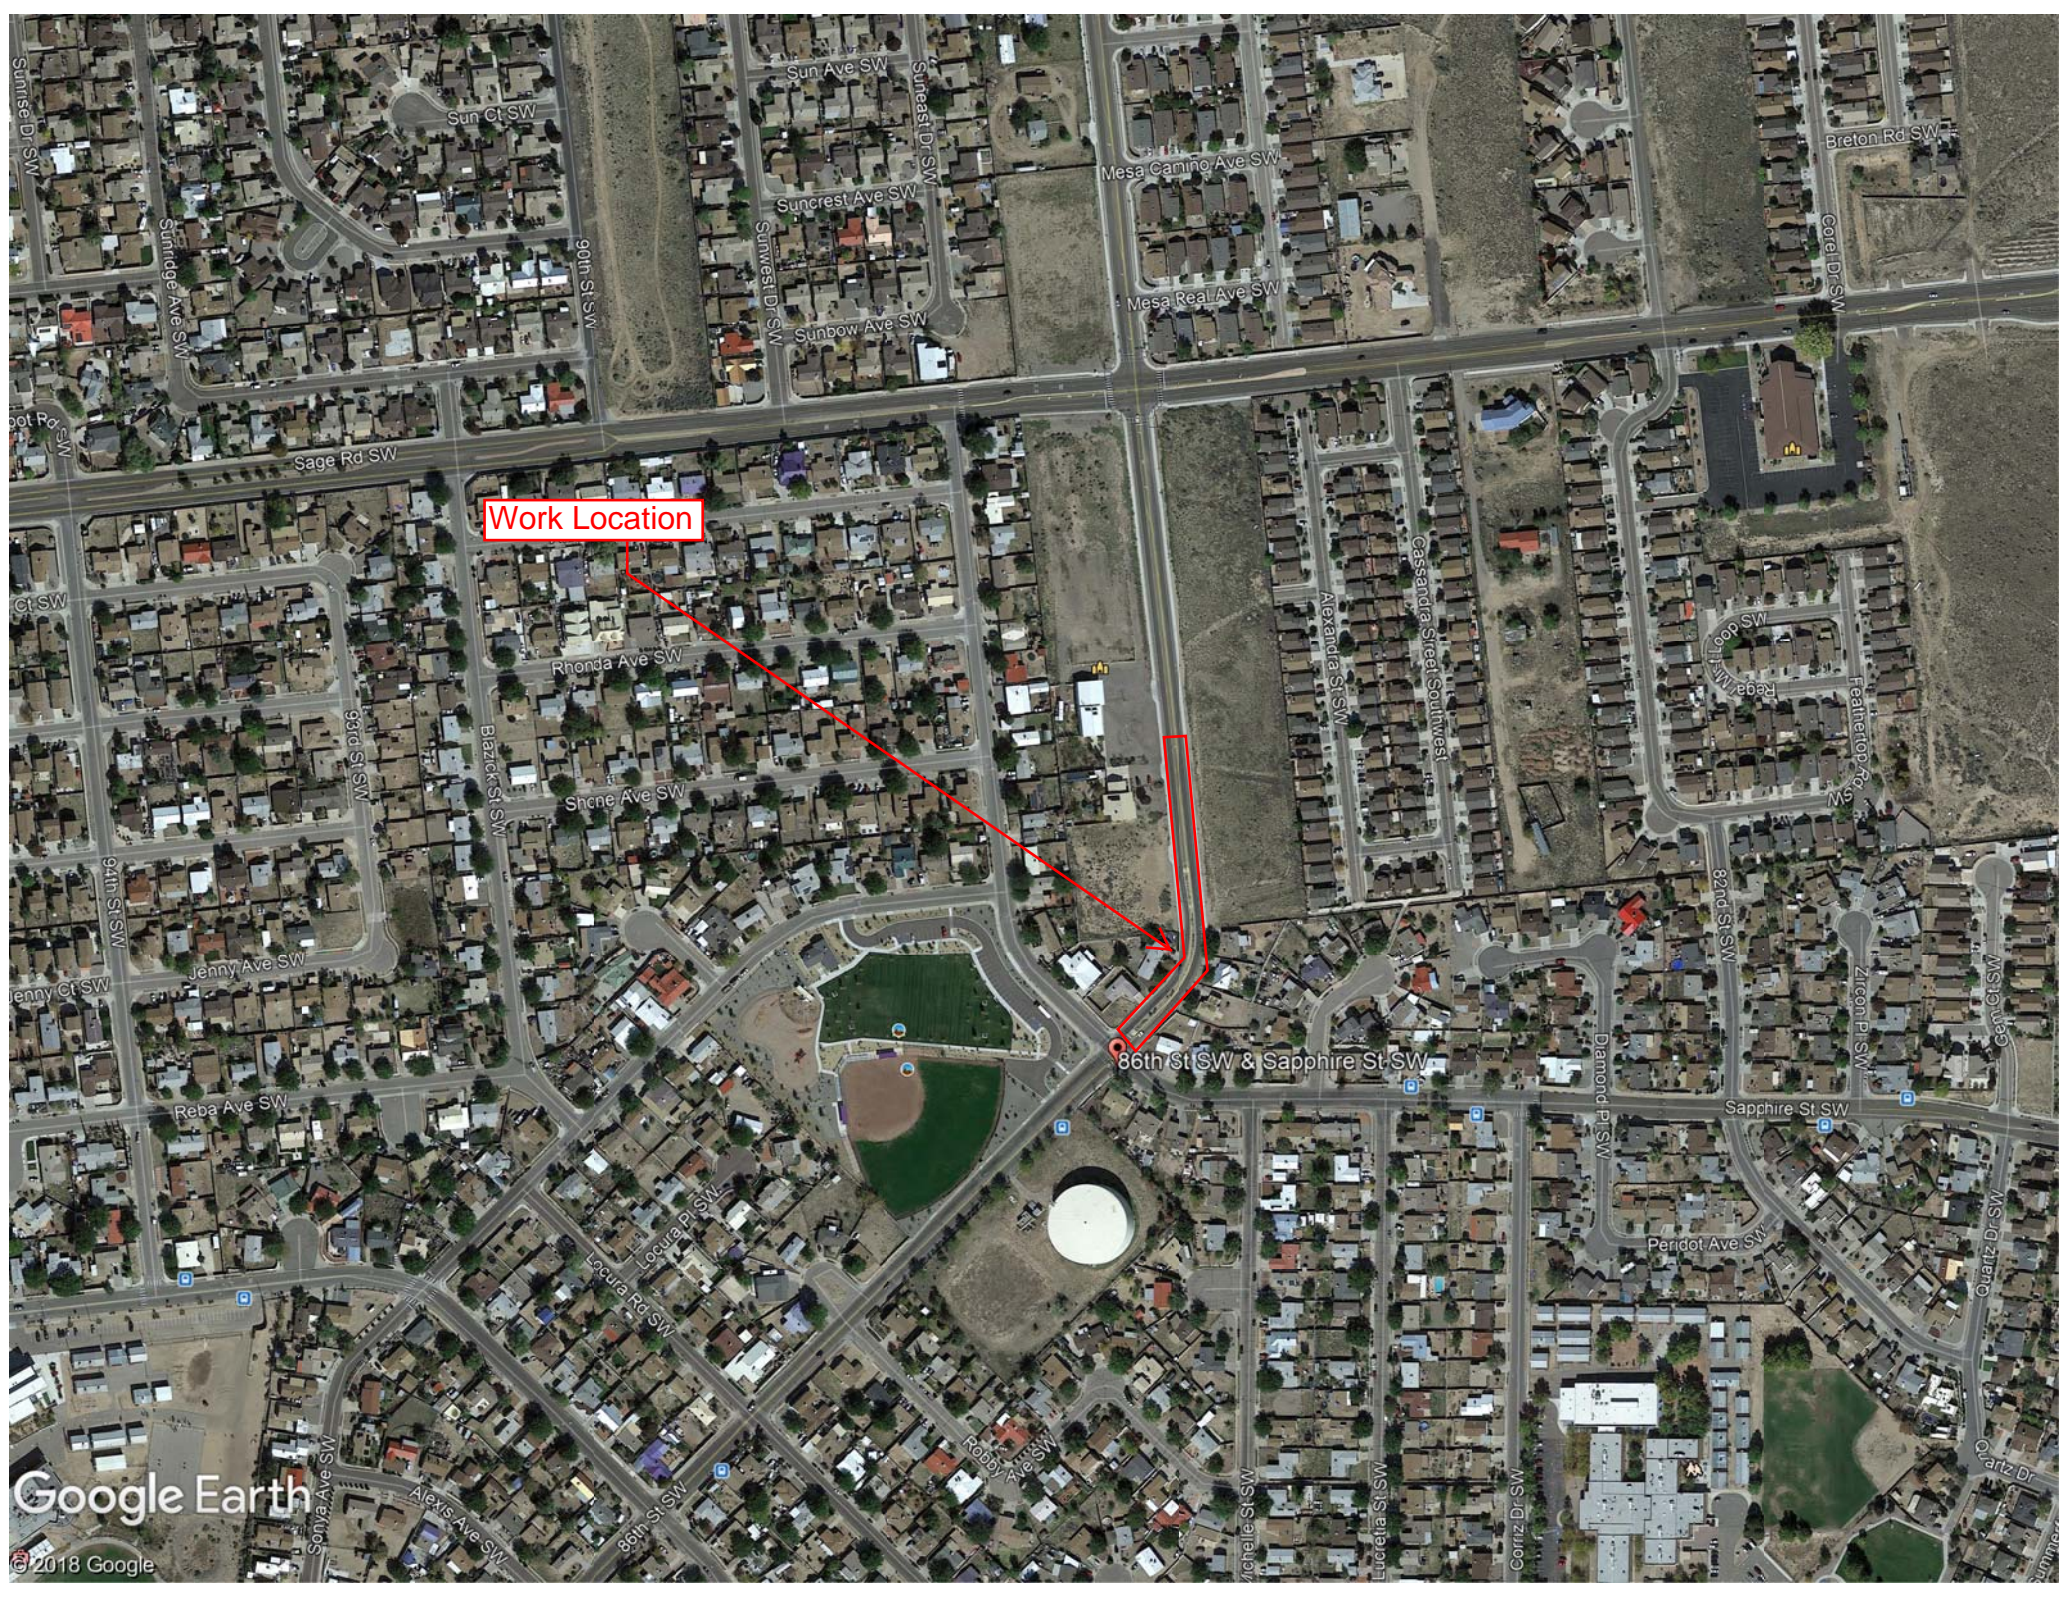

Work Location

86th St SW & Sapphire St SW




SCALE 1"=50'


DEMOLITION NOTES:


1. ERADICATE WHITE STRIPE BY WATER-BLAST METHOD ONLY
2. ERADICATE YELLOW STRIPE BY WATER-BLAST METHOD ONLY

SHEET NOTES:

- A. SEE SHEET 4 FOR EXISTING SECTION A-A

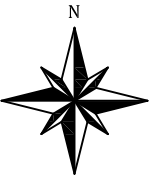

CITY OF ALBUQUERQUE DEPARTMENT OF MUNICIPAL DEVELOPMENT ENGINEERING DIVISION				
TITLE: 86TH STREET CHICANE IMPROVEMENTS				
NOT FOR CONSTRUCTION	DESIGNED BY: DUSTIN DAVIDSON		LAST DESIGN UPDATE	Mo./Day/Yr.
	REVIEWED BY:			09/26/2019
	UPDATED BY: BRIDGETTE GARRETT			10/28/2019
				10/29/2019
				11/05/2019
City Project No. 424292		Zone Map No. M9	Sheet 1	Of 5

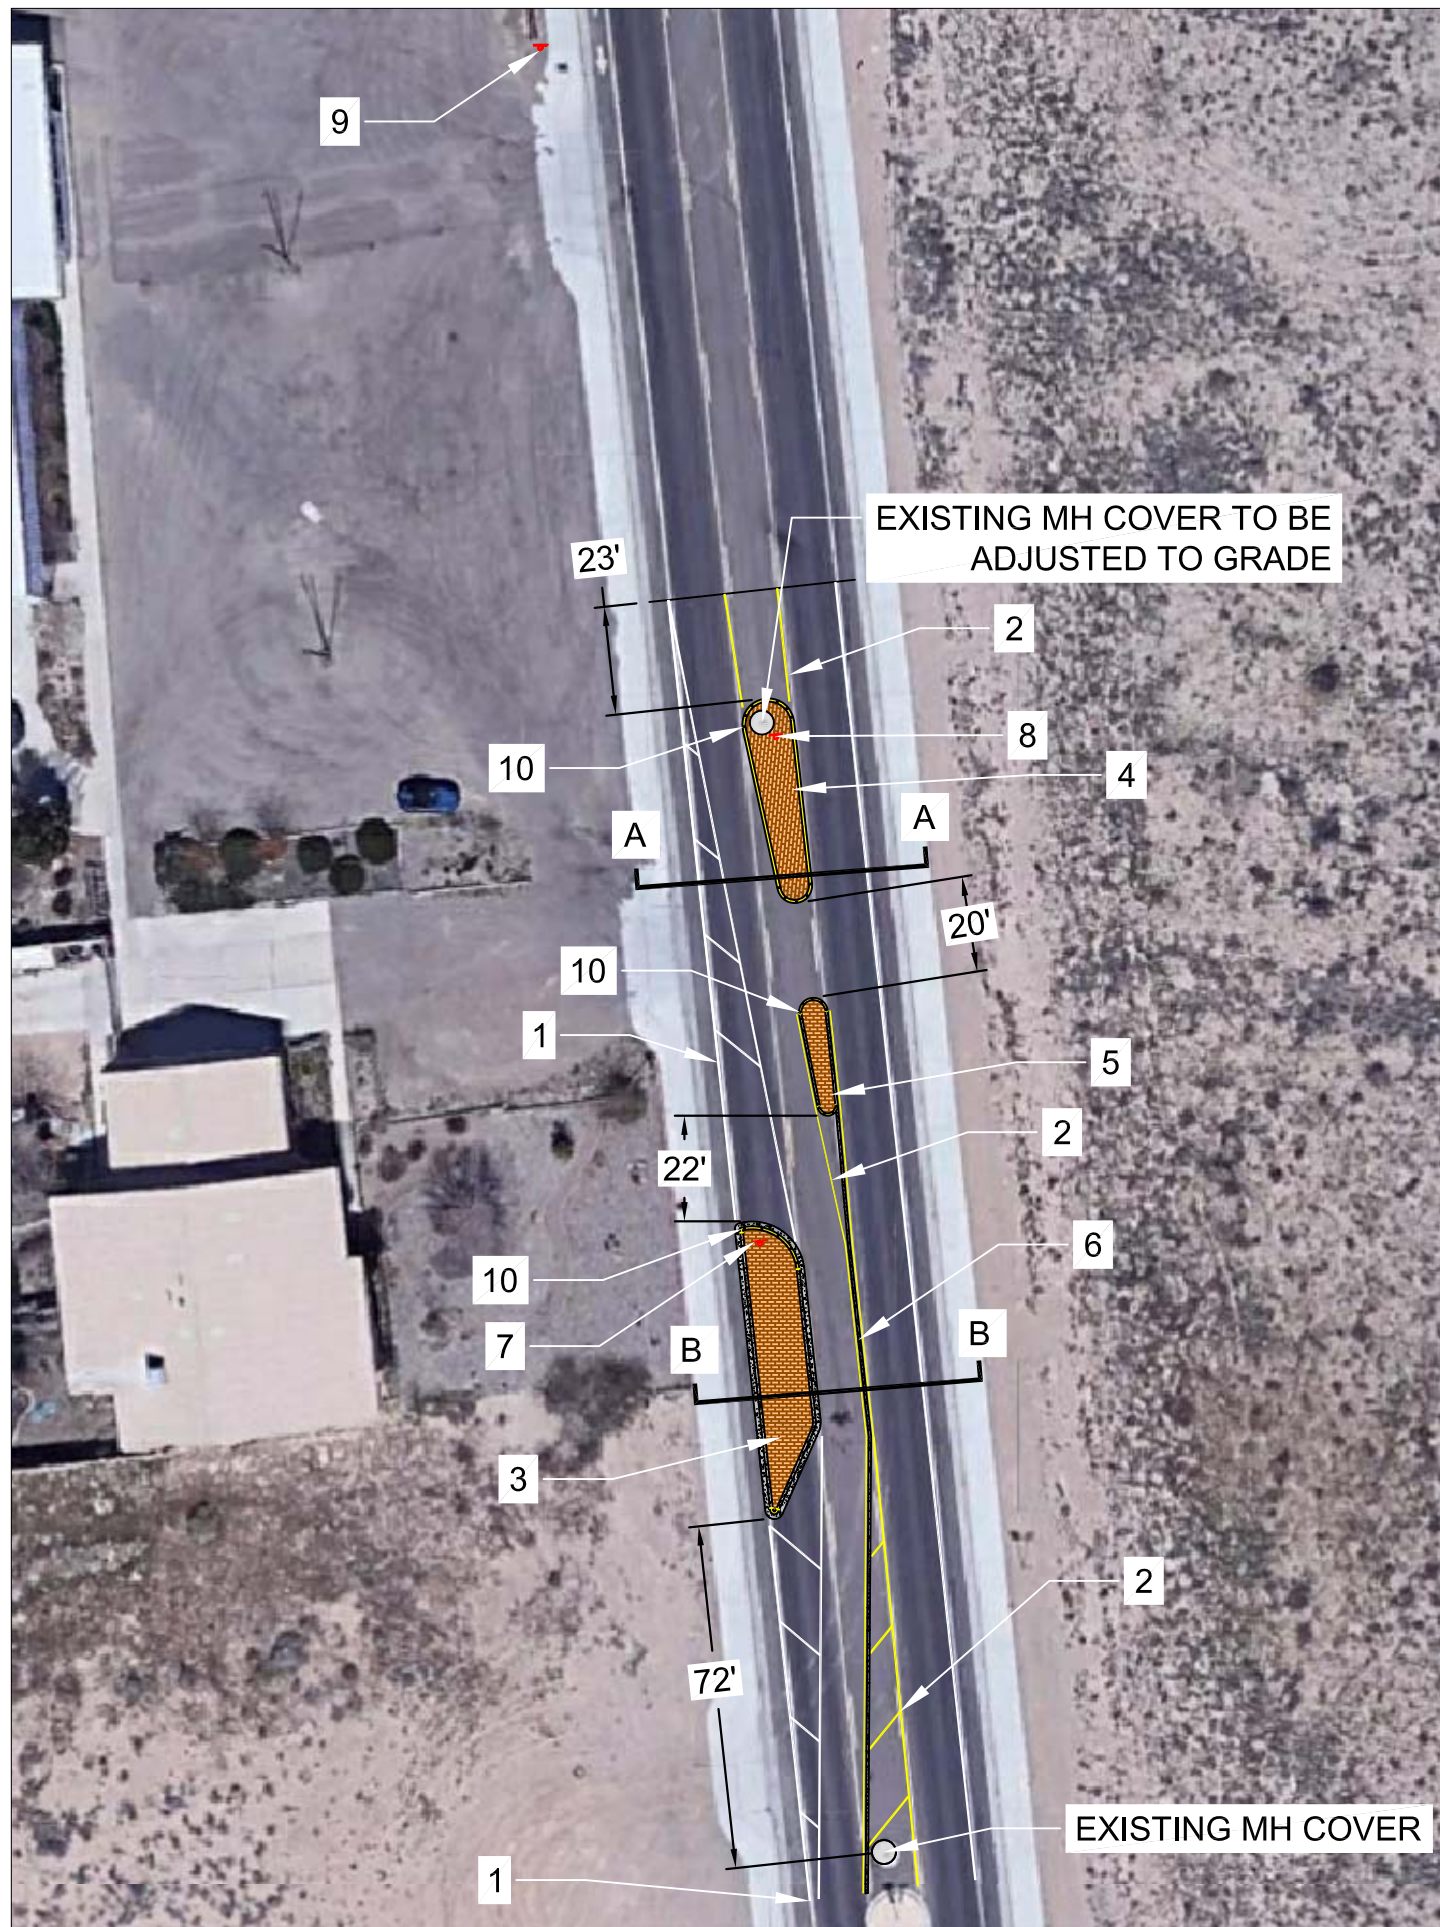

SCALE 1"=40'

KEYED IMPROVEMENT NOTES:

1. INSTALL 6" REFLECTORIZED PLASTIC SOLID WHITE STRIPE (TYP.)
2. INSTALL 4" REFLECTORIZED PLASTIC SOLID YELLOW STRIPE (TYP.)
3. INSTALL CHICANE PER DETAIL ON SHEET 3
4. INSTALL MEDIAN PER MEDIAN PINNED CURB DETAIL 1 ON SHEET 3
5. INSTALL MEDIAN PER MEDIAN PINNED CURB DETAIL 2 ON SHEET 3
6. INSTALL 170 LF - CONCRETE PINNED CURB PER DETAIL ON SHEET 3
7. INSTALL MUTCD OM3-R
8. INSTALL MUTCD R4-7
9. INSTALL MUTCD W5-1
10. INSTALL 1-WAY RAISED PAVEMENT MARKERS, PER DETAILS ON SHEETS 3 & 5


SHEET NOTES:



- A. SEE SHEET 4 FOR SECTIONS A-A AND B-B
- B. SEE SHEET 5 FOR SIGN DETAILS
- C. HATCH SPACING IS 20'





SCALE 1"=100'




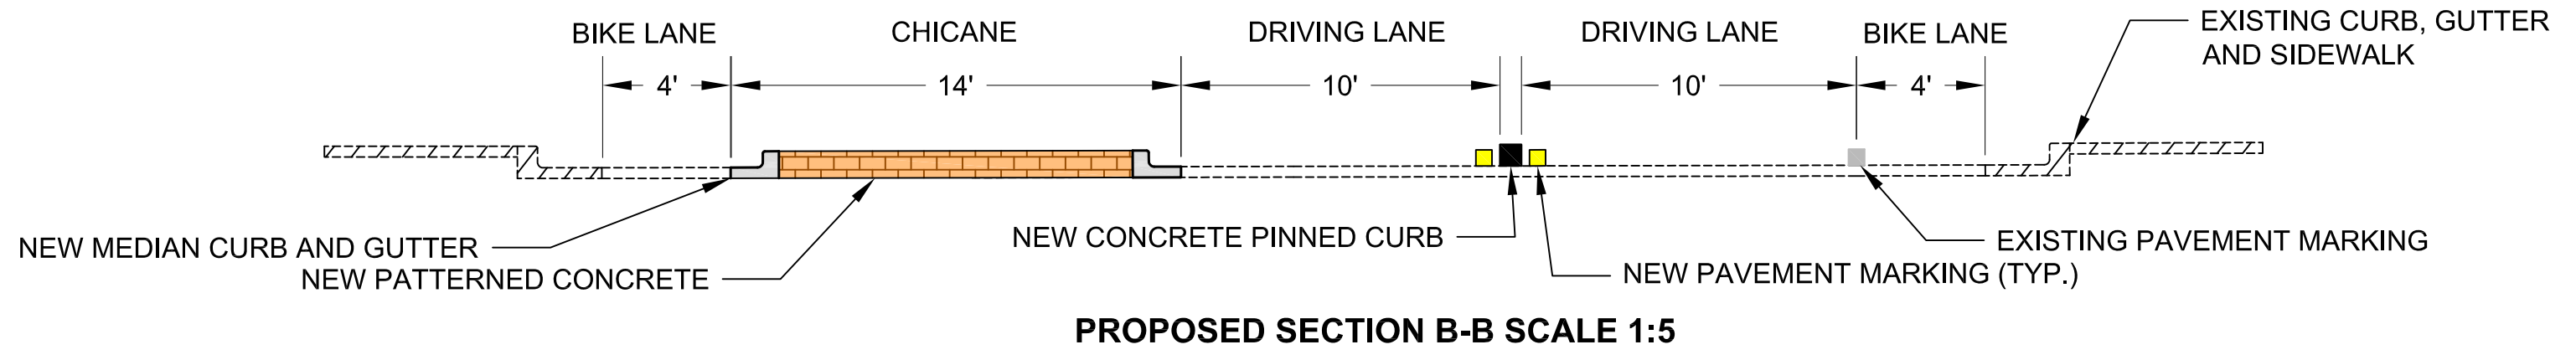
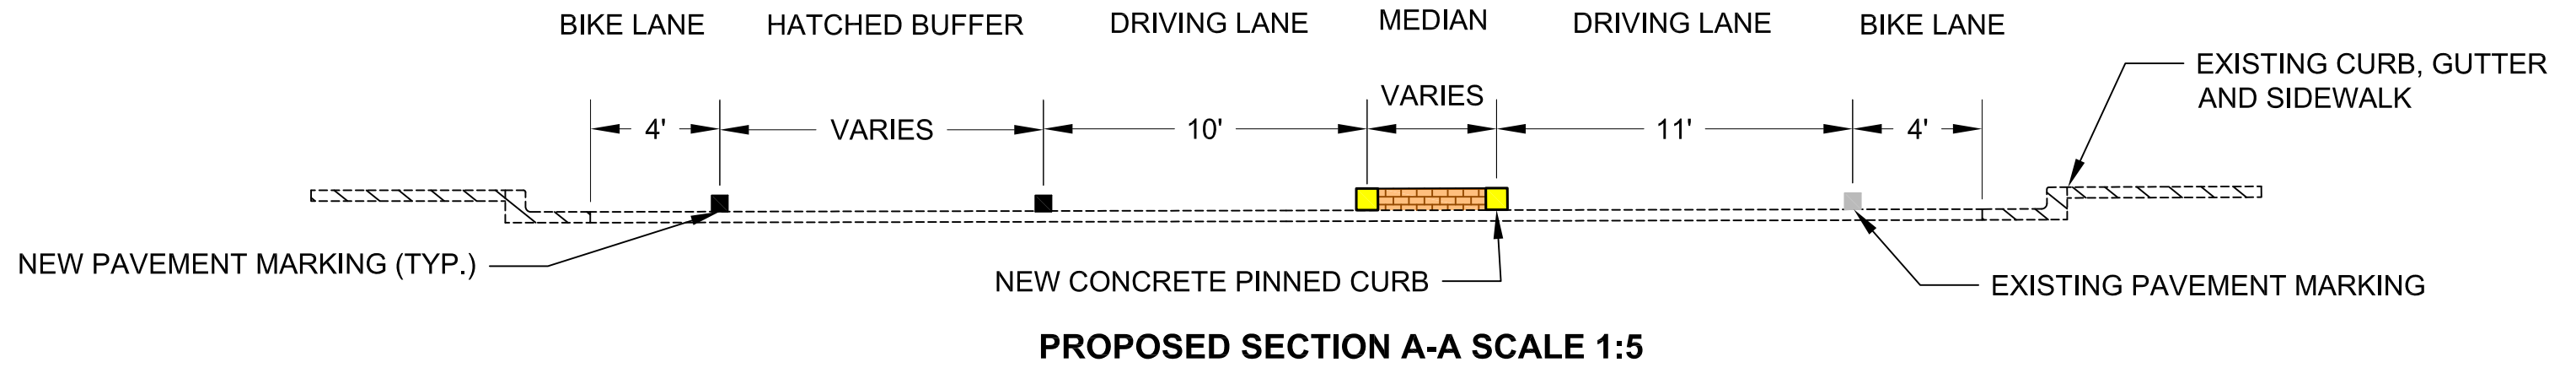
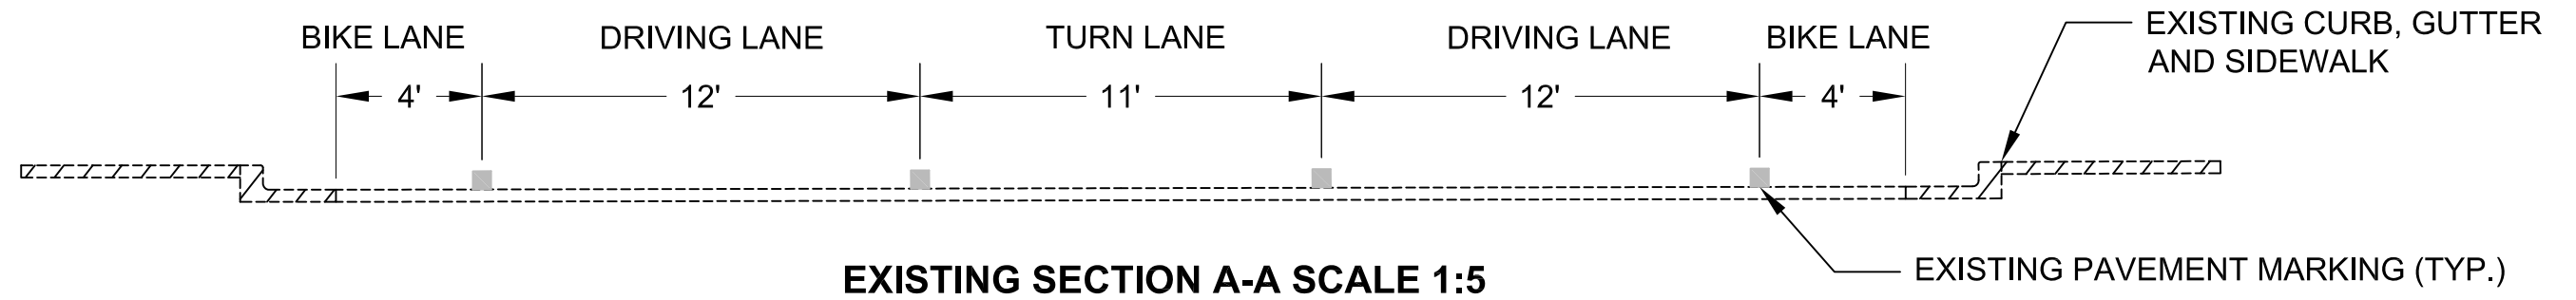
CITY OF ALBUQUERQUE DEPARTMENT OF MUNICIPAL DEVELOPMENT ENGINEERING DIVISION				
TITLE: 86TH STREET CHICANE IMPROVEMENTS				
NOT FOR CONSTRUCTION	DESIGNED BY: DUSTIN DAVIDSON		LAST DESIGN UPDATE	Mo./Day/Yr.
	REVIEWED BY:			09/26/2019
	UPDATED BY: BRIDGETTE GARRETT			10/28/2019
				10/29/2019
				11/05/2019
City Project No. 424292		Zone Map No. M9	Sheet 2	Of 5

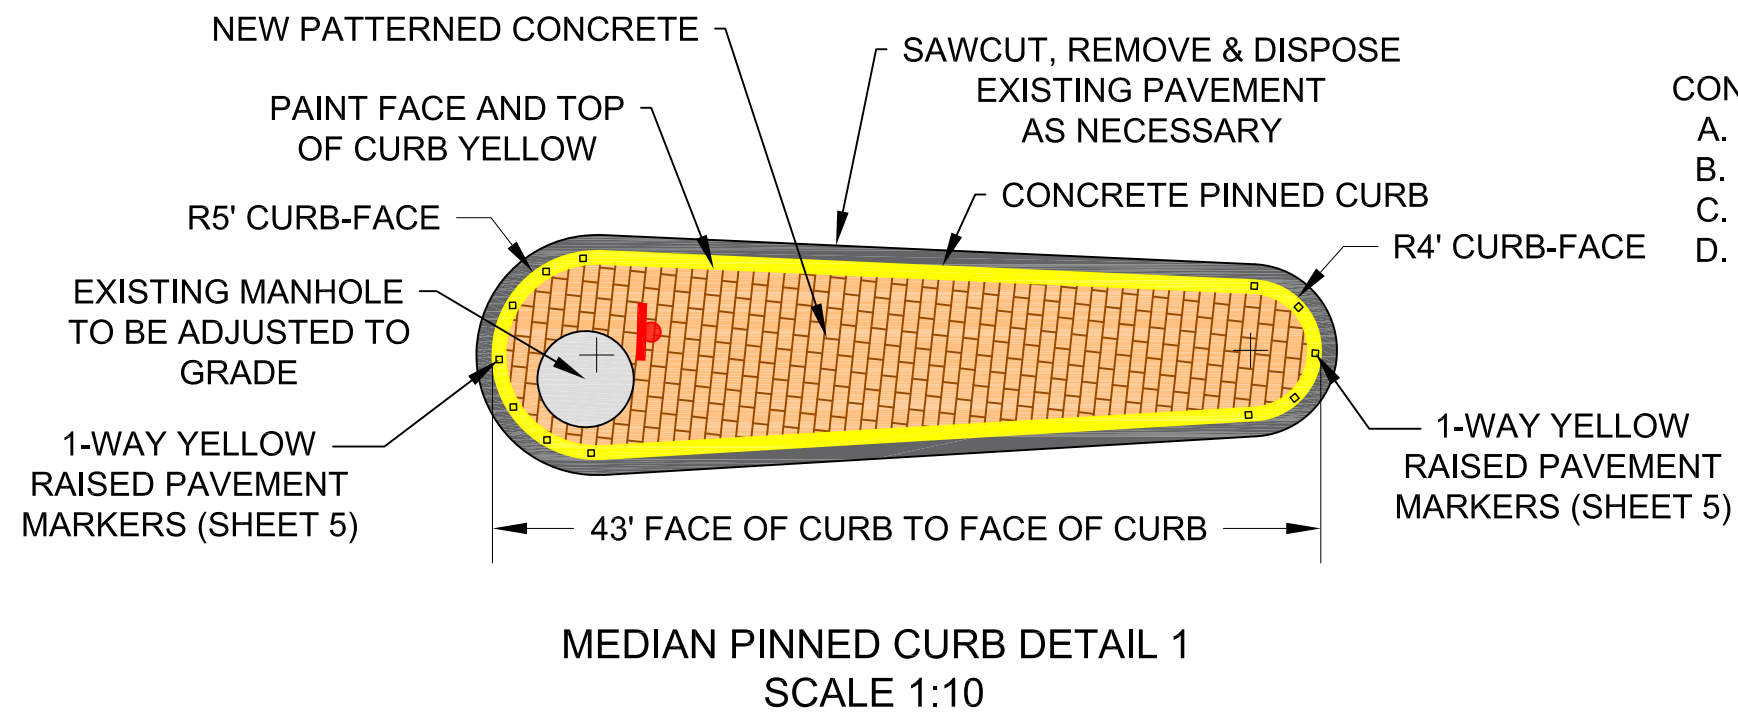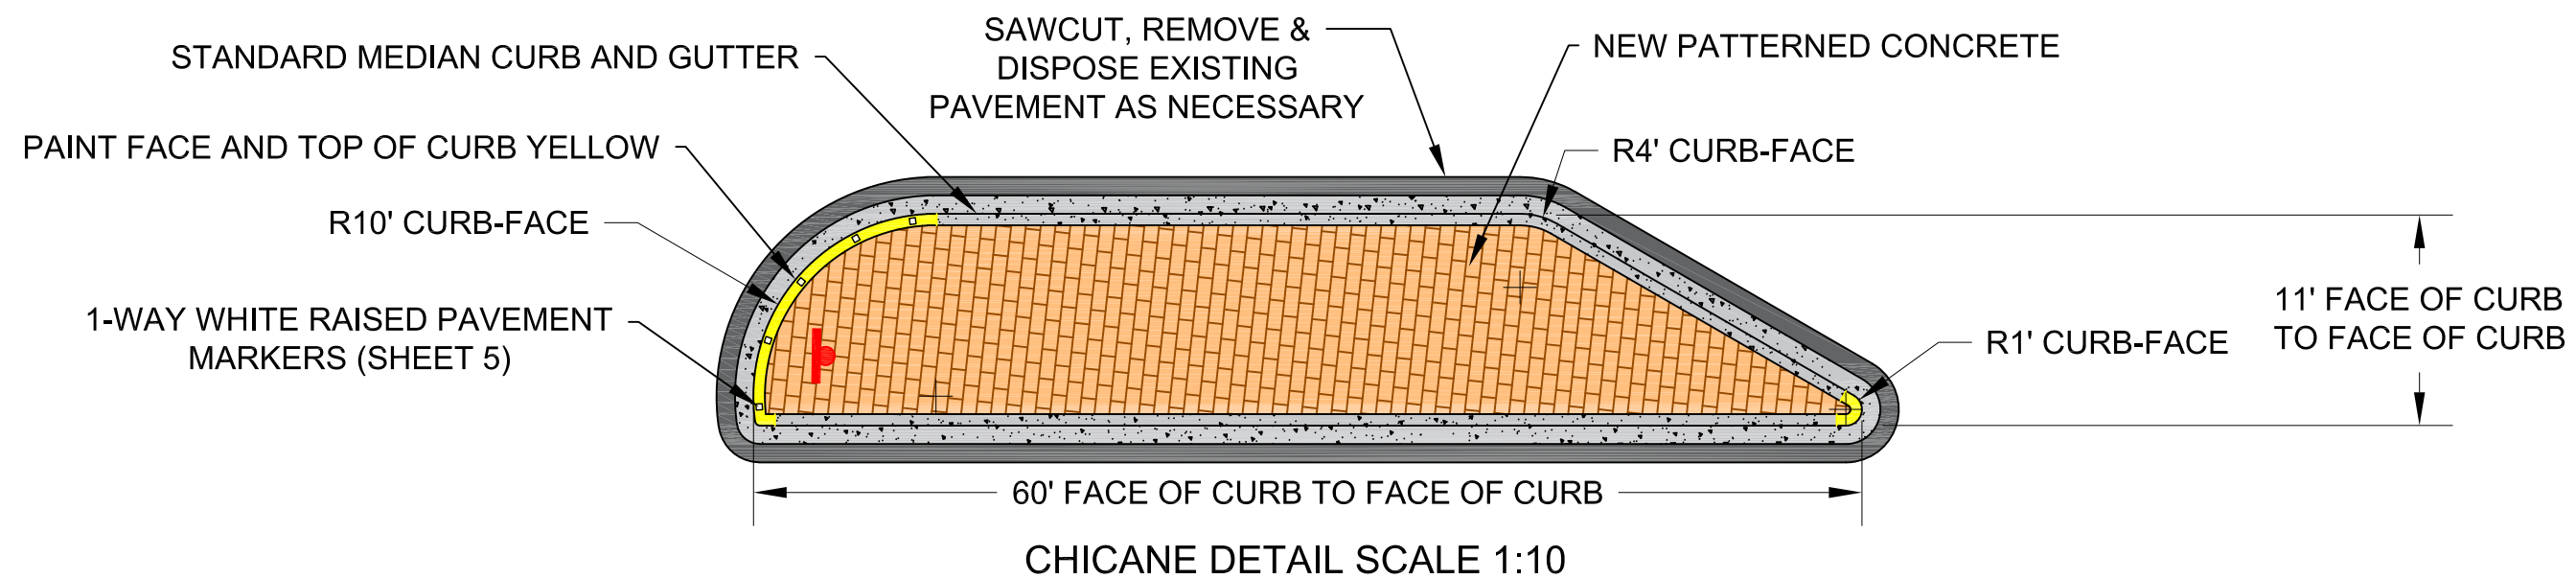


- A. 3/4" RADIUS
- B. 2" RADIUS
- C. EXISTING PAVEMENT
- D. BUILD PER COA SD 2415C

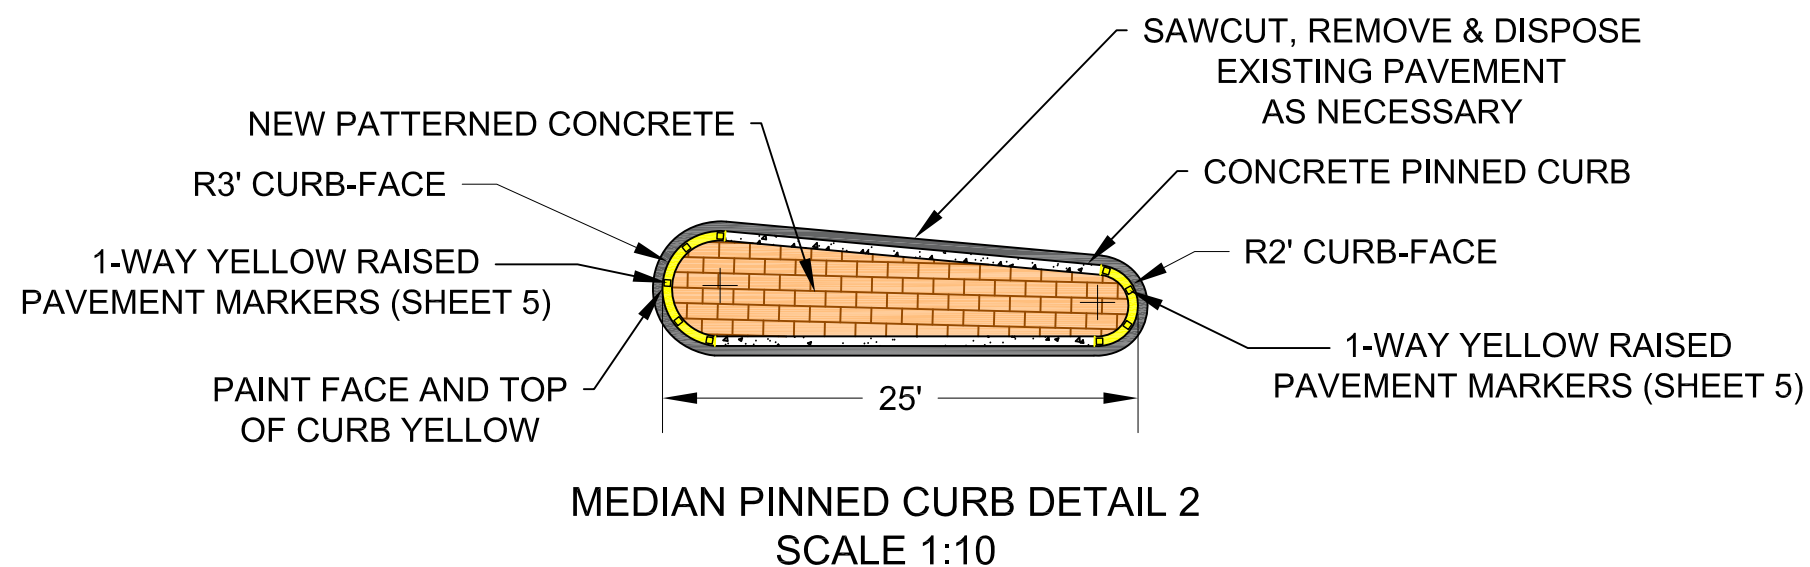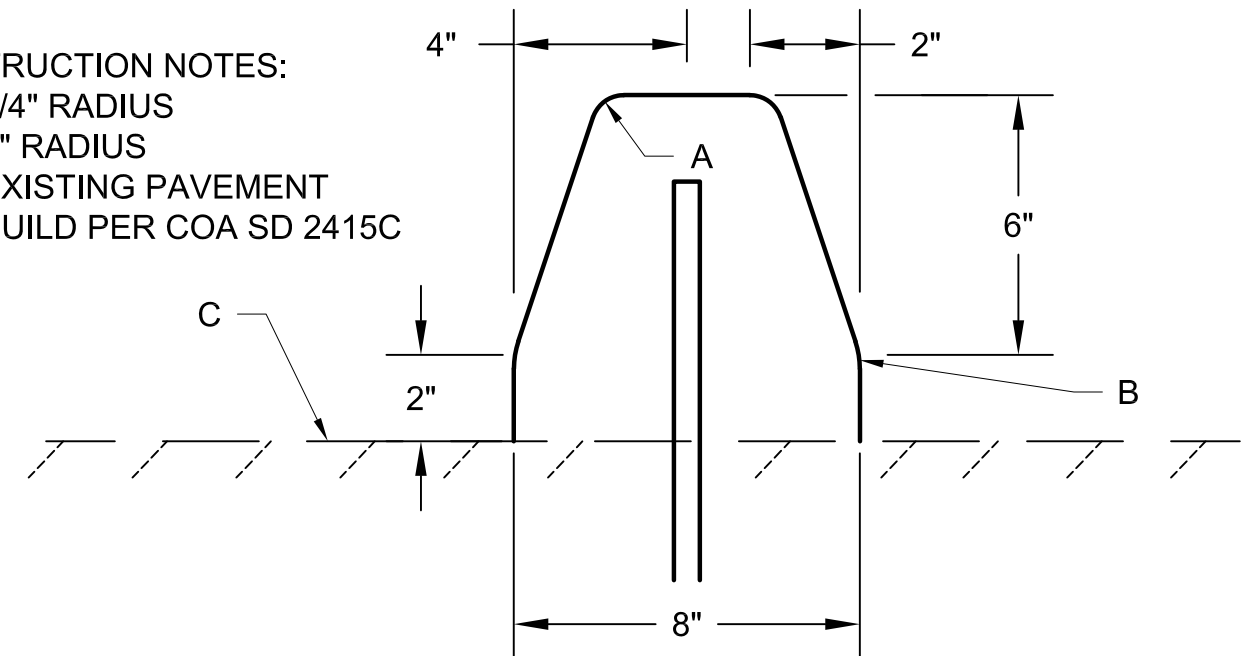

CITY OF ALBUQUERQUE DEPARTMENT OF MUNICIPAL DEVELOPMENT ENGINEERING DIVISION				
TITLE: 86TH STREET CHICANE IMPROVEMENTS				
<div style="color: red; transform: rotate(-45deg); font-weight: bold; font-size: 1.2em;">NOT FOR CONSTRUCTION</div>	DESIGNED BY: DUSTIN DAVIDSON		LAST DESIGN UPDATE	Mo./Day/Yr.
	REVIEWED BY:			09/26/2019
	UPDATED BY: BRIDGETTE GARRETT			10/28/2019
				10/29/2019
				11/05/2019
City Project No. 424292	Zone Map No. M9	Sheet	Of	35




CITY OF ALBUQUERQUE DEPARTMENT OF MUNICIPAL DEVELOPMENT ENGINEERING DIVISION				
TITLE: 86TH STREET CHICANE IMPROVEMENTS				
NOT FOR CONSTRUCTION	DESIGNED BY: DUSTIN DAVIDSON		LAST DESIGN UPDATE	Mo./Day/Yr.
	REVIEWED BY:			09/26/2019
	UPDATED BY: BRIDGETTE GARRETT			10/28/2019
				10/29/2019
				11/05/2019
City Project No. 424292		Zone Map No. M9	Sheet 4	Of 5



W5-1
36X36



OM3-R
12"X36"

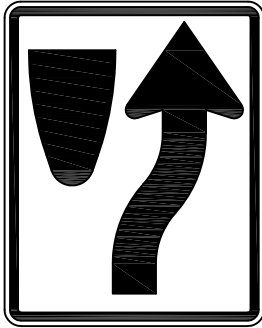


R4-7
24"X30"



1-WAY RAISED PAVEMENT MARKER
REFLECTIVE: YELLOW; 4"X 4"



1-WAY RAISED PAVEMENT MARKER
REFLECTIVE: WHITE; 4"X 4"


CITY OF ALBUQUERQUE DEPARTMENT OF MUNICIPAL DEVELOPMENT ENGINEERING DIVISION				
TITLE: 86TH STREET CHICANE IMPROVEMENTS				
<div>NOT FOR CONSTRUCTION</div>	DESIGNED BY: DUSTIN DAVIDSON		LAST DESIGN UPDATE	Mo./Day/Yr.
	REVIEWED BY:			09/26/2019
				10/28/2019
				10/29/2019
				11/05/2019
UPDATED BY: BRIDGETTE GARRETT				
City Project No. 424292		Zone Map No. M9	Sheet 5	Of 5


Remove 3140 SF
existing landscaping
& irrigation.

Add 3140 SF pattern
concrete in median,
nose to nose

Add 175 Ft.
Guardrail with
end treatments

Remove &
Replace 30 Ft. of
damaged curb

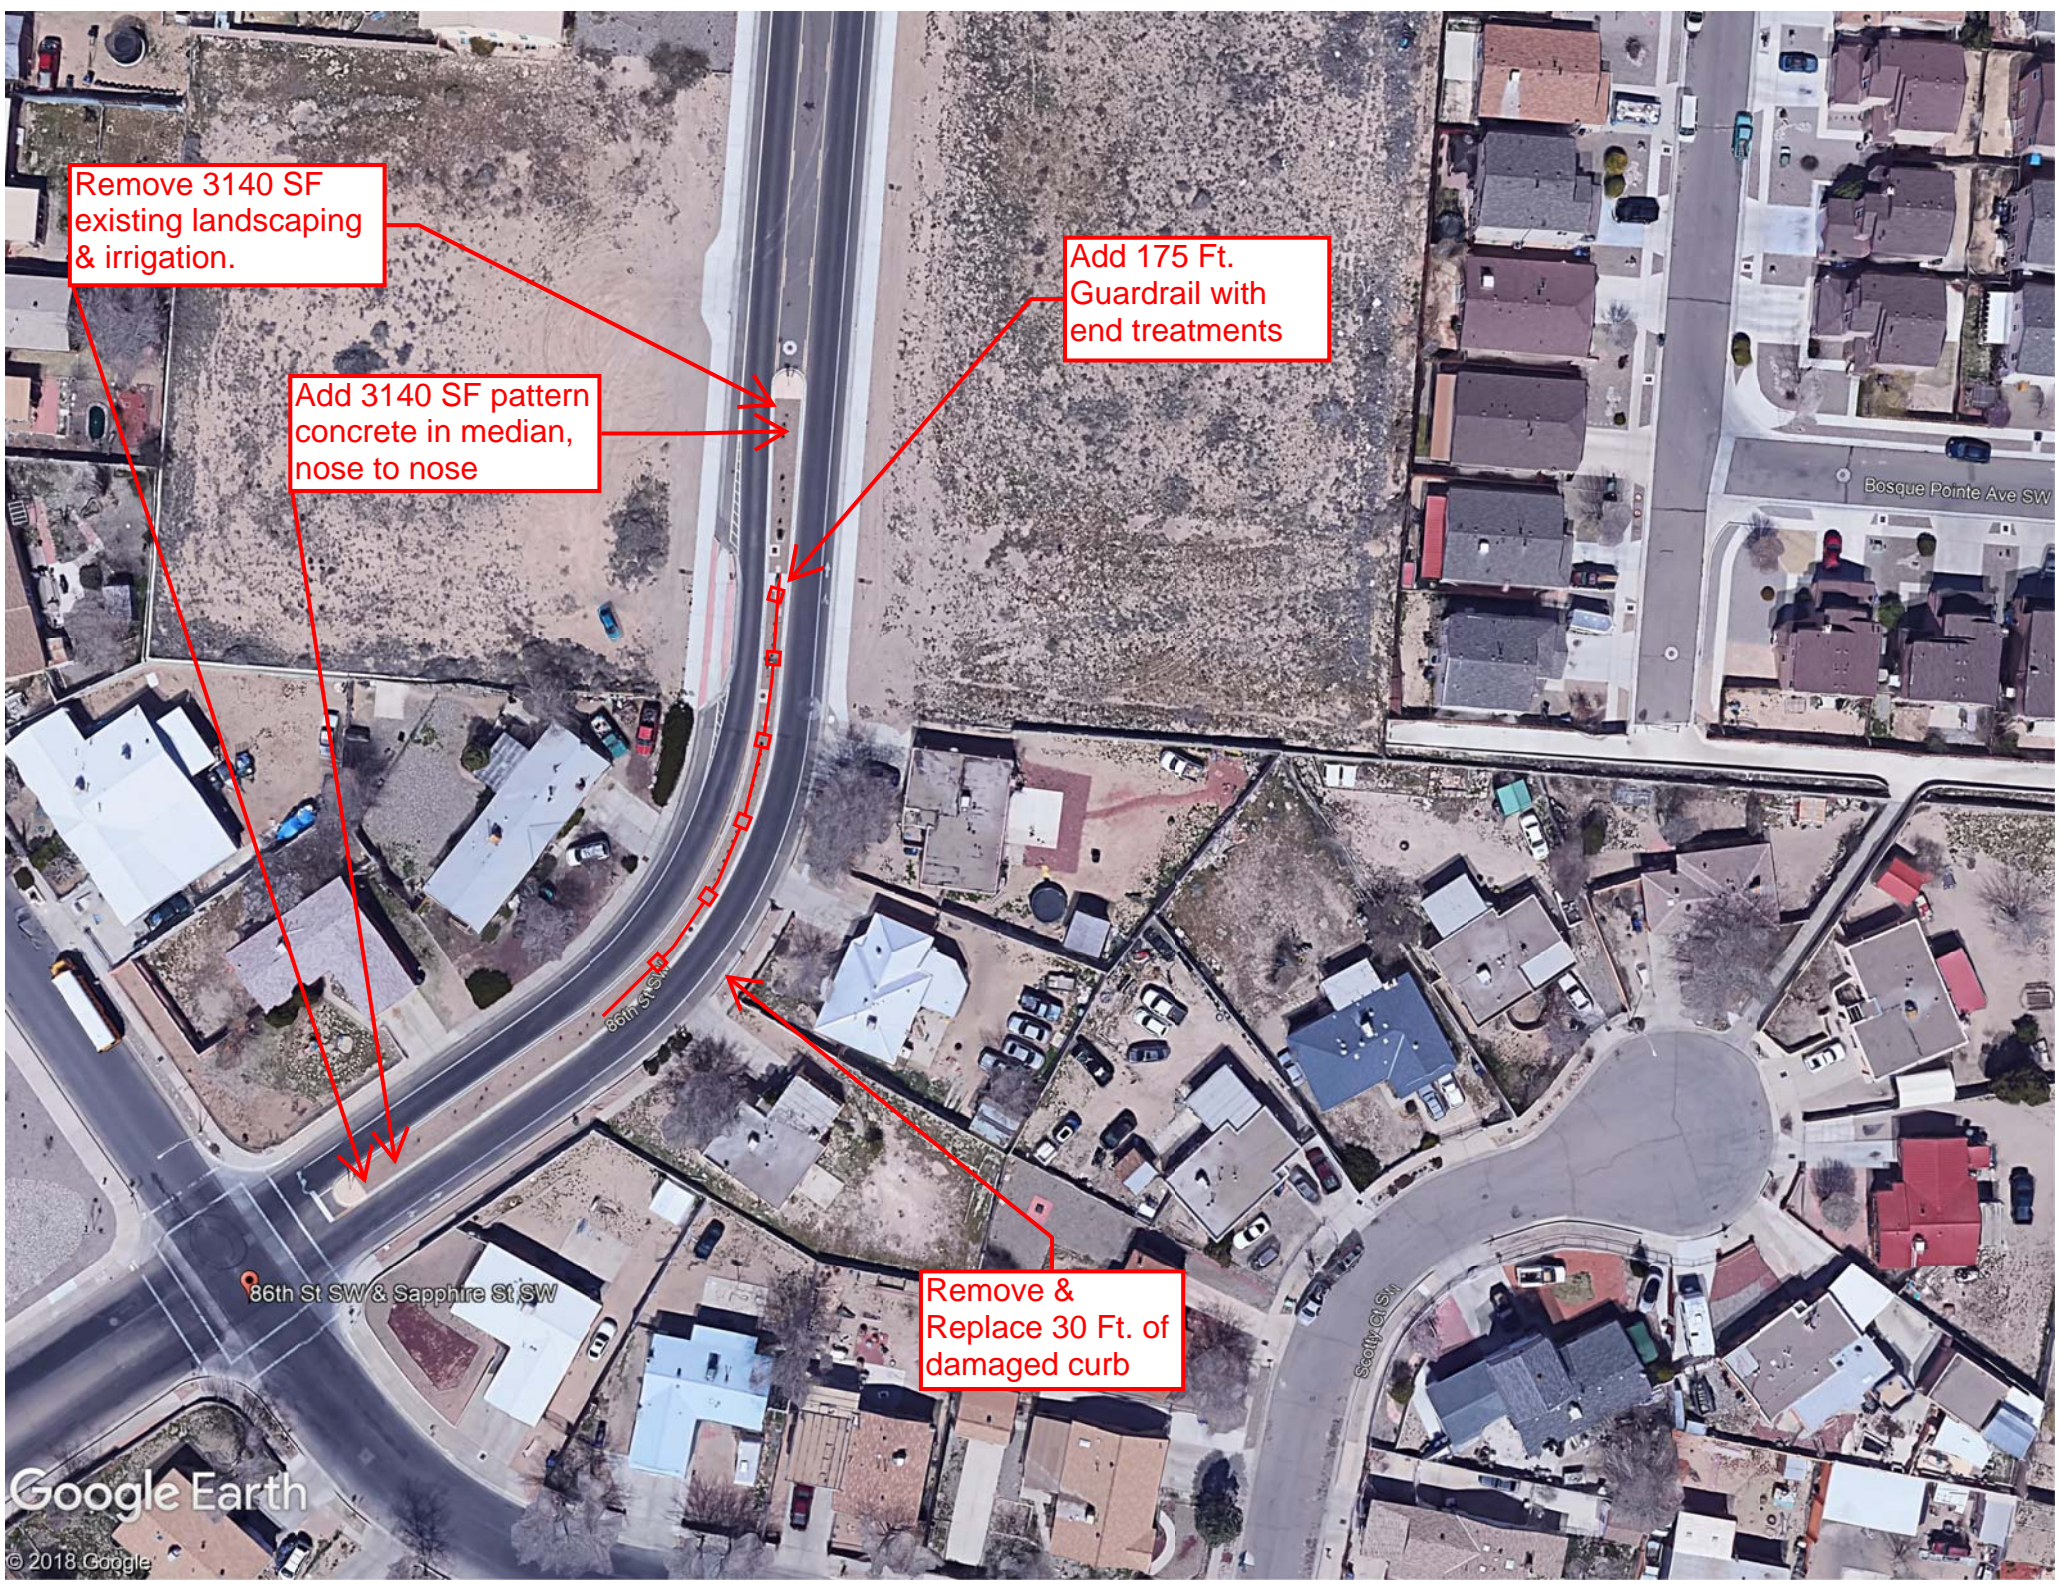




Work was constructed in compliance with details provided on previous pages and City of Albuquerque Standard Specifications and Drawings.

FOR
INFORMATION
ONLY



