



ROQUE INFRA BUILDING DIVISION									
SHEETS									
		NO./DAY/YR.				NO./DAY/YR.			



Bohannon & Huston
www.bhinc.com 800.877.5332



CITY OF ALBUQUERQUE
DEPARTMENT OF MUNICIPAL
DEVELOPMENT ENGINEERING DIVISION

FIRE STATION FLASHER DETAILS			
DESIGN REVIEW COMMITTEE	CITY ENGINEER APPROVAL	LAST DESIGN UPDATE	MO./DAY/YR.

CITY PROJECT NO.	785406	ZONE MAP NO.		SHEET	15	OF	16
------------------	--------	--------------	--	-------	----	----	----

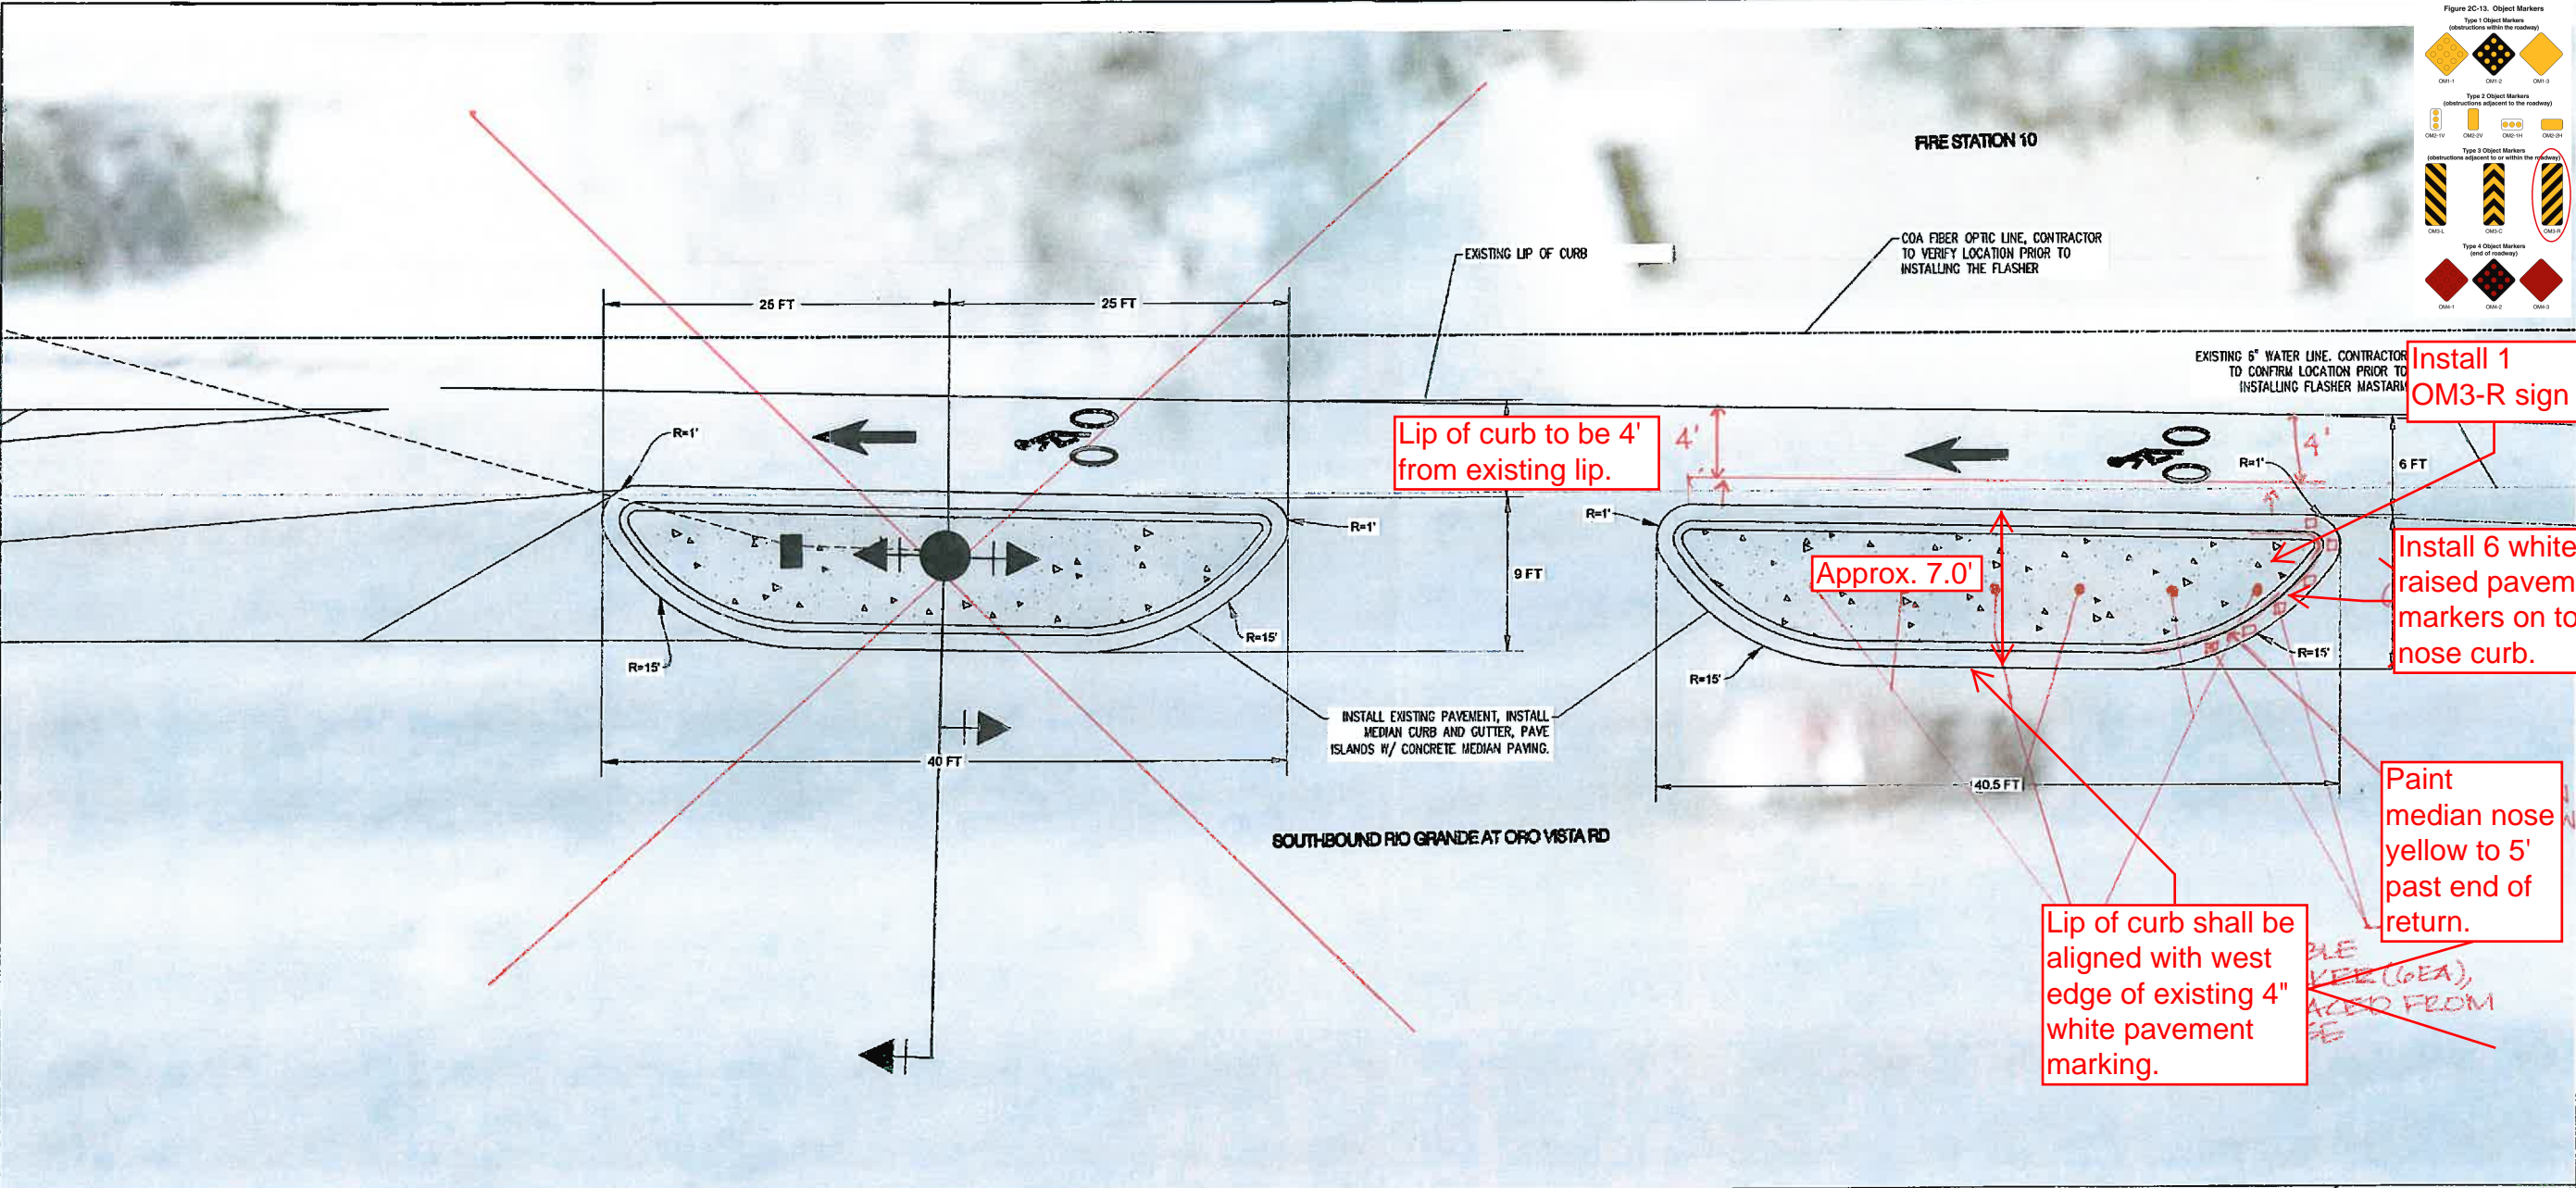


Figure 2C-13. Object Markers

Type 1 Object Markers (obstructions within the roadway)

OM1-1 OM1-2 OM1-3

Type 2 Object Markers (obstructions adjacent to the roadway)

OM2-1V OM2-2V OM2-3H OM2-4H

Type 3 Object Markers (obstructions adjacent to or within the roadway)

OM3-1 OM3-2 OM3-3

Type 4 Object Markers (end of roadway)

OM4-1 OM4-2 OM4-3

AS-BUILT INFORMATION		DATE
CONTRACTOR	DATE	
DESIGNED BY	DATE	
CHECKED BY	DATE	
IN CHARGE BY	DATE	
VERIFIED BY	DATE	
RECORDED BY	DATE	
MICRO-FILM INFORMATION		DATE
NO.	DATE	

BENCH MARKS		NO.	FIELD
CONTRACTOR	NO.		
DESIGNED BY	NO.		
CHECKED BY	NO.		
IN CHARGE BY	NO.		
VERIFIED BY	NO.		
RECORDED BY	NO.		


ENGINEER'S SEAL		NO.	FIELD
CONTRACTOR	NO.		
DESIGNED BY	NO.		
CHECKED BY	NO.		
IN CHARGE BY	NO.		
VERIFIED BY	NO.		
RECORDED BY	NO.		


REVISIONS		NO.	DATE	REMARKS
DESIGNED BY	TSCARBERRY		DATE Dec 08, 2017	
DRAWN BY	##		DATE Dec 08, 2017	
CHECKED BY	TSCARBERRY		DATE Dec 08, 2017	

Bohannon & Huston
www.bhinc.com 800.877.5332

CITY OF ALBUQUERQUE
DEPARTMENT OF MUNICIPAL
DEVELOPMENT ENGINEERING DIVISION

FIRE STATION FLASHER CURB DETAILS		MO./DAY/YR.	MO./DAY/YR.
DESIGN REVIEW COMMITTEE	CITY ENGINEER APPROVAL		
LAST DESIGN UPDATE			

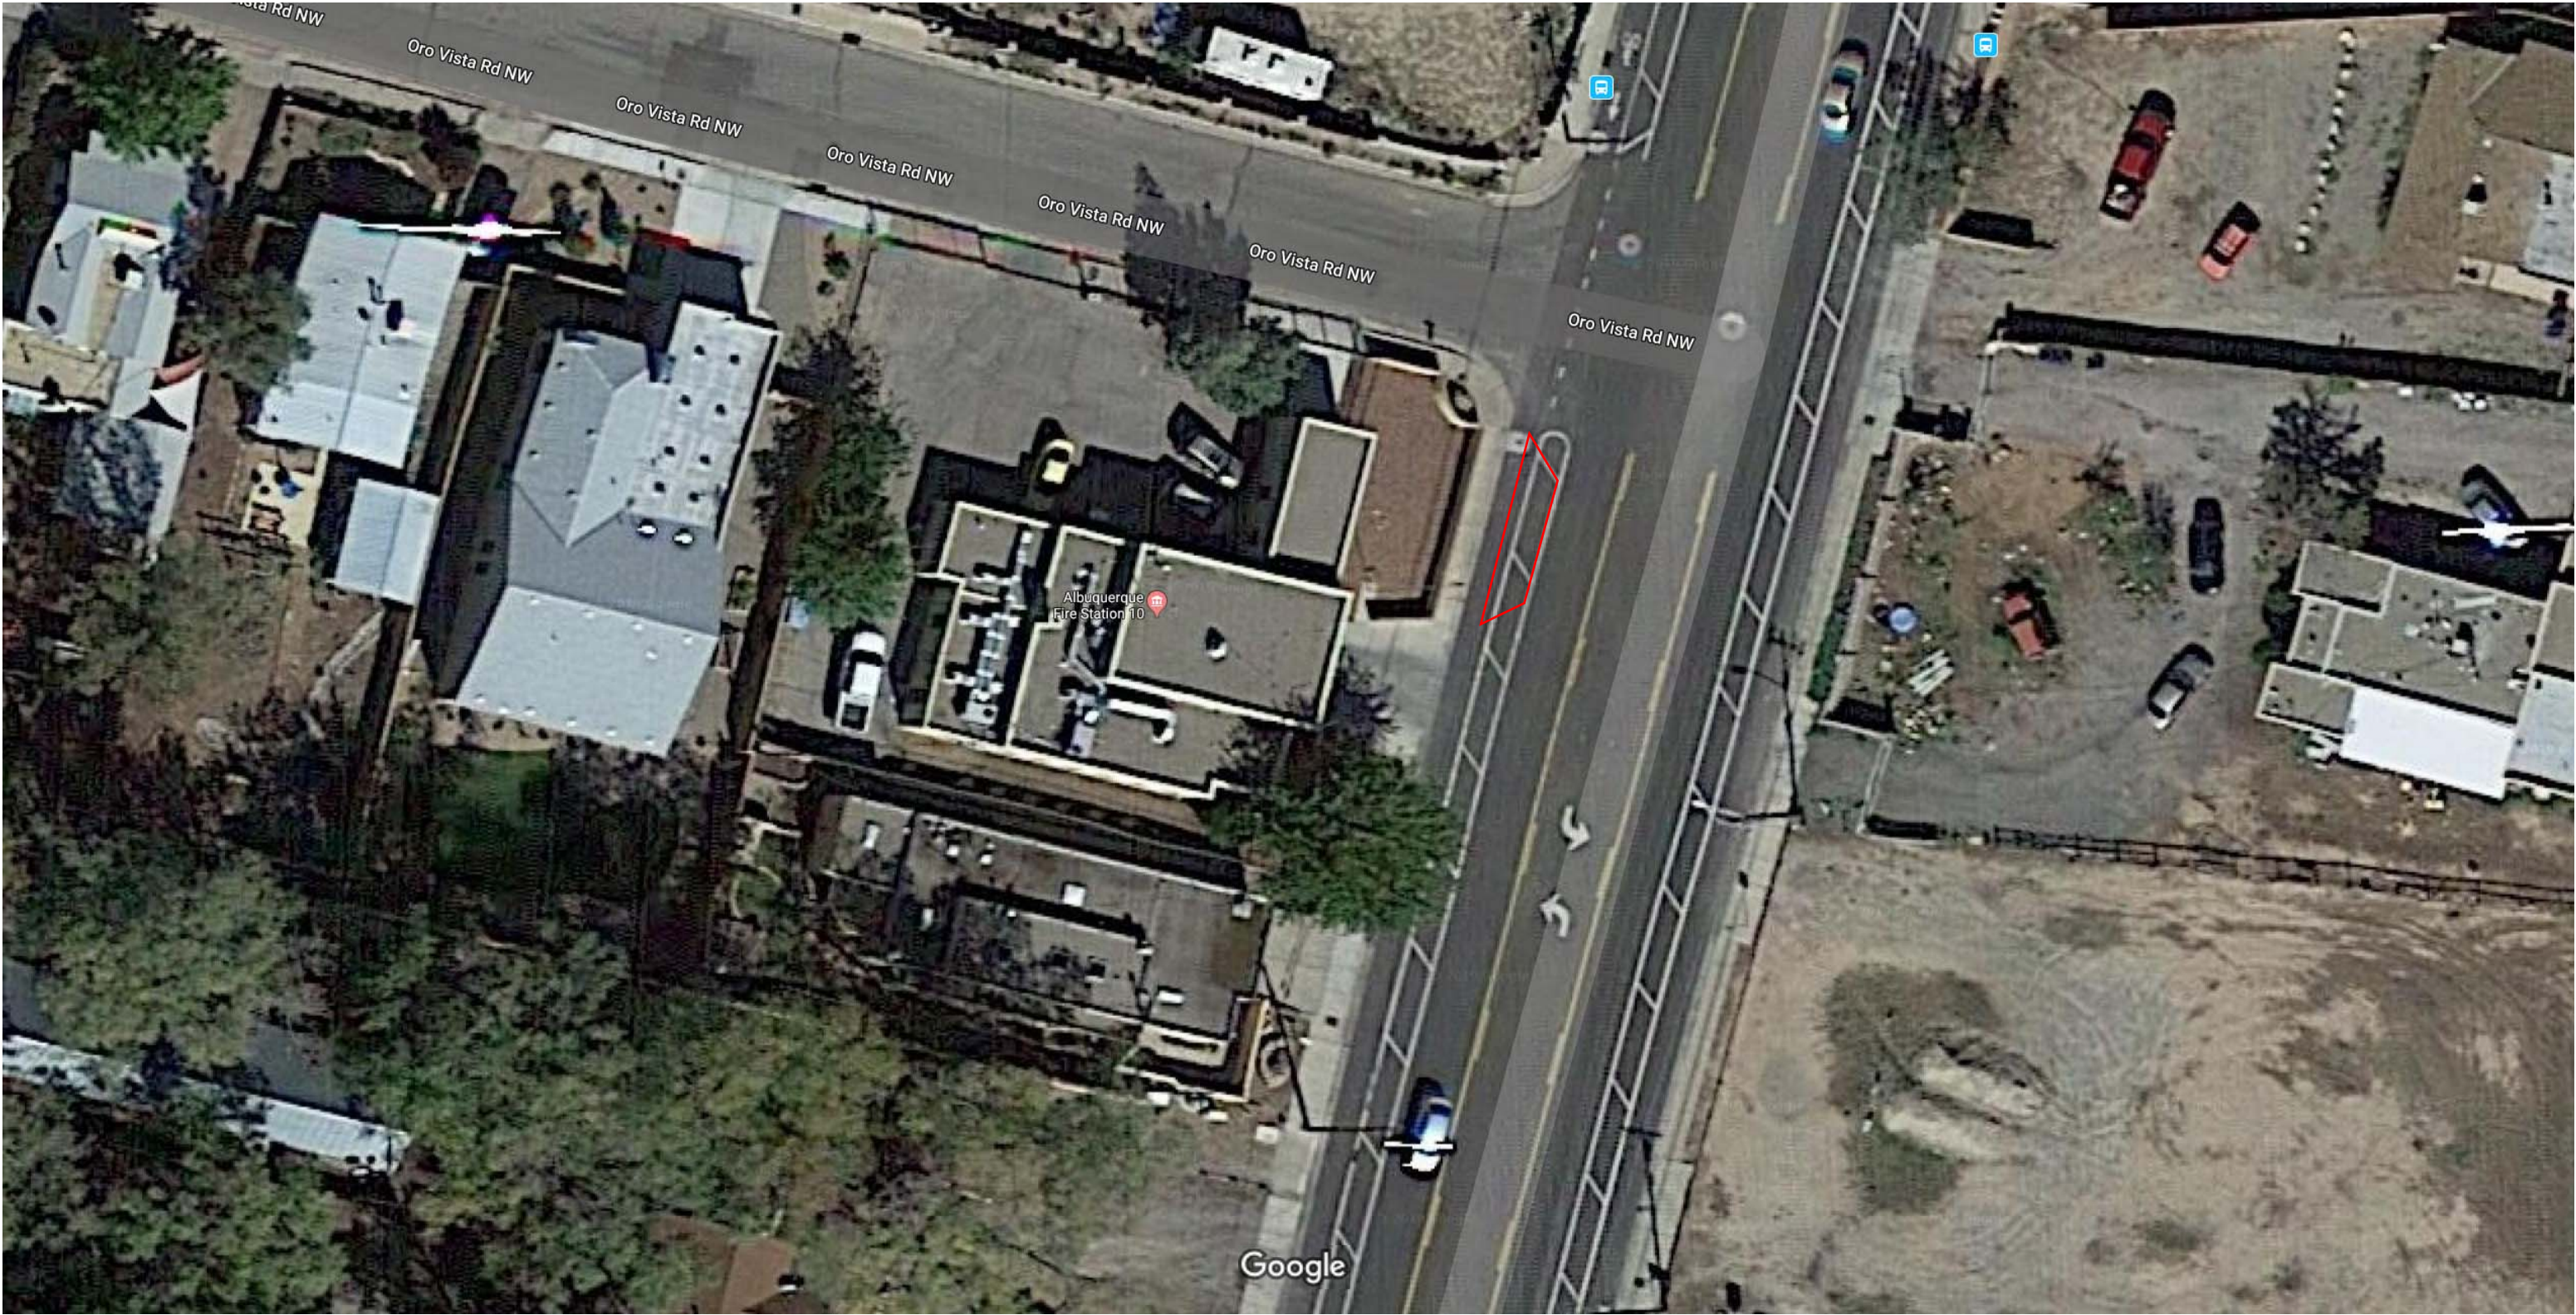

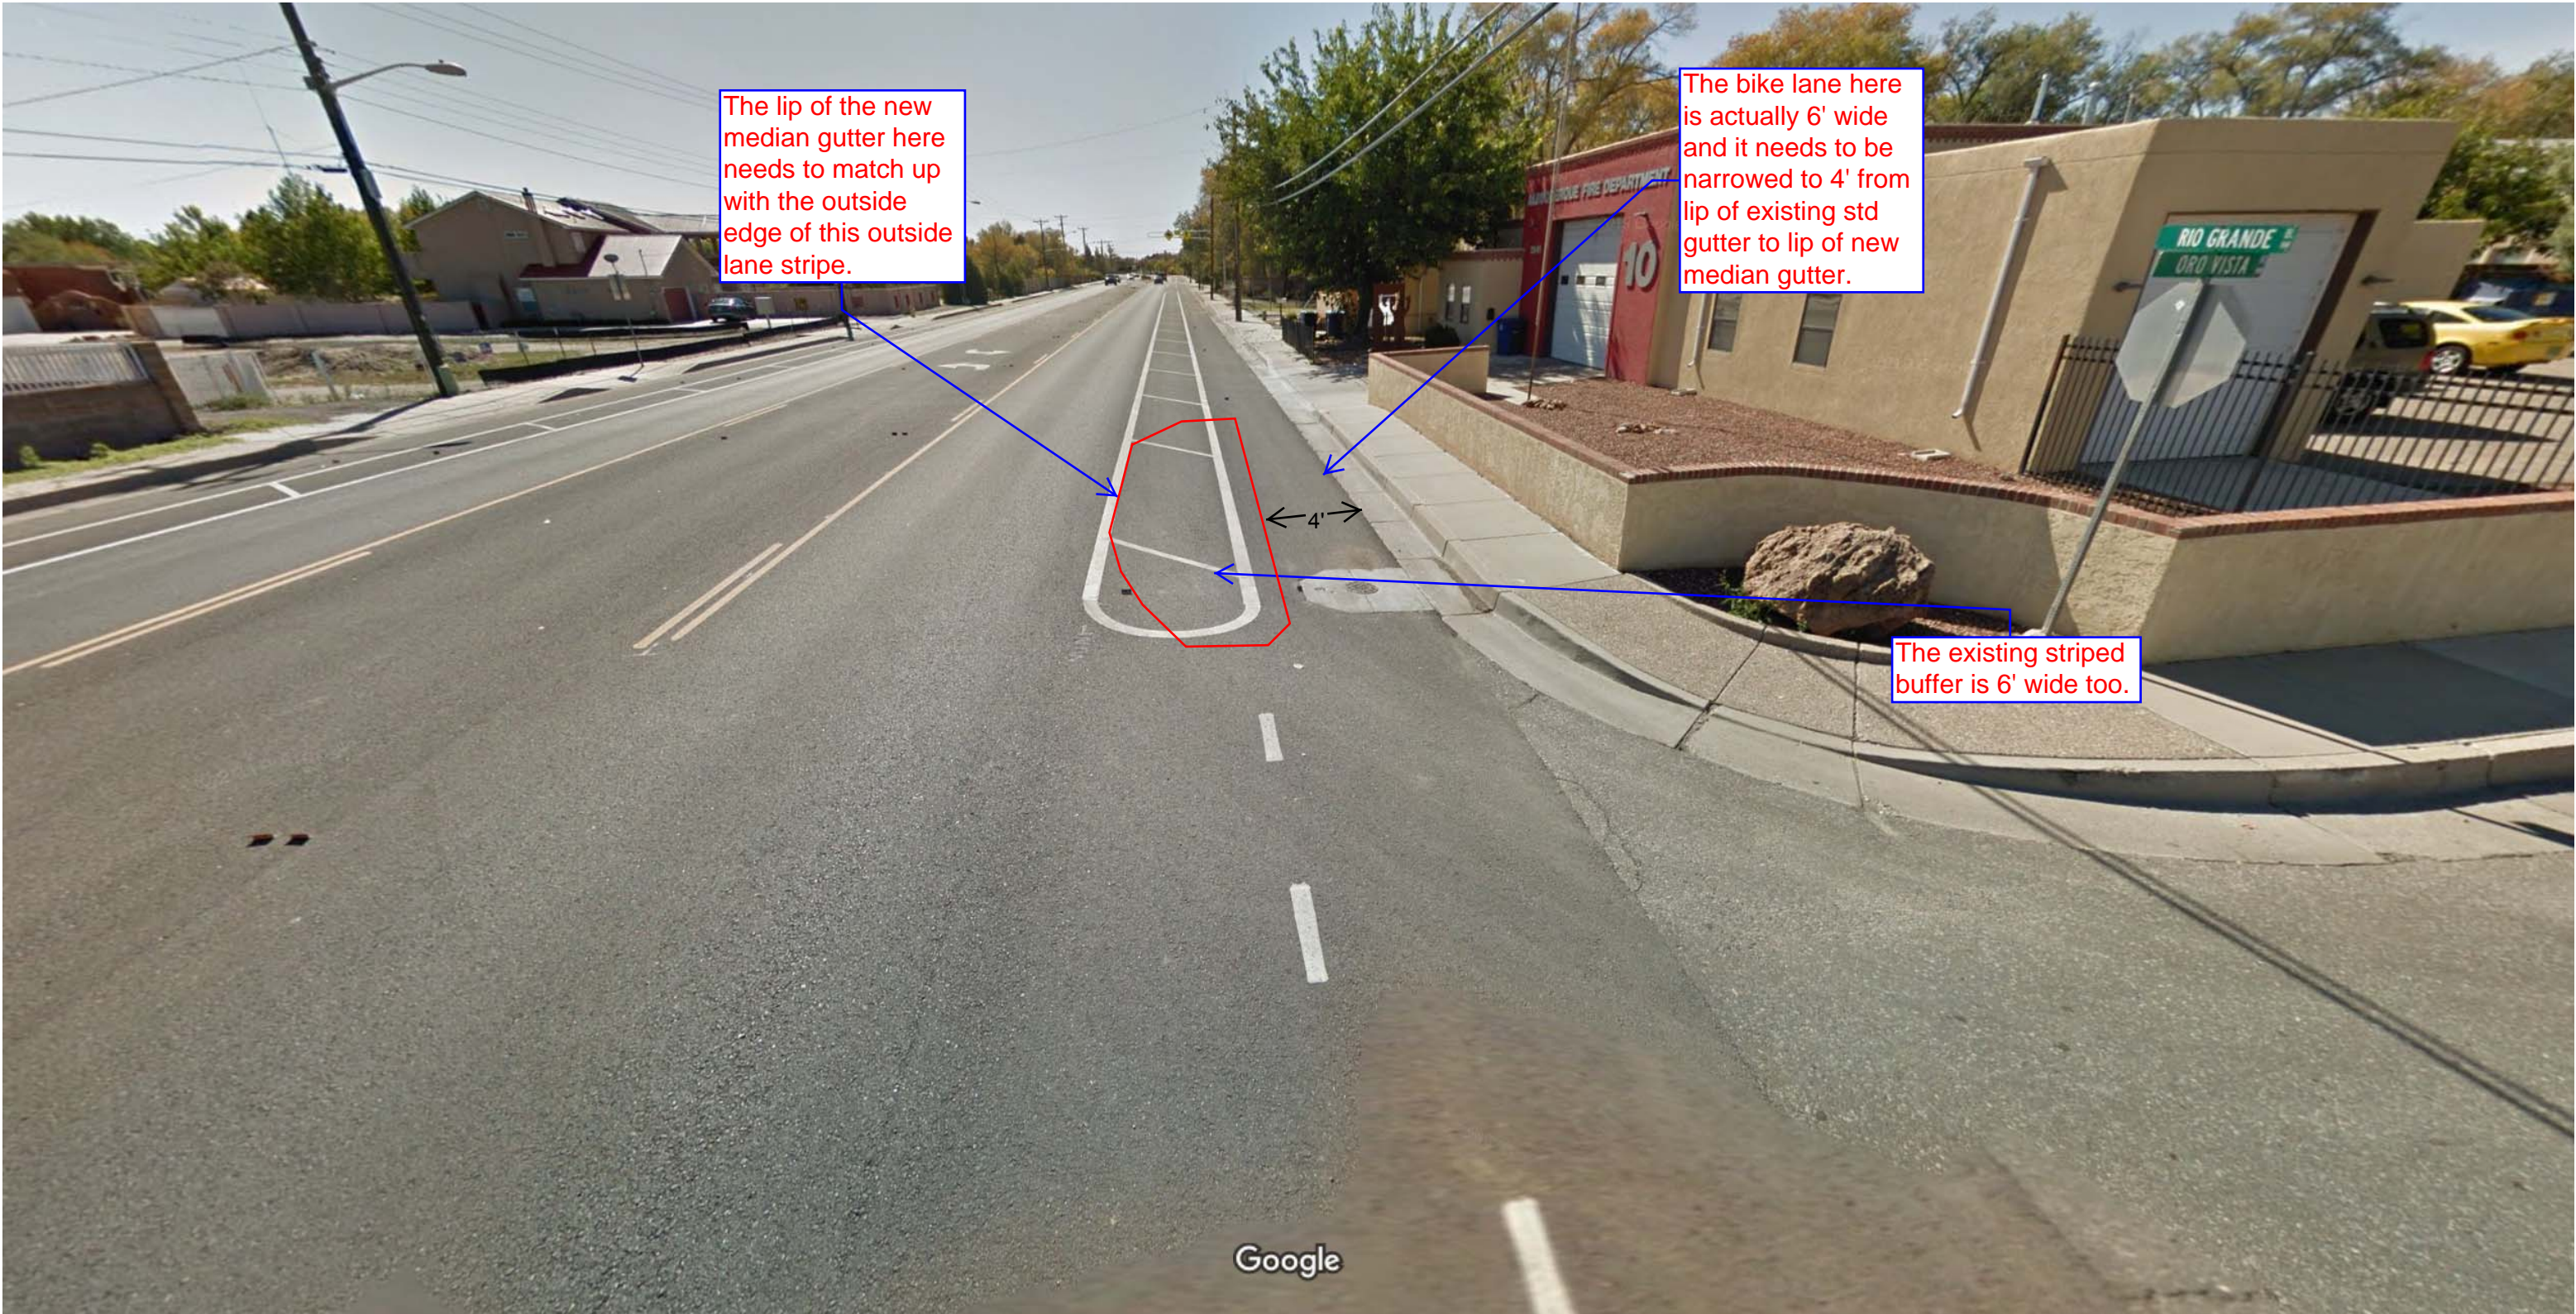



Work was constructed in compliance with details provided on previous pages and City of Albuquerque Standard Specifications and Drawings.

FOR
INFORMATION
ONLY

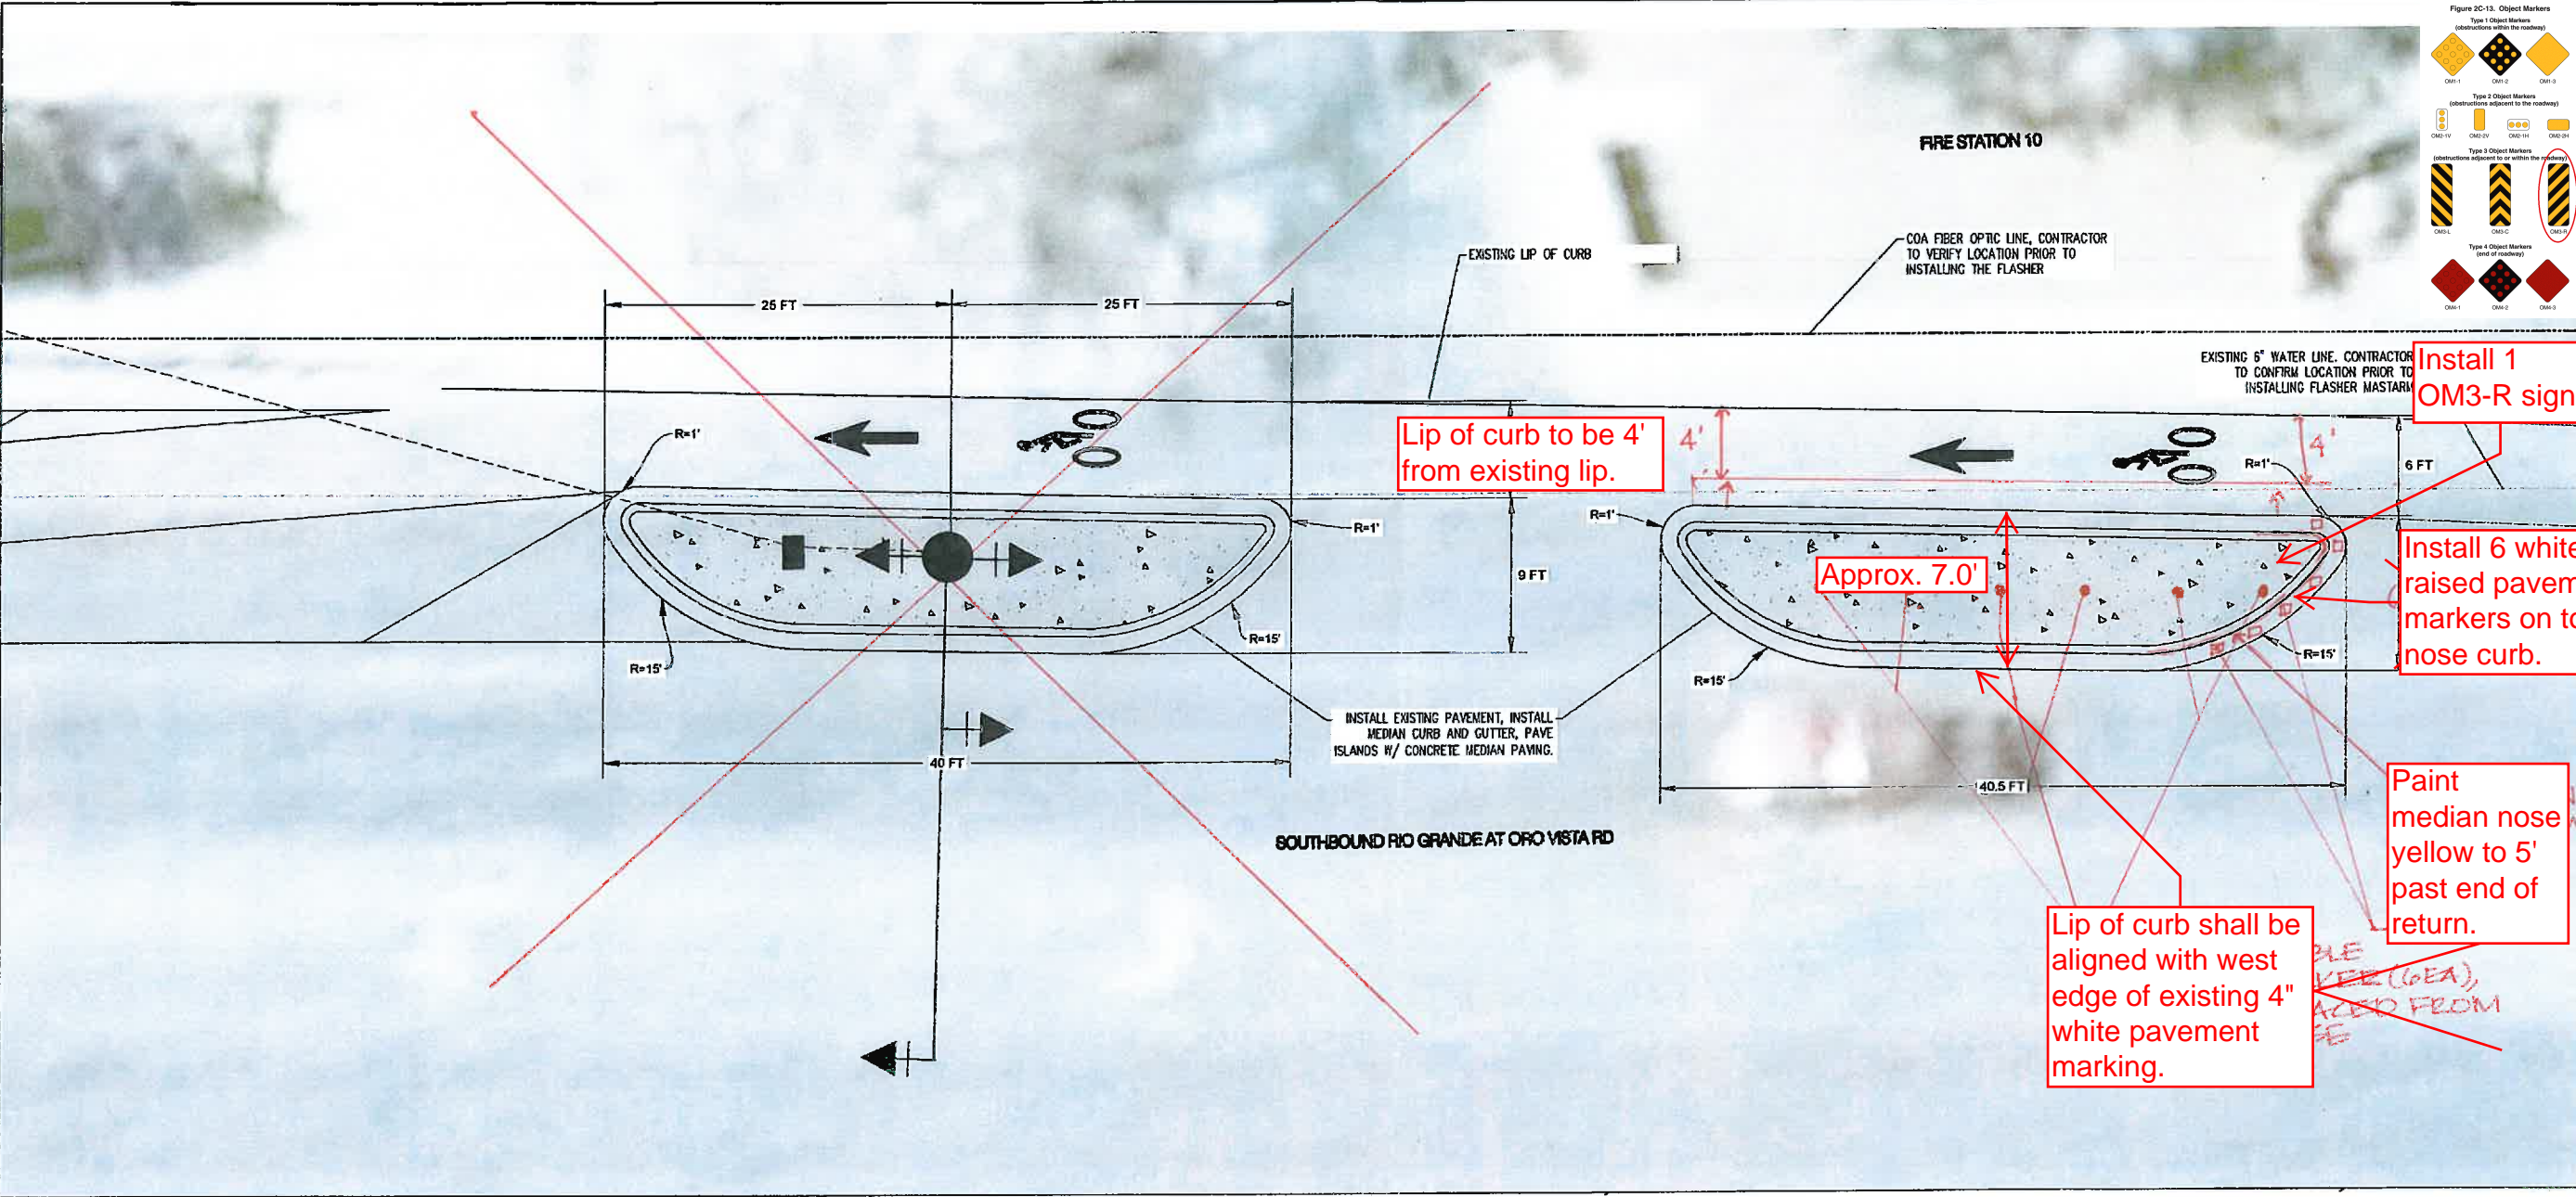


Figure 2C-13. Object Markers

Type 1 Object Markers (obstructions within the roadway)

OM1-1 OM1-2 OM1-3

Type 2 Object Markers (obstructions adjacent to the roadway)

OM2-1V OM2-2V OM2-3H OM2-4H

Type 3 Object Markers (obstructions adjacent to or within the roadway)

OM3-1 OM3-2 OM3-3

Type 4 Object Markers (end of roadway)

OM4-1 OM4-2 OM4-3

AS-BUILT INFORMATION		DATE
CONTRACTOR	DATE	
DESIGNED BY	DATE	
CHECKED BY	DATE	
INCHES RANGE BY	DATE	
VERIFICATION BY	DATE	
RECORDED BY	DATE	
MICRO-FILM INFORMATION		DATE
NO.	DATE	

BENCH MARKS		NO.	DATE
CONTRACTOR	DATE		
DESIGNED BY	DATE		
CHECKED BY	DATE		
INCHES RANGE BY	DATE		
VERIFICATION BY	DATE		
RECORDED BY	DATE		

SURVEY IN FIELD		NO.	DATE
CONTRACTOR	DATE		
DESIGNED BY	DATE		
CHECKED BY	DATE		
INCHES RANGE BY	DATE		
VERIFICATION BY	DATE		
RECORDED BY	DATE		

ENGINEER'S SEAL		NO.	DATE
CONTRACTOR	DATE		
DESIGNED BY	DATE		
CHECKED BY	DATE		
INCHES RANGE BY	DATE		
VERIFICATION BY	DATE		
RECORDED BY	DATE		

Bohannon & Huston
www.bhinc.com 800.877.5332

CITY OF ALBUQUERQUE
DEPARTMENT OF MUNICIPAL
DEVELOPMENT ENGINEERING DIVISION

FIRE STATION FLASHER CURB DETAILS

DESIGN REVIEW COMMITTEE	CITY ENGINEER APPROVAL	MO./DAY/YR.	MO./DAY/YR.

LAST DESIGN UPDATE

CITY PROJECT NO. 785406

ZONE MAP NO.

SHEET 16 OF 16

