





Remove and replace damaged asphalt pavement in three areas. Raise grade and add gravel and fabric to accommodate tree roots.

Sidewalks at Tree Roots

EXISTING CONDITION (PLAN VIEW):

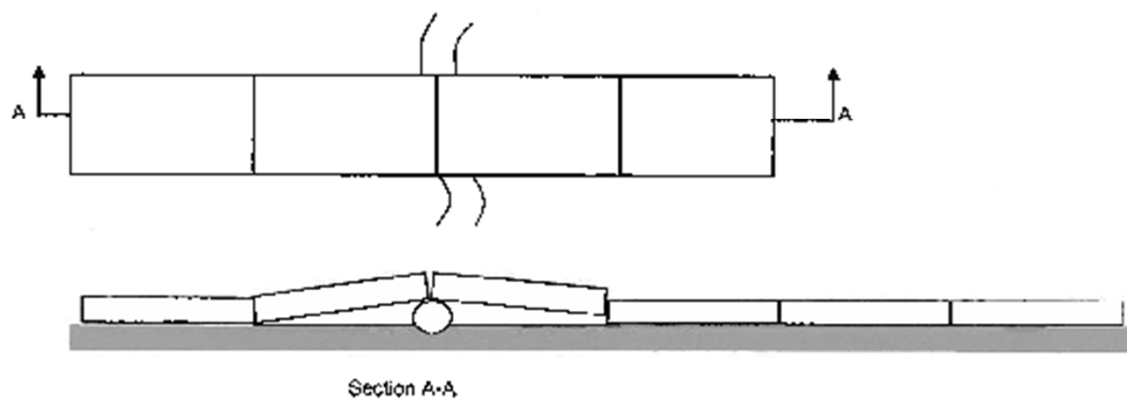

PROPOSED MITIGATION:

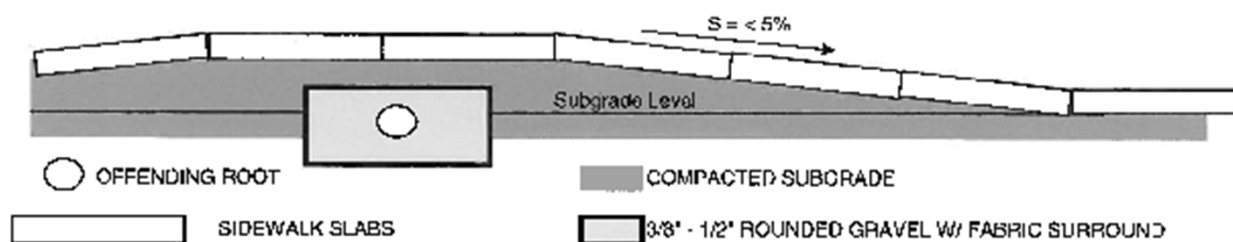



Work was constructed in compliance with details provided on previous pages and City of Albuquerque Standard Specifications and Drawings.

FOR
INFORMATION
ONLY



