


Ellison Road Repair

Legend

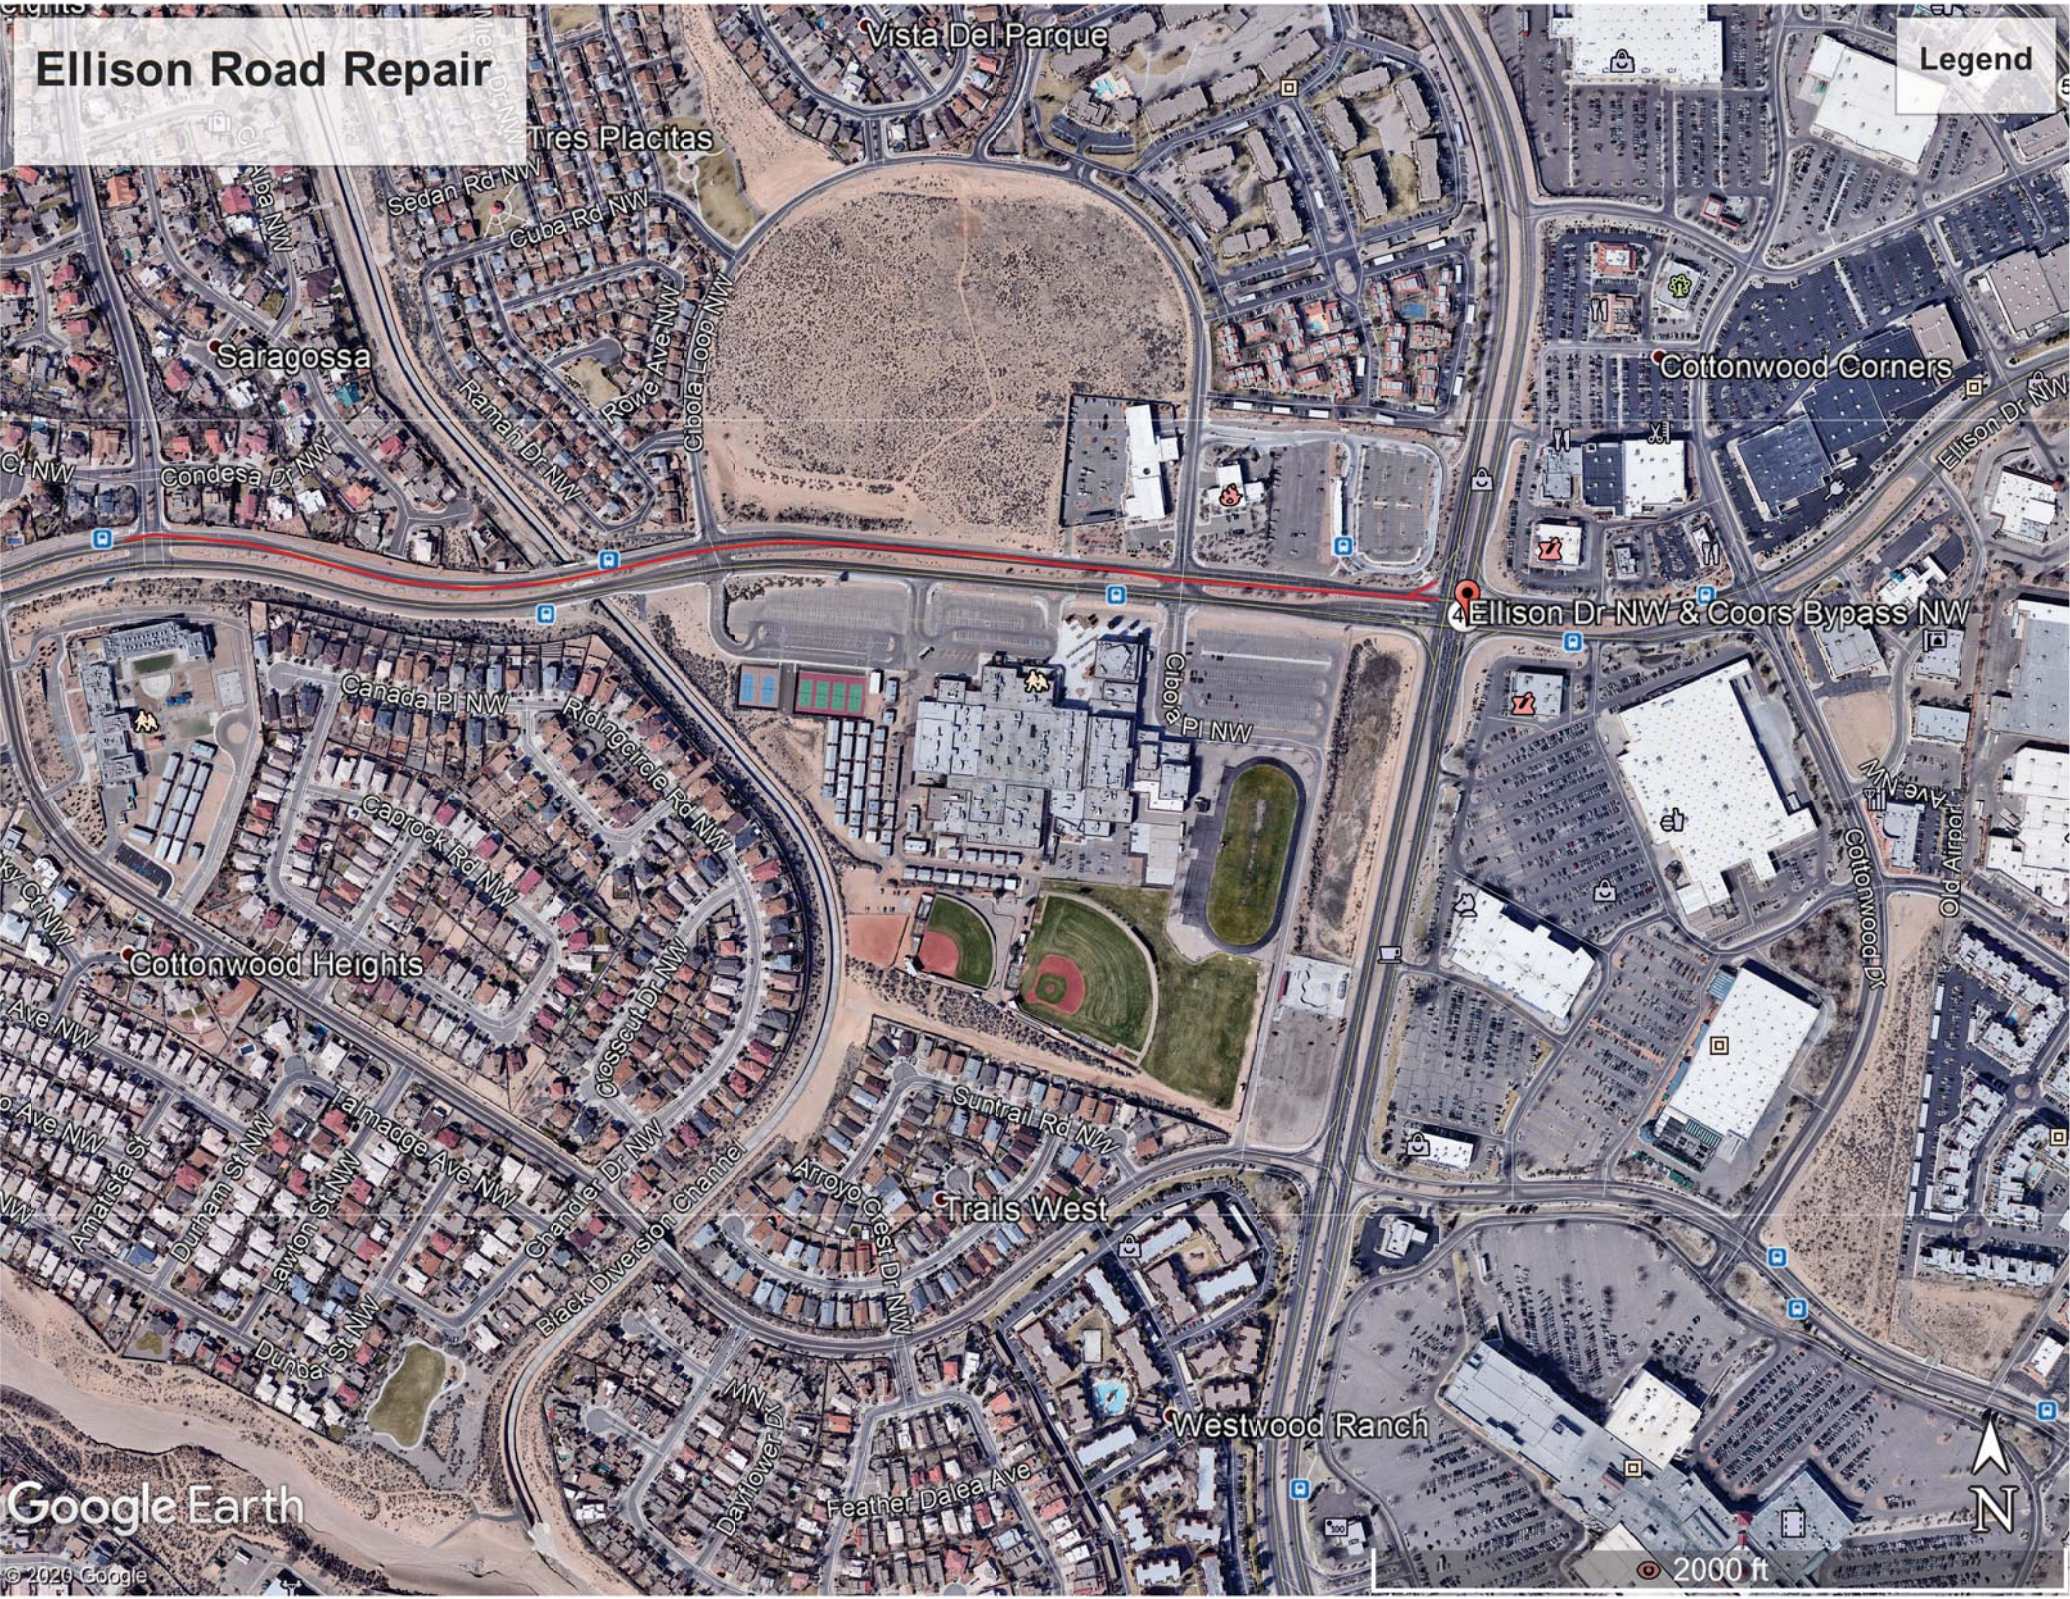

Google Earth

© 2020 Google



2000 ft

Work was constructed
per details provided on
previous pages and
City of Albuquerque
Standard Specifications

FOR INFORMATION ONLY



Work was constructed
per details provided on
previous pages and
City of Albuquerque
Standard Specifications

FOR INFORMATION ONLY



Work was constructed
per details provided on
previous pages and
City of Albuquerque
Standard Specifications

FOR INFORMATION ONLY

