




Add ADA Ramp

Add 5 to 6 ft wide sidewalk

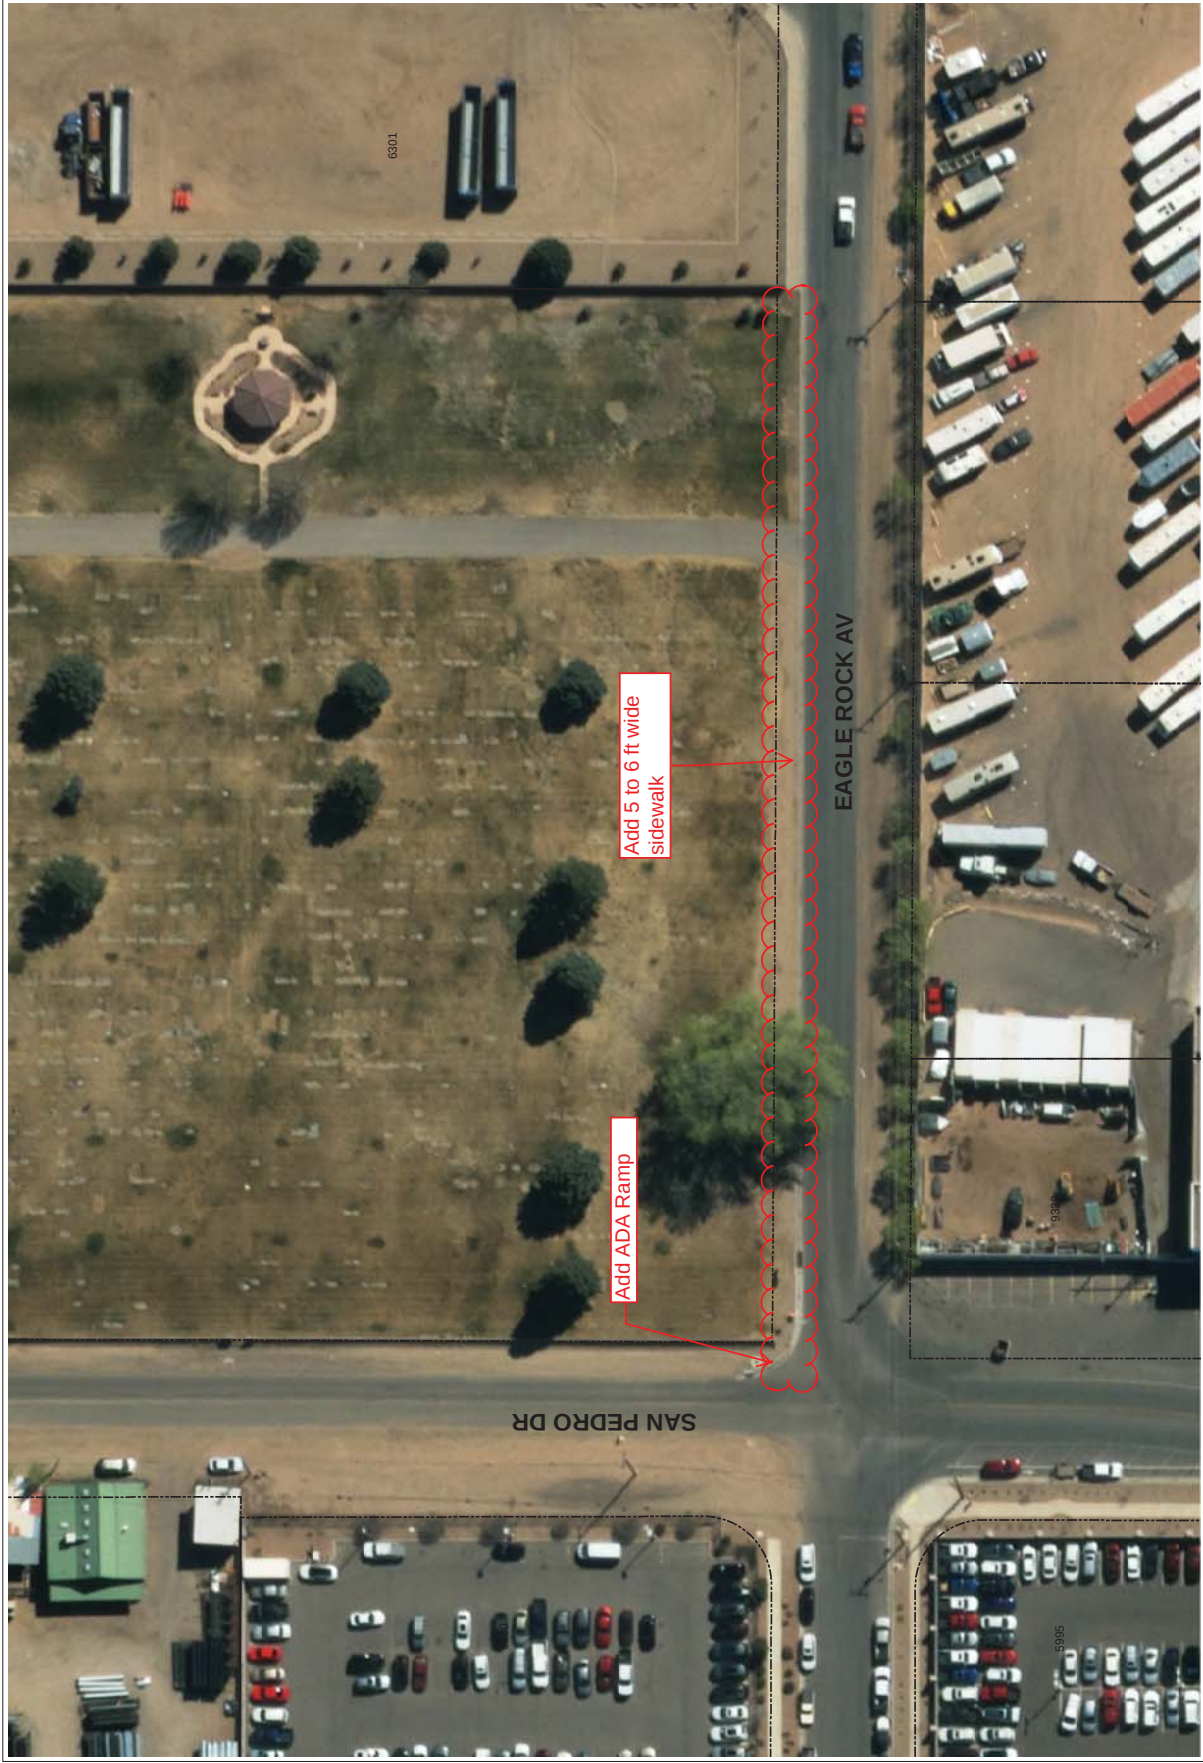

San Pedro and Eagle Rock Sidewalk Project