



Google Maps Vassar Dr NE & Phoenix Ave NE

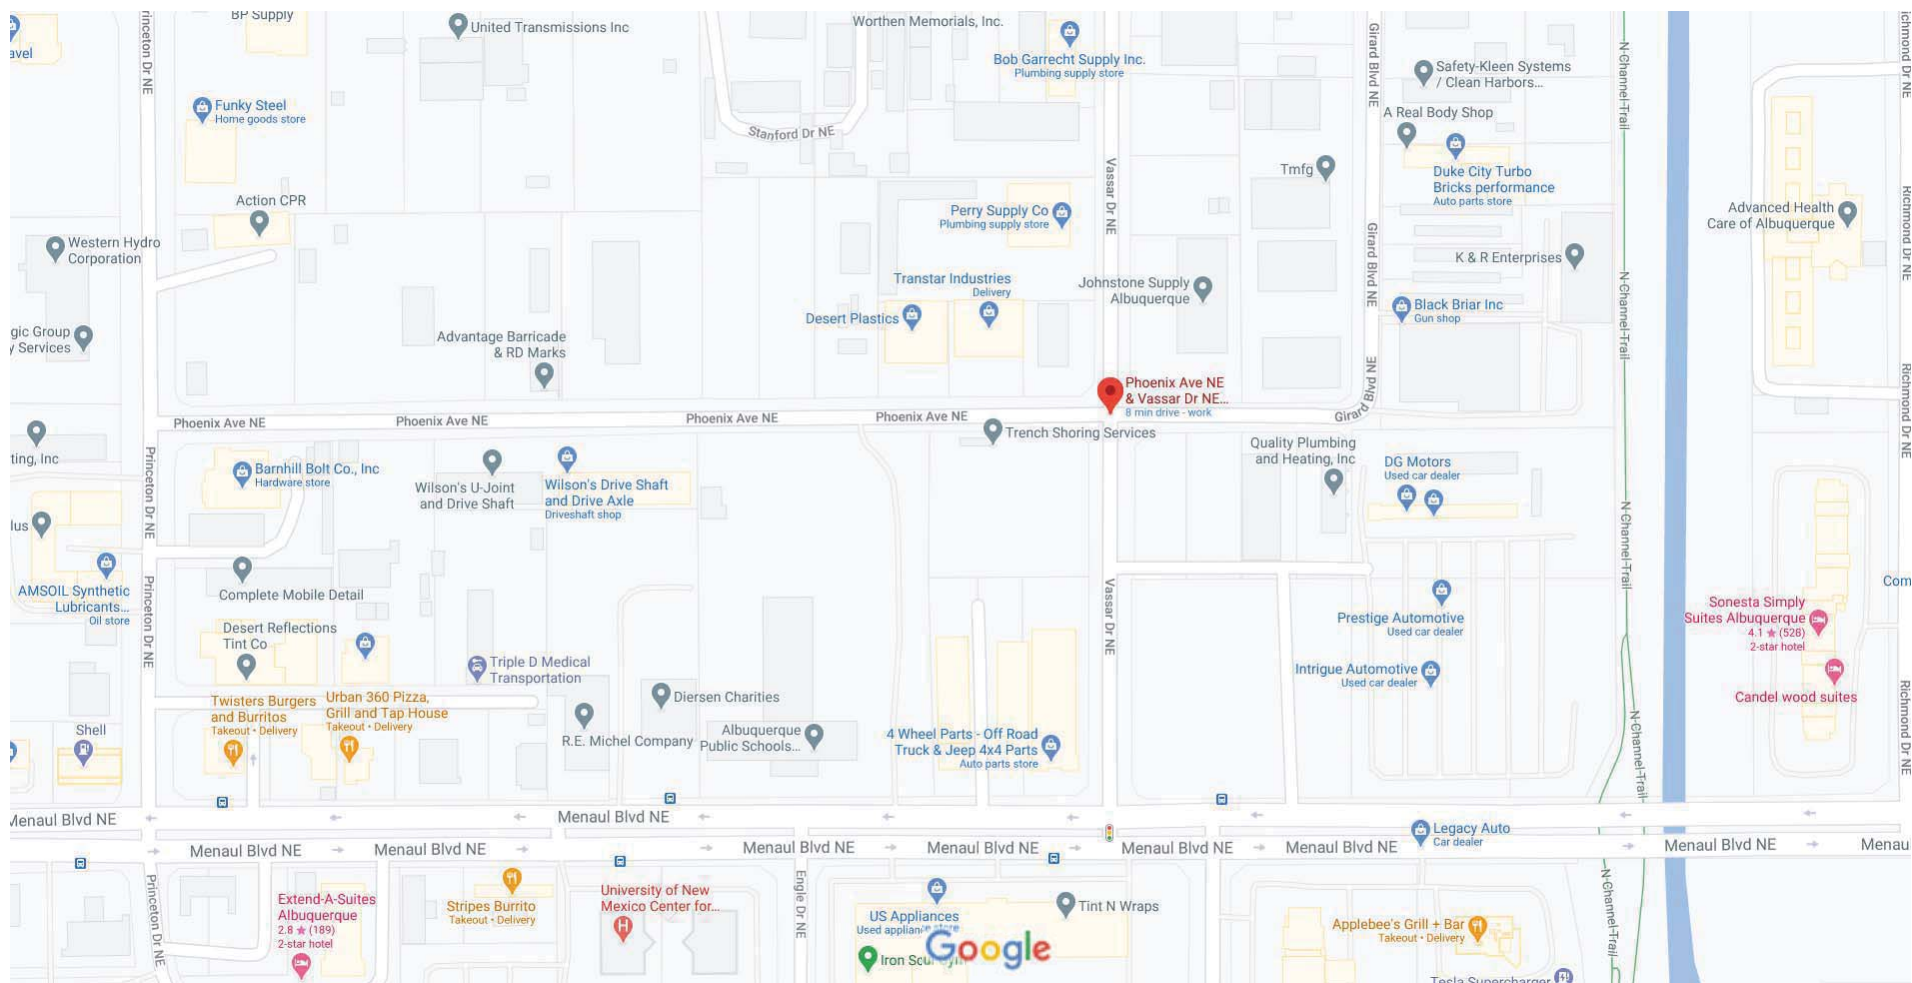


Map data ©2021 Google 100 ft

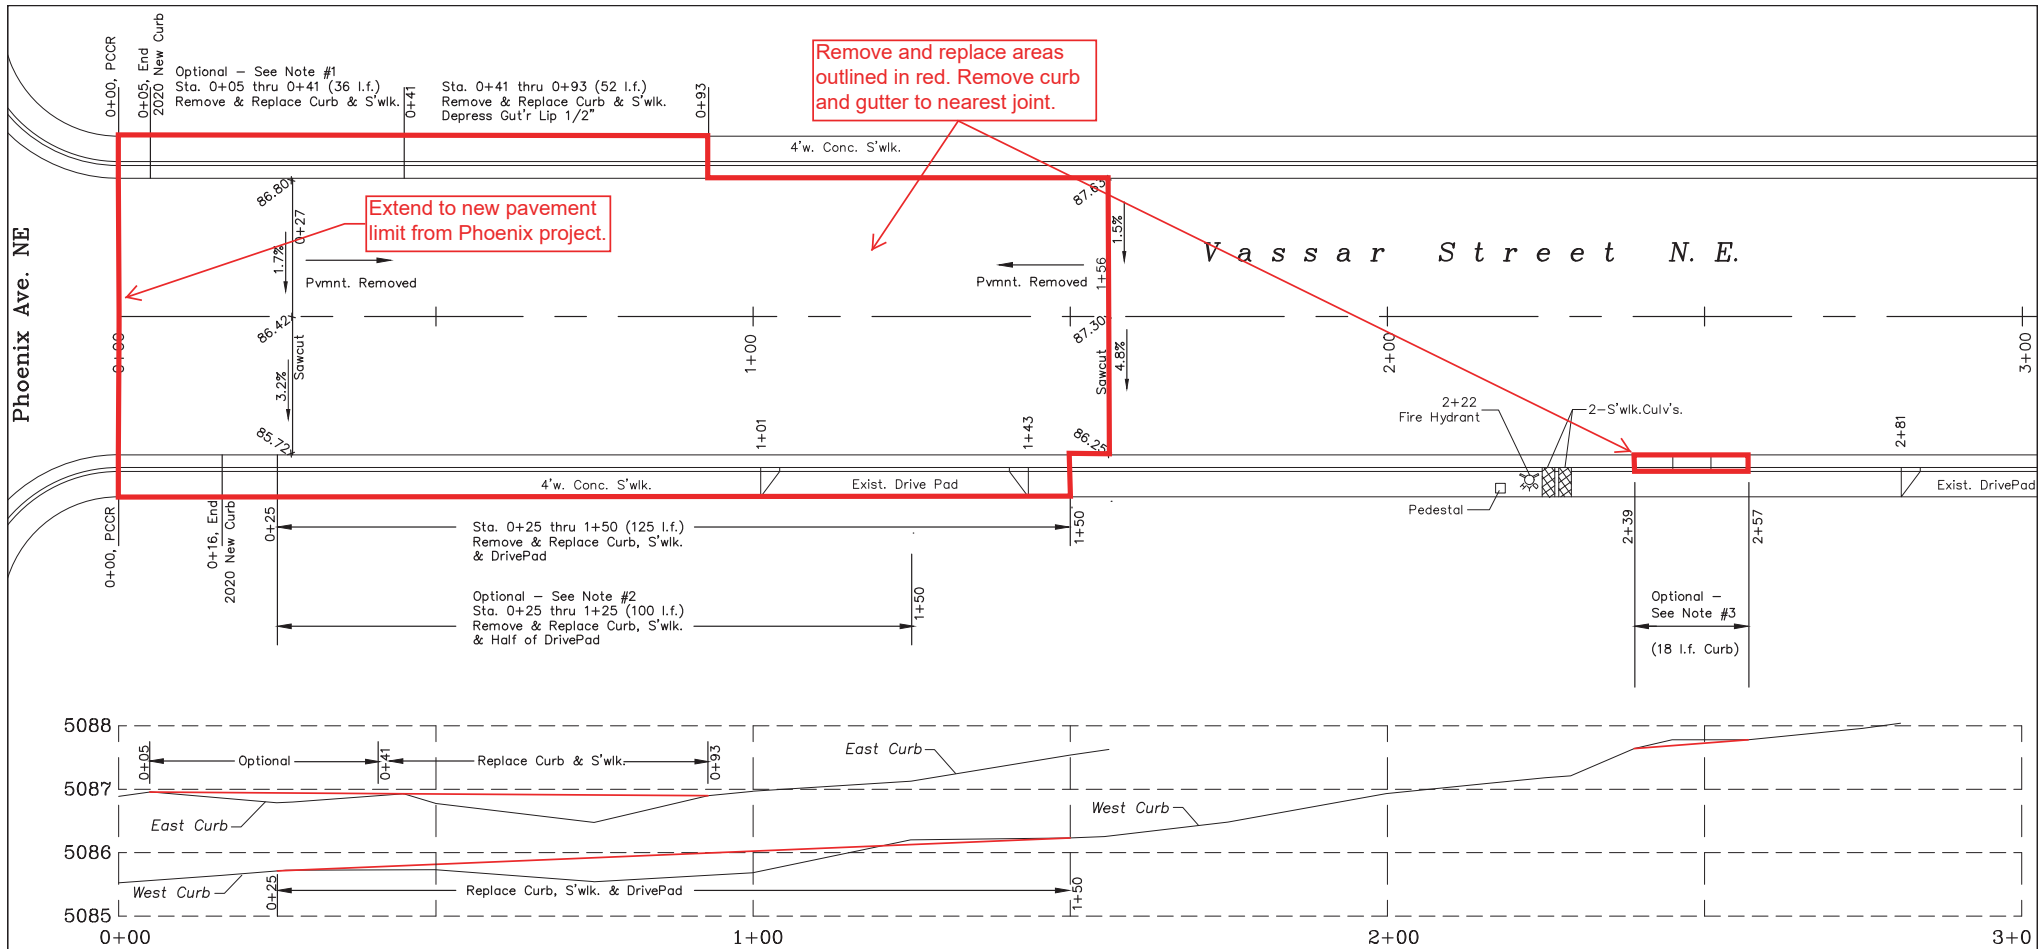

Notes Regarding Work Options:

1. Though the curb profile line has a dip, there is sufficient cross slope to prevent drainage problems.
2. The east one half of the driveway measures level, and could remain.
3. 2 curb stones measure level. By removing one additional curbstone to the north, the flowline could be re-shaped to provide positive slope. 18 l.f. total curb replacement.

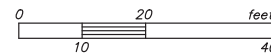

Scales: 1"=20' Horiz.
1"= 2' Vert.

Street Reconstruction Vassar Street, South of Phoenix Ave. N.E. Due to Waterline Break

City of Albuquerque, New Mexico
Department of Municipal Development
Contractor: Franklins Earthmoving, Inc.

March, 2021

