

WORK ORDER #80????


MATHESON PARK

Menaul Blvd to Candelaria

Eubank to Juan Tabo

General Location Map



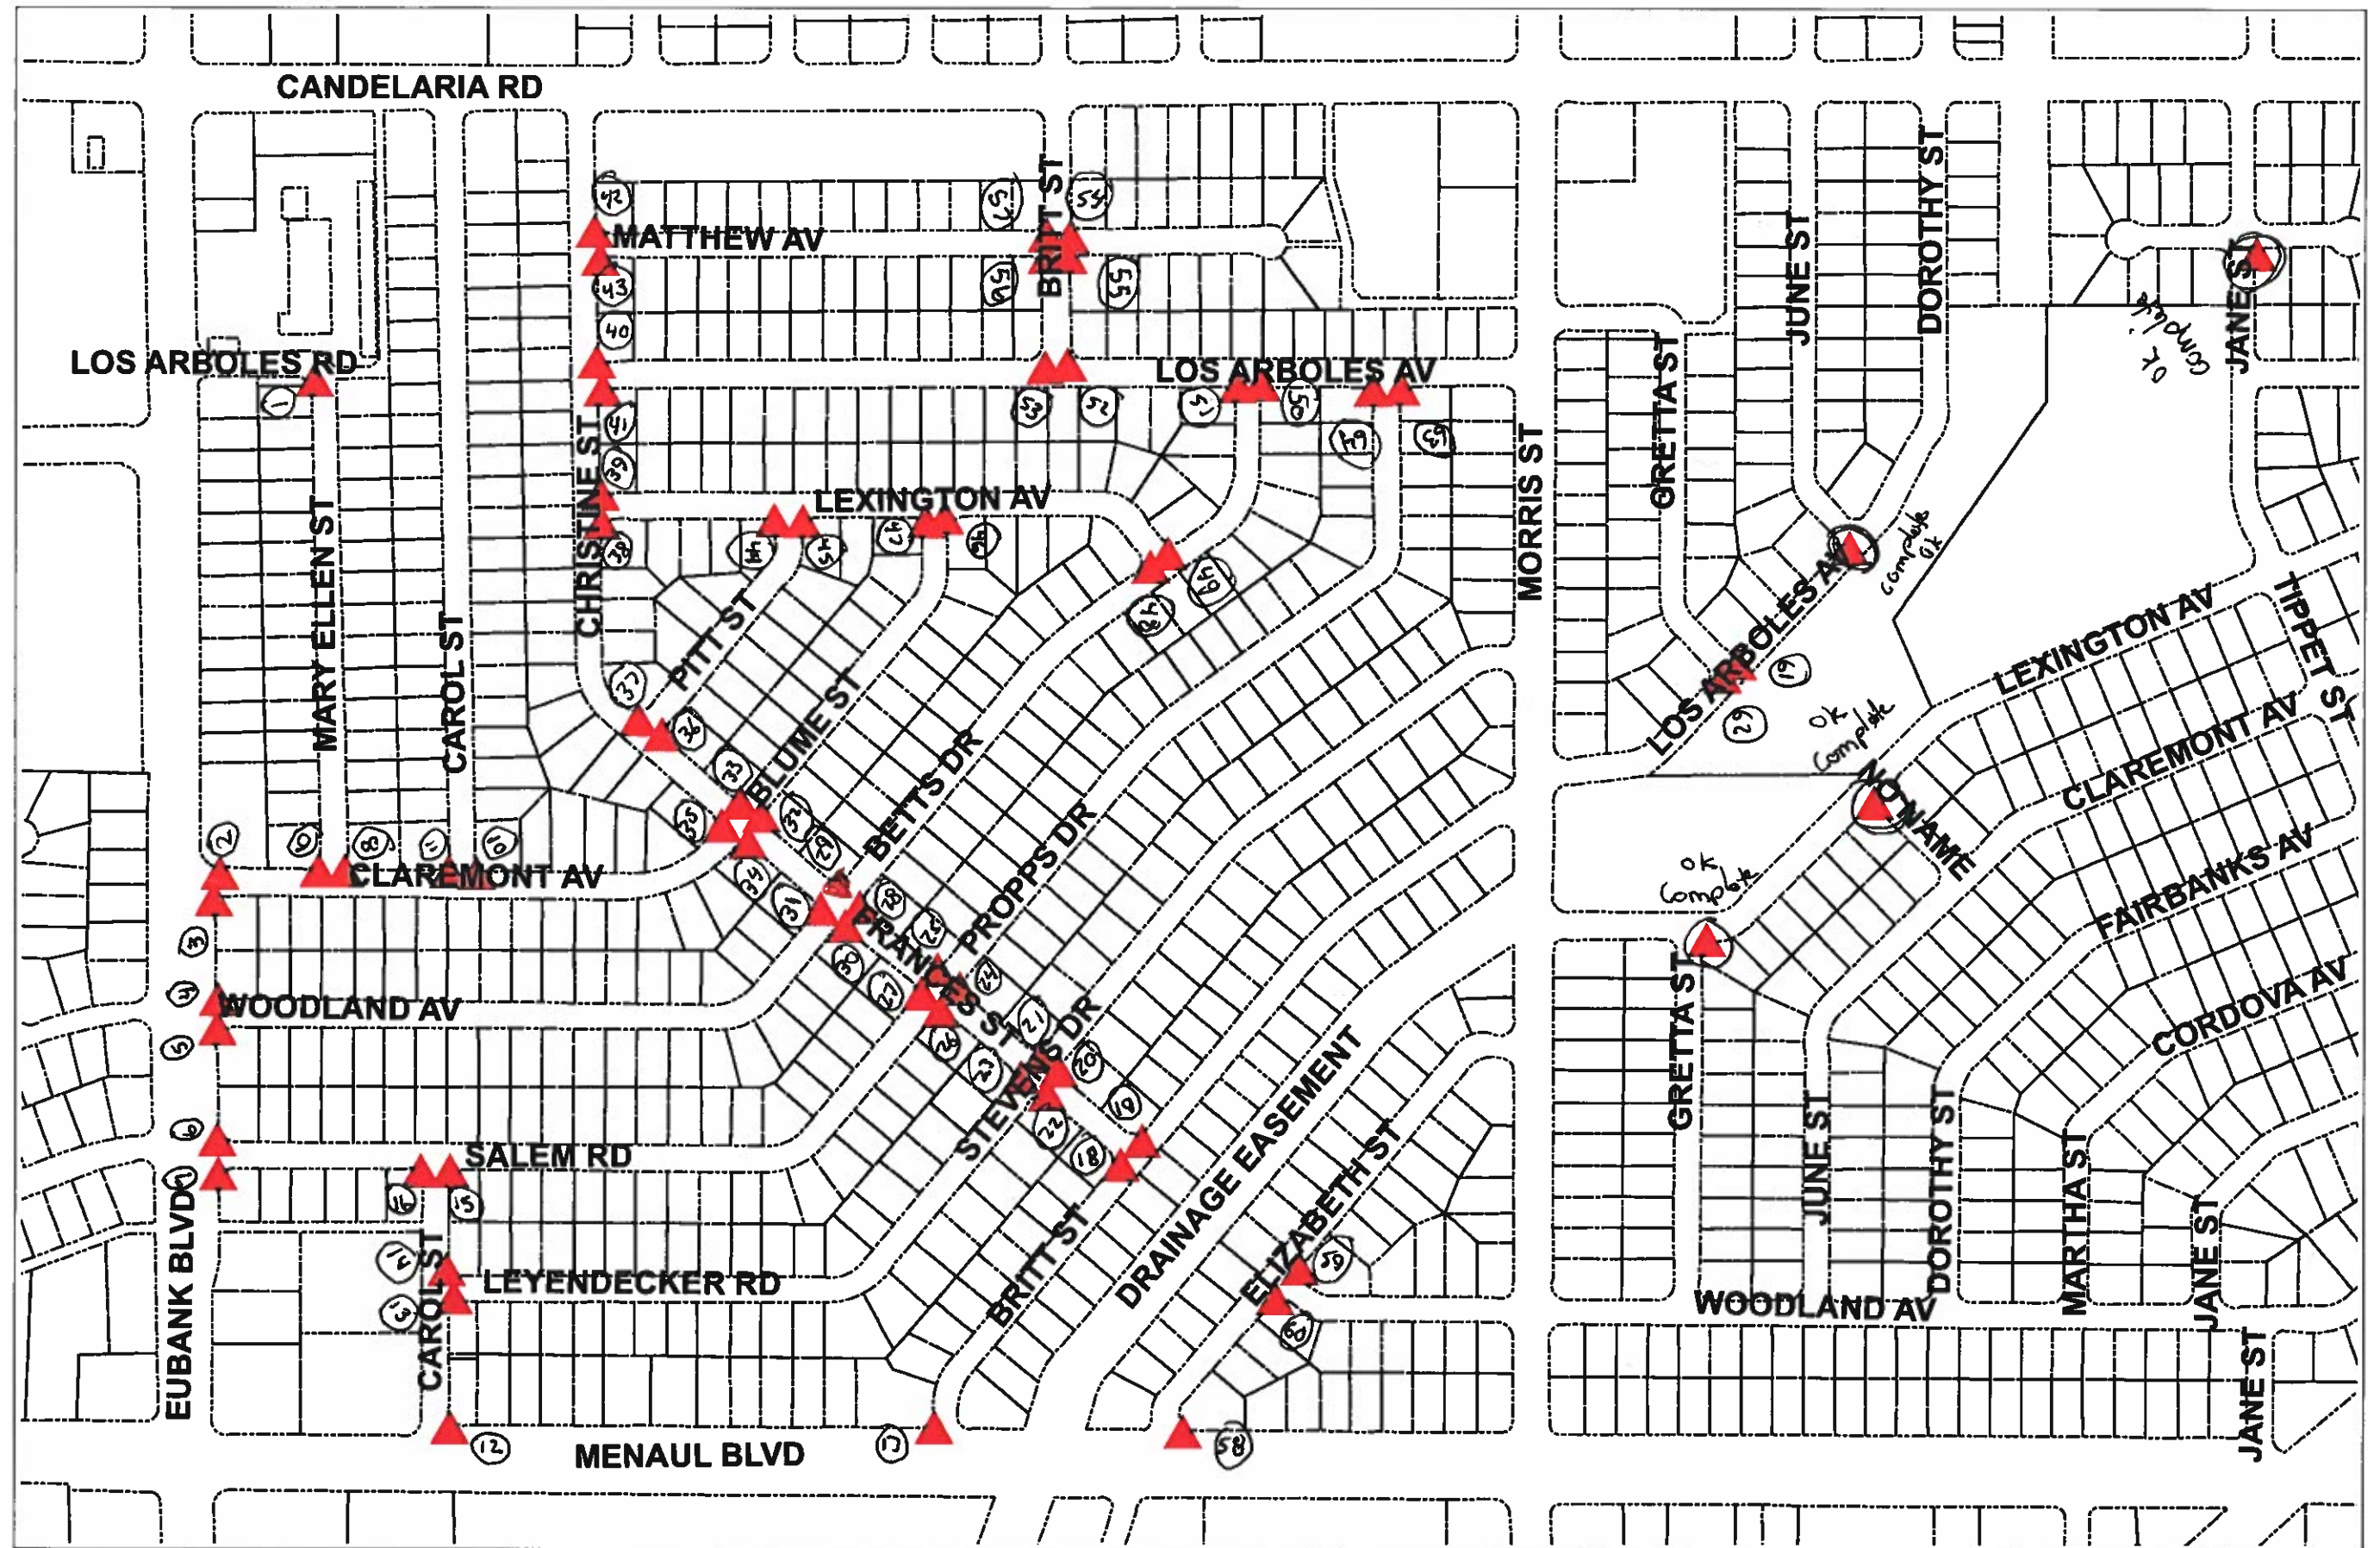

MATHESON PARK

No Neighborhood Association
Missing 67 ADA Curb Ramps (approx. \$221K)

▲ Missing ADA Ramp



0 120 240 480 Feet