


Google Maps 7901 Lomas Blvd NE

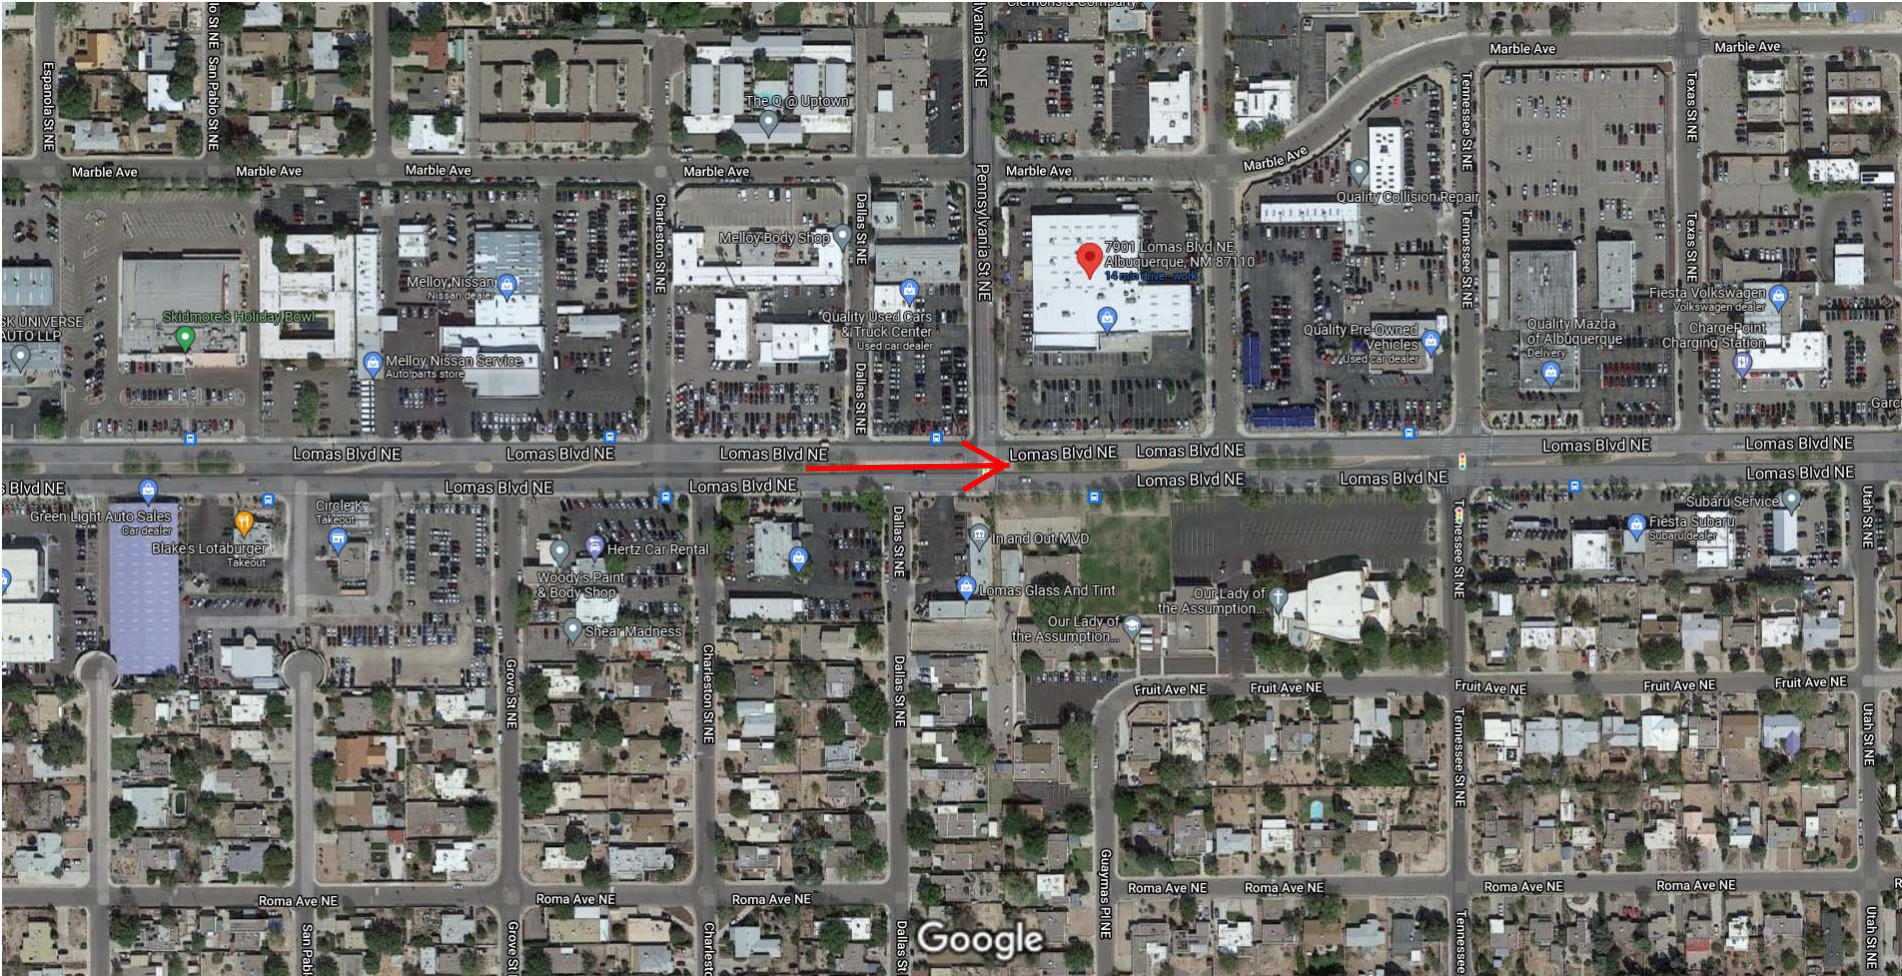

Imagery ©2021 Maxar Technologies, NMRGIS, U.S. Geological Survey, USDA Farm Service Agency, Map data ©2021 100 ft

East Median

Construct new pedestrian refuge pass through in existing median, relocate pull box. Replace with new large pull box.

Striping to be performed by others.

Google

NE Corner

Reconstruct ramp and concrete around vault lid, adjust pull box to grade. Replace with new large pull box. Do not remove existing curb.

Relocate ped pole, add curb

Google

Image capture: Jun 2019 © 2021 Google

Albuquerque, New Mexico



Street View - Jun 2019



