




8201 Osuna Rd NE, Albuquerque, NM 87109





Remove all dirt and debris from in front of curb.

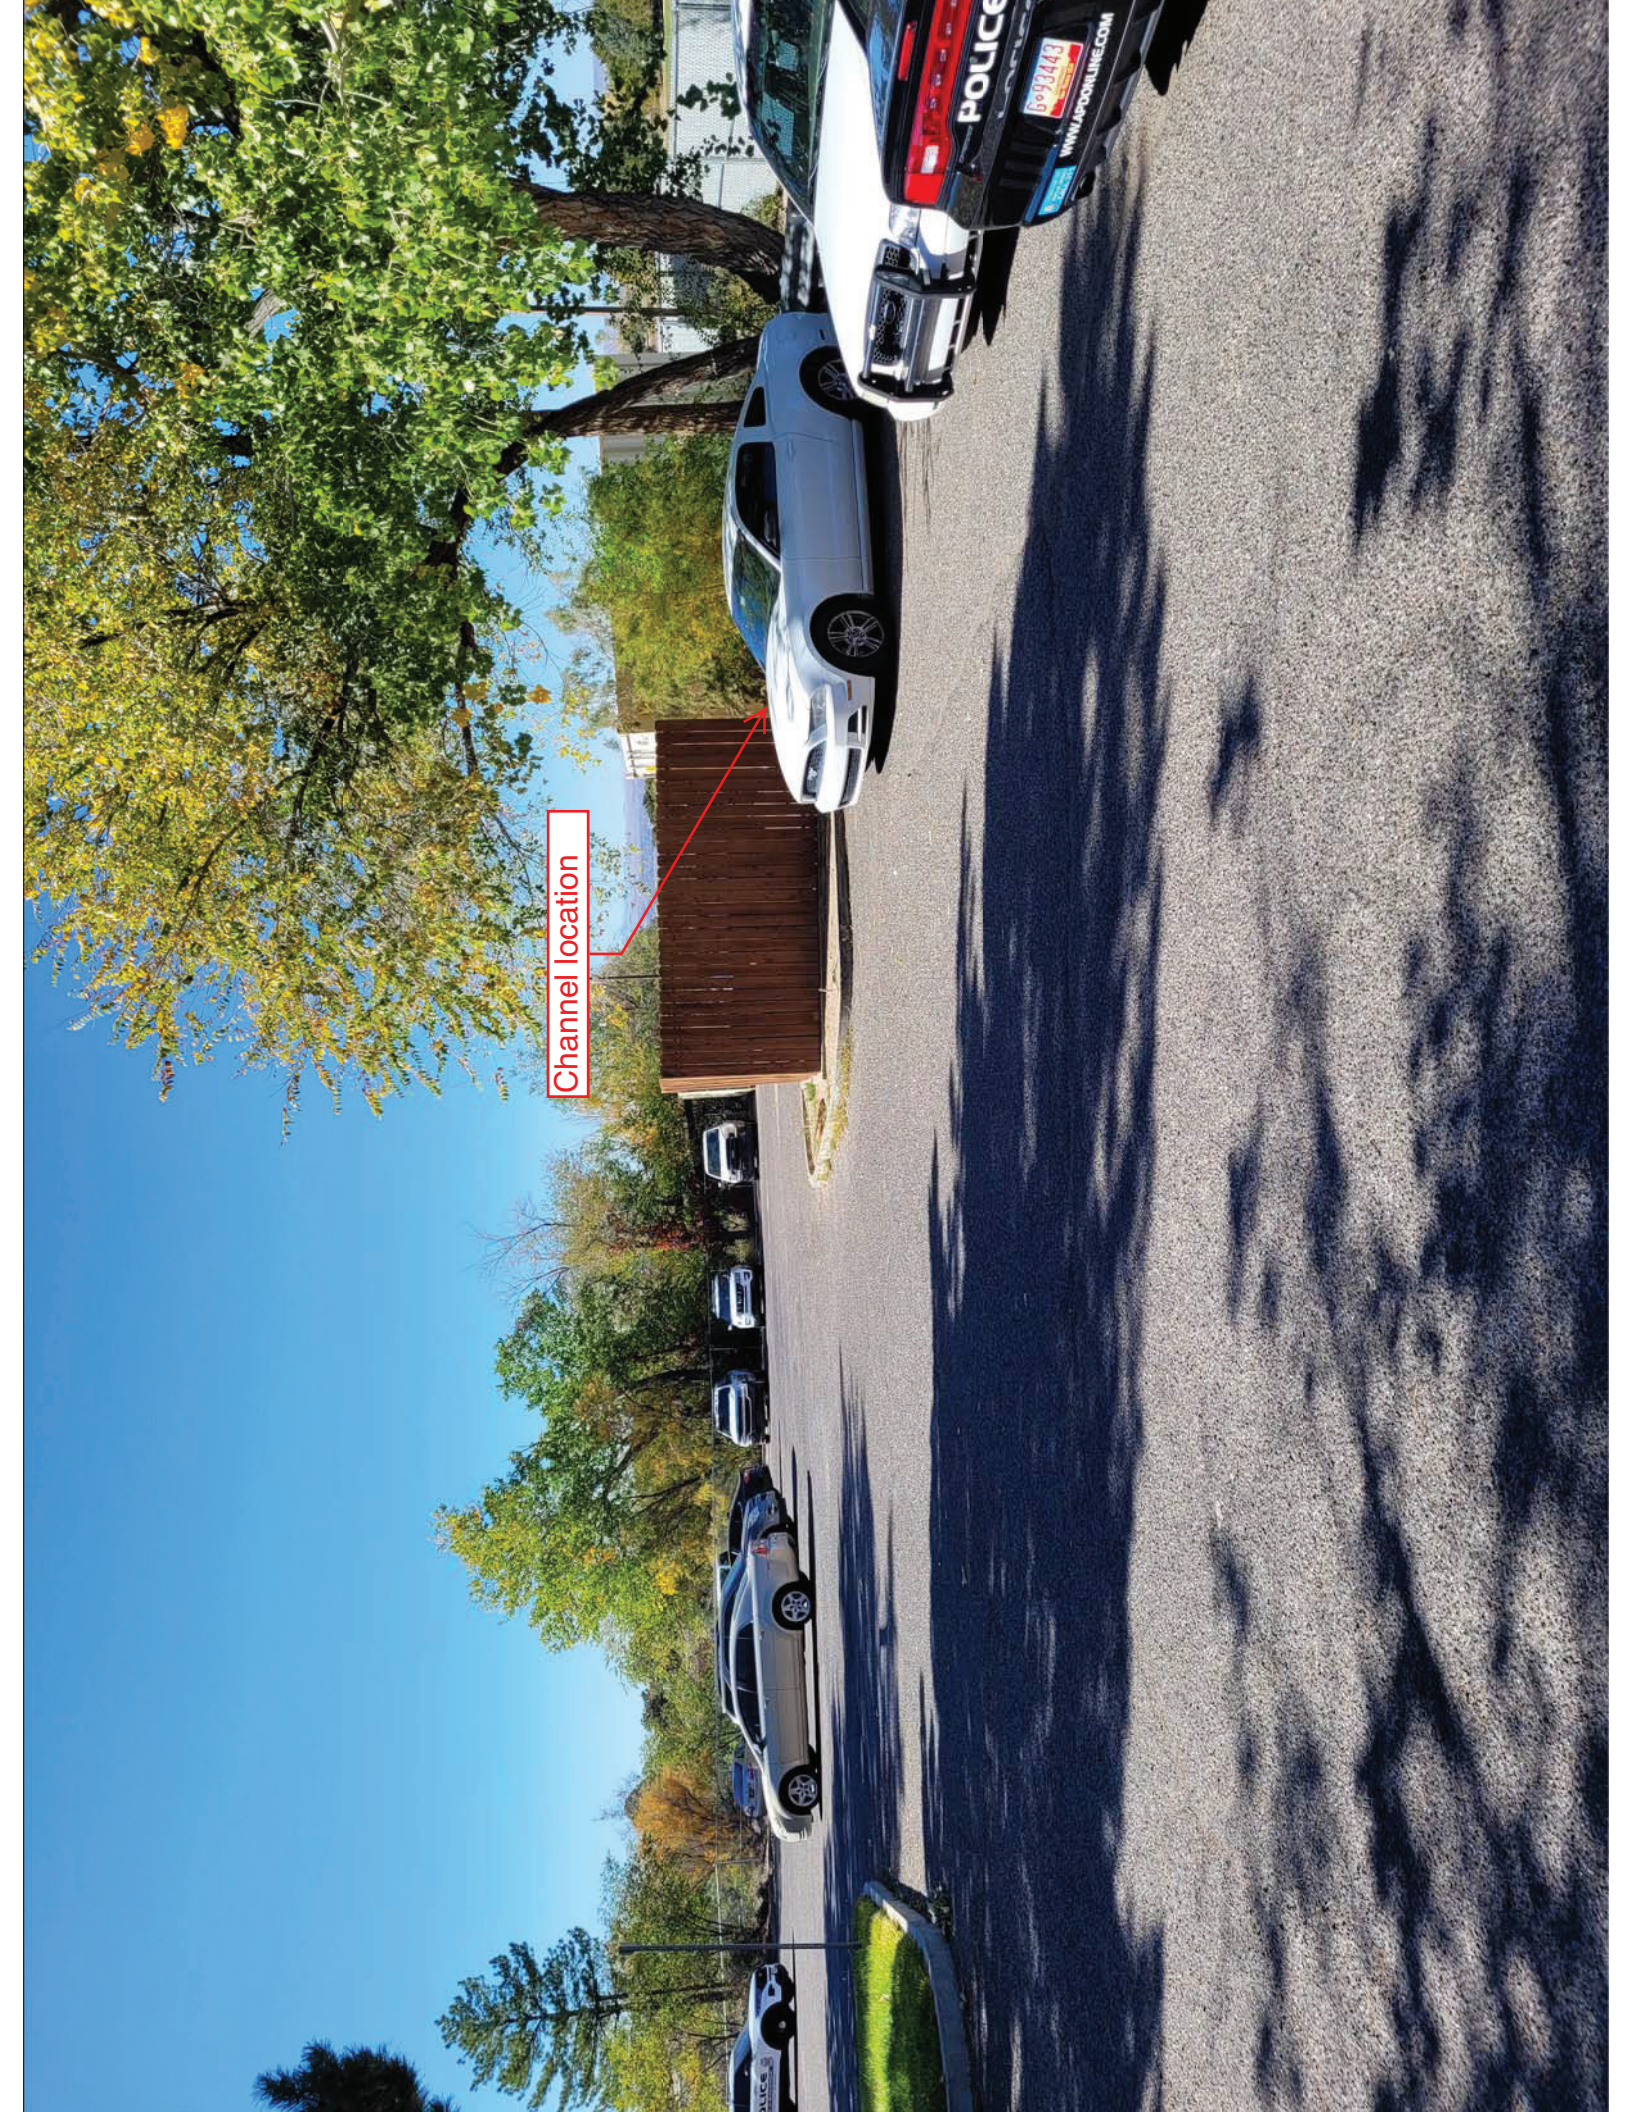

Channel location



Upstream channel
connection



Construct approx. 20 LF of 3' wide
4" concrete channel with raised
curbs; tie to existing asphalt



Downstream
channel
connection.
Remove 3 LF of
existing curb.