





Albuquerque, New Mexico  
Google Street View  
Jan 2023 See more dates

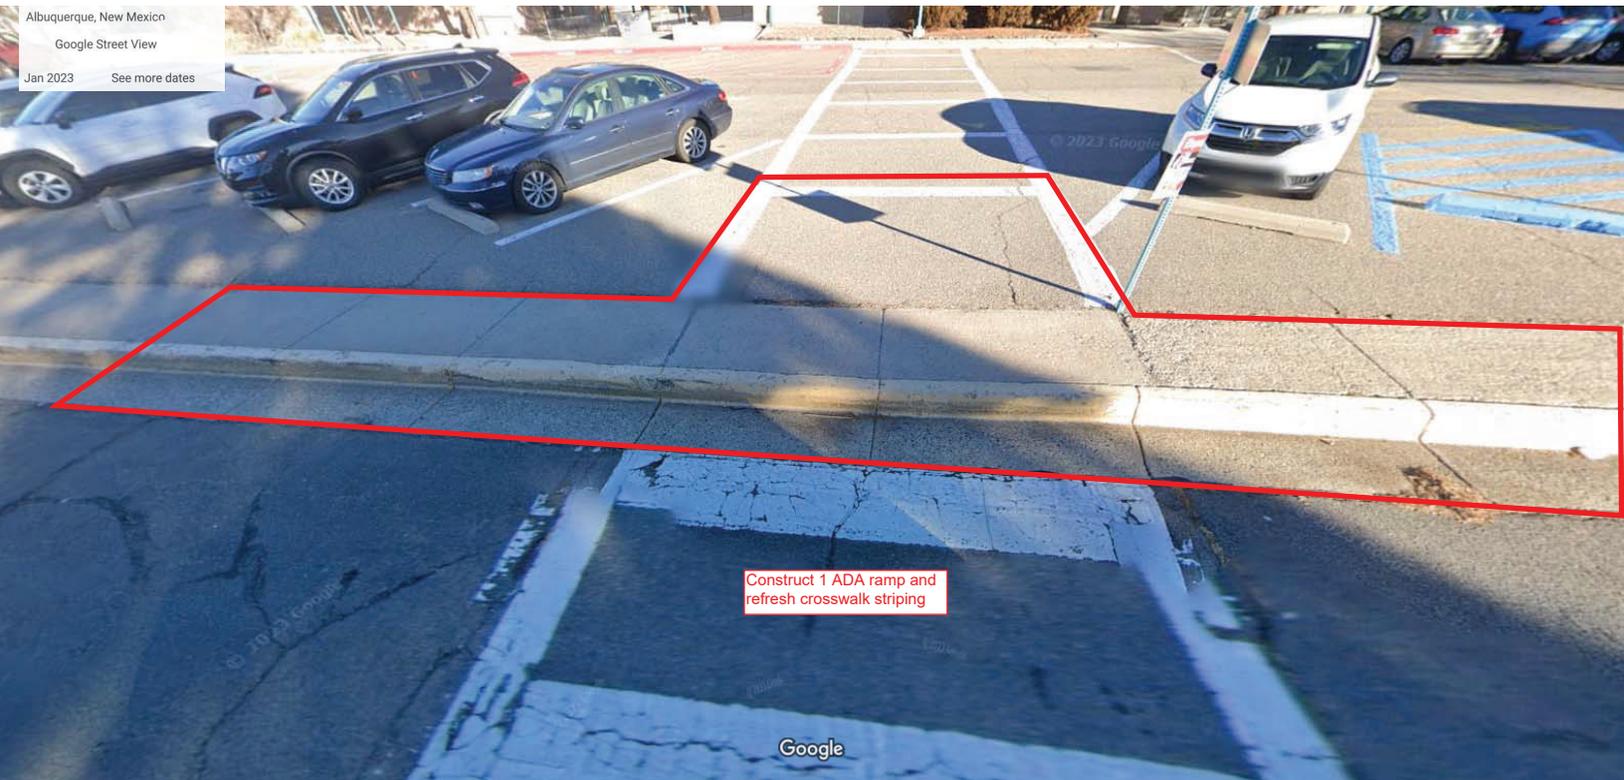

Construct 1 ADA ramp and refresh crosswalk striping

Google

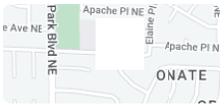

Albuquerque, New Mexico  
Google Street View  
Apr 2019 See more dates



Google



Work was constructed per details provided on previous pages and City of Albuquerque Standard Specifications  
FOR INFORMATION ONLY



Work was constructed per details provided on previous pages and City of Albuquerque Standard Specifications  
FOR INFORMATION ONLY



Work was constructed per details provided on previous pages and City of Albuquerque Standard Specifications  
FOR INFORMATION ONLY

