
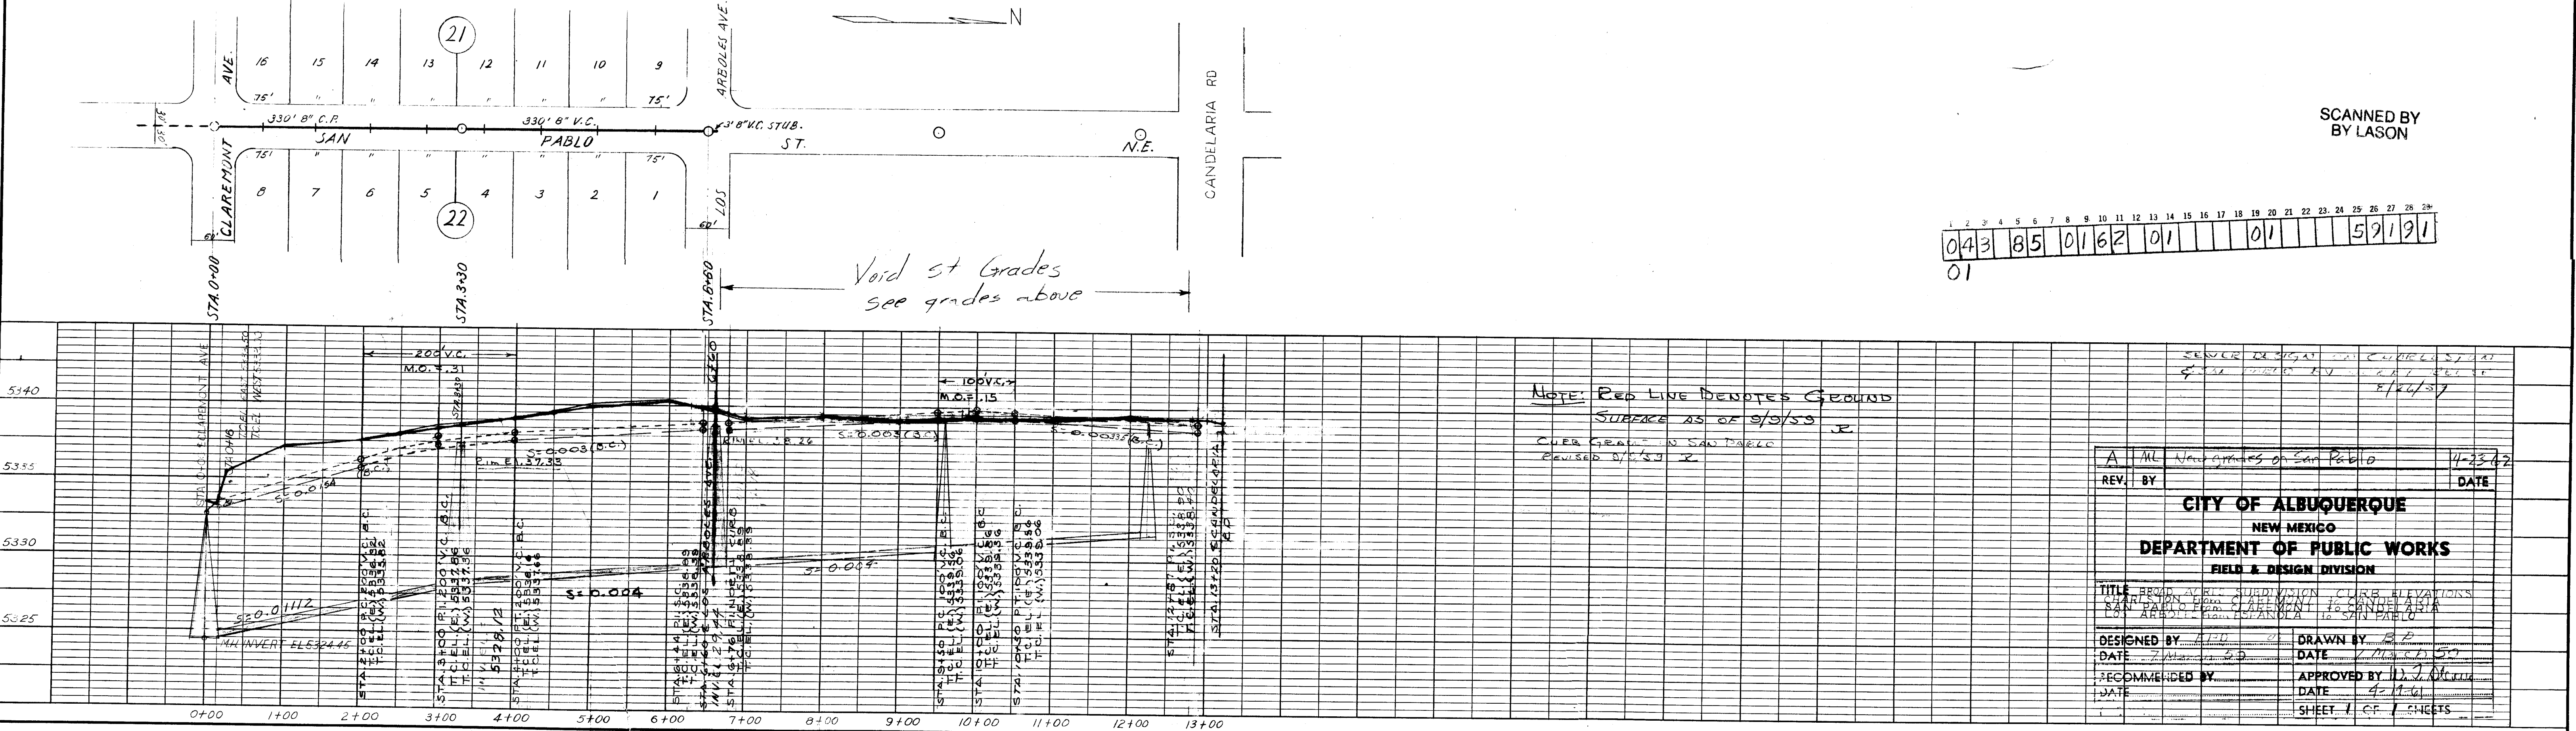


PLAN	SURVEYED	DATE
	NOTE BOOK	BY
	ALIGNMENT CHECKED	
	NO.	

PROFILE	SURVEYED	DATE
	NOTE BOOK	BY
	STRUCTURE NOTATIONS	
	NO.	

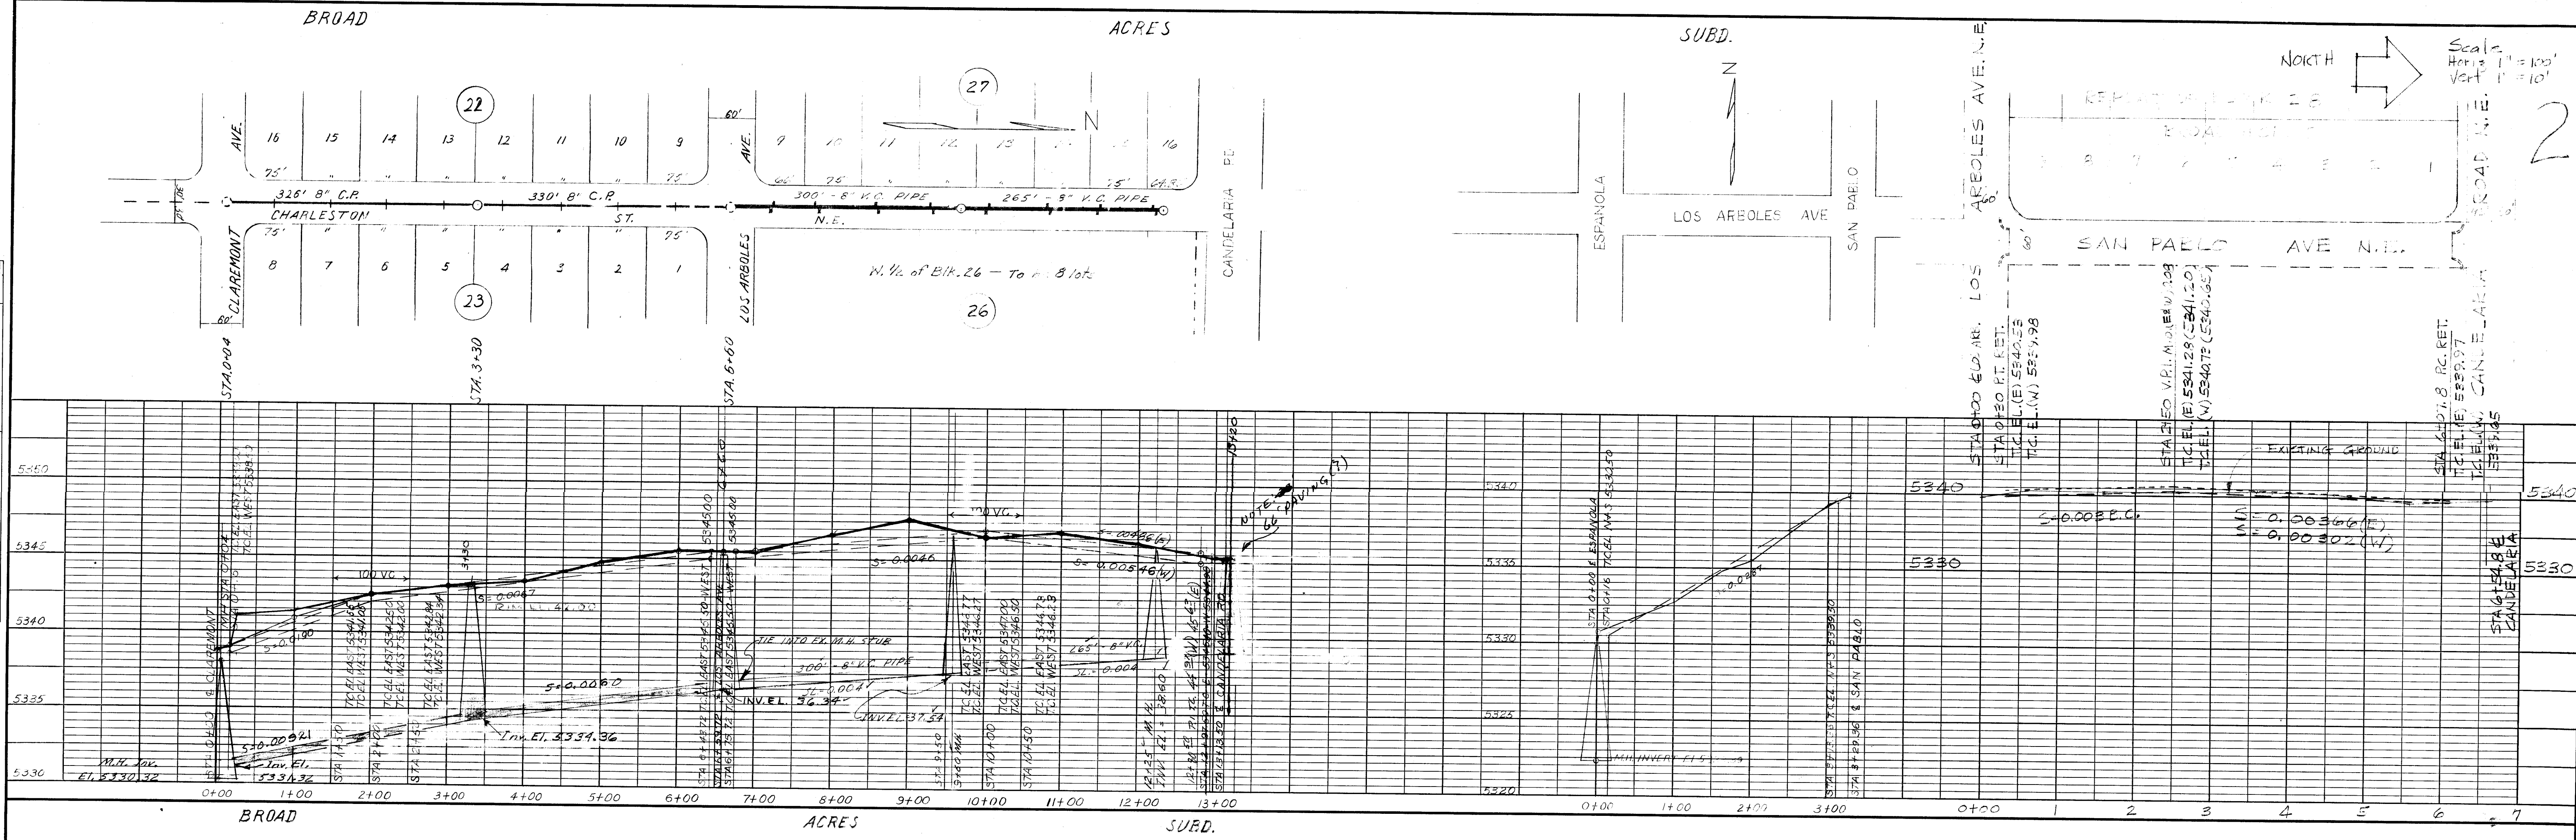

1	2	3	4	5	6	7	8	9	10	11	12	13	14	15	16	17	18	19	20	21	22	23	24	25	26	27	28	29	30
043	85	01	62	01																									
01																													

NOTE: Red Line Denotes Ground Surface as of 9/9/55
CURB GRADE IN SAN PABLO
REVISED 9/9/55

REV.	BY	DATE
A	ML	4-23-62
CITY OF ALBUQUERQUE NEW MEXICO DEPARTMENT OF PUBLIC WORKS FIELD & DESIGN DIVISION		
TITLE: Broad Acres Subdivision, Curbs, Elevations, San Pablo Ave. to Candelaria Rd. Arboles Ave. to Candelaria Rd.		
DESIGNED BY	DRAWN BY	DATE
DATE	DATE	DATE
RECOMMENDED BY	APPROVED BY	DATE
DATE	DATE	DATE
SHEET 1 OF 1 SHEETS		