

Red Robin WB Approach



Install 2 new breakaway bollards or delineators (spacing 4' center to center, approximately 3' from face of curb).

Remove and replace existing signs. Use OM4-1 signs.

Remove bollard, cable and post.

Red Robin EB Approach

Install 2 new bollards or delineators (spacing 4' center to center, approximately 3' from face of curb)

Reinstall and align existing wood post.

Remove existing sign.
Replace with OM4-1 sign.

Install OM4-1 sign.

Remove bollard, post and cable.

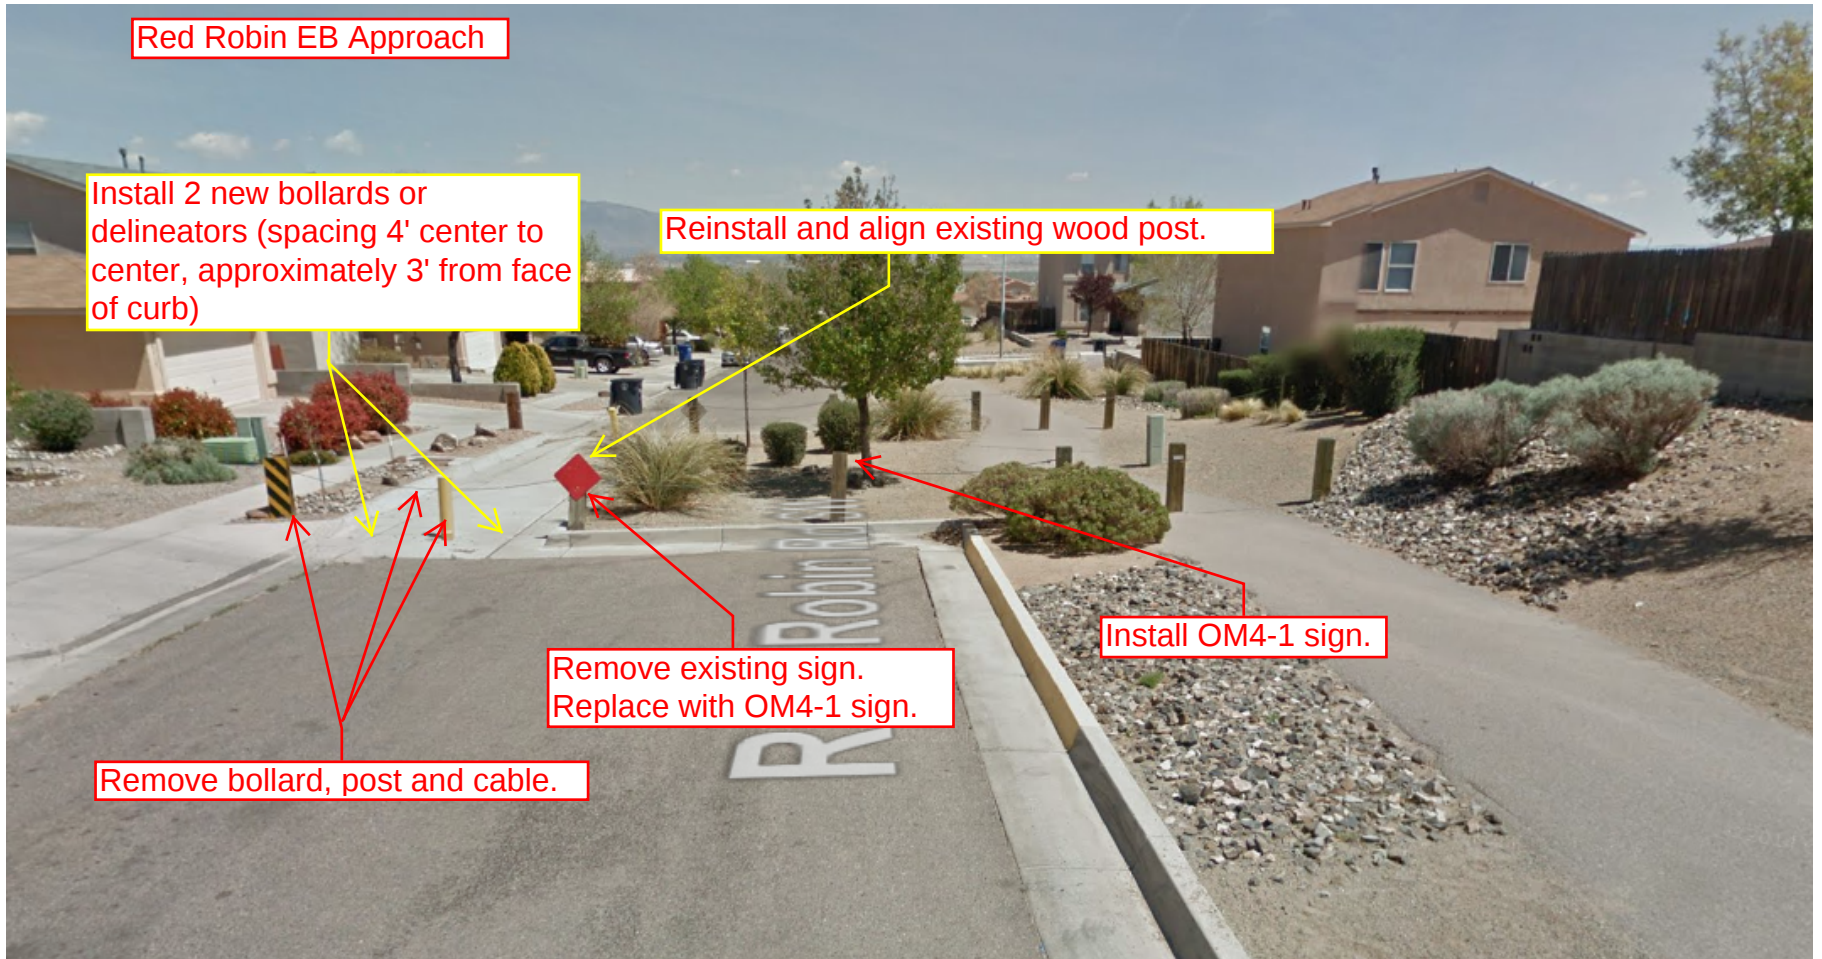


Figure 3C-1. Object Markers and End-of-Roadway Markers

Type 1 Object Markers



OM1-1



OM1-2



OM1-3

Type 2 Object Markers



OM2-1V



OM2-2V



OM2-1H



OM2-2H

Type 3 Object Markers



OM-3L




OM-3C



OM-3R

End-of-Roadway Markers

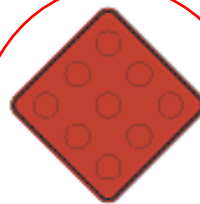

OM4-1



OM4-2



OM4-3