

PLAN

84" RCP

FLOW

VERTICAL
CORRECTION

HEADWALL

GUN CLUB DR

FLOW

84" RCP

B

A


A

GAS LINE

WATER LINE

B


Flow

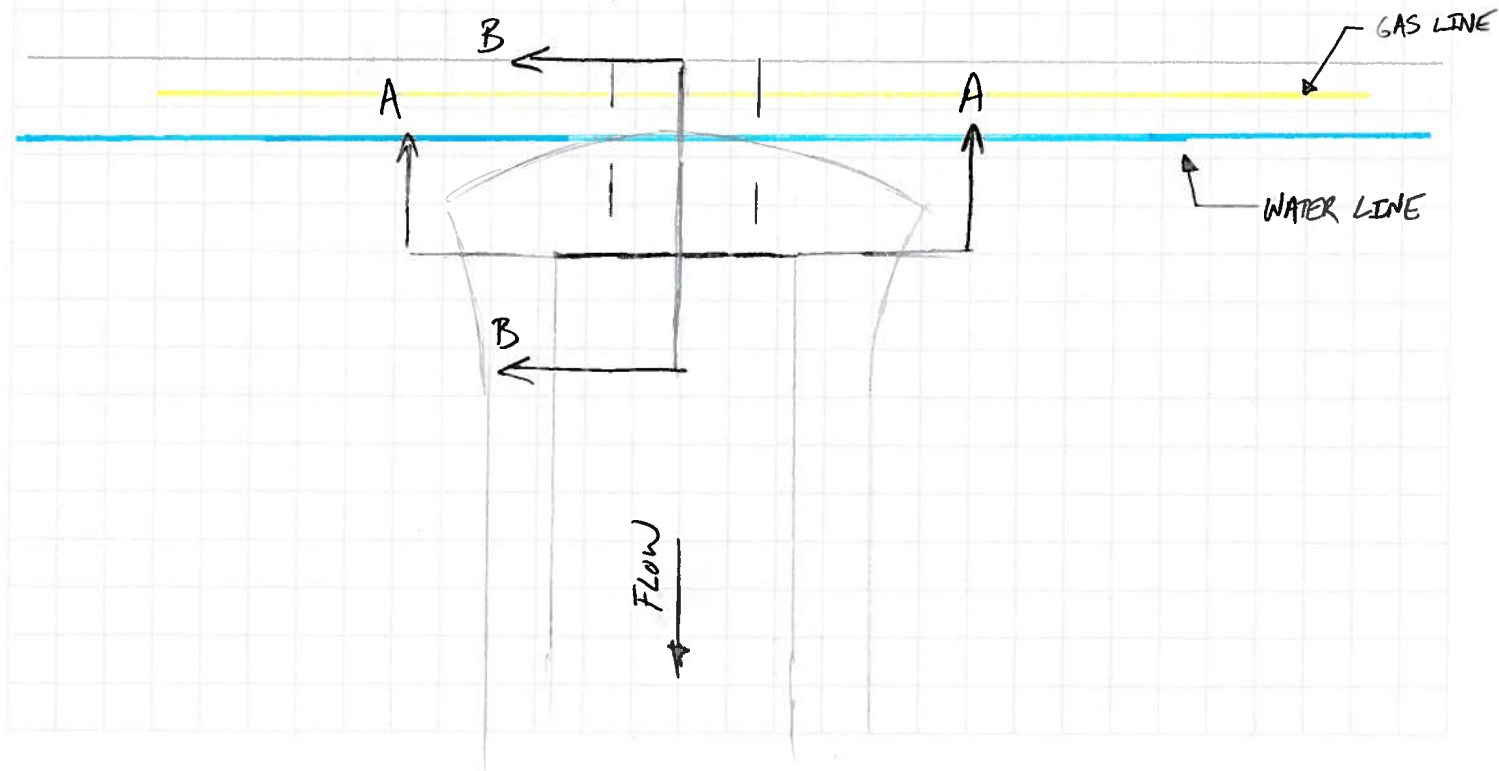

84" / 12 = 8' DIAMETER

SCALE : $\frac{1}{2}" = 1'-0"$

DETAIL A

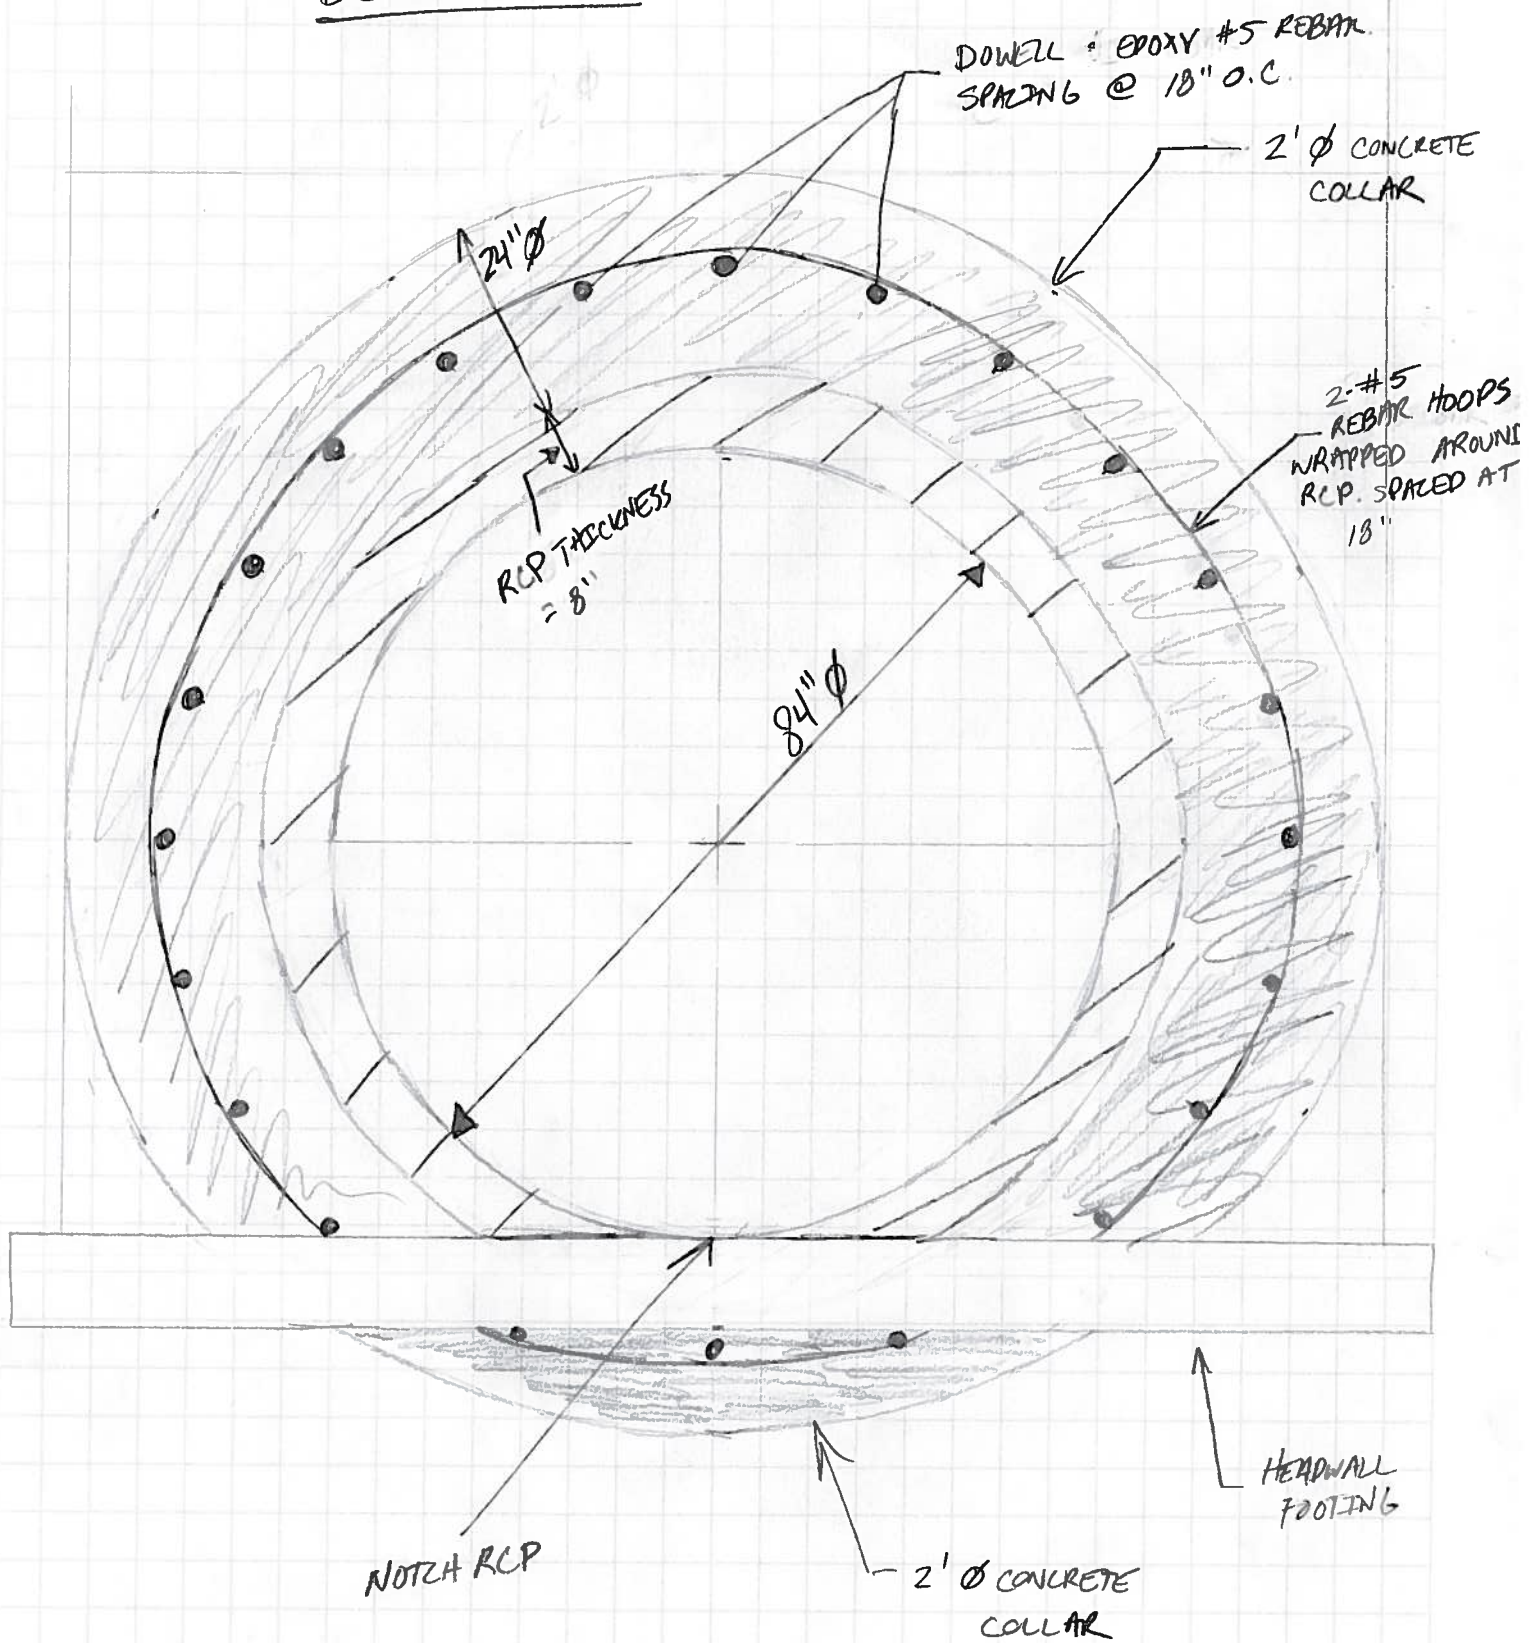

SCALE: 1" = 1'-0"

DETAIL B

