
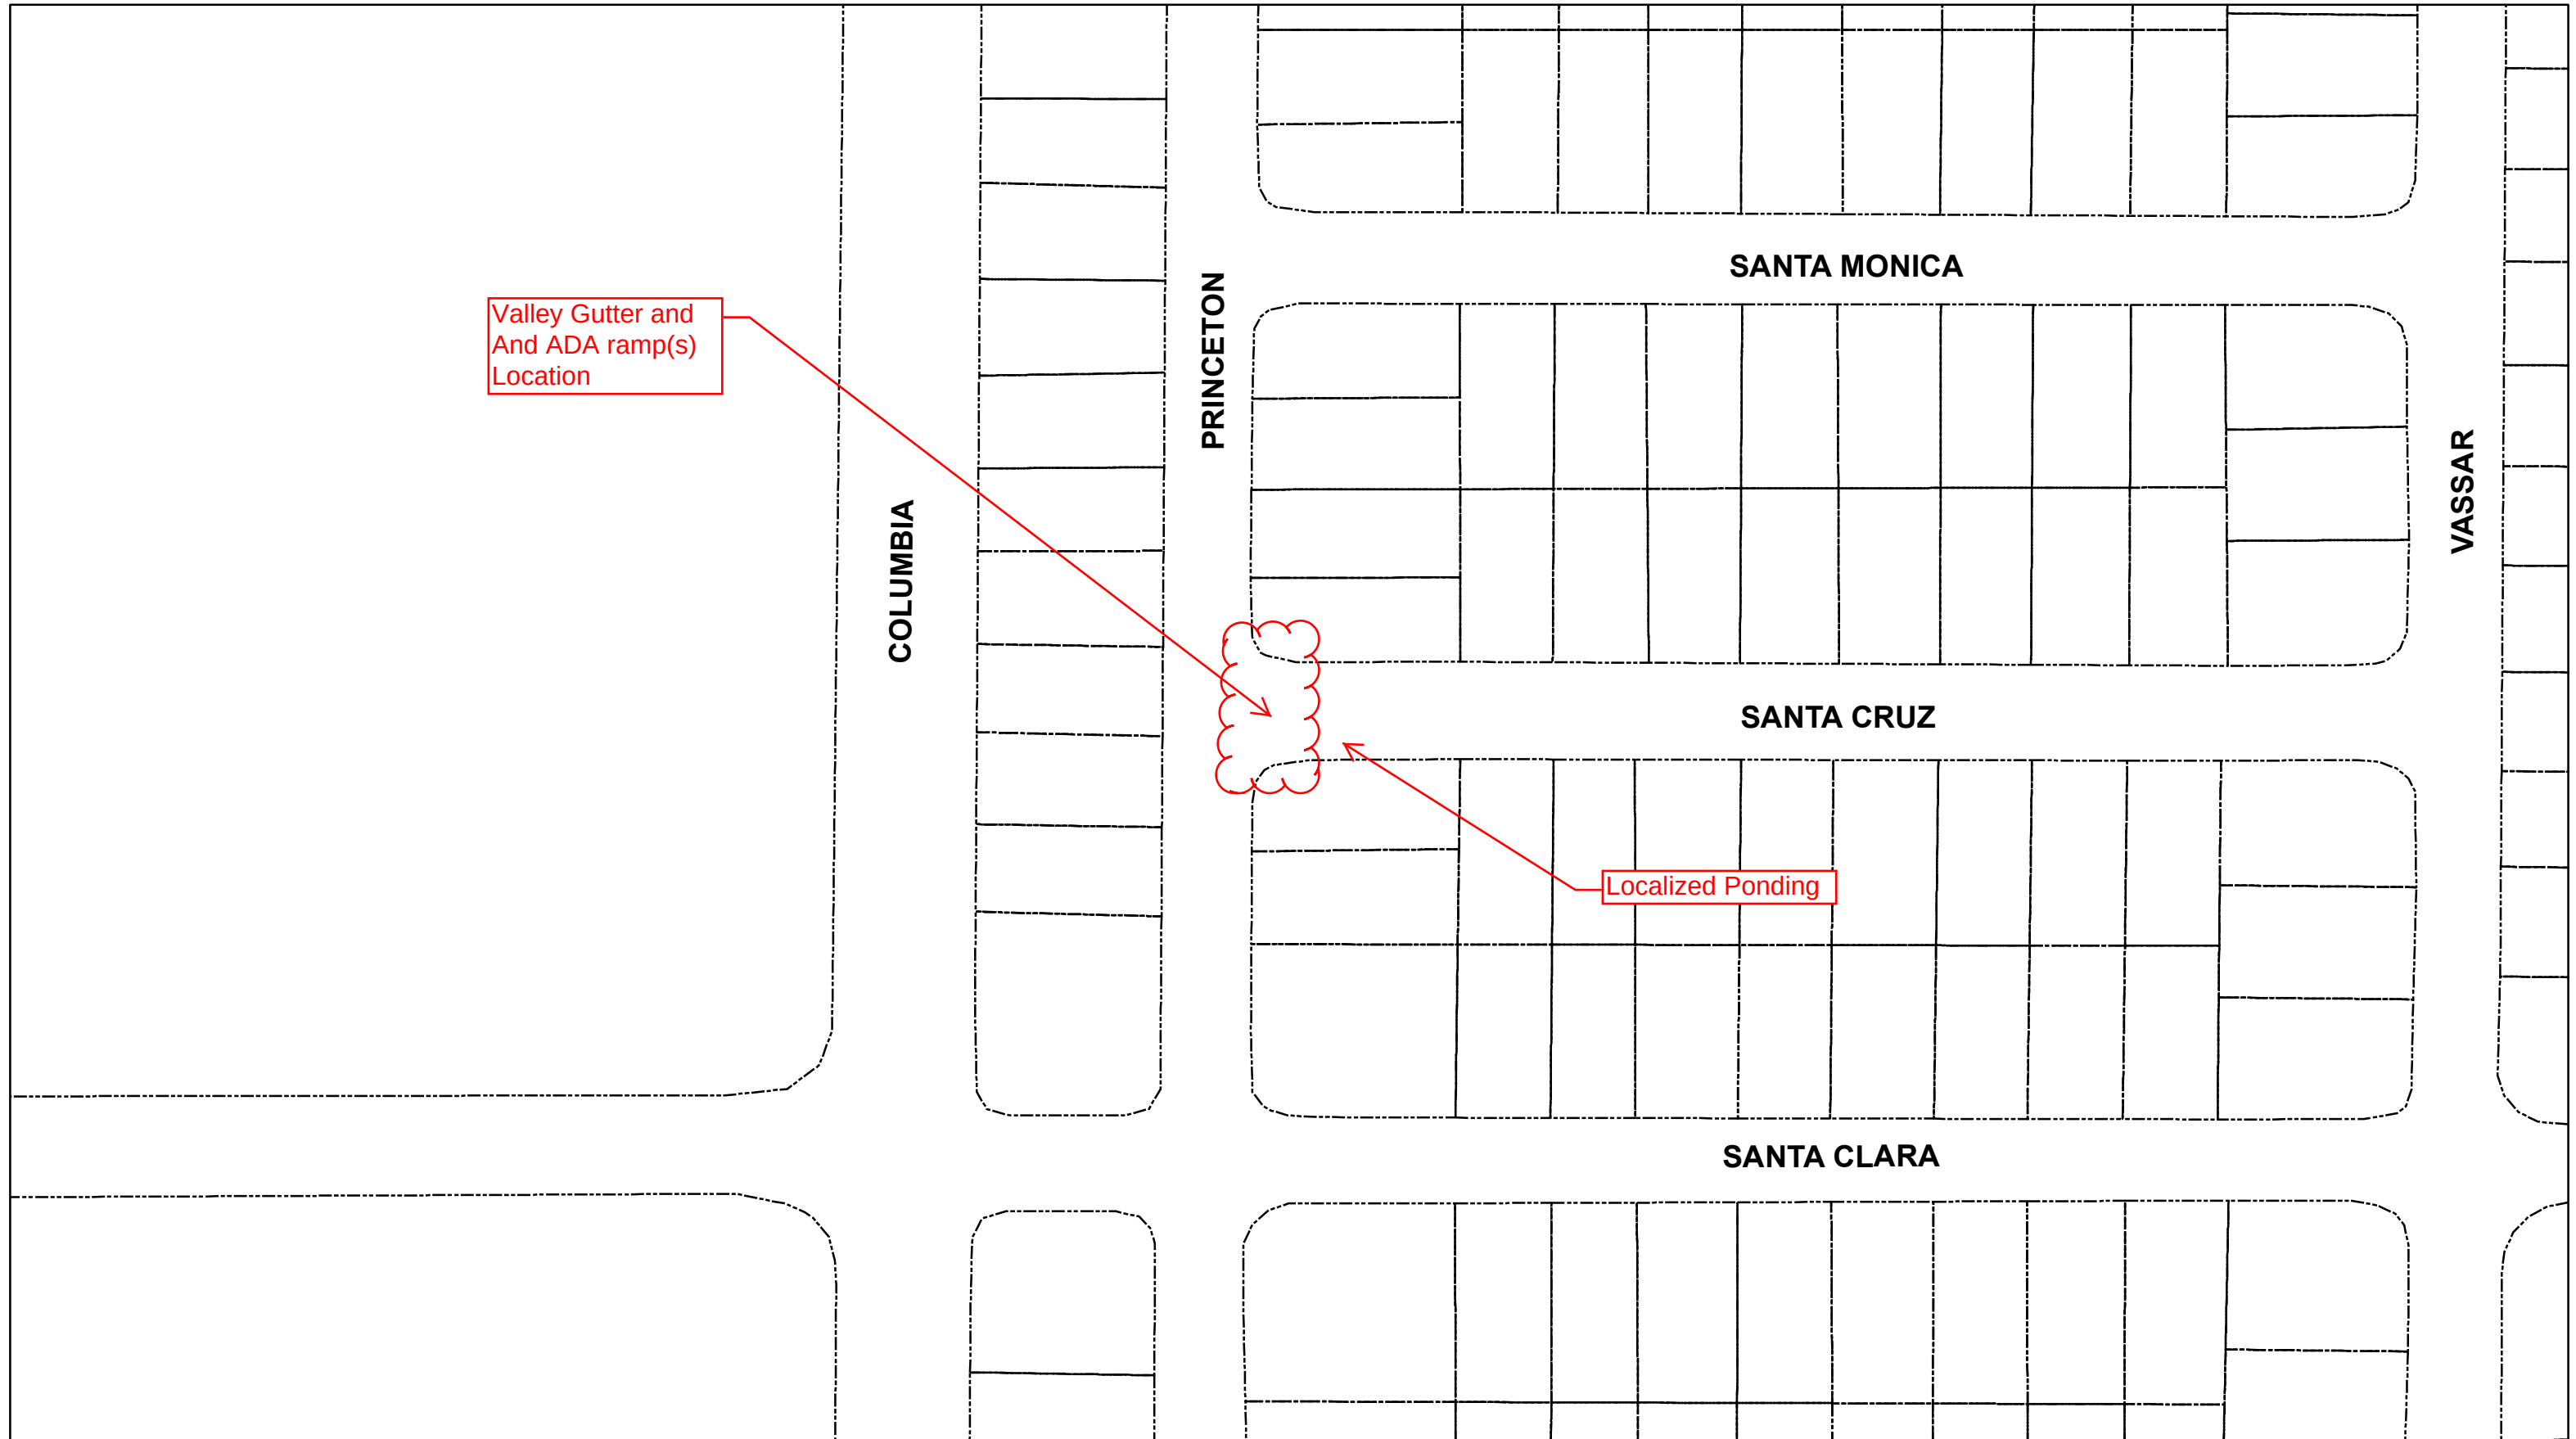


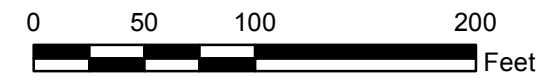

Valley Gutter and
And ADA ramp(s)
Location

Localized Ponding

ADA Improvements and Valley Gutter