



[illegible]

YALE AVE

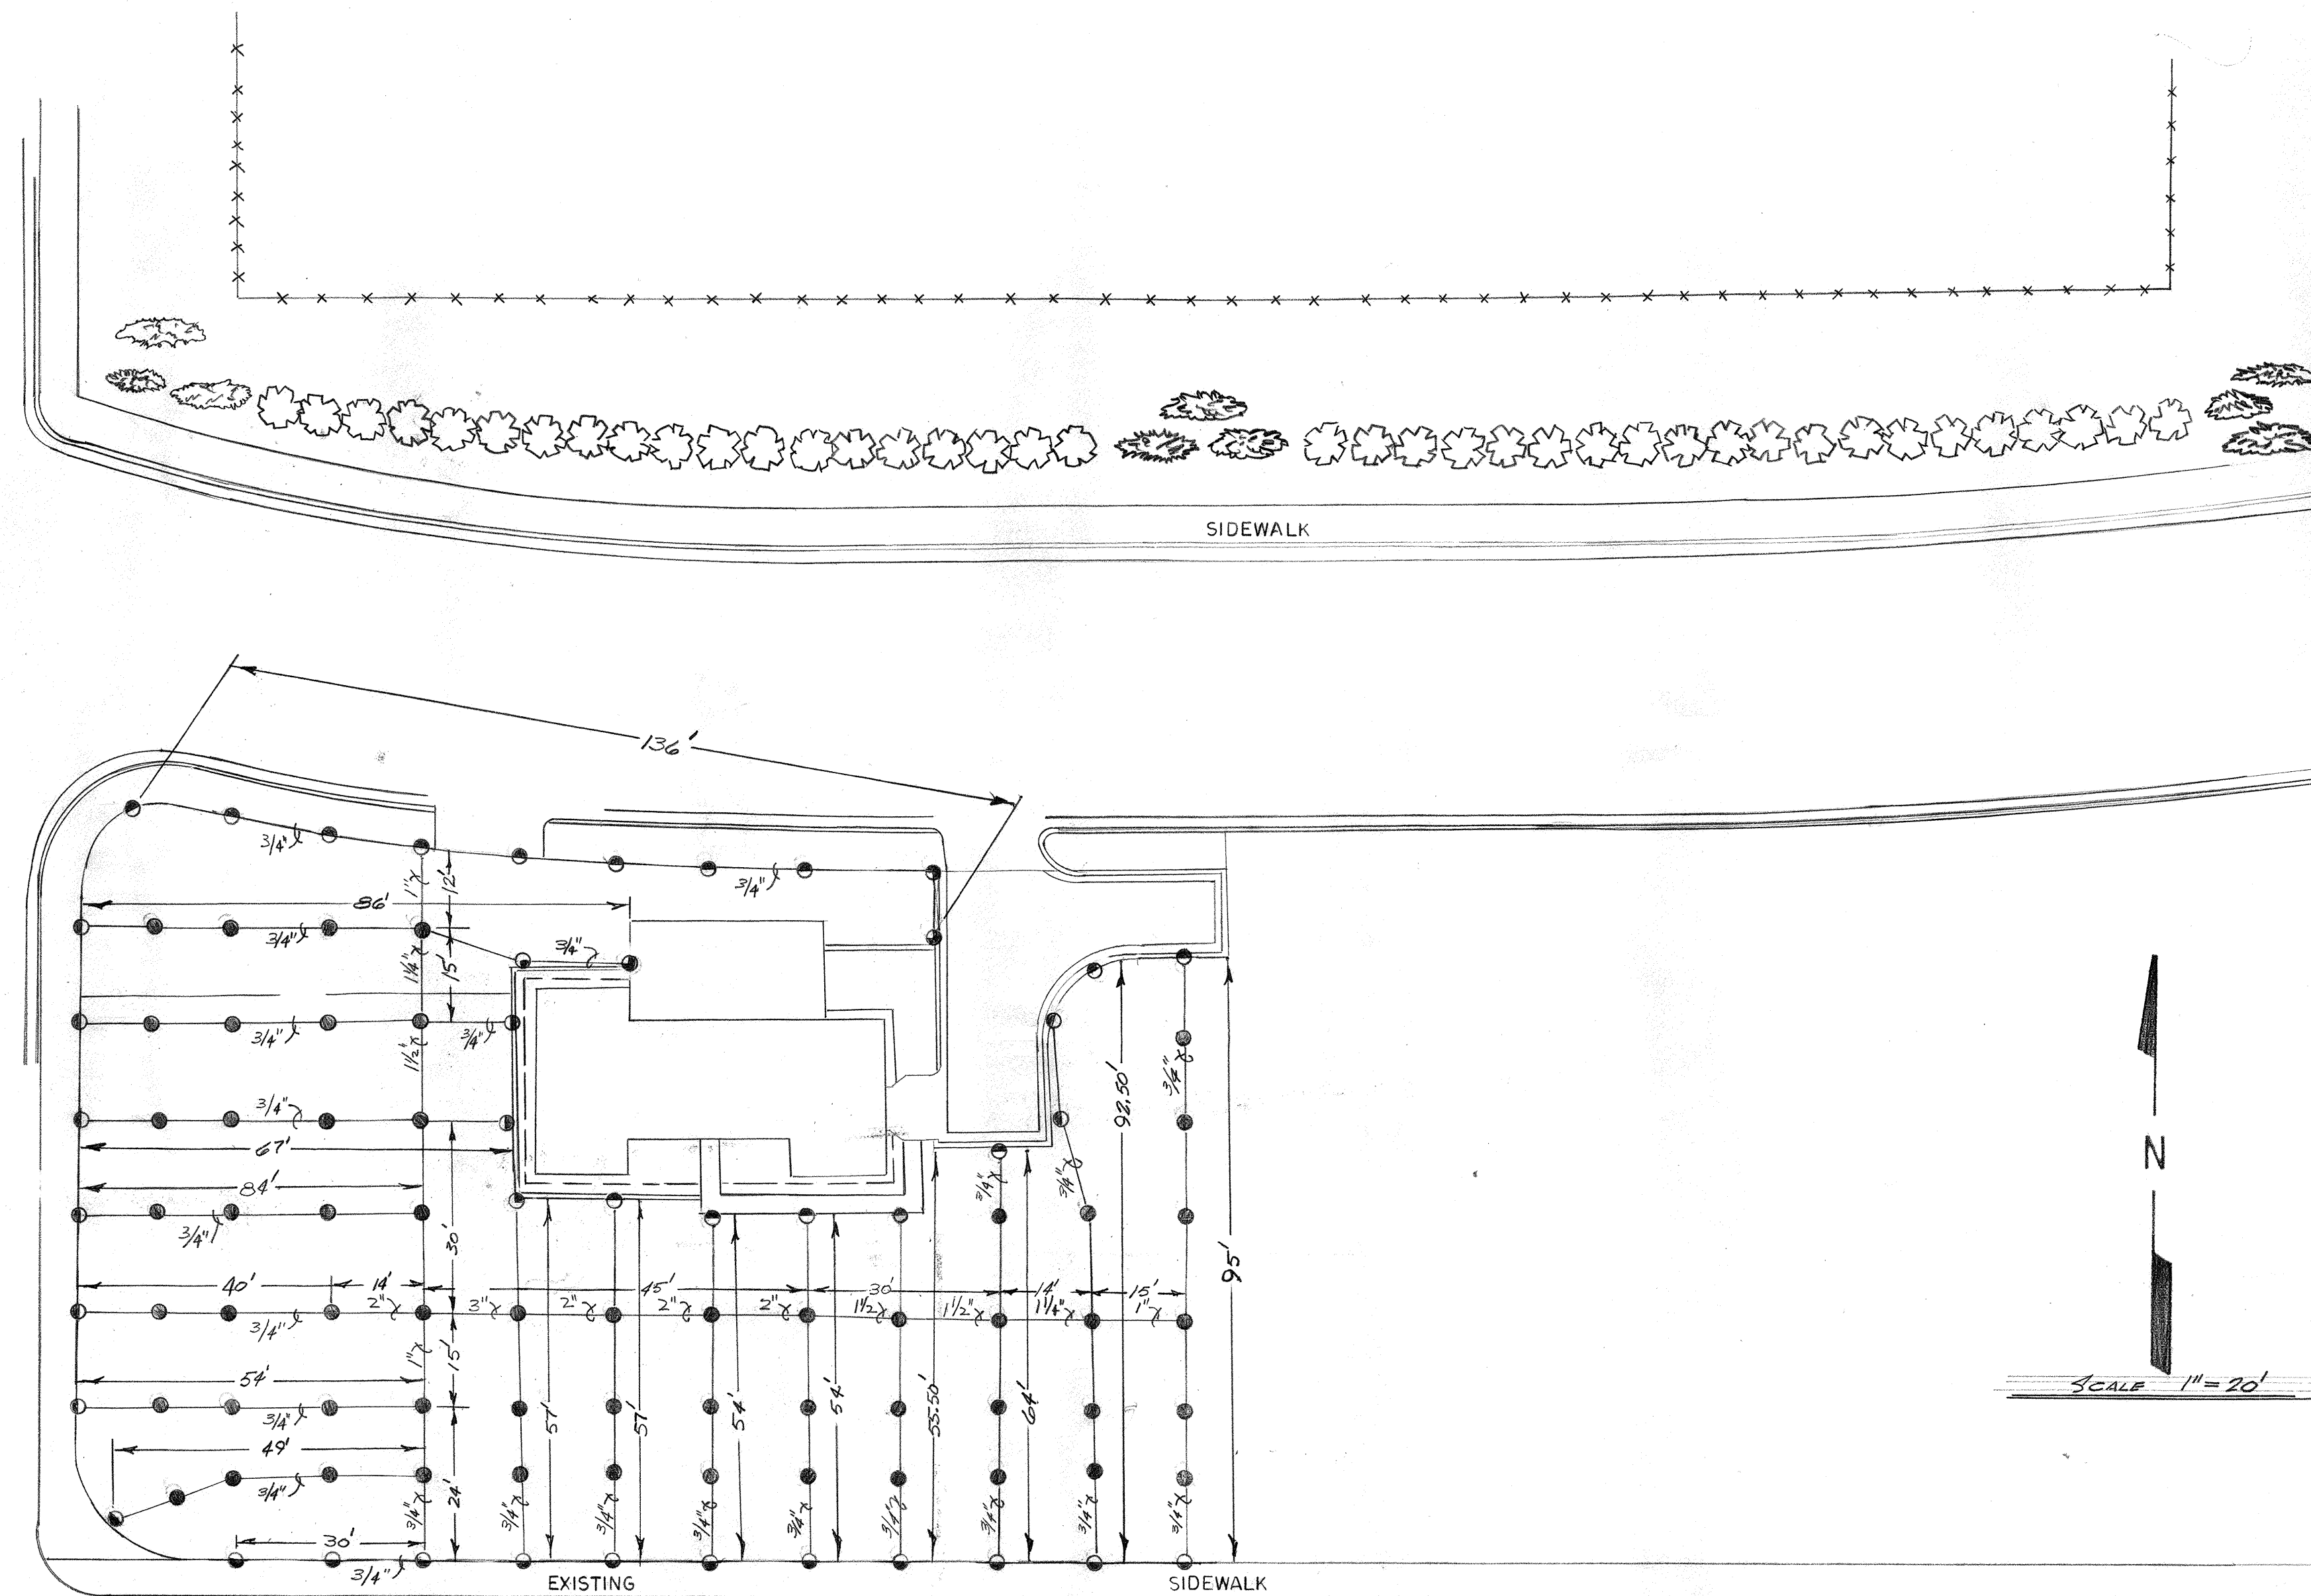


CENTRAL

AVE.

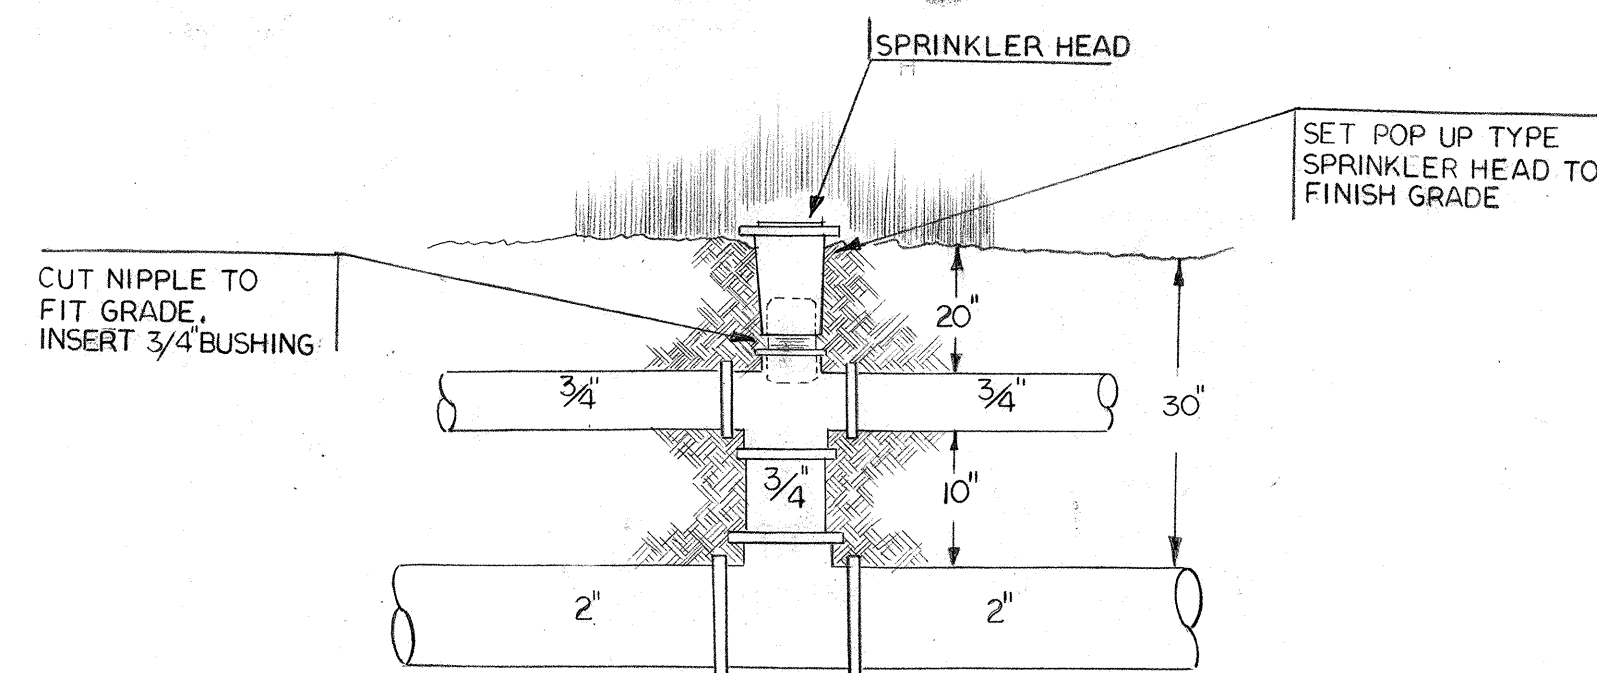

TYPICAL 3/4" AND MAIN LINE CONNECTION

- FULL HEADS 2 GAL. PER MIN. HEADS, RADIUS 14", NOZZLE 1/2"
- HALF HEADS AND FEMALE CONNECTION.
- TWO THIRDS HEADS POP UP TYPE 2" OR MORE, CHAMPION OR APPROVED EQUAL.
- ONE QUARTER HEAD

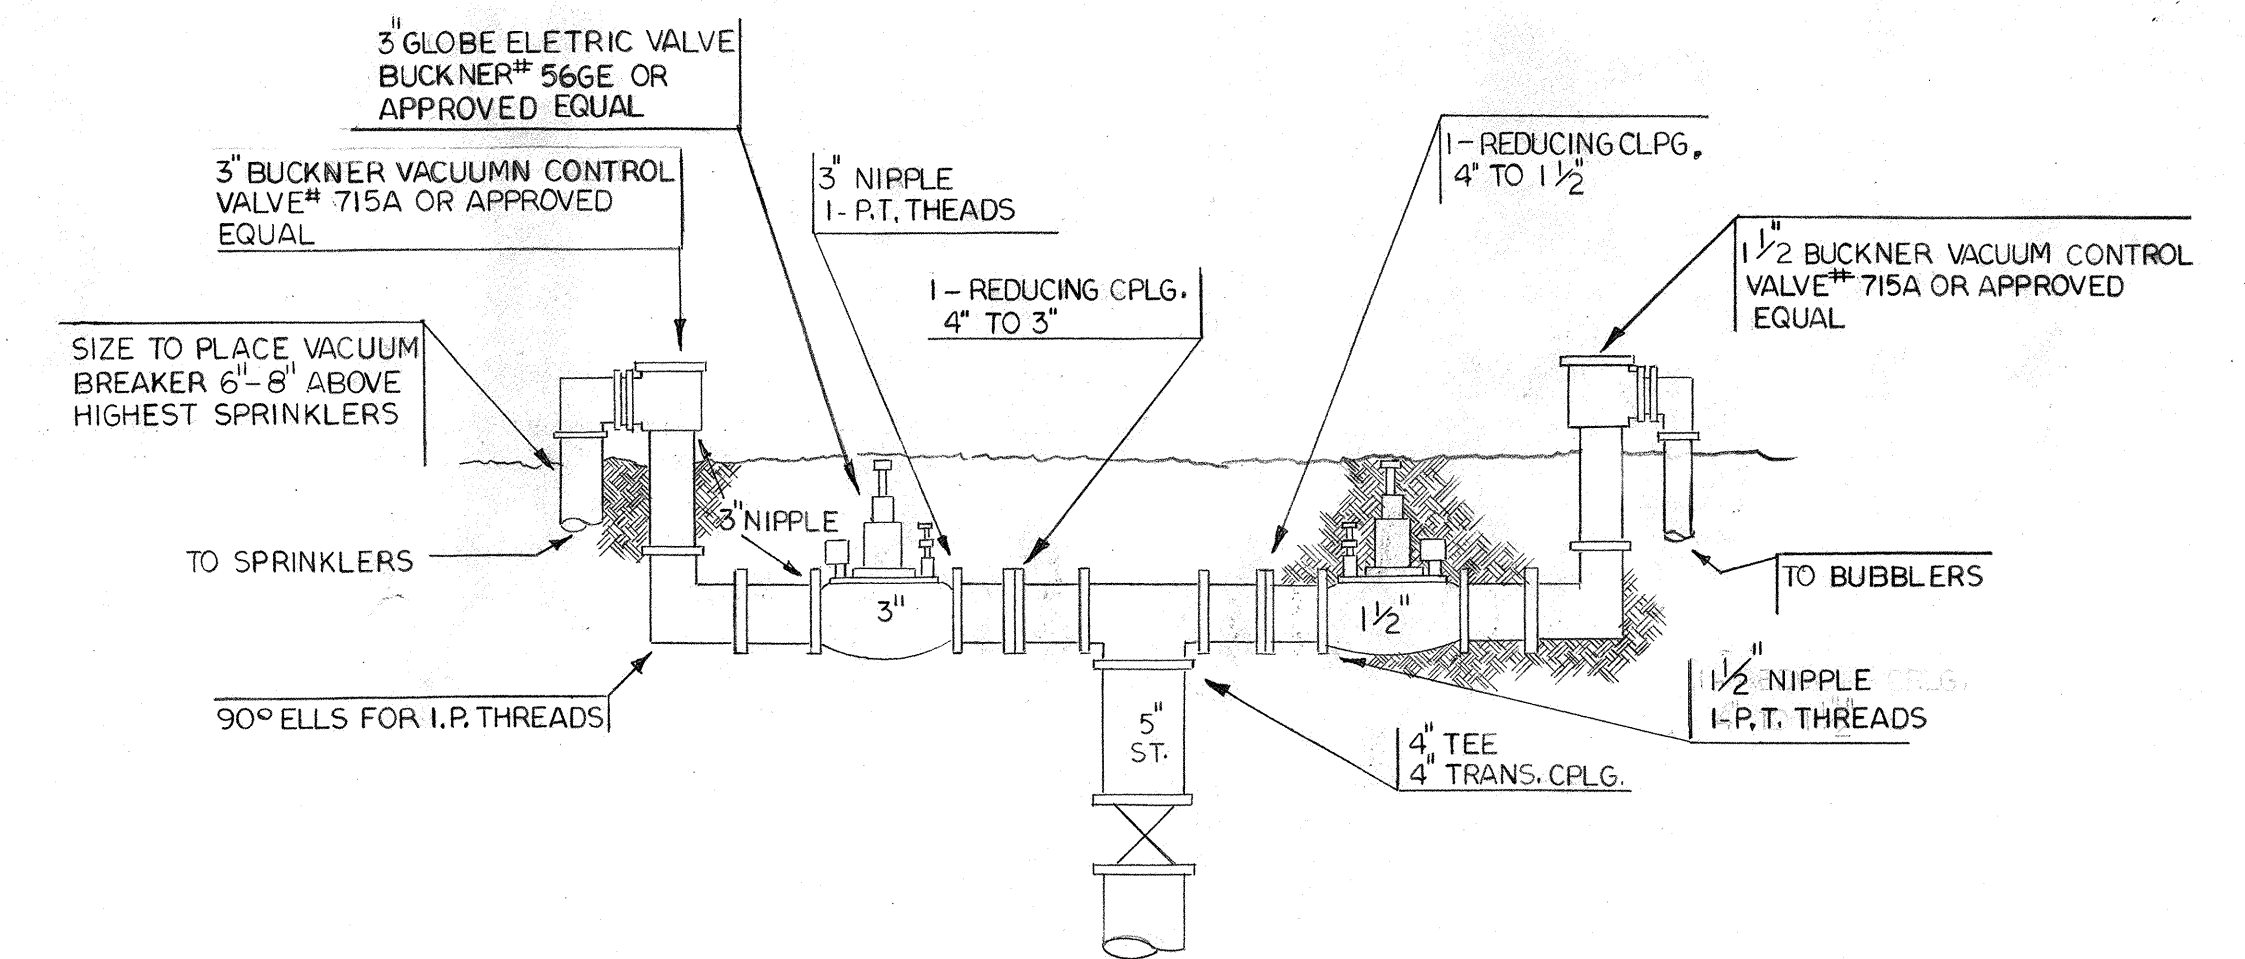



09 161 0368 10

CITY OF ALBUQUERQUE PUBLIC WORKS DEPARTMENT ENGINEERING DIVISION			
TITLE <u>YALE PUMP STATION LANDSCAPING</u>			
SUBMITTED BY	APPROVED BY	PRELIMINARY DRWG.	
DATE	DATE	DATE	
DESIGNED BY	APPROVED BY	CONSTRUCTION DRWG.	
DATE	DATE	DATE	
DRAWN BY <u>M. Evans</u>	APPROVED BY	AS BUILT DRWG. ☒	
DATE <u>12/16/07</u>	DATE	DATE	
CHECKED BY	APPROVED BY	FILE NO.	
DATE	DATE	DATE	
REV. BY <u>M. Evans</u>	DATE	REV. 4	
DATE <u>10-3-08</u>	DATE	DATE	
DATE	DATE	DATE	
SHEET NO. <u>3</u>		SHEETS <u>4</u>	

5-246

PLAN	SURVEYED	DATE
	PLOTTED	BY
	CHECKED	
	REVISION	

PROFILE	SURVEYED	DATE
	PLOTTED	BY
	CHECKED	
	REVISION	

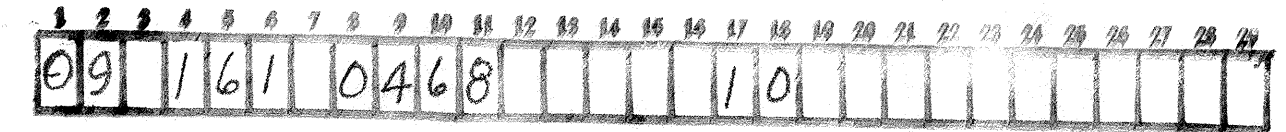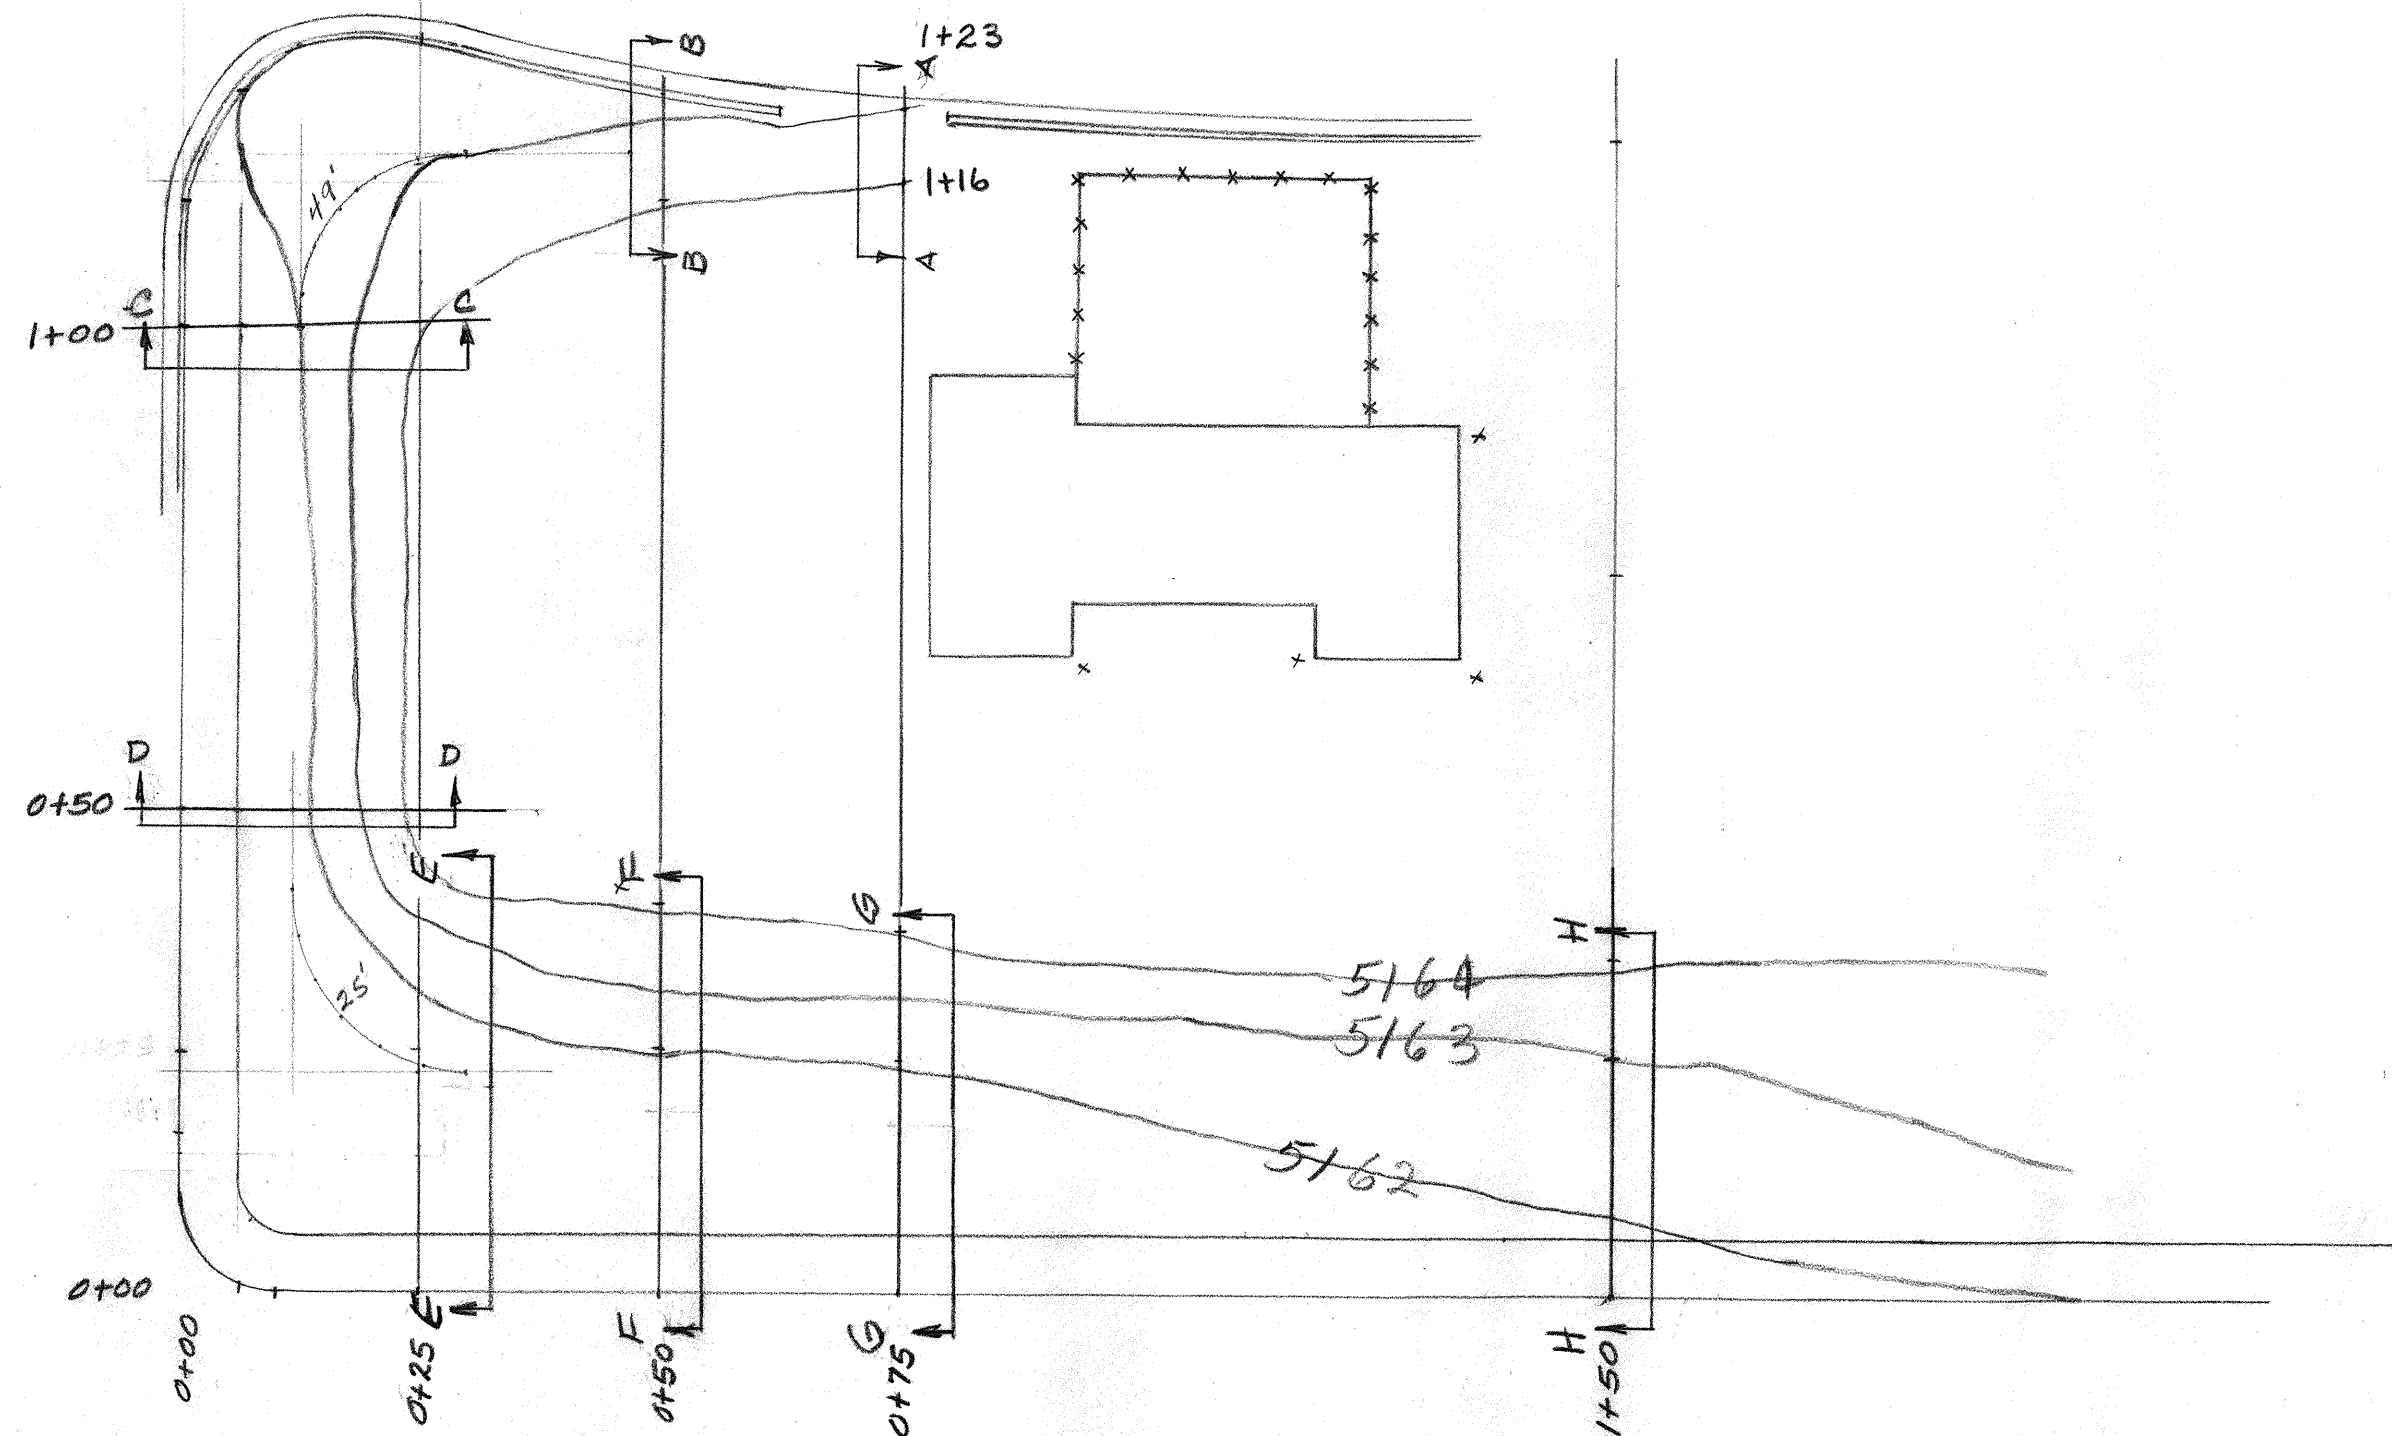

85 Cu. Yds. of Fill Required

SCALE
HORIZ. 1"=50'
VERT. 1"=1'

CITY OF ALBUQUERQUE PUBLIC WORKS DEPARTMENT ENGINEERING DIVISION		
TITLE <u>YALE PUMP STATION LANDSCAPING</u>		
SUBMITTED BY	APPROVED BY	PRELIMINARY DRWG.
DATE	DATE	DATE
DESIGNED BY	APPROVED BY	CONSTRUCTION DRWG.
DATE	DATE	DATE
DRAWN BY <u>M. EVANS</u>	APPROVED BY	AS BUILT DRWG. ☒
DATE <u>1/10/62</u>	DATE	DATE
CHECKED BY	APPROVED BY	FILE NO.
DATE	DATE	DATE
REV. BY <u>M. GRIEGO</u>	NOTES: <u>Rev. to As BUILT</u>	SHEET NO. <u>4</u> OF <u>4</u>
DATE <u>10-3-68</u>	NOTES:	SHEETS

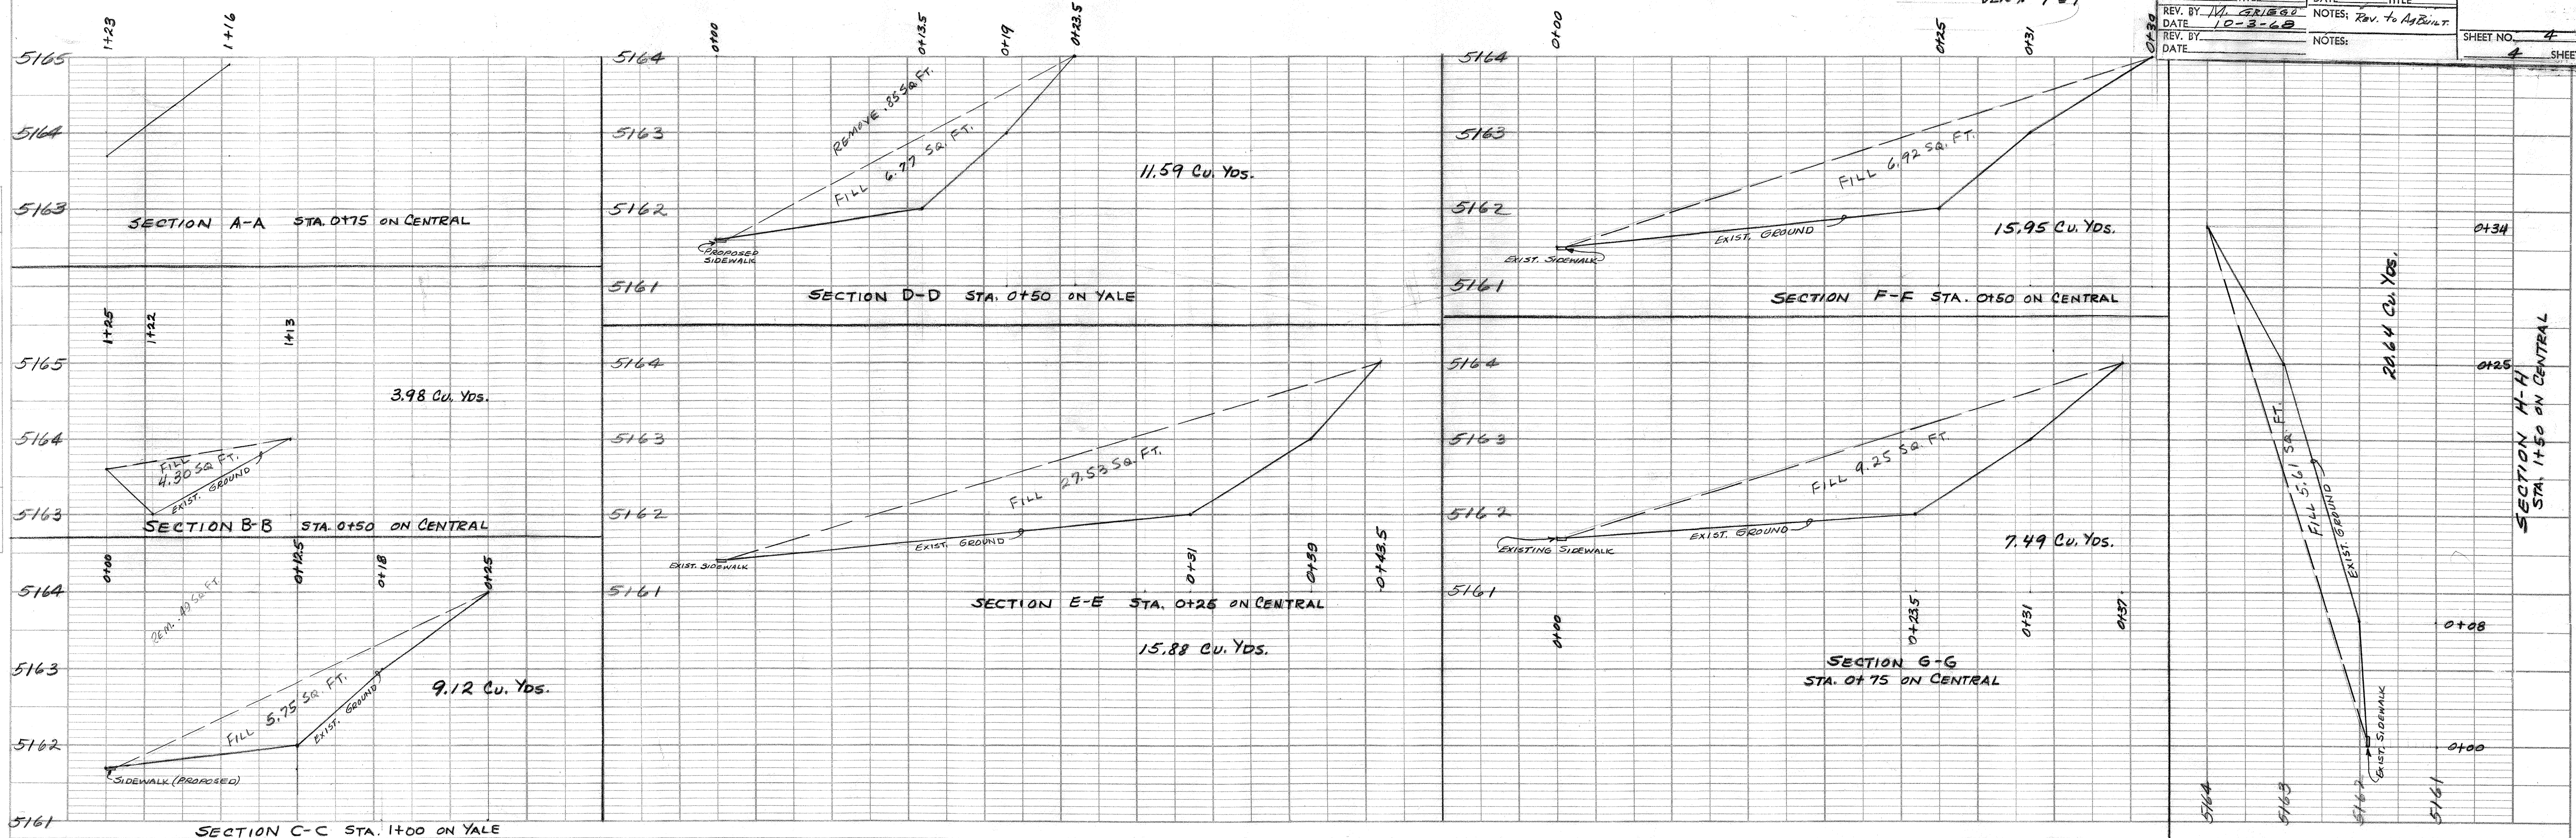


PLATE 1-PLAN-PROFILE D.P.R. & R.E. STANDARD
100% ASPHALT VELLUM—MADE AND PRINTED IN U.S.A.
EUGENE DIETZEN CO.

S-246