


ACADEMY ESTATES UNIT 7

SCALE: HORIZ. 1" = 50'
VERT. 1" = 10'

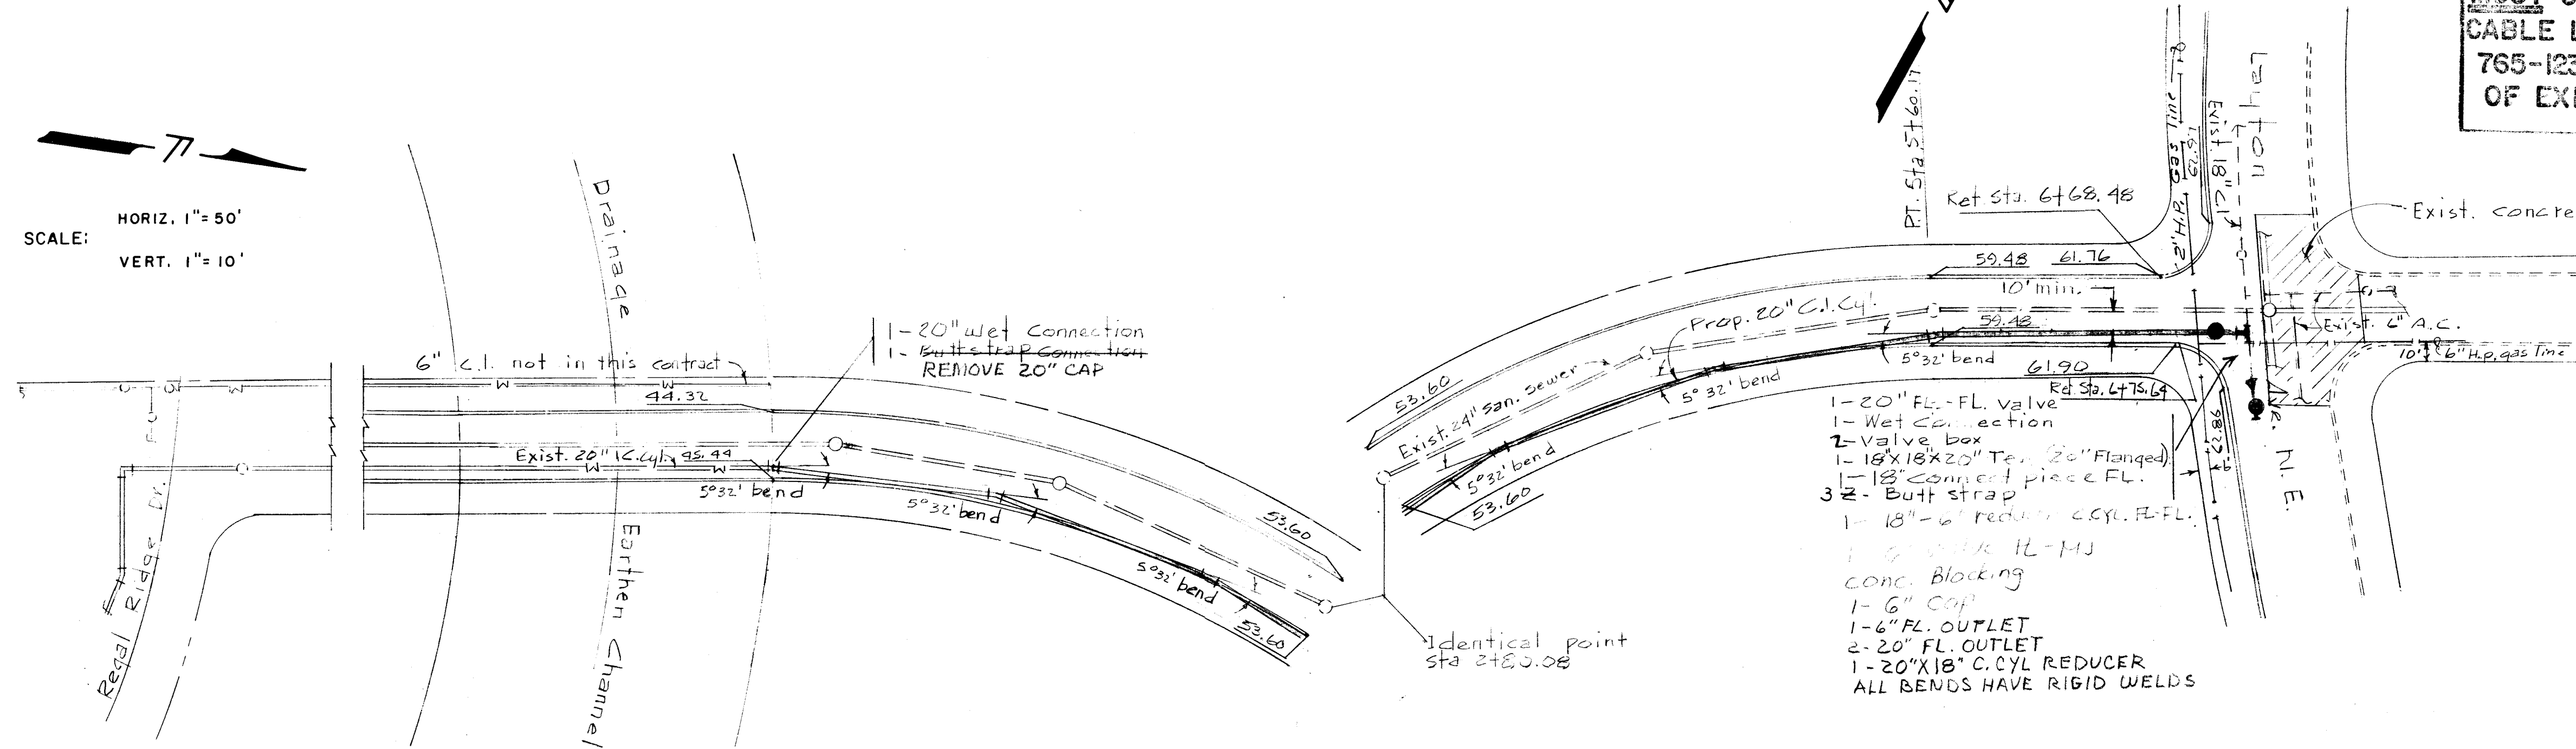


48 HOURS PRIOR TO ANY EXCAVATION, CONTRACTOR MUST CONTACT LINE AND CABLE LOCATING SERVICE, 765-1234, FOR LOCATION OF EXISTING UTILITIES.

- LEGEND**
- Prop. Water Line
 - - - Exist. Water Line
 - - - Exist. Sanitary Sewer
 - - - Prop. Curb
 - - - Prop. Curb Elevation
 - - - Exist. Gas Line

Coordinate Construction with Tijeras IA Interceptor and City Water Resources Dept.

ESTRELLITA DEL NORTE ROAD N.E.

SCANNED BY BY LASON

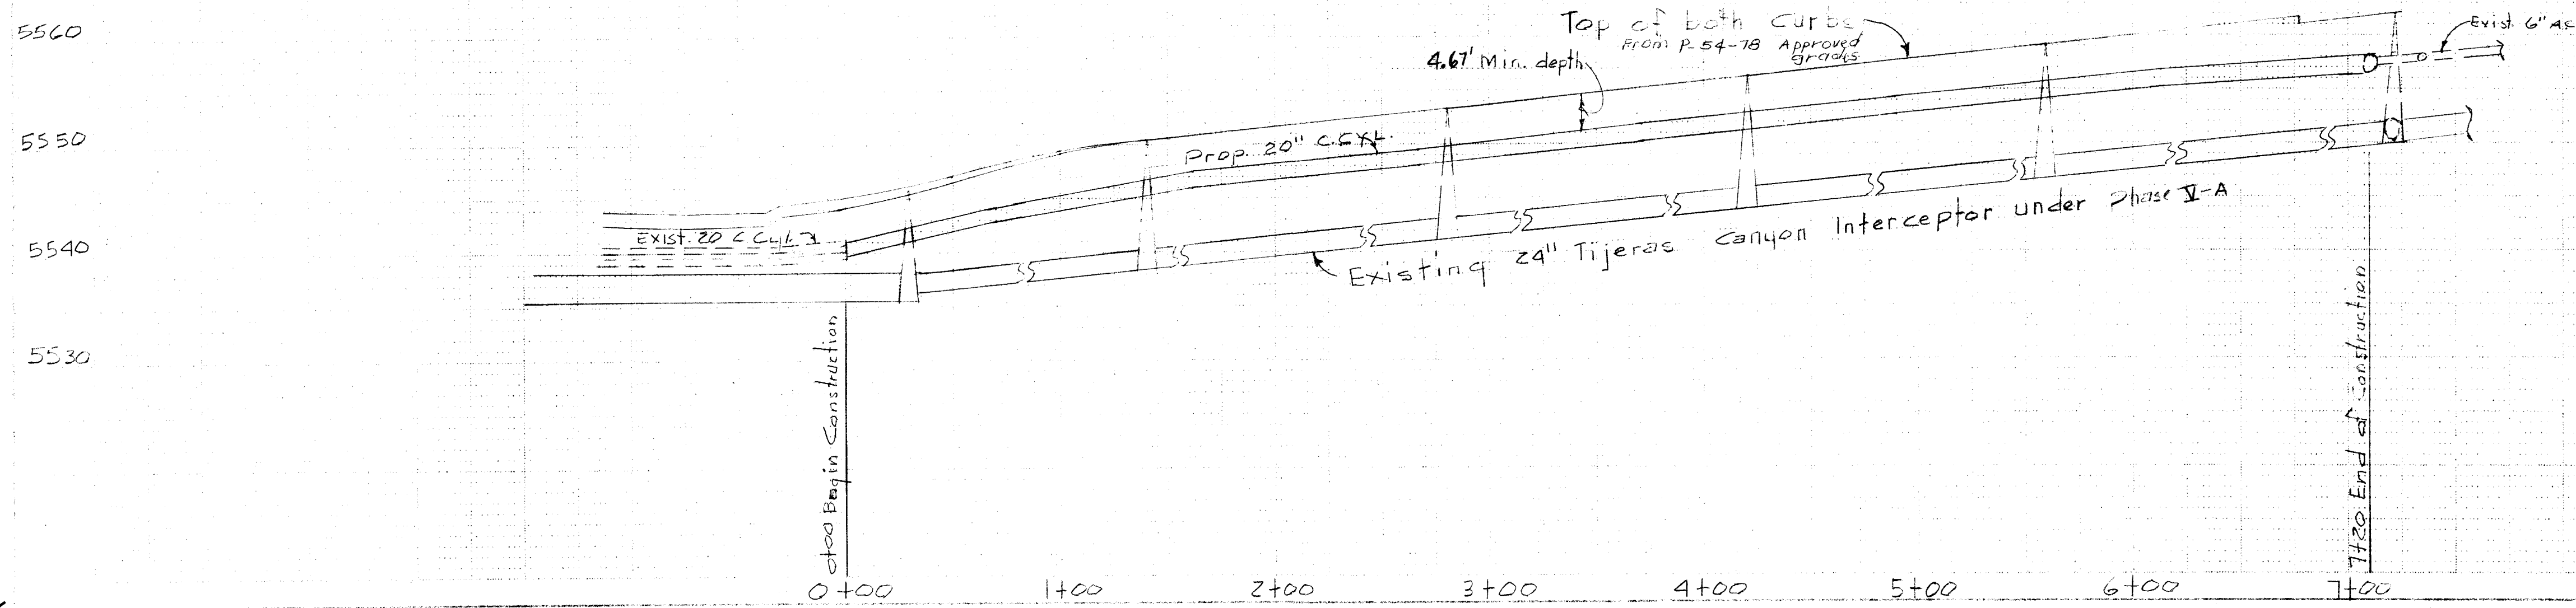

APPROVAL OF AS-BUILT DRAWINGS
ASSISTANT CITY ENGINEER - FIELD
DATE: 12-6-88

APPROVED FOR CONSTRUCTION
CITY ENGINEER
DATE: 7-26-77

CITY OF ALBUQUERQUE PUBLIC WORKS DEPARTMENT ENGINEERING DIVISION					
TITLE: WATER LINE EXTENSION IN ACADEMY ESTATES UNIT 7					
APPROVALS	ENGINEER	DATE	APPROVALS	ENGINEER	DATE
City Engineer	7-29-78		Liquid Waste		
A.C.E. Design	7-29-78		Trails		
A.C.E. Hydrology			Water		
DRAWING NO. W-97-78			SHEET 1 OF 1		

AS-BUILT INFORMATION		BENCH MARKS		SURVEY INFORMATION		FIELD NOTES		DATE	
NO.	BY	NO.	BY	NO.	BY	NO.	BY	NO.	BY
1	W. J. LASON	1	W. J. LASON	1	W. J. LASON	1	W. J. LASON	1	W. J. LASON
2	W. J. LASON	2	W. J. LASON	2	W. J. LASON	2	W. J. LASON	2	W. J. LASON
3	W. J. LASON	3	W. J. LASON	3	W. J. LASON	3	W. J. LASON	3	W. J. LASON
4	W. J. LASON	4	W. J. LASON	4	W. J. LASON	4	W. J. LASON	4	W. J. LASON
5	W. J. LASON	5	W. J. LASON	5	W. J. LASON	5	W. J. LASON	5	W. J. LASON
6	W. J. LASON	6	W. J. LASON	6	W. J. LASON	6	W. J. LASON	6	W. J. LASON
7	W. J. LASON	7	W. J. LASON	7	W. J. LASON	7	W. J. LASON	7	W. J. LASON
8	W. J. LASON	8	W. J. LASON	8	W. J. LASON	8	W. J. LASON	8	W. J. LASON
9	W. J. LASON	9	W. J. LASON	9	W. J. LASON	9	W. J. LASON	9	W. J. LASON
10	W. J. LASON	10	W. J. LASON	10	W. J. LASON	10	W. J. LASON	10	W. J. LASON