


**C** MAINTENANCE BUILDING

1/8"=1'-0"

**B** NOT USED

1/8"=1'-0"

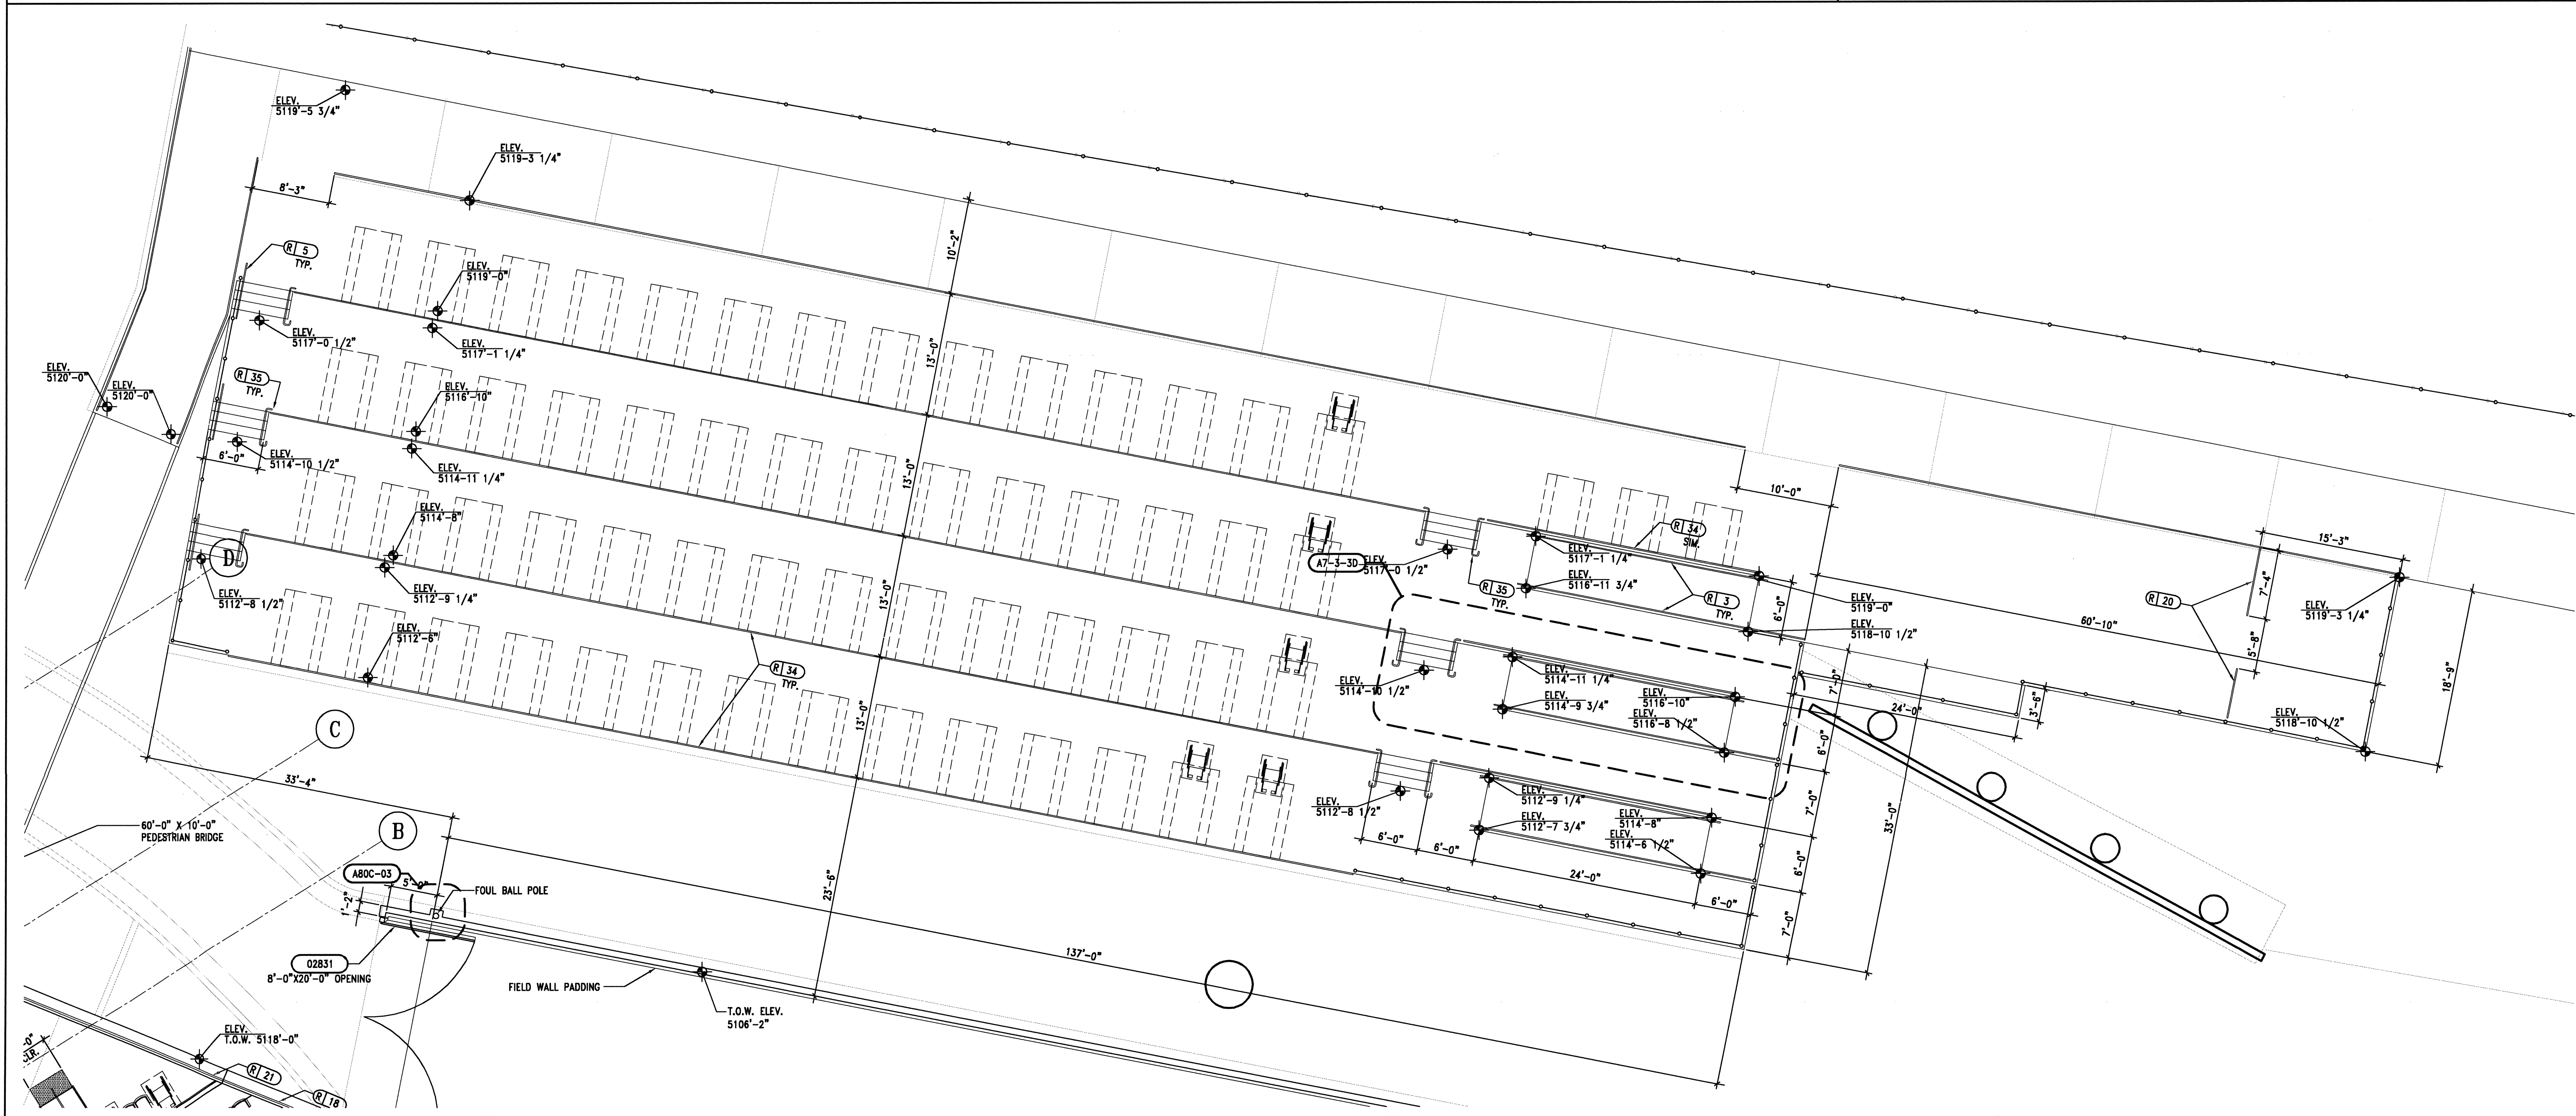

**A** MAIN CONCOURSE LEVEL AREA F FLOOR PLAN

1/8"=1'-0"

- DIVISION 2 - SITE WORK**
- 02104 Plant Material Removal
  - 02130 Plant Material Preservation
  - 02300 Earthwork
  - 02831 Chain Link Fences and Gates
  - 02850 Pedestrian Bridges
  - 02910 Natural Turf Playing Field System
- DIVISION 3 - CONCRETE**
- 03100 Concrete Formwork
  - 03200 Concrete Reinforcement
  - 03300 Cast-in-Place Concrete
  - 03410 Precast/Prestressed Concrete
  - 03450 Architectural Precast Concrete
  - 03530 Concrete Toppings
  - 03535 Polymer Concrete
  - 03931 Concrete Restoration: Crack Repair by Epoxy Injection
- DIVISION 4 - MASONRY**
- 04810 Unit Masonry Assemblies
  - 04820 Reinforced Unit Masonry
  - 04860 Stone Masonry Veneer
- DIVISION 5 - METALS**
- 05125 Structural Steel
  - 05210 Steel Joists
  - 05300 Metal Decking
  - 05400 Light Gauge Metal Framing
  - 05500 Metal Fabrications
  - 05521 Pipe and Tube Ralls
  - 05580 Formed Metal Fabrications
  - 05810 Expansion Joint Cover Assemblies
- DIVISION 6 - WOOD AND PLASTICS**
- 06105 Miscellaneous Carpentry
  - 06200 Finish Carpentry
  - 06400 Architectural Woodwork
- DIVISION 7 - THERMAL & MOISTURE PROTECTION**
- 07115 Bituminous Waterproofing
  - 07142 Hot Fluid-Applied Waterproofing
  - 07151 Bentonite Waterproofing
  - 07190 Water Repellents
  - 07210 Building Insulation
  - 07410 Metal Wall Panels
  - 07418 Architectural Standing Seam Roof
  - 07430 Composite Wall Panels
  - 07531 DPM Single-Ply Membrane Roofing
  - 07620 Steel Metal Flashing and Trim
  - 07720 Roof Accessories
  - 07811 Sprayed-On Insulative Materials
  - 07840 Fireproofing
  - 07910 Joint Sealants
  - 07915 Precast Sealing Bowl Joint Sealants
- DIVISION 8 - DOORS AND WINDOWS**
- 08110 Steel Doors and Frames
  - 08211 Flush Wood Doors
  - 08310 Access Doors
  - 08330 Overhead Ceiling Doors
  - 08410 Aluminum Entrances and Storefronts
  - 08520 Aluminum Windows
  - 08655 Security Windows and Accessories
  - 08711 Door Hardware
  - 08800 Clazing
  - 08814 Mirrored Glass
  - 08811 Glazed Aluminum Curtain Walls
- DIVISION 9 - FINISHES**
- 09215 Gypsum Veneer Plaster
  - 09220 Portland Cement Plaster
  - 09260 Gypsum Board Assemblies
  - 09265 Gypsum Board Shaft Wall Systems
  - 09310 Ceramic Tile
  - 09511 Acoustical Panel Ceilings
  - 09650 Resilient Athletic Flooring
  - 09651 Resilient Tile Flooring
  - 09653 Resilient Wall Base and Accessories
  - 09655 Synthetic Turf
  - 09675 Acrylic Floor Floor Toppings
  - 09680 Carpet
  - 09780 Floor Sealer
  - 09791 Concrete Stain
  - 09815 Hazard Striping
  - 09910 Painting
- DIVISION 10 - SPECIALTIES**
- 10155 Toilet Compartments
  - 10350 Floppoles
  - 10425 Signs
  - 10450 Pedestrian Control Devices
  - 10520 Fire Protection Specialties
  - 10800 Toilet and Bath Accessories
- DIVISION 11 - EQUIPMENT**
- 11180 Loading Dock Equipment
  - 11172 Waste Compactor
  - 11480 Baseball Stadium Game Equipment
  - 11481 Field Wall Posts
  - 11700 Sound Reinforcement System
- DIVISION 12 - FURNISHINGS**
- DIVISION 13 - SPECIAL CONSTRUCTION**
- DIVISION 14 - CONVEYING SYSTEMS**
- 14240 Hydraulic Elevators
- DIVISION 15 - MECHANICAL**
- 16950 Sports Field Lighting
- DIVISION 16 - ELECTRICAL**
- 16950 Sports Field Lighting
- NOTE:** ALL PARTITIONS ARE TYPE STB UNLESS NOTED OTHERWISE

**HOK**  
SPORT+VENUE+EVENT  
HOK SPORTS FACILITIES GROUP, LLC  
Architecture, Planning,  
Interiors, Facility Programming  
323 West 8th Street, Suite 700  
Kansas City, Missouri 64105

**SMP ARCHITECTS**  
ASSOCIATE ARCHITECT  
115 Ashland Drive SE  
Albuquerque, NM 87106

**CHAVEZ-GRIEVE CONSULTING ENGINEERS, INC.**  
CIVIL/STRUCTURAL ENGINEER  
5629 Jefferson Street NE, Suite 1  
Albuquerque, NM 87110

**BOHANNAN HUSTON**  
CIVIL ENGINEER  
7000 Jefferson Street NE  
Albuquerque, NM 87110

**CME, INC.**  
MECH/ELECT/PLUMBING ENGINEER  
4400 Lomas Boulevard NE, Suite 500E  
Albuquerque, NM 87110

**MORROW REARDON WILKINSON, LTD.**  
LANDSCAPE ARCHITECT  
210 La Vista Drive NE  
Albuquerque, NM 87106

**WJHW**  
AUDIO/VISUAL CONSULTANTS  
13714 Gorman Road, Suite 110  
Dallas, TX 75244


**BREDSON & ASSOCIATES**  
SPORTS LIGHTING DESIGN CONSULTANTS  
9033 East 43rd Street, Suite 214A  
Raytown, MO 64133

**OVATIONS**  
FOOD SERVICE CONSULTANTS  
10012 North 2nd Street, Suite 215  
Tampa, FL 33618

ALBUQUERQUE  
AAA BALLPARK  
FOR  
THE CITY OF  
ALBUQUERQUE, NEW MEXICO

**RECORD DRAWINGS**  
June 10, 2003

PACKAGE		
REVISIONS		
NO.	DATE	DESCRIPTION
1	2/28/02	ADDENDUM NO. 1
2	3/8/02	ADDENDUM NO. 2

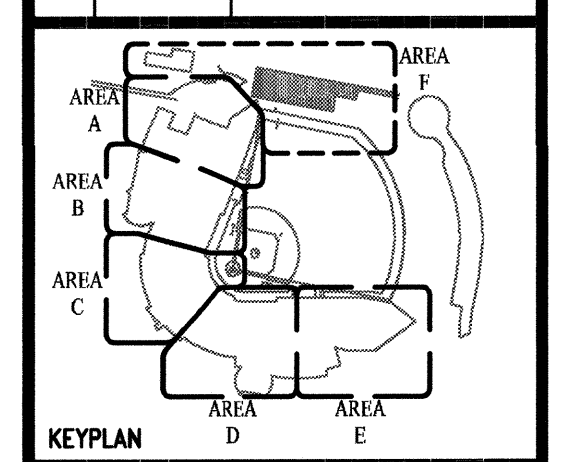

PROJECT NO. 01-004-10	ISSUED BY: HOK SPORT
DRAWN BY:	REVIEWED BY:

ISSUE DATE: FEBRUARY 12, 2002

SHEET TITLE:

MAIN CONCOURSE  
AREA F  
FLOOR PLAN

DISCIPLINE - CATEGORY - SUB-CATEGORY - SHEET

**A2-2F**